


INTERNATIONAL • SERVICES • EXPANSION • PROGRAM

**APM STATION + PLATFORM**

GENERAL SITE PLAN

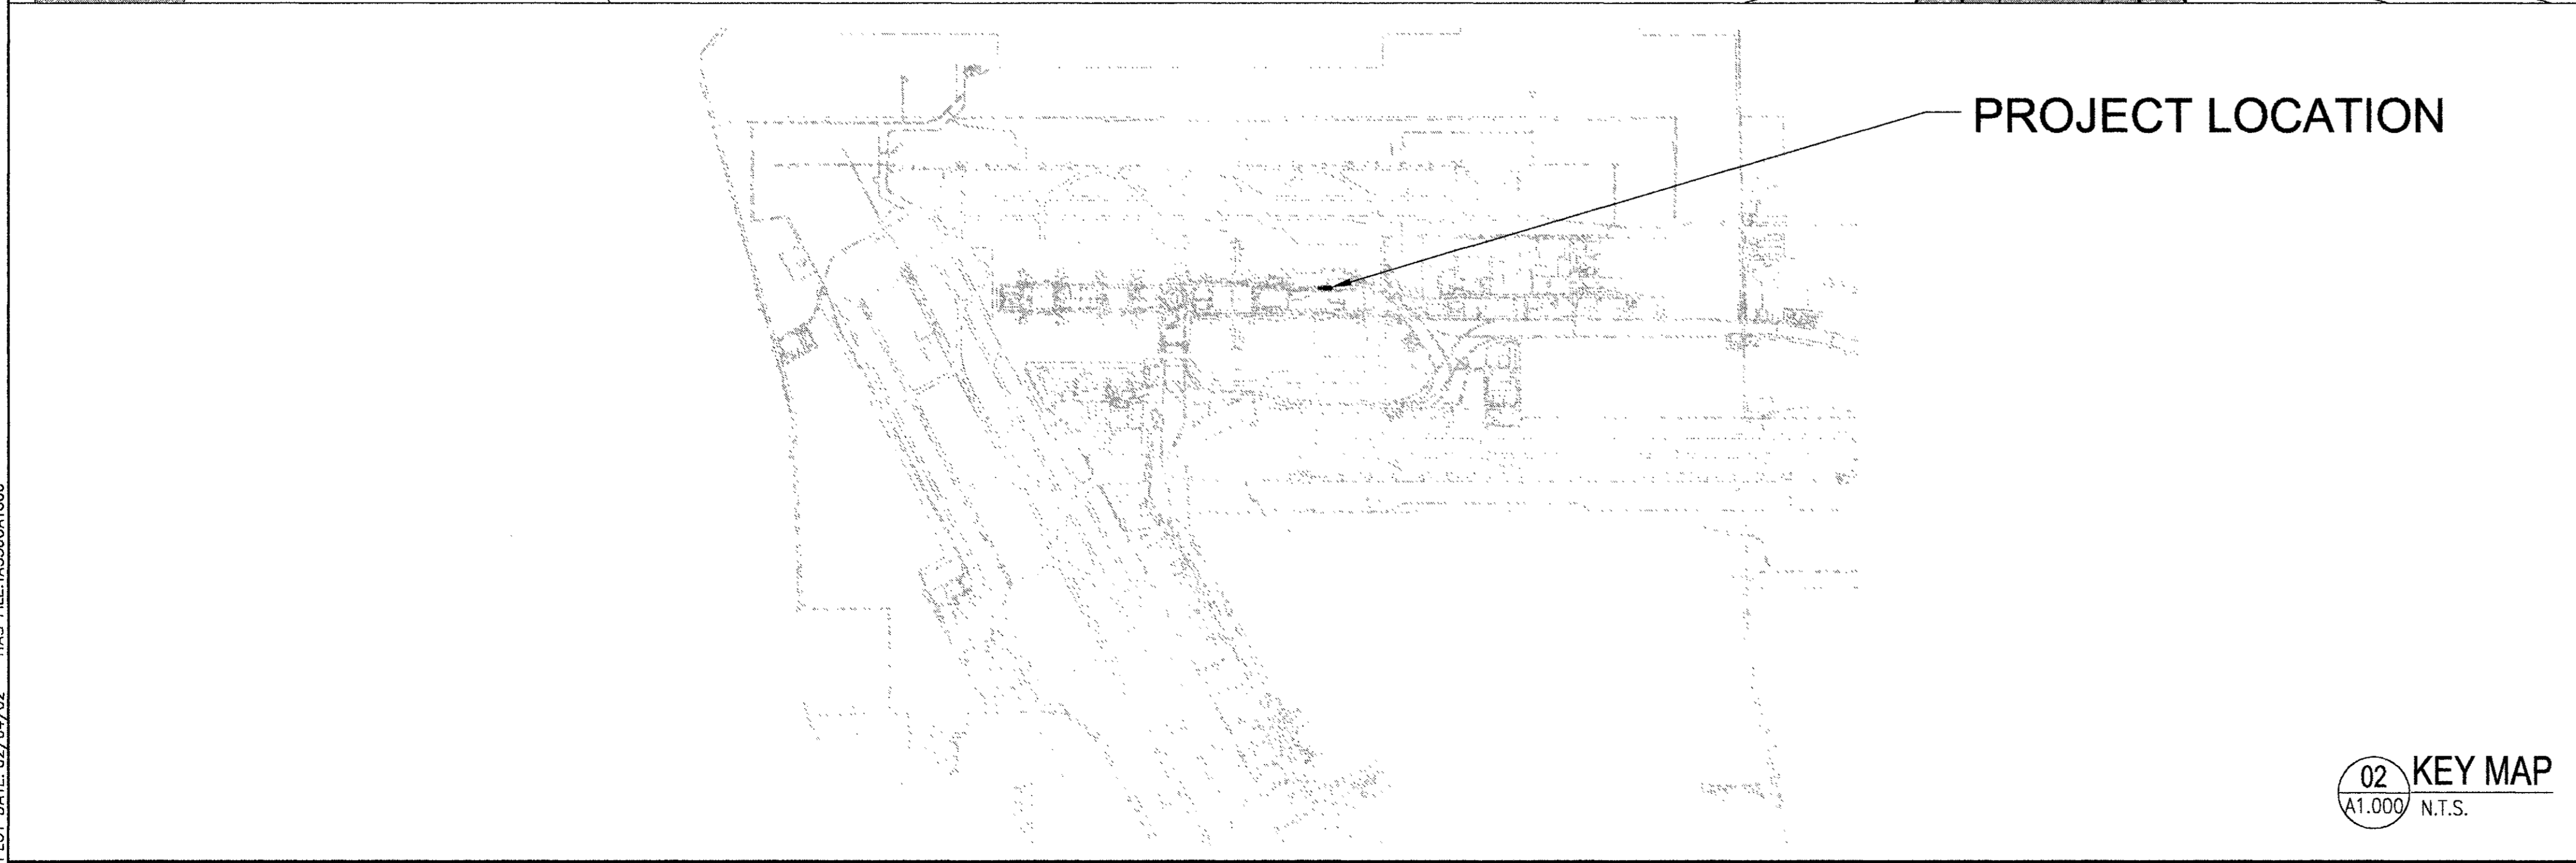

**GENERAL NOTES:**

- FOR CIVIL, ROADWAYS, AND TRAFFIC CONTROL PLANS REFER TO HAS PROJECT 536A-2.
- THE CONTRACTOR MUST COORDINATE THE CONSTRUCTION OF THE APM STATION & PLATFORM (HAS PROJECT 536C) WITH THE FOLLOWING PROJECTS:
  - APM GUIDEWAY EXTENSION (HAS 536A-1)
  - FIS, SECURE BRIDGE & STERILE BRIDGE (HAS 500F-1)
  - ROADWAYS (HAS PROJECT 536A-2)
  - SITE UTILITIES (HAS 536A-3)

**RECORD DRAWINGS**  
 DO NOT MODIFY  
 Rey de la Reza Architects, Inc.  
 13 May 2005

Note: Information used to develop these documents was taken from Record of the Work Drawings prepared by the construction contractor, Clark Construction Group - Texas. The information provided by the contractor was not verified by the design firm named above.

APPROVED BY: \_\_\_\_\_ DATE: \_\_\_\_\_

PROJECT NO. \_\_\_\_\_

C.I.P. NO. \_\_\_\_\_

H.A.S. NO. \_\_\_\_\_

SHEET NO. \_\_\_\_\_

SCALE: 1" = 60'

NOTE: REFER TO GRAPHIC SCALE IF ACTUAL SHEET SIZE IS OTHER THAN 30"x42".

0' 60' 120' 180'

PLOT DATE: 02/04/02 HAS FILE: A536CA1000

PROJECT MGR: \_\_\_\_\_

DESIGNER: \_\_\_\_\_

DRAWN BY: \_\_\_\_\_

CHECKED BY: \_\_\_\_\_

DRAWING STANDARD: \_\_\_\_\_

SCALE: \_\_\_\_\_

DATE: \_\_\_\_\_

REGISTERED ARCHITECT

APPROVED BY: \_\_\_\_\_ DATE: \_\_\_\_\_

DIRECTOR

HOUSTON AIRPORT SYSTEM

PROJECT NO. \_\_\_\_\_

C.I.P. NO. \_\_\_\_\_


H.A.S. NO. \_\_\_\_\_

SHEET NO. \_\_\_\_\_

**A1.000**



REVISIONS			
NO.	DESCRIPTION	DATE	BY
1	ISSUED FOR BID	10/19/01	
2	RECORD SET	05/13/05	EM

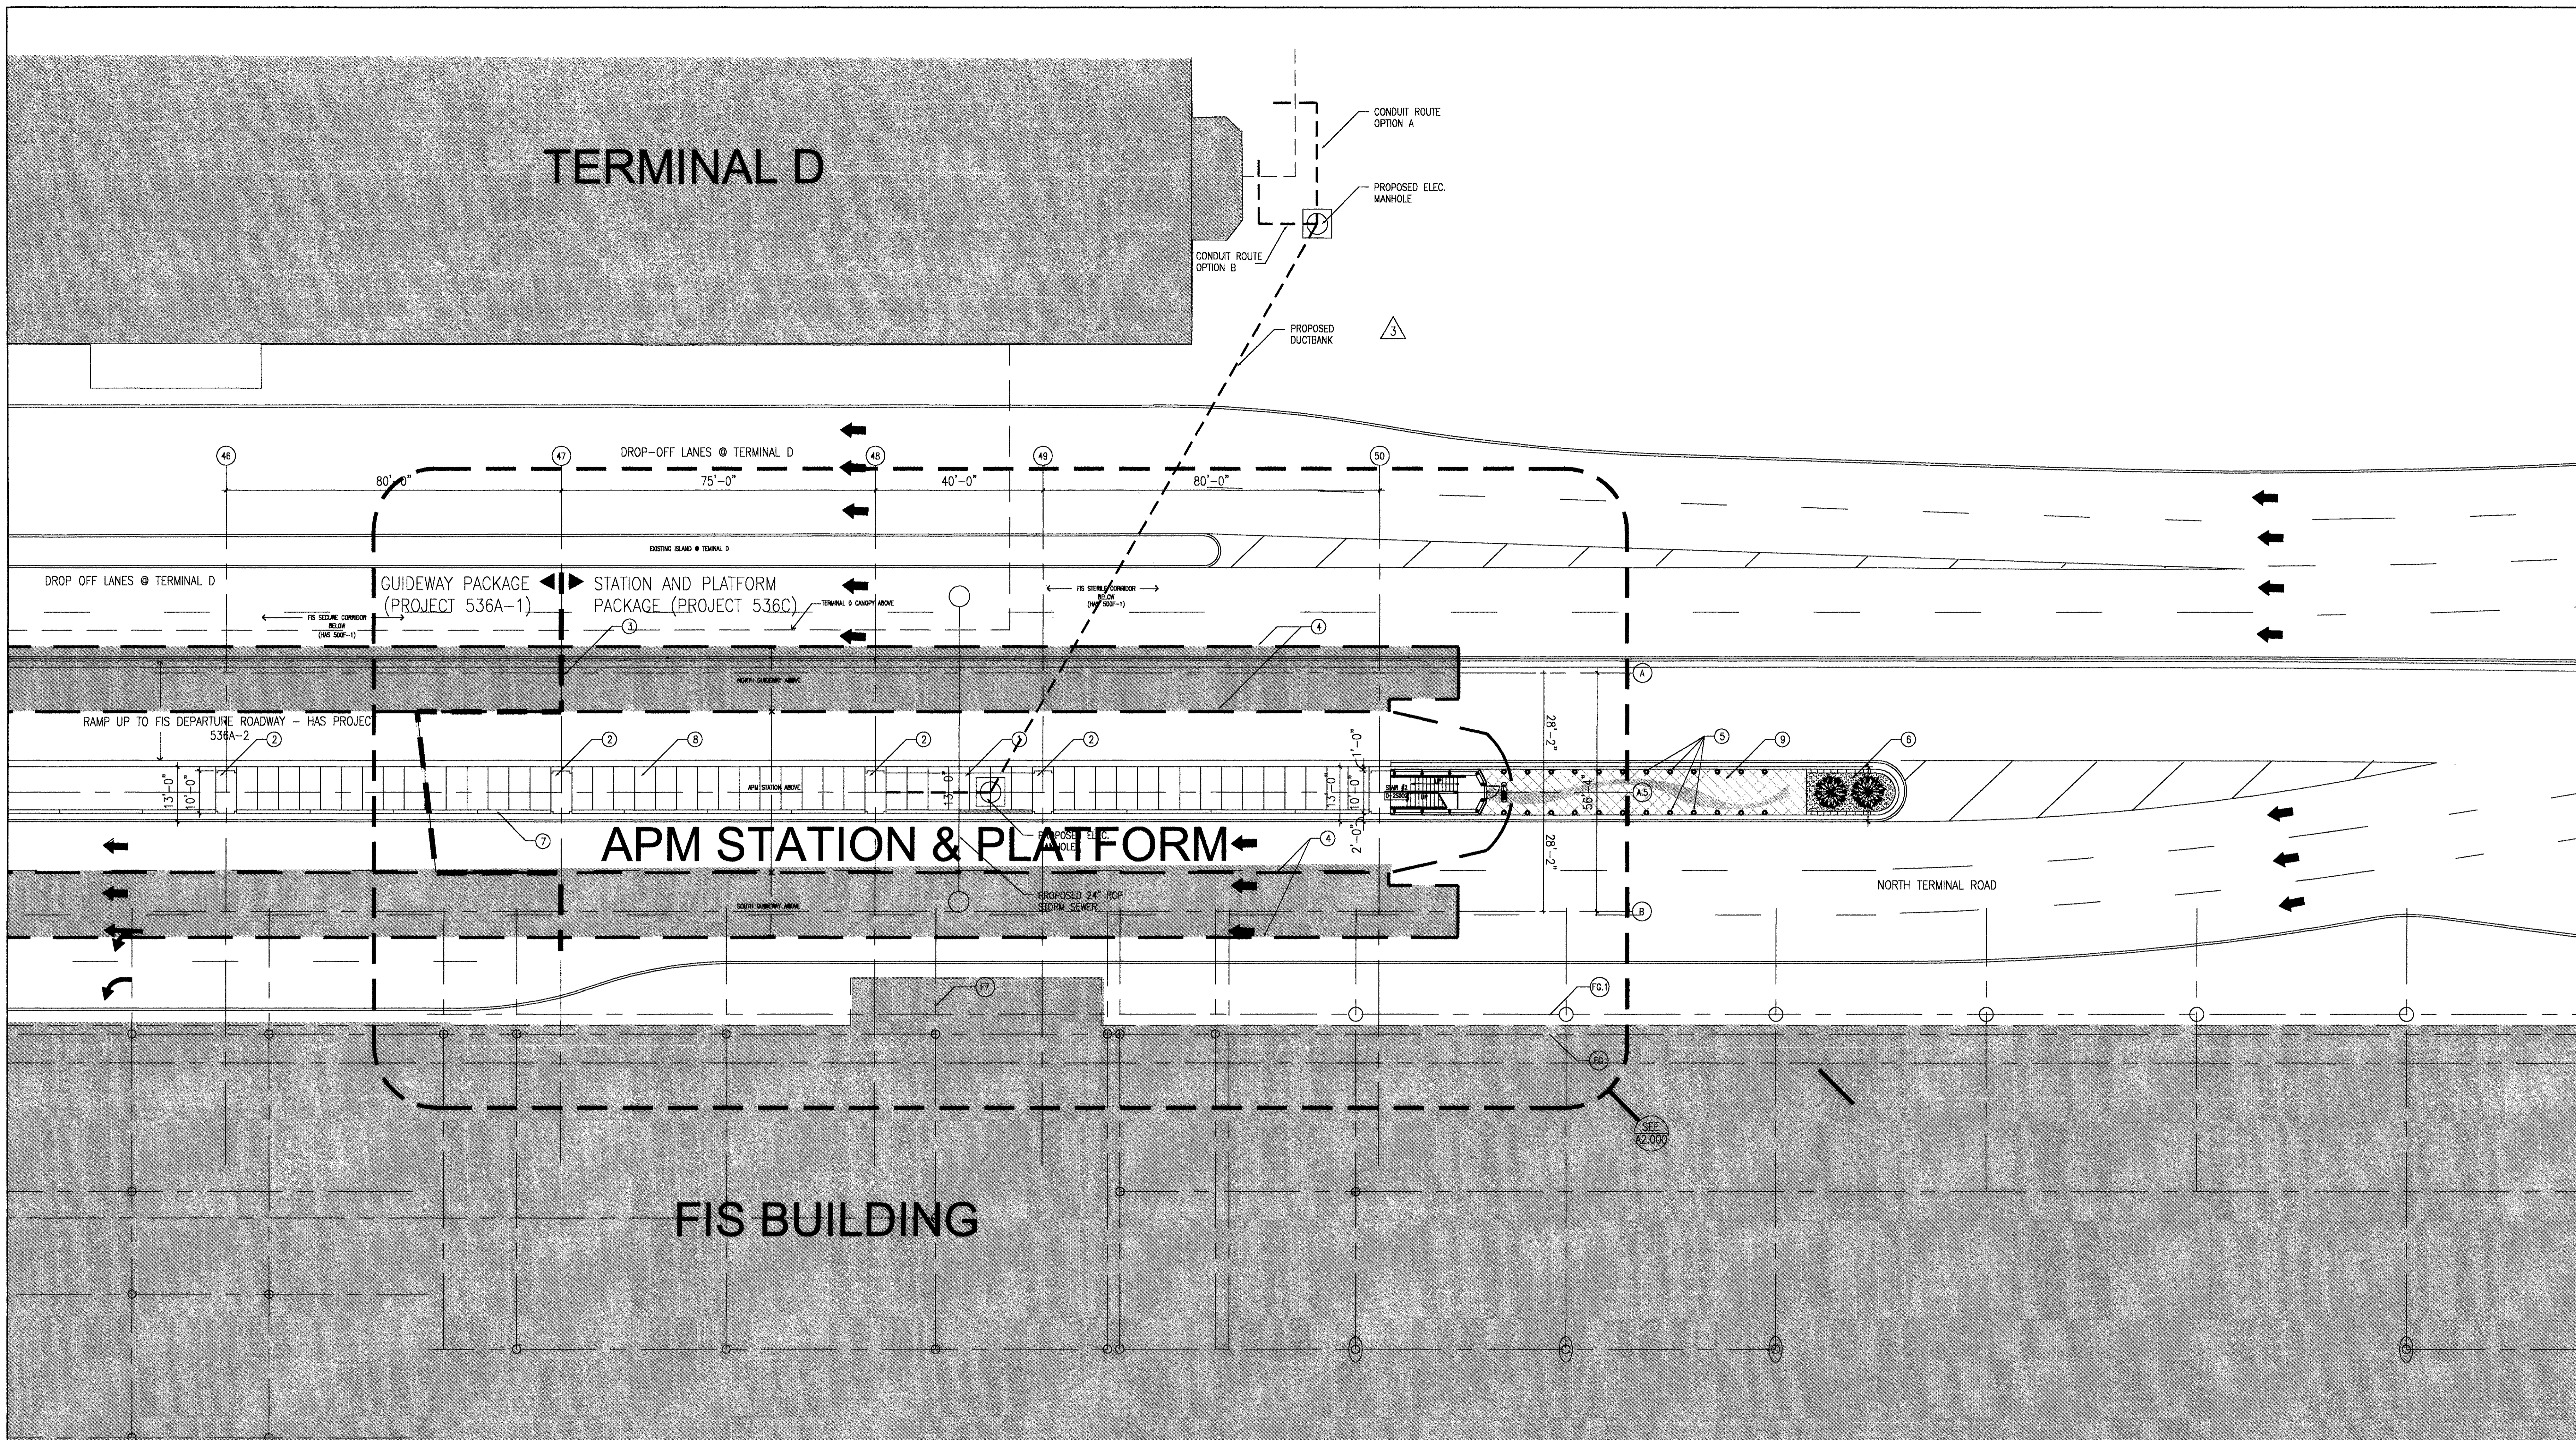

INTERNATIONAL • SERVICES • EXPANSION • PROGRAM

**APM STATION + PLATFORM**

APM STATION SITE PLAN

PROJECT MGR: HEM  
 DESIGNER: SG  
 DRAWN BY: SEM  
 CHECKED BY: AB  
 DRAWING STANDARD: ISEP 07.20.2000

SCALE: 1/16" = 1'-0"  
 DATE: 09/14/05

**REGISTERED ARCHITECT**  
 ROY DE LA REZA  
 STATE OF TEXAS

APPROVED BY: \_\_\_\_\_ DATE: \_\_\_\_\_

DIRECTOR  
 HOUSTON AIRPORT SYSTEM

PROJECT NO. 1140  
 C.I.P. NO. A-0354  
 H.A.S. NO. 536C  
 SHEET NO. 8

- KEYED NOTES:**
- 13'-0" ISLAND BY OTHERS N.I.C. (HAS PROJECT 536A-2)
  - C.I.P. CONCRETE COLUMN
  - PROJECT LIMIT BETWEEN APM GUIDEWAY PACKAGE (HAS PROJECT 536A-1) AND APM STATION AND PLATFORM (HAS 536C)
  - APM STATION @ PLATFORM ABOVE
  - BOLLARDS BY OTHERS N.I.C. (LANDSCAPING PROJECT)
  - PLANTER - PRECAST CONCRETE BY OTHERS N.I.C. (LANDSCAPING PROJECT)
  - 2'-3" HIGH PROTECTION WALL N.I.C. - CONCRETE (HAS PROJECT 536A-2)
  - CONCRETE PAVEMENT WITH CONTROL JOINT BY OTHERS N.I.C. (LANDSCAPING PROJECT)
  - PAVERS N.I.C. (LANDSCAPING PROJECT)

**GENERAL NOTES:**

**FOR CIVIL, ROADWAYS, AND TRAFFIC CONTROL PLANS REFER TO HAS PROJECT 536A-2.**

**RECORD DRAWINGS**  
 DO NOT MODIFY  
 Roy de la Reza Architects, Inc.  
 13 May 2005

Note: Information used to develop these documents was taken from Record of the Work Drawings prepared by the construction contractor, Clark Construction Group - Texas. The information provided by the contractor was not verified by the design firm named above.

APPROVED BY: \_\_\_\_\_ DATE: \_\_\_\_\_

DIRECTOR  
 HOUSTON AIRPORT SYSTEM

PROJECT NO. 1140  
 C.I.P. NO. A-0354  
 H.A.S. NO. 536C  
 SHEET NO. 8

NOTE: REFER TO GRAPHIC SCALE IF ACTUAL SHEET SIZE IS OTHER THAN 30"x42".

0' 8' 16' 32' 48'  
 SCALE: 1/16" = 1'-0"


PLOT DATE: 02/04/02 HAS FILE: A536CA1100







NO.	DESCRIPTION	DATE	BY
ISSUED FOR BD		10/19/01	
ADDENDUM 1		02/01/02	SG
RECORD SET		05/13/05	EM

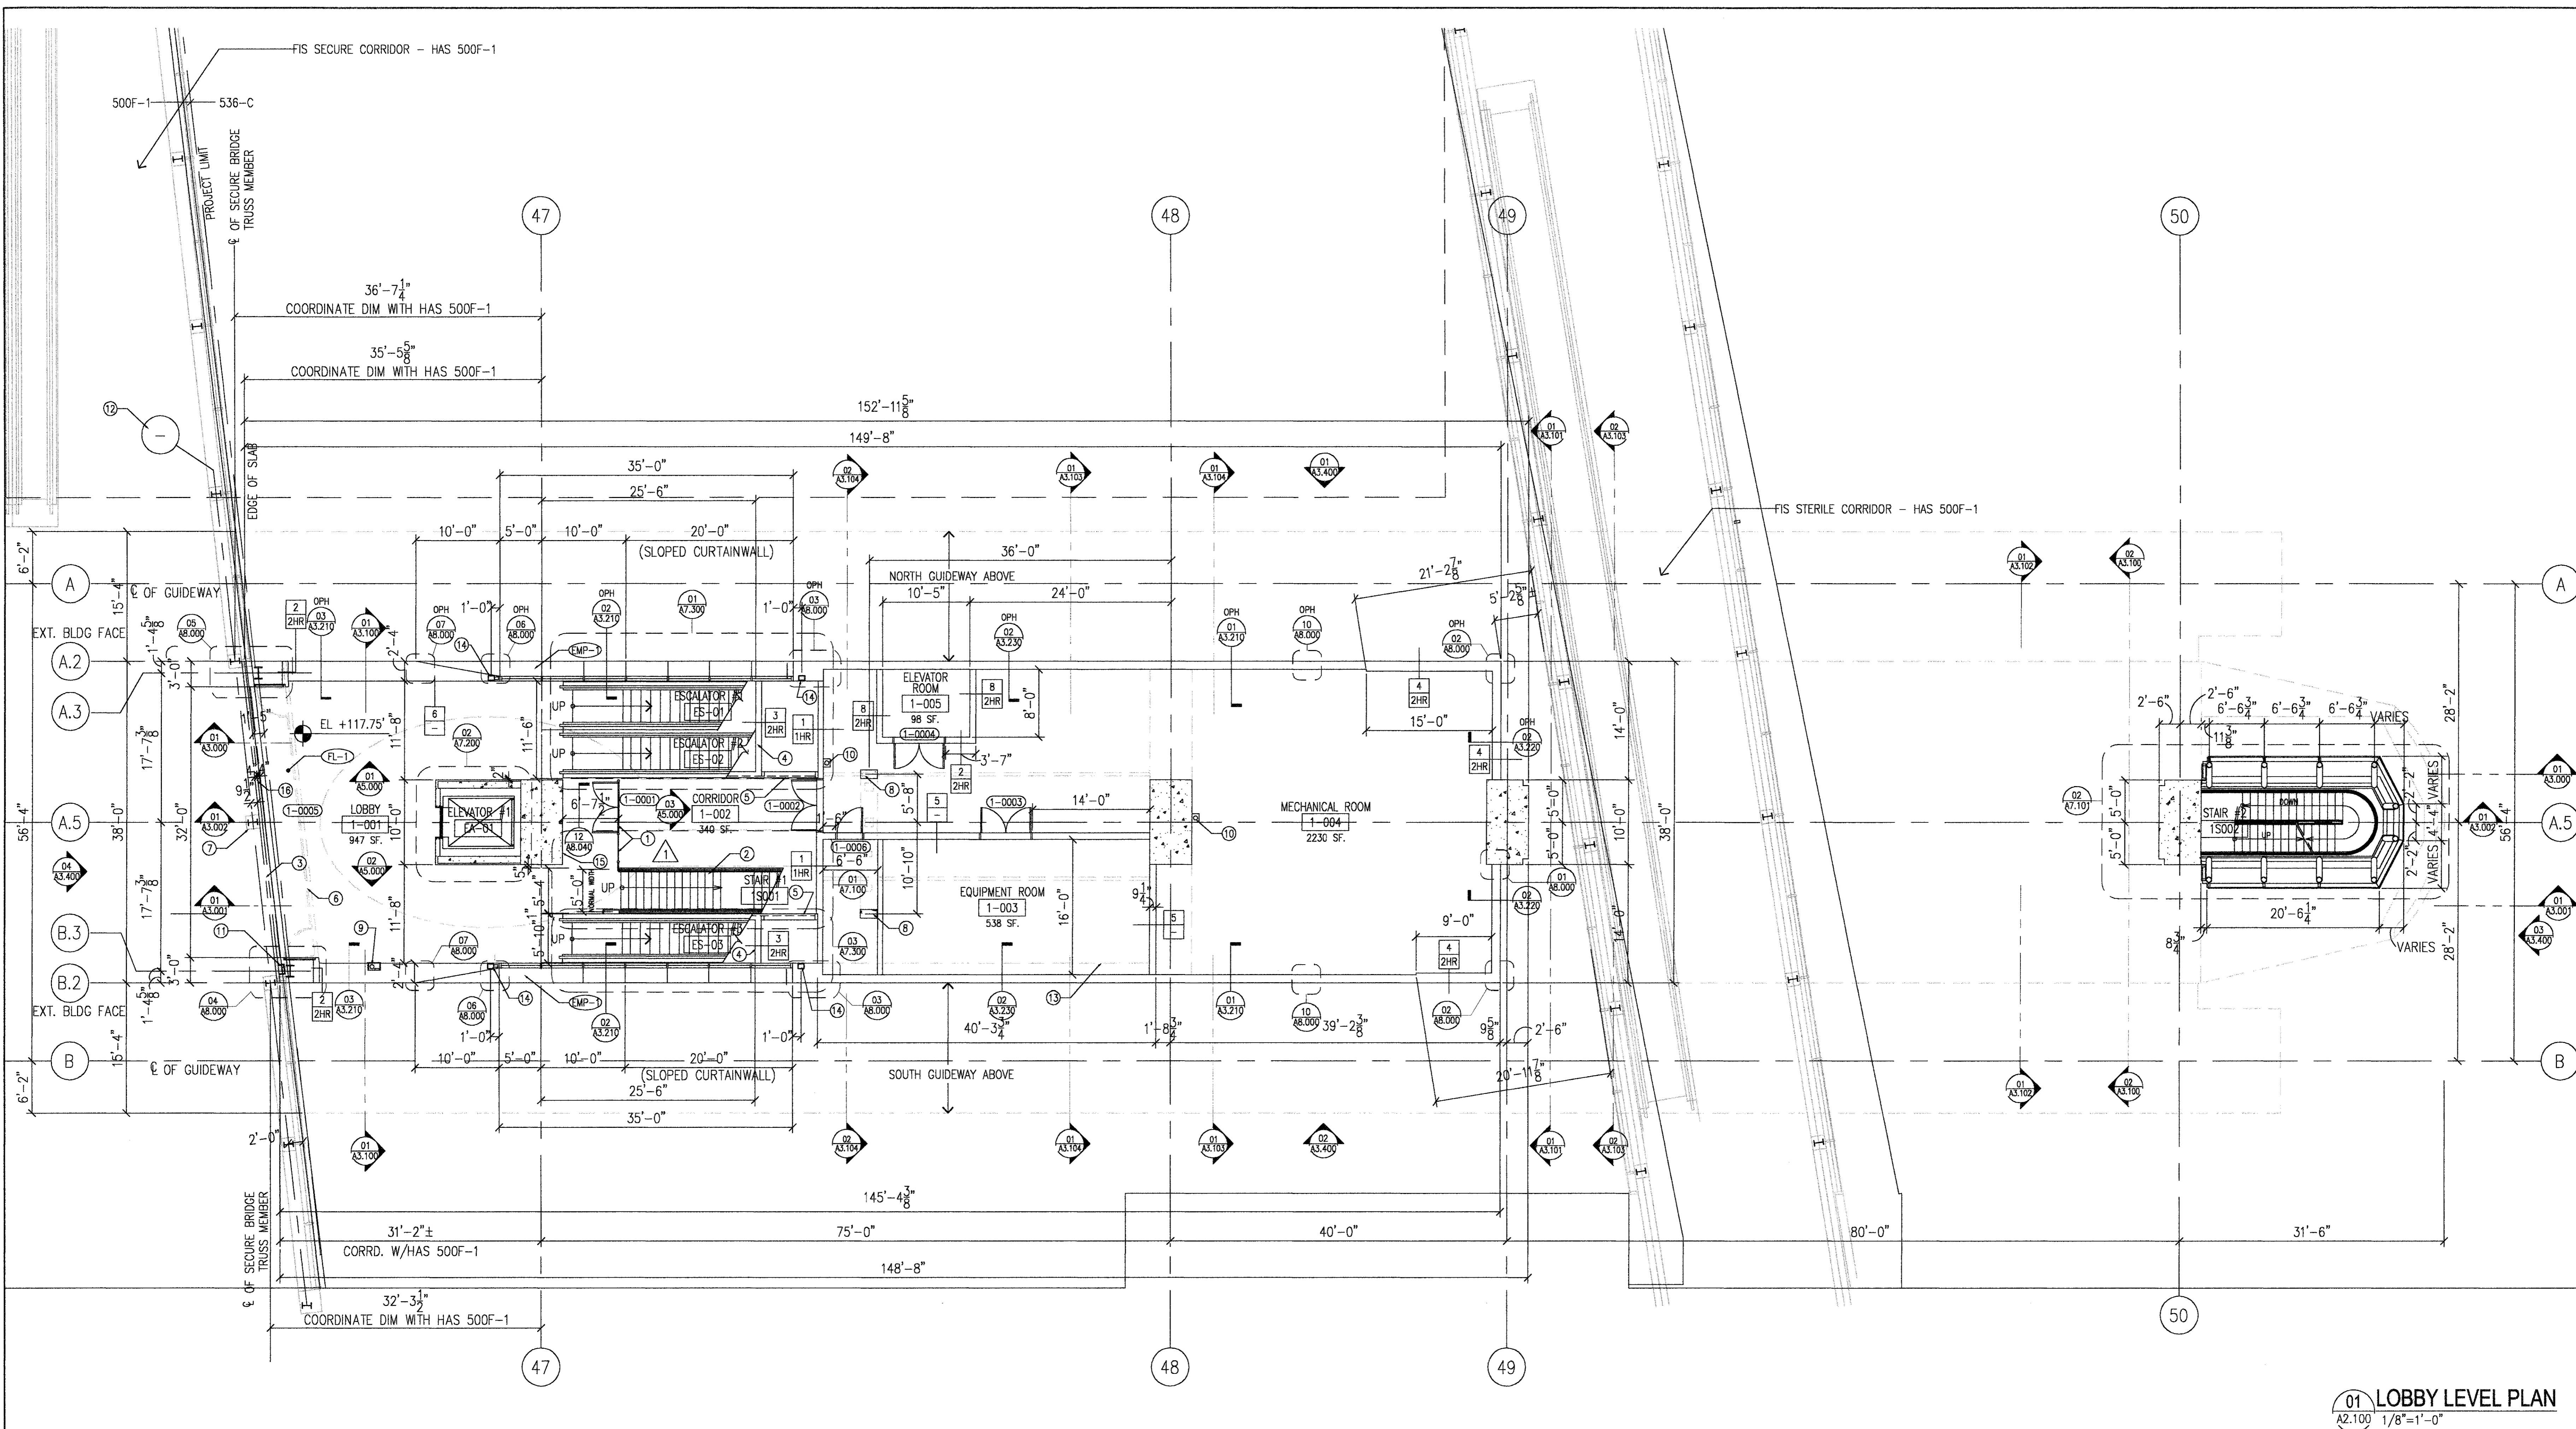


01 LOBBY LEVEL PLAN  
 A2.100 1/8"=1'-0"

KEYED NOTES

- ① GLASS GATE AND FIXED GLASS PANEL. FASTENED TO 2 1/2" DIA. STL. POLES WELDED TO EMBEDDED PLATES. 3/8" GLASS PANELS TEMPERED. RE DETAIL 12/48.040
- ② STEEL PAN STAIRS WITH TERRAZZO FILL TYPE F6-1
- ③ EXPANSION JOINT N.I.C. BY OTHERS (HAS 500F-1) - RE 500F-1 FOR DETAIL @ CONCRETE SLAB
- ④ EDGE OF ESCALATOR PIT
- ⑤ POWDERCOATED ALUMINUM LOUVERS UNDER ESCALATORS
- ⑥ HORIZONTAL EXIT 2HR FIRE RATED ROLLING DOOR WITH SWINGING EGRESS DOOR TYPE SAFESCAPE 12500 FIRE DOORS FROM MCKEON
- ⑦ CLADDING AROUND BRIDGE COLUMN BY PROJECT 500F-1 - N.I.C.
- ⑧ CONCRETE COLUMN 12"x24" RE: STRUCTURAL
- ⑨ FIRE EXTINGUISHER CABINET
- ⑩ FIRE EXTINGUISHER - WALL MOUNTED BRACKET
- ⑪ FIRE VALVE CABINET
- ⑫ SECURE BRIDGE COLUMN GRID LINE (REFER HAS PROJECT 500F-1) - TO BE COORDINATED WITH 500F
- ⑬ CHASE ABOVE - AROUND PIPES CROSSING EQUIPMENT ROOM
- ⑭ 9"x7"x1/2" STEEL COLUMNS SUPPORT OF FRAME FOR CW2-A AND CW2-B CURTAIN WALLS - SECURE TO CONCRETE FLOOR AND CONCRETE BEAM ABOVE. RE: STRUCTURAL  
THE EMBEDDED LENGTH FOR (6) #4 DIA. A325 THREADED RODS IS 10" GRIND SMOOTH CONTACT SURFACE OF PLATE AND CONCRETE BEAM.
- ⑮ CONCRETE COLUMN IN LOBBY - PAINT
- ⑯ EDGE OF APM STATION CONCRETE SLAB


GENERAL NOTES:

- OVERALL DIMENSIONS @ SECURE BRIDGE TO BE COORDINATED WITH HAS PROJECT 500F-1 - AND FIELD VERIFIED
- (FL-1) TERRAZZO FLOOR
- (EMP-1) EXTERIOR POWDERCOATED METAL WALL PANEL - ALUMINUM PANEL 1/8" THICK - TYPE SERIES 3000 MODIFIED FROM UNH-CLAD - COPPER SALES OR EQUAL. POWDERCOATED FINISH - KYNAR 500

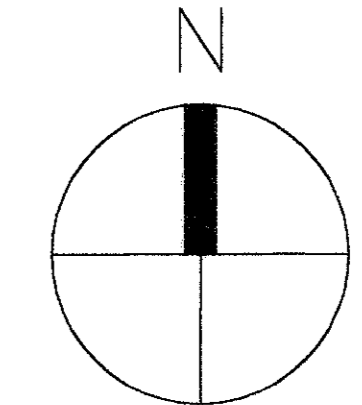


**RECORD DRAWINGS**  
 DO NOT MODIFY  
 Rey de la Reza Architects, Inc.  
 13 May 2005

Note: Information used to develop these documents was taken from Record of the Work Drawings prepared by the construction contractor, Clark Construction Group - Texas. The information provided by the contractor was not verified by the design firm named above.

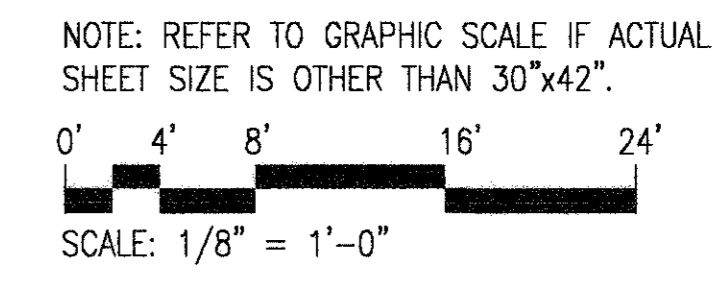

INTERNATIONAL SERVICES • EXPANSION PROGRAM  
**APM STATION + PLATFORM**  
 LOBBY LEVEL PLAN

PROJECT MGR: HEM  
 DESIGNER: SG  
 DRAWN BY: SEM  
 CHECKED BY: AS  
 DRAWING STANDARD: ISEP 07.20.2000  
 SCALE: 1/8"=1'-0"  
 DATE: 09/14/01

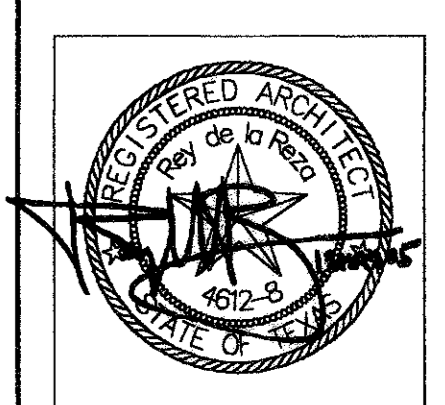


APPROVED BY: \_\_\_\_\_ DATE: \_\_\_\_\_  
 DIRECTOR  
 HOUSTON AIRPORT SYSTEM

PROJECT NO. 1140  
 C.I.P. NO. A-0354  
 H.A.S. NO. 536C  
 SHEET NO. \_\_\_\_\_




NO.	DESCRIPTION	DATE	BY
	ISSUED FOR BID	10/19/01	
▲	ADDENDUM 1	02/01/02	SG
▲	RECORD SET	05/13/05	EM

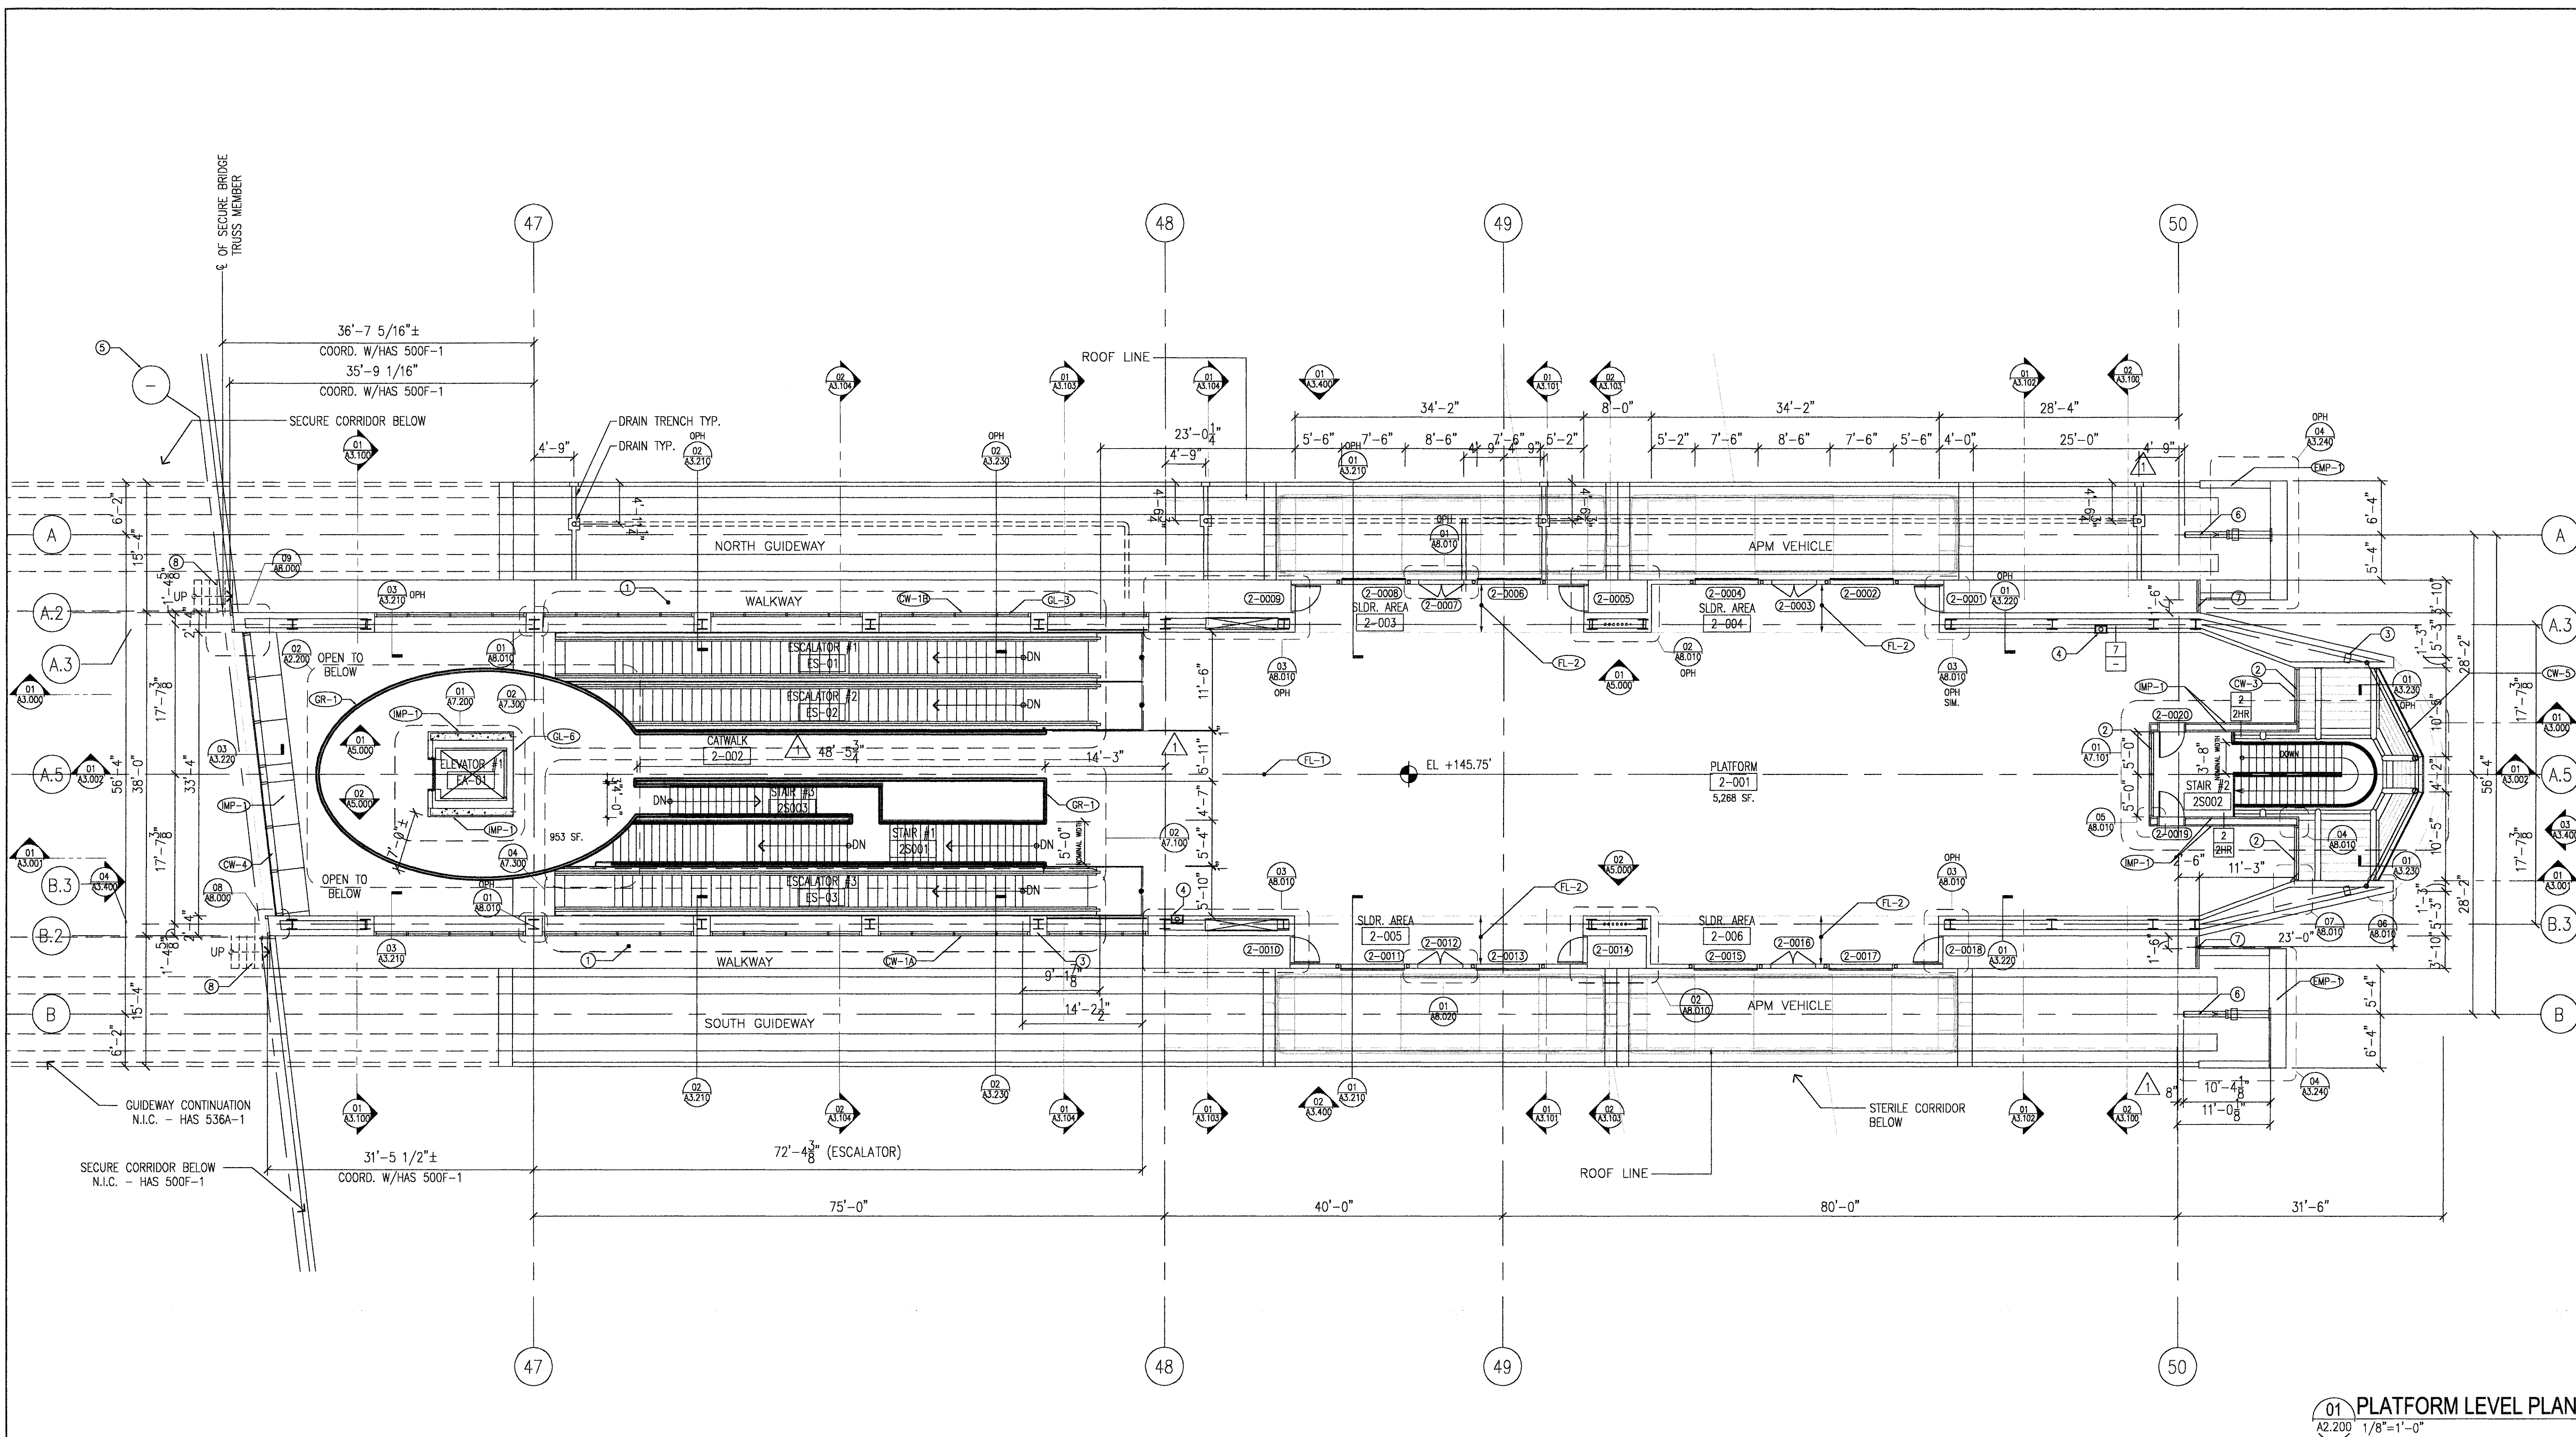

INTERNATIONAL SERVICES • EXPANSION • PROGRAM  
**APM STATION + PLATFORM**  
 PLATFORM LEVEL PLAN

01 PLATFORM LEVEL PLAN  
 A2.200 1/8"=1'-0"

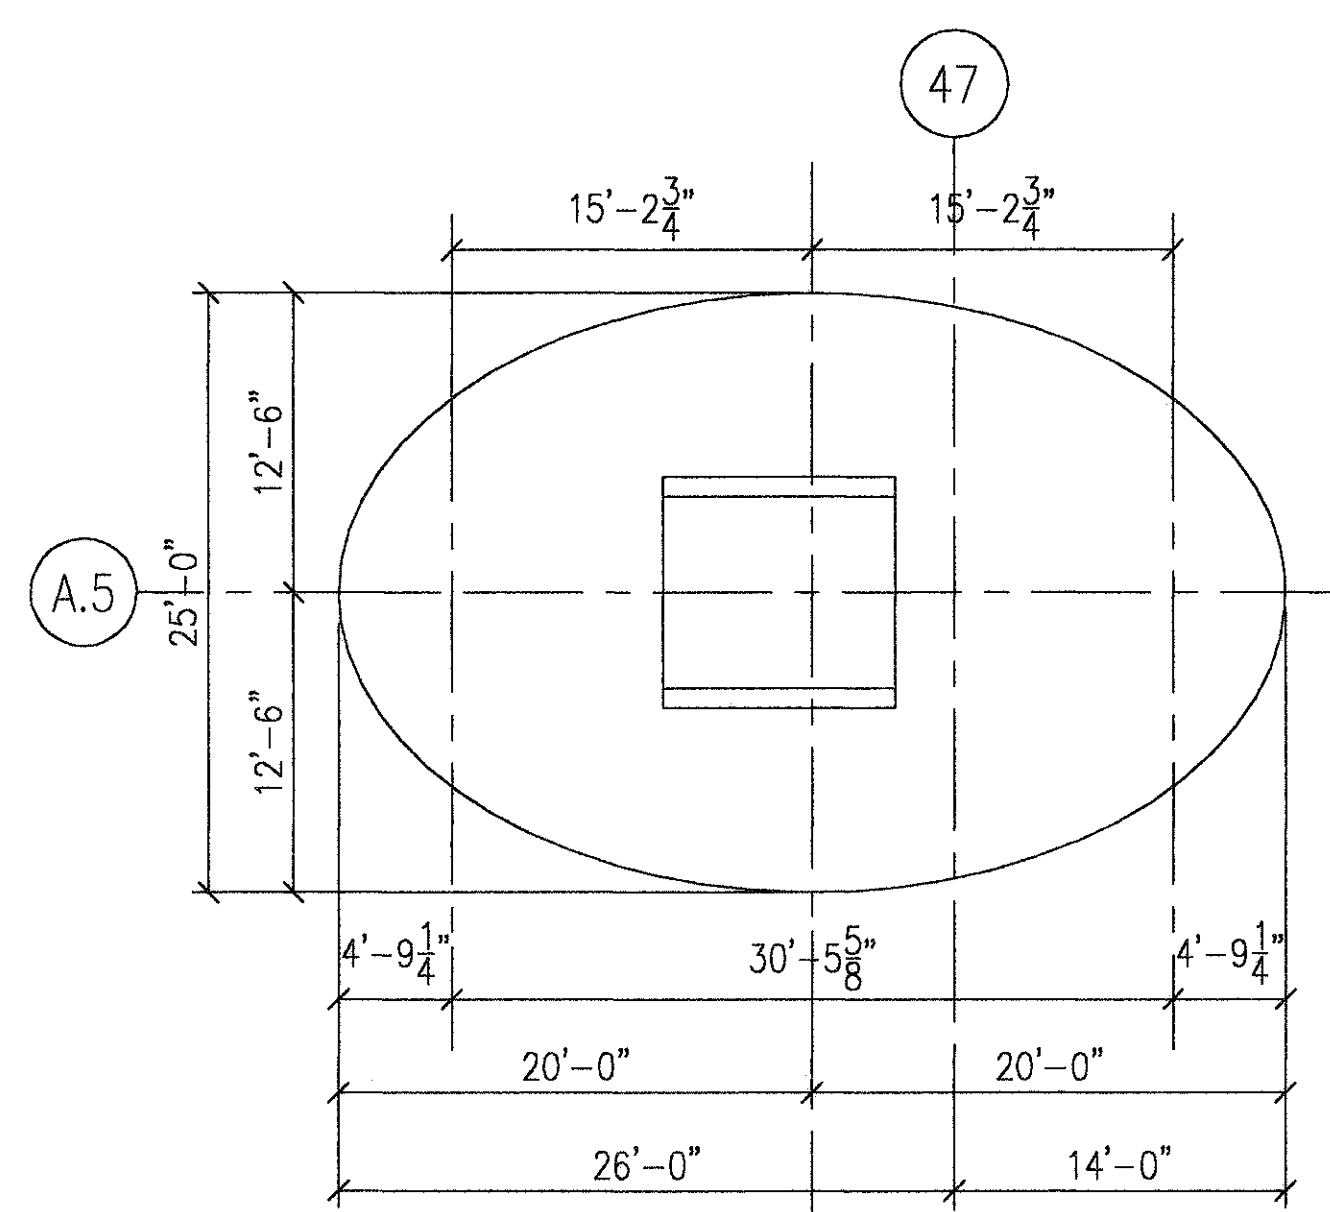

DIMENSIONS SHOWN ARE TO FINISH FACE OF WALL. FACE OF STRUCTURE IS GIVEN DIMENSION LESS 2 1/2"


02 ELLIPSE GEOMETRY  
 A2.200 1/8"=1'-0"

**KEYED NOTES**

- ① CONCRETE WALKWAY
- ② SPRINKLERS ON BOTH SIDES OF THE CURTAIN WALL ALLOWING A 2HR FIRE RATING - FOR SPRINKLERS REFER TO PLUMBING
- ③ STEEL COLUMN WITH 3HR FIREPROOFING - RE STRUCTURAL - UL ASSEMBLY HX723
- ④ FIRE EXTINGUISHER CABINET
- ⑤ SECURE BRIDGE TRUSS GRID LINE (REFER HAS PROJECT 500F)
- ⑥ RETROFIT BUFFER BY HAS 536D - N.I.C.
- ⑦ STEEL GUARDRAIL - PAINT - SAME CONSTRUCTION AS GUARDRAIL @ STAIR #2
- ⑧ STEEL STAIR N.I.C. HAS PROJECT 536A-1 TO BE COORDINATED WITH HAS 536A-1


**GENERAL NOTES:**

- OVERALL DIMENSIONS @ SECURE BRIDGE TO BE COORDINATED WITH HAS PROJECT 500F - AND FIELD VERIFIED
- CW-1A CURTAIN WALL SYSTEM TYPE 1A
- GL-3 1 1/4" INSULATED GLAZING UNIT WITH FRIT.
- GL-6 LAMINATED GLASS - RE SHEET A7.200
- GR-1 GLASS GUARDRAIL
- FL-1 TERRAZZO FLOOR - TYPE 1
- FL-2 TERRAZZO FLOOR - TYPE 2
- MP-1 INTERIOR STAINLESS STEEL WALL PANELS
- EMP-1 EXTERIOR POWDERCOATED METAL WALL PANEL
- CW-3 CURTAIN WALL SYSTEM TYPE 3
- CW-4 CURTAIN WALL SYSTEM TYPE 4
- CW-5 CURTAIN WALL SYSTEM TYPE 5
- CW-1B CURTAIN WALL SYSTEM TYPE 1B

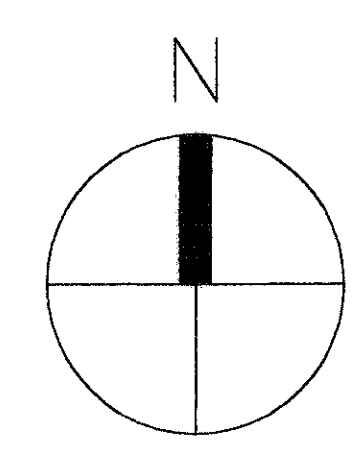


**RECORD DRAWINGS**  
 DO NOT MODIFY  
 Rey de la Reza Architects, Inc.  
 13 May 2005

Note: Information used to develop these documents was taken from Record of the Work Drawings prepared by the construction contractor, Clark Construction Group - Texas. The information provided by the contractor was not verified by the design firm named above.

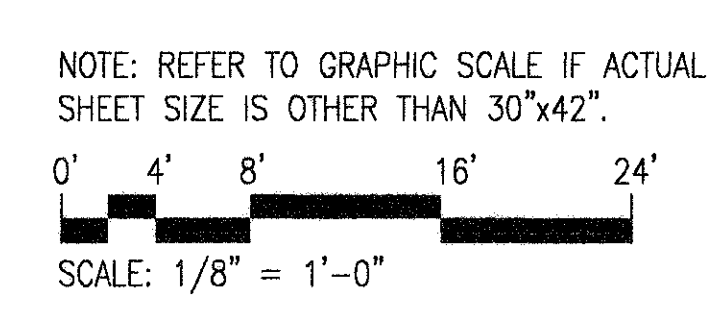


PROJECT MGR:	HEM
DESIGNER:	SG
DRAWN BY:	SEM
CHECKED BY:	AB
DRAWING STANDARD:	ISBP 07.20.2000
SCALE:	1/8"=1'-0"
DATE:	09/14/01

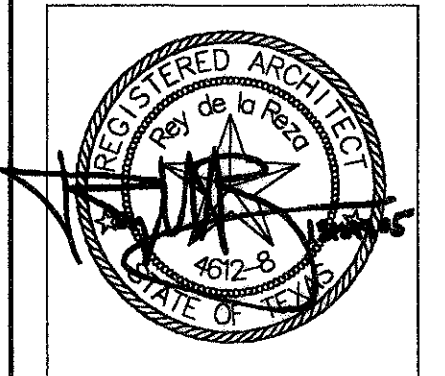

APPROVED BY:	DATE:
DIRECTOR	HOUSTON AIRPORT SYSTEM
PROJECT NO.	1140
C.I.P. NO.	A-0354
H.A.S. NO.	536C
SHEET NO.	A2.200




REVISIONS			
NO.	DESCRIPTION	DATE	BY
ISSUED FOR BID	10/18/01		
RECORD SET	05/13/05	EM	

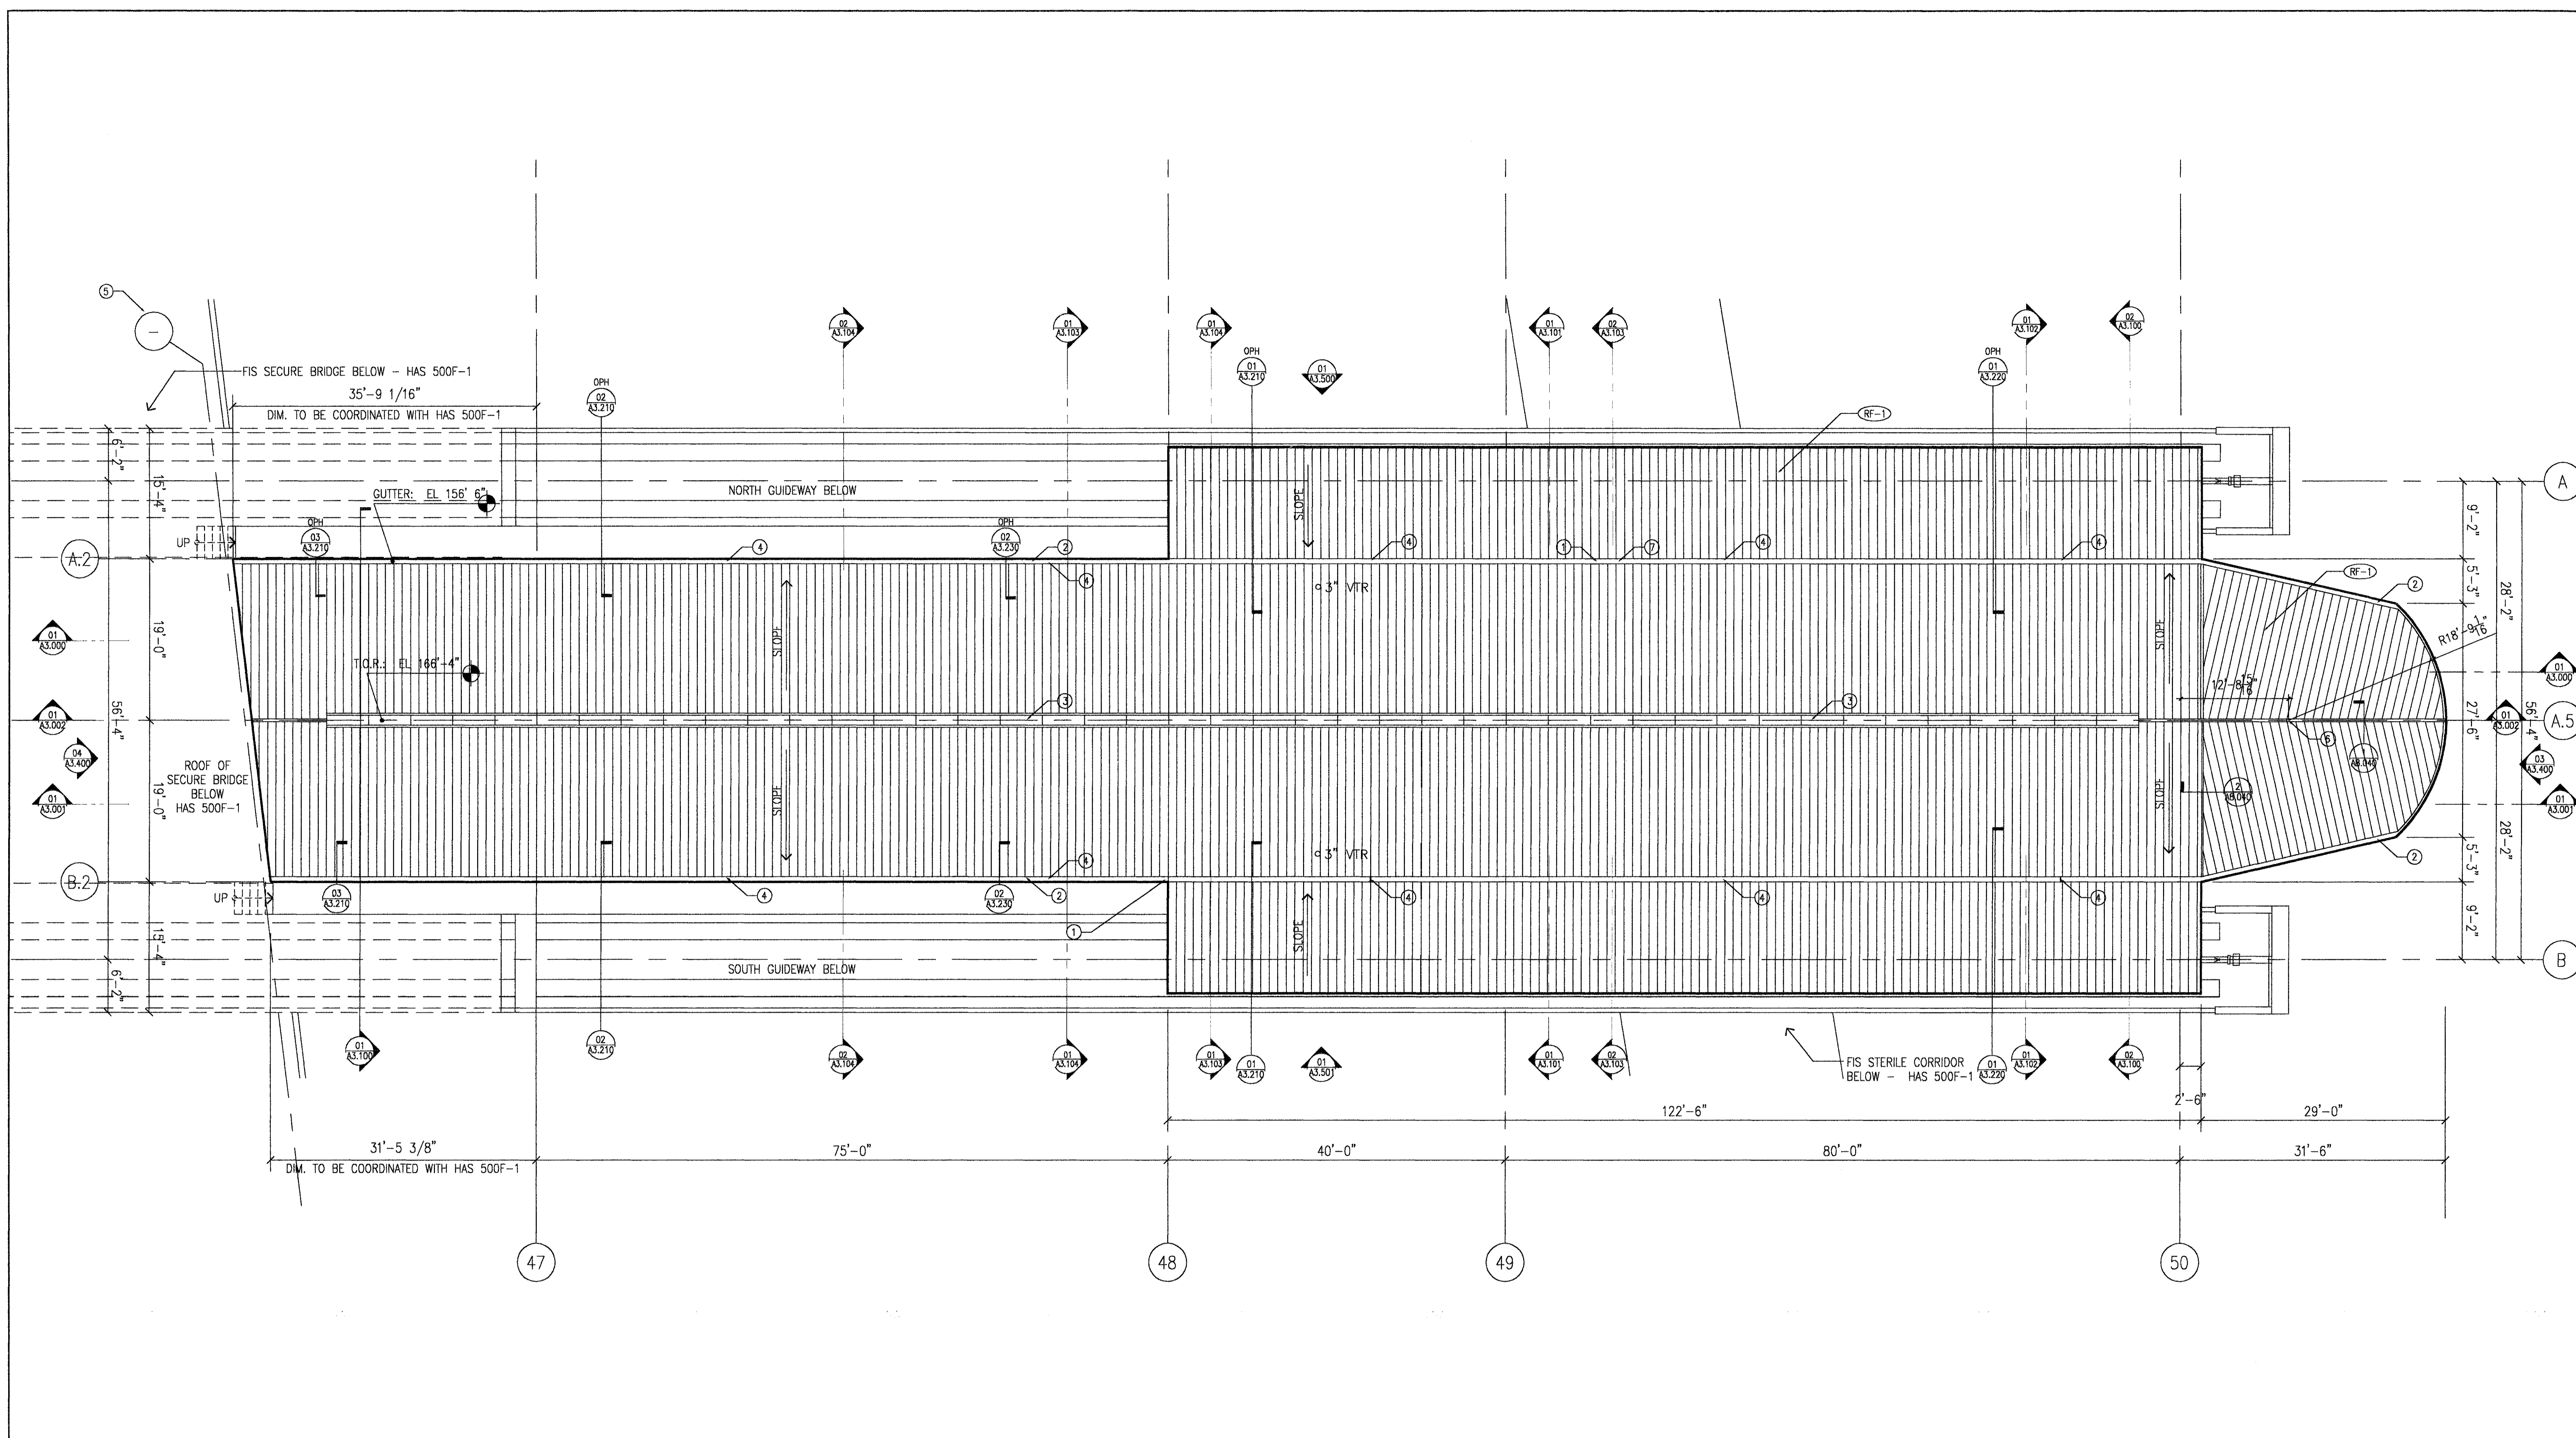

INTERNATIONAL SERVICES • EXPANSION • PROGRAM  
**APM STATION + PLATFORM**  
 ROOF PLAN

PROJECT MGR:	HEM
DESIGNER:	SG
DRAWN BY:	SEM
CHECKED BY:	AB
DRAWING STANDARD:	ISEP 07.20.2000
SCALE:	1/8"=1'-0"
DATE:	09/14/01

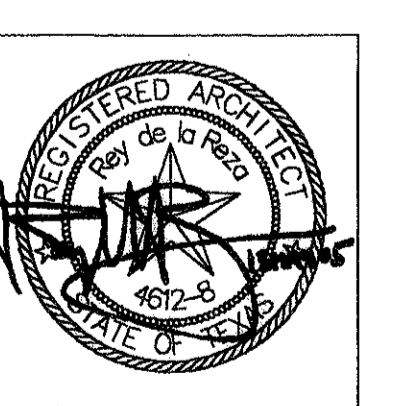


APPROVED BY:	DATE:
DIRECTOR	HOUSTON AIRPORT SYSTEM
PROJECT NO.	1140
C.I.P. NO.	A-0354
H.A.S. NO.	5362
SHEET NO.	

**KEYED NOTES:**

- ① DOWNSPOUT - FOR LOCATION REFER TO PLUMBING
- ② STAINLESS STEEL GUTTER - 16GA - RE SHEET AB.020
- ③ SKYLIGHT: DOUBLE GLAZED LOW RISE VAULT WITH CIRCULAR END GLAZING - RE SHEET A2.880
- ④ EXPANSION JOINT IN STAINLESS STEEL GUTTER - RE SHEET 4/AB.020
- ⑤ SECURE BRIDGE COLUMN GRID LINE (REFER HAS PROJECT SOOF - EXACT LOCATION TO BE COORDINATED WITH HAS SOOF)
- ⑥ CENTER POINT OF CURVE @ EDGE OF ROOF
- ⑦ OVERFLOW DRAIN - RE. PLUMBING

**GENERAL NOTES:**

- OVERALL DIMENSIONS @ SECURE BRIDGE TO BE COORDINATED WITH HAS PROJECT SOOF - AND FIELD VERIFIED
- RF-1 STANDING SEAM METAL ROOF - TYPE UC3 FROM LINA - CLAD - COPPER SALES OR EQUAL - HIGH PERFORMANCE COATING KYMAR 500 - COLOR SILVER METALLIC

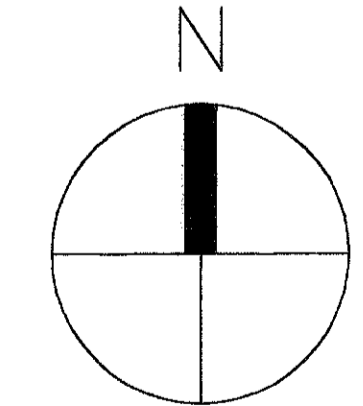

**RECORD DRAWINGS**  
 DO NOT MODIFY  
 Rey de la Reza Architects, Inc.  
 13 May 2005

Note: Information used to develop these documents was taken from Record of the Work Drawings prepared by the construction contractor, Clark Construction Group - Texas. The information provided by the contractor was not verified by the design firm named above.

NOTE: REFER TO GRAPHIC SCALE IF ACTUAL SHEET SIZE IS OTHER THAN 30"x42".

SCALE: 1/8" = 1'-0"



GENERAL NOTES:


NO.	DESCRIPTION	DATE	BY
ISSUED FOR BID		10/19/01	
ADDENDUM 1		02/01/02	SG
RECORD SET		06/13/05	EM

INTERNATIONAL SERVICES • EXPANSION • PROGRAM

APM STATION + PLATFORM

PARTITION TYPES

PROJECT MGR:	HEM
DESIGNER:	SG
DRAWN BY:	SEM
CHECKED BY:	AB
DRAWING STANDARD:	ISP 07.20.2000
SCALE:	AS NOTED
DATE:	09/14/01

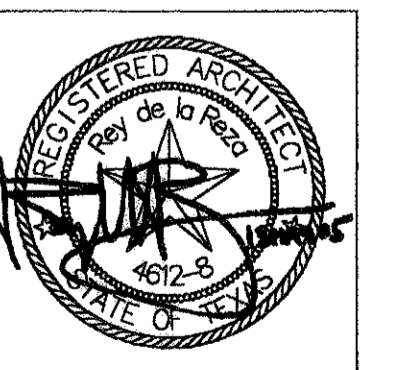

APPROVED BY: DATE:

DIRECTOR HOUSTON AIRPORT SYSTEM


PROJECT NO. 1140

C.I.P. NO. A-0354

H.A.S. NO. 536C


SHEET NO.

**RECORD DRAWINGS**  
 DO NOT MODIFY  
 Rey de la Reza Architects, Inc.  
 13 May 2005  
 Note: Information used to develop these documents was taken from Record of the Work Drawings prepared by the construction contractor, Clark Construction Group - Texas  
 The information provided by the contractor was not verified by the design firm named above.

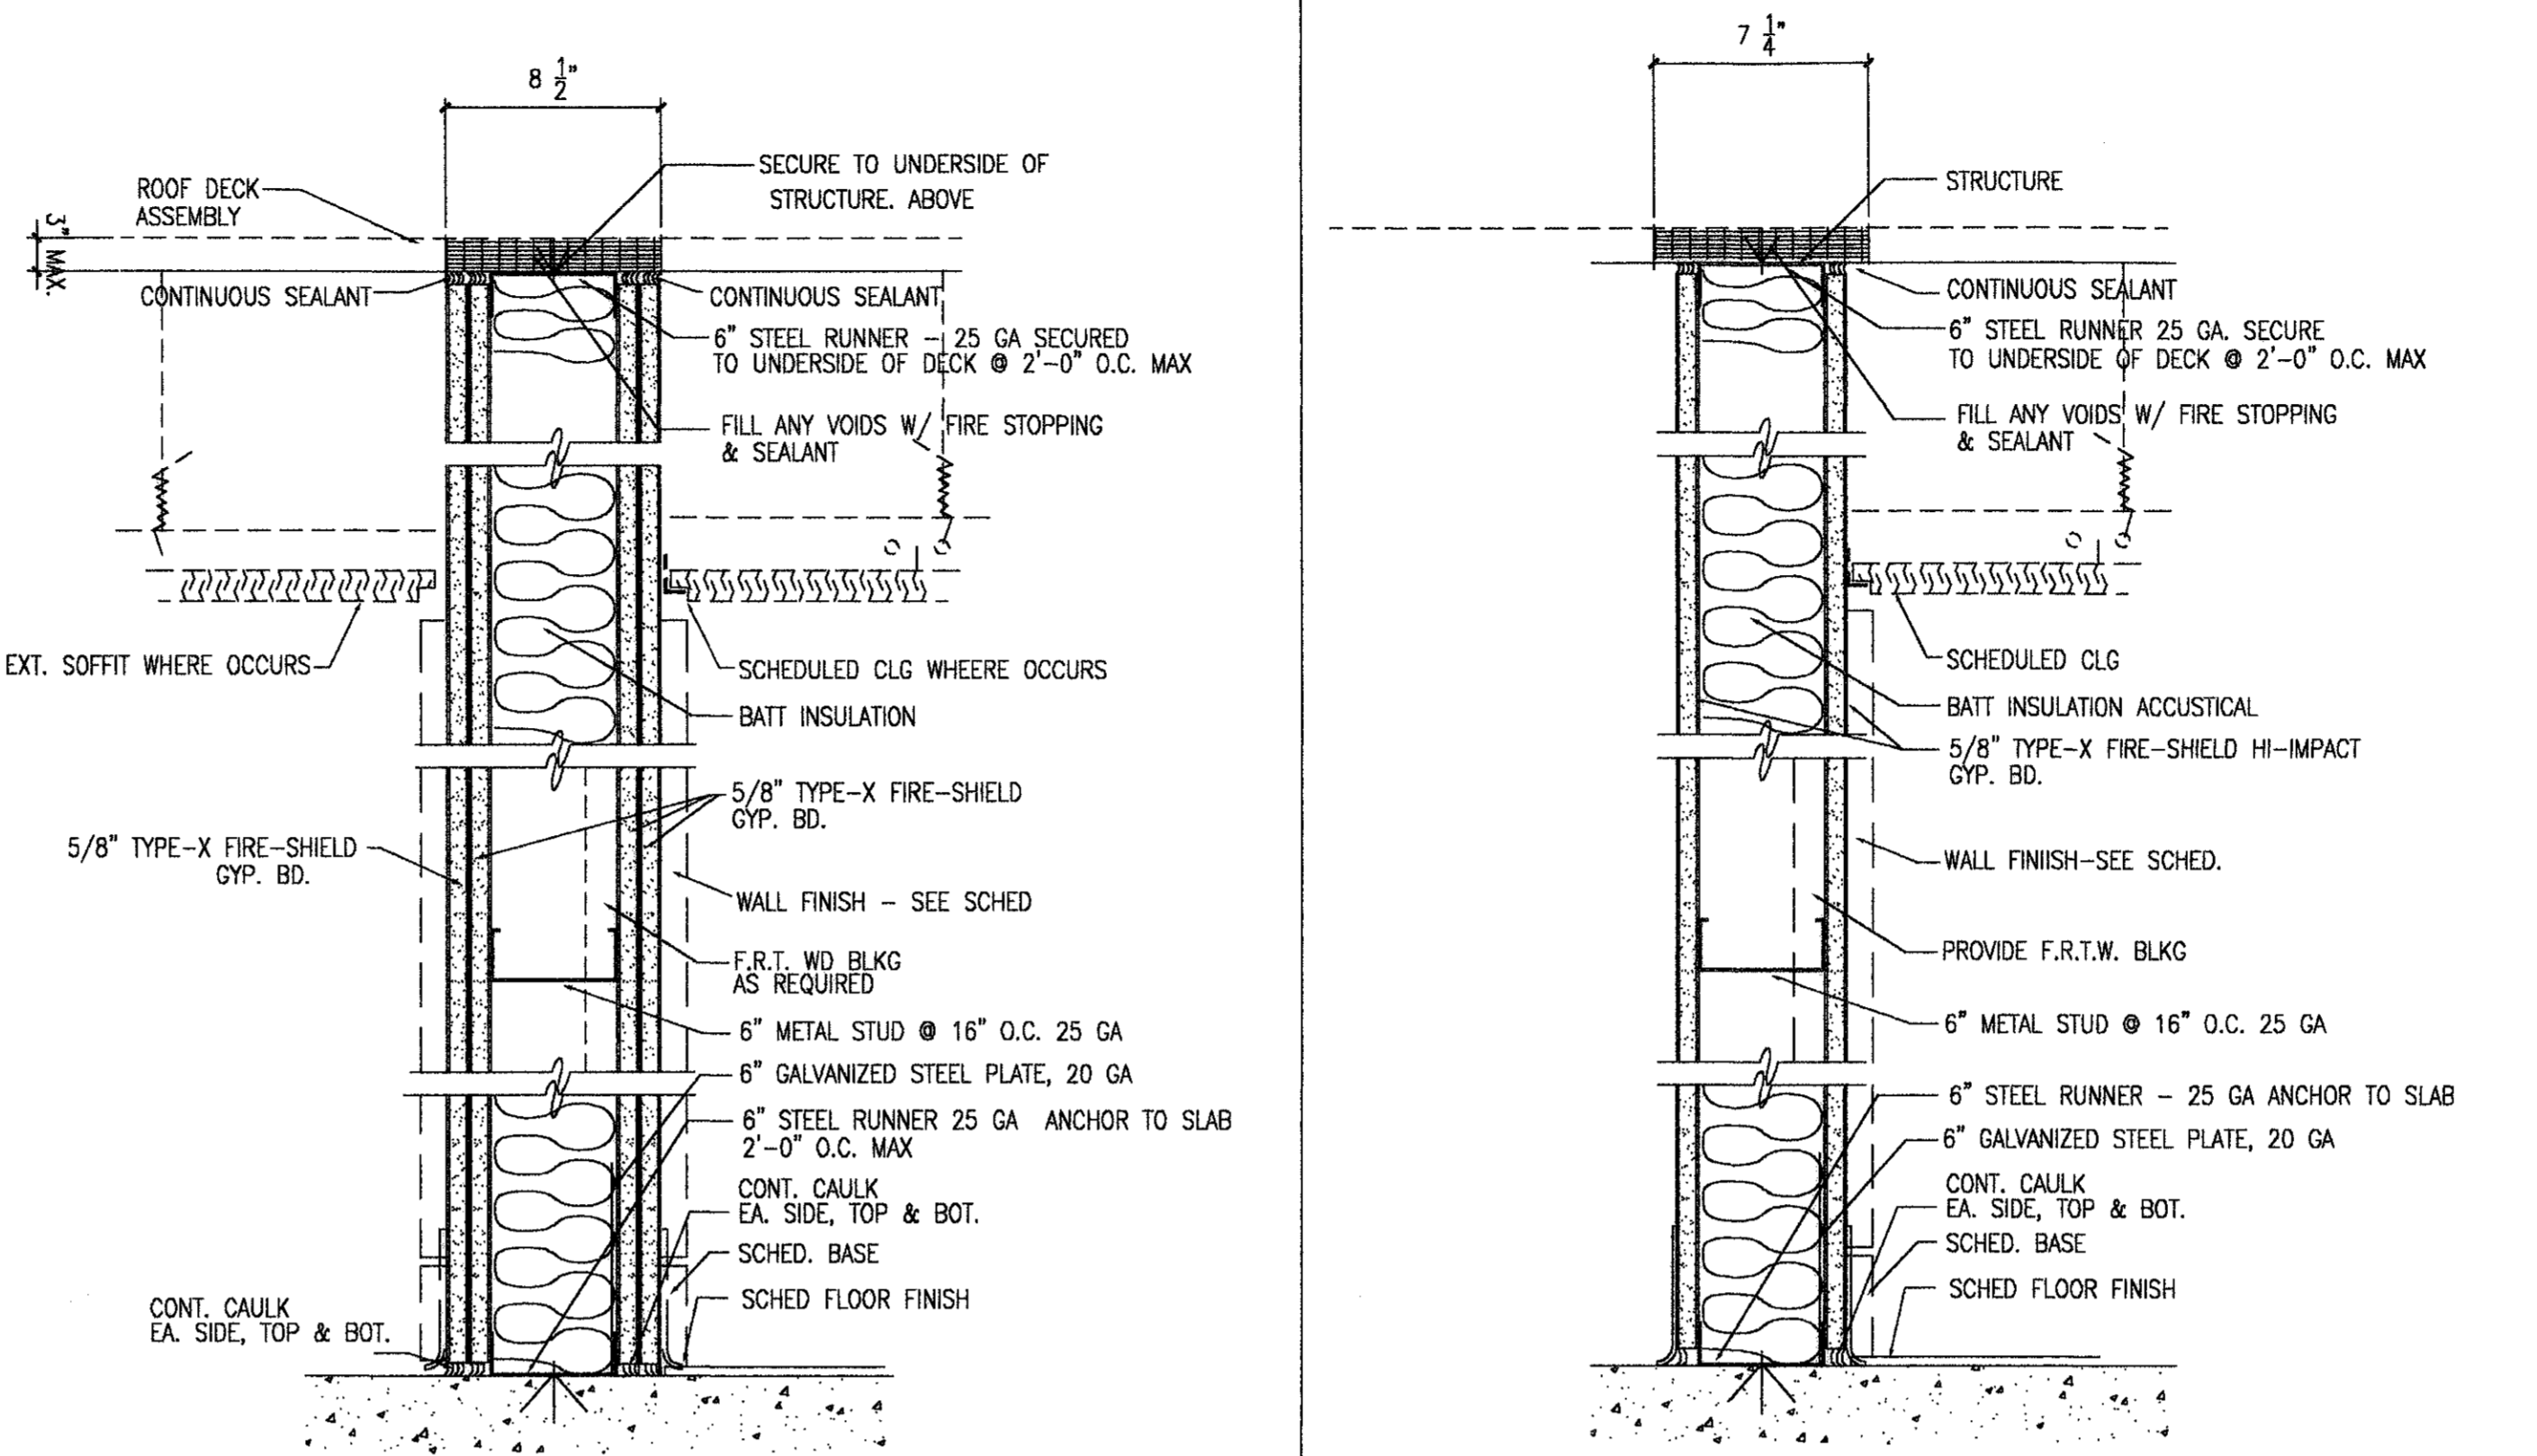


**2 WALL TYPE 2**  
 2 HR - UL# U411


**1 WALL TYPE 1**  
 1 HR - UL# U465

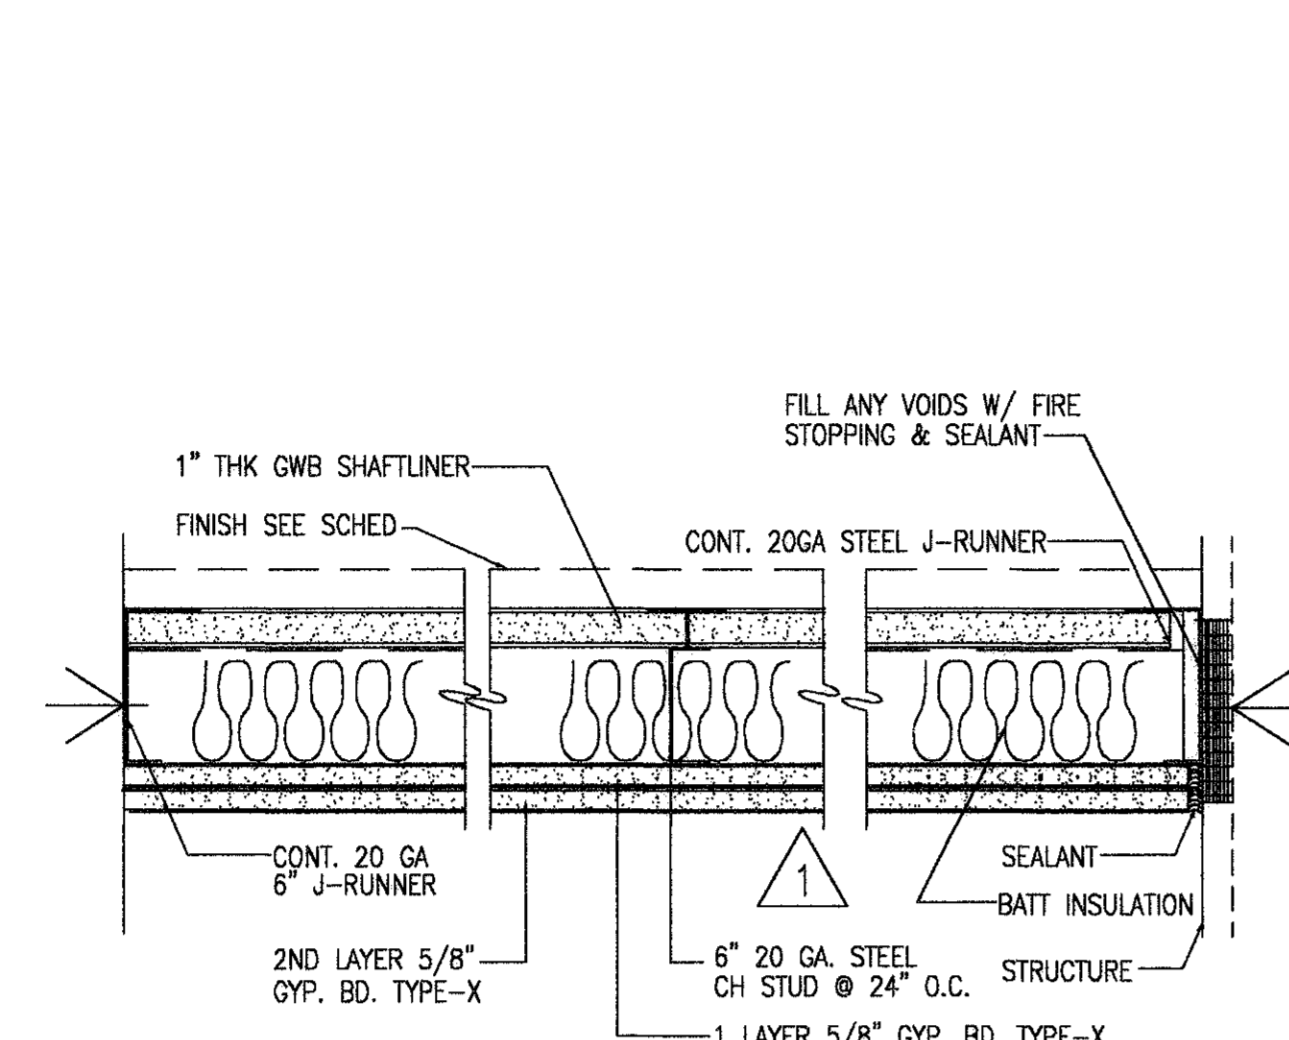


**3 WALL TYPE 3**  
 2 HR - ICBO EVALUATION SERVICES INC.,  
 EVALUATION REPORT NO. 3579

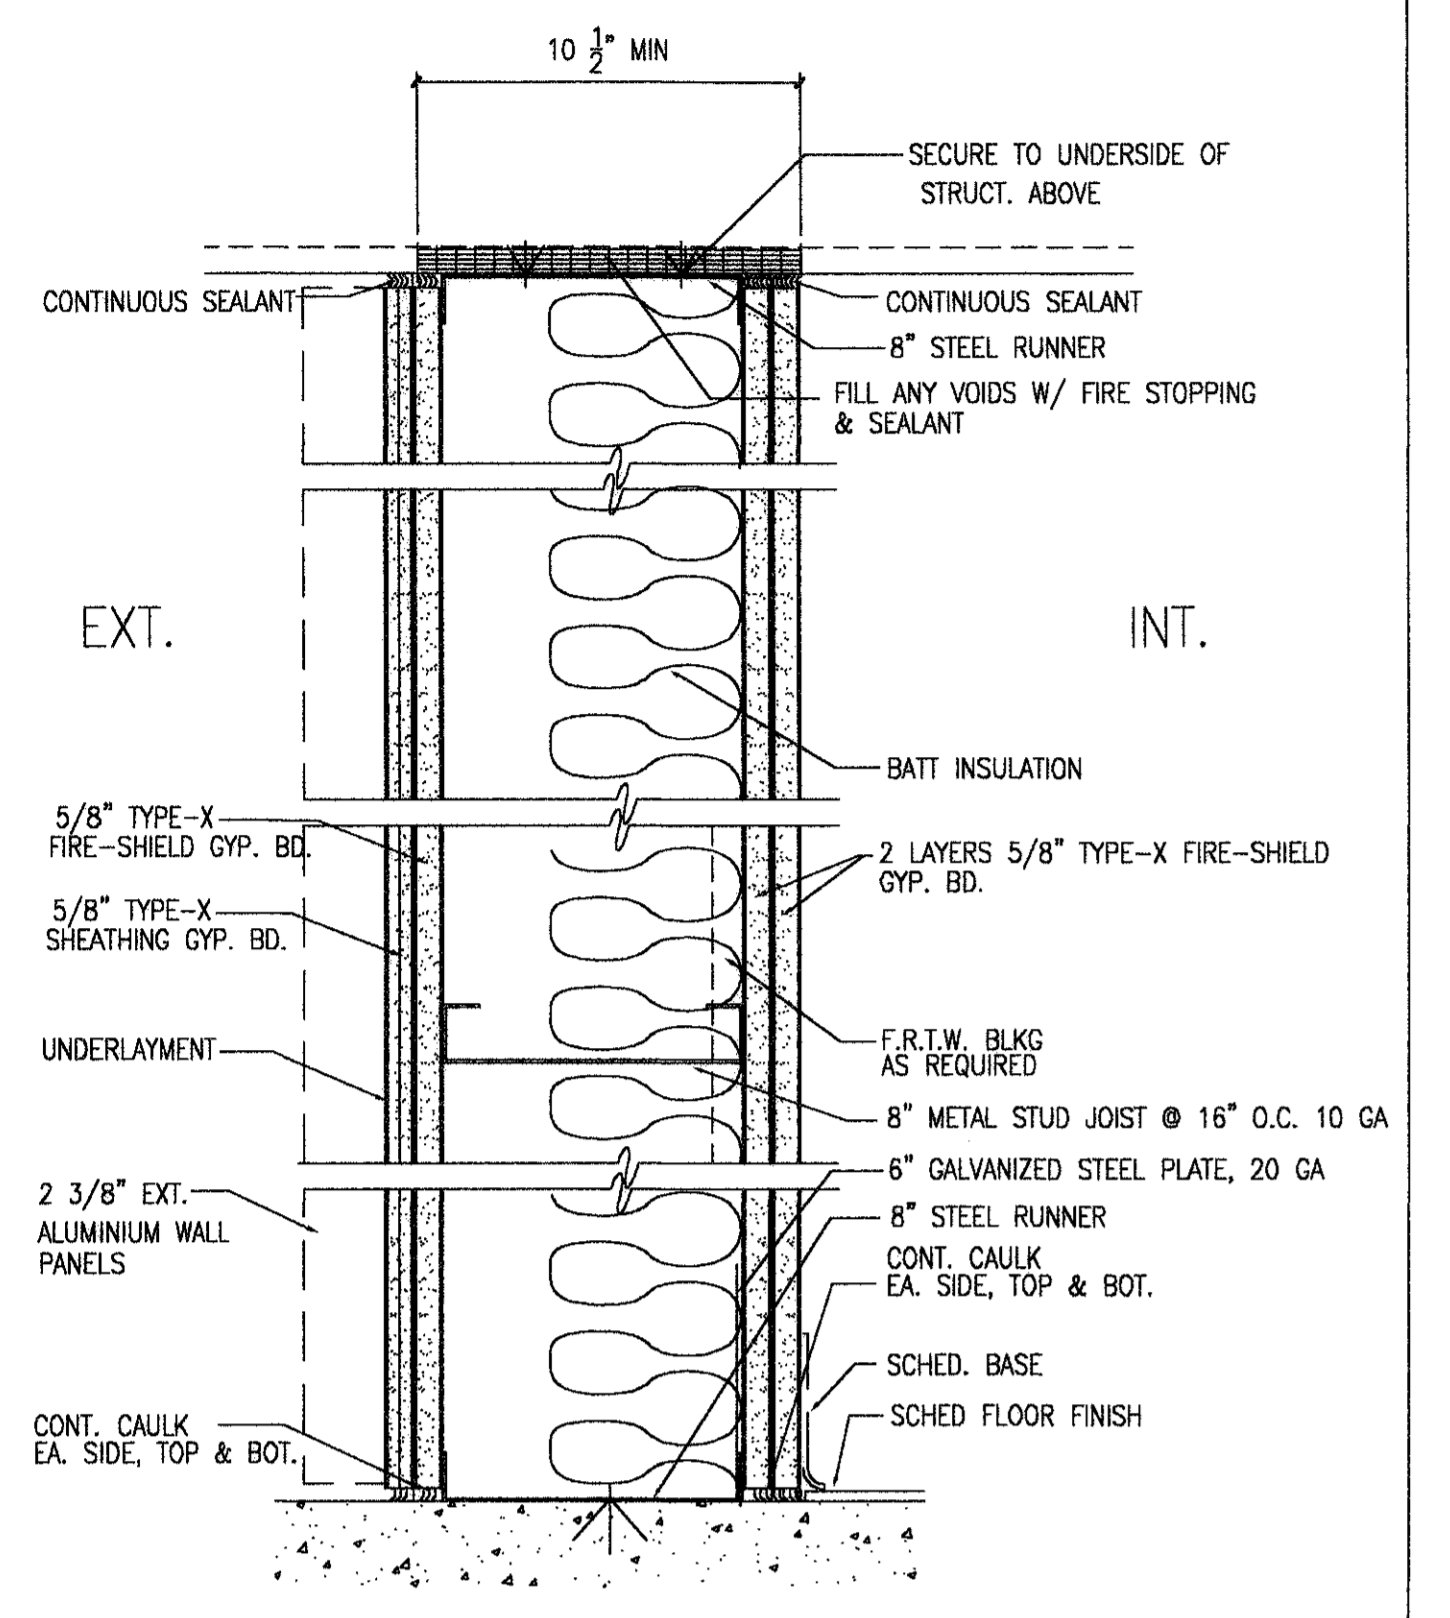


**4 WALL TYPE 4**  
 EXT. WALL @ MECHANICAL ROOM 2 HR - UL# U411

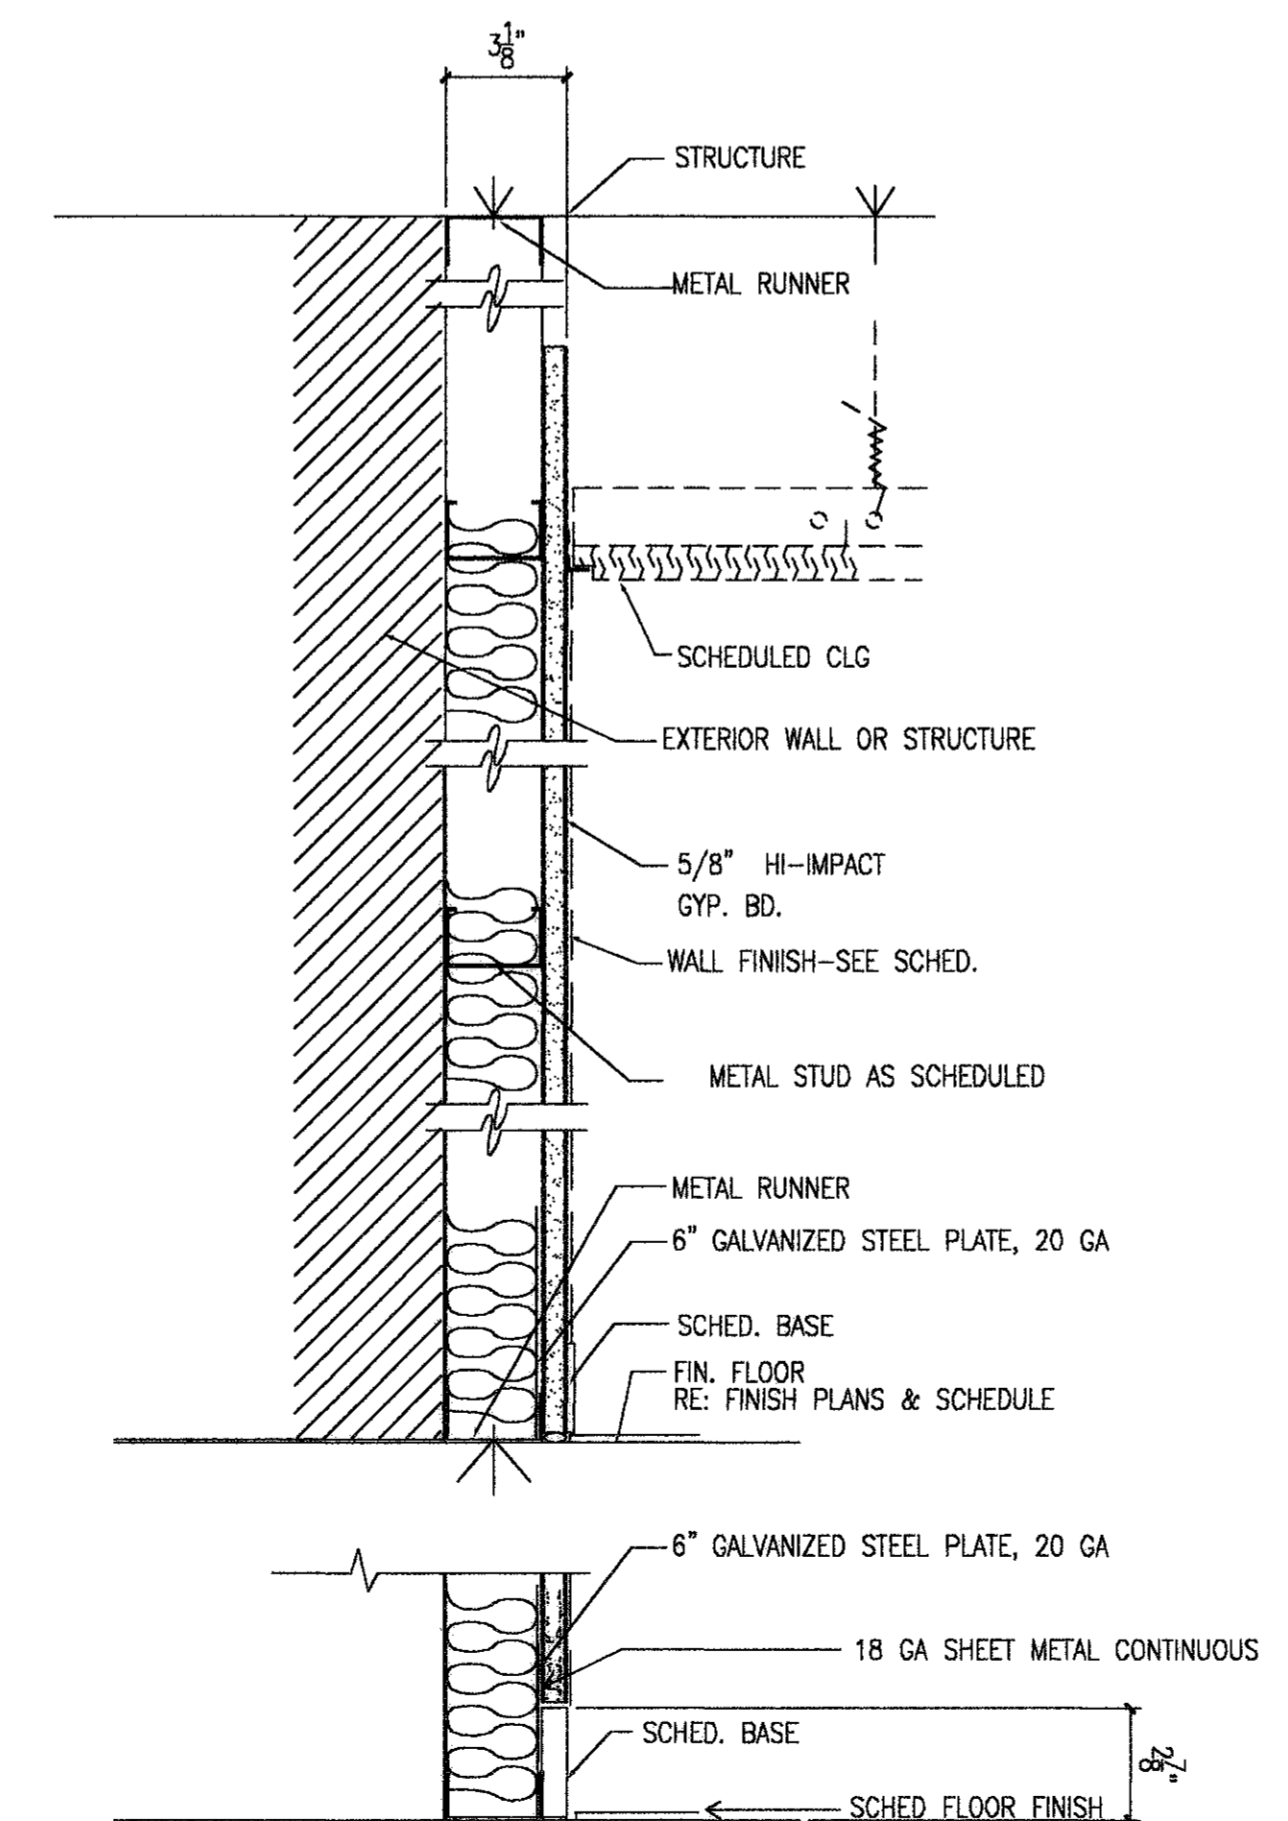


**6 WALL TYPE 6**  
 TYPICAL FURRED WALL

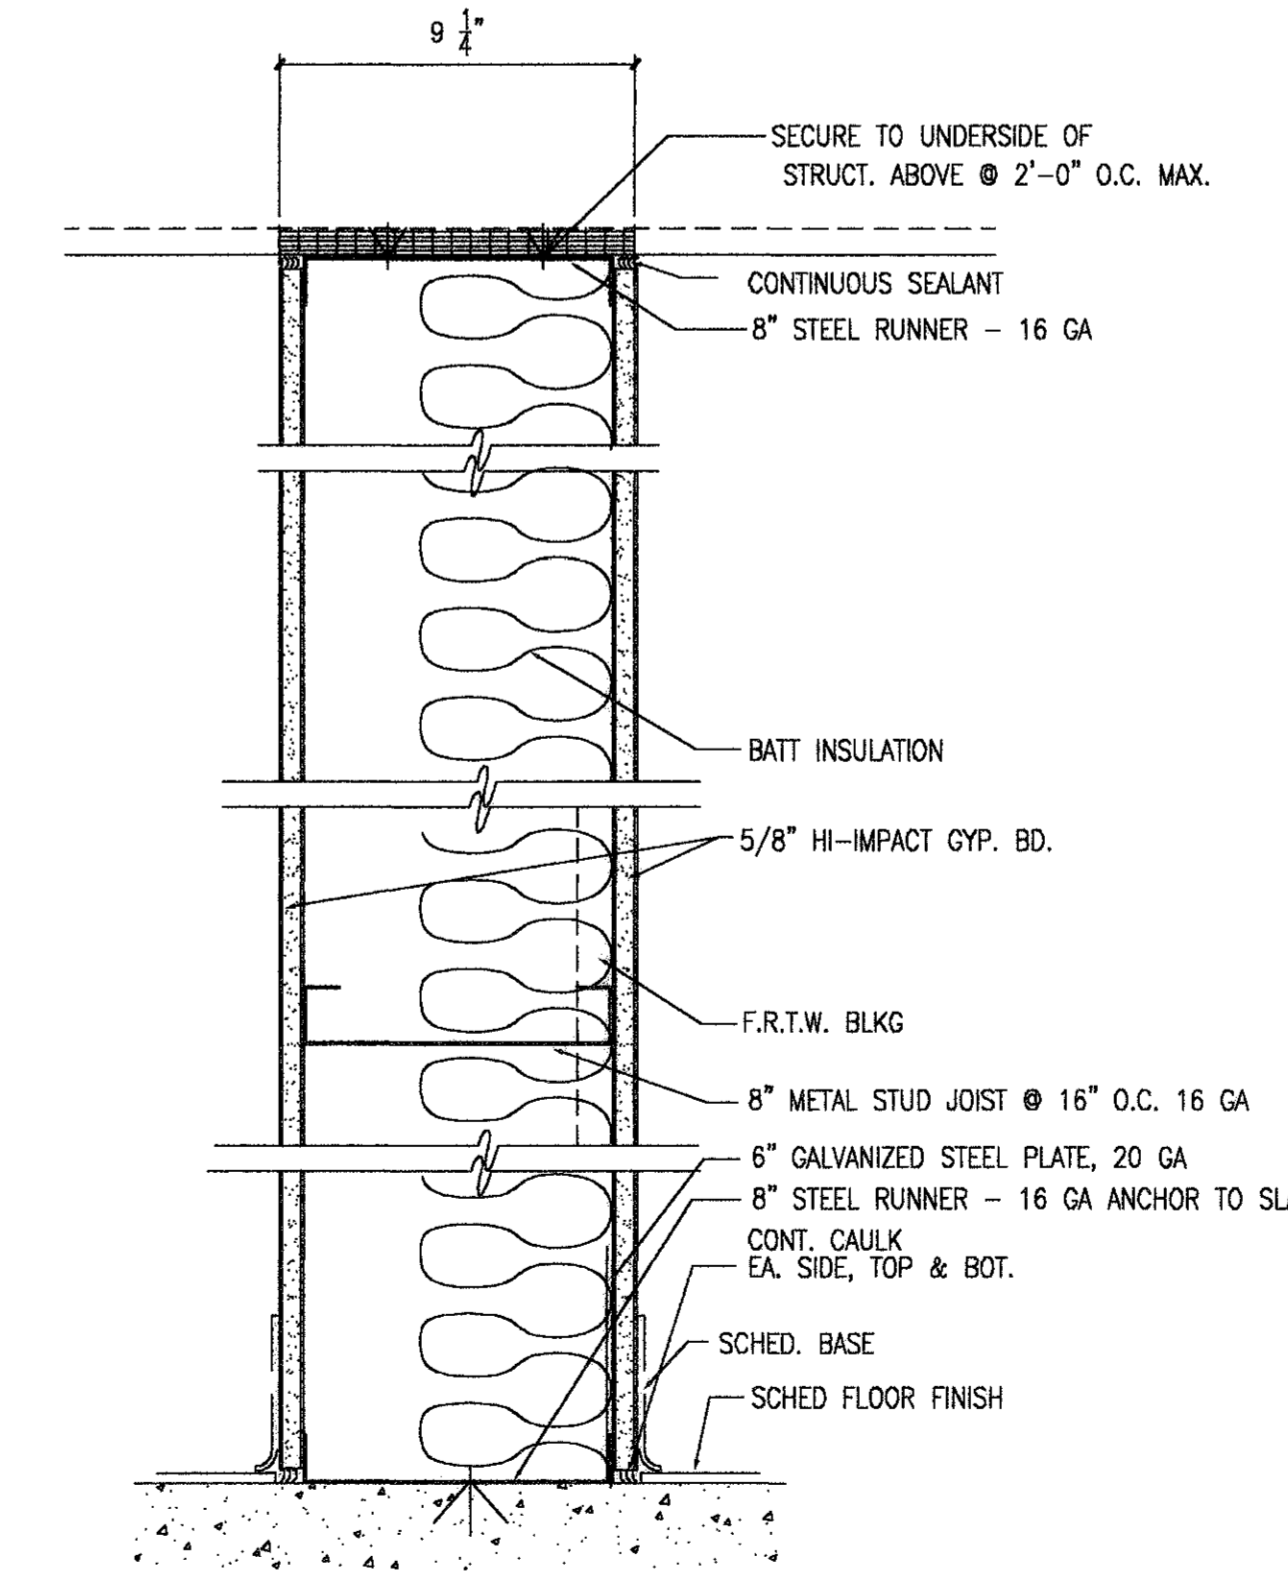

**5 WALL TYPE 5**  
 EQUIPMENT ROOM

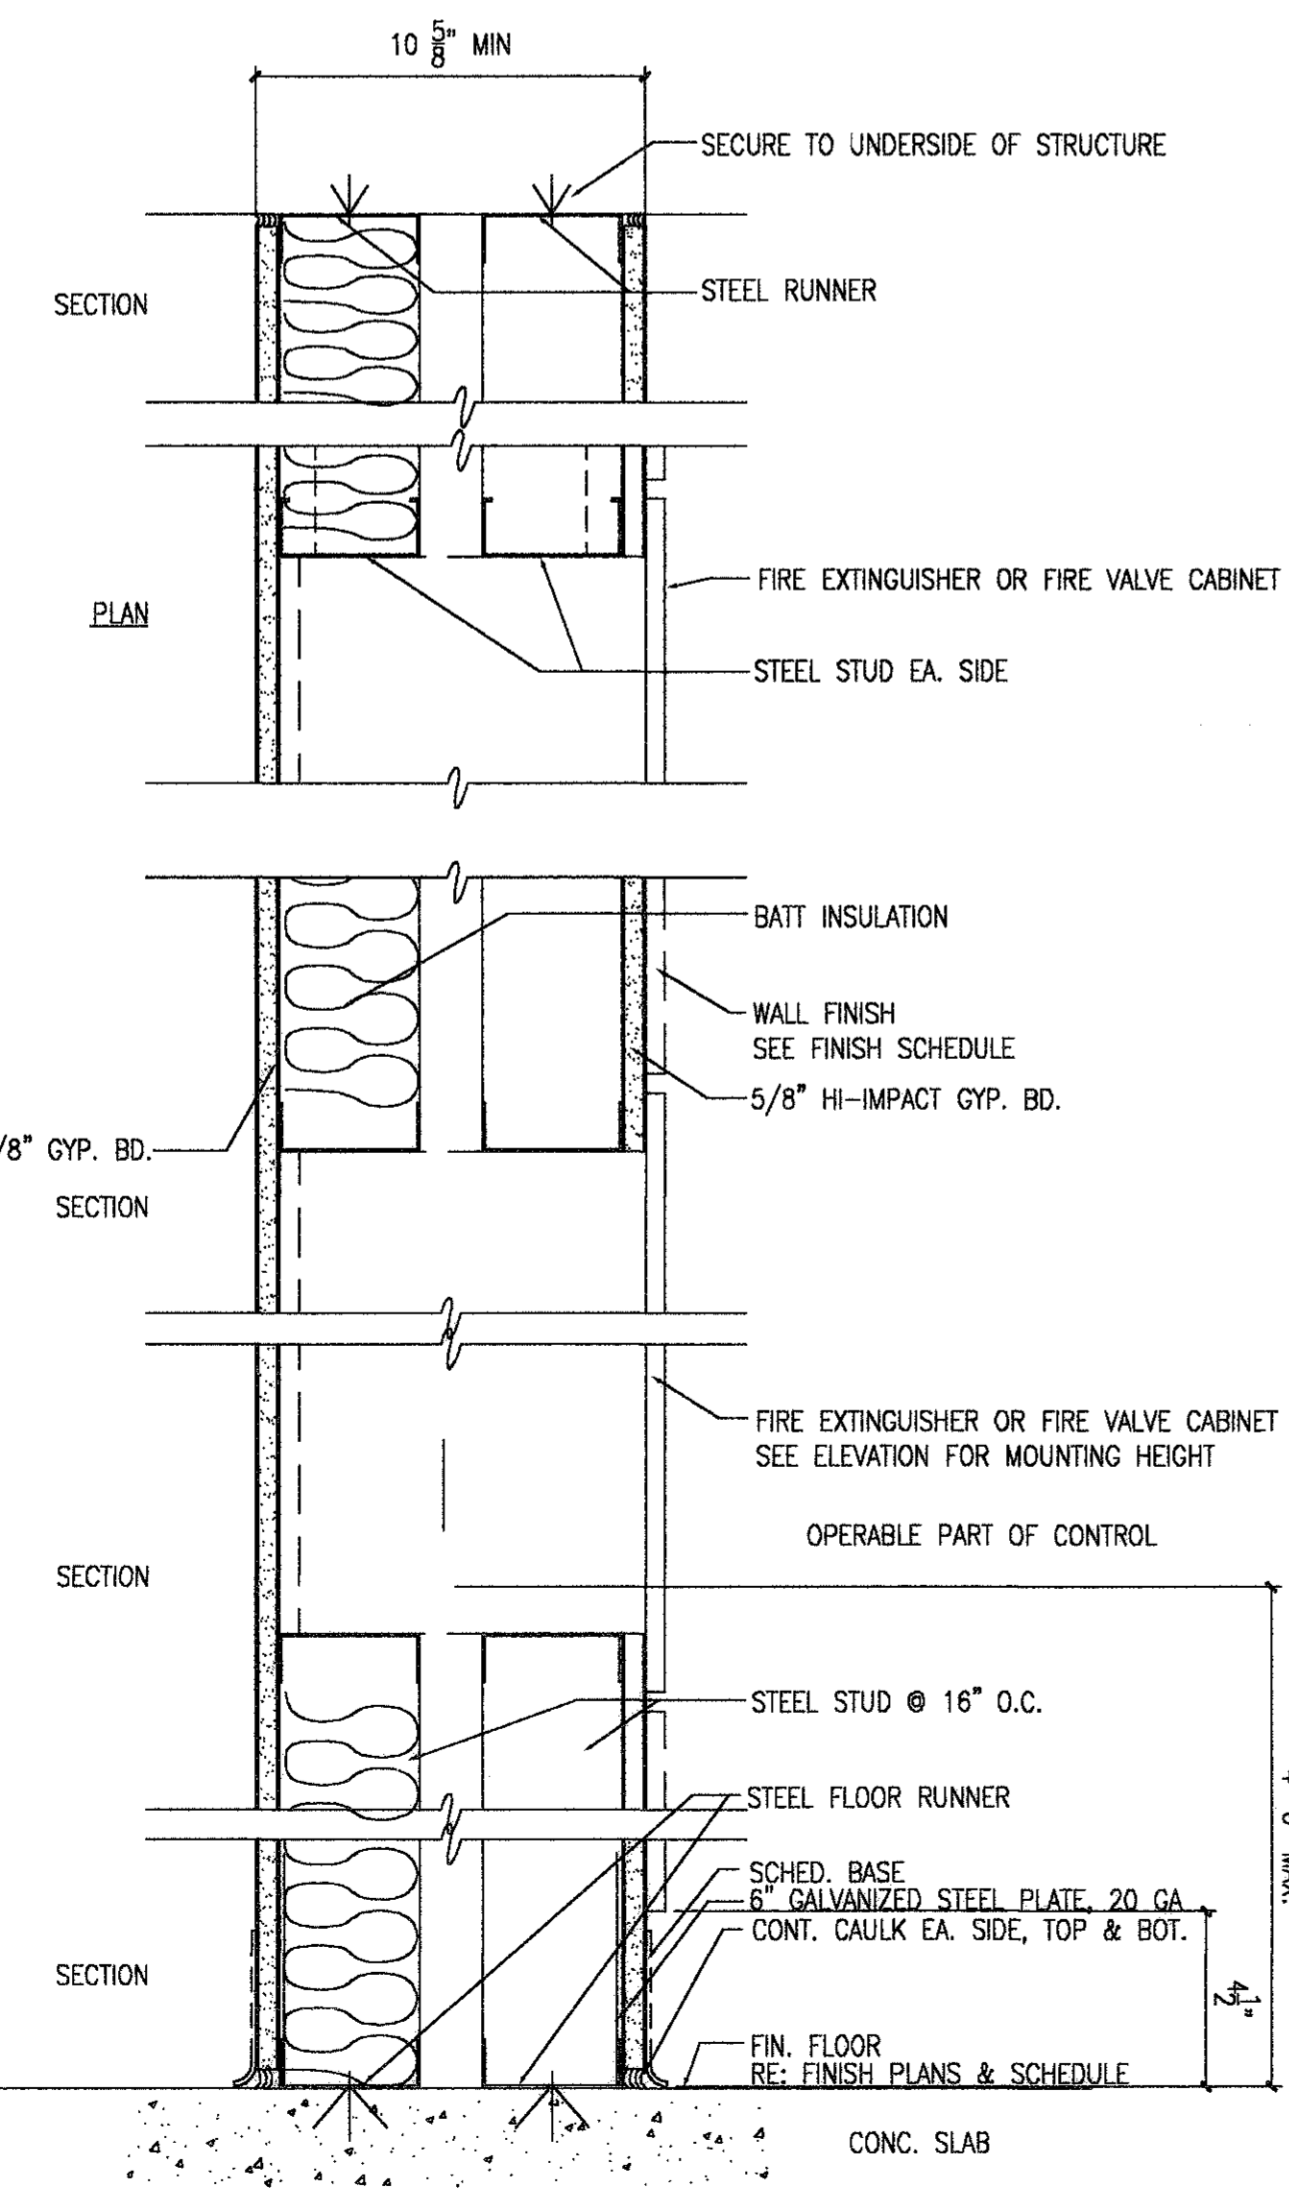

**7 FIRE EXTINGUISHER CABINET**  
 TYPICAL

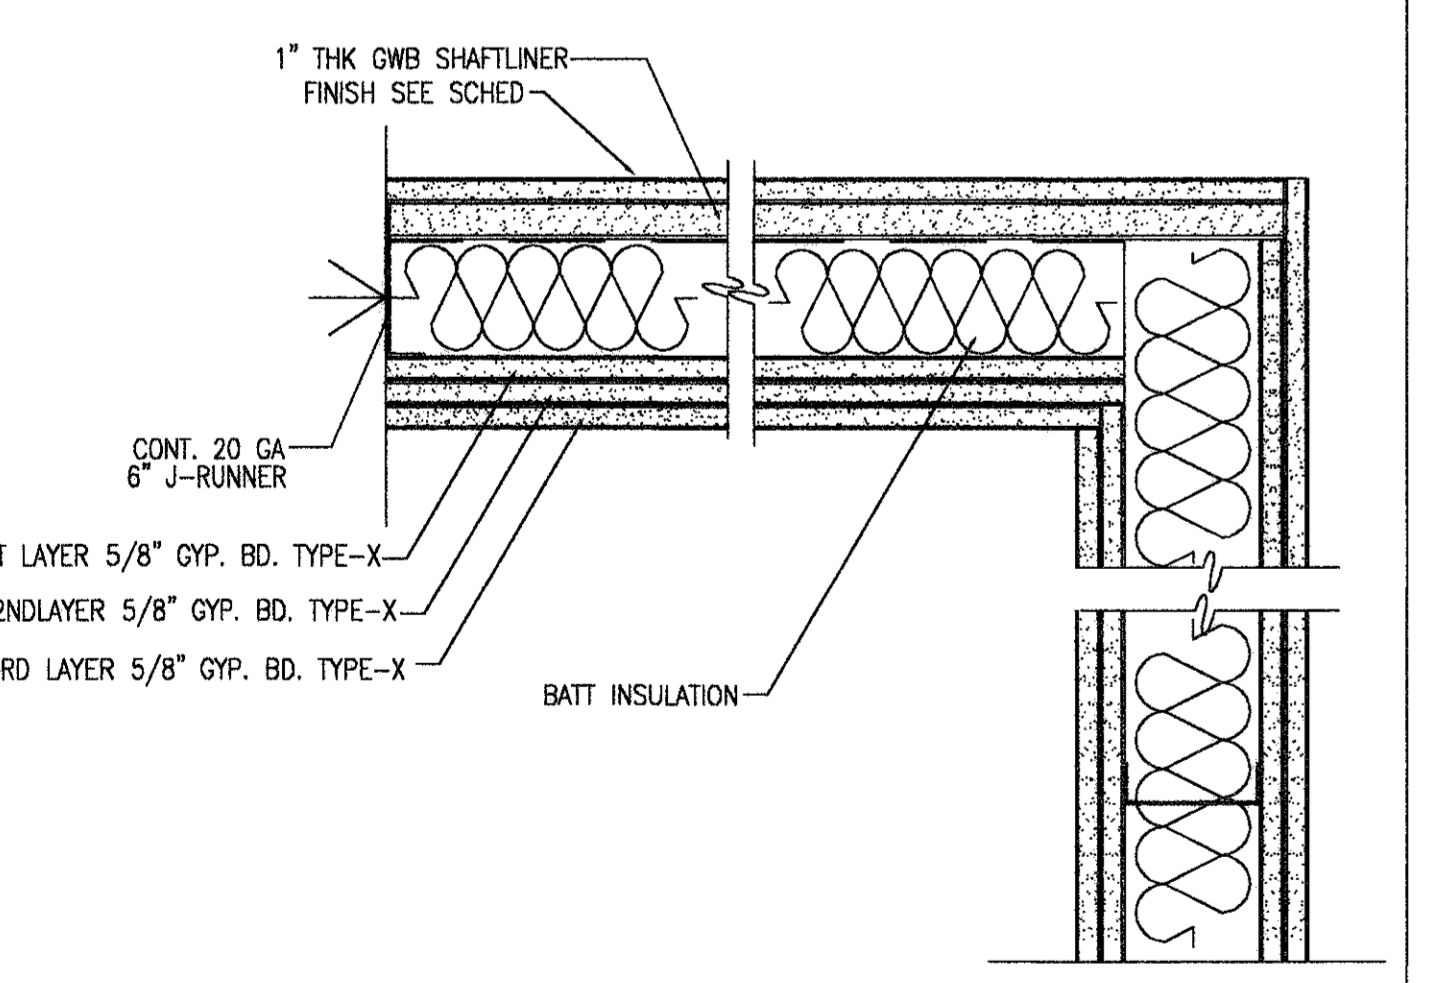

**8 WALL TYPE 8**  
 2 HR - ICBO EVALUATION SERVICES INC.,  
 EVALUATION REPORT NO. 3579



**DOOR SCHEDULE**

DOOR NUMBER	OPENING SIZE	DOOR			FRAME					FIRE RATING MIN.	HARDWARE	REMARKS
		DOOR TYPE	MATERIAL	FINISH	MATERIAL	FINISHES	FRAME JAMB	FRAME HEAD	SILL			
0-0001	3'-0"x7'-0"	C	ALUM	PAINT	ALUM	PAINT	-	-	-	-	HW-6	POWDERCOATED - WITH 3'x2'-3" LOUVER PANEL - INSECT MESH INSIDE FACE PERFORATED ALUMINIUM
1-0001	6'-0"x3'-0"		GLASS									GLASS GATE. REFER TO DWG 12/AB.040 FOR DETAILS AND HARDWARE
1-0002	6'-0"x7'-0"	B	HM		SSTL	SSTL	T1	T1		60	HW-2	LOBBY FACE SSTL CLAD - INT. FACE PAINTED
1-0003	6'-0"x7'-0"	B	HM	PNT	STEEL	PNT	T1	T1			HW-1	
1-0004	6'-0"x7'-0"	B	HM	PNT	STEEL	PNT	T1	T1		90	HW-1	
1-0005	33'-6"x12'-0"	F			SSTL STEEL		T1	T1		120	HW-7	McKEON SAFESCAPE T2500 FIRE DOOR WITH 2 SWINGING EGRESS DOORS WITH SSTL PANELS ON SIDE IN OPEN POSITION RE: DOOR TYPE D
1-0006	3'-0"x7'-0"	A	HM	PNT	STEEL	PNT	T1	T1			HW-8	
2-0001	2'-8"x6'-8"	D	HM		SSTL	SSTL	T2	T2			HW-3	INT. FACE SSTL CLAD EXT. FACE POWDERCOATED STEEL
2-0002	SLIDING DOOR	-	-	-	-	-	-	-	-	-	-	BY VEHICLE SUPPLIER - 536D
2-0003	5'-4"x6'-8"	E	HM	SSTL	SSTL	SSTL	T1	T1			HW-4	WITH GLASS PANEL - 1/2" TEMPERED GLASS
2-0004	SLIDING DOOR	-	-	-	-	-	-	-	-	-	-	BY VEHICLE SUPPLIER - 536D
2-0005	2'-8"x6'-8"	D	HM		SSTL	SSTL	T2	T2			HW-3	INT. FACE SSTL CLAD EXT. FACE POWDERCOATED STEEL
2-0006	SLIDING DOOR	-	-	-	-	-	-	-	-	-	-	BY VEHICLE SUPPLIER - 536D
2-0007	5'-4"x6'-8"	E	HM	SSTL	SSTL	SSTL	T1	T1			HW-4	WITH GLASS PANEL - 1/2" TEMPERED GLASS
2-0008	SLIDING DOOR	-	-	-	-	-	-	-	-	-	-	BY VEHICLE SUPPLIER - 536D
2-0009	2'-8"x6'-8"	D	HM		SSTL	SSTL	T2	T2			HW-3	INT. FACE SSTL CLAD EXT. FACE POWDERCOATED STEEL
2-0010	2'-8"x6'-8"	D	HM		SSTL	SSTL	T2	T2			HW-3	INT. FACE SSTL CLAD EXT. FACE POWDERCOATED STEEL
2-0011	SLIDING DOOR	-	-	-	-	-	-	-	-	-	-	BY VEHICLE SUPPLIER - 536D
2-0012	5'-4"x6'-8"	E	HM	SSTL	SSTL	SSTL	T1	T1			HW-4	WITH GLASS PANEL - 1/2" TEMPERED GLASS
2-0013	SLIDING DOOR	-	-	-	-	-	-	-	-	-	-	BY VEHICLE SUPPLIER - 536D
2-0014	2'-8"x6'-8"	D	HM		SSTL	SSTL	T2	T2			HW-3	INT. FACE SSTL CLAD EXT. FACE POWDERCOATED STEEL
2-0015	SLIDING DOOR	-	-	-	-	-	-	-	-	-	-	BY VEHICLE SUPPLIER - 536D
2-0016	5'-4"x6'-8"	E	HM	SSTL	SSTL	SSTL	T1	T1			HW-4	WITH GLASS PANEL - 1/2" TEMPERED GLASS
2-0017	SLIDING DOOR	-	-	-	-	-	-	-	-	-	-	BY VEHICLE SUPPLIER - 536D
2-0018	2'-8"x6'-8"	D	HM		STEEL	SSTL	T2	T2			HW-3	INT. FACE SSTL CLAD EXT. FACE POWDERCOATED STEEL
2-0019	3'-0"x7'-0"	D	HM	SSTL	SSTL	SSTL	T1	T1		90	HW-5	
2-0020	3'-0"x7'-0"	D	HM	SSTL	SSTL	SSTL	T1	T1		90	HW-5	

**LEGEND:**  
 SLDR SLIDING DOORS  
 HM HOLLOW METAL  
 TBD TO BE DETERMINED  
 PNT PAINT  
 SSTL STAINLESS STEEL  
 ALUM POWDERCOATED ALUMINIUM

T1: FRAME FACE DIMENSION 2" RE: 01/A2.801 FOR JAMB. RE: 02/A2.801 FOR HEAD  
 T2: FRAME FACE DIMENSION 1 1/2" RE: 03/A2.801 FOR JAMB. RE: 04/A2.801 FOR HEAD

**NOTE:**  
 HARDWARE SCHEDULE  
 FOR DOOR TYPE  
 REFER SHEET A2.801

**DOOR HARDWARE SCHEDULE**

- |  |   |   |
|--|---|---|
| <p>HW-1<br/>                 3 PR BUTT HINGES<br/>                 1 LEVER LOCKSET (STOREROOM FUNCTION)<br/>                 1 REGULAR OR PARALLEL CLOSER<br/>                 1 FLOOR STOP<br/>                 1 SET SILENCERS<br/>                 1 SET FLUSHBOLTS<br/>                 1 DUSTPROOF STRIKE</p>   | <p>HW-3<br/>                 1 1/2 PR BUTT HINGES<br/>                 2 CYLINDERS<br/>                 1 LEVER LOCKSET EXIT DEVICE<br/>                 1 CLOSER<br/>                 1 THRESHOLD - TYPE 2<br/>                 1 FLOOR STOP<br/>                 1 SET WEATHERSTRIPPING<br/>                 1 DOOR ALARM CONTACT</p> | <p>HW-5<br/>                 1SET OFFSET PIVOT HINGES<br/>                 2 CYLINDERS<br/>                 1 LEVER LOCKSET EXIT DEVICE<br/>                 1 CLOSER<br/>                 1 SET WEATHERSTRIPPING<br/>                 1 FLOOR STOP<br/>                 1 THRESHOLD - TYPE 1<br/>                 1 DOOR ALARM CONTACT</p> |
| <p>HW-2<br/>                 3 PR BUTT HINGES<br/>                 1 LEVER LOCKSET (STOREROOM FUNCTION)<br/>                 1 REGULAR OR PARALLEL CLOSER<br/>                 2 FLOOR STOPS<br/>                 1 SET SILENCERS<br/>                 1 SET FLUSHBOLTS<br/>                 1 DUSTPROOF STRIKE<br/>                 1 ELECTROMAGNETIC LOCK<br/>                 1 POWER TRANSFER<br/>                 2 DOOR ALARM CONTACTS</p> | <p>HW-4<br/>                 2 SETS OFFSET PIVOT HINGES<br/>                 4 CYLINDERS<br/>                 2 LEVER LOCKSET EXIT DEVICE<br/>                 2 CLOSERS<br/>                 2 THRESHOLD - TYPE 2<br/>                 1 SET WEATHERSTRIPPING</p>  | <p>HW-6<br/>                 HINGES BY DOOR MANUFACTURER<br/>                 1 SIDE PIVOT<br/>                 1 CYLINDER<br/>                 1 RIM EXIT DEVICE (NO OUTSIDE PULL)<br/>                 1 CLOSER<br/>                 1 SET WEATHERSTRIPPING<br/>                 1 THRESHOLD</p>  |

NOTE: COORDINATE ALL DOOR HARDWARE WITH THE SECURITY REQUIREMENTS SHOWN ON SHEETS Q0.000 THROUGH Q5.101

**ROOM FINISH SCHEDULE**

NO.	NAME	FLOOR	BASE	WALL				CEILING	HEIGHT	REMARKS
				NORTH	EAST	SOUTH	WEST			
1-0001	LOBBY	FL-1	B-1	PA-1	-	PA-1	-	PA-2	28'	PAINTED GWB CEILING UNDER BALCONY AND CATWALK SSTL CEILING AC-2 @ ROLLING DOOR AREA
1-0002	CORRIDOR	FL-1	B-1	LV	IMP-1	LV	PA-3	PA-2	28'	
1-0003	EQUIP. ROOM	CN-1	B-3	PA-2	PA-2	PA-2	PA-2	PA-2	VARIED	
1-0004	MECH. ROOM	CN-1	B-3	PA-2	PA-2	PA-2	PA-2	PA-3	28'	
1-0005	ELEV. & ESC. ROOM	CN-1	B-3	PA-2	PA-2	PA-2	PA-2	PA-2		
2-0001	PLATFORM	FL-1	B-1	PA-1	-	PA-1	-	AC-1	VARIED	
2-0002	CATWALK	FL-1	B-1	-	-	-	-	AC-1	VARIED	
2-0003	SLDR. AREA	FL-2	B-1	IMP-1	IMP-1	-	IMP-1	AC-2		
2-0004	SLDR. AREA	FL-2	B-1	IMP-1	IMP-1	-	IMP-1	AC-2		
2-0005	SLDR. AREA	FL-2	B-1	-	IMP-1	IMP-1	IMP-1	AC-2		
2-0006	SLDR. AREA	FL-2	B-1	-	IMP-1	IMP-1	IMP-1	AC-2		

**LEGEND AND FINISH SCHEDULE:**

**POWDERCOAT COLORS ON METAL**  
 COLOR #1: WHITE VANILLA CREAM DURANAR UC 63699  
 COLOR #2: SILVER METALLIC KYNAR 500 - FROM UNA-CLAD COPPER SALES, INC. STANDARD COLORS  
 COLOR #3: CUSTOM COLOR BLUE SILVER METALLIC KYNAR 500

**INTERIOR FINISH:**


- BASE**  
 B-1 STAINLESS STEEL - 4" HIGH NON-DIRECTIONAL MACHINE POLISH  
 B-2 RUBBER BASE, 4" HIGH, COVED
- FLOOR**  
 FL-1 EPOXY TERRAZZO TYPE 1 TO BE SELECTED - 3/8" THK  
 FL-2 EPOXY TERRAZZO TYPE 2 TO BE SELECTED  
 CN-1 CONCRETE SEALER
- PAINTS**  
 PA-1 "DUROPLEX" PAINTING BY TRIARCH INDUSTRIES OR EQUAL - FINISH: CUSTOM COLOR TO BE DETERMINED BY ARCHITECT, TEXTURED FLOAT  
 PA-2 PAINT ON GWB  
 PA-3 PAINT ON CONCRETE
- METAL**  
 IMP-1 INTERIOR STAINLESS STEEL WALL METAL PANELS - NGAGE SYSTEM BY BAKER METAL PRODUCTS INC. - 1/16" THK MIN. - FINISH: NON-DIRECTIONAL MACHINE POLISH  
 EMP-2 ALUMINIUM LOUVERS TYPE THIN LINES FROM INDUSTRIAL LOUVERS INC. 1 1/2" THICK OR EQUAL POWDERCOATED COLOR #2
- CEILING**  
 AC-1 PRE-FINISHED CURVED PERFORATED METAL CEILING, TYPE ALUMA VAULT SYSTEM 1000 BY GORDON MANUFACTURER WITH BLACK NON WOVEN ACCOUSTICAL MAT - PATTERN ITEM # R316 ROUND 3/16" x 0.65" STAGGERED CENTERS OPEN AREA 7% - CUSTOM COLOR: EQUAL TO BRIGHT SILVER 399 x 440 FROM BAKER METAL PRODUCT INC. FLUROPON CLASSIC II COLOR SELECTOR  
 AC-2 REMOVABLE FLAT STAINLESS STEEL METAL PANELS. FINISH - NON DIRECTIONAL MACHINE POLISH

**EXTERIOR MATERIAL FINISH:**

- EMP-1 EXTERIOR POWDERCOATED WALL METAL PANELS - ALUMINIUM PANEL 1/8" THICK - TYPE SERIE 3000 MODIFIED FROM UNA-CLAD - COPPER SALES OR EQUAL -POWDERCOATED KYNAR 500 COLOR #1 OR COLOR #2 AS NOTED IN ARCHITECTURAL DRAWINGS
- EMP-2 ALUMINIUM LOUVERS TYPE THIN LINES FROM INDUSTRIAL LOUVERS INC. - 1 1/2" THICK OR EQUAL POWDERCOATED COLOR #2
- RF-1 STANDING SEAM METAL ROOF- TYPE UC3 FROM UNA-CLAD - COPPER SALES, INC OR EQUAL- POWDERCOATED KYNAR 500: COLOR #2
- 12" ALUMINIUM CHANNEL ON FACADES: POWDERCOATED KYNAR 500: COLOR #1
  - GUARDRAILS @ STAIR#2 AND STRUCTURAL FRAME: PAINT
  - ALL CURTAIN WALLS MULLIONS AND COVER PLATES: POWDERCOATED COLOR#2
  - PAINT ALL VISIBLE CONCRETE FACES AT INTERIOR AND EXTERIOR: CAST-IN-PLACE COLUMNS, BEAMS, SLABS, CEILING, STAIRS... COLORS TO BE DETERMINED BY ARCHITECT.

INTERNATIONAL SERVICES • EXPANSION • PROGRAM  
**APM STATION + PLATFORM**  
 DOOR SCHEDULE AND ROOM SCHEDULE

PROJECT MGR: HEM  
 DESIGNER: SG  
 DRAWN BY: SEM  
 CHECKED BY: AB  
 DRAWING STANDARD: SEP 07.20.2000  
 SCALE: NTS  
 DATE: 09/14/01

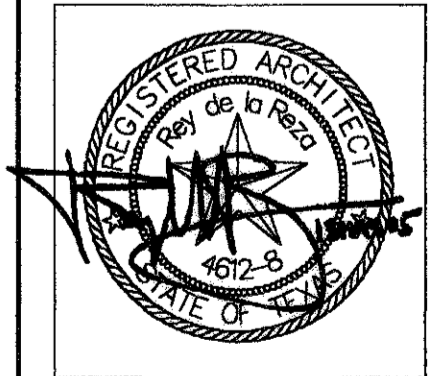

APPROVED BY: DATE:

HOUSTON AIRPORT SYSTEM  
 PROJECT NO. 1140  
 C.I.P. NO. A-0354  
 H.A.S. NO. 536C  
 SHEET NO.


**RECORD DRAWINGS**  
 DO NOT MODIFY  
 Rey de la Reza Architects, Inc.  
 13 May 2005  
 Note: Information used to develop these documents was taken from Record of the Work Drawings prepared by the construction contractor, Clark Construction Group - Texas  
 The information provided by the contractor was not verified by the design firm named above.




**RECORD DRAWINGS**  
 DO NOT MODIFY  
 Rey de la Reza Architects, Inc.  
 13 May 2005

Note: Information used to develop these documents was taken from Record of the Work Drawings prepared by the construction contractor, Clark Construction Group - Texas. The information provided by the contractor was not verified by the design firm named above.


NO.	DESCRIPTION	DATE	BY
ISSUED FOR BID		10/16/01	
RECORD SET		05/13/05	EM

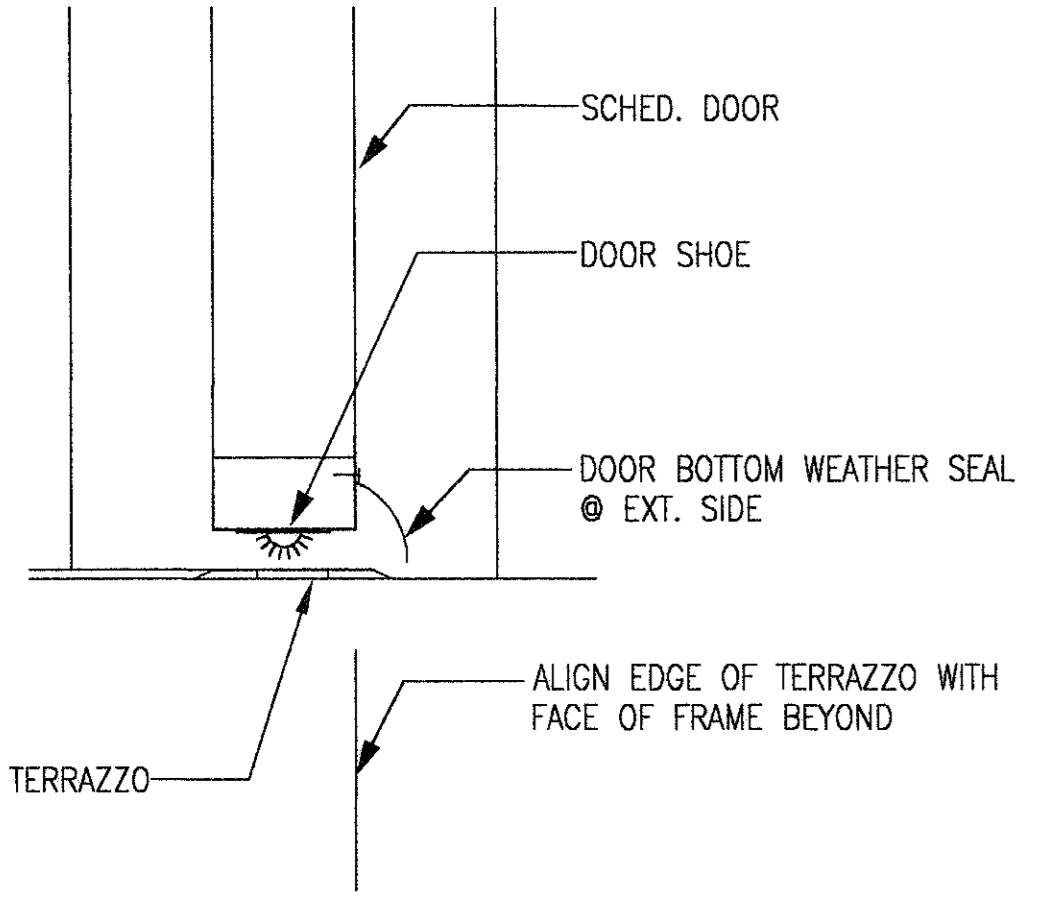


**05 SILL TYPE 1**  
 (A2.801) 1'-1/2"=1'-0"

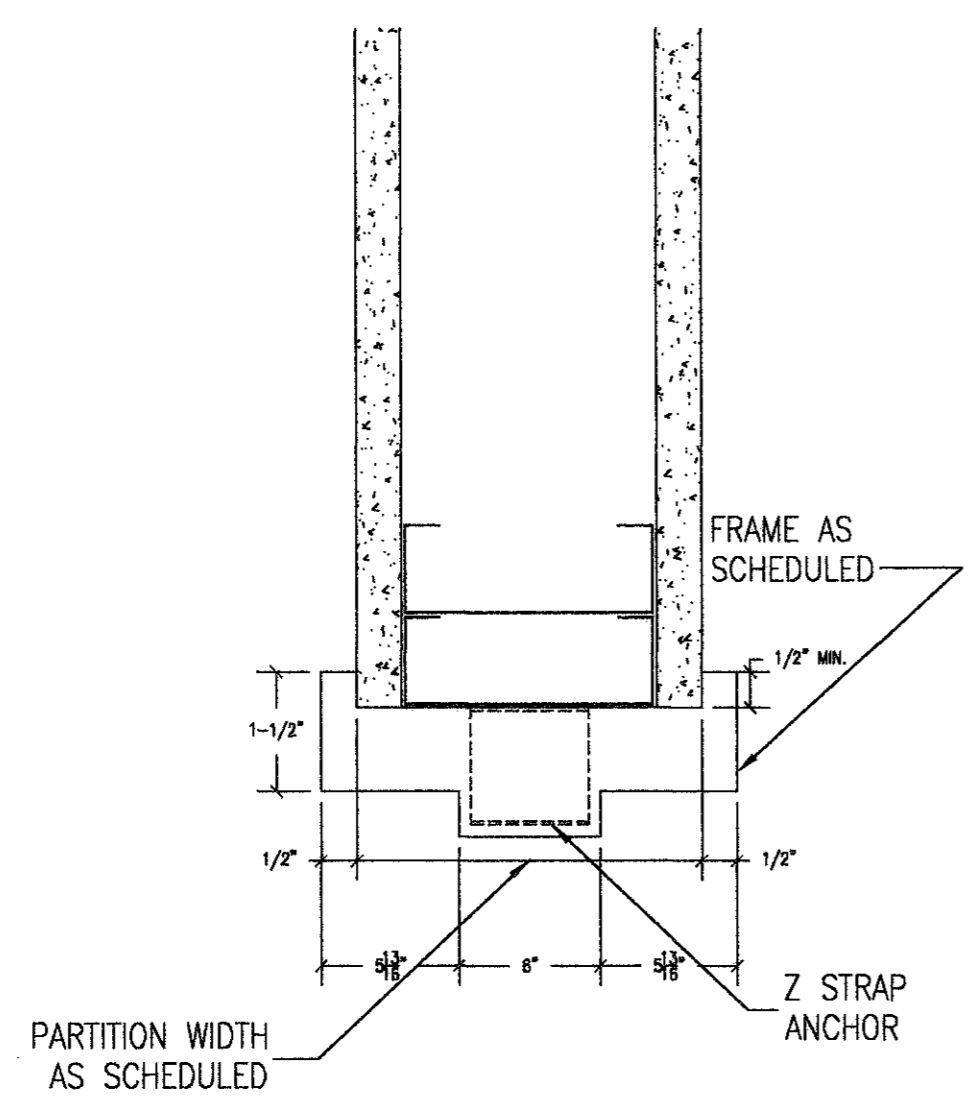


**04 HEAD DETAIL FRAME TYPE 2**  
 (A2.801) 1'-1/2"=1'-0"

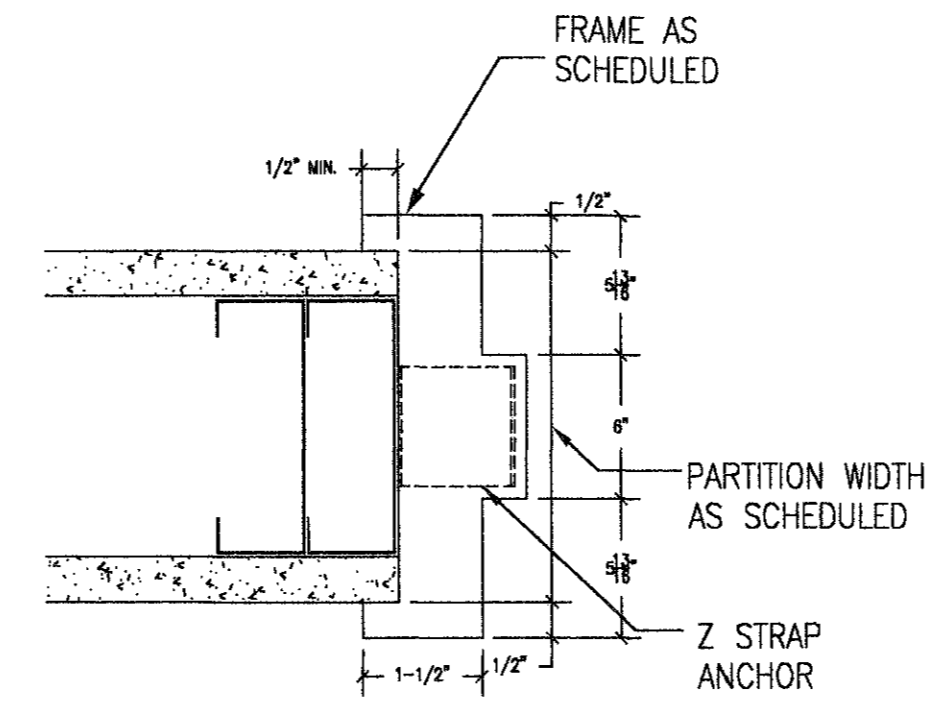


**03 JAMB DETAIL FRAME TYPE 2**  
 (A2.801) 1'-1/2"=1'-0"

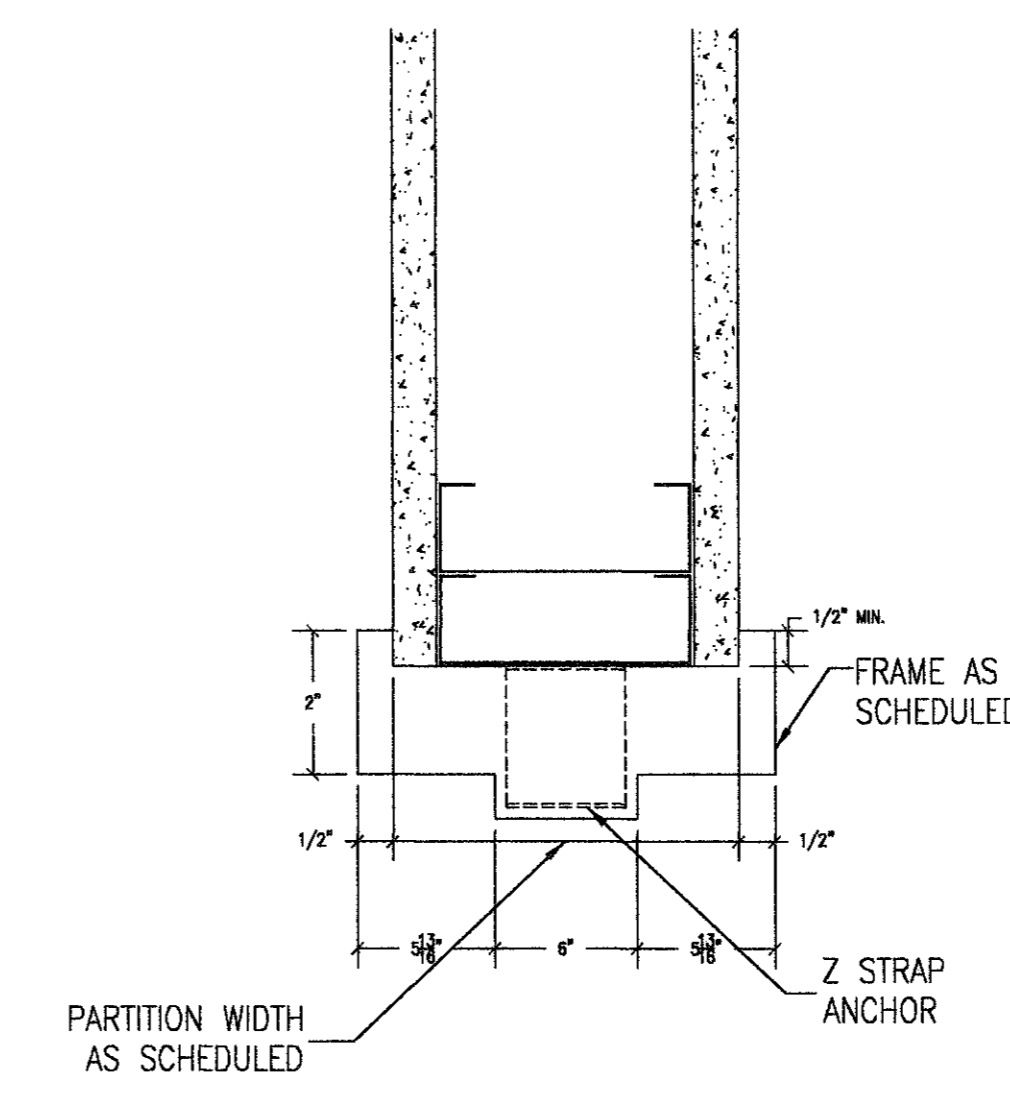

**02 HEAD DETAIL FRAME TYPE 1**  
 (A2.801) 1'-1/2"=1'-0"

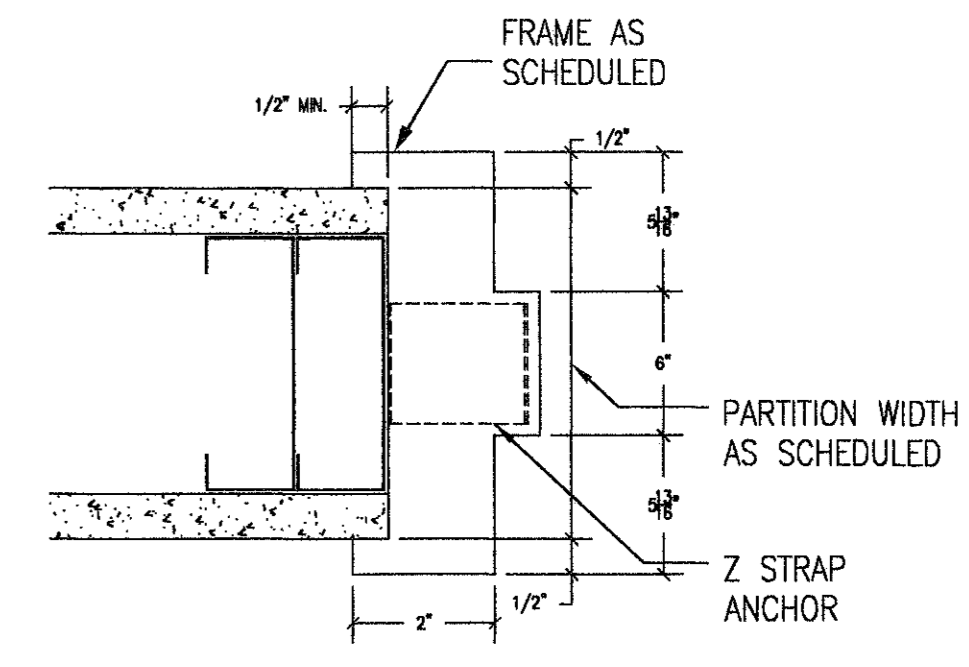


**01 JAMB DETAIL FRAME TYPE 1**  
 (A2.801) 1'-1/2"=1'-0"

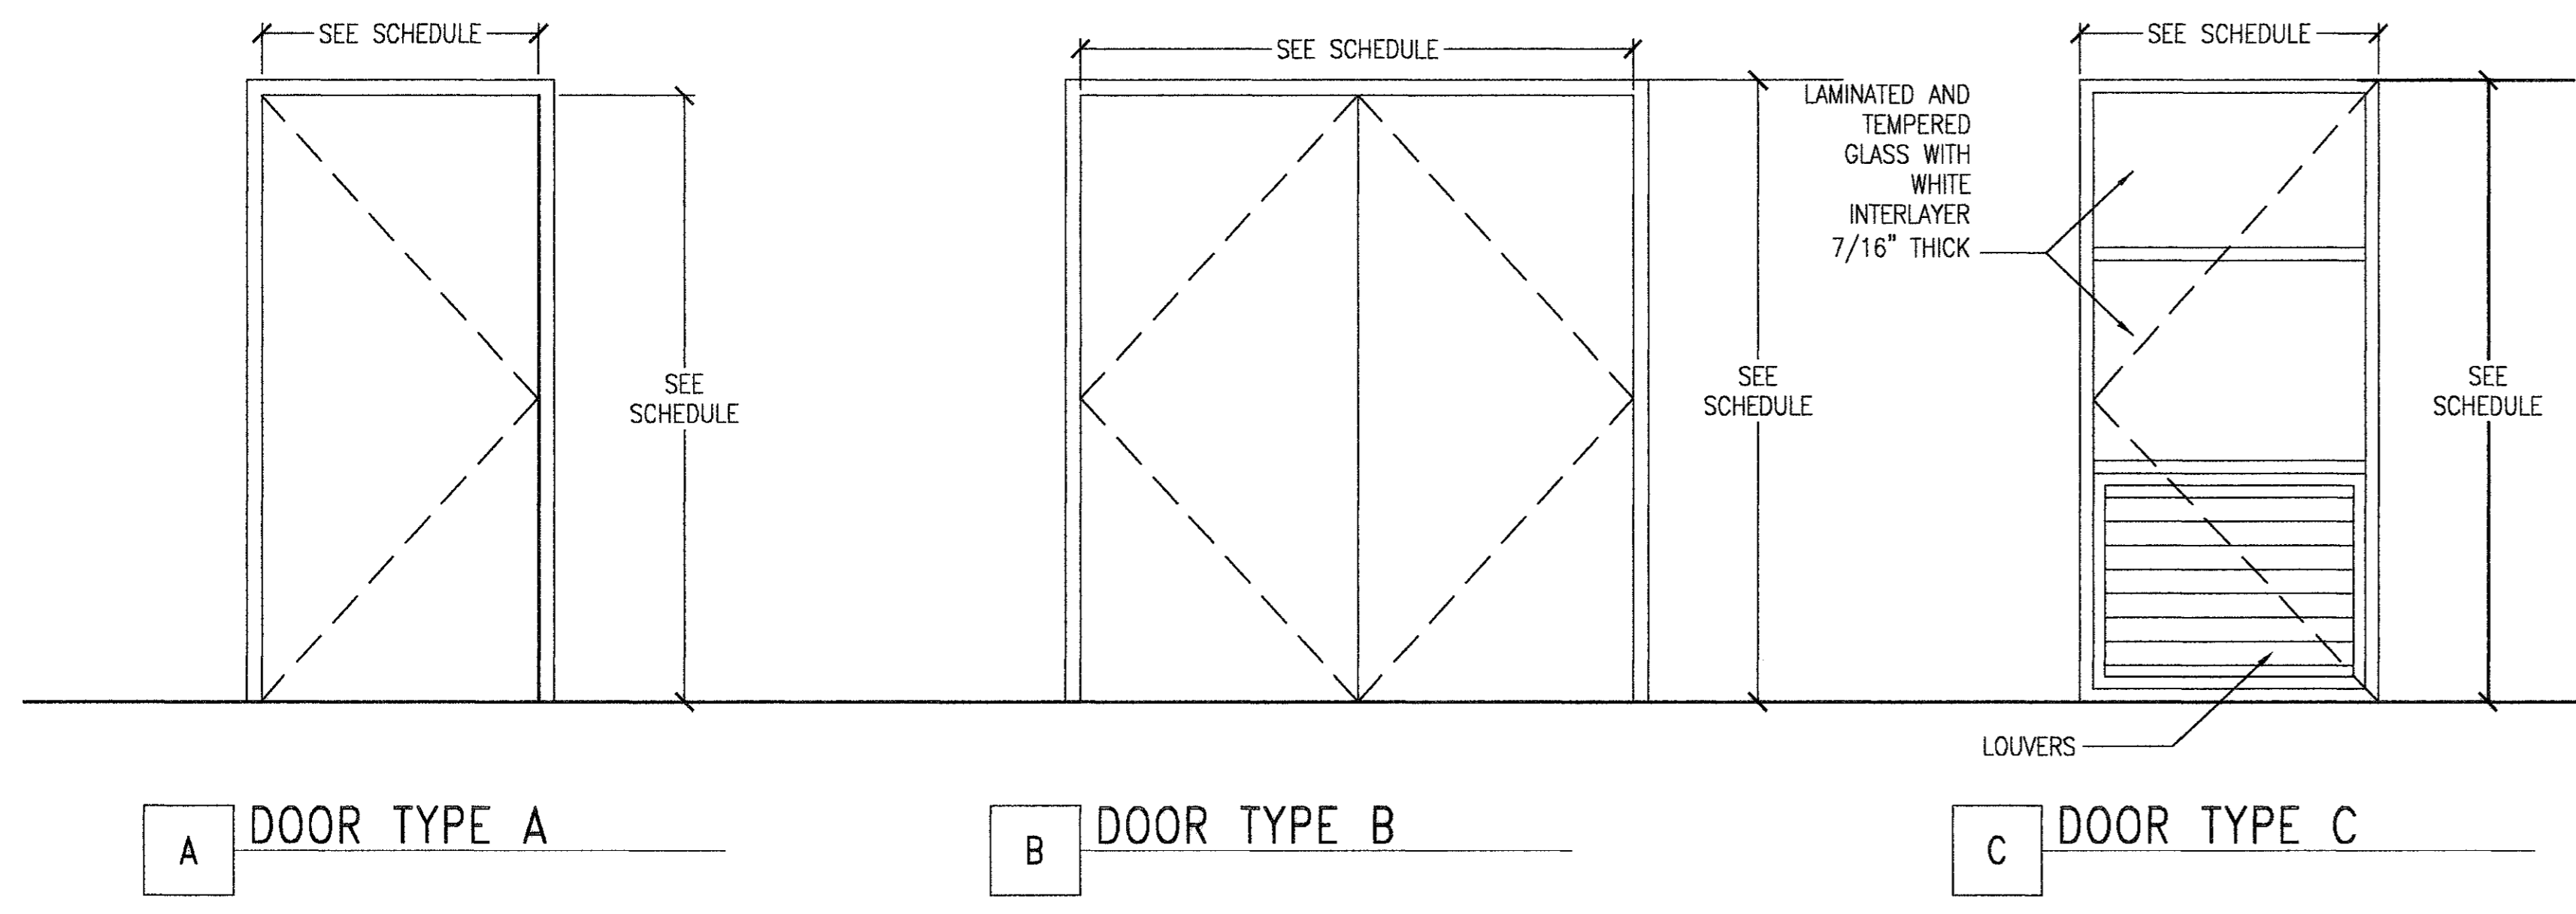

**A DOOR TYPE A**

**B DOOR TYPE B**


**C DOOR TYPE C**

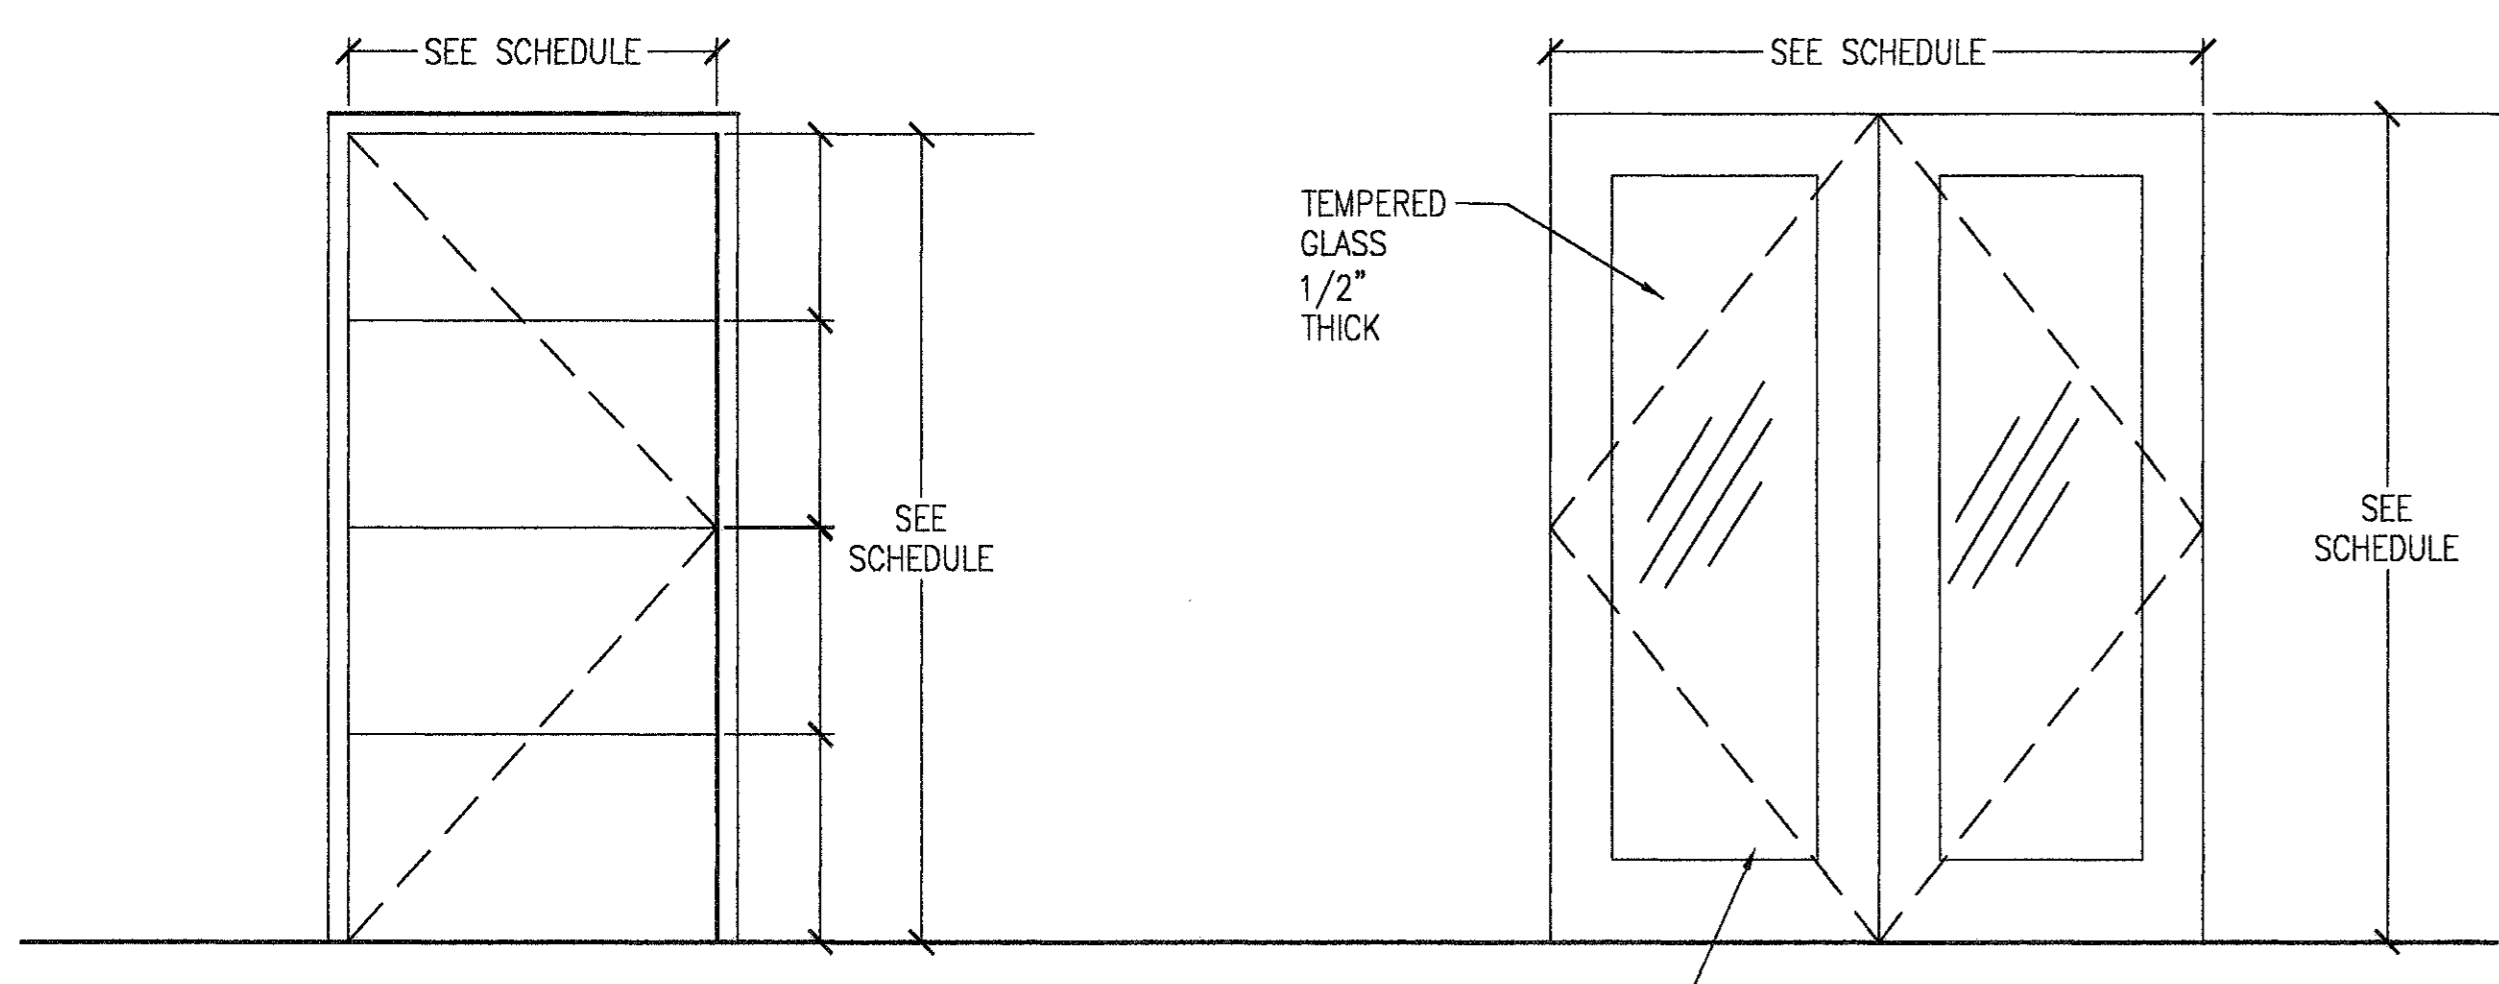

**D DOOR TYPE D**

**E DOOR TYPE E**

GLASS PANEL DIMENSIONS TO MATCH SIMILAR EXISTING DOOR PANELS AT STATION C

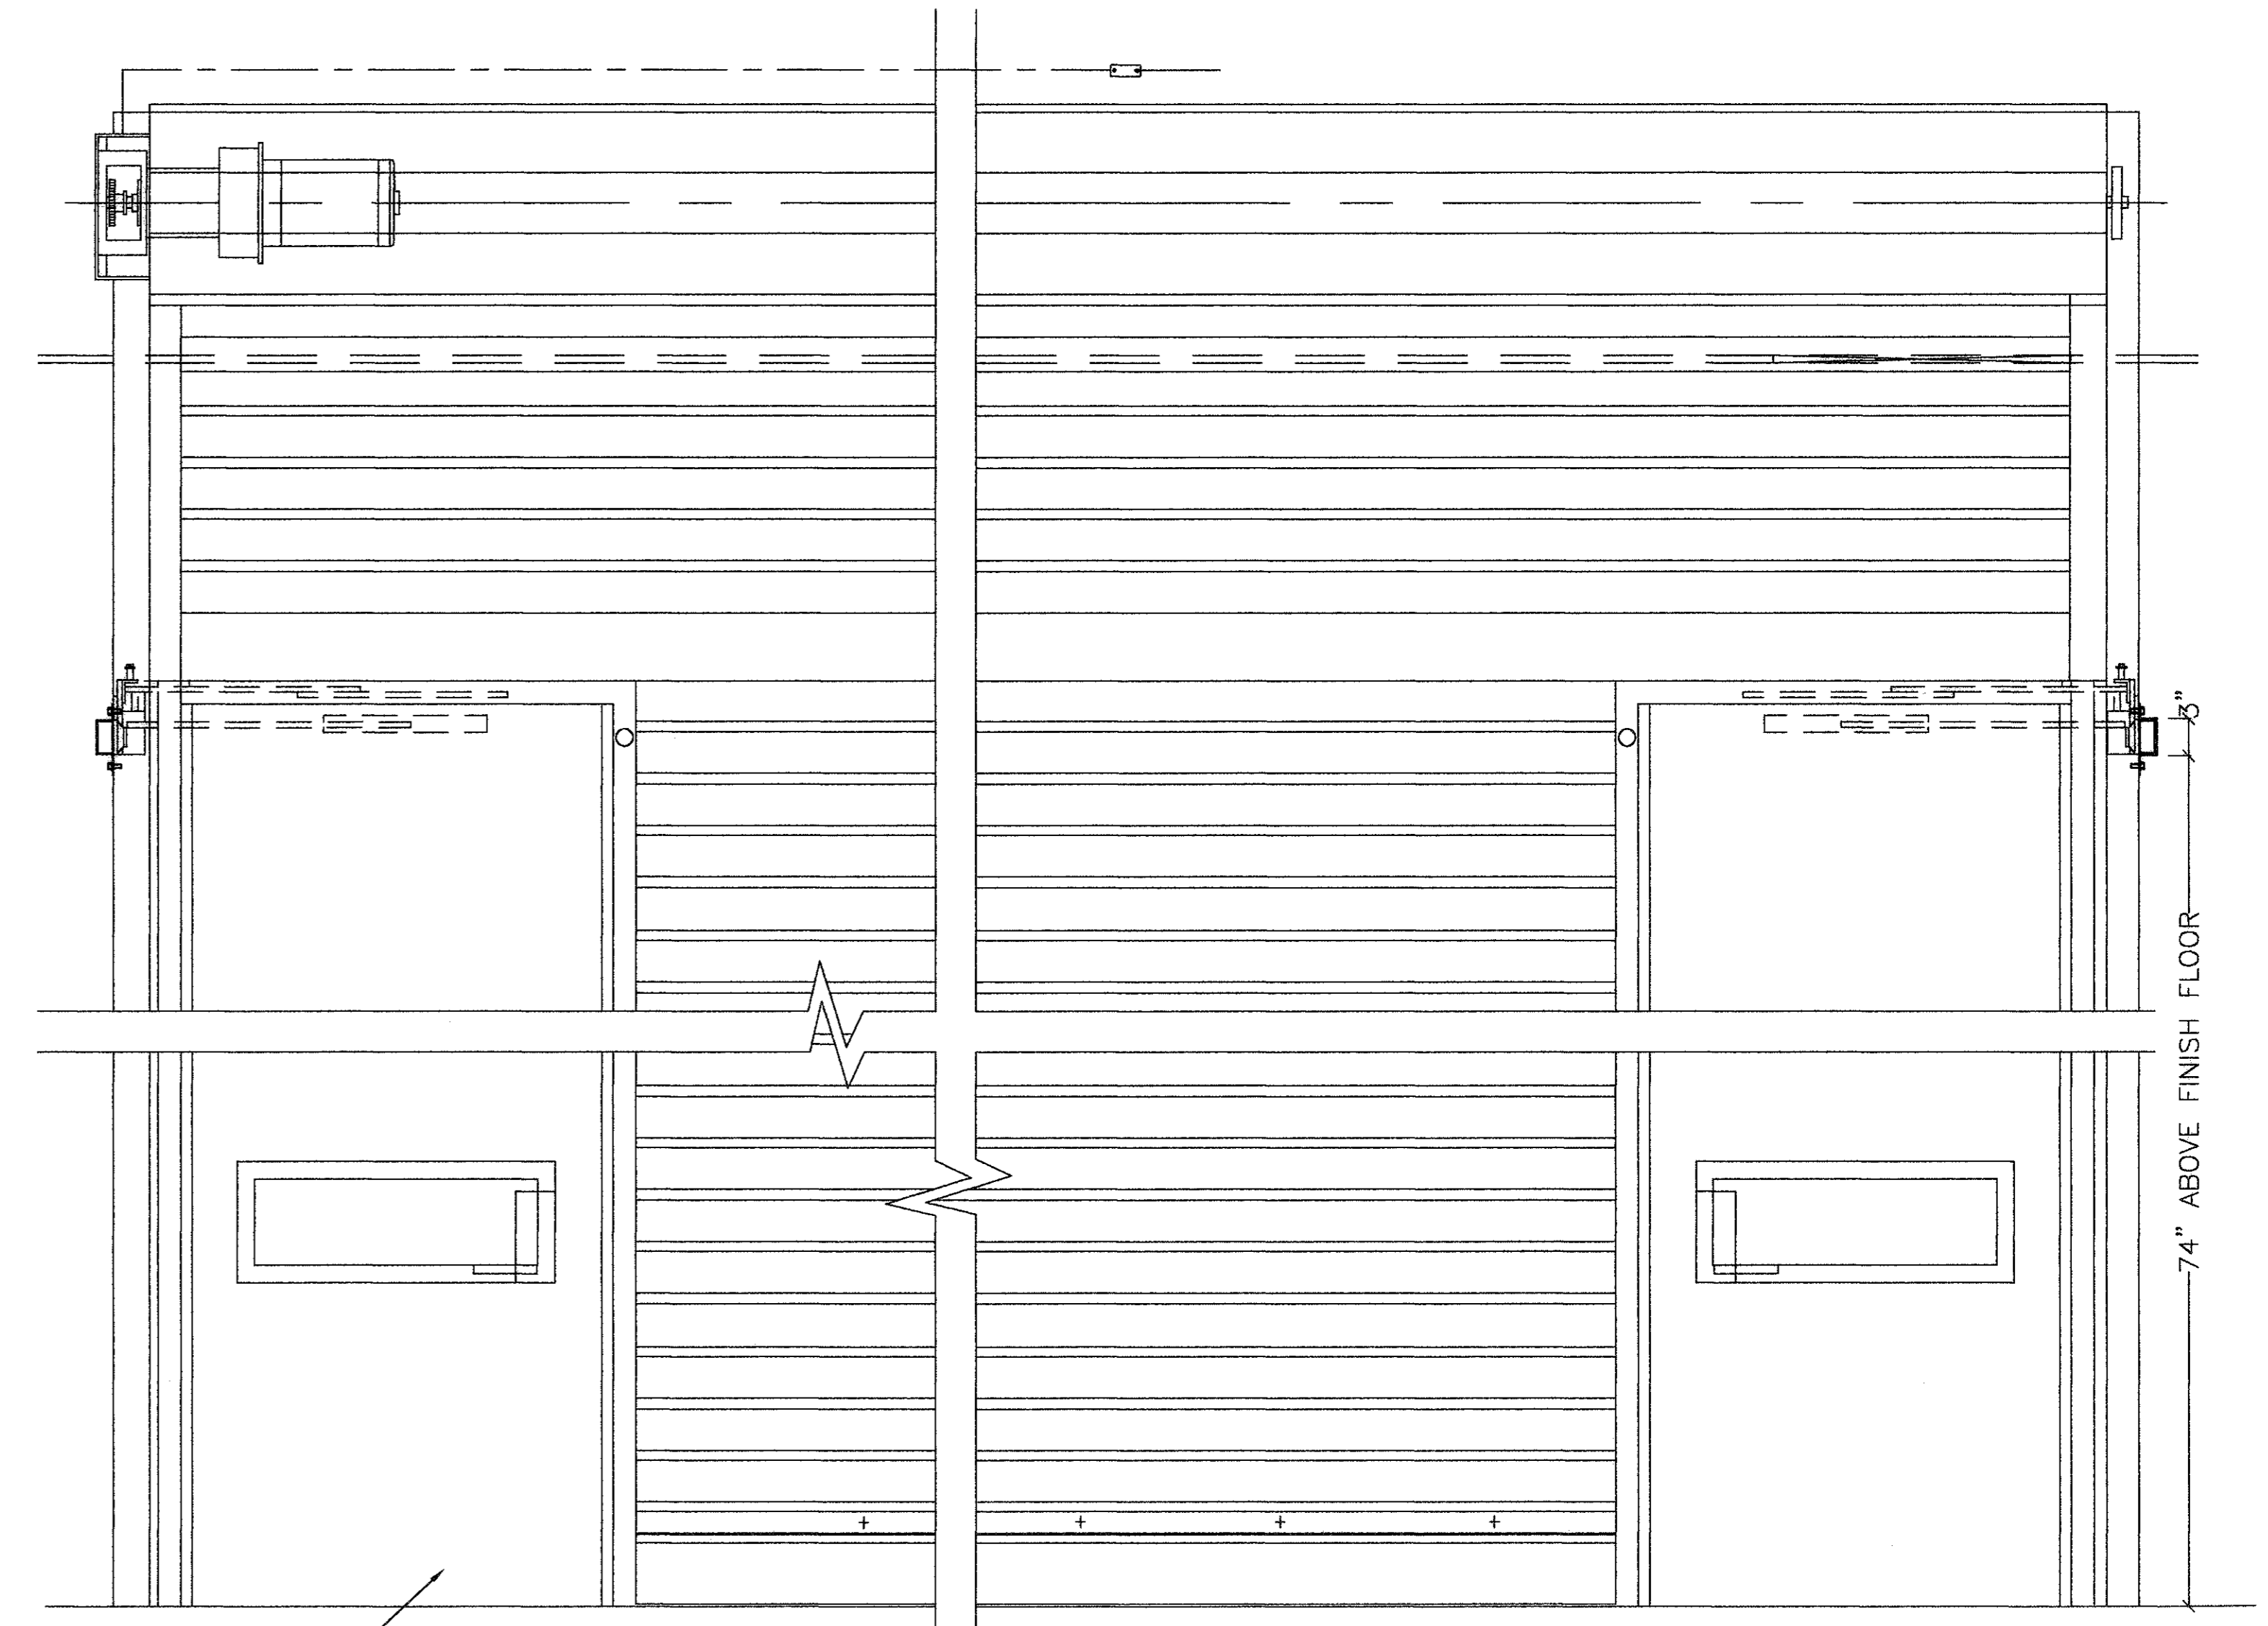


**F DOOR TYPE F**  
 2 HR RATING

**06 DOOR TYPES**  
 (A2.801) 1"=1'-0"

INTERNATIONAL SERVICES • EXPANSION • PROGRAM  
**APM STATION + PLATFORM**  
 DOOR TYPES AND DETAILS

PROJECT MGR: HEM  
 DESIGNER: SG  
 DRAWN BY: SEM  
 CHECKED BY: AB  
 DRAWING STANDARD: ISEP 07.20.2000  
 SCALE: NTS  
 DATE: 09/14/01

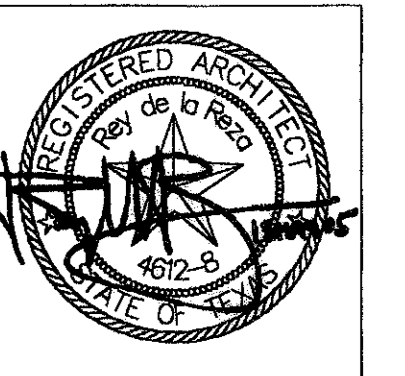

APPROVED BY: DATE:  
 DIRECTOR  
 HOUSTON AIRPORT SYSTEM

PROJECT NO. 1140  
 C.I.P. NO. A-0354  
 H.A.S. NO. 636C  
 SHEET NO. 15




**RECORD DRAWINGS**  
 DO NOT MODIFY  
 Rey de la Reza Architects, Inc.  
 13 May 2005


Note: Information used to develop these documents was taken from Record of the Work Drawings prepared by the construction contractor, Clark Construction Group - Texas. The information provided by the contractor was not verified by the design firm named above.

WINDOW AND GLASS SCHEDULE				
CURTAIN WALL NUMBER	TYPE OF FRAME	COLOR OF MULLIONS AND COVER	TYPE OF GLASS	REMARKS
CW-1A	F-1	COLOR# 2	GL-3	CUSTOM FRIT PATTERN ON GLASS
CW-1B	F-1	COLOR# 2	GL-3	CUSTOM FRIT PATTERN ON GLASS
CW-2A	F-1	COLOR# 2	GL-2	SILL MULLION TO FOLLOW ESCALATOR SLOPE
CW-2B	F-1	COLOR# 2	GL-2	SILL MULLION TO FOLLOW ESCALATOR SLOPE
CW-3	F-1	COLOR# 2	GL-2	TOP MULLIONS CURVED
CW-4	F-2	COLOR# 2	GL-1 AND GL-5	TOP MULLIONS CURVED
CW-5	F-3	COLOR# 2	GL-4	BUTT-GLAZED VERTICAL JOINTS CUSTOM EXTRUDED VERTICAL MULLIONS @ ANGLED CORNERS


REVISIONS		
NO.	DESCRIPTION	DATE
NO.	ISSUED FOR BID	10/19/01
1	ADDENDUM 1	02/01/02 SG
2	RECORD SET	05/13/05 EM

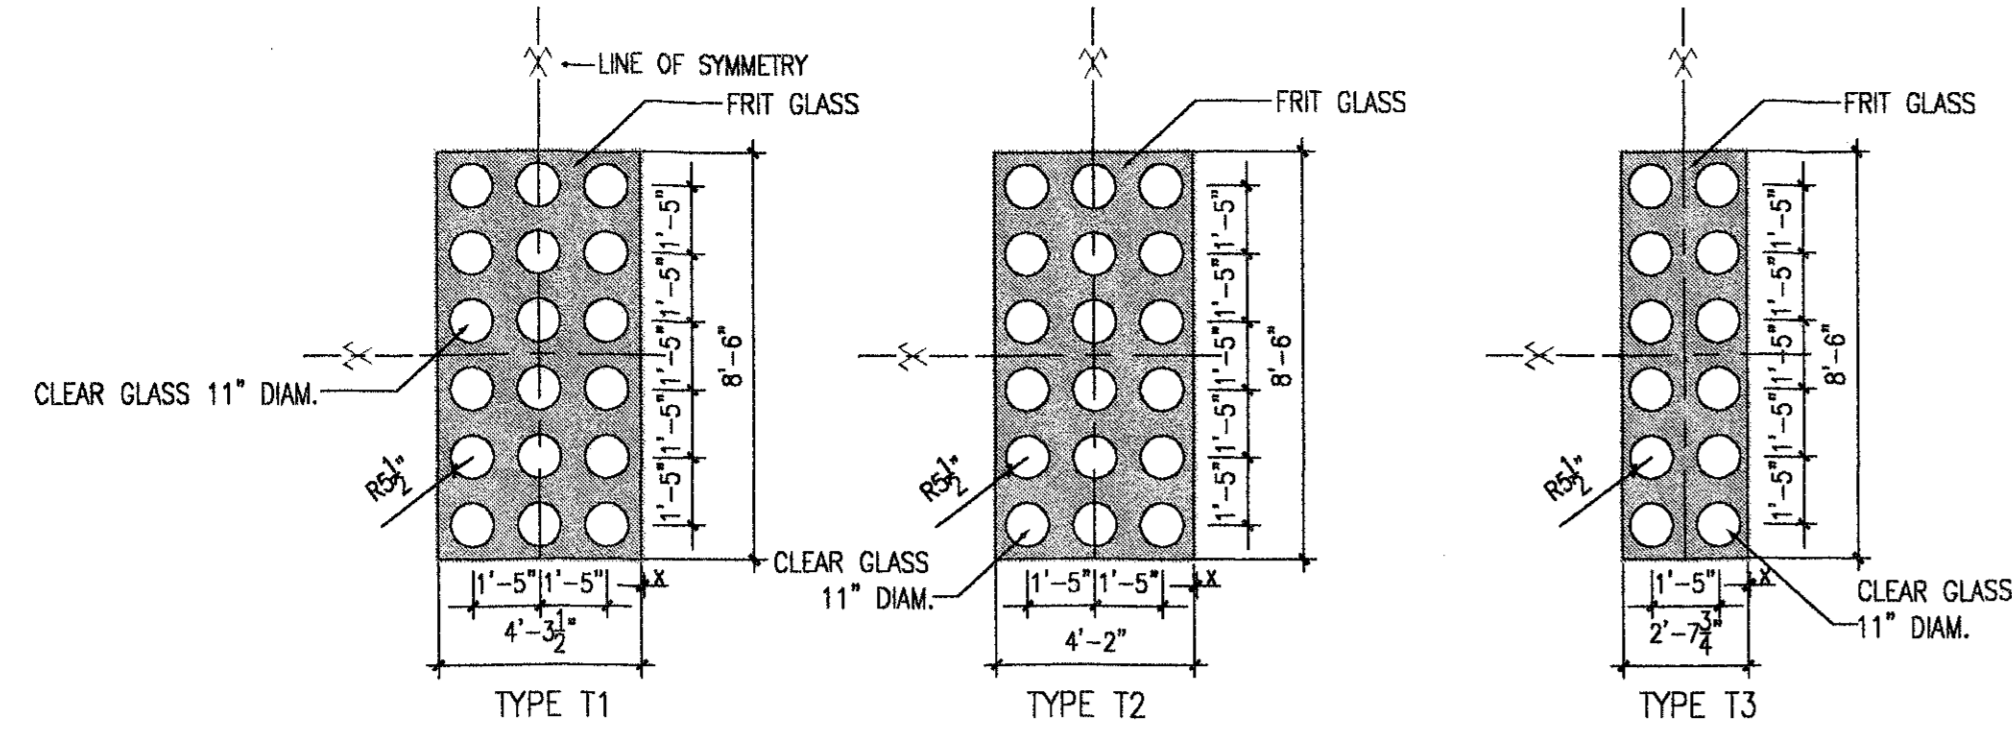

**FRIT GLASS @ CURTAIN WALLS**  
 CW-1A & CW-1B  
 06  
 A2.850 1/4"=1'-0"

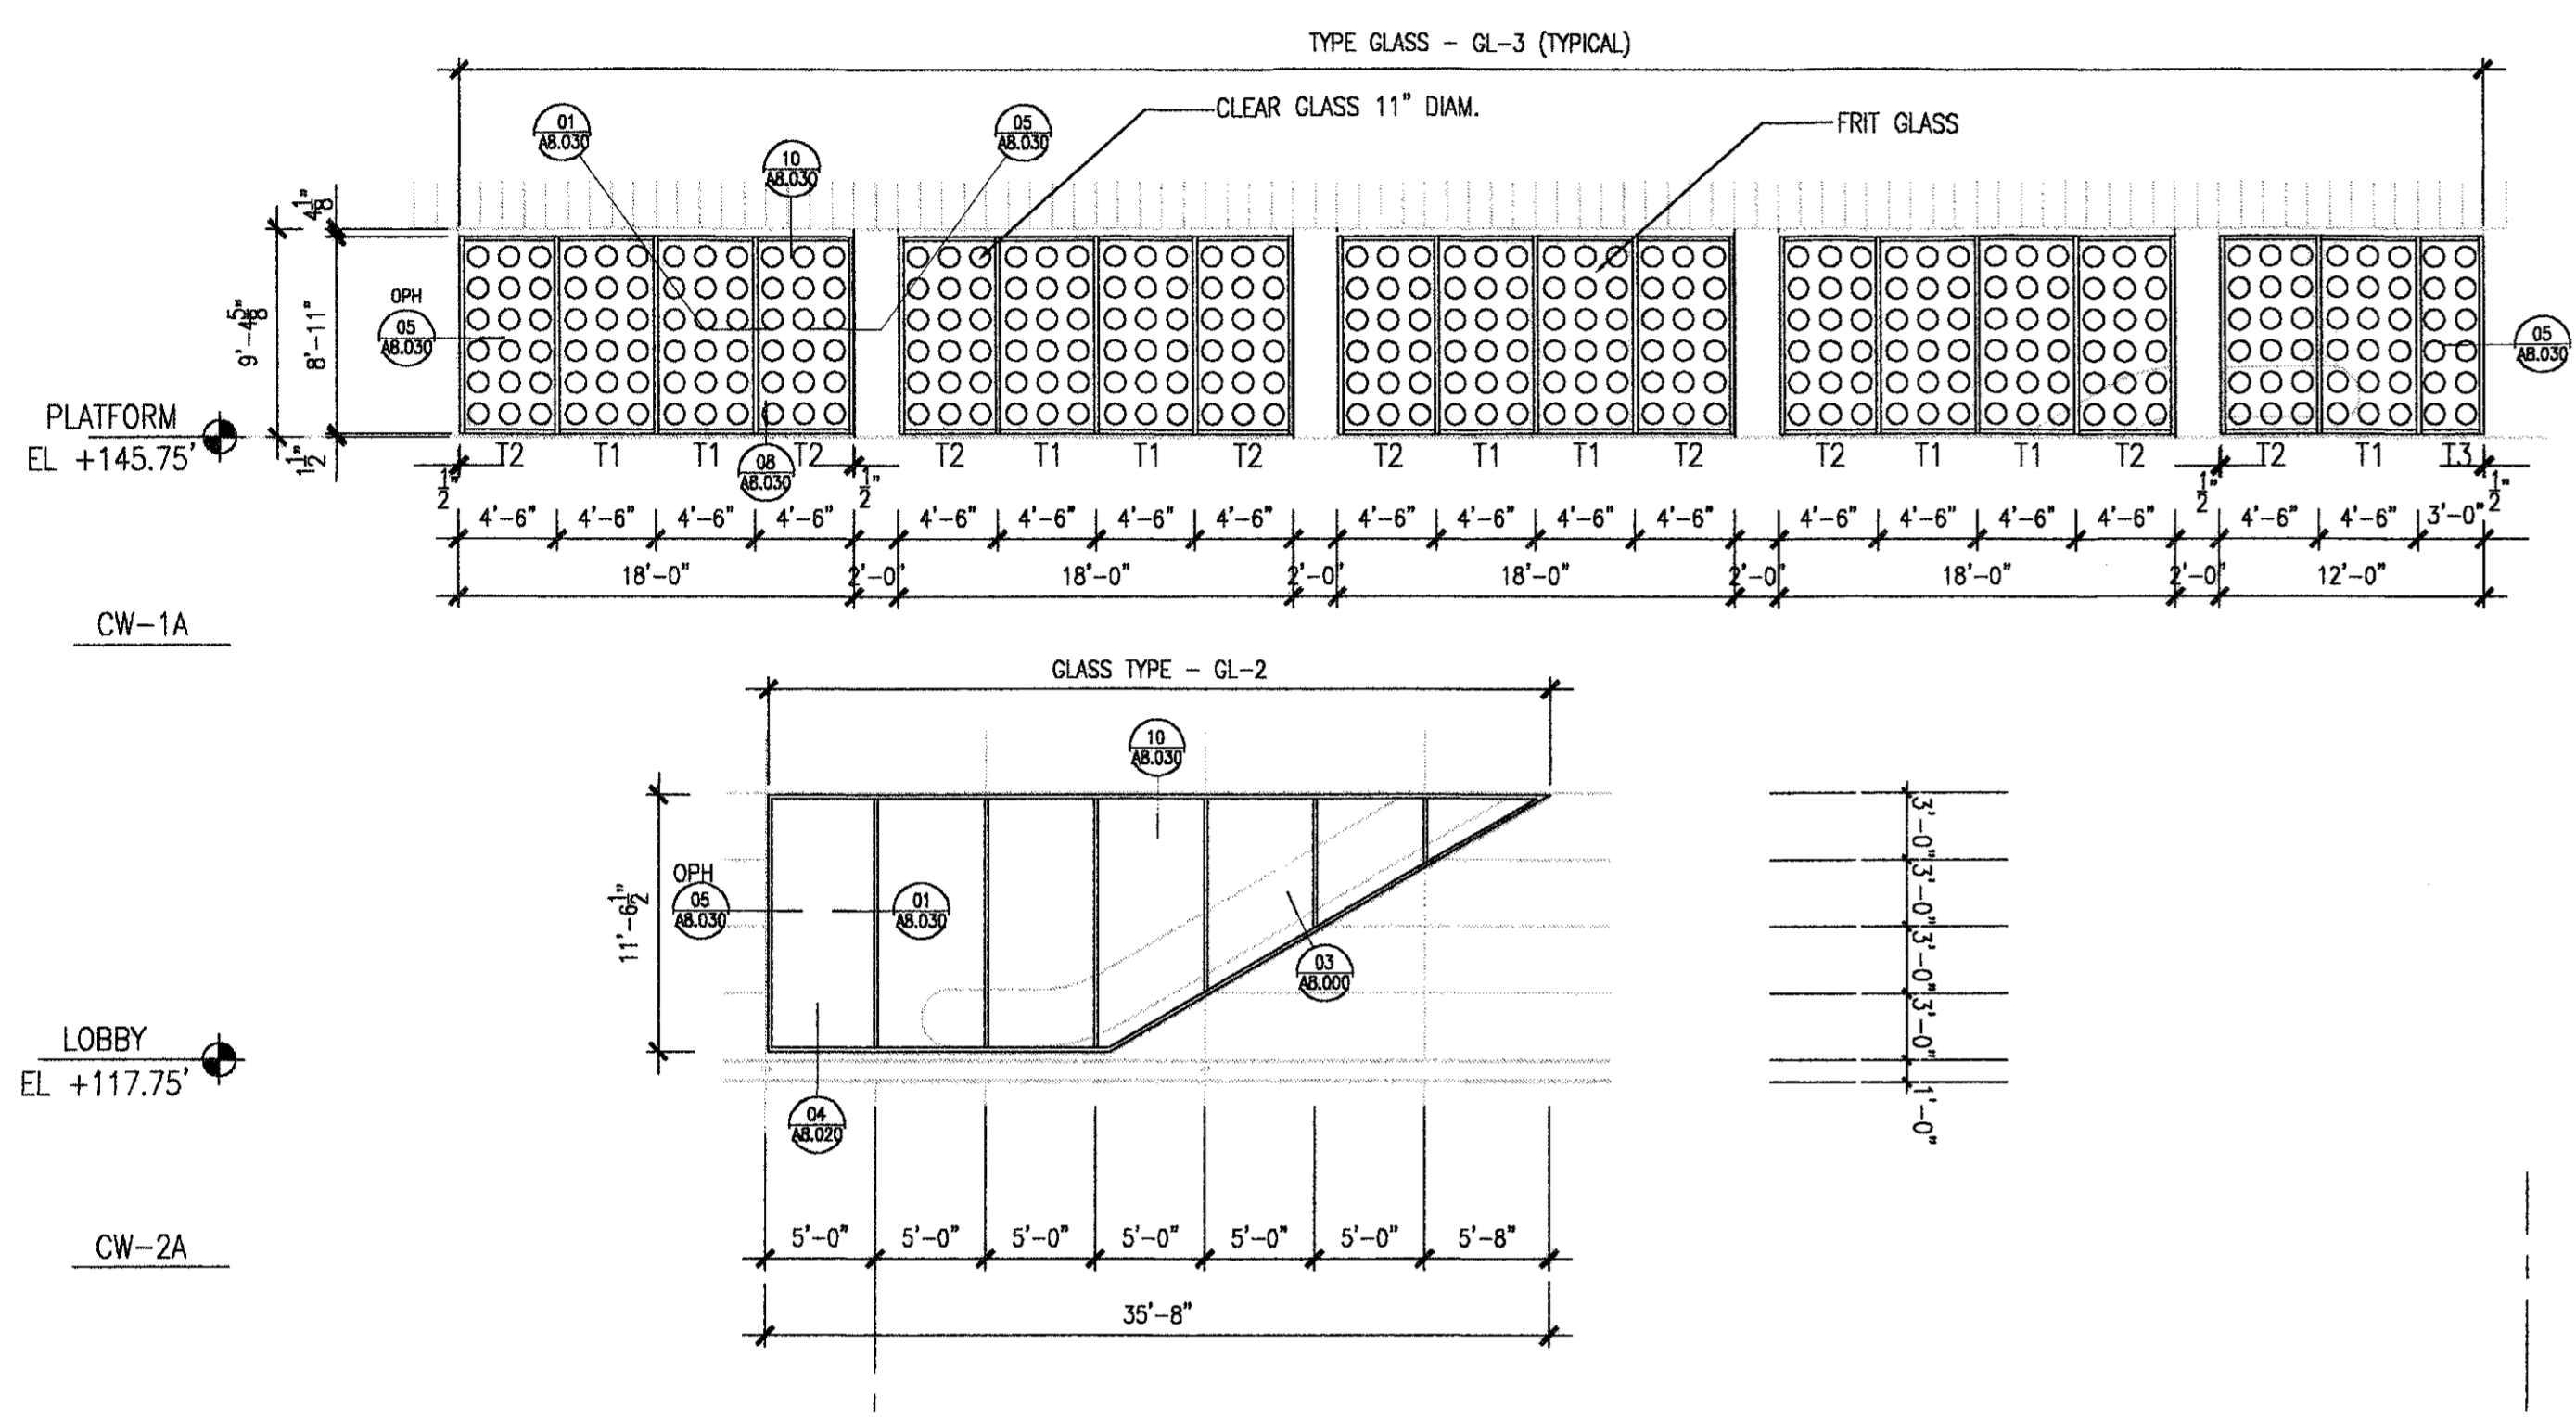

**SOUTH CURTAIN WALLS**  
 CW-1A & CW-2A  
 03  
 A2.850 1/8"=1'-0"

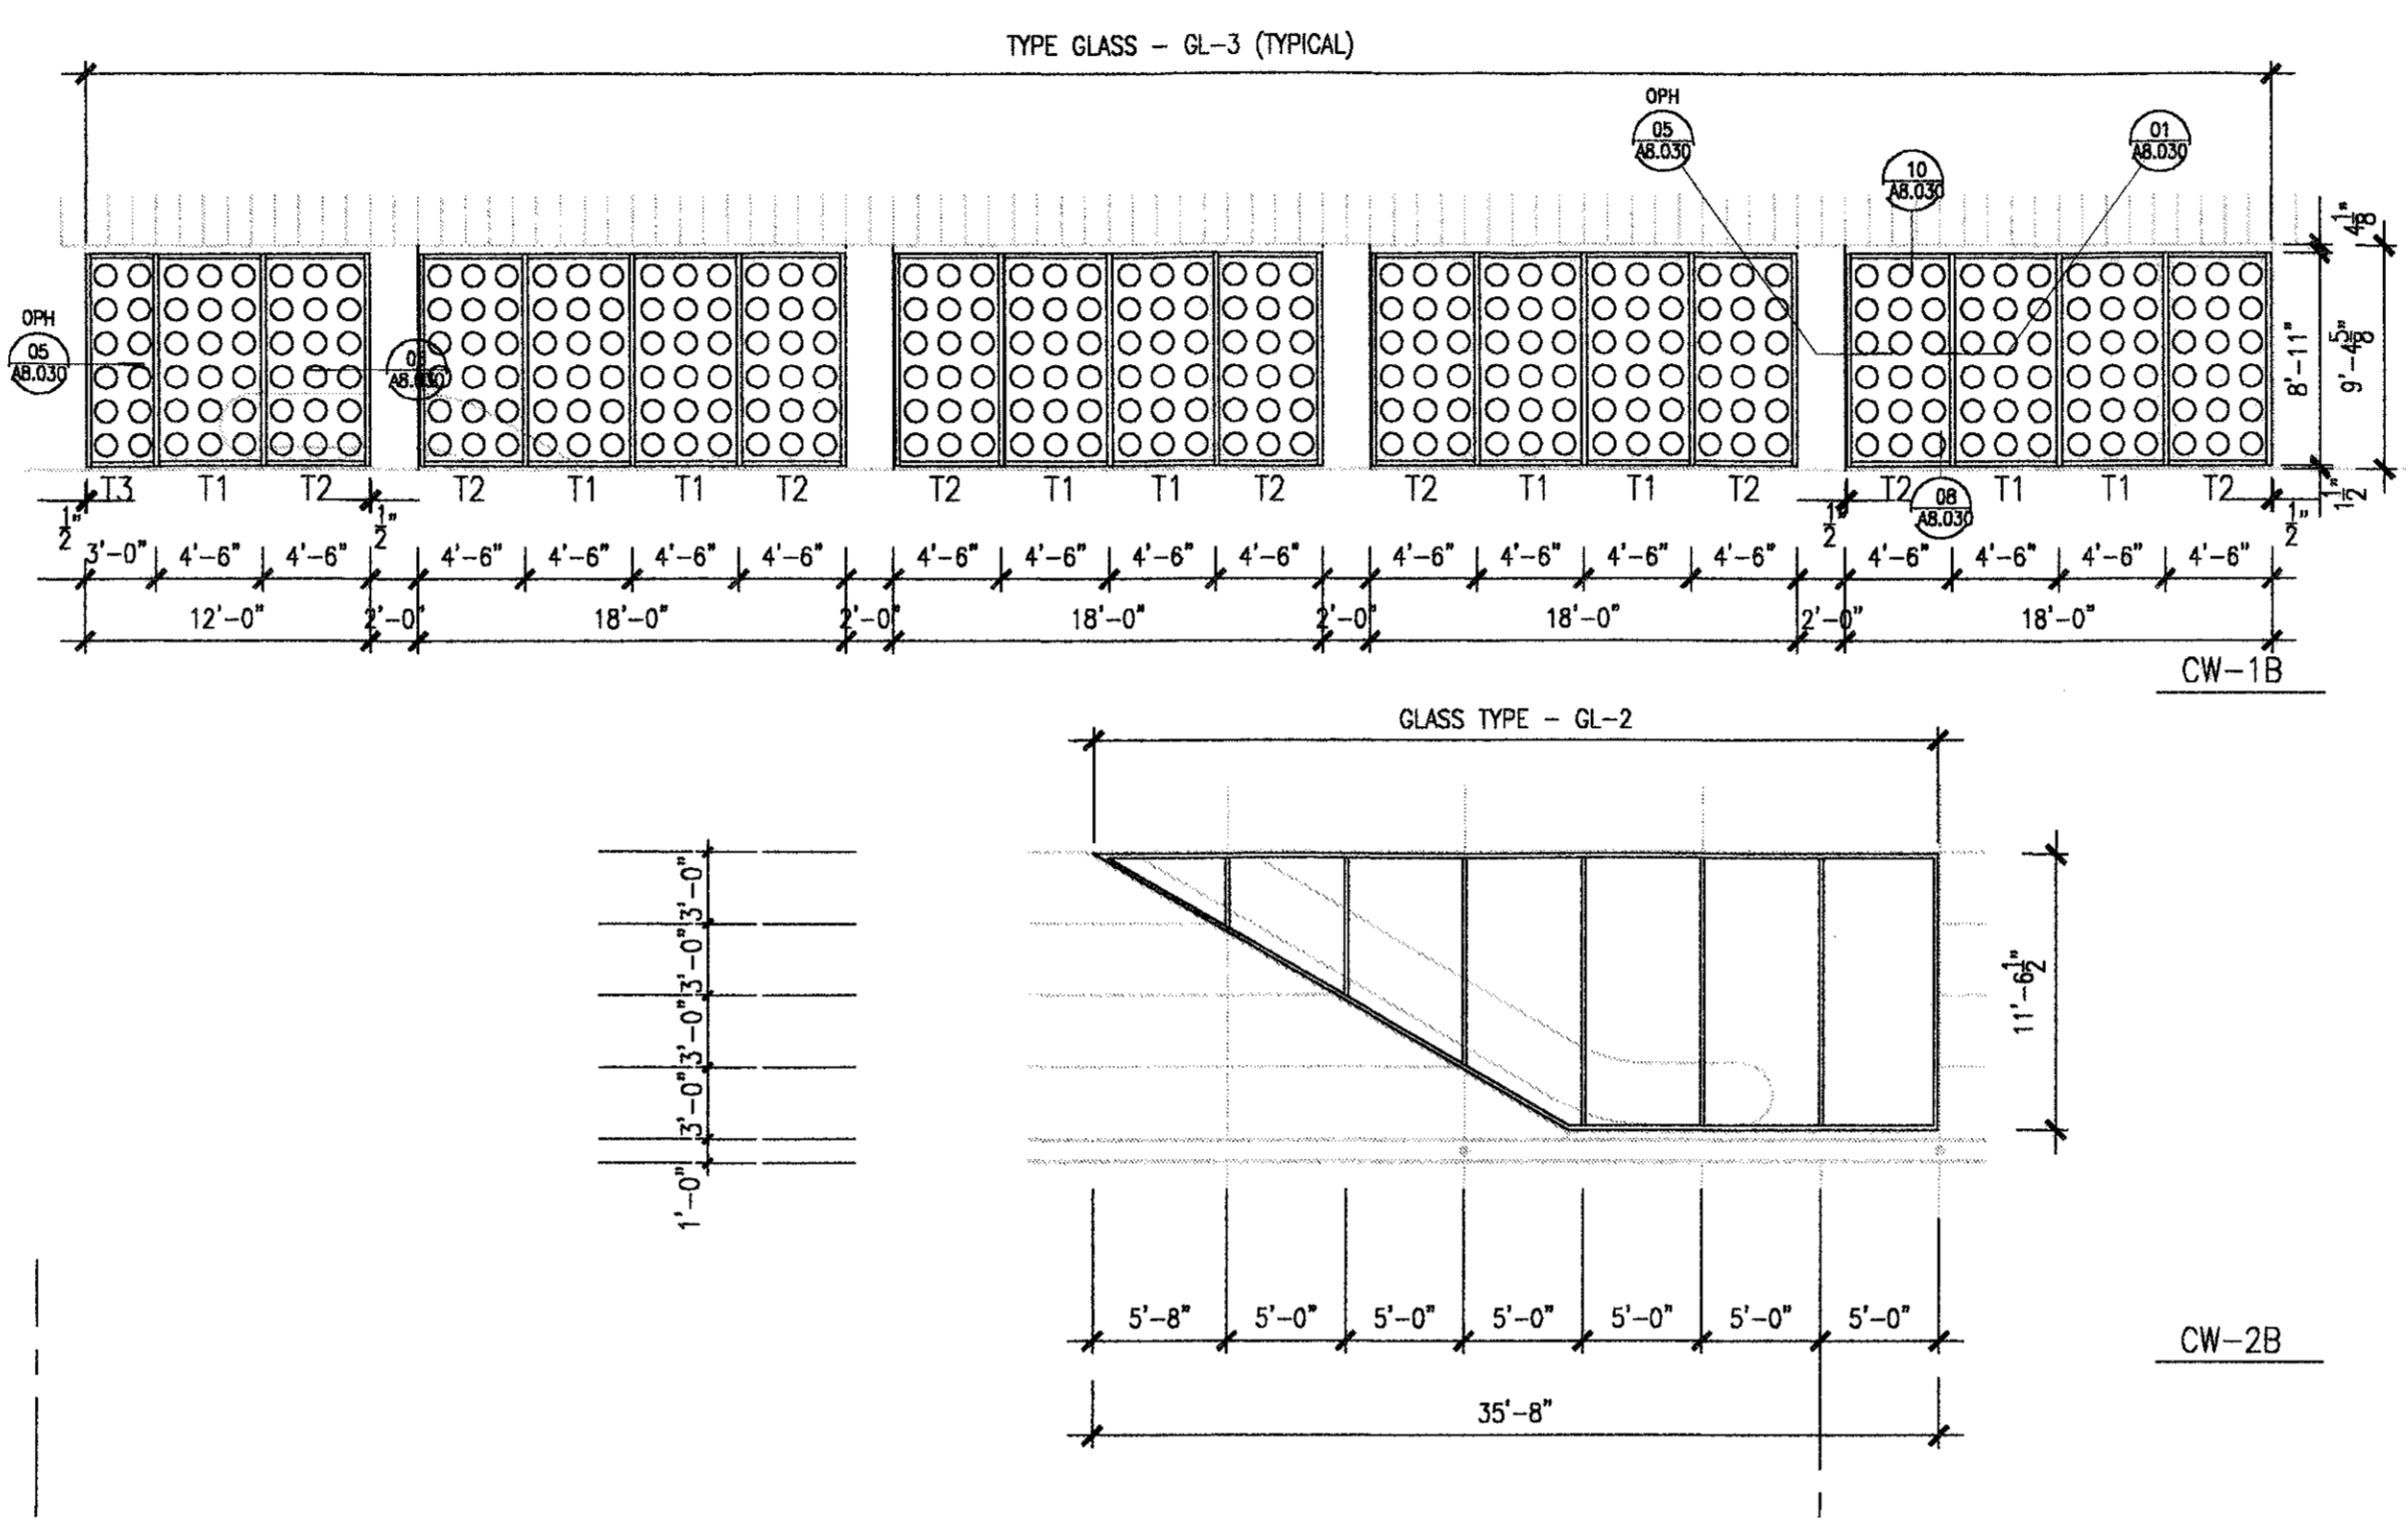

**NORTH CURTAIN WALLS**  
 CW-1B & CW-2B  
 02  
 A2.850 1/8"=1'-0"

**LEGEND:**

**TYPE OF FRAME**

F-1 2 1/2" x 7 1/2" ALUMINUM HORIZONTAL AND VERTICAL MULLIONS - 1600 WALL SYSTEM 1 BY KAWNEER OR EQUAL - POWDERCOATED FINISH - SILVER/PEWTER METALIC COLOR - STEEL REINFORCEMENT AS REQUIRED FOR WIND LOADS

F-2 2 1/2" x 10 1/2" VERTICAL ALUMINUM MULLIONS WITH STEEL REINFORCEMENT - STEEL REINFORCEMENT AS REQUIRED FOR WIND LOADS  
2 1/2" x 7 1/2" HORIZONTAL ALUMINUM MULLIONS - SILVER/PEWTER METALIC COLOR  
1600 WALL SYSTEM 1 BY KAWNEER OR EQUAL - POWDERCOAT FINISH - SILVER/PEWTER METALIC COLOR

F-3 2 1/2" x 6 1/2" ALUMINUM HORIZONTAL AND VERTICAL MULLIONS - CW-250 CURTAIN WALL SYSTEM BY VISTAWALL OR EQUAL: CUSTOM BUTT - GLAZING @ VERTICAL JOINTS, CUSTOM EXTRUDED MULLIONS @ ANGLED CORNERS

**TYPE OF GLASS**

GL-1 1" INSULATING GLASS - LOW E: 1/4" TEMPERED GRAY EXTERIOR LITE, 1/2" AIR SPACE, 1/4" TEMPERED INTERIOR CLEAR LITE - VIRACON VE3-2M OR EQUAL

GL-2 1" INSULATING GLASS - 1/4" TEMPERED CLEAR LITE, 1/2" AIR SPACE, 1/4" TEMPERED CLEAR LITE

GL-3 1" INSULATING GLASS - 1/4" TEMPERED CLEAR EXTERIOR LITE WITH ENCAPSULATED FRIT PATTERN ON INSIDE FACE, 1/2" AIR SPACE, 1/4" TEMPERED CLEAR INTERIOR LITE. CUSTOM COLOR FOR FRIT TO BE SELECTED.


GL-4 7/16" LAMINATED/PATTERNED GLASS - TWO (2) LAYERS/LITES 3/16" CLEAR FLOAT GLASS LAMINATED OVER A .03 INCH THICK (MIN.) PVB INTER-LAYER SHEET MATERIAL. GLASS LITES TO BE HEAT STRENGTHENED INDEPENDENTLY PRIOR TO LAMINATING COMPLYING WITH MANUFACTURERS STANDARDS. PVB INTER-LAYER LAMINATE: SINGLE SHEET MATERIAL CONSISTING OF INTEGRAL TRANSLUCENT SILVER METALLIC CIRCULAR SHAPES (DOTS) DISPLACED UNIFORMLY WITHIN A CLEAR BACKGROUND. COMPOSITE LAMINATED GLASS PANEL(S) SYSTEM PROVIDES FOR THE DIFFUSION (TRANSMITTING) OF LIGHT IN THE PERCENTAGES INDICATED ON THE DRAWINGS. HIGHEST DENSITY AT THE BOTTOM TO LOWEST DENSITY AT THE TOP. REFERENCE SPECIFICATIONS AND ARCHITECTS SAMPLES.

GL-5 1" INSULATING GLASS - 1/4" TEMPERED CLEAR EXTERIOR LITE, 1/2" AIR SPACE, 1/4" TEMPERED BLUE GLASS INTERIOR LITE, VERSALUX BLUE 2000 BY VIRACON OR EQUAL


**GENERAL NOTES**

- DIMENSIONS OF ALL CURTAIN WALLS TO BE FIELD VERIFIED
- PROVIDE MOCK-UP 24" x 24" SAMPLE OF EACH CURTAIN WALL SYSTEM SHOWING CONNECTION BETWEEN HORIZONTAL AND VERTICAL MULLIONS WITH THE APPROVED COLOR FINISH
- PROVIDE 12"x12" SAMPLE OF EACH GLASS TYPE
- PROVIDE 24"x24" SAMPLE OF GLASS TYPE GL-3
- SAMPLE SIZES AND MOCK-UPS IN THESE NOTES SUPERCEDED THE SPECIFICATIONS. OTHER REQUIREMENTS OF THE SPECIFICATIONS SHALL NOT BE AFFECTED BY THESE NOTES


**01 WINDOW SCHEDULE**  
 A2.850

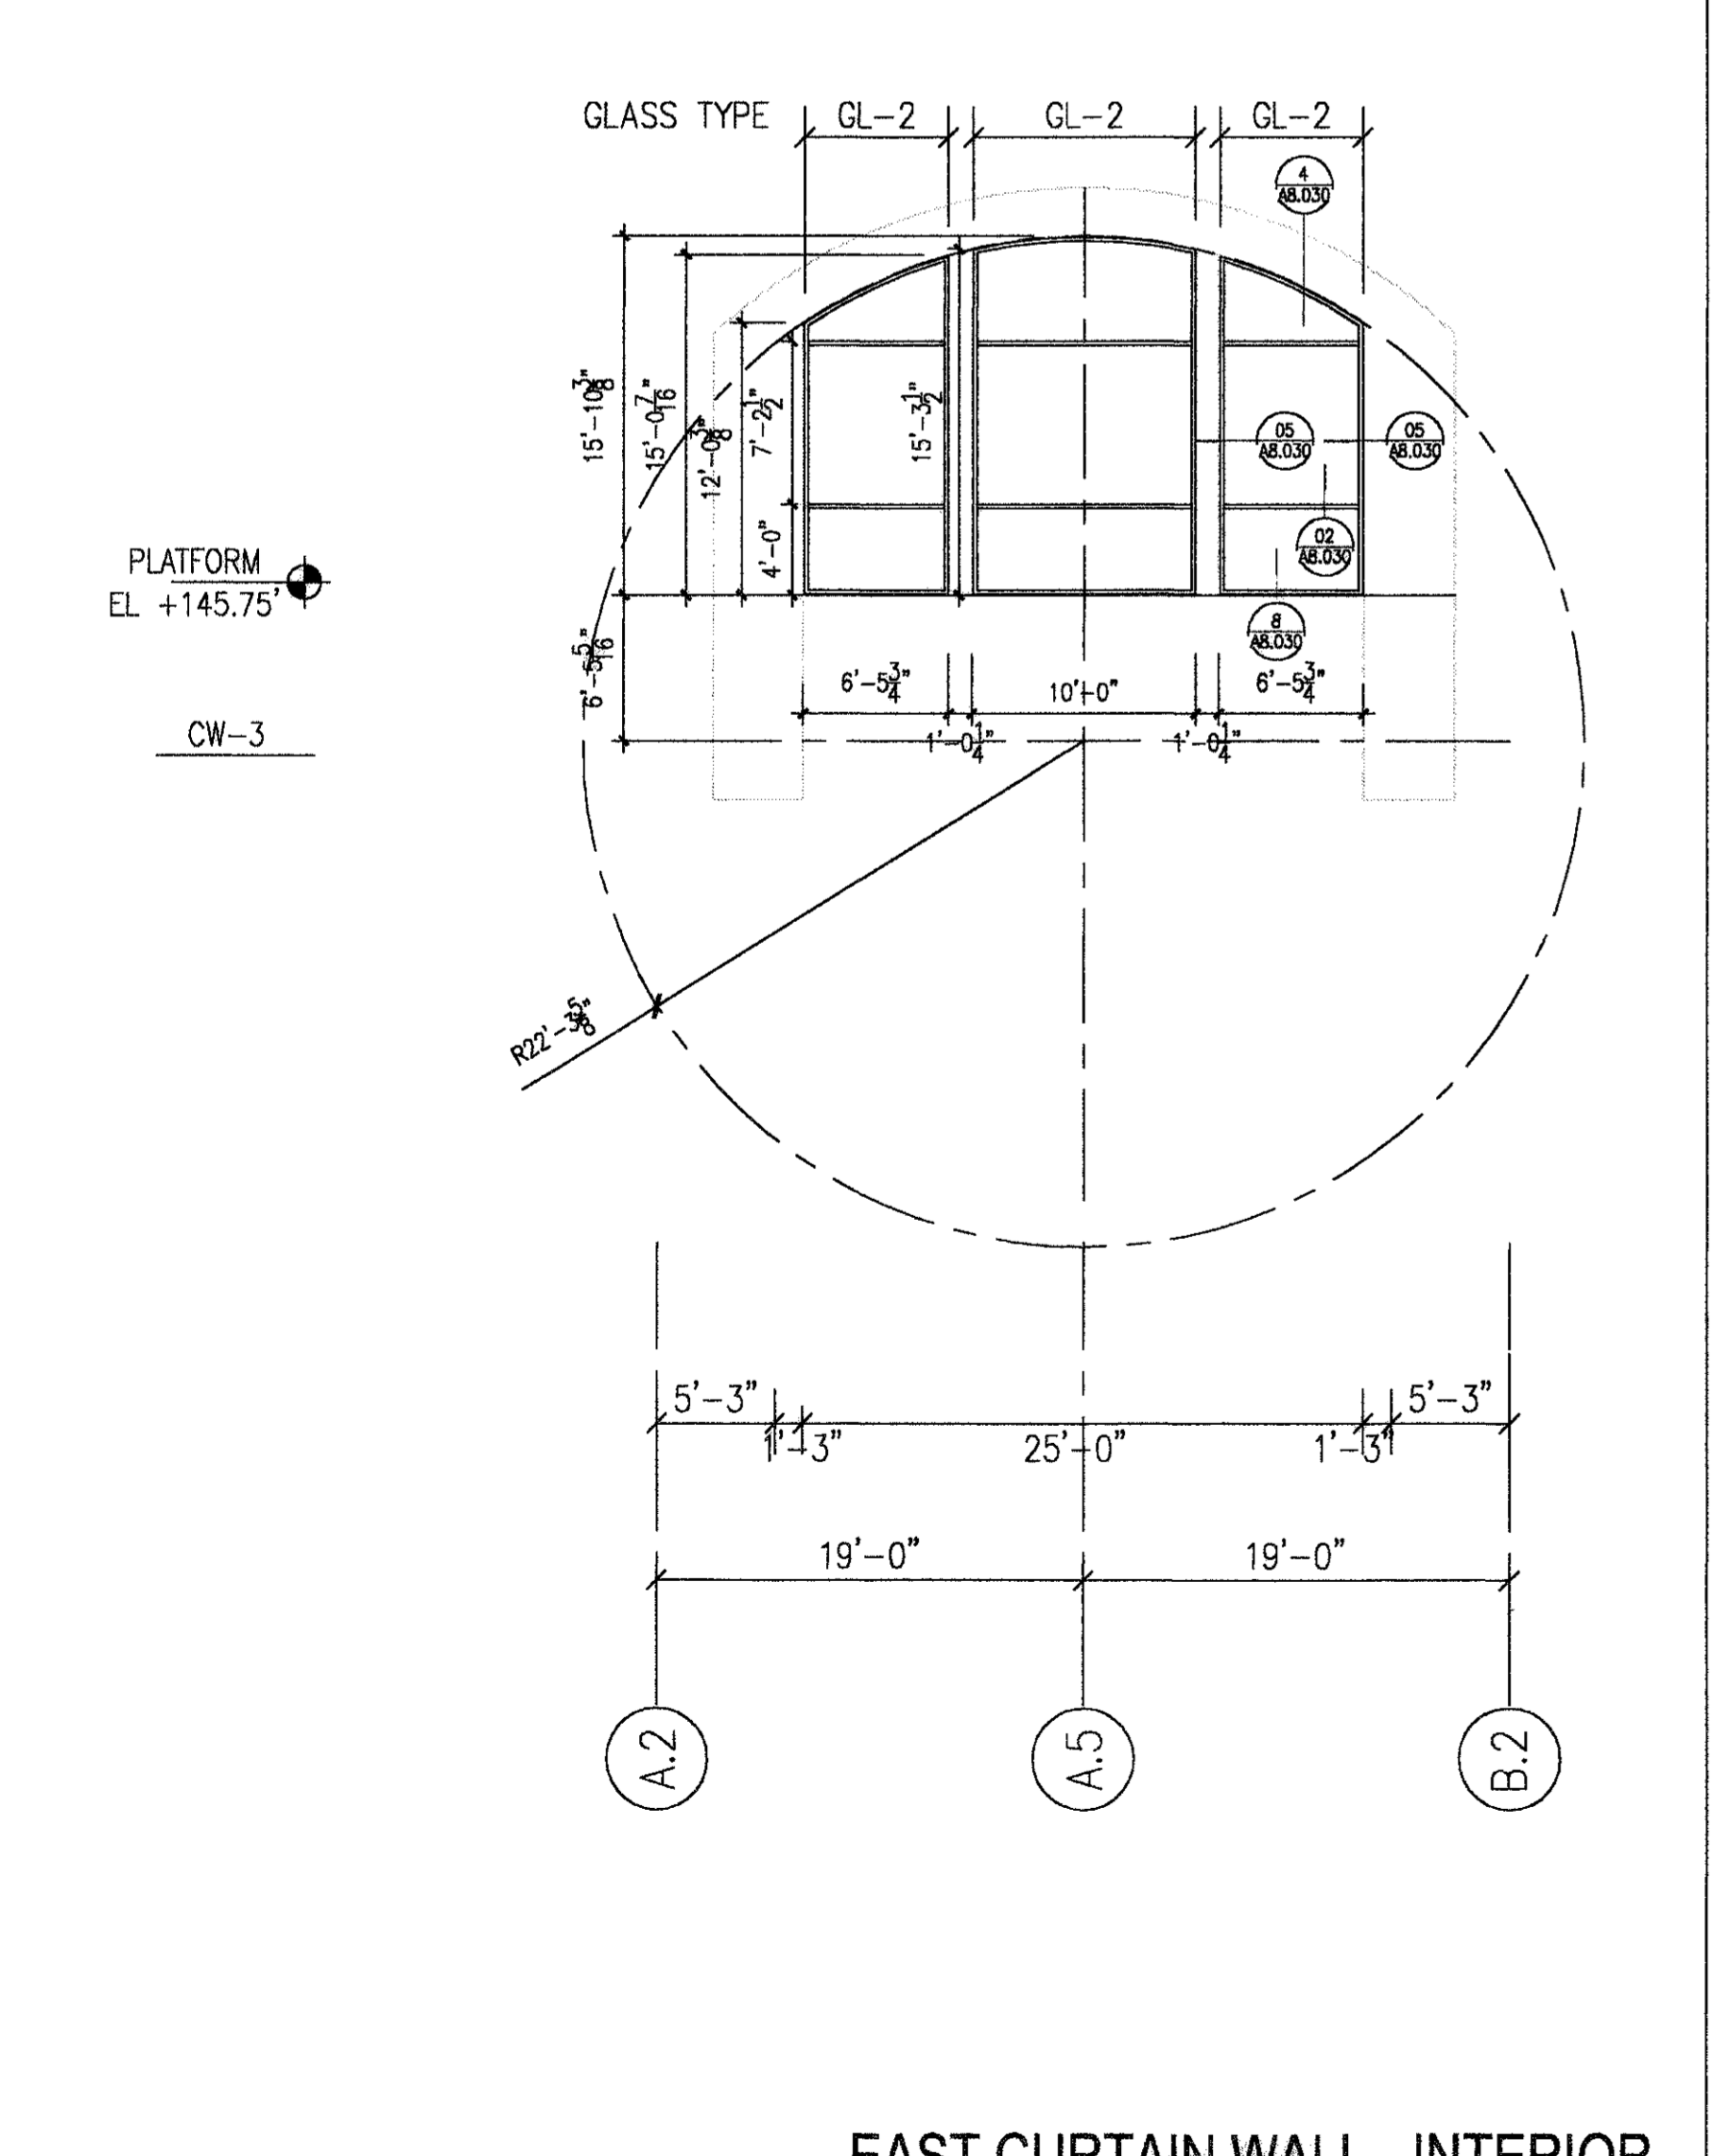

**EAST CURTAIN WALL - INTERIOR**  
 CW-3  
 06  
 A2.850 1/8"=1'-0"

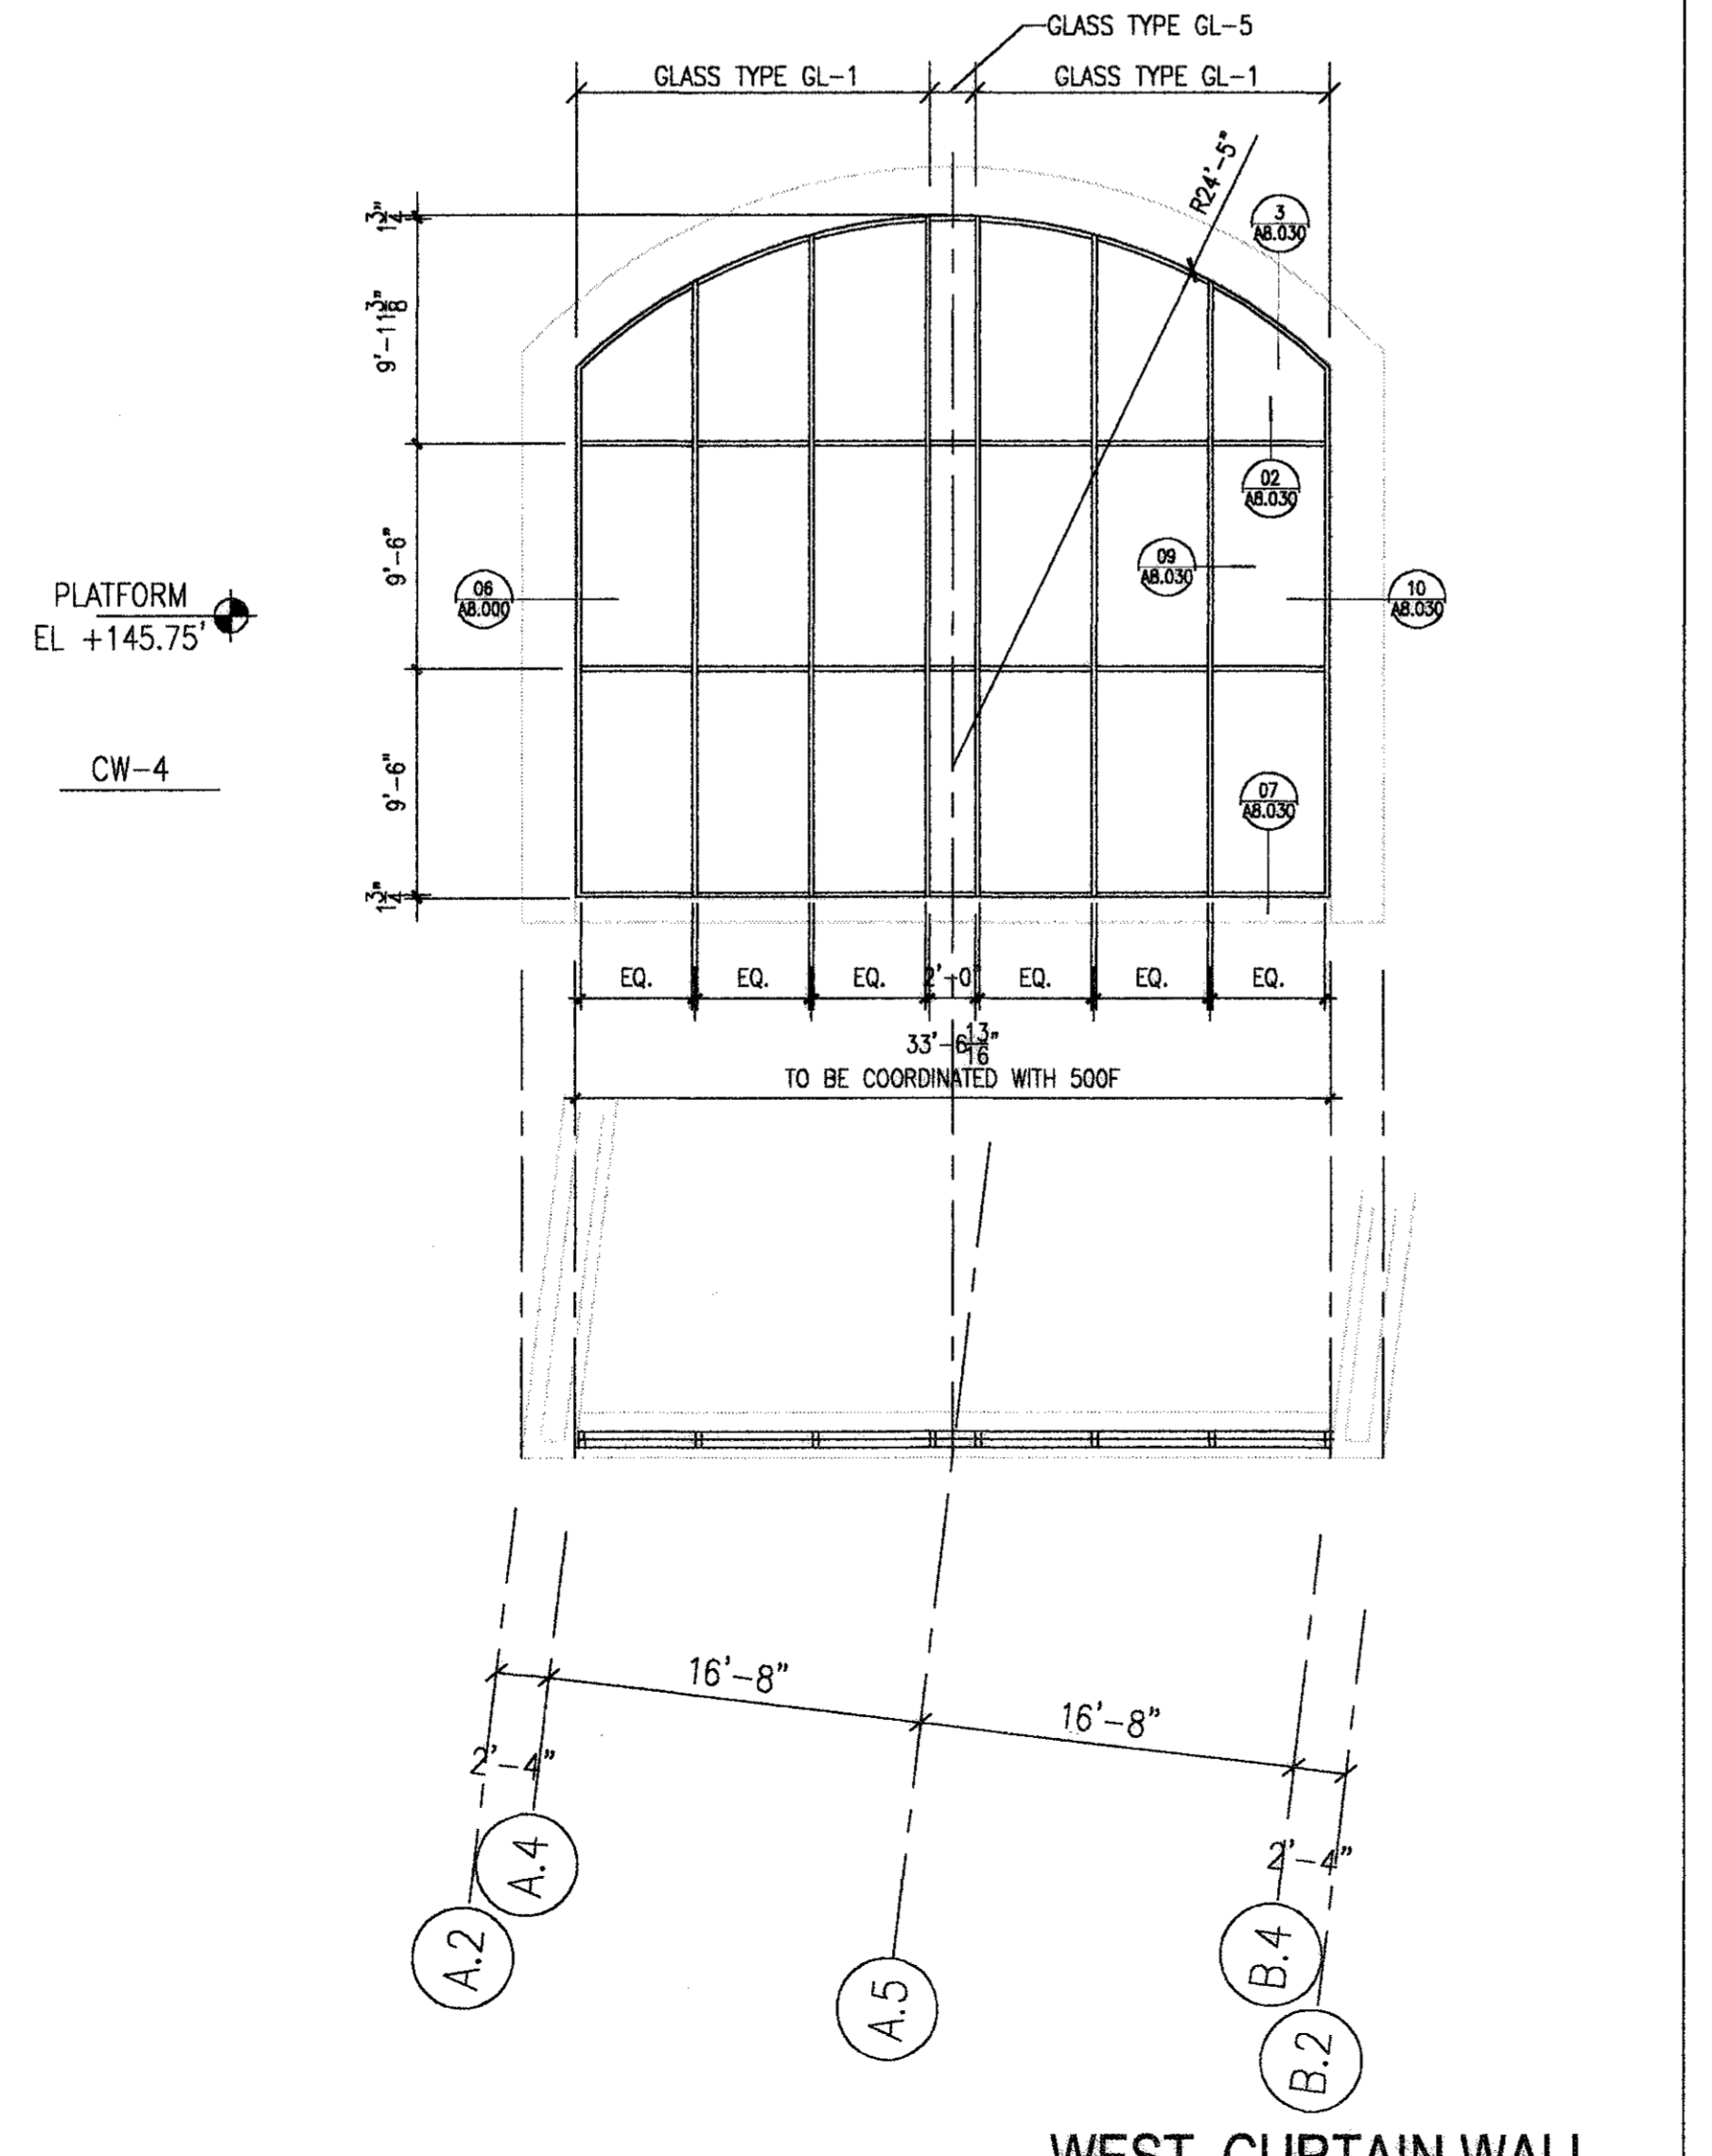

**WEST CURTAIN WALL**  
 CW-4  
 05  
 A2.850 1/8"=1'-0"

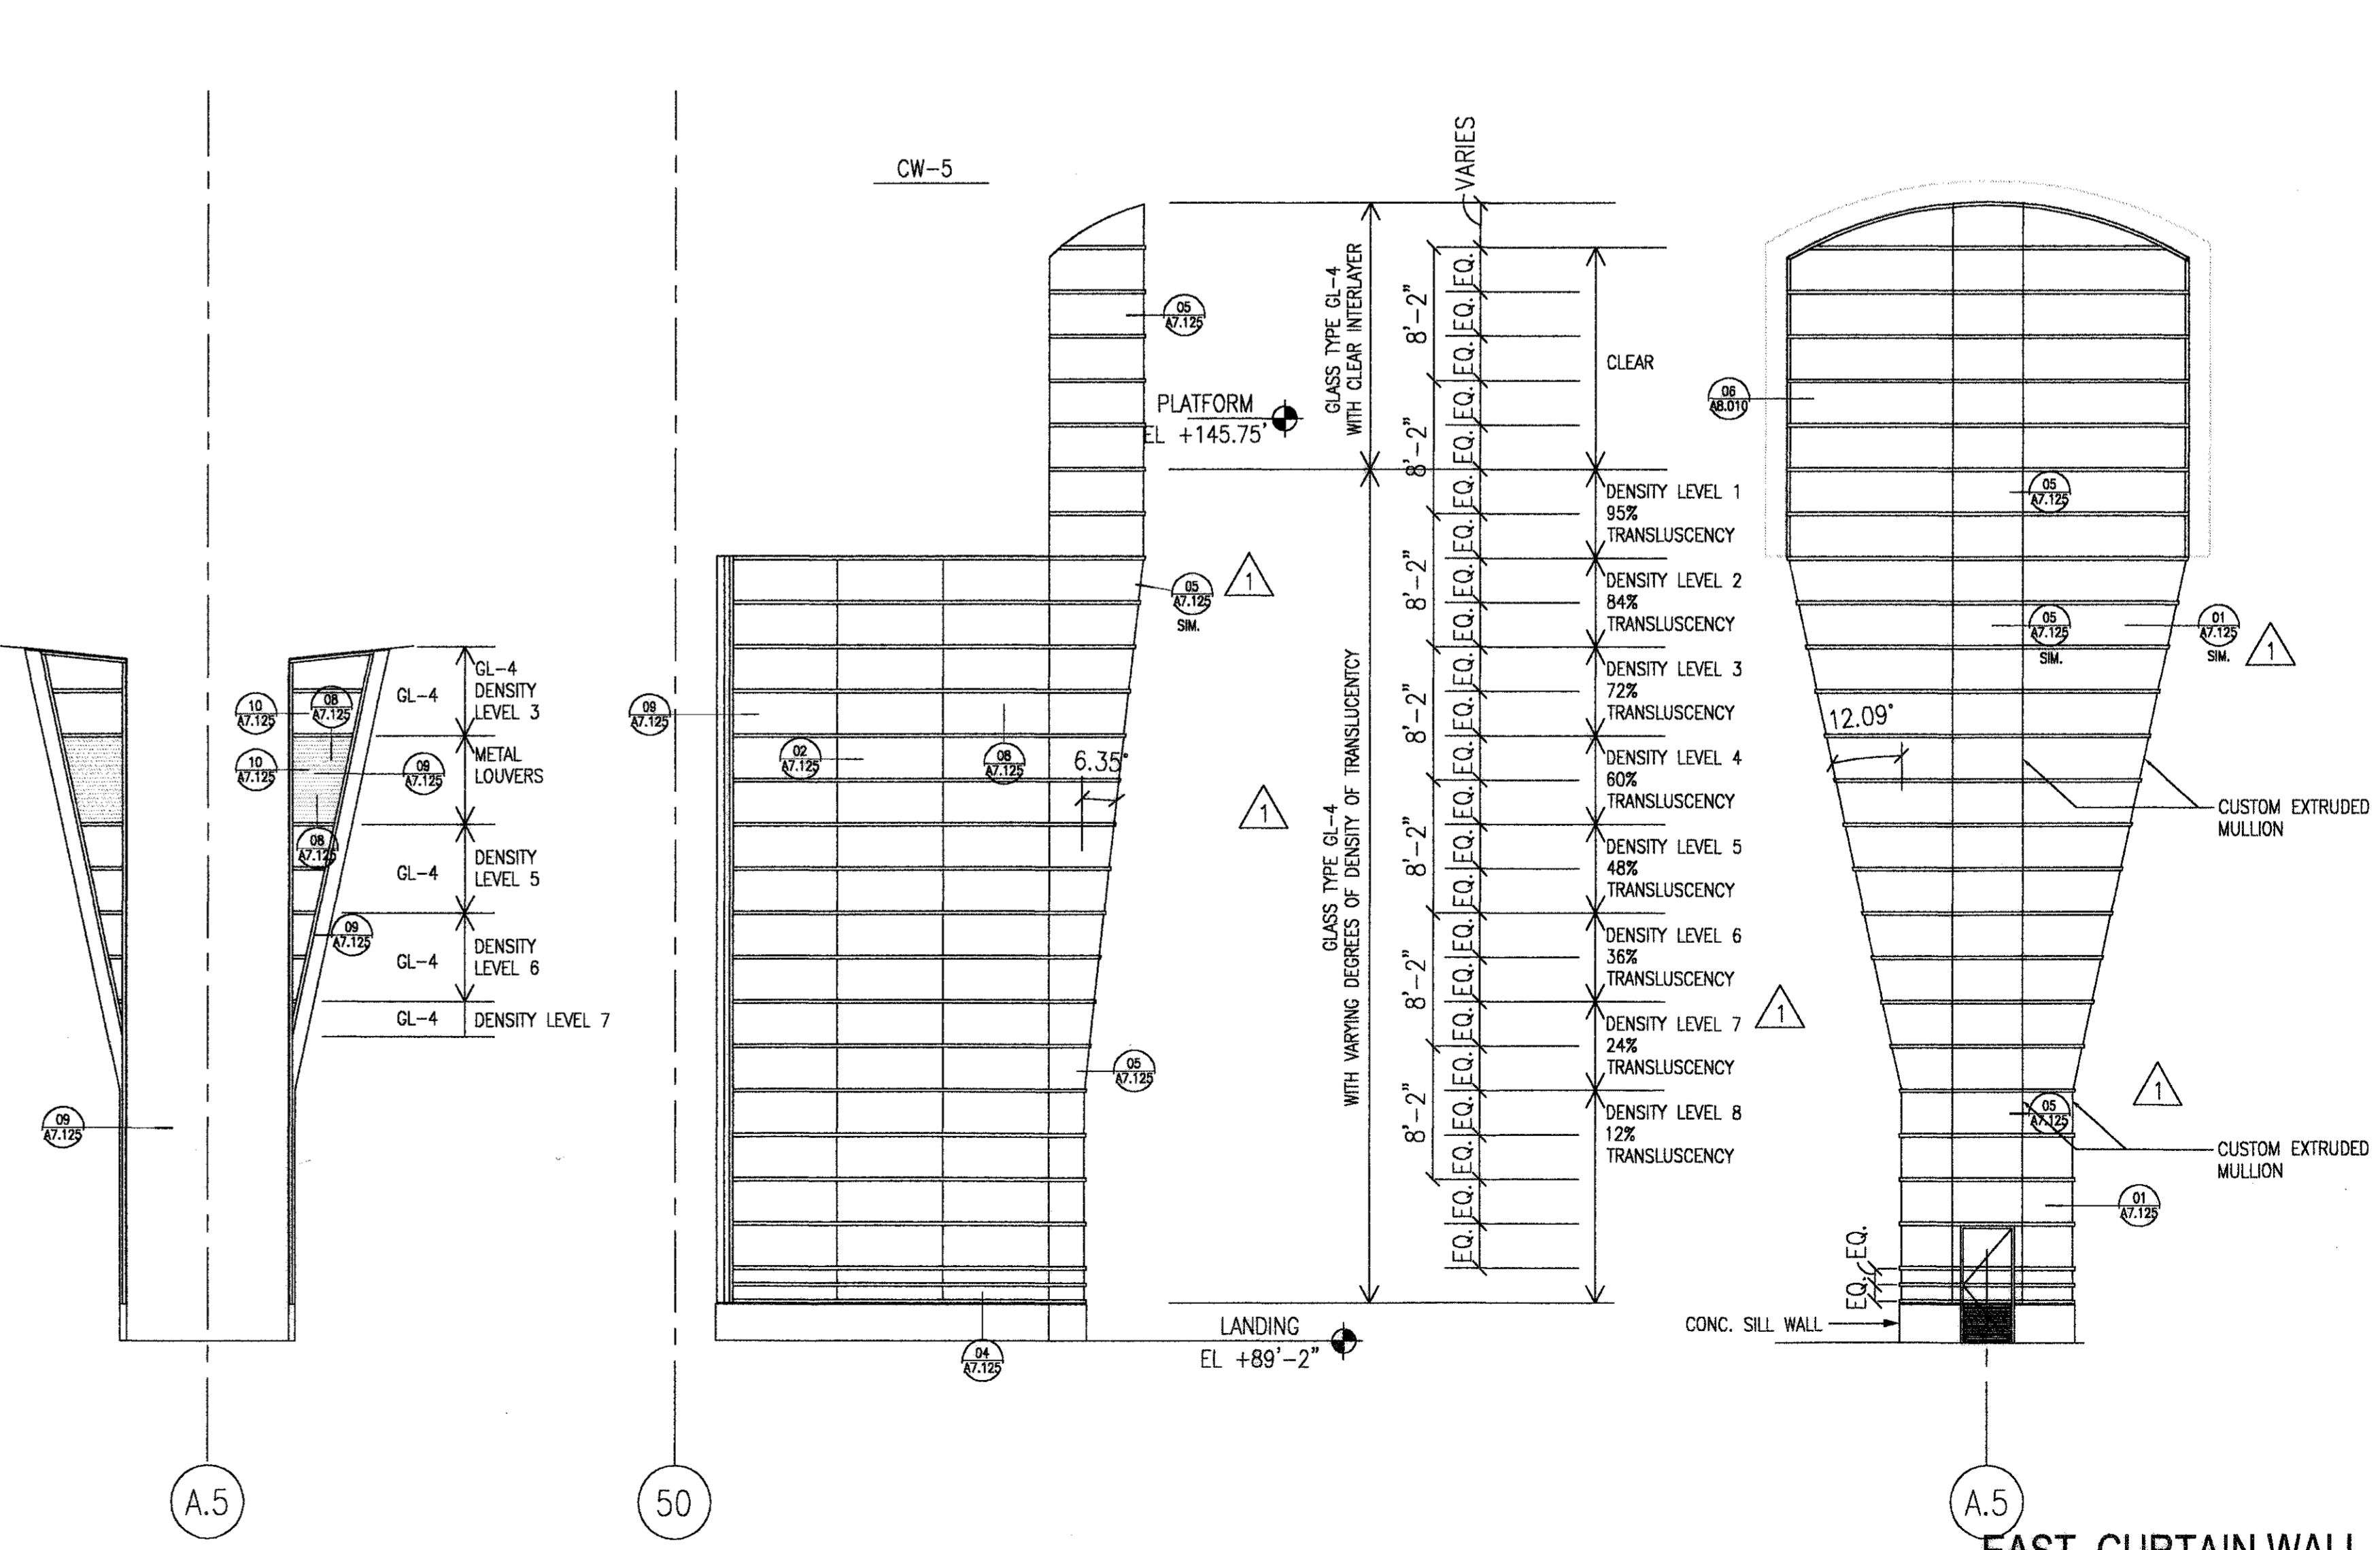


**EAST CURTAIN WALL**  
 CW-5  
 04  
 A2.850 1/8"=1'-0"

INTERNATIONAL SERVICES • EXPANSION • PROGRAM

**APM STATION + PLATFORM**  
 WINDOW SCHEDULE  
 CURTAIN WALLS


PROJECT MGR: HEM  
 DESIGNER: SC  
 DRAWN BY: SEM  
 CHECKED BY: AB  
 DRAWING STANDARD: ISEP 07.20.2000  
 SCALE: 1/8"=1'-0"  
 DATE: 09/14/01

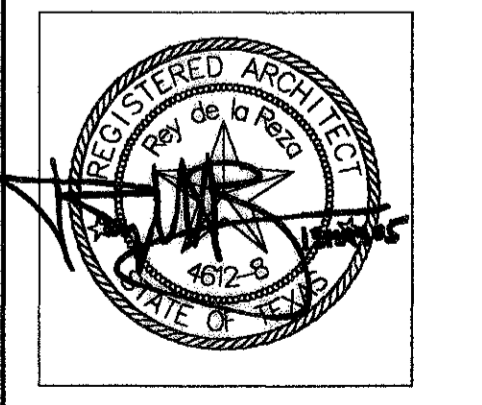

APPROVED BY: DATE:  
 DIRECTOR  
 HOUSTON AIRPORT SYSTEM

PROJECT NO. 1140  
 C.I.P. NO. A-0354  
 H.A.S. NO. 536C  
 SHEET NO.



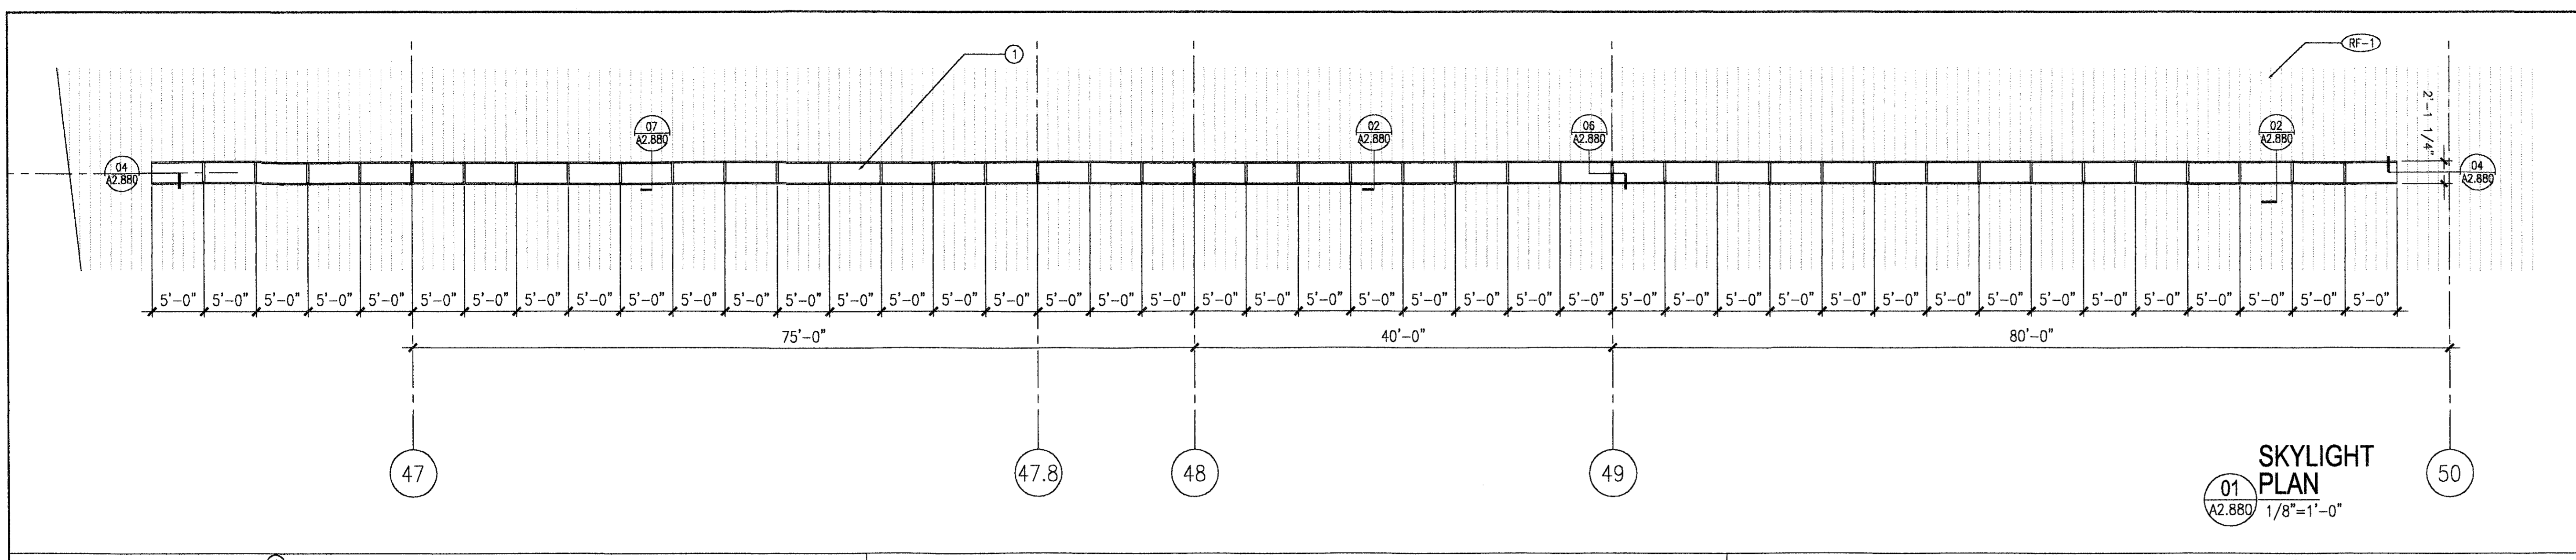

**GENERAL NOTES:**

- (RF-1) STANDING SEAM METAL ROOF - TYPE UC3 FROM UNA-CLAD - COPPER SALES OR EQUAL - POWDERCOATED KYNAR 500; COLOR #2 SILVER METALLIC
- (AC-1) PRE-FINISHED CURVED, PERFORATED METAL CEILING PANEL - TYPE ALUMA VAULT SYSTEM 1000 BY GORDON MANUFACTURER - WITH BLACK NON WOVEN ACOUSTICAL MAT







**RECORD DRAWINGS**  
 DO NOT MODIFY  
 Rey de la Raza Architects, Inc.  
 13 May 2005  
 Note: Information used to develop these documents was taken from Record of the Work Drawings prepared by the construction contractor, Clark Construction Group - Texas.  
 The information provided by the contractor was not verified by the design firm named above.

**HOUSTON AIRPORT SYSTEM**  
 GEORGE BUSH  
 INTERCONTINENTAL AIRPORT  
 HOUSTON TEXAS  
**Lea & Elbert**  
 1008 W RANDOL MILL RD  
 ARLINGTON, TX 76010  
 Tel: 817.281.1448  
 Tel: 817.861.3236  
**REY DE LA RAZA ARCHITECTS, INC.**  
 ARCHITECT PLANNING INTERIOR DESIGN  
 1542 WEST 18TH ST.  
 HOUSTON, TX 77008  
 Tel: 713.888.3121  
 Tel: 713.882.0112

NO.	DESCRIPTION	DATE	BY
1	ISSUED FOR BID	10/19/01	
2	RECORD SET	05/13/05	EM


**KEYED NOTES:**

- 1 DOUBLE GLAZED LOW RISE VAULT SKYLIGHT
- 2 INSULATED CLOSURE
- 3 EXTRUDED ALUMINIUM CHANNEL - POWDERCOATED
- 4 ALUMINIUM CLADDING 1/8" THK. POWDERCOATED KYNAR 500 CUSTOM COLOR: BLUE SILVER METALLIC
- 5 5/8" GYPSUM SHEATHING TYPE-X
- 6 3" METAL DECK + 1HR FIREPROOFING
- 7 W16 BEAM + 3 HR FIREPROOFING - RE STRUCTURAL
- 8 CONTINUOUS STEEL Z CLIP - 12 GA
- 9 CURVED CEILING PANELS TYPE AC-1
- 10 HOLD DOWN CLIP
- 11 CURVED CEILING TEE : SYSTEM 1000 ALUMA-VAULT FROM GORDON OR EQUAL
- 12 RIGID INSULATION - UL FIRE CLASSIFIED
- 13 EXTRUDED ALUMINIUM FRAME - POWDERCOATED - COLOR #2 - SILVER METALLIC
- 14 STEEL CHANNEL + 3 HR FIREPROOFING - RE STRUCTURAL
- 15 LIGHT FIXTURE WITH BLUE SLEEVE
- 16 OUTER ACRYLIC GLAZING
- 17 INNER ACRYLIC GLAZING
- 18 STEEL BEAM + 3HR FIREPROOFING - RE STRUCTURAL
- 19 ROOFING UNDERLAYMENT TYPE VYCOR ULTRA FROM GRACE MANUFACTURER OR EQUAL
- 20 PREFINISHED FLASHING POWDERCOATED - COLOR #2
- 21 FASTENER @ SIDE CLADDING
- 22 PREFINISHED POWDERCOATED METAL FLASHING
- 23 PREFINISHED STANDING SEAM PANEL
- 24 PREFINISHED J CHANNEL
- 25 SEALANT
- 26 WEEP HOLE
- 27 SPRAY FIREPROOFING
- 28 Z CLIP - 20 G.A.
- 29 2" GALVANIZED STEEL Z CLIP - 20 G.A. SECURE TO DECK @ 2" O.C. MAX.
- 30 BATT INSULATION FIXED ON Z CLIP - TYPE FIRE SAFE INSULATION BY ROCKWOOL OR EQUAL UL CLASSIFIED PRODUCT
- 31 FASTENER
- 32 3 5/8" METAL STUD 16GA @ 24" O.C.
- 33 3 5/8" STEEL RUNNER
- 34 BRACING AS REQUIRED FOR STABILITY
- 35 1/4" THICK BENT STEEL PLATES WELD TO CHANNEL BEAM OR TO W BEAM SIM
- 36 BENT STEEL PLATE 1/8" THICK - POWDERCOATED COLOR #2
- 37 PTZ CAMERA - RE SECURITY

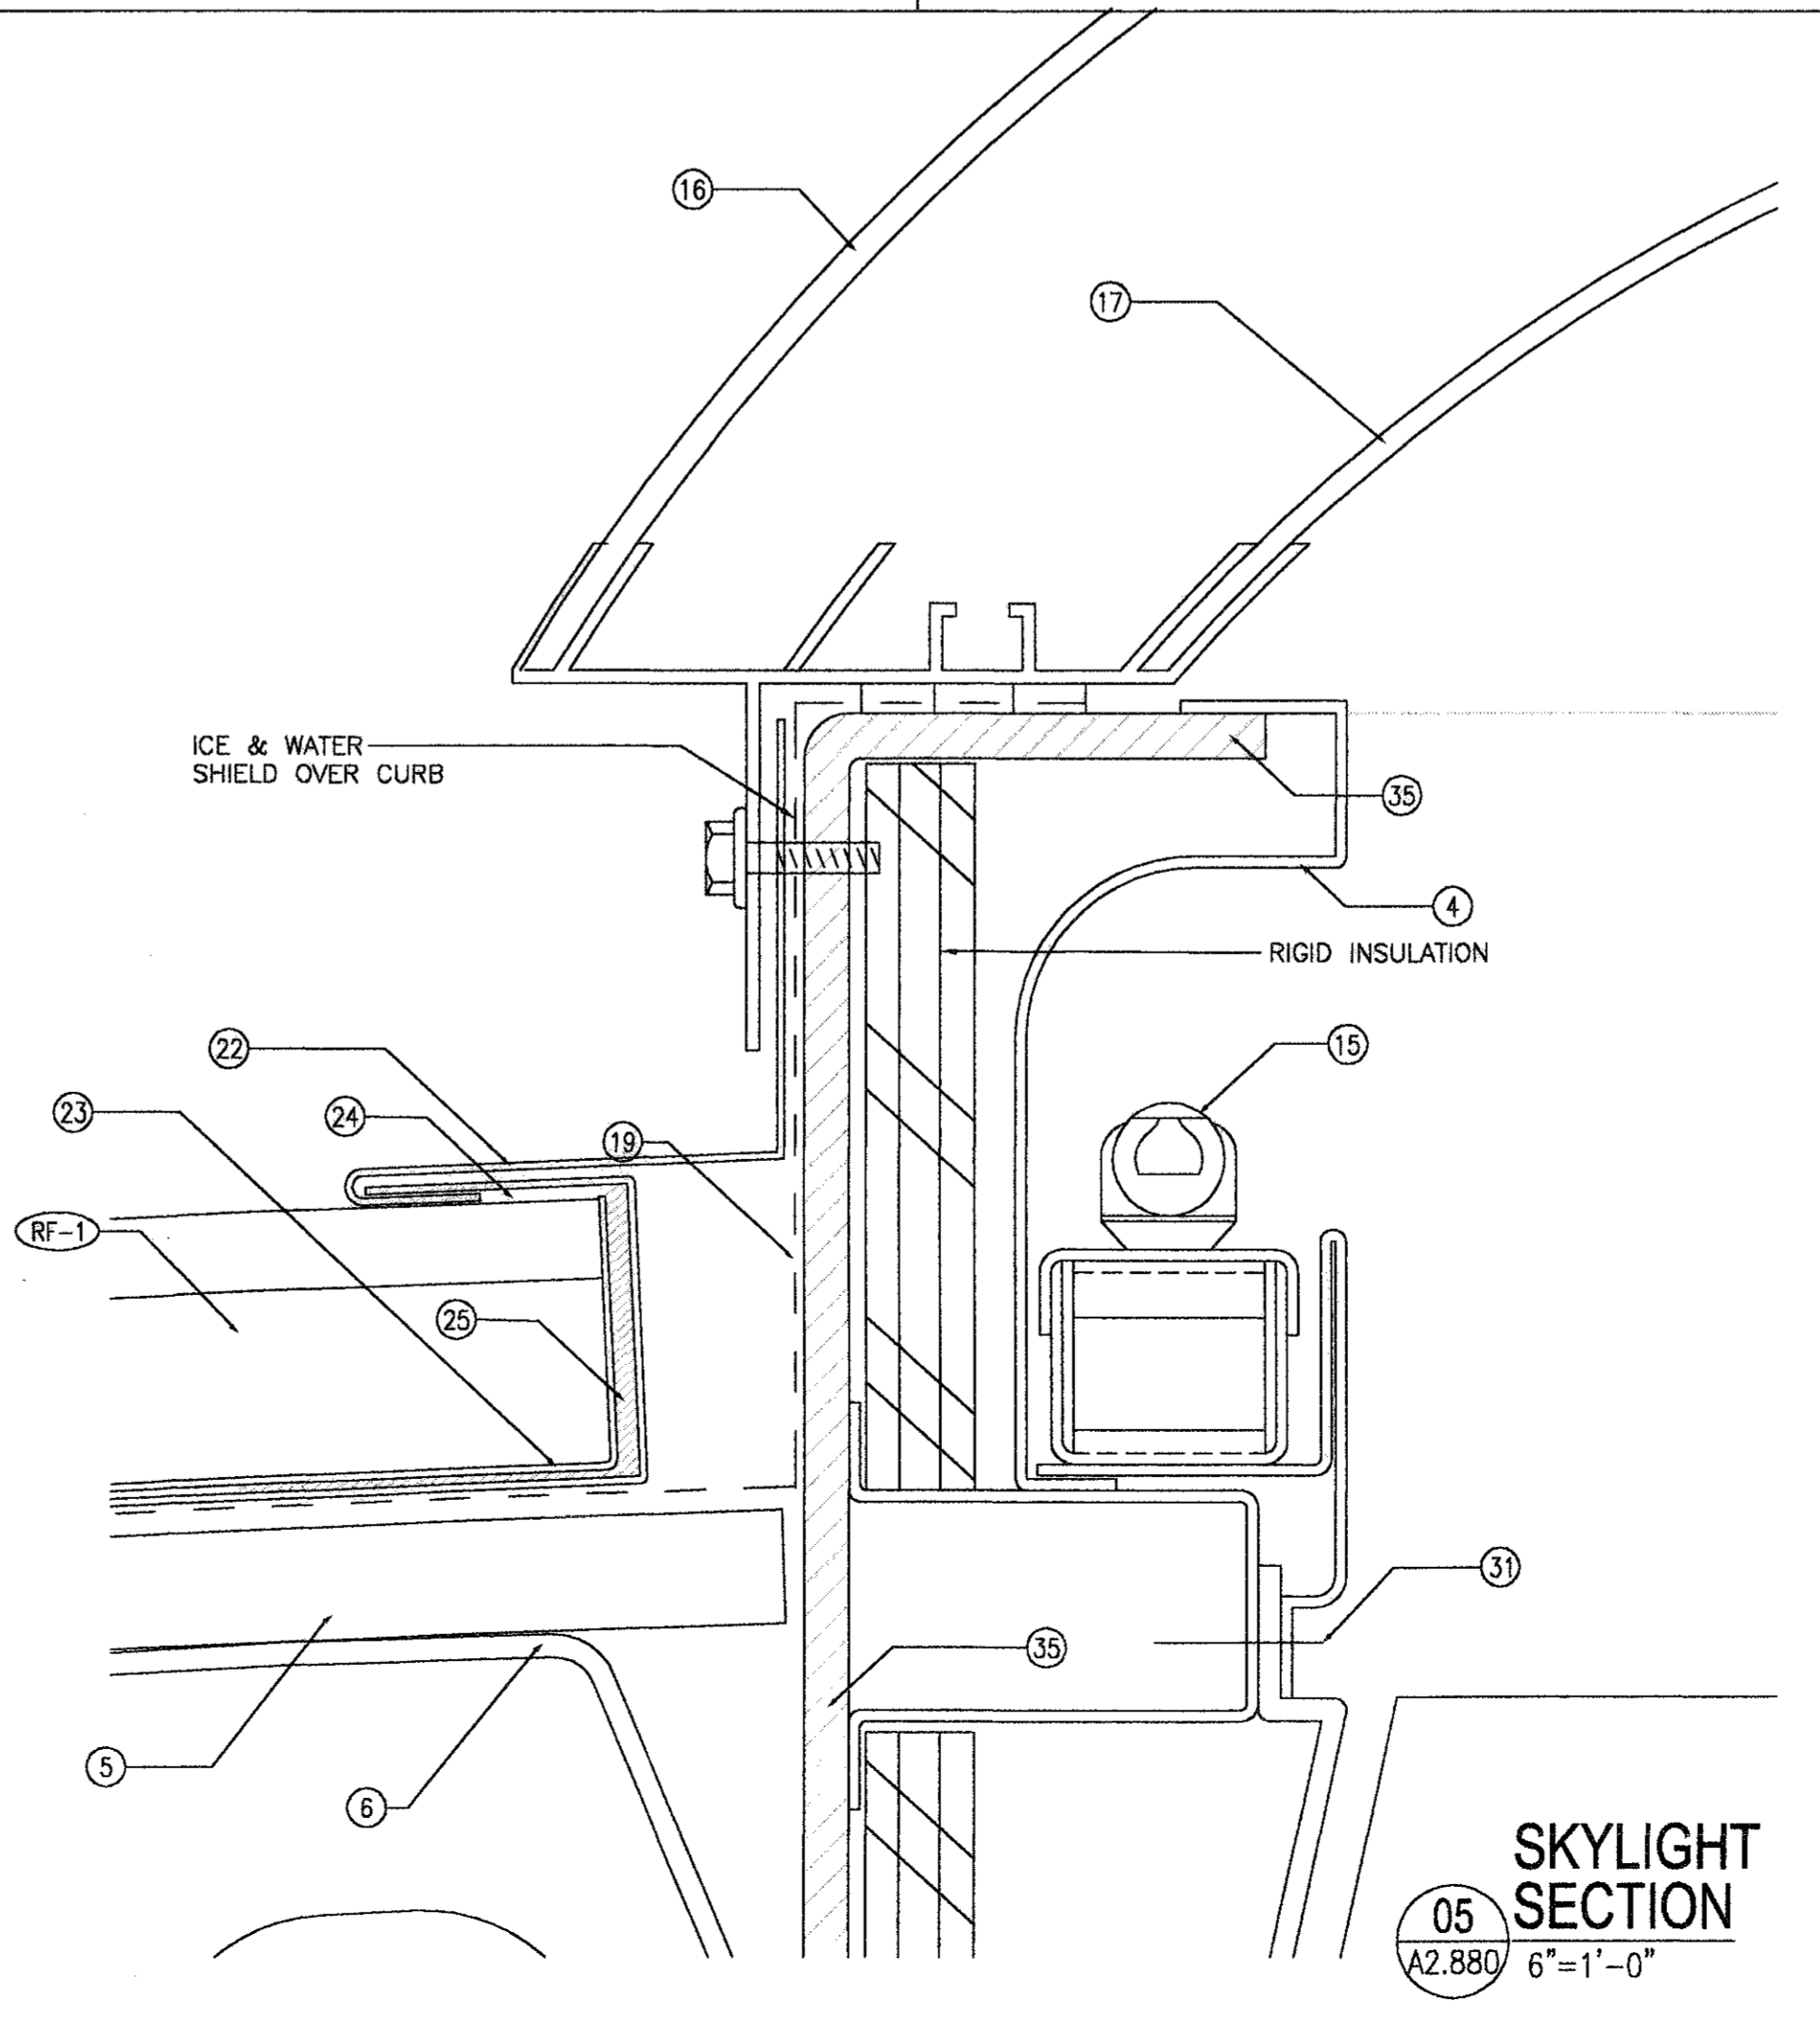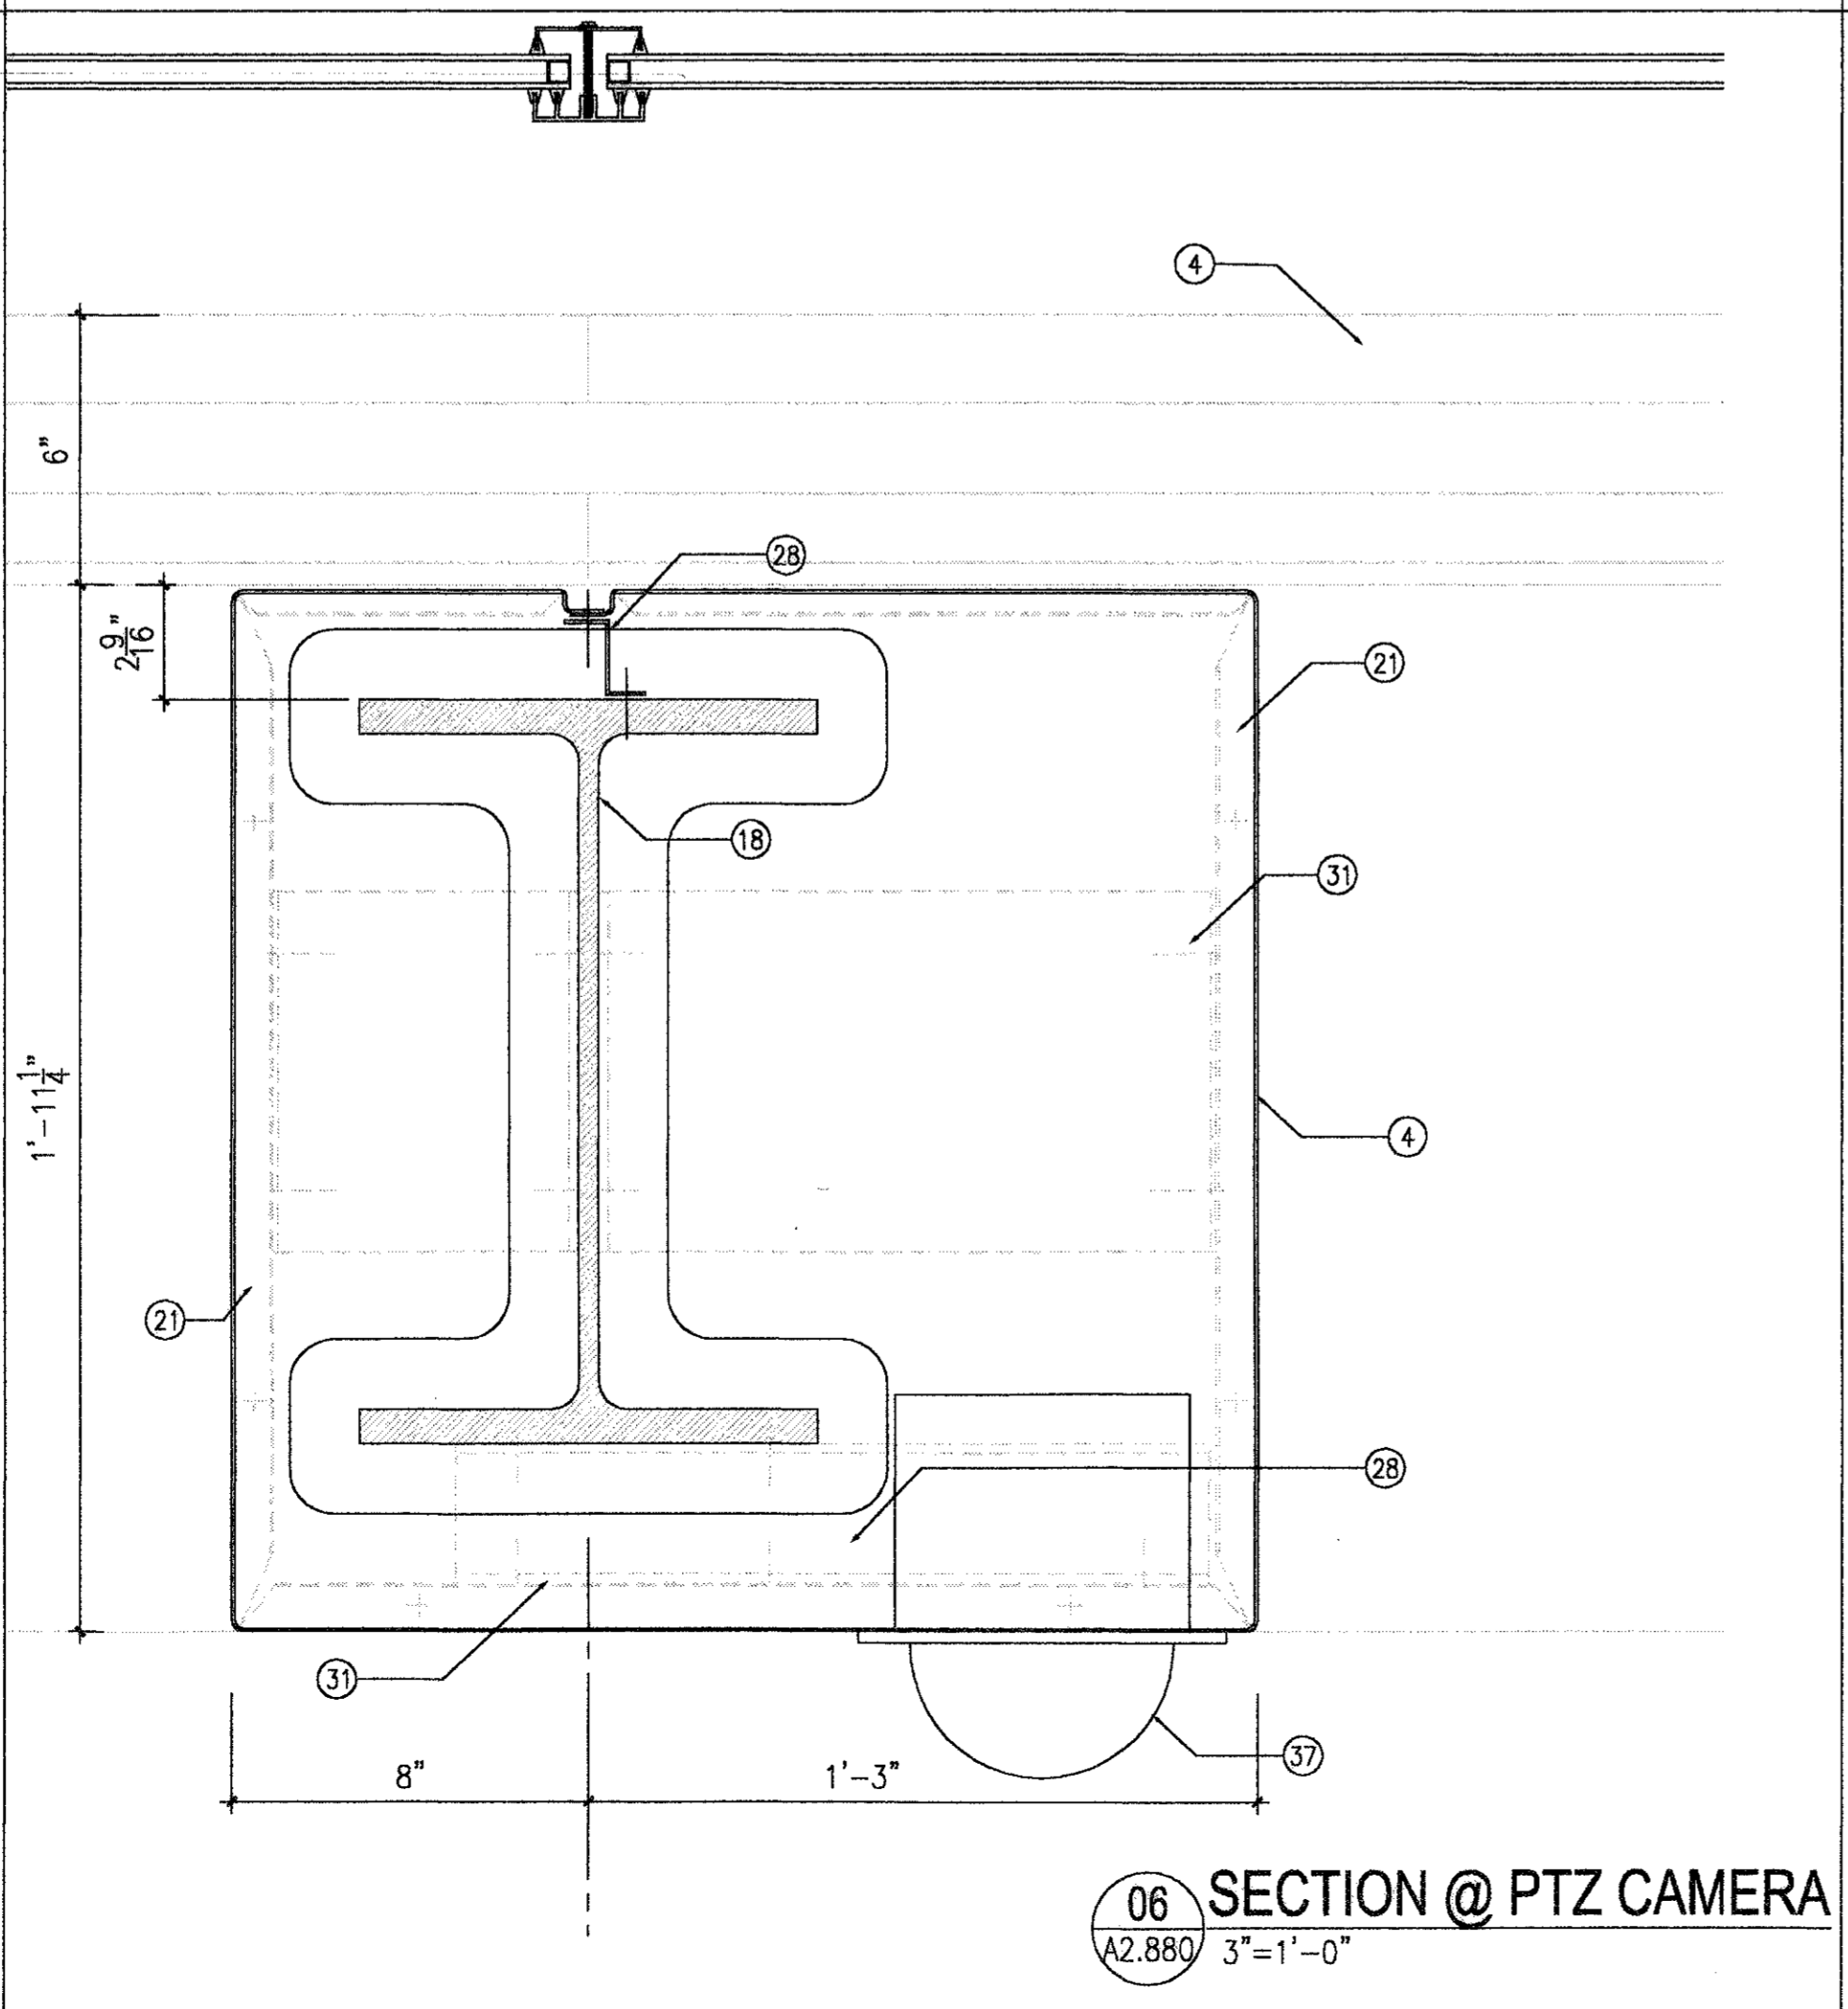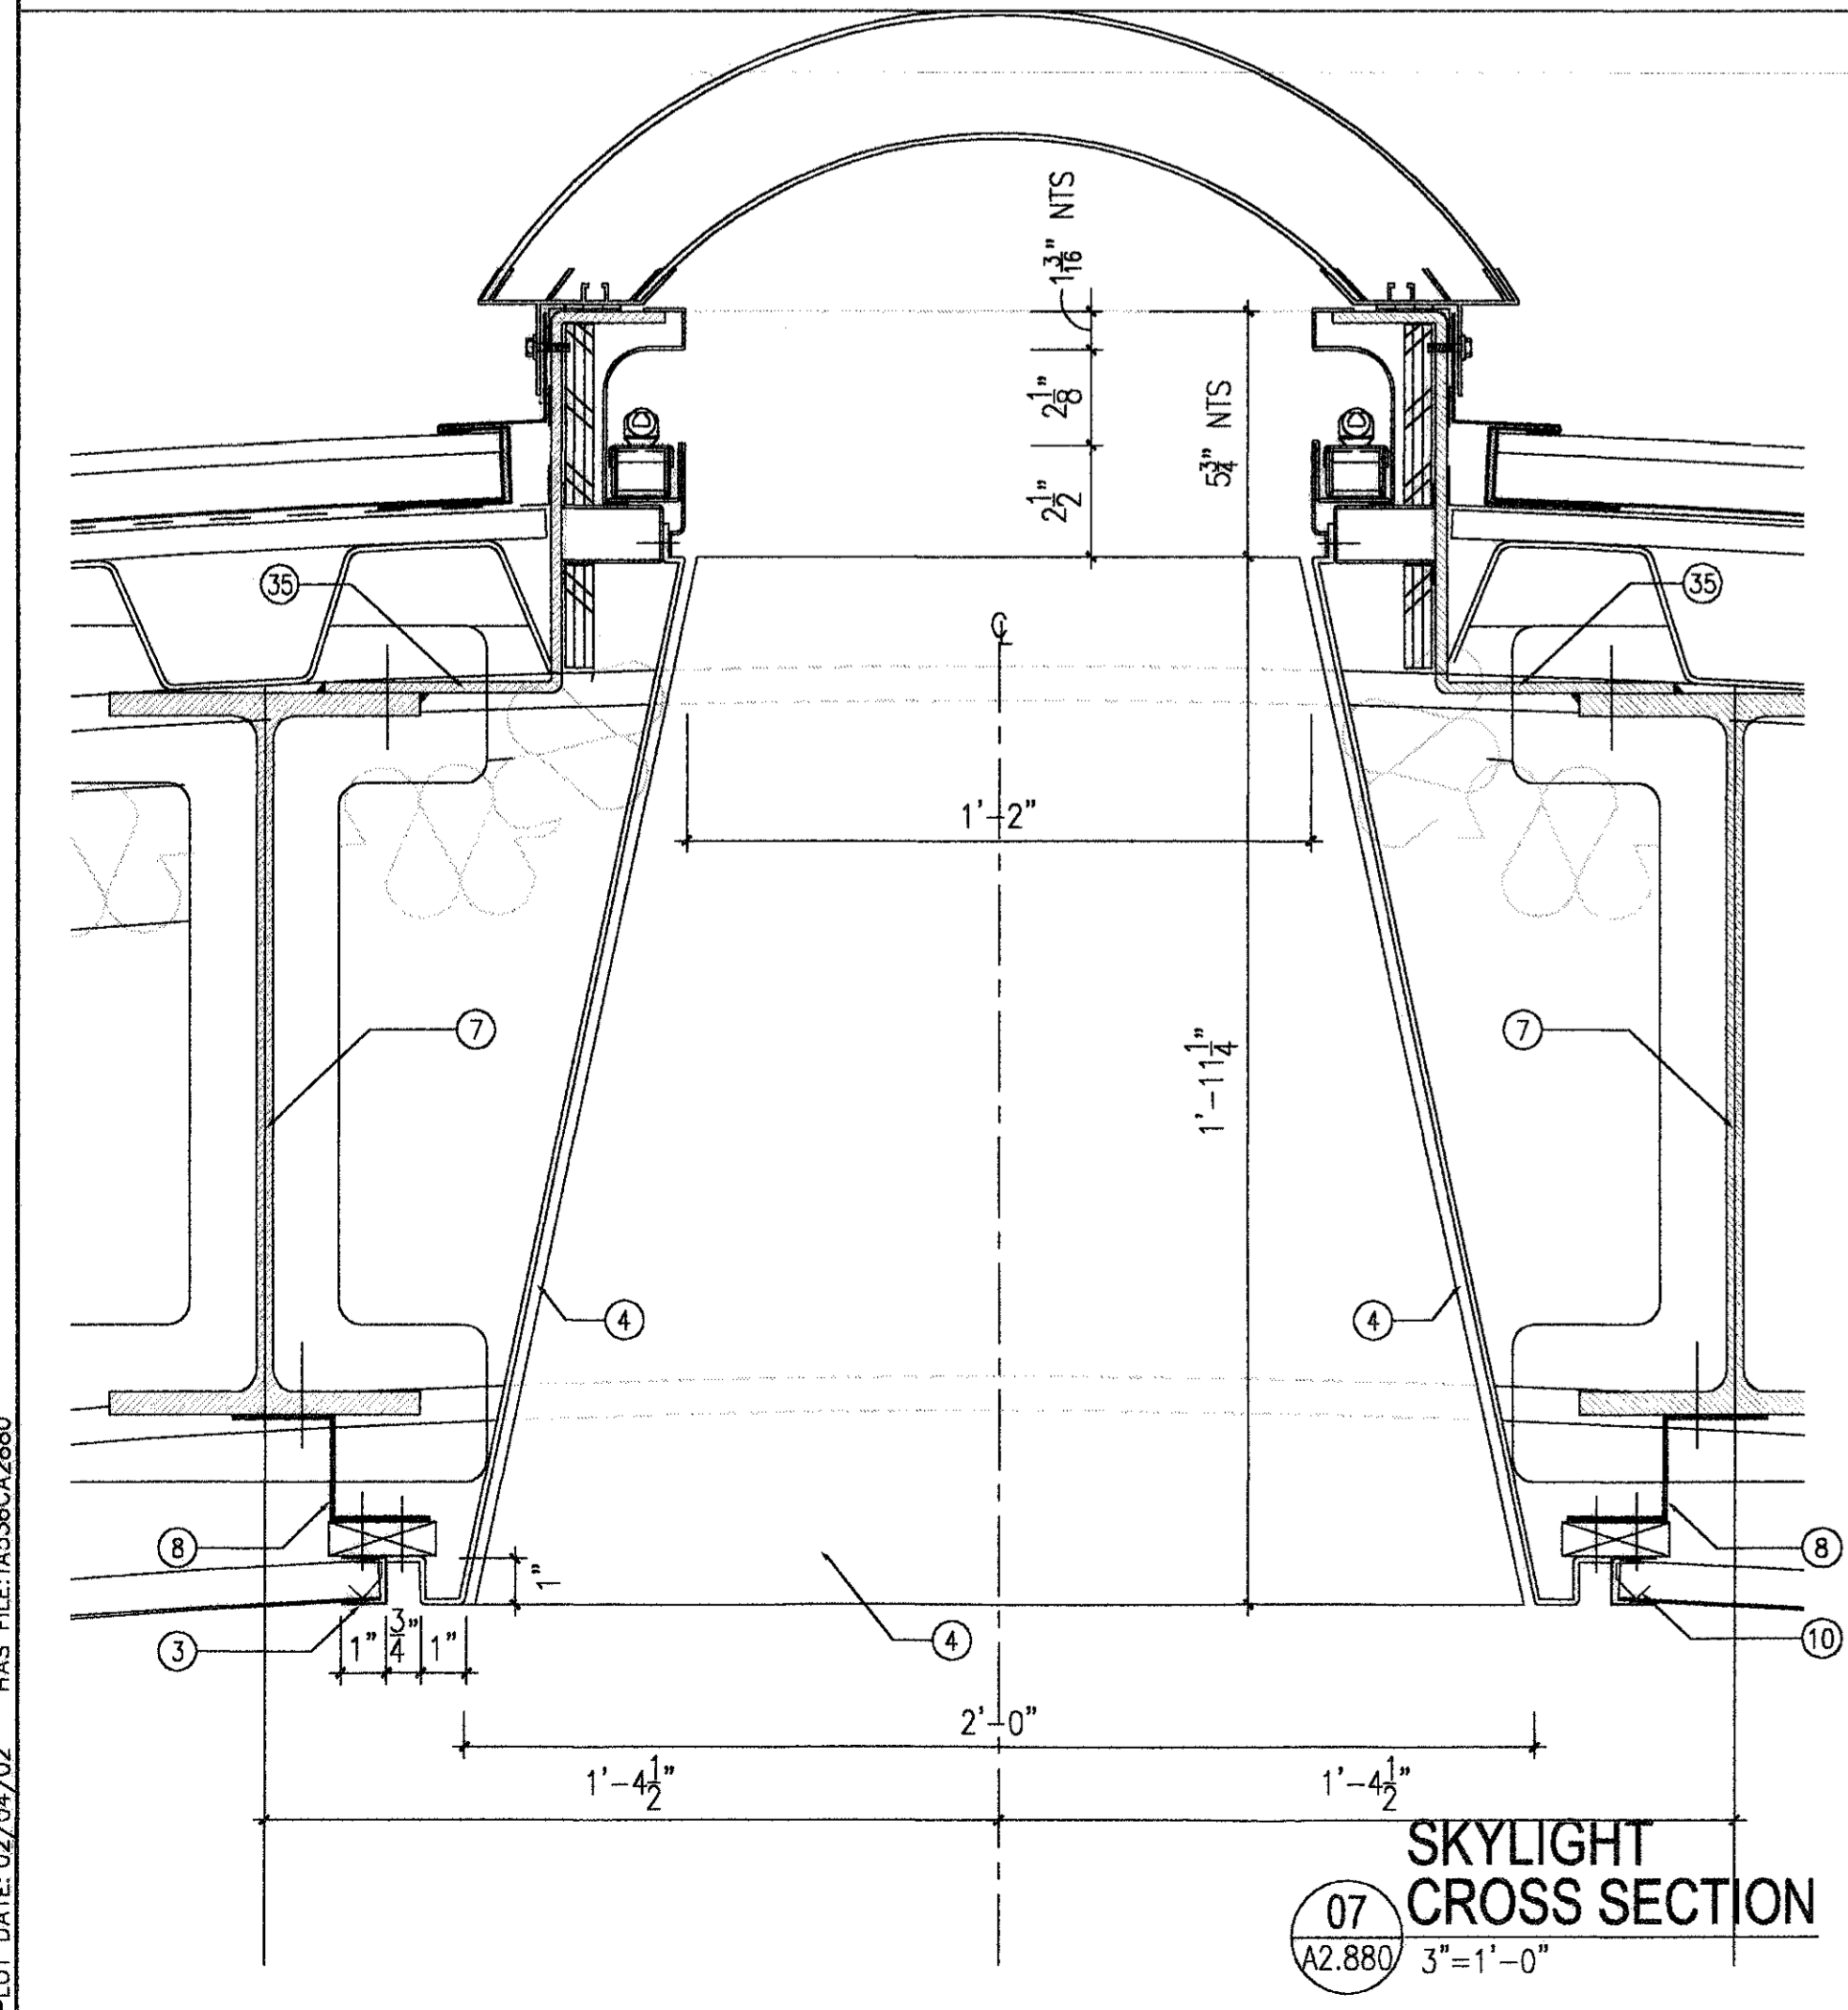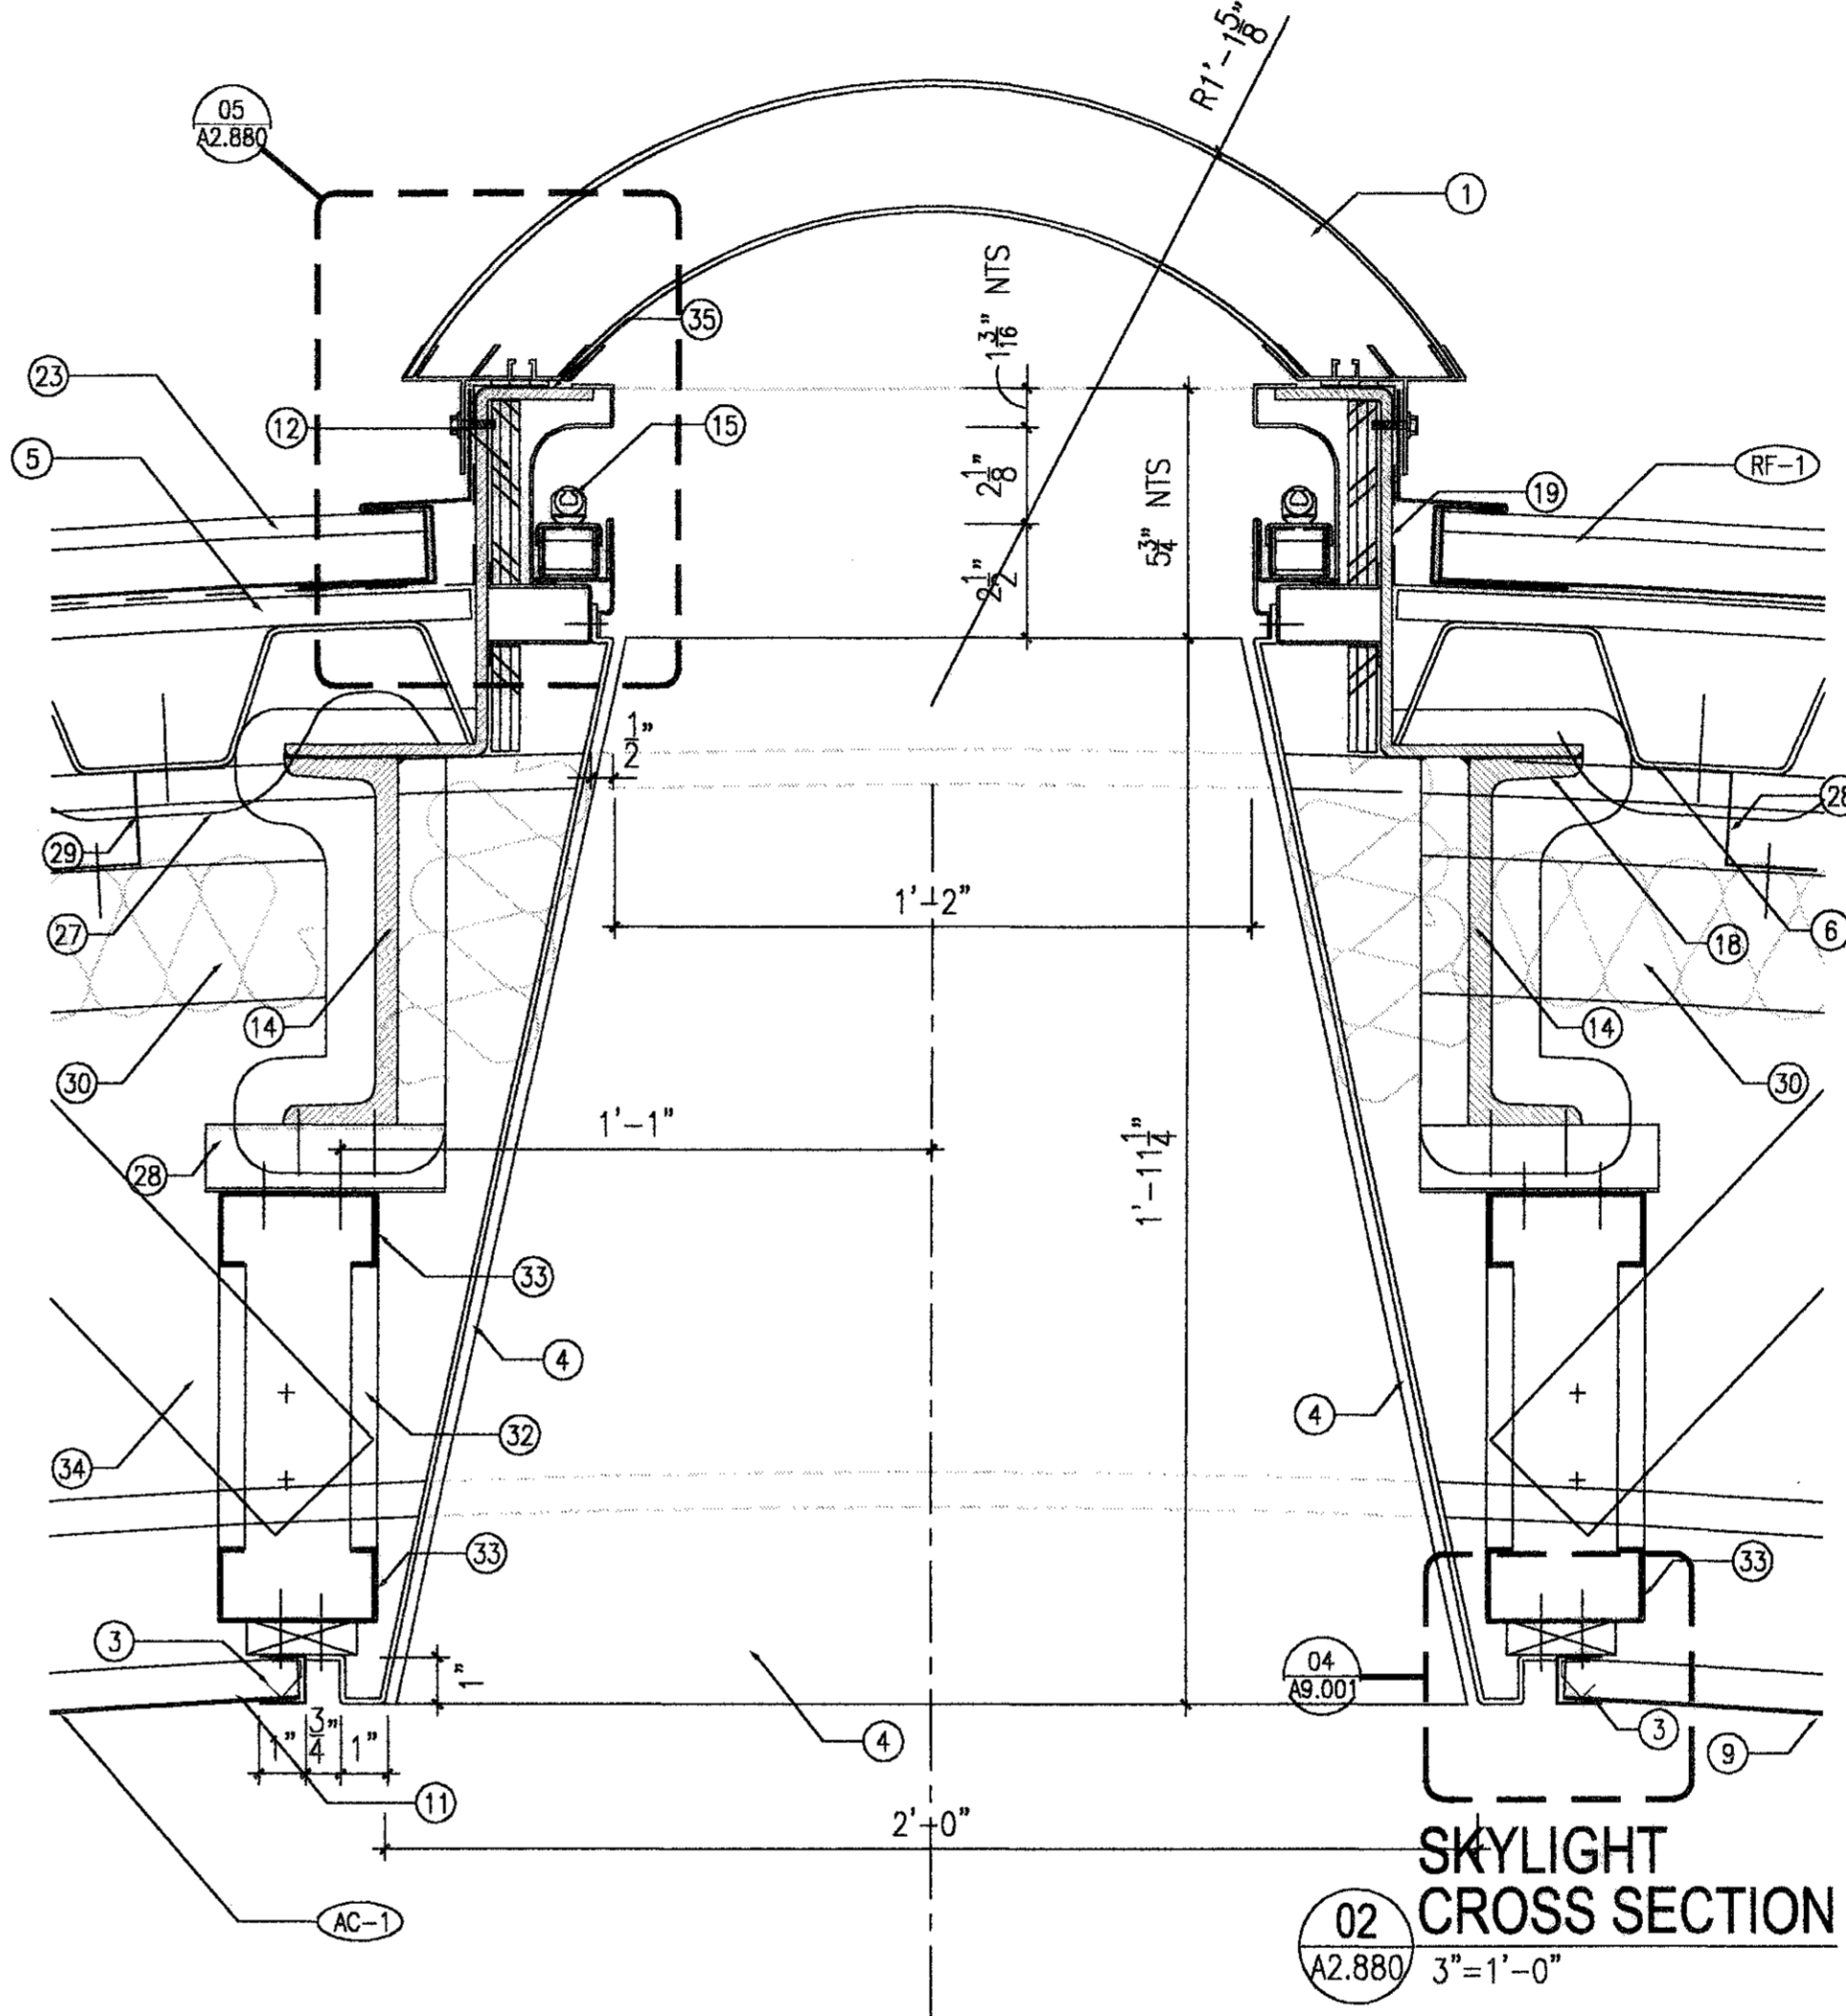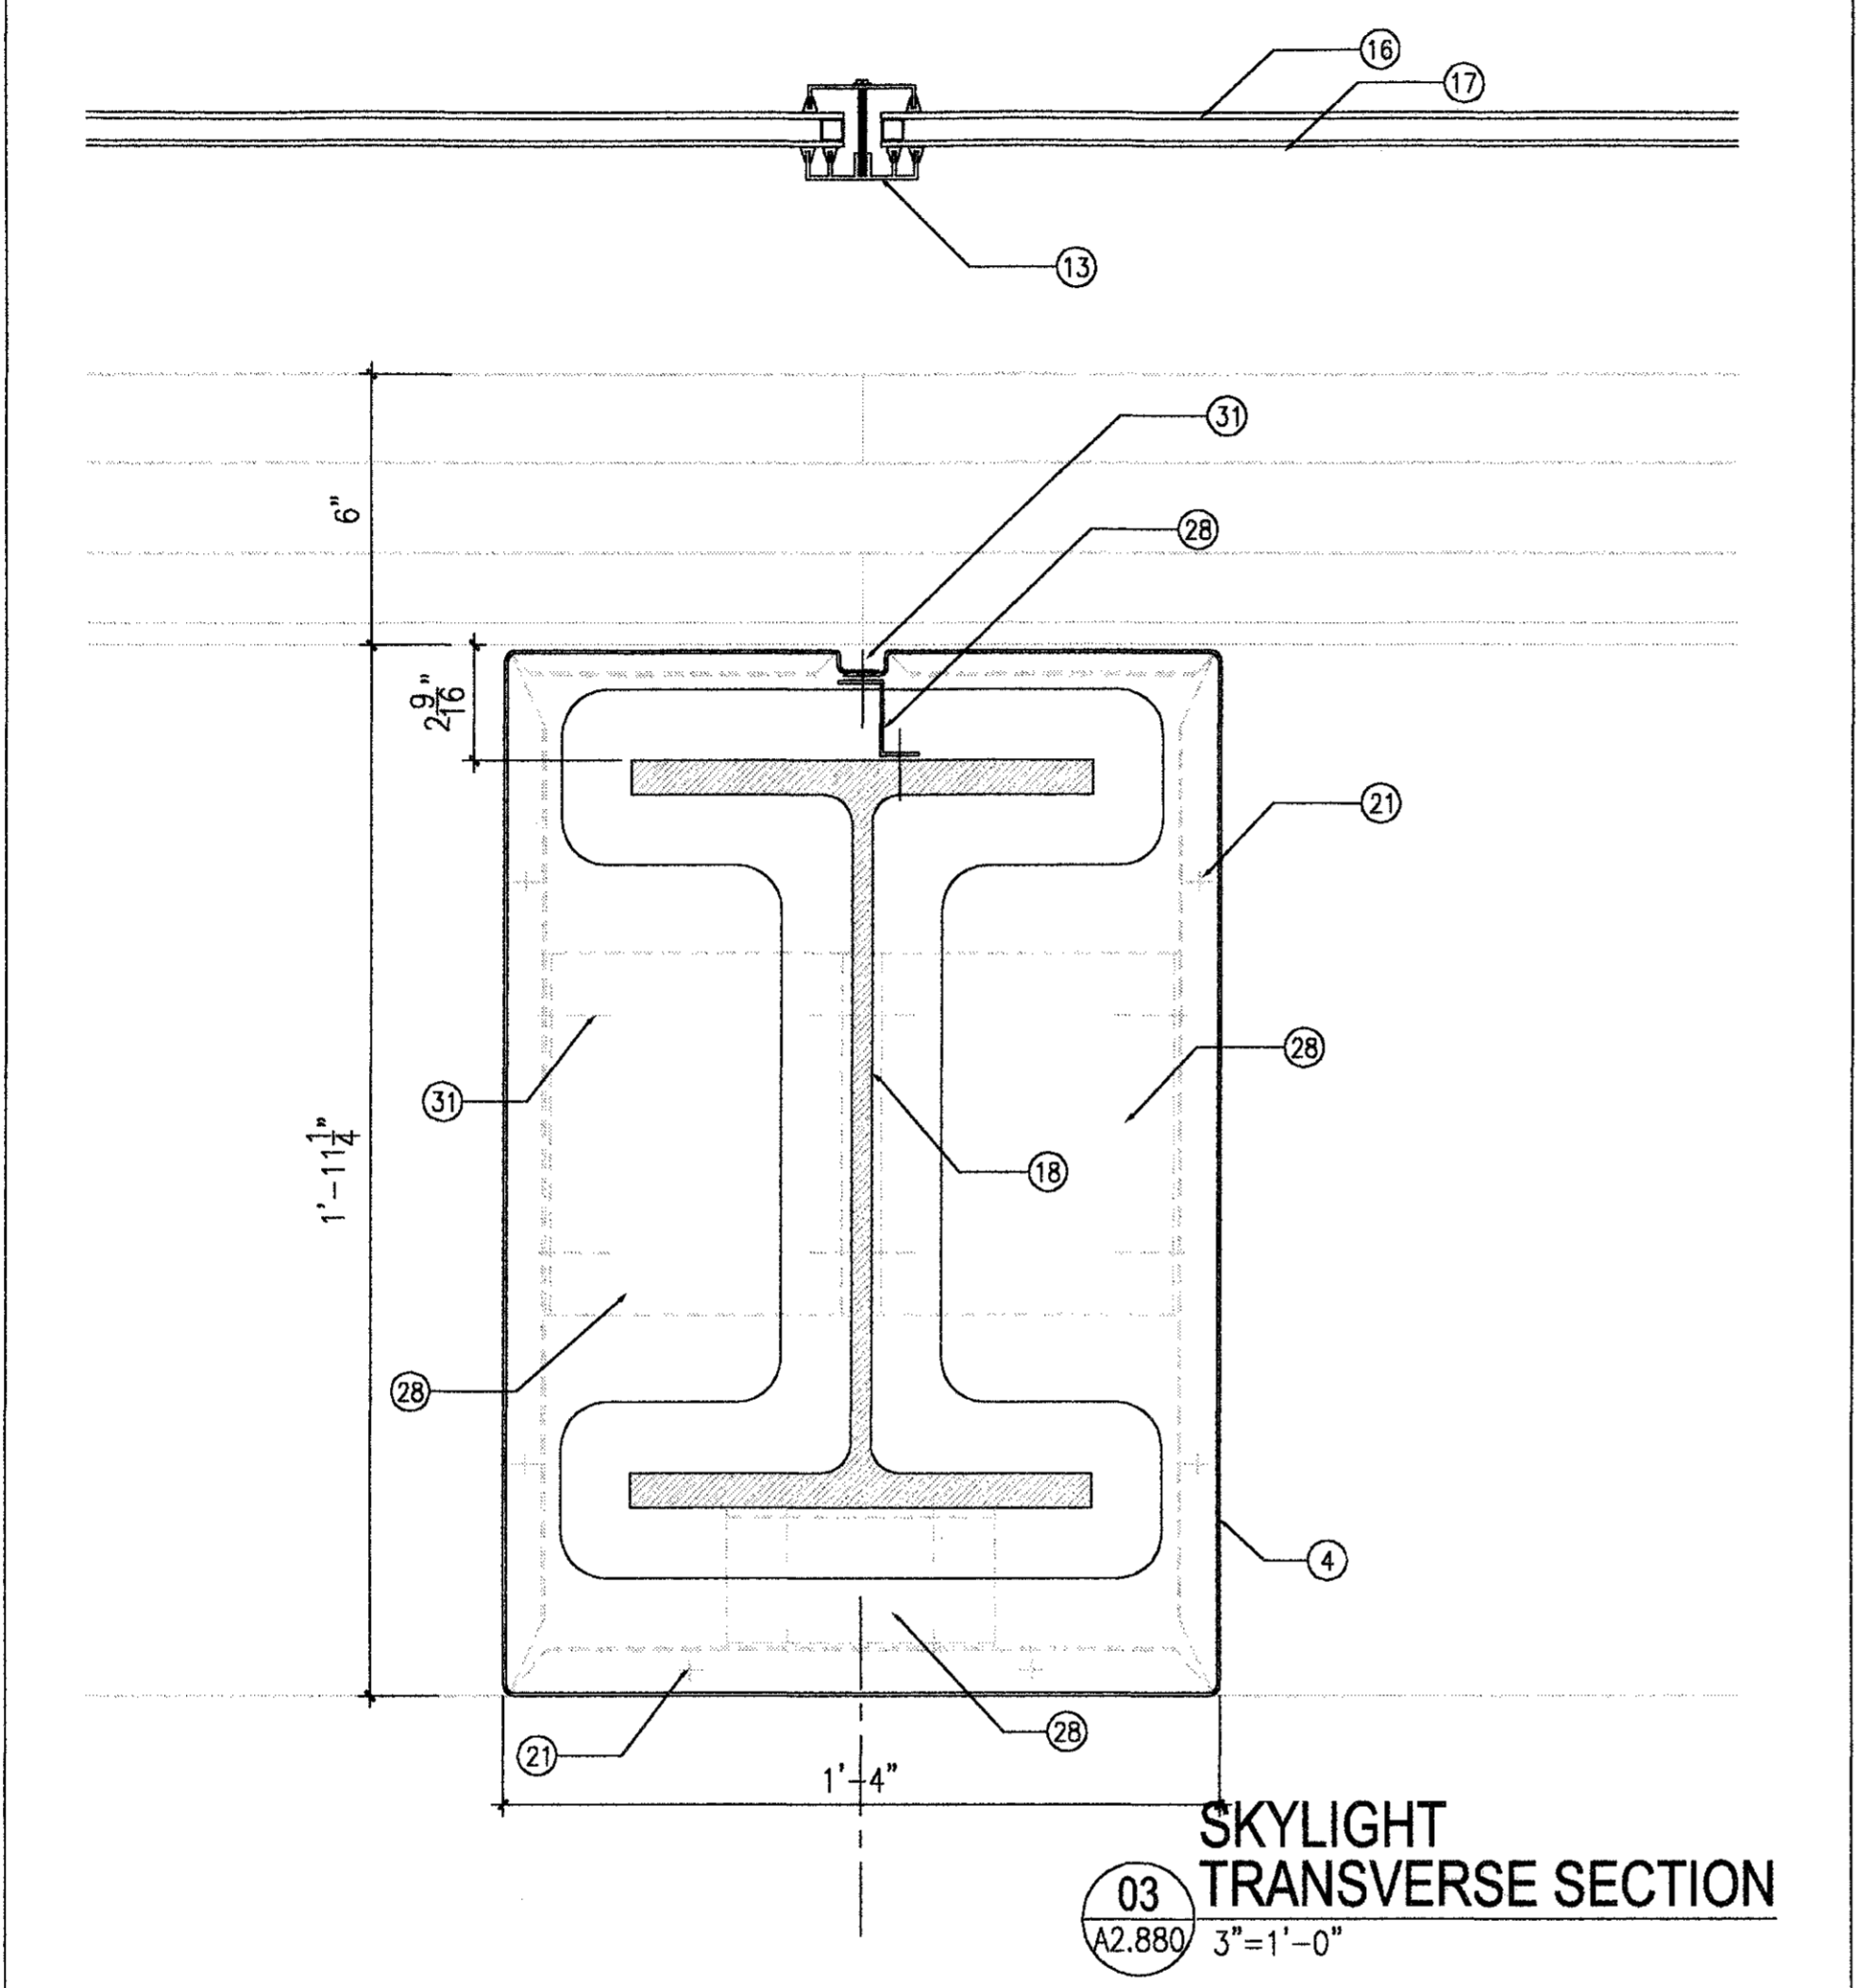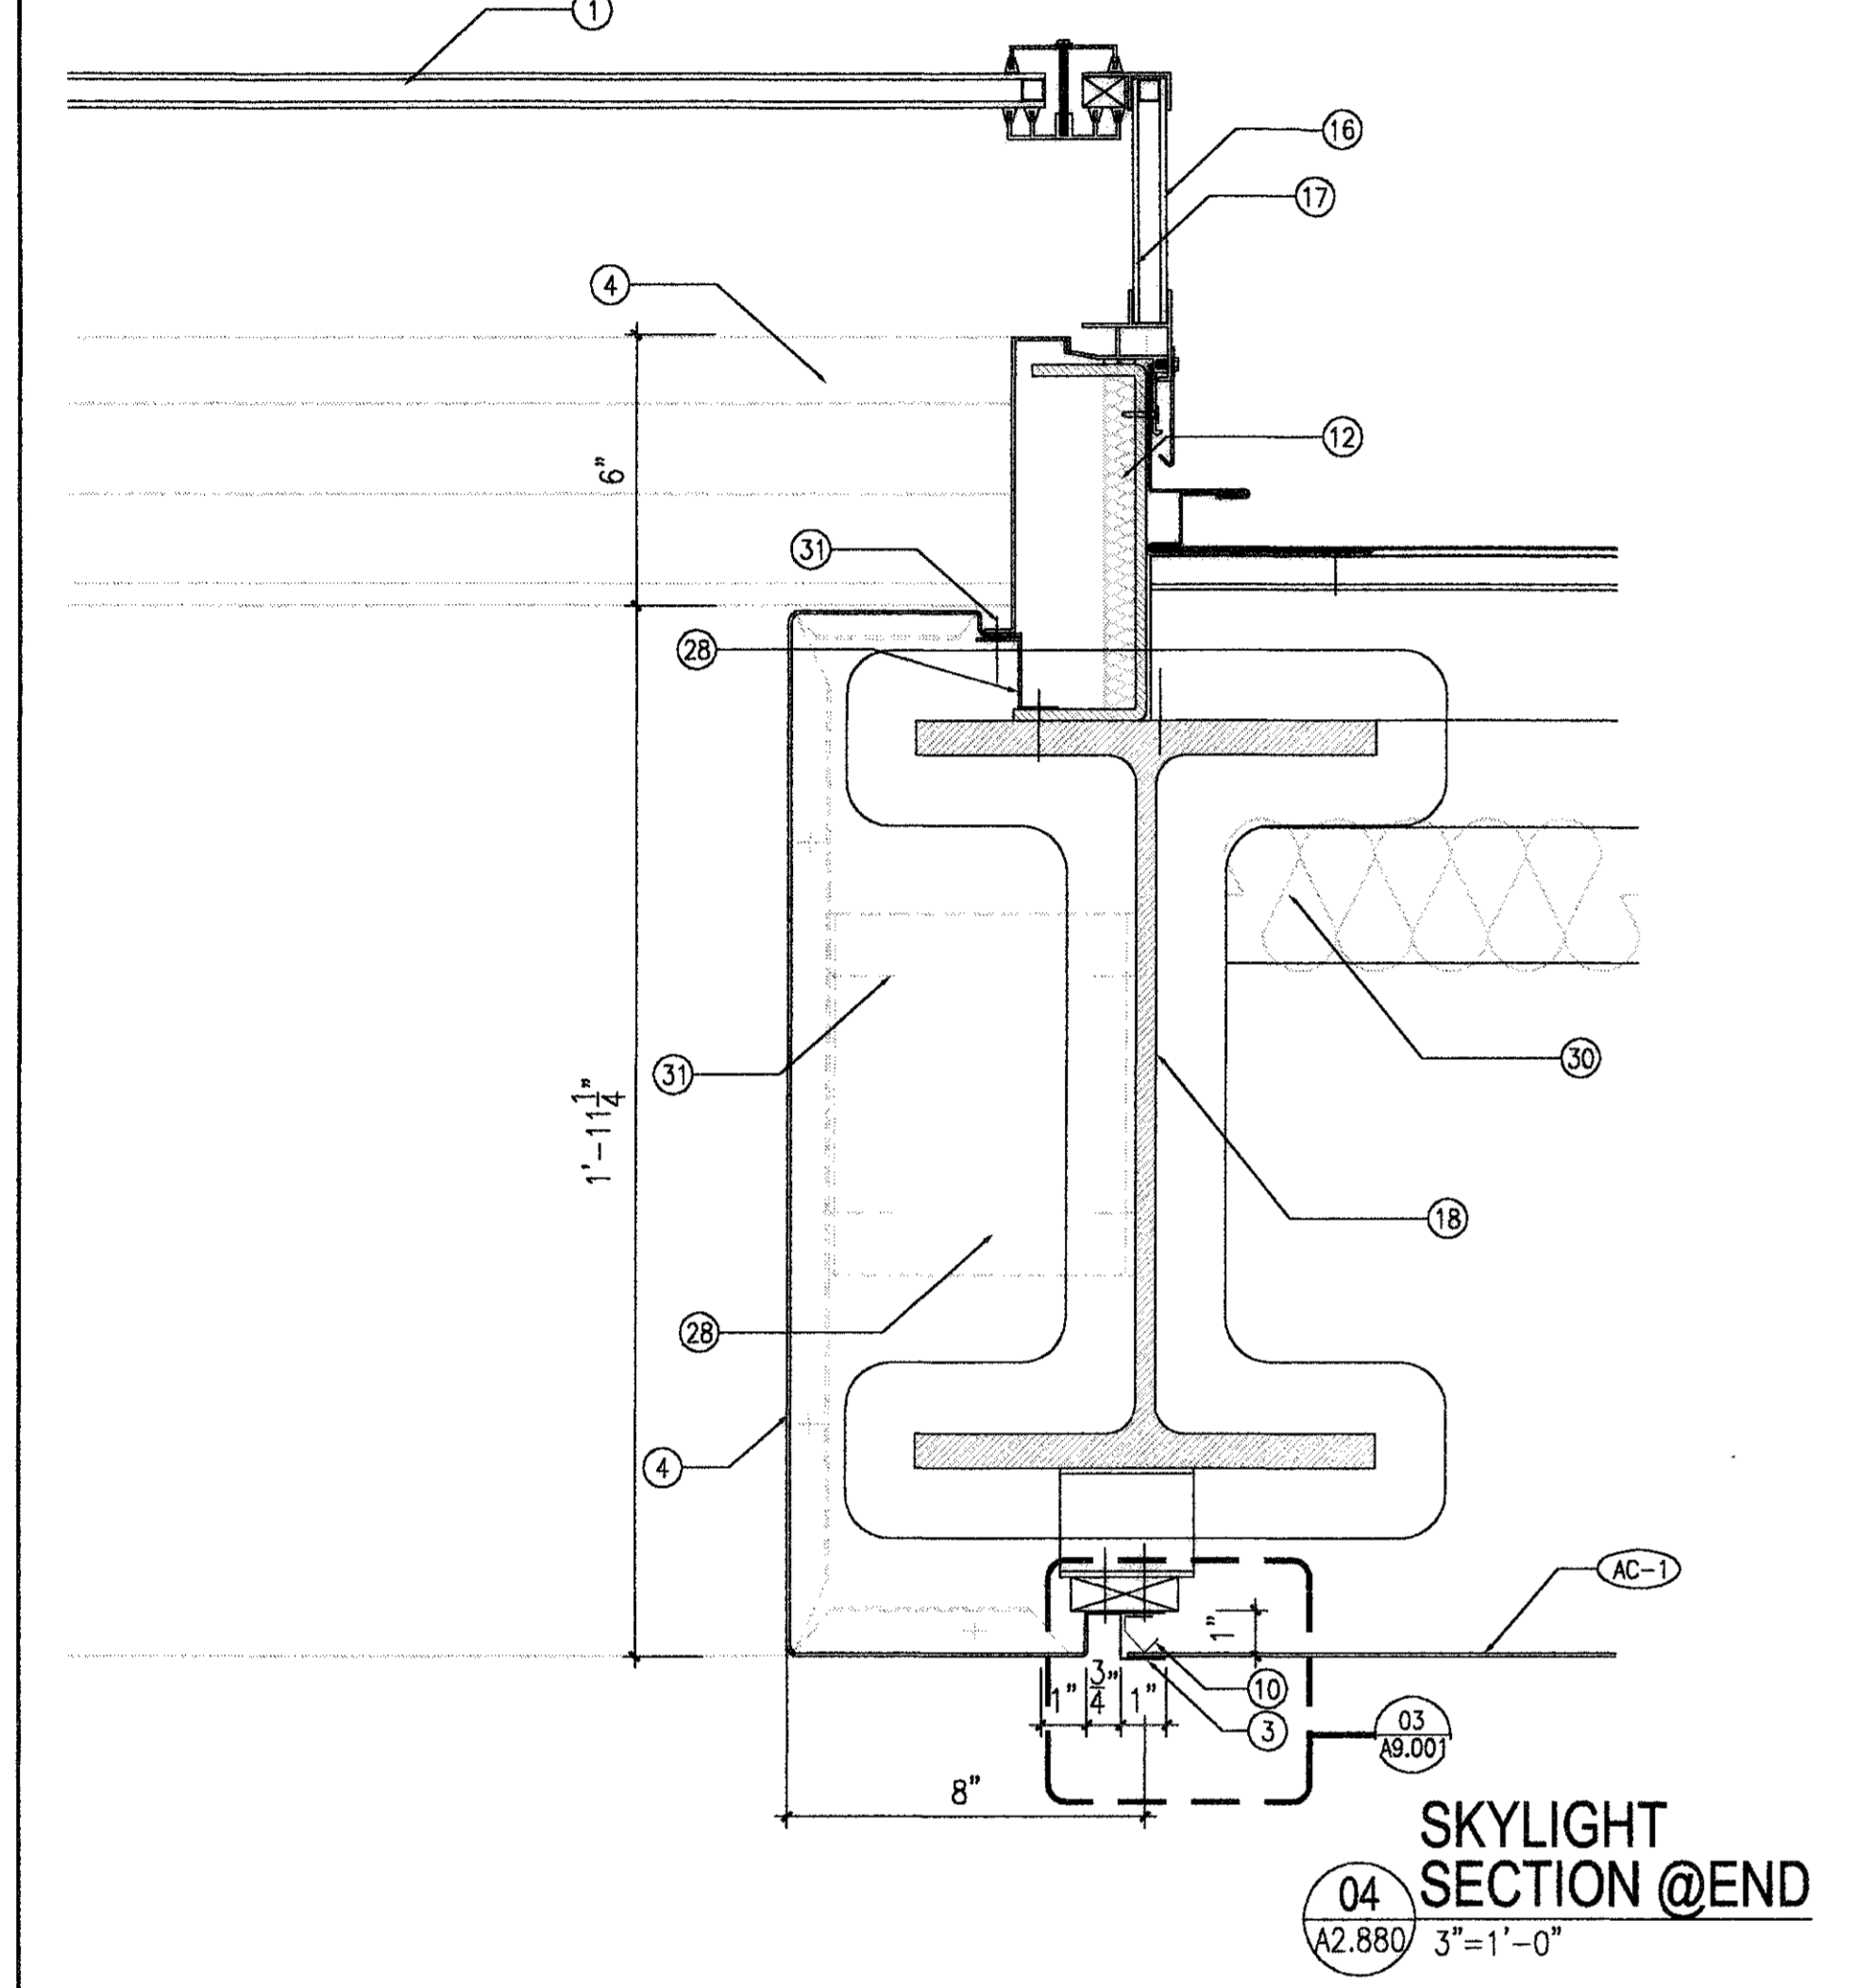

NOTE: REFER TO GRAPHIC SCALE IF ACTUAL SHEET SIZE IS OTHER THAN 30"x42".  
 0" 3" 6" 1"  
 SCALE: 3" = 1'-0"

PROJECT MGR: HEM  
 DESIGNER: SC  
 DRAWN BY: SEM  
 CHECKED BY: AB  
 DRAWING STANDARD: ISEP 07.20.2000  
 SCALE: AS NOTED  
 DATE: 09/14/01

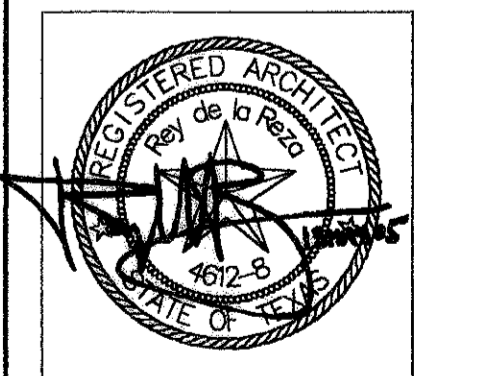


APPROVED BY: DATE:  
 HOUSTON AIRPORT SYSTEM  
 PROJECT NO. 1140  
 C.I.P. NO. A-0354  
 H.A.S. NO. 536C  
 SHEET NO.

PLOT DATE: 02/04/02 HAS FILE: A2.880CA2.880



NO.	DESCRIPTION	DATE	BY
ISSUED FOR BID		10/19/01	
RECORD SET		05/13/05	EM

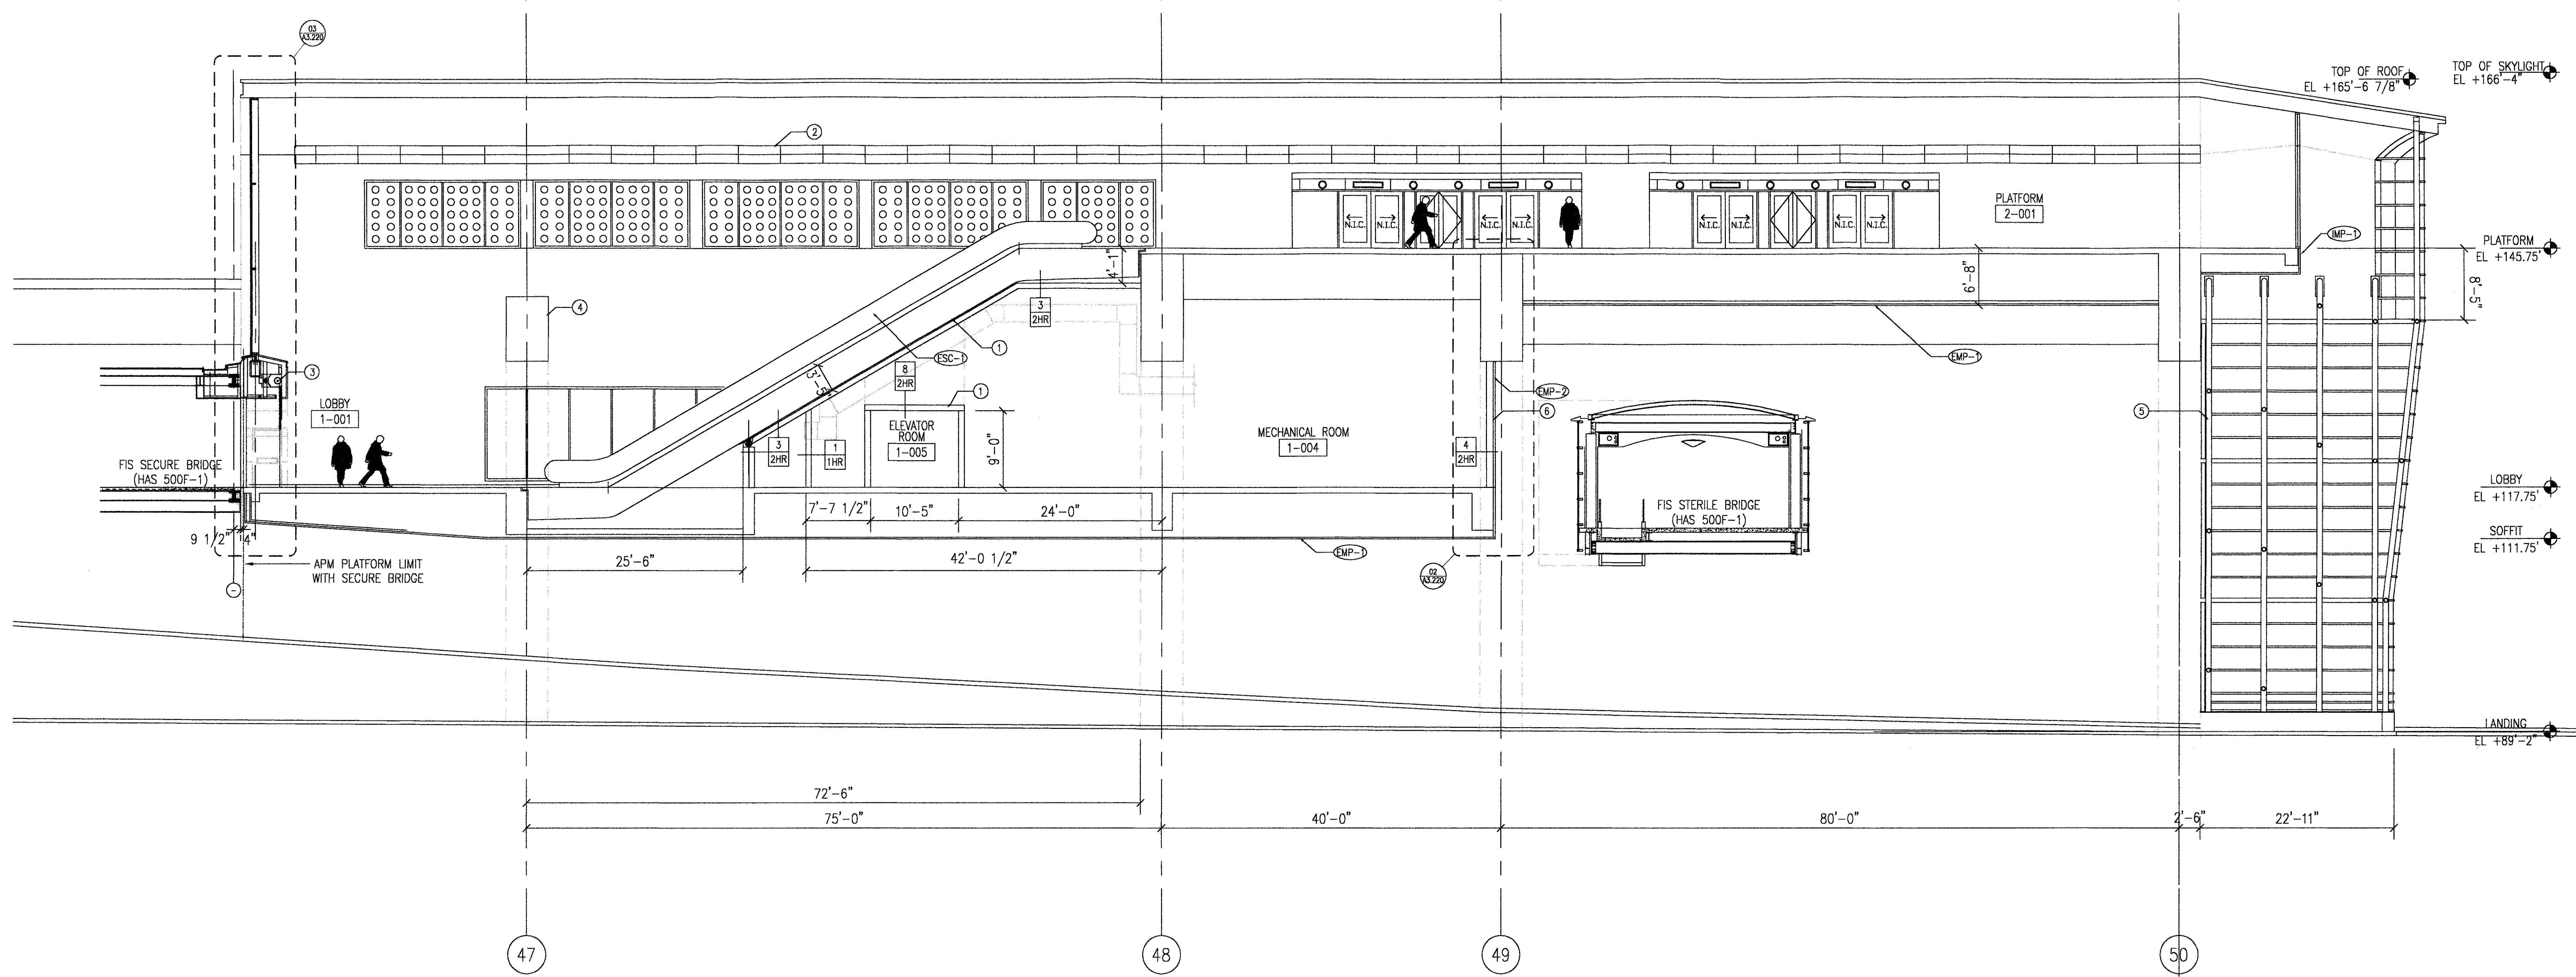

LONGITUDINAL SECTION @ ESCALATORS  
 BETWEEN COLUMN LINES A & A.5  
 01  
 A3.000 1/8"=1'-0"


INTERNATIONAL SERVICES • EXPANSION • PROGRAM  
**APM STATION + PLATFORM**  
 LONGITUDINAL SECTION

**KEYED NOTES:**

- ① PARTITION - 2HR FIRE RATING
- ② A/C DUCT SSIL CLAD
- ③ 2HR ROLL-UP DOOR WITH 2 SWINGING EGRESS DOORS BY McKEON MANUFACTURER OR EQUAL
- ④ CONCRETE BEAM - ARCHITECTURAL CONCRETE
- ⑤ 8" STEEL PIPES - CURTAIN WALL STRUCTURAL FRAME - PAINT - RE STRUCTURAL
- ⑥ INTERIOR FACE OF LOUVERS CLOSED BY 1/8" THK ALUMINUM SHEET WELDED CONTINUOUSLY TO FRAME

**GENERAL NOTES:**

- CURVED ROOF AND SKYLIGHT NOT REPRESENTED ON LONGITUDINAL SECTIONS FOR CLARITY
- (MP-1) INTERIOR STAINLESS STEEL WALL PANELS MULTI DIRECTIONAL MACHINE POLISH
- (EMP-1) EXTERIOR POWDERCOAT METAL WALL PANEL - ALUMINUM PANEL 1/8" THICK - TYPE SERIES 3000 MODIFIED FROM UNA-CLAD - COPPER SALES OR EQUAL  
 POWDERCOAT KYMAR 500 - FOR COLOR RE. SCHEDULE SHEET A2.800
- (ESC-1) MONTGOMERY KONE TRANSIT ESCALATOR WITH GLASS BALUSTRADE
- (EMP-2) POWDERCOAT ALUMINUM LOUVERS - WITH INSECT MESH WHEN USED BY MECHANICAL - CLOSED WITH ALUMINUM SHEET WELDED TO FRAME WHEN NOT USED BY MECHANICAL RE: MECHANICAL FOR OPENINGS

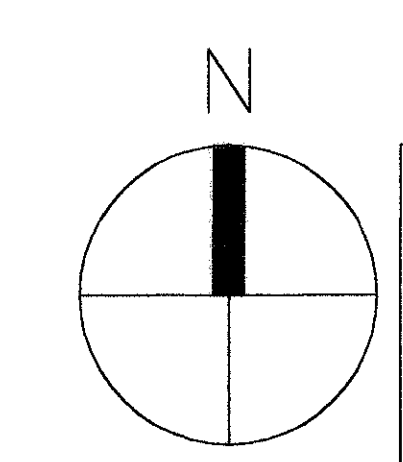


**RECORD DRAWINGS**  
 DO NOT MODIFY  
 Roy de la Reza Architects, Inc.  
 13 May 2005  
 Note: Information used to develop these documents was taken from Record of the Work. Drawings prepared by the construction contractor, Clark Construction Group - Texas. The information provided by the contractor was not verified by the design firm named above.

NOTE: REFER TO GRAPHIC SCALE IF ACTUAL SHEET SIZE IS OTHER THAN 30"x42".  
 0' 4' 8' 16' 24'  
 SCALE: 1/8" = 1'-0"

PROJECT MGR:	HEM
DESIGNER:	SG
DRAWN BY:	SEM
CHECKED BY:	AB
DRAWING STANDARD:	ISEP 07.20.2000

SCALE: 1/8"=1'-0"  
 DATE: 09/14/01

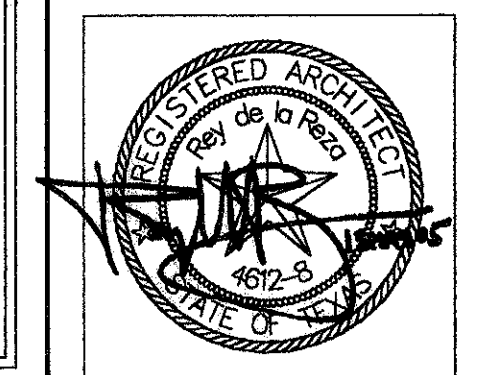

APPROVED BY: \_\_\_\_\_ DATE: \_\_\_\_\_

DIRECTOR  
 HOUSTON AIRPORT SYSTEM

PROJECT NO. 1140

C.I.P. NO. A-0354


H.A.S. NO. 536C

SHEET NO.

**A3.000**



NO.	DESCRIPTION	DATE	BY
RECORD SET	06/13/05	EM	

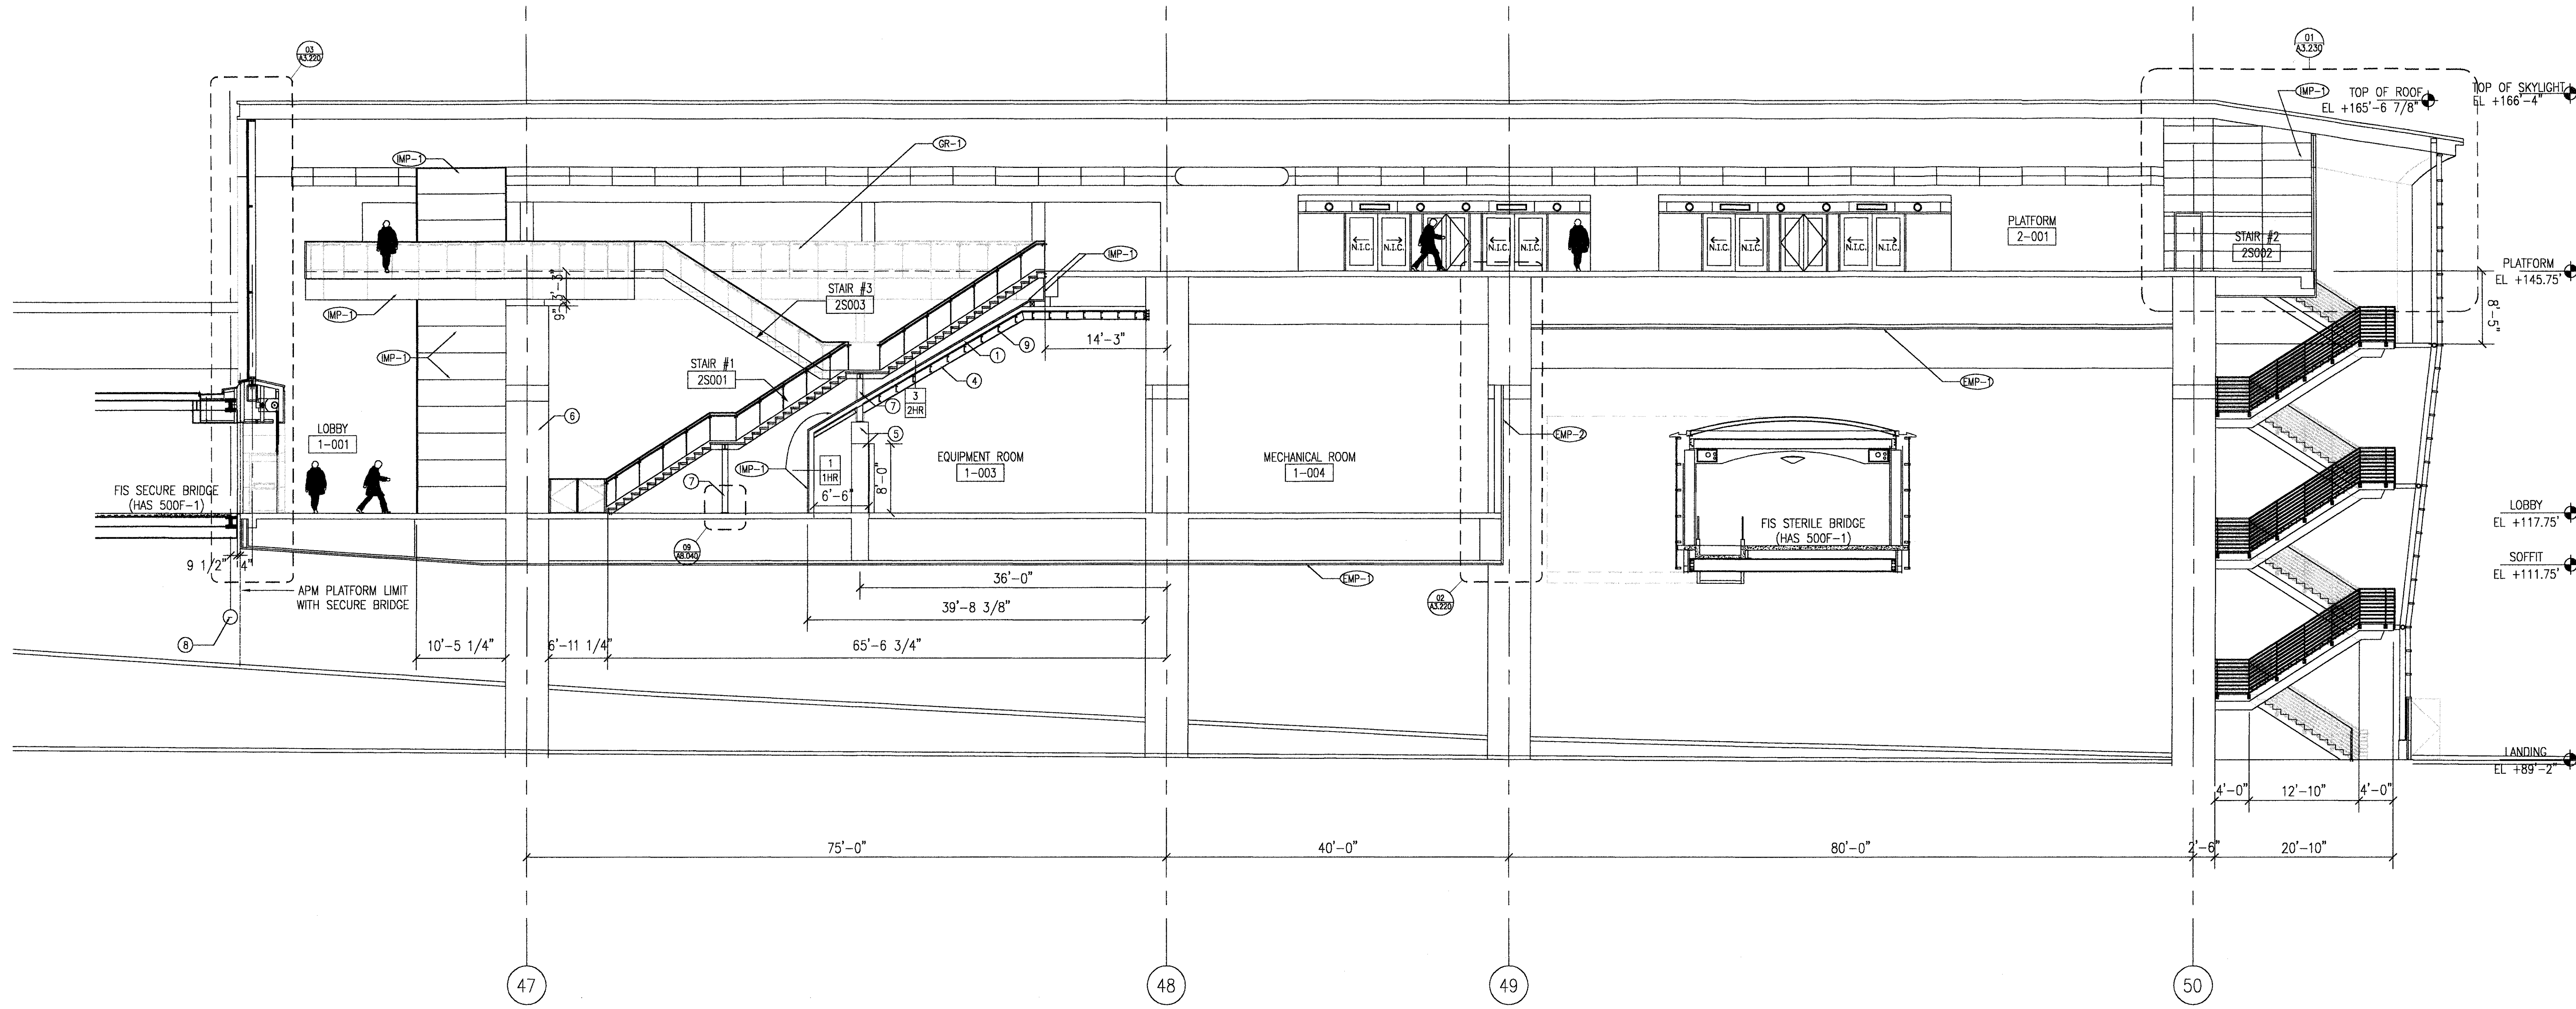

LONGITUNAL SECTION @ STAIRS  
 BETWEEN COLUMN LINES A.5 & B  
 01  
 A3.001 1/8"=1'-0"


INTERNATIONAL SERVICES • EXPANSION • PROGRAM  
**APM STATION + PLATFORM**  
 LONGITUNAL SECTION

**KEYED NOTES:**

- ① PARTITION - 2HR FIRE RATING - ICBO EVALUATION SERVICE INC., EVALUATION REPORT NO. 3579
- ② A/C DUCT SSTL CLAD
- ③ 2HR ROLL-UP DOOR
- ④ STEEL BEAM WITH 3HR SPRAY FIREPROOFING
- ⑤ CONCRETE COLUMN AND CONCRETE BEAM - RE STRUCTURE
- ⑥ CONCRETE COLUMN - ARCHITECTURAL CONCRETE
- ⑦ 8" STEEL TUBE & BASE PLATE-ANCHOR TO CONCRETE - SUPPORT OF STAIR LANDING
- ⑧ SECURE BRIDGE COLUMN GRID LINE. LOCATION TO BE COORDINATED WITH HAS 500F-1
- ⑨ 8" STEEL STUD @ 2' O.C. 10 GA - SECURED TO W12 BEAM AND WALL - TO SUSPEND CABLE TRAYS AND CONDUITS IN EQUIPMENT ROOM

**GENERAL NOTES:**


- (GR-1) GLASS GUARDRAIL
- (MP-1) INTERIOR STAINLESS STEEL WALL PANELS MULTI DIRECTIONAL MACHINE POLISH
- (EMP-1) EXTERIOR POWDERCOAT METAL WALL PANEL - ALUMINUM PANEL 1/8" THICK - TYPE SERIES 3000 MODIFIED FROM UNA-CLAD - COPPER SALES OR EQUAL POWDERCOAT KYNAR 500 - FOR COLOR RE. SCHEDULE SHEET A2.800
- (ESC-1) MONTGOMERY KONE TRANSIT ESCALATOR WITH GLASS BALUSTRADE
- (EMP-2) POWDERCOAT ALUMINUM LOUVERS - WITH INSECT MESH WHEN USED BY MECHANICAL - CLOSED WITH ALUMINUM SHEET WELDED TO FRAME WHEN NOT USED BY MECHANICAL RE: MECHANICAL FOR OPENINGS

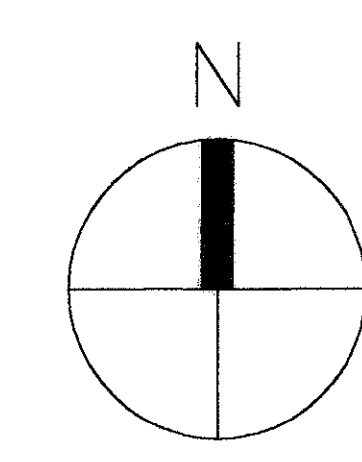

**RECORD DRAWINGS**  
 DO NOT MODIFY  
 Rey de la Reza Architects, Inc.  
 13 May 2005  
 Note: Information used to develop these documents was taken from Record of the Work Drawings prepared by the construction contractor, Clark Construction Group - Texas. The information provided by the contractor was not verified by the design firm named above.

NOTE: REFER TO GRAPHIC SCALE IF ACTUAL SHEET SIZE IS OTHER THAN 30"x42".  
 0' 4' 8' 16' 24'  
 SCALE: 1/8" = 1'-0"


PROJECT MGR:	HEM
DESIGNER:	SG
DRAWN BY:	SEM
CHECKED BY:	AB
DRAWING STANDARD:	ISEP 07.20.2000
SCALE:	1/8"=1'-0"
DATE:	09/14/01

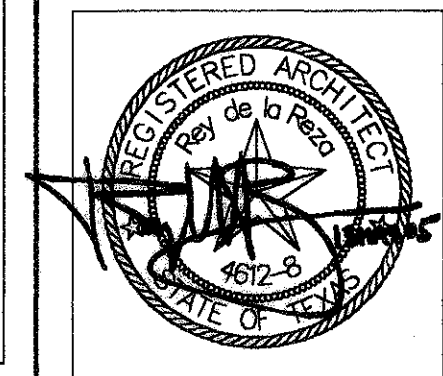

APPROVED BY:	DATE:
DIRECTOR	
HOUSTON AIRPORT SYSTEM	
PROJECT NO.	1140
C.I.P. NO.	A-0354
H.A.S. NO.	536C
SHEET NO.	



NO.	DESCRIPTION	DATE	BY
1	ISSUED FOR BID	10/19/01	
2	RECORD SET	05/13/05	EM

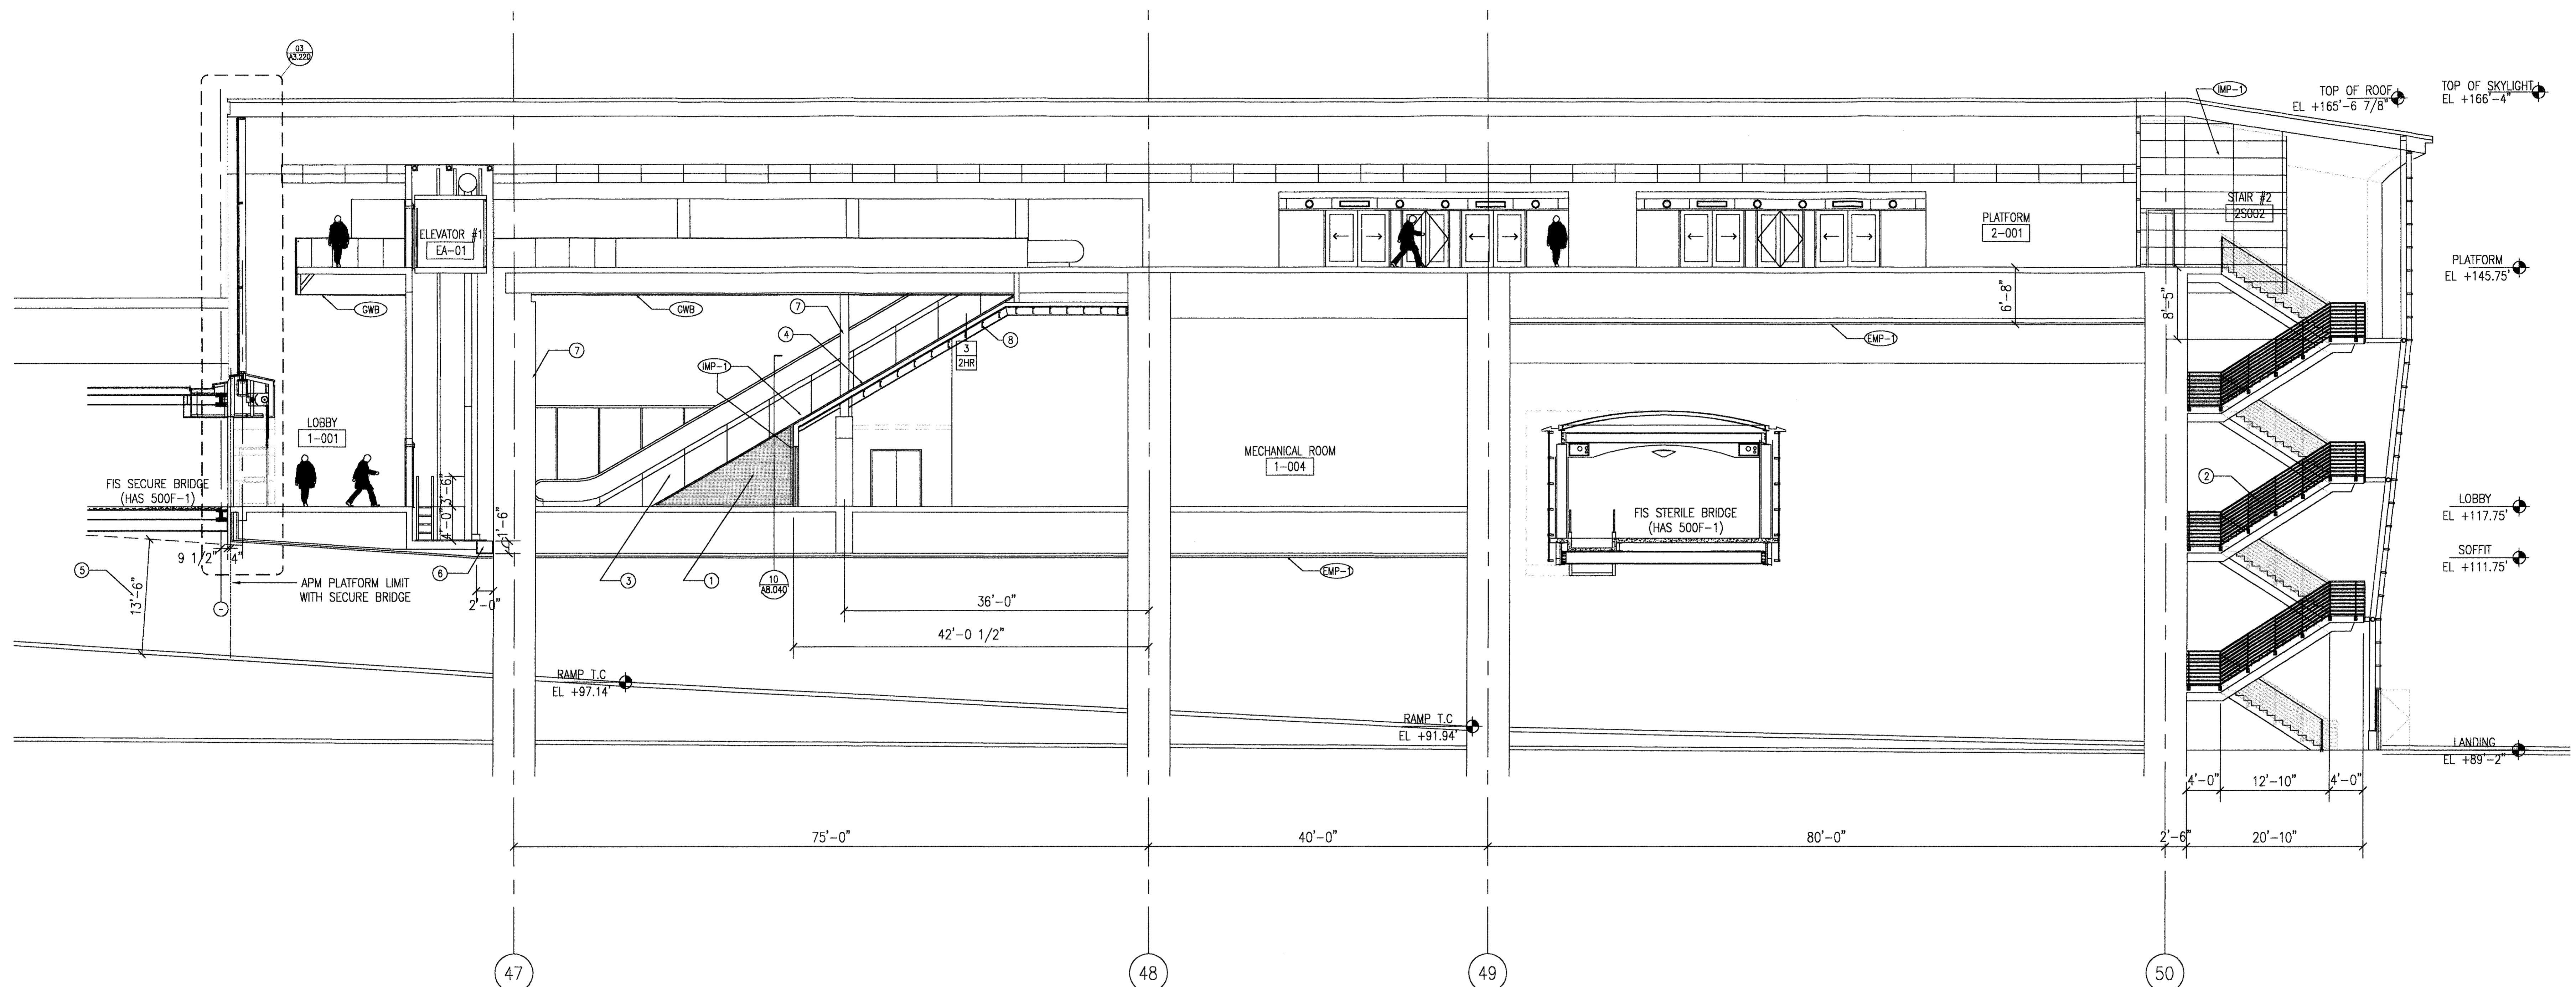

LONGITUDINAL SECTION  
 @ COLUMN LINE A.5  
 01  
 A3.002 1/8" = 1'-0"


INTERNATIONAL • SERVICES • EXPANSION • PROGRAM  
**APM STATION + PLATFORM**  
 LONGITUDINAL SECTION

**KEYED NOTES:**

- ① METAL LOUVERS WITH POWDERCOATED FINISH - COLOR #2
- ② STEEL GUARDRAIL - PAINT
- ③ SSSL CLADDING ON ESCALATOR VISIBLE FACES
- ④ PARTITION SLOPE TO MATCH ESCALATOR SLOPE
- ⑤ MINIMUM CLEARANCE AT RAMP UP TO FIS DEPARTURE: 13'-6" TO BE COORDINATED WITH HAS PROJECT 536A-2
- ⑥ STEEL PAN @ SUMP PIT - RE: STRUCTURAL WITH WATER PROOFING MEMBRANE TYPE VYCOR ULTRA FROM GRACE MANUFACTURER OR EQUAL
- ⑦ CONCRETE COLUMN - PAINT
- ⑧ 8" STEEL STUD @ 2' O.C. 10 GA - SECURED TO W12 BEAM AND WALL - TO SUSPEND CABLE TRAYS AND CONDUITS IN EQUIPMENT ROOM


**GENERAL NOTES:**

- (IMP-1) INTERIOR STAINLESS STEEL WALL PANELS MULTI DIRECTIONAL MACHINE POLISH
- (EMP-1) EXTERIOR POWDERCOAT METAL WALL PANEL - ALUMINUM PANEL 1/8" THICK - TYPE SERIES 3000 MODIFIED FROM UNA-CLAD - COPPER SALES OR EQUAL POWDERCOAT KYNAR 500 - FOR COLOR RE. SCHEDULE SHEET A2.800
- (GWB) PAINT GYPSUM BOARD

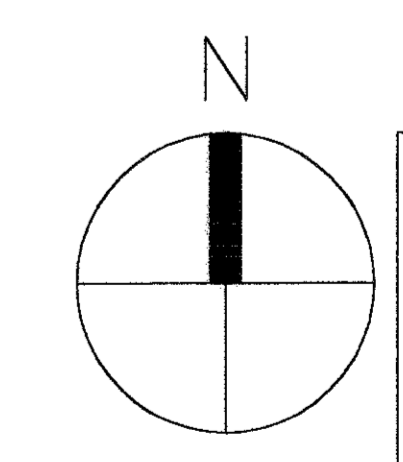


**RECORD DRAWINGS**  
 DO NOT MODIFY  
 Rey de la Reza Architects, Inc.  
 13 May 2005

Note: Information used to develop these documents was taken from Record of the Work Drawings prepared by the construction contractor, Clark Construction Group - Texas. The information provided by the contractor was not verified by the design firm named above.

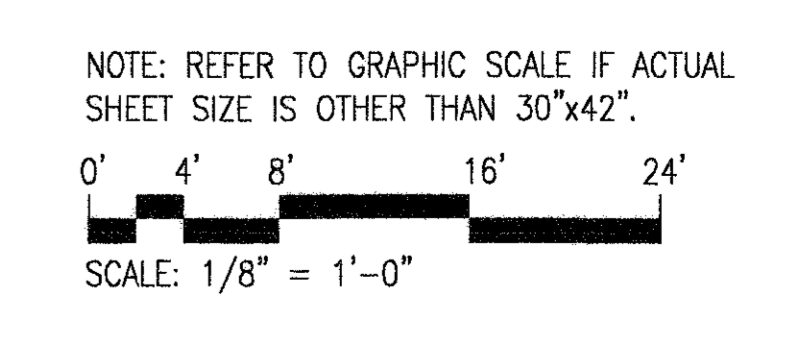

PROJECT MGR: HEM  
 DESIGNER: SG  
 DRAWN BY: SEM  
 CHECKED BY: AB  
 DRAWING STANDARD: ISEP 07.20.2000  
 SCALE: 1/8" = 1'-0"  
 DATE: 09/14/01

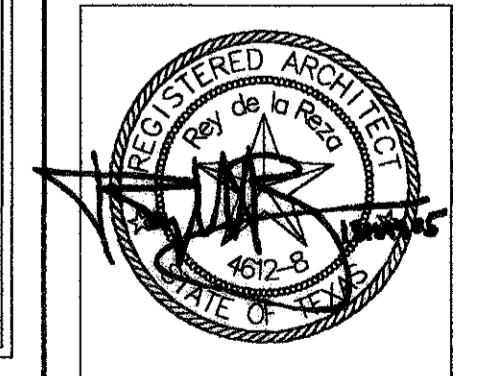

APPROVED BY: DATE:  
 DIRECTOR  
 HOUSTON AIRPORT SYSTEM

PROJECT NO. 1140  
 C.I.P. NO. A-0354  
 H.A.S. NO. 536C  
 SHEET NO.




**GENERAL NOTES:**

- (EMP-1) EXTERIOR POWDERCOAT METAL WALL PANEL - ALUMINUM PANEL 1/8" THICK - TYPE SERIES 3000 MODIFIED FROM UNA-CLAD - COPPER SALES OR EQUAL. POWDERCOAT KYNAR 500 - FOR COLOR RE. SCHEDULE SHEET A2.800
- (RF-1) STANDING SEAM METAL ROOF - TYPE UC3 FROM UNA-CLAD - COPPER SALES OR EQUAL - WIDTH 1'-0" - POWDERCOAT KYNAR 500; COLOR#2 SILVER METALLIC


REVISIONS		
NO.	DESCRIPTION	DATE
1	ISSUED FOR BID	10/19/01
2	RECORD SET	05/13/05 EM

**KEYED NOTES:**


- 1 SKYLIGHT - RE SHEET A2.880
- 2 C.I.P. CONCRETE BEAM - ARCHITECTURAL CONCRETE
- 3 LAMINATED GLASS WITH PARTIAL WHITE INTERLAYER
- 4 MEP SUPPLY FROM FIS BRIDGE (500F-1) HOT WATER, CHILLED WATER, SPRINKLER, WATER, ELECTRICAL - REFER TO MEP - AND COORDINATE WITH 500F-1 @ SECURE BRIDGE
- 5 2"3" HIGH C.I.P. CONCRETE WALL BY OTHERS - N.I.C. - HAS 536A-2
- 6 CONCRETE PAVEMENT BY OTHERS - N.I.C. - (HAS LANDSCAPING PROJECT)
- 7 CENTER POINT OF CURVED ROOF AND CEILING
- 8 SSTL CLADDING @ DUCT CONNECTION - 1/16" THK - MULTI DIRECTIONAL MACHINE POLISH

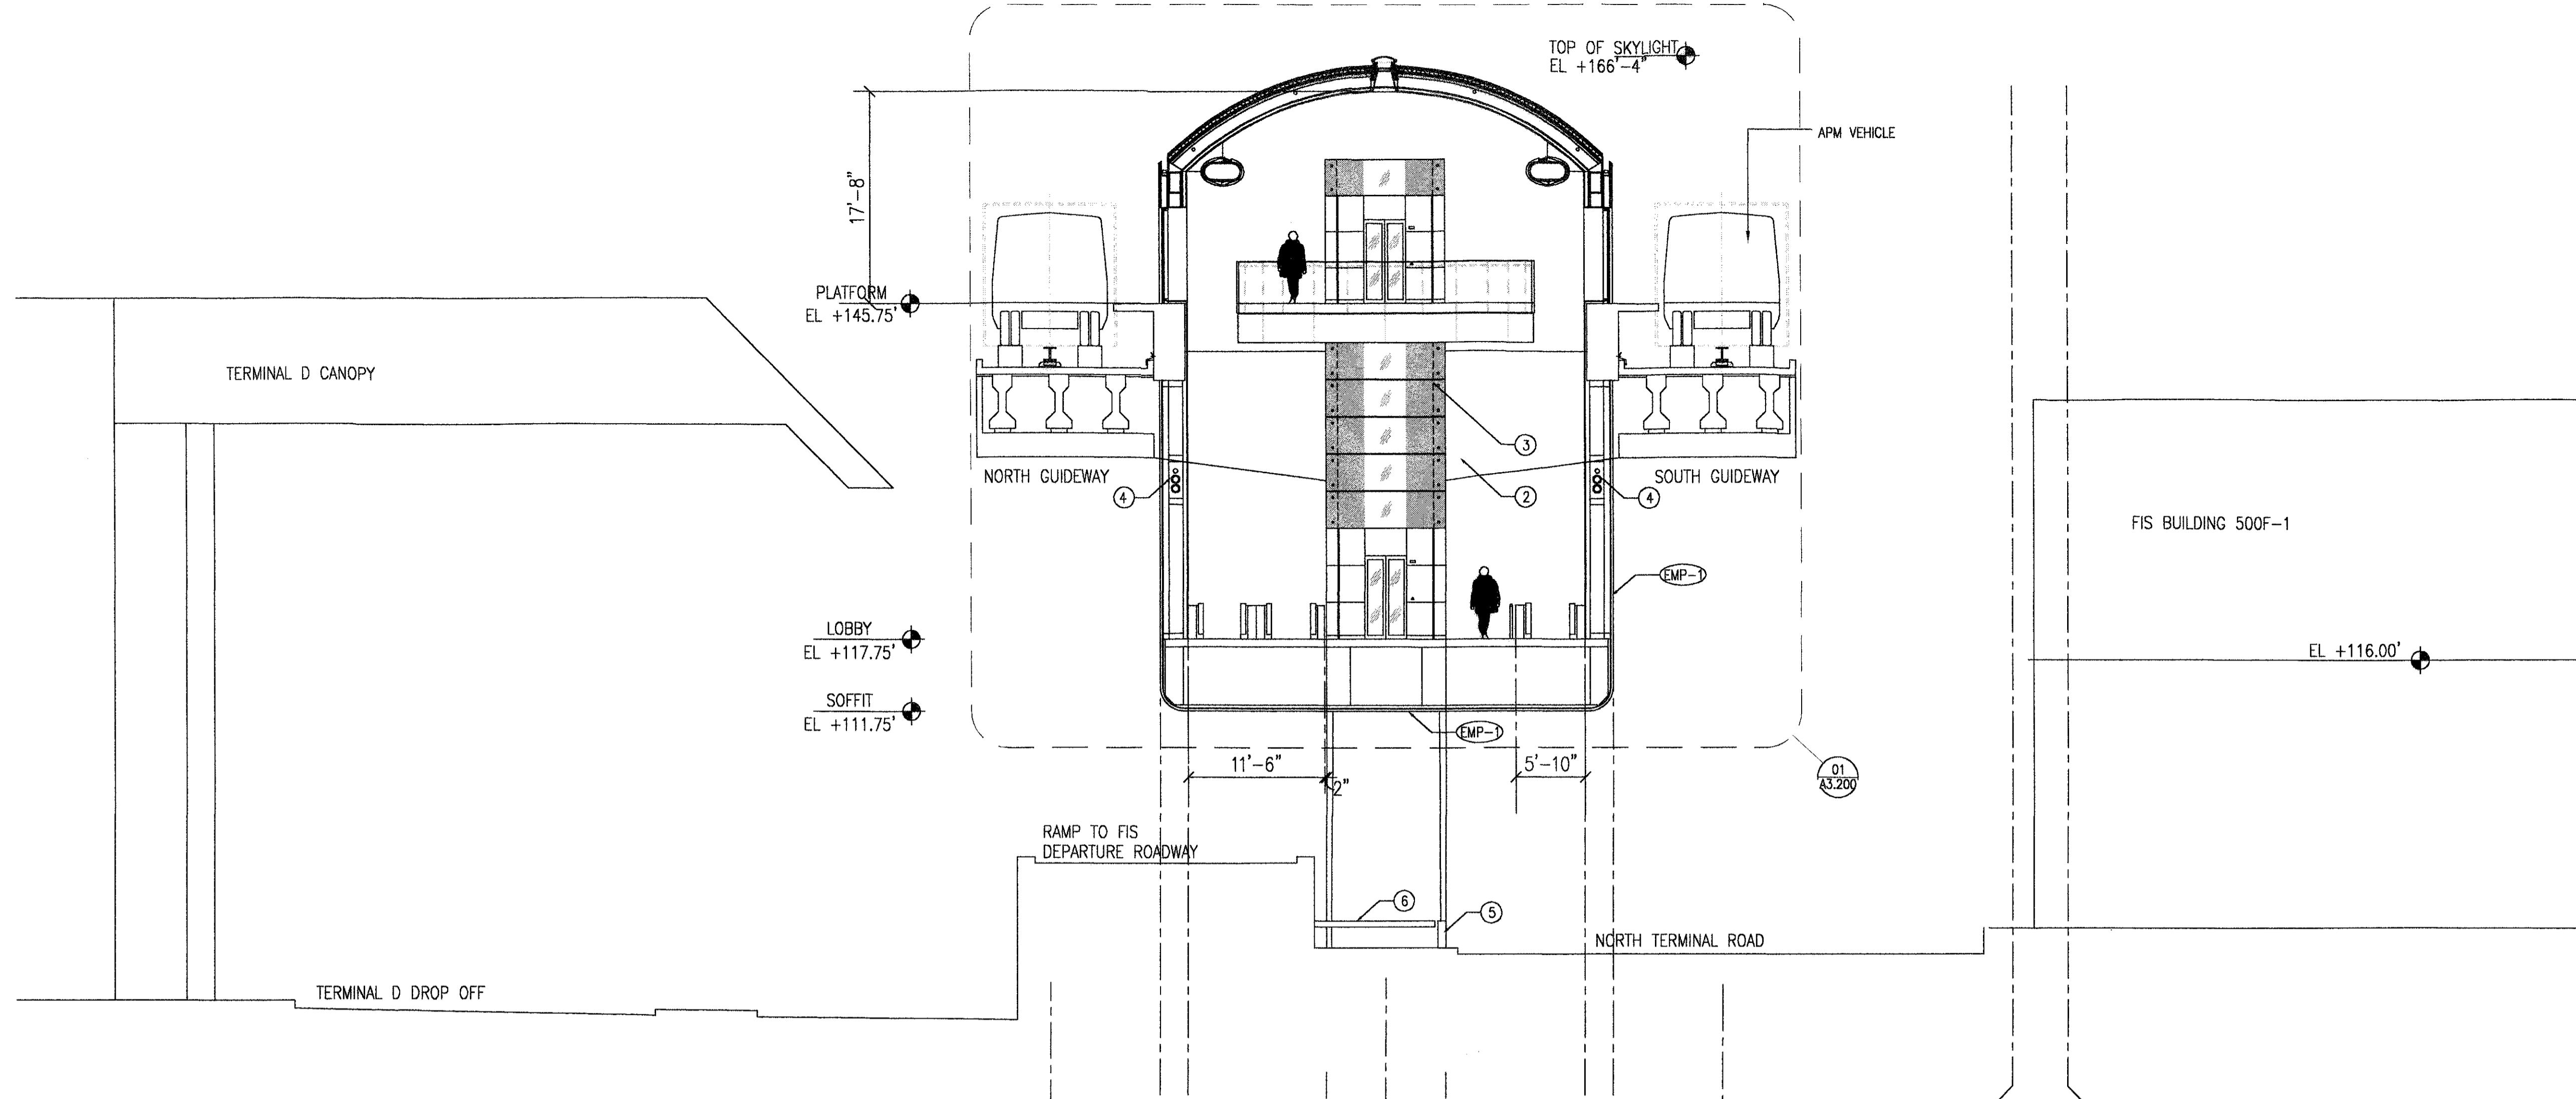

**CROSS SECTION @ LOBBY**  
 01  
 A3.100 1/8"=1'-0"

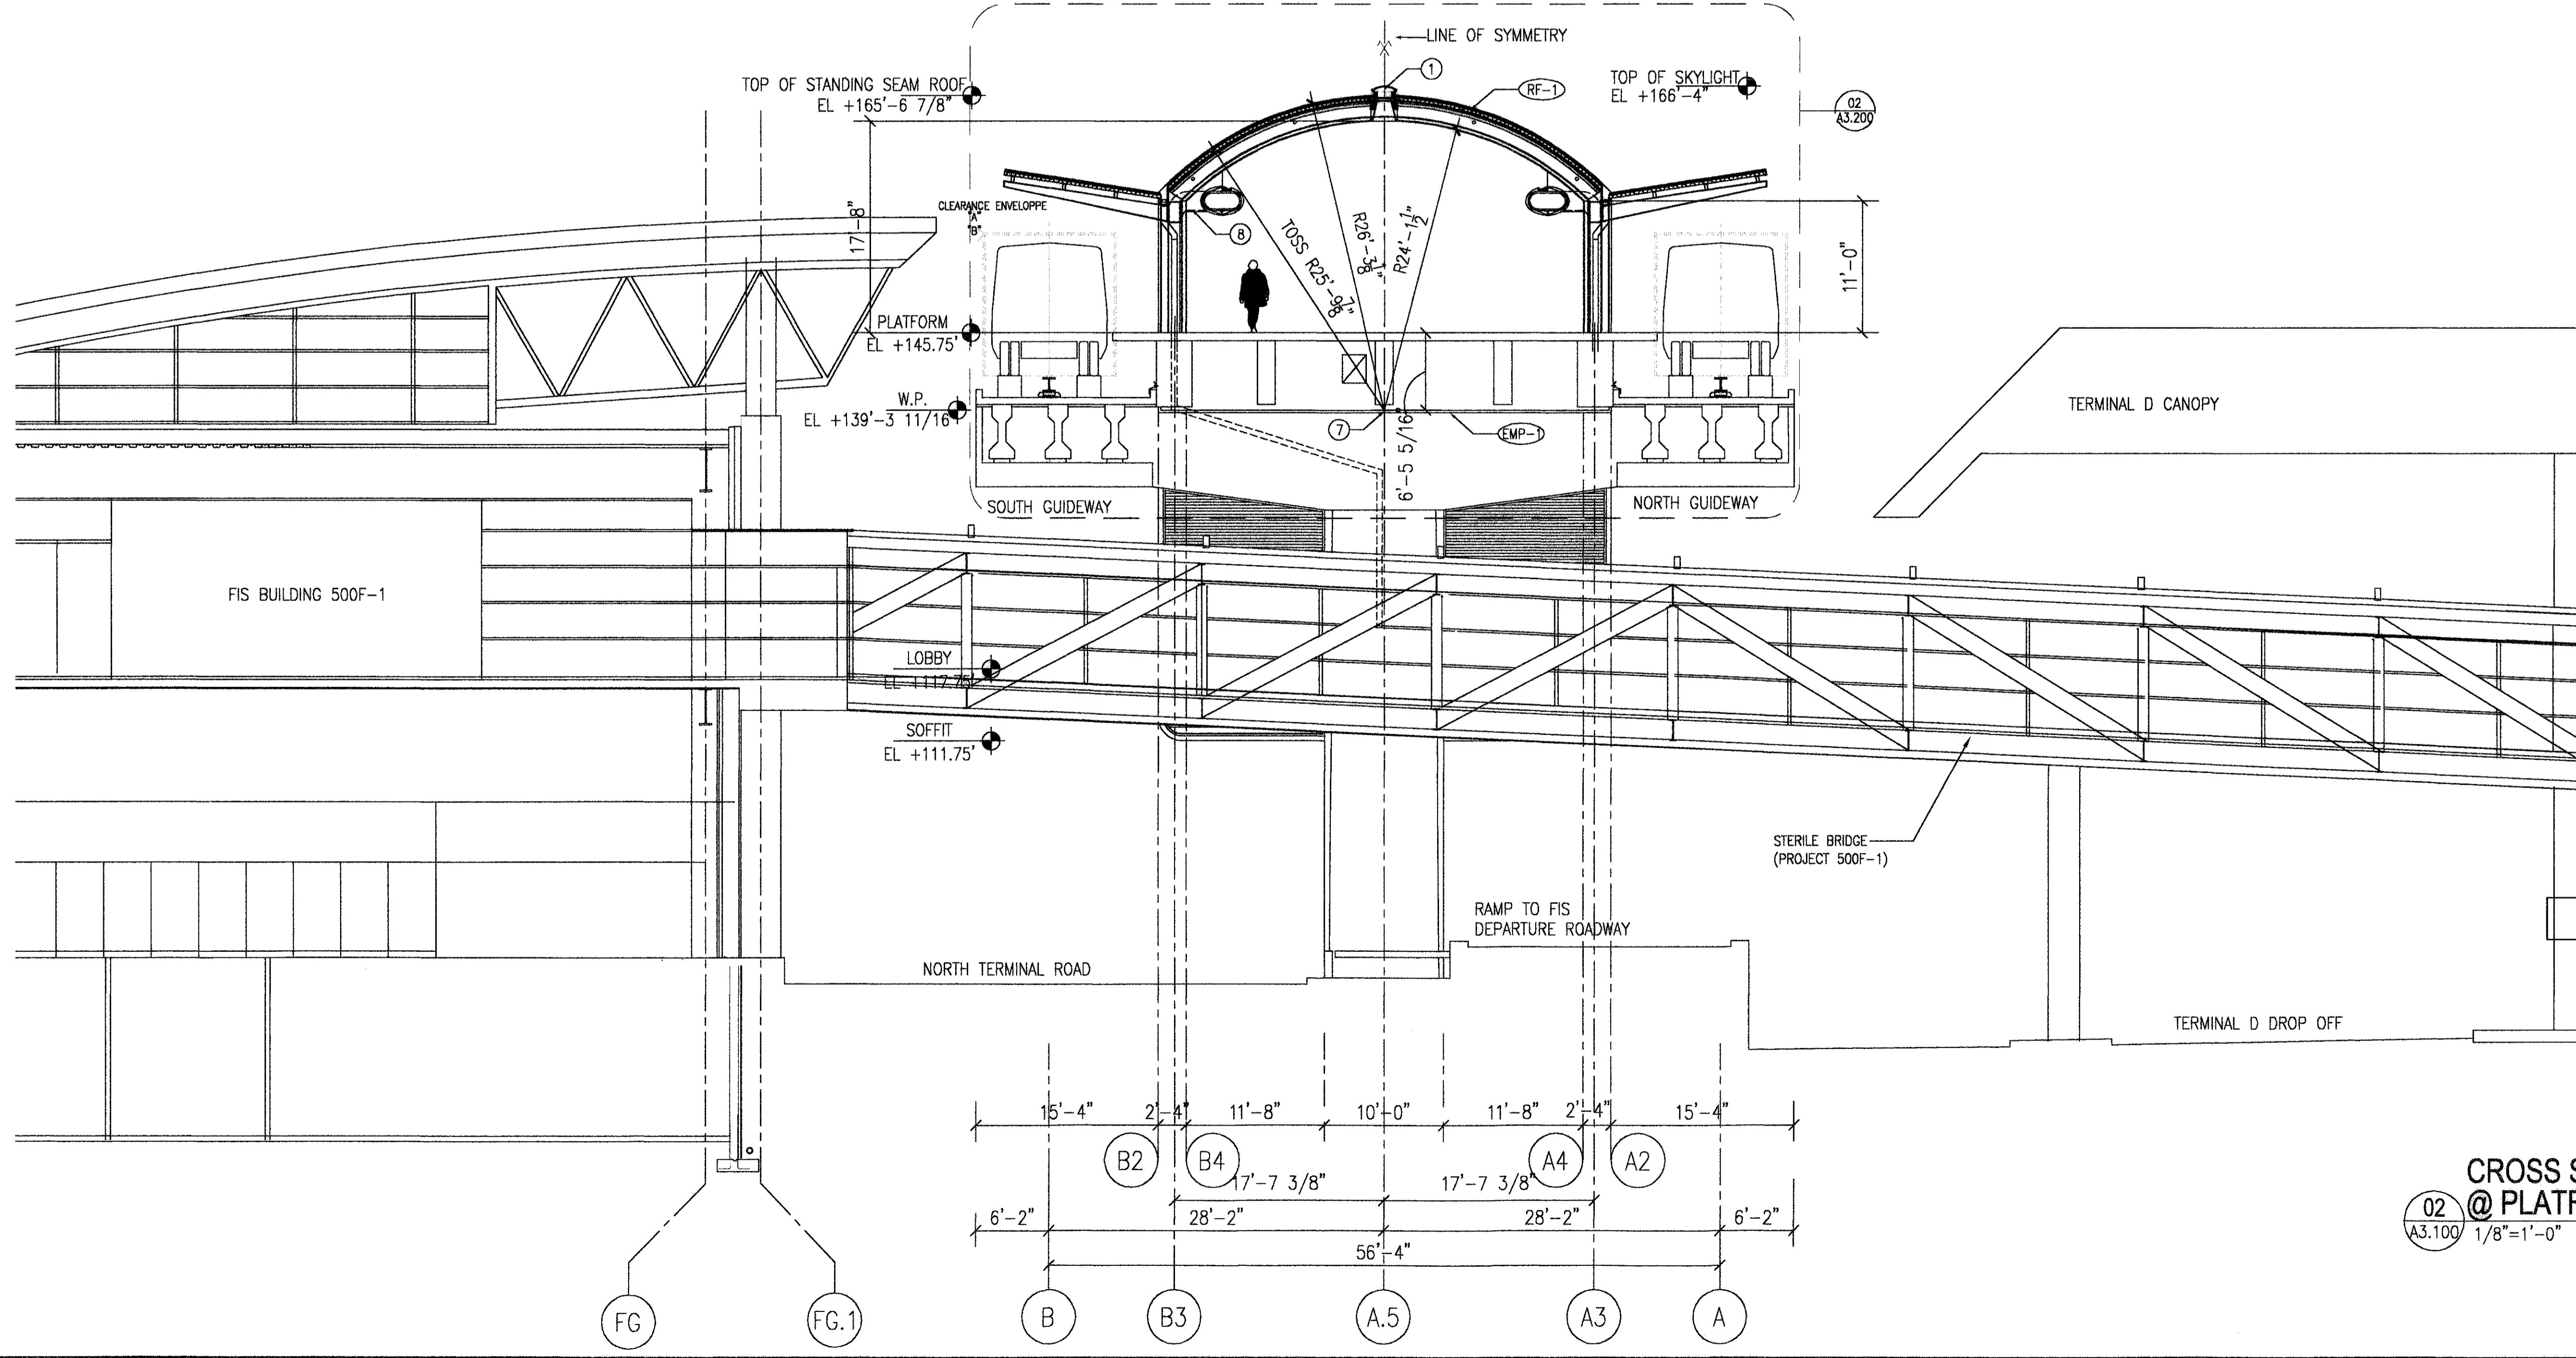

**CROSS SECTION @ PLATFORM**  
 02  
 A3.100 1/8"=1'-0"

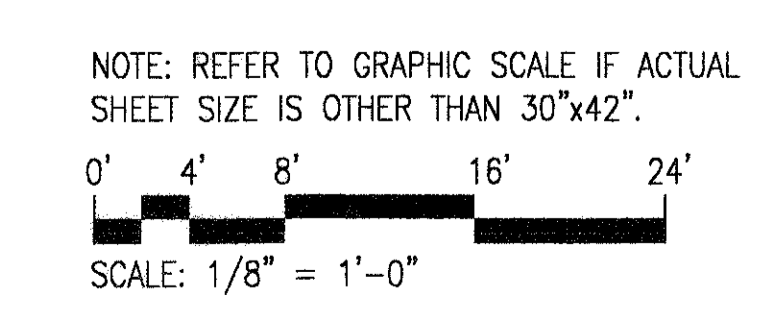

**RECORD DRAWINGS**  
 DO NOT MODIFY  
 Rey de la Reza Architects, Inc.  
 13 May 2005


Note: Information used to develop these documents was taken from Record of the Work Drawings prepared by the construction contractor, Clark Construction Group - Texas. The information provided by the contractor was not verified by the design firm named above.

INTERNATIONAL • SERVICES • EXPANSION • PROGRAM

**APM STATION + PLATFORM**

CROSS SECTIONS

PROJECT MGR:	HJM
DESIGNER:	SG
DRAWN BY:	SEM
CHECKED BY:	AB
DRAWING STANDARD:	ISIP 07.20.2000
SCALE:	1/8"=1'-0"
DATE:	09/14/01

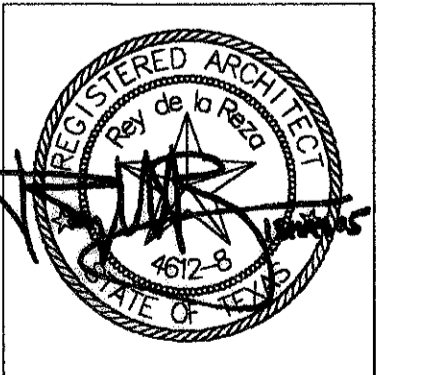

APPROVED BY:	DATE:
DIRECTOR	
HOUSTON AIRPORT SYSTEM	
PROJECT NO.	1140
C.I.P. NO.	A-0354
H.A.S. NO.	536C
SHEET NO.	




**GENERAL NOTES:**

- OVERALL DIMENSIONS @ SLIDING DOORS TO BE COORDINATED WITH HAS 536D
- (EMP-2) POWDERCOAT ALUMINUM LOUVERS  
 - WITH INSECT MESH WHEN USED BY MECHANICAL  
 - CLOSED WITH 1/8" THK ALUMINUM SHEET  
 WELDED CONTINUOUSLY TO FRAME WHEN NOT USED BY MECHANICAL  
 RE: MECHANICAL FOR OPENINGS
- (RF-1) STANDING SEAM METAL ROOF - TYPE UC3 FROM LUNA-CLAD - COPPER SALES OR EQUAL - WIDTH 1'-0" - POWDERCOAT KYNAR 500; COLOR#2 SILVER METALLIC

REVISIONS			
NO.	DESCRIPTION	DATE	BY
ISSUED FOR BID		10/19/01	
RECORD SET		05/13/05	EM

**KEYED NOTES:**

- ① SKYLIGHT - RE SHEET A2.880
- ② SLIDING DOORS N.I.C. - TO BE COORDINATED WITH HAS 536D
- ③ 12" ALUMINUM CHANNEL - POWDERCOATED COLOR#1 - FASTENING NOT VISIBLE; ANCHORED TO STRUCTURE BY ALUM PLATE WELD TO BACK OF CHANNEL

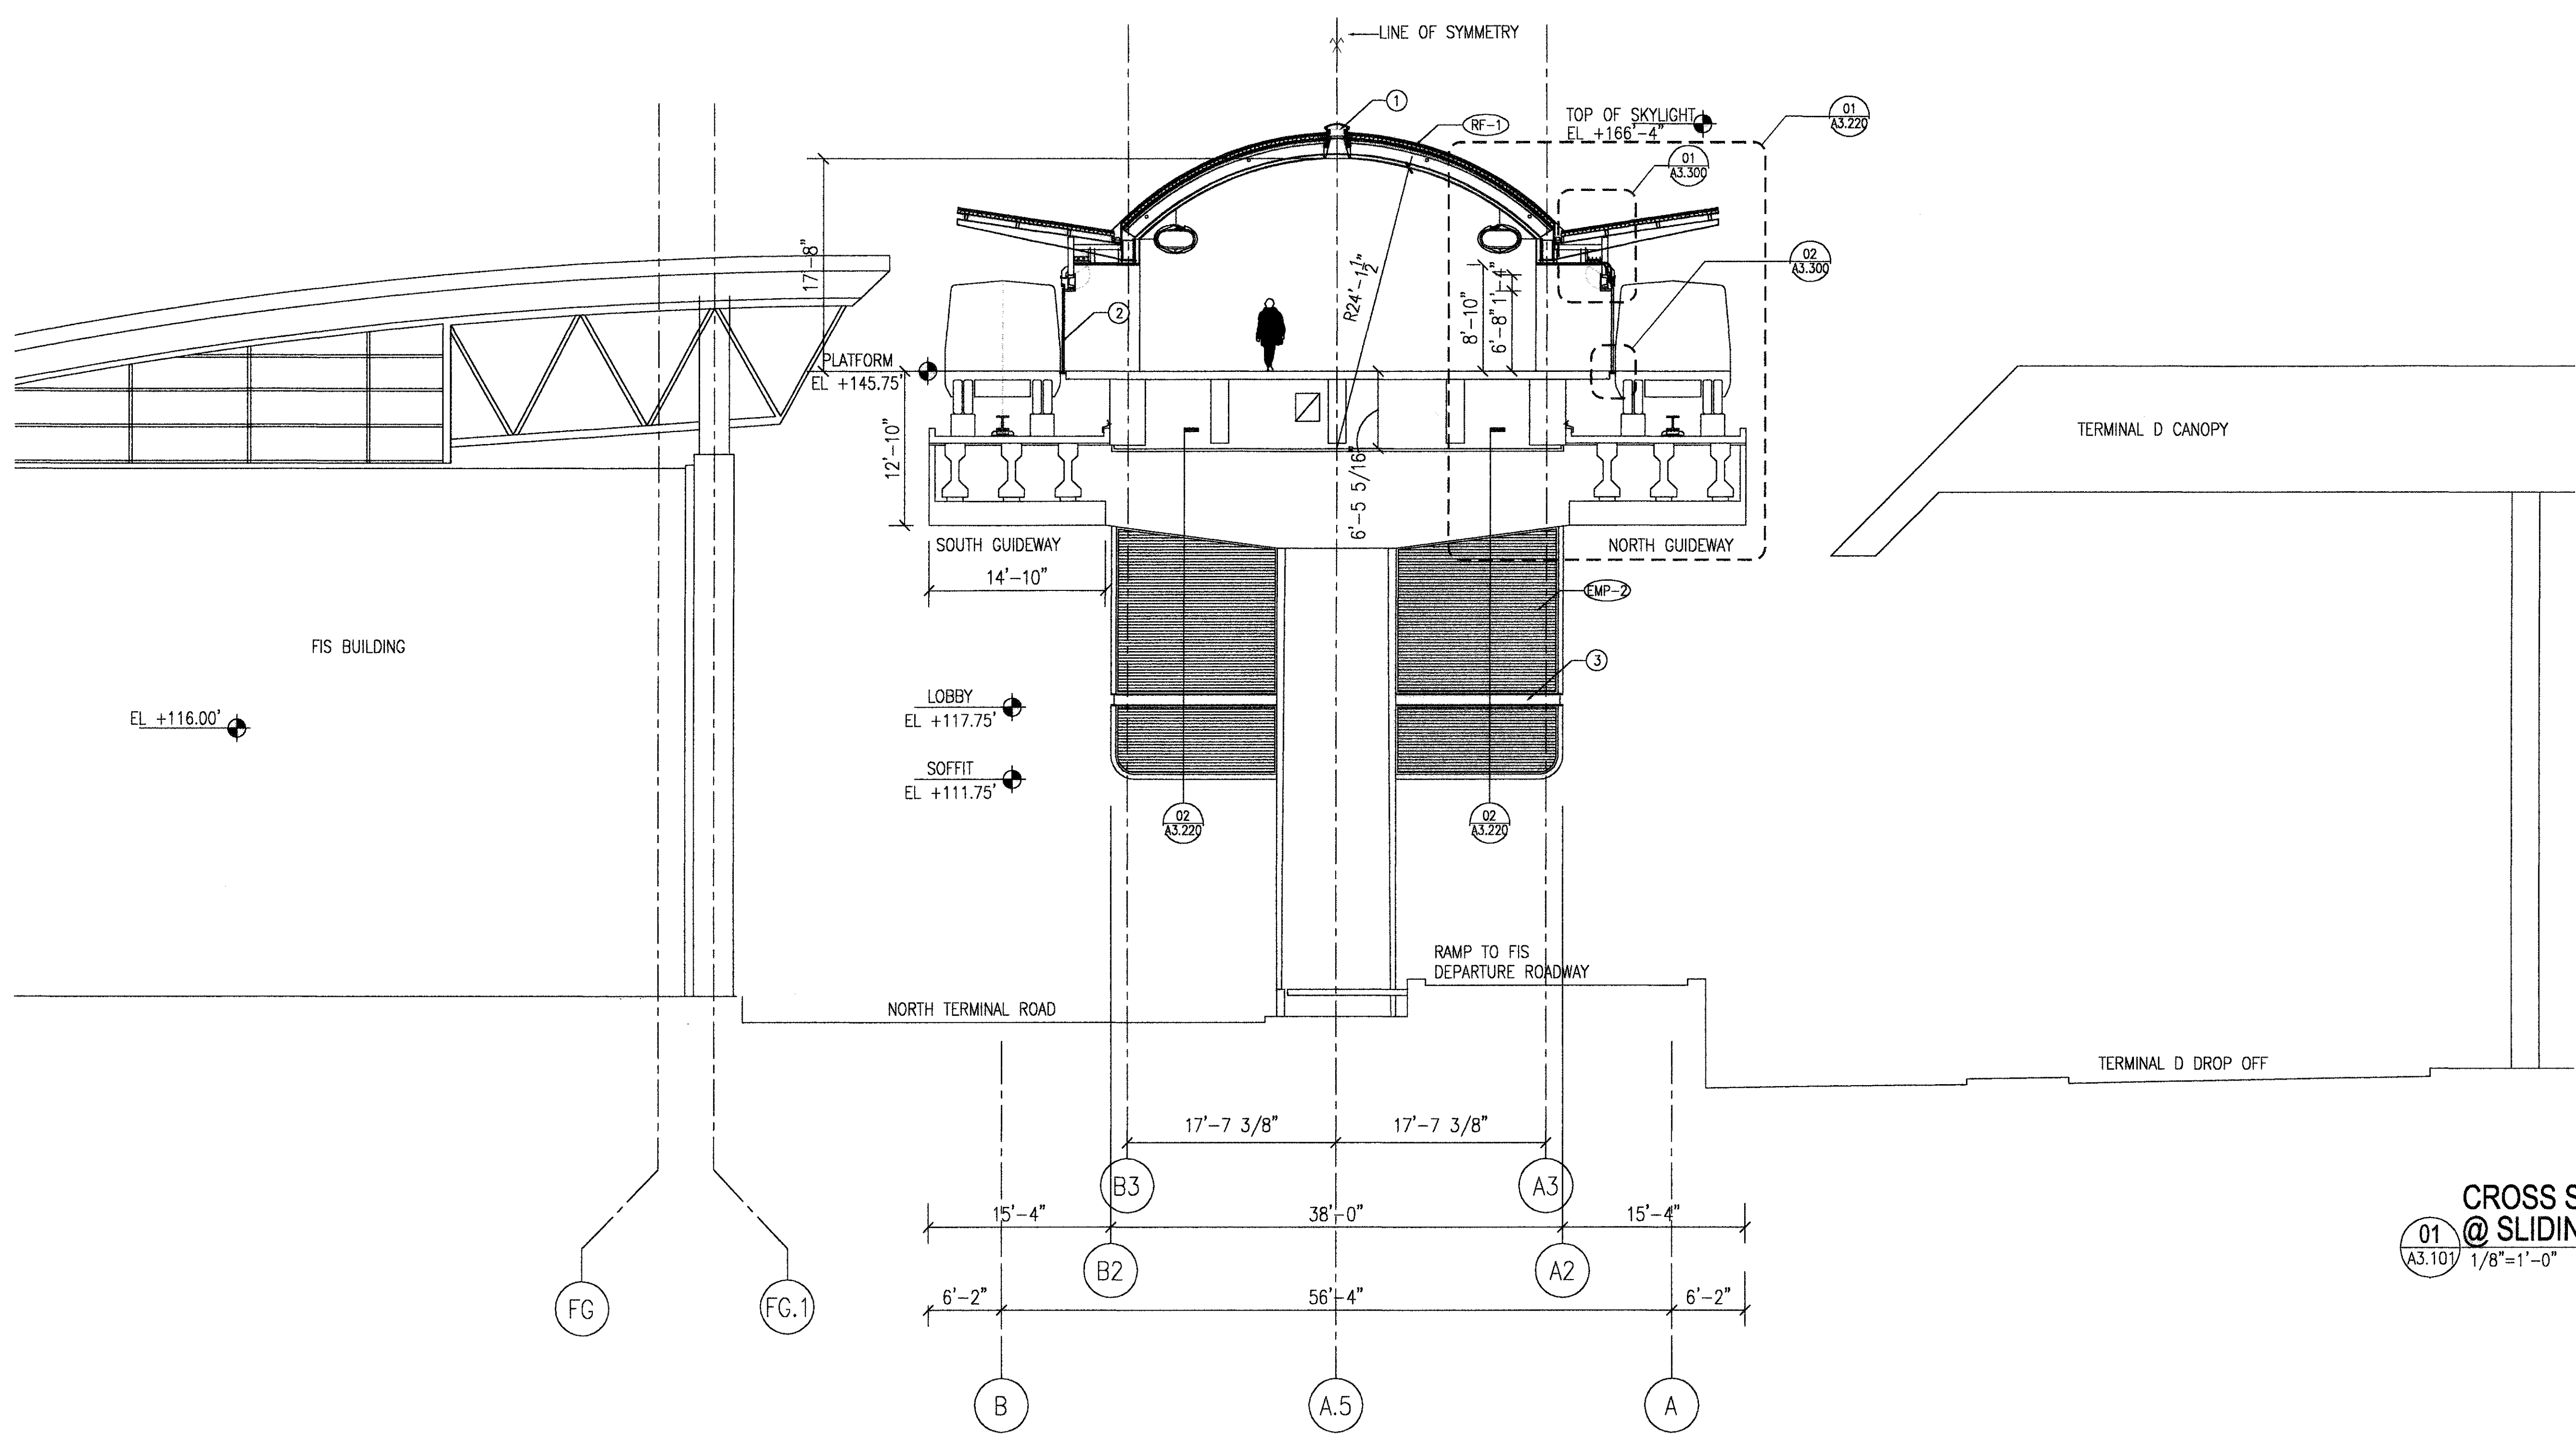

**CROSS SECTION @ SLIDING DOORS**  
 01  
 A3.101 1/8"=1'-0"

**RECORD DRAWINGS**  
 DO NOT MODIFY  
 Rey de la Reza Architects, Inc.  
 13 May 2005

Note: Information used to develop these documents was taken from Record of the Work Drawings prepared by the construction contractor. Clark Construction Group - Texas. The information provided by the contractor was not verified by the design firm named above.

NOTE: REFER TO GRAPHIC SCALE IF ACTUAL SHEET SIZE IS OTHER THAN 30"x42".


SCALE: 1/8" = 1'-0"

INTERNATIONAL • SERVICES • EXPANSION • PROGRAM

**APM STATION + PLATFORM**

CROSS SECTIONS

PROJECT MGR: HEM  
 DESIGNER: SG  
 DRAWN BY: SEM  
 CHECKED BY: AB  
 DRAWING STANDARD: ISEP 07.20.2000  
 SCALE: 1/8"=1'-0"  
 DATE: 09/14/01

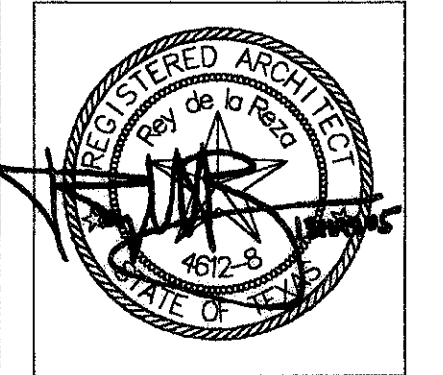

APPROVED BY: \_\_\_\_\_ DATE: \_\_\_\_\_

DIRECTOR  
 HOUSTON AIRPORT SYSTEM

PROJECT NO. 1140  
 C.I.P. NO. A-0354  
 H.A.S. NO. 536C  
 SHEET NO. A3.101





Houston Airport System  
 GEORGE BUSH  
 INTERCONTINENTAL AIRPORT  
 HOUSTON TEXAS

**Lee-Elliott**  
 1009 W. RANDOLPH MILL RD  
 HOUSTON, TEXAS 77061  
 Tel: 817.281.1446  
 Tel: 817.861.3296

**REY DE LA REZA ARCHITECTS, INC.**  
 ARCHITECTS REGISTERED PROFESSIONAL ENGINEERS  
 1245 WEST 18TH ST.  
 HOUSTON, TEXAS 77058  
 Tel: 713.868.9121  
 Tel: 713.862.9112


REVISIONS		
NO.	DESCRIPTION	DATE
ISSUED FOR BID	10/19/01	BY
RECORD SET	05/13/05	EM

**GENERAL NOTES:**

- (CW-3) CURTAIN WALL TYPE 3 - RE WINDOW SCHEDULE SHEET A2.850
- (CW-5) CURTAIN WALL TYPE 5 - RE WINDOW SCHEDULE SHEET A2.850
- (MP-1) INTERIOR STAINLESS STEEL WALL PANELS MULTI DIRECTIONAL MACHINE POLISH
- (MP-2) POWDERCOAT ALUMINUM LOUVERS
- (MP-3) EXTERIOR POWDERCOAT METAL WALL PANEL - ALUMINUM PANEL 1/8" THICK - TYPE SERIES 3000 MODIFIED FROM UNA-CLAD - COPPER SALES OR EQUAL POWDERCOAT KYNAR 500 - FOR COLOR RE. SCHEDULE SHEET A2.800

**KEYED NOTES:**

- ① A/C DUCT THROUGH CONCRETE BENTS 50 AND 49 - RE MECHANICAL AND STRUCTURAL

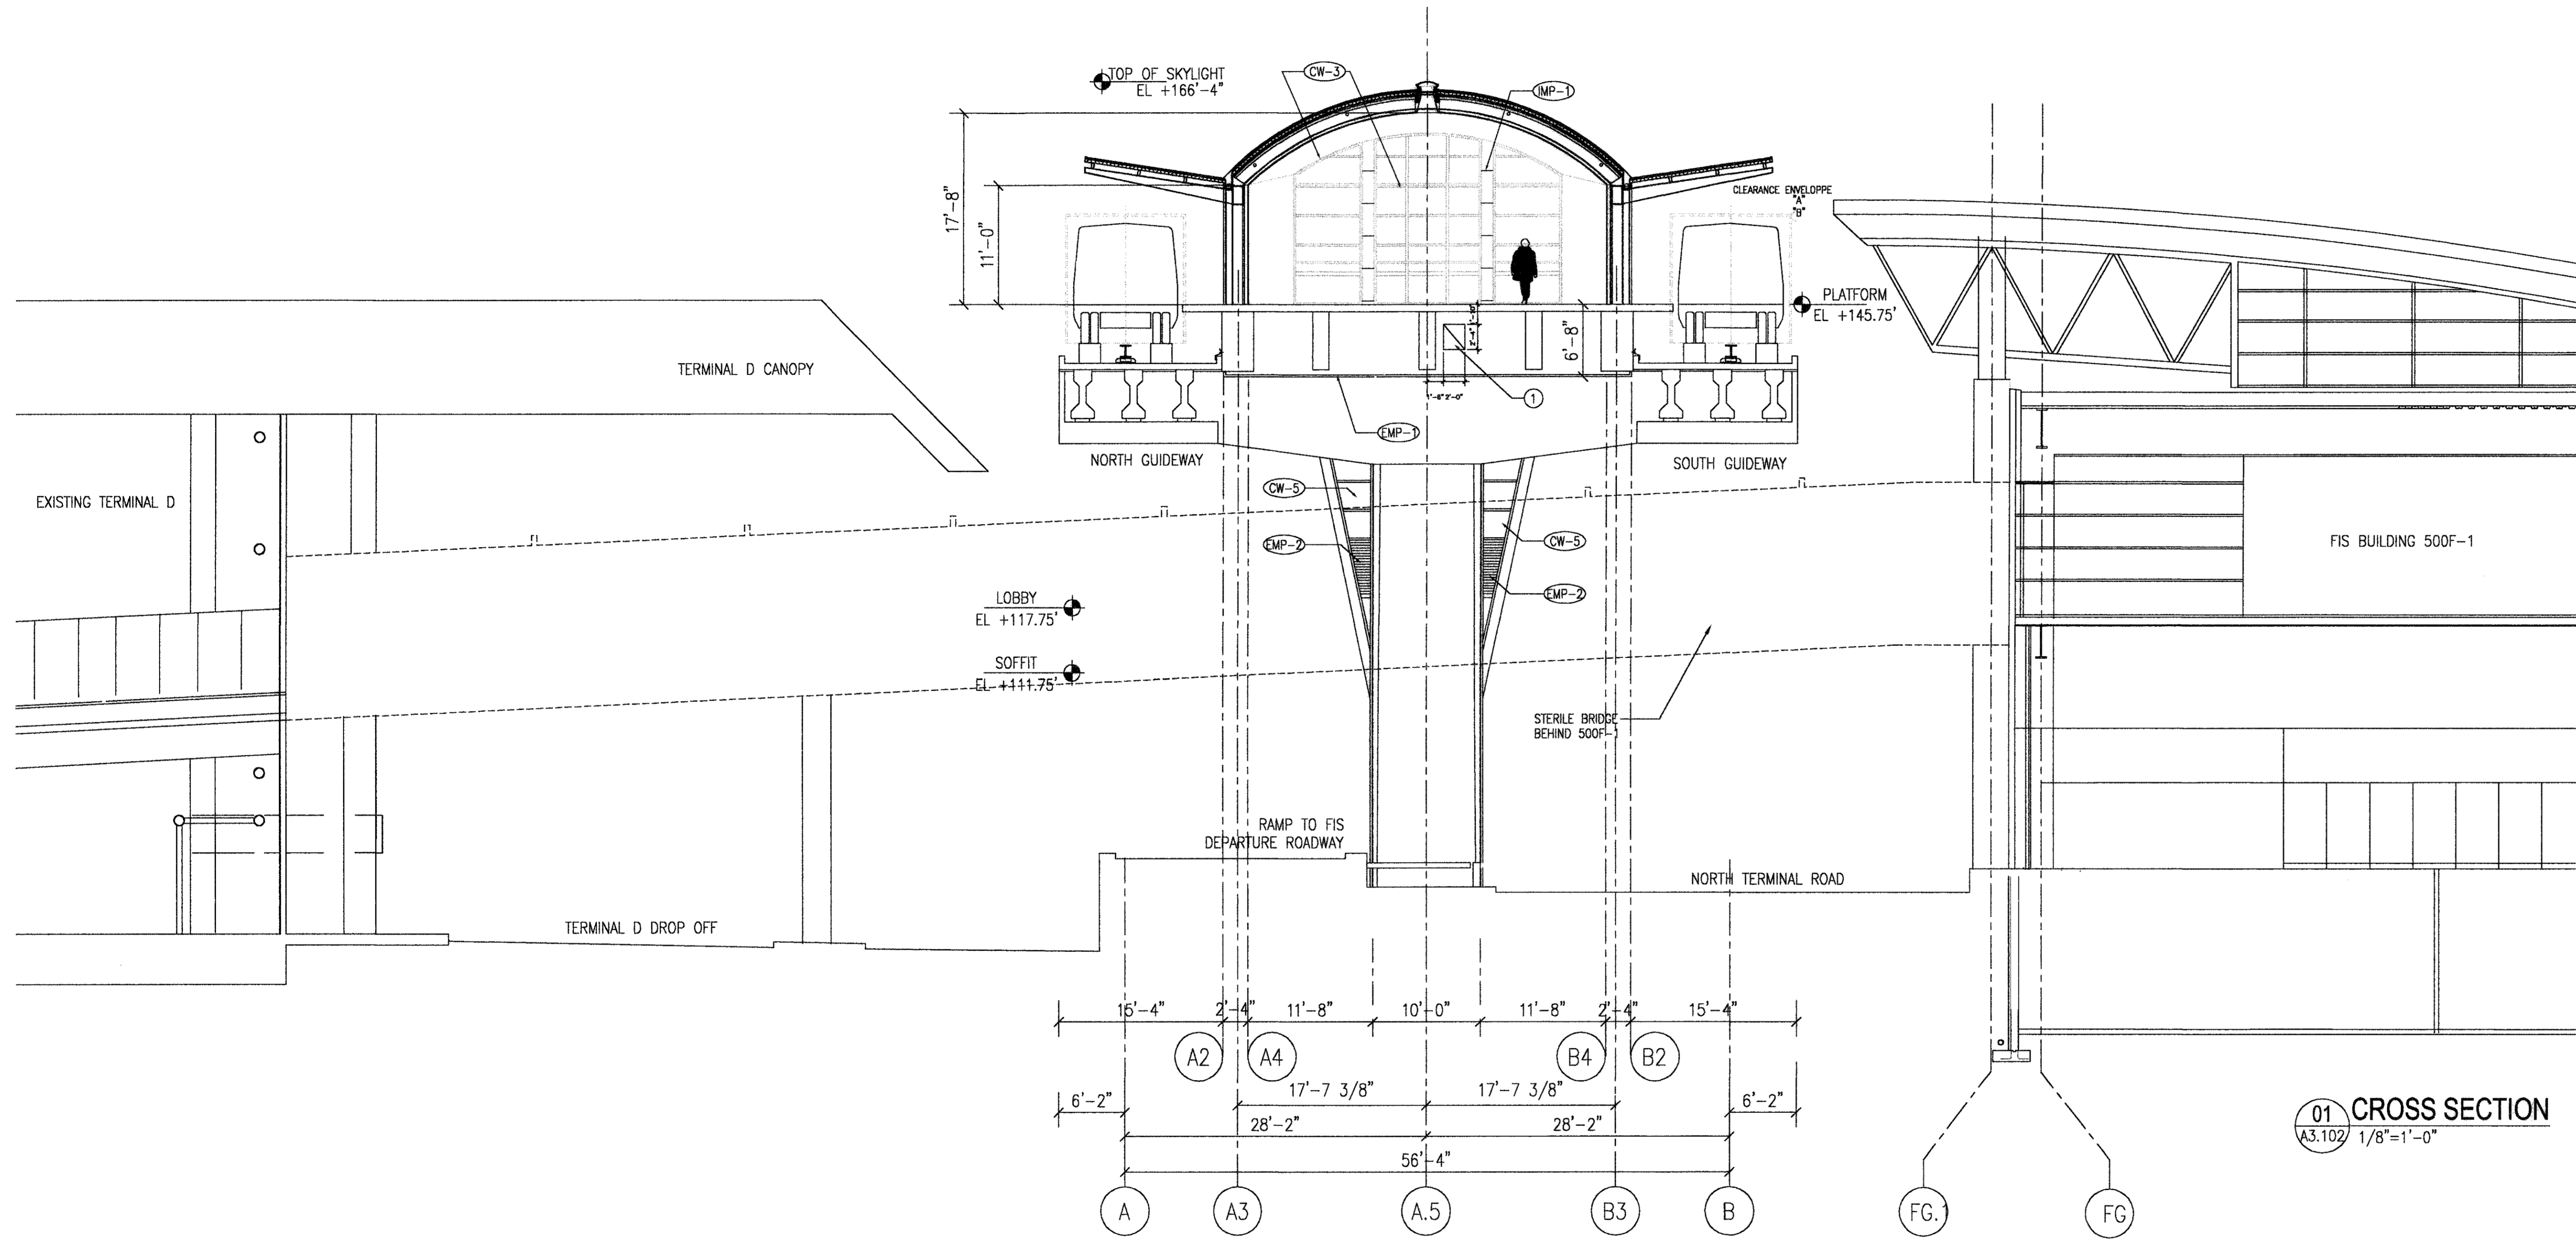


**01 CROSS SECTION**  
 A3.102 1/8" = 1'-0"

INTERNATIONAL • SERVICES • EXPANSION • PROGRAM  
**APM STATION + PLATFORM**  
 CROSS SECTIONS

PROJECT MGR: HEM  
 DESIGNER: SC  
 DRAWN BY: SEM  
 CHECKED BY: AB  
 DRAWING STANDARD: ISEP 07.20.2000  
 SCALE: 1/8" = 1'-0"  
 DATE: 09/14/01

**RECORD DRAWINGS**  
 DO NOT MODIFY  
 Rey de la Reza Architects, Inc.  
 13 May 2005  
 Note: Information used to develop these documents was taken from Record of the Work Drawings prepared by the construction contractor, Clark Construction Group - Texas. The information provided by the contractor was not verified by the design firm named above.

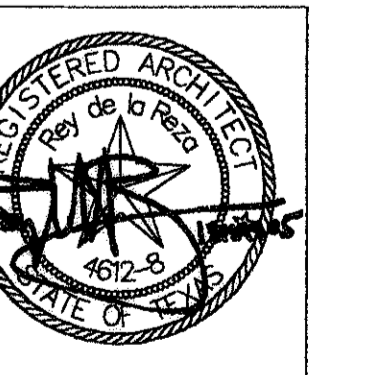

APPROVED BY: DATE:

PROJECT NO. 1140  
 C.I.P. NO. A-0354  
 H.A.S. NO. 538C  
 SHEET NO.


NOTE: REFER TO GRAPHIC SCALE IF ACTUAL SHEET SIZE IS OTHER THAN 30"x42".  
  
 SCALE: 1/8" = 1'-0"




**GENERAL NOTES:**

- (EMP-1) EXTERIOR POWDERCOAT METAL WALL PANEL - ALUMINUM PANEL 1/8" THICK - TYPE SERIES 3000 MODIFIED FROM UNA-CLAD - COPPER SALES OR EQUAL. POWDERCOAT KYNAR 500 - FOR COLOR RE. SCHEDULE SHEET A2.800
- (RF-1) STANDING SEAM METAL ROOF - TYPE UC3 FROM UNA-CLAD - COPPER SALES OR EQUAL - WIDTH 1'-0" - POWDERCOAT KYNAR 500. COLOR#2 SILVER METALLIC

REVISIONS			
NO.	DESCRIPTION	DATE	BY
	ISSUED FOR BID	10/18/01	
REVISION #1		01/27/03	SG
RECORD SET		05/13/05	EM

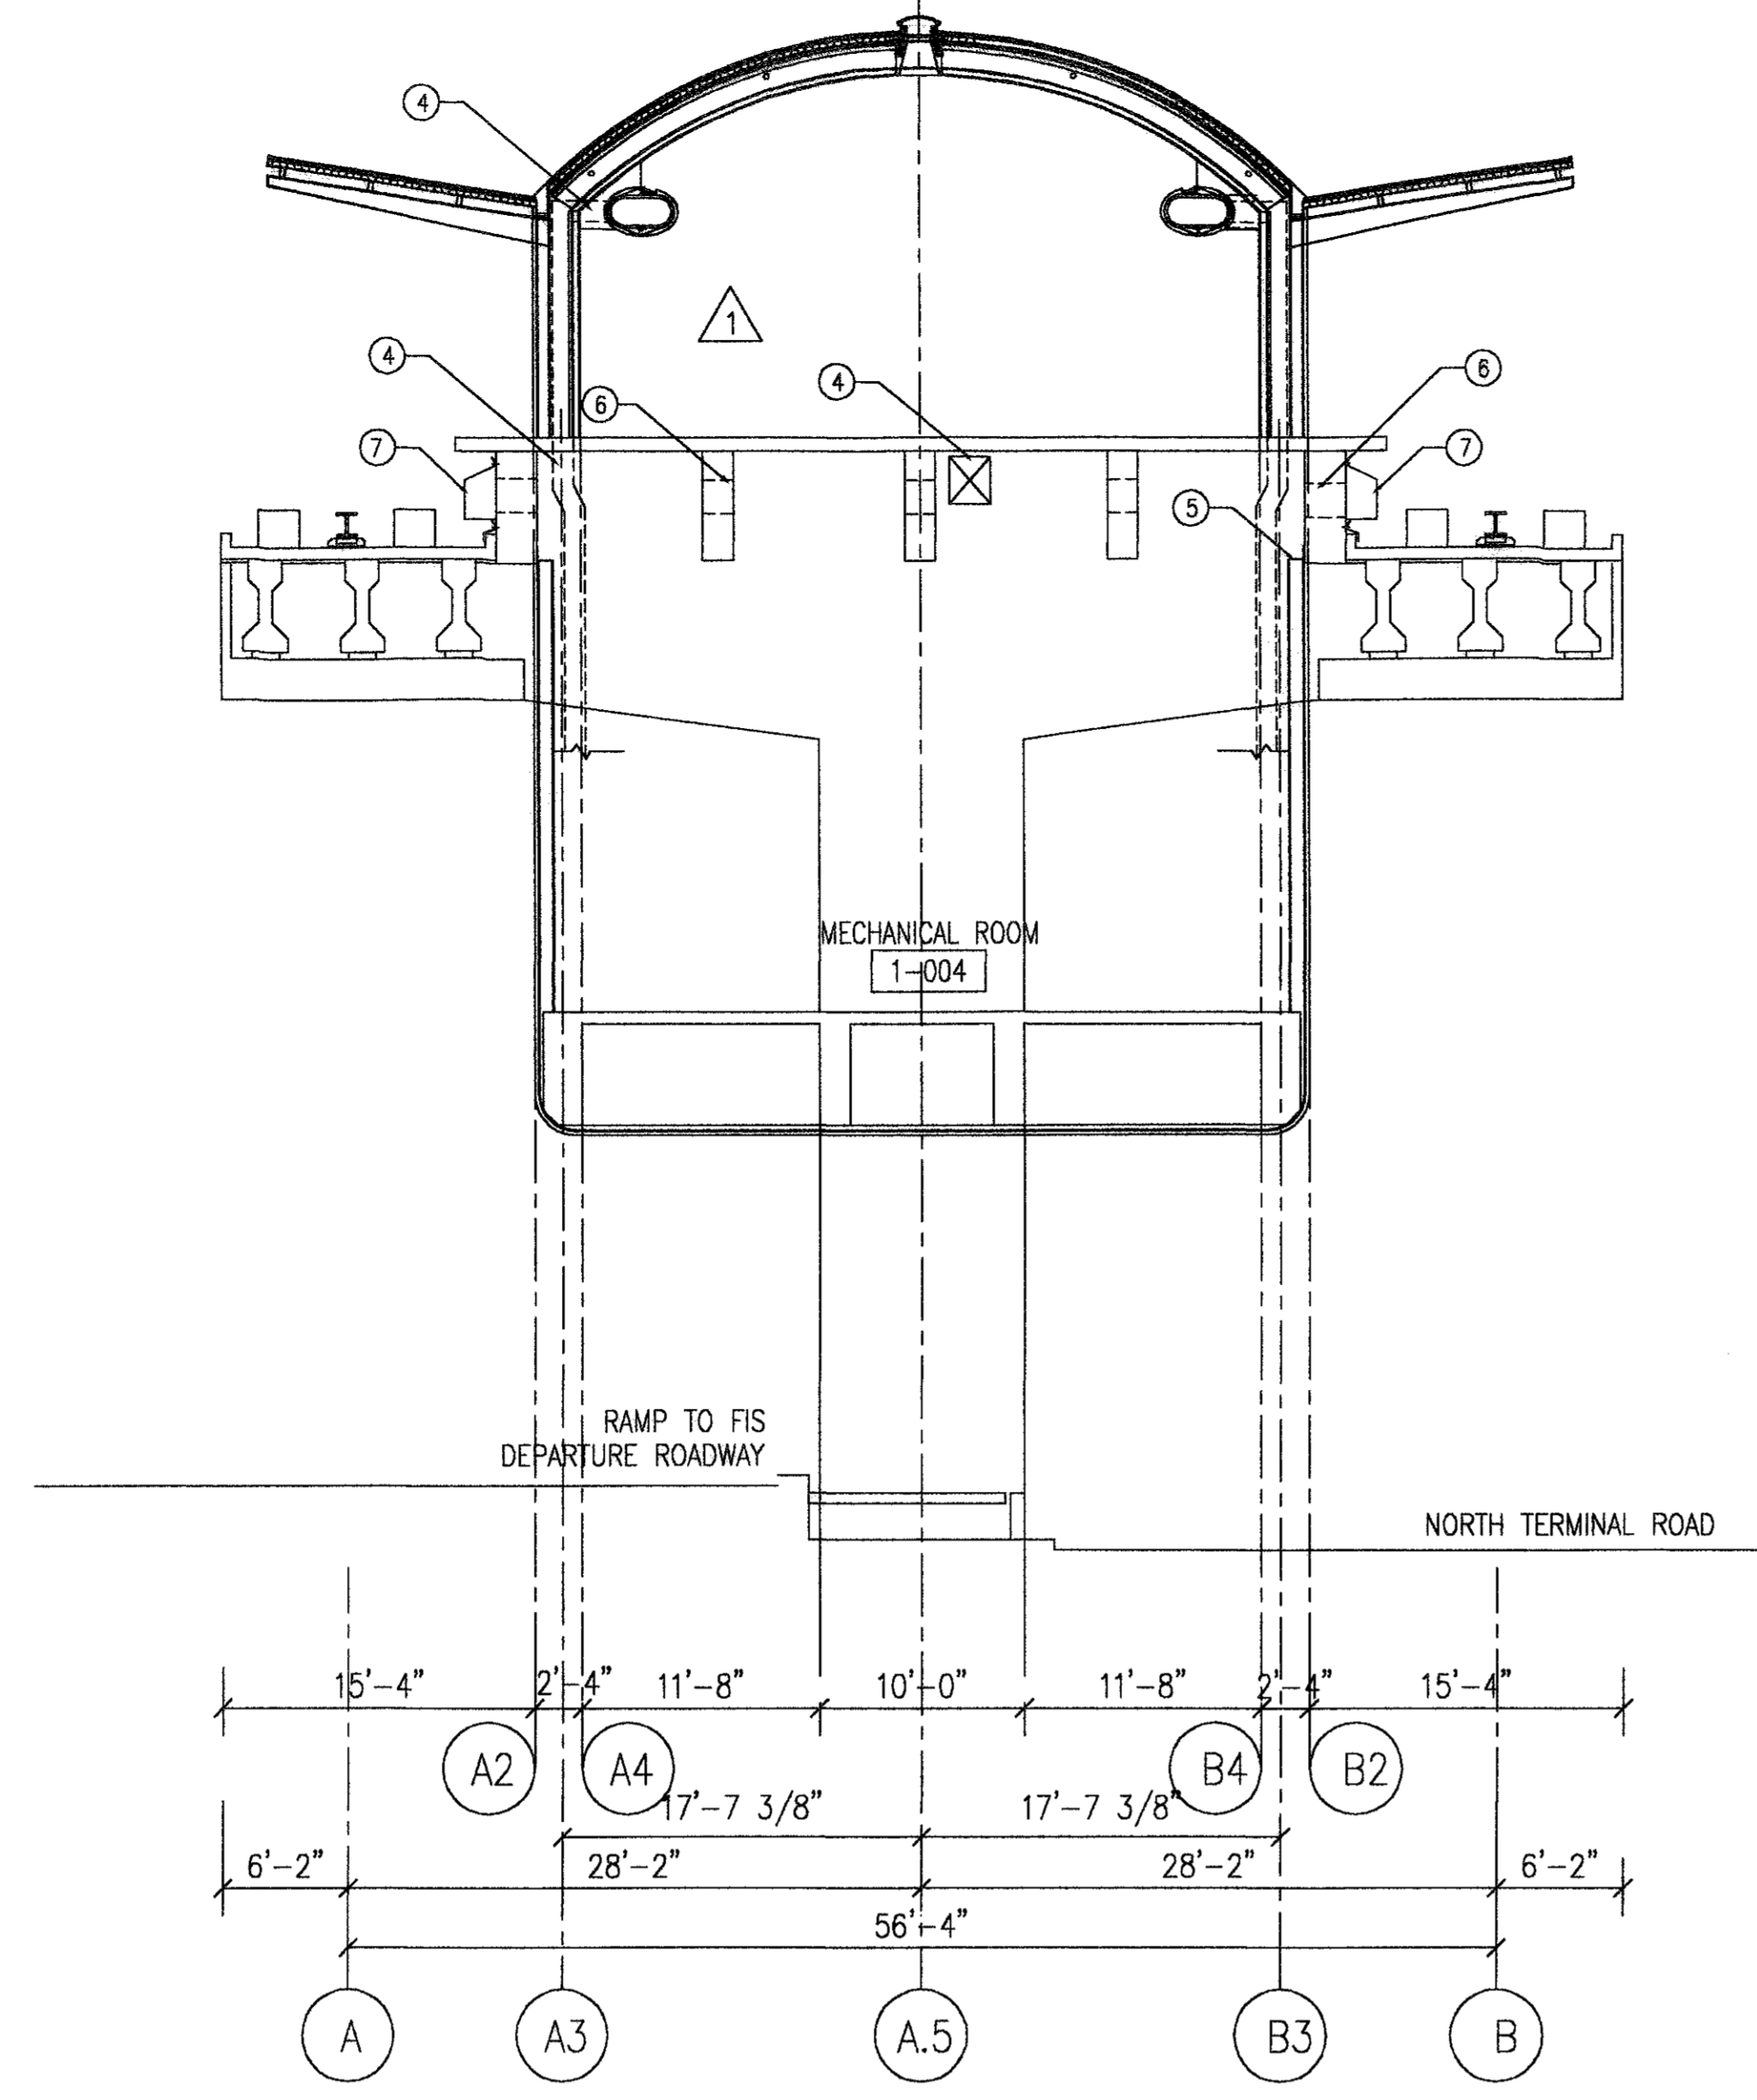

**CROSS SECTION @ MECHANICAL ROOM**  
 01  
 A3.103 1/8"=1'-0"

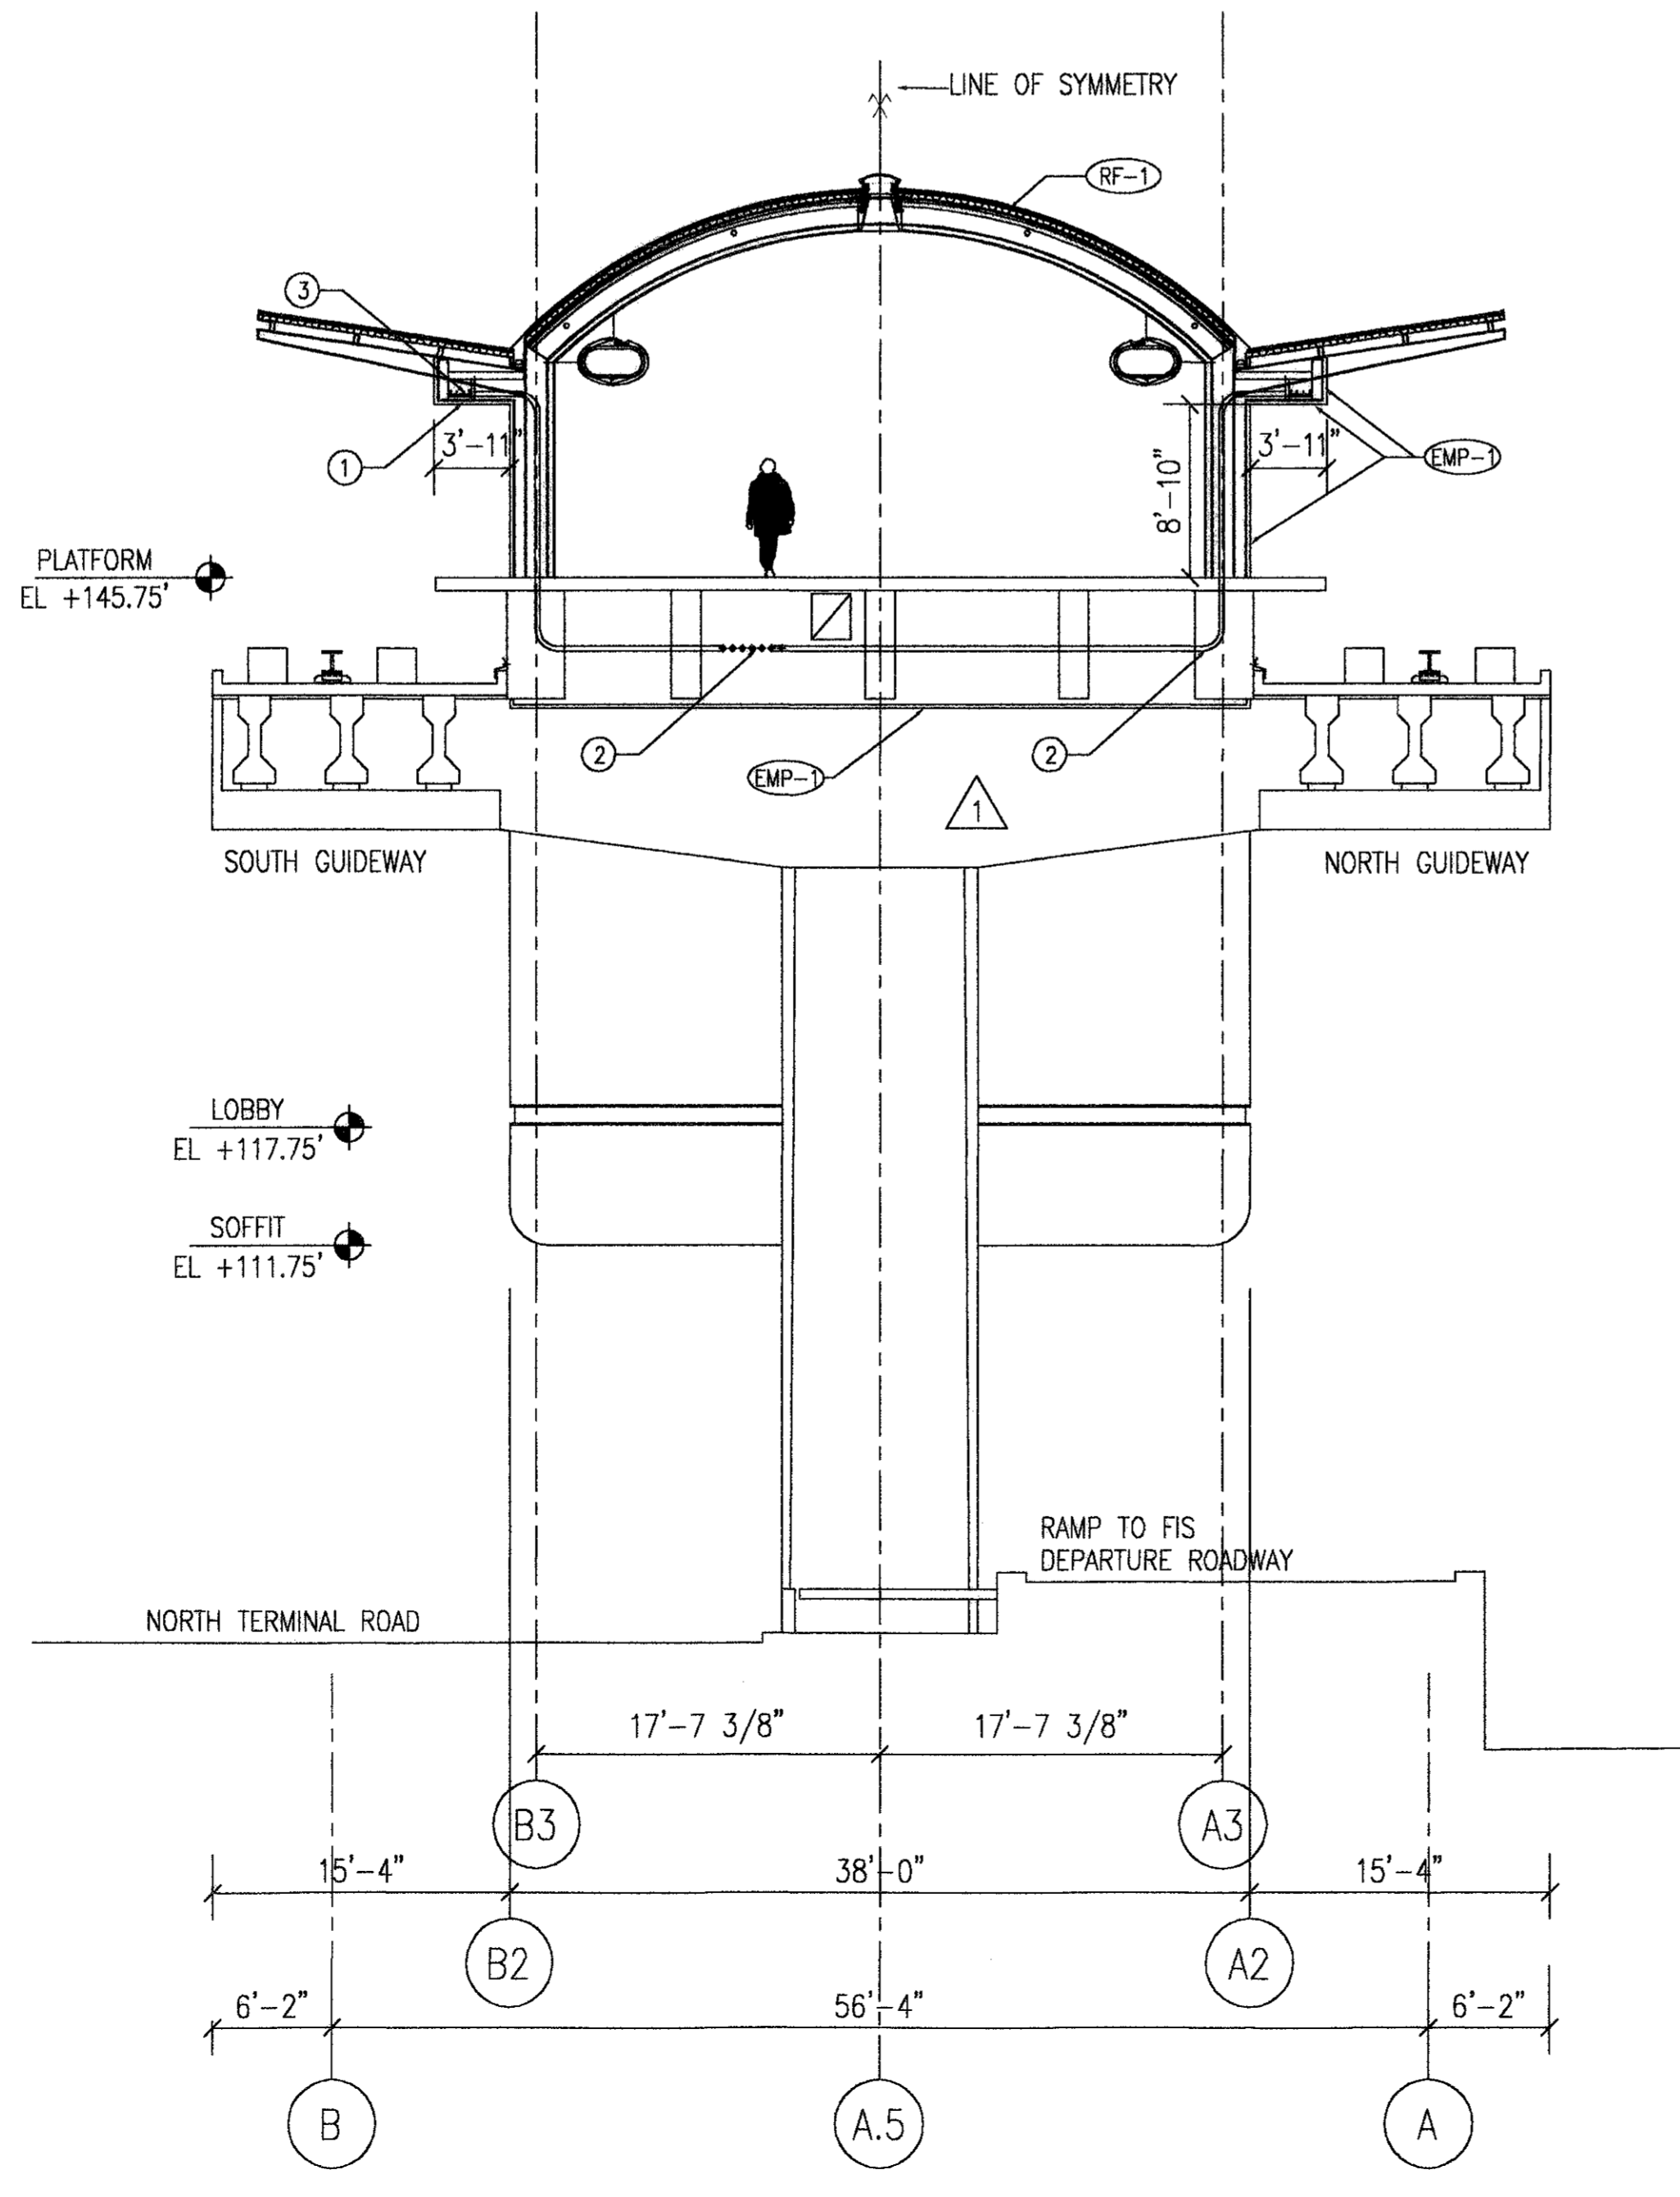

**CROSS SECTION @ PLATFORM**  
 02  
 A3.103 1/8"=1'-0"

**KEYED NOTES:**

- 1 EXTERIOR SOFFIT - METAL PANEL TYPE EMP-1
- 2 SIX 2-1/2" AND ONE 1-1/4" CONDUITS: RE ELECTRICAL RE STRUCTURAL TO BE COORDINATED WITH 536D
- 3 CONTINUOUS CABLE TRAY N.I.C. RE 536D
- 4 A/C DUCT - RE MECHANICAL
- 5 8"x8" STEEL ANGLE
- 6 20"x30" PENETRATION FOR CONDUITS FROM GUIDEWAY. RE STRUCTURAL. RE ELECTRICAL TO BE COORDINATED WITH PROJECT 536D
- 7 GALVANIZED STEEL COVER AND SEALANT @ CONDUITS PENETRATION




**RECORD DRAWINGS**  
 DO NOT MODIFY  
 Rey de la Reza Architects, Inc.  
 13 May 2005

Note: Information used to develop these documents was taken from Record of the Work Drawings prepared by the construction contractor, Clark Construction Group - Texas. The information provided by the contractor was not verified by the design firm named above.

INTERNATIONAL • SERVICES • EXPANSION • PROGRAM  
**APM STATION + PLATFORM**  
 CROSS SECTIONS

PROJECT MGR:	HEM
DESIGNER:	SG
DRAWN BY:	SEM
CHECKED BY:	AB
DRAWING STANDARD:	ISEP 07.20.2000
SCALE:	1/8"=1'-0"
DATE:	09/14/01

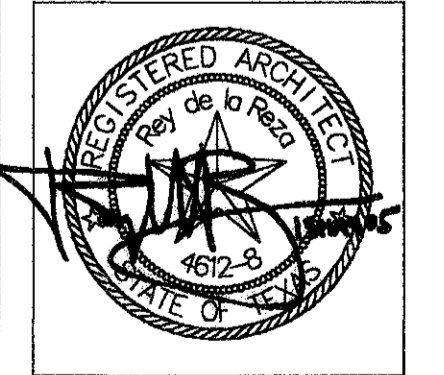

APPROVED BY:	DATE:
DIRECTOR	
HOUSTON AIRPORT SYSTEM	
PROJECT NO.	1140
C.I.P. NO.	A-0354
H.A.S. NO.	536C
SHEET NO.	

NOTE: REFER TO GRAPHIC SCALE IF ACTUAL SHEET SIZE IS OTHER THAN 30"x42".  
 0' 4' 8' 16' 24'  
 SCALE: 1/8" = 1'-0"



**GENERAL NOTES:**


- (EMP-2) EXTERIOR POWDERCOAT METAL WALL PANEL-- ALUMINUM PANEL 1/8" THICK - TYPE SERIES 3000 MODIFIED FROM UNA-CLAD - COPPER SALES OR EQUAL. POWDERCOAT KYMAR 500 - FOR COLOR RE. SCHEDULE SHEET A2.800
- (REF-1) STANDING SEAM METAL ROOF-- TYPE UC3 FROM UNA-CLAD - COPPER SALES OR EQUAL. WIDTH 1'-0"-- POWDERCOAT KYMAR 500. COLOR#2 SILVER METALLIC
- (IMP-1) INTERIOR STAINLESS STEEL WALL PANELS MULTI DIRECTIONAL MACHINE POLISH

REVISIONS


NO.	DESCRIPTION	DATE	BY
	ISSUED FOR BID	10/19/01	
▲	ADDENDUM 1	02/01/02	SG
▲	REVISION #1	01/27/03	SG
▲	RECORD SET	05/13/05	EM

**KEYED NOTES:**

- ① OPENING IN CONCRETE BENT FOR CONDUITS. RE. STRUCTURAL RE. ELECTRICAL TO BE COORDINATED WITH HAS 536D
- ② W12 BEAM WITH 3 HR FIREPROOFING SUPPORT OF SLOPE WALL RE. STRUCTURAL
- ③ 8" STEEL TUBE & BASE PLATE SUPPORT OF STAIR LANDING - PAINT
- ④ 2'x2'-6" CONCRETE BEAM - RE. STRUCTURAL - PAINT
- ⑤ 2'x1" CONCRETE COLUMN - RE. STRUCTURAL - PAINT
- ⑥ 12"x12" CONCRETE COLUMNS - RE. STRUCTURAL - PAINT
- ⑦ SSTL METAL PANELS TYPE IMP-1 ON VISIBLE FACES OF SLOPE WALL UNDER CATWALK AND STAIRS
- ⑧ 8" STEEL STUD @ 2' O.C. 10 GA - SECURED TO W12 BEAM AND WALL - TO SUSPEND CABLE TRAYS AND CONDUITS
- ⑨ 1/2" X 1/2" ALUMINUM REVEAL @ GYPSUM CEILING AROUND BOTH 12" COLUMNS

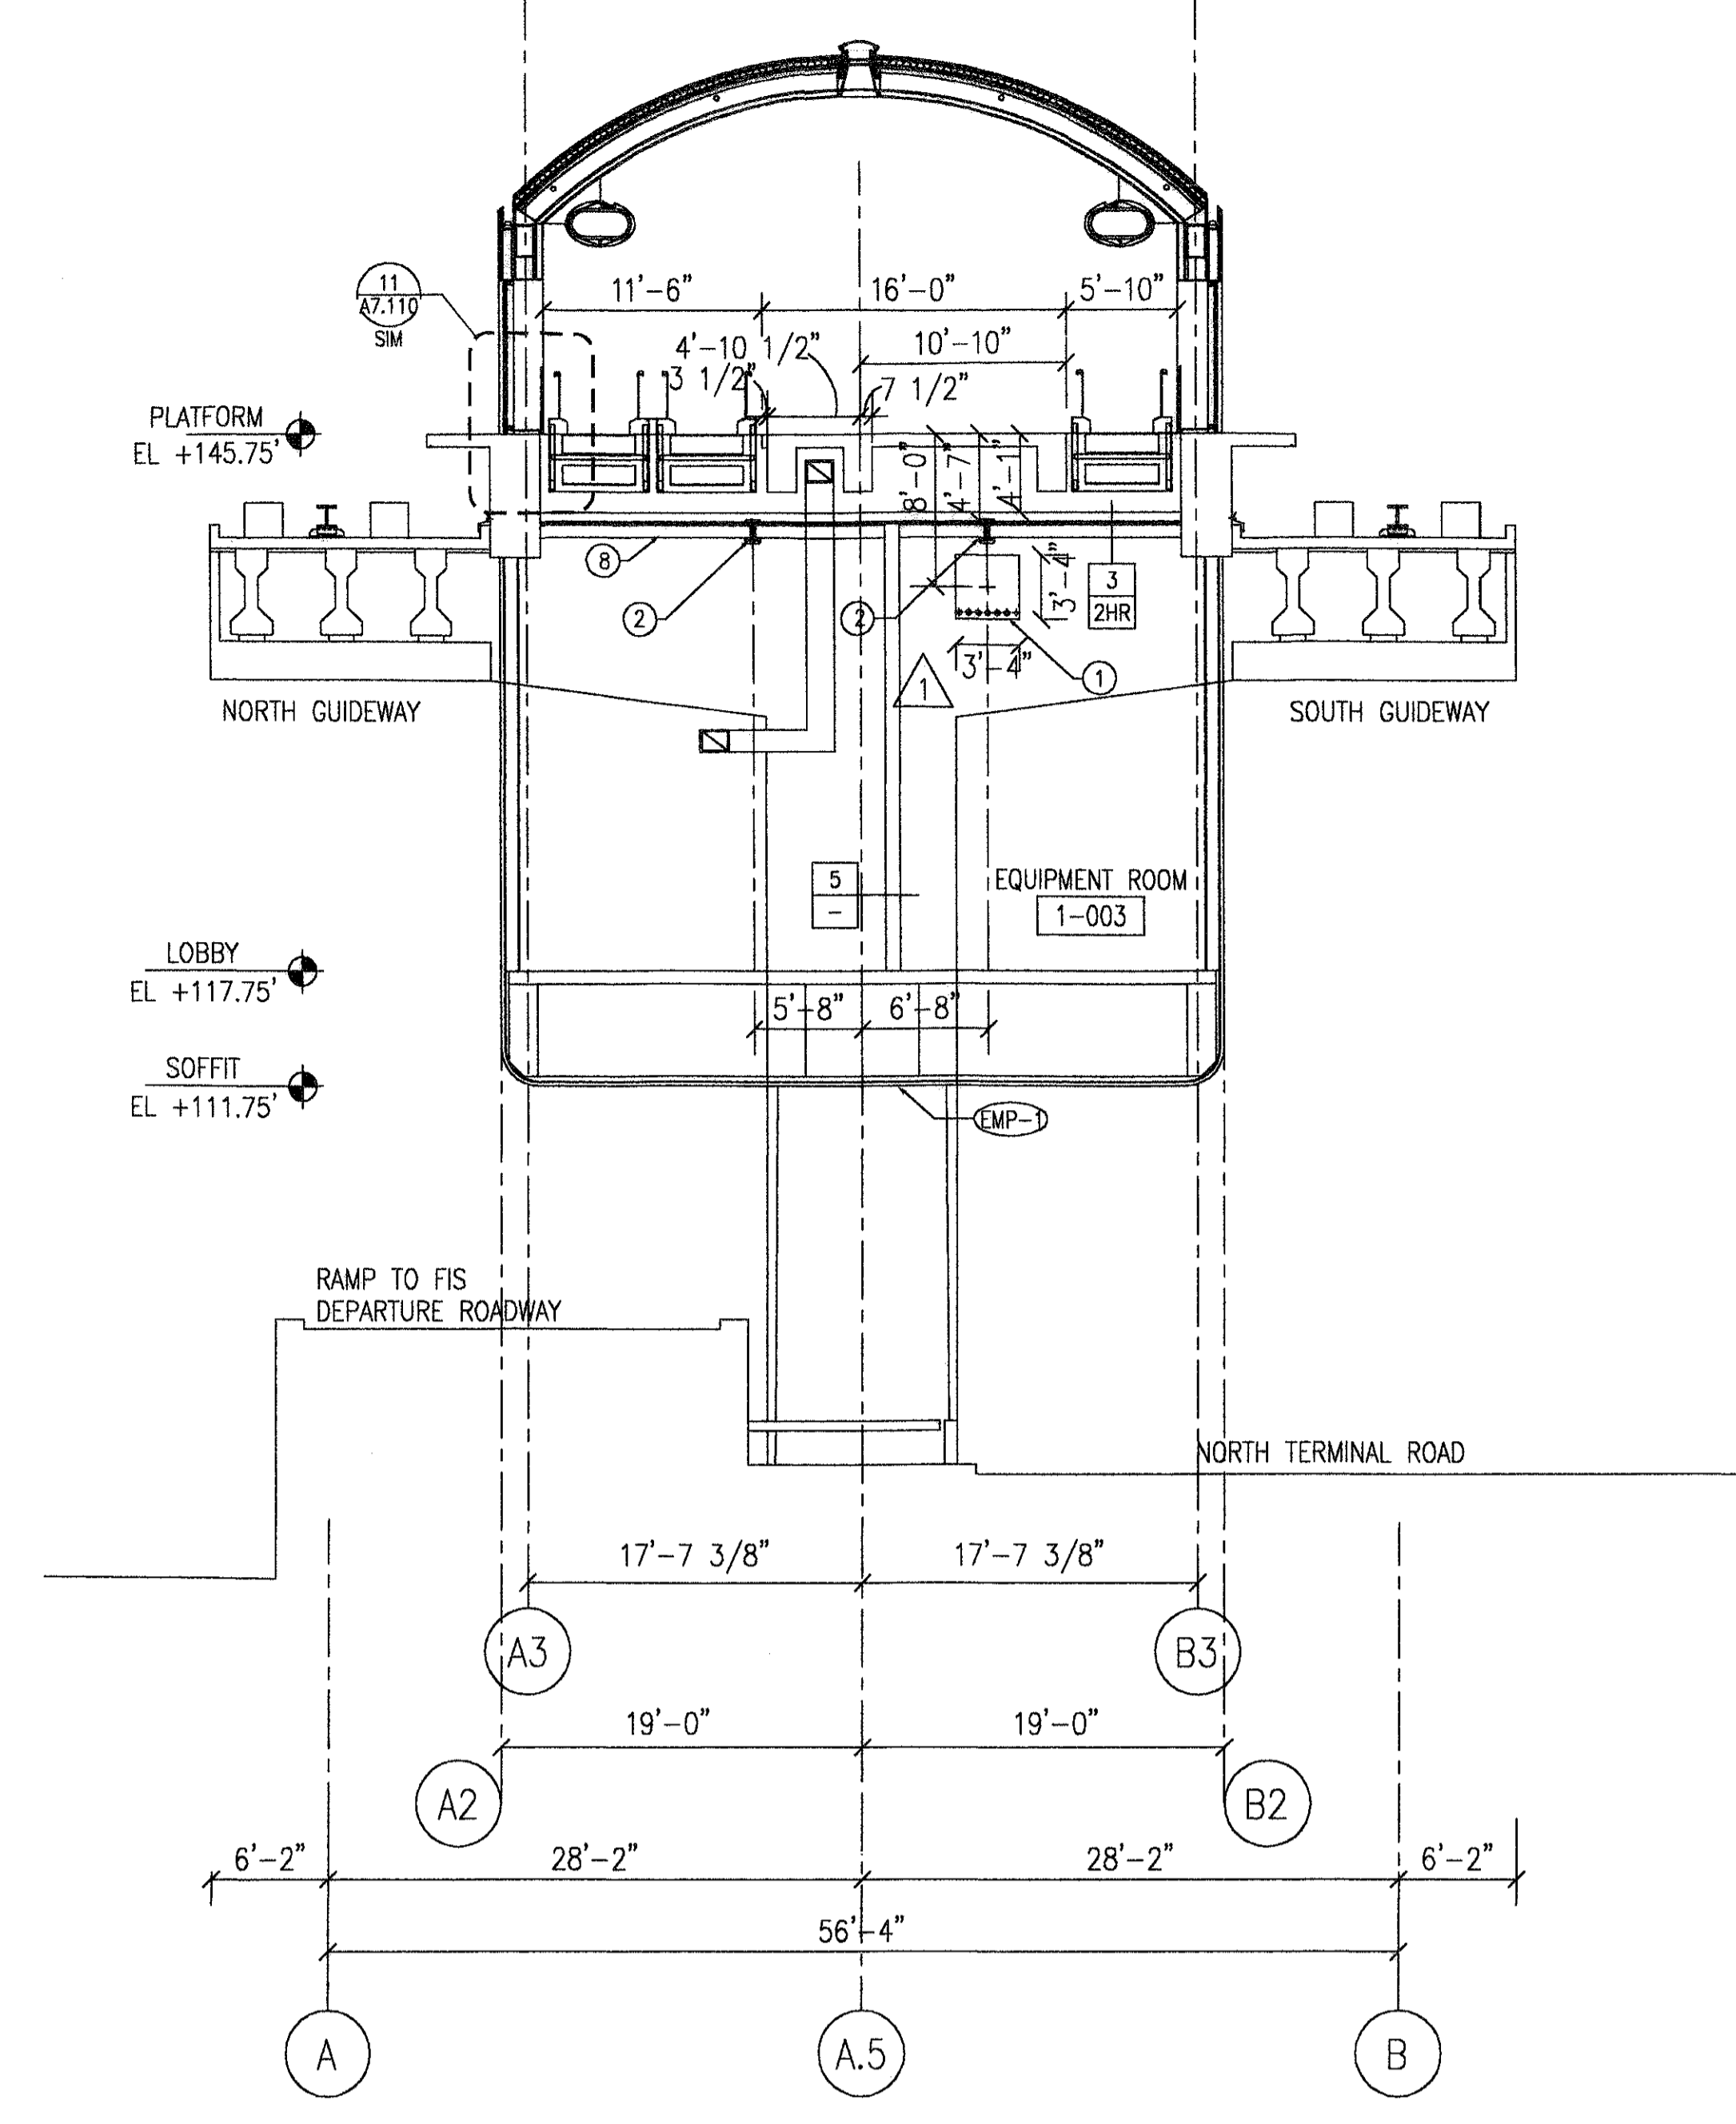

**CROSS SECTION @ EQUIPMENT ROOM**  
 01  
 A3.104/ 1/8"=1'-0"

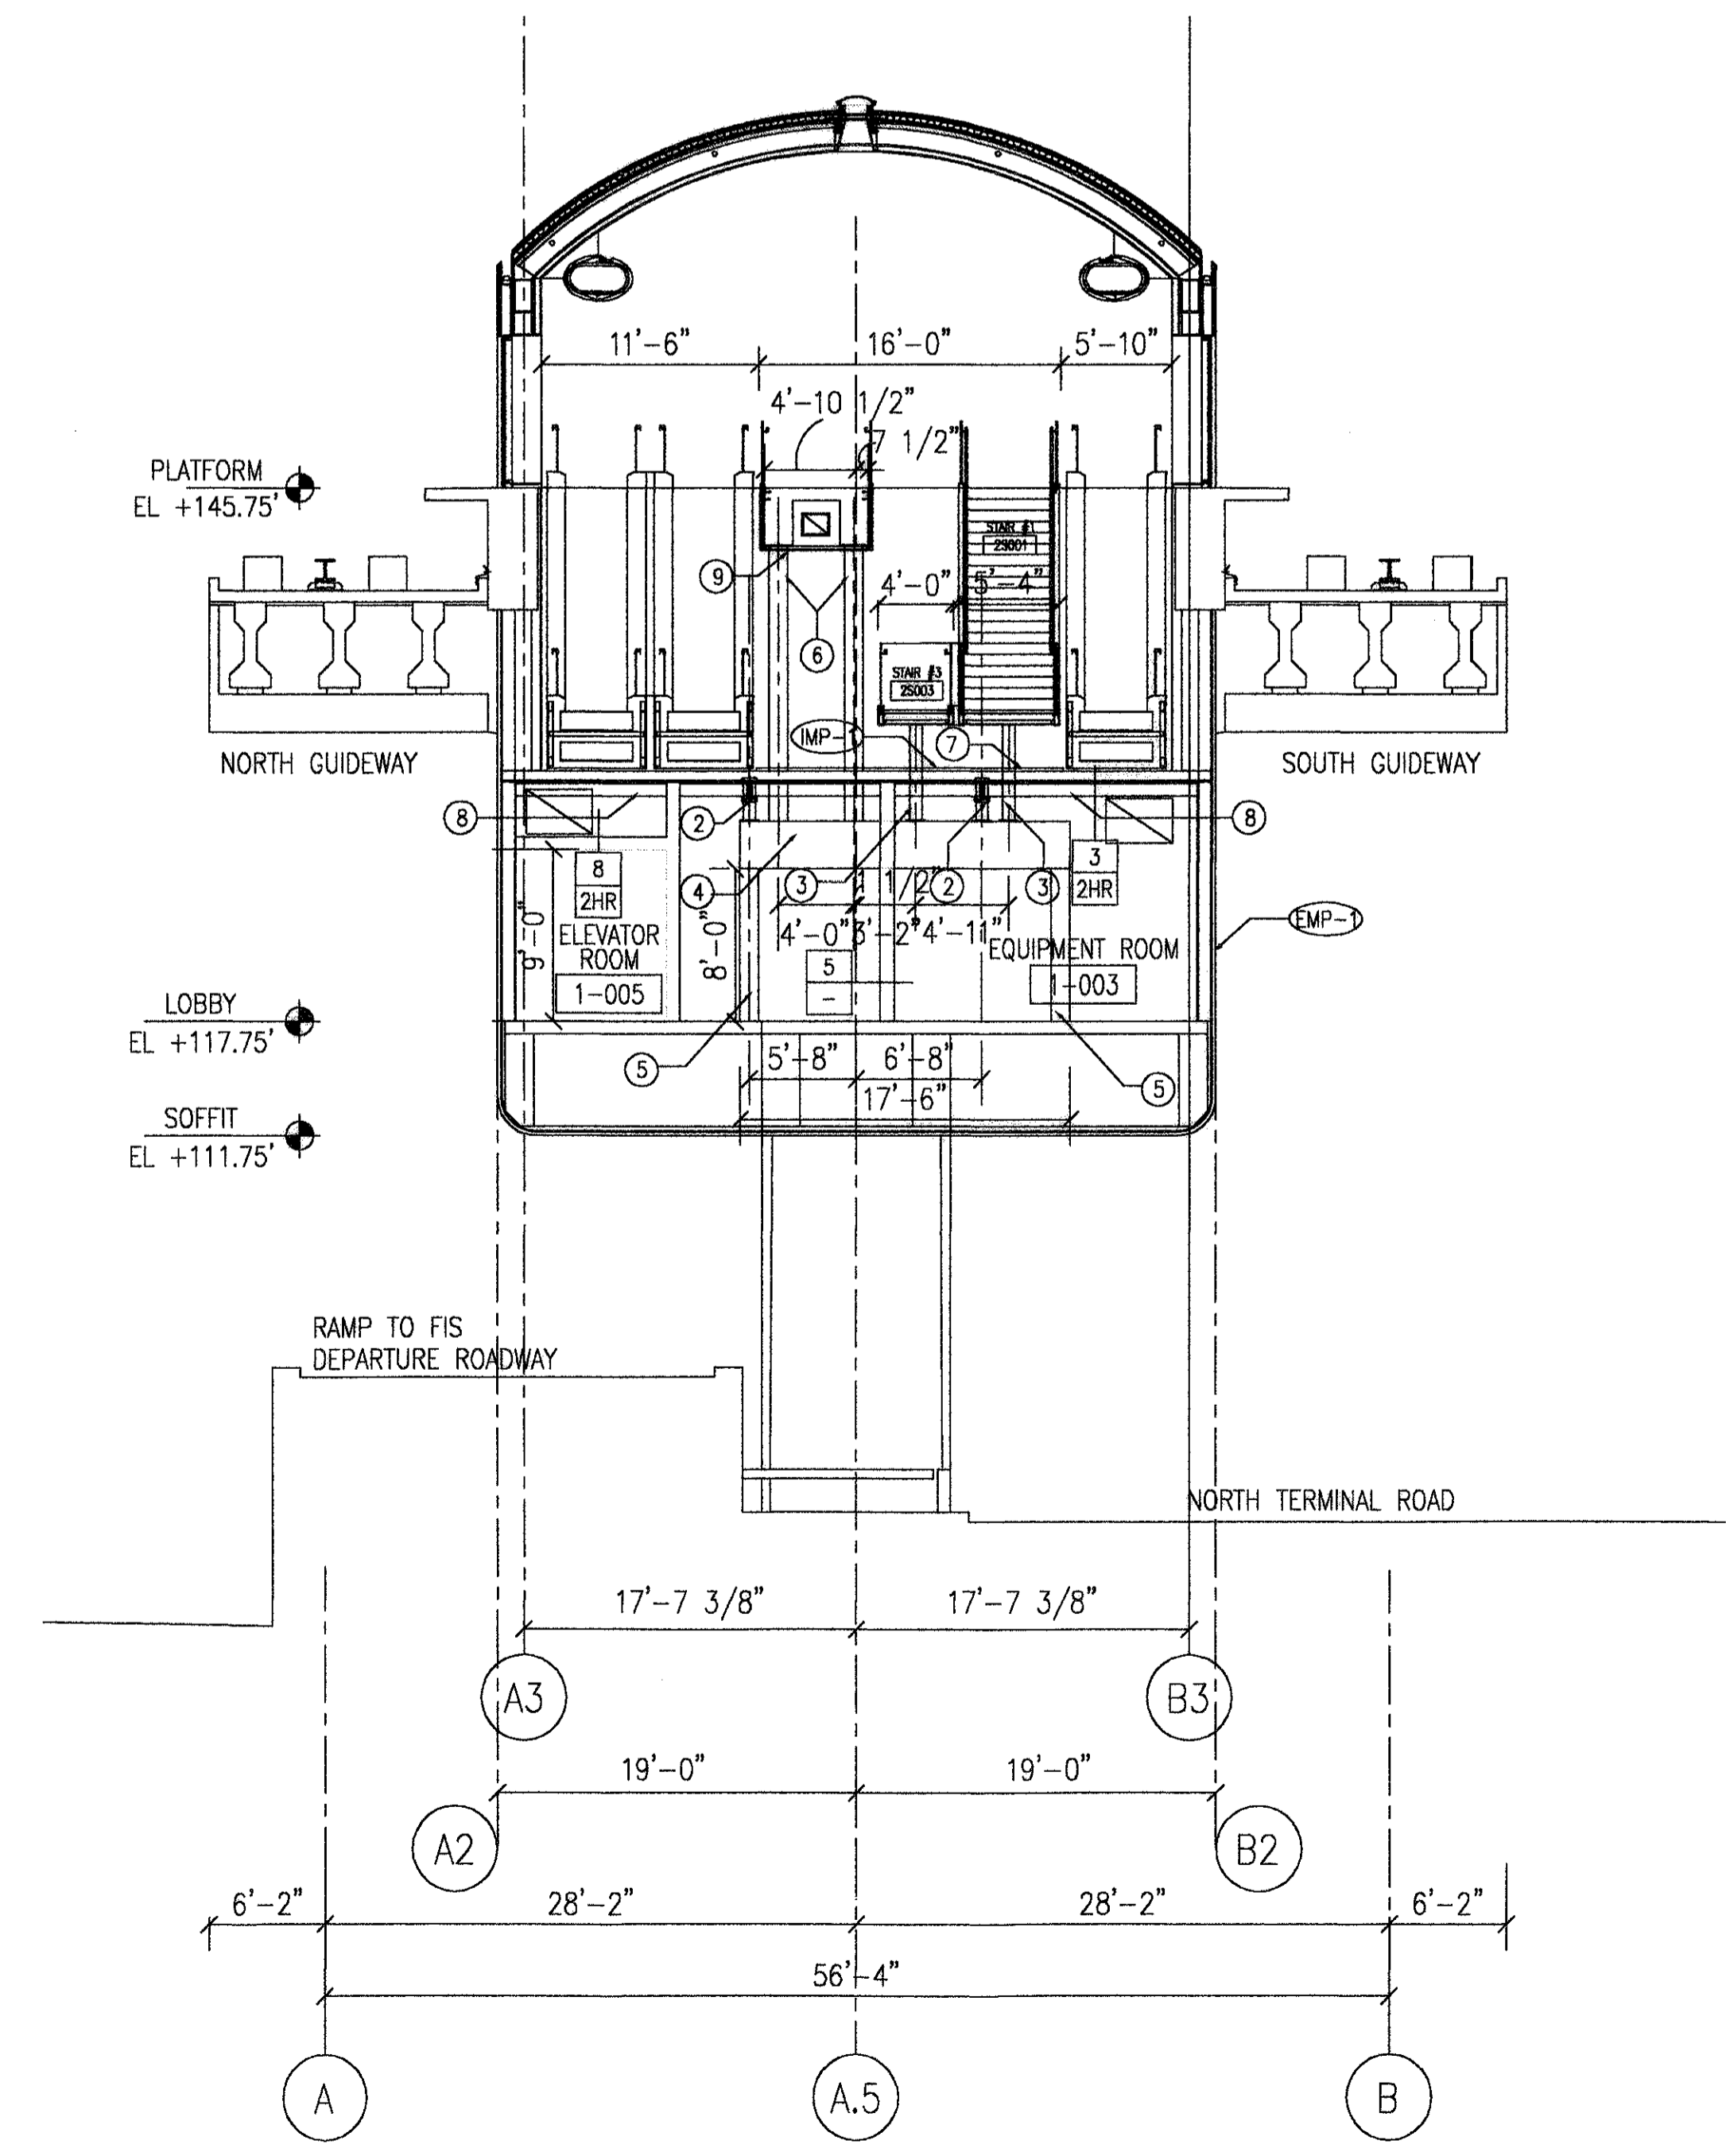

**CROSS SECTION @SLOPE WALL STRUCTURE**  
 02  
 A3.104/ 1/8"=1'-0"

**RECORD DRAWINGS**  
 DO NOT MODIFY  
 Rey de la Reza Architects, Inc.  
 13 May 2005


Note: Information used to develop these documents was taken from Record of the Work Drawings prepared by the construction contractor, Crank Construction Group - Texas. The information provided by the contractor was not verified by the design firm named above.

INTERNATIONAL • SERVICES • EXPANSION • PROGRAM

**APM STATION + PLATFORM**

CROSS SECTIONS

PROJECT MGR: HEM  
 DESIGNER: SG  
 DRAWN BY: SEM  
 CHECKED BY: AB  
 DRAWING STANDARD: ISEP 07.20.2000  
 SCALE: 1/8"=1'-0"  
 DATE: 09/14/01

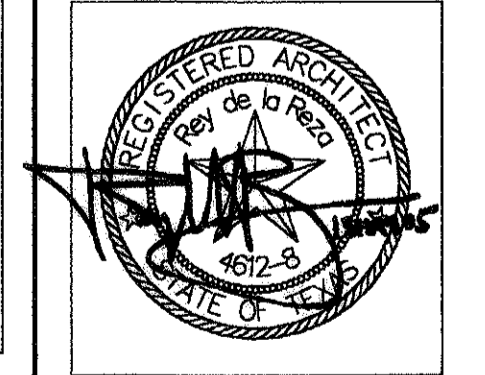

APPROVED BY: \_\_\_\_\_ DATE: \_\_\_\_\_


DIRECTOR  
 HOUSTON AIRPORT SYSTEM

PROJECT NO. 1140  
 C.L.P. NO. A-0354  
 H.A.S. NO. 536C  
 SHEET NO. 25


NOTE: REFER TO GRAPHIC SCALE IF ACTUAL SHEET SIZE IS OTHER THAN 30"x42".

SCALE: 1/8" = 1'-0"



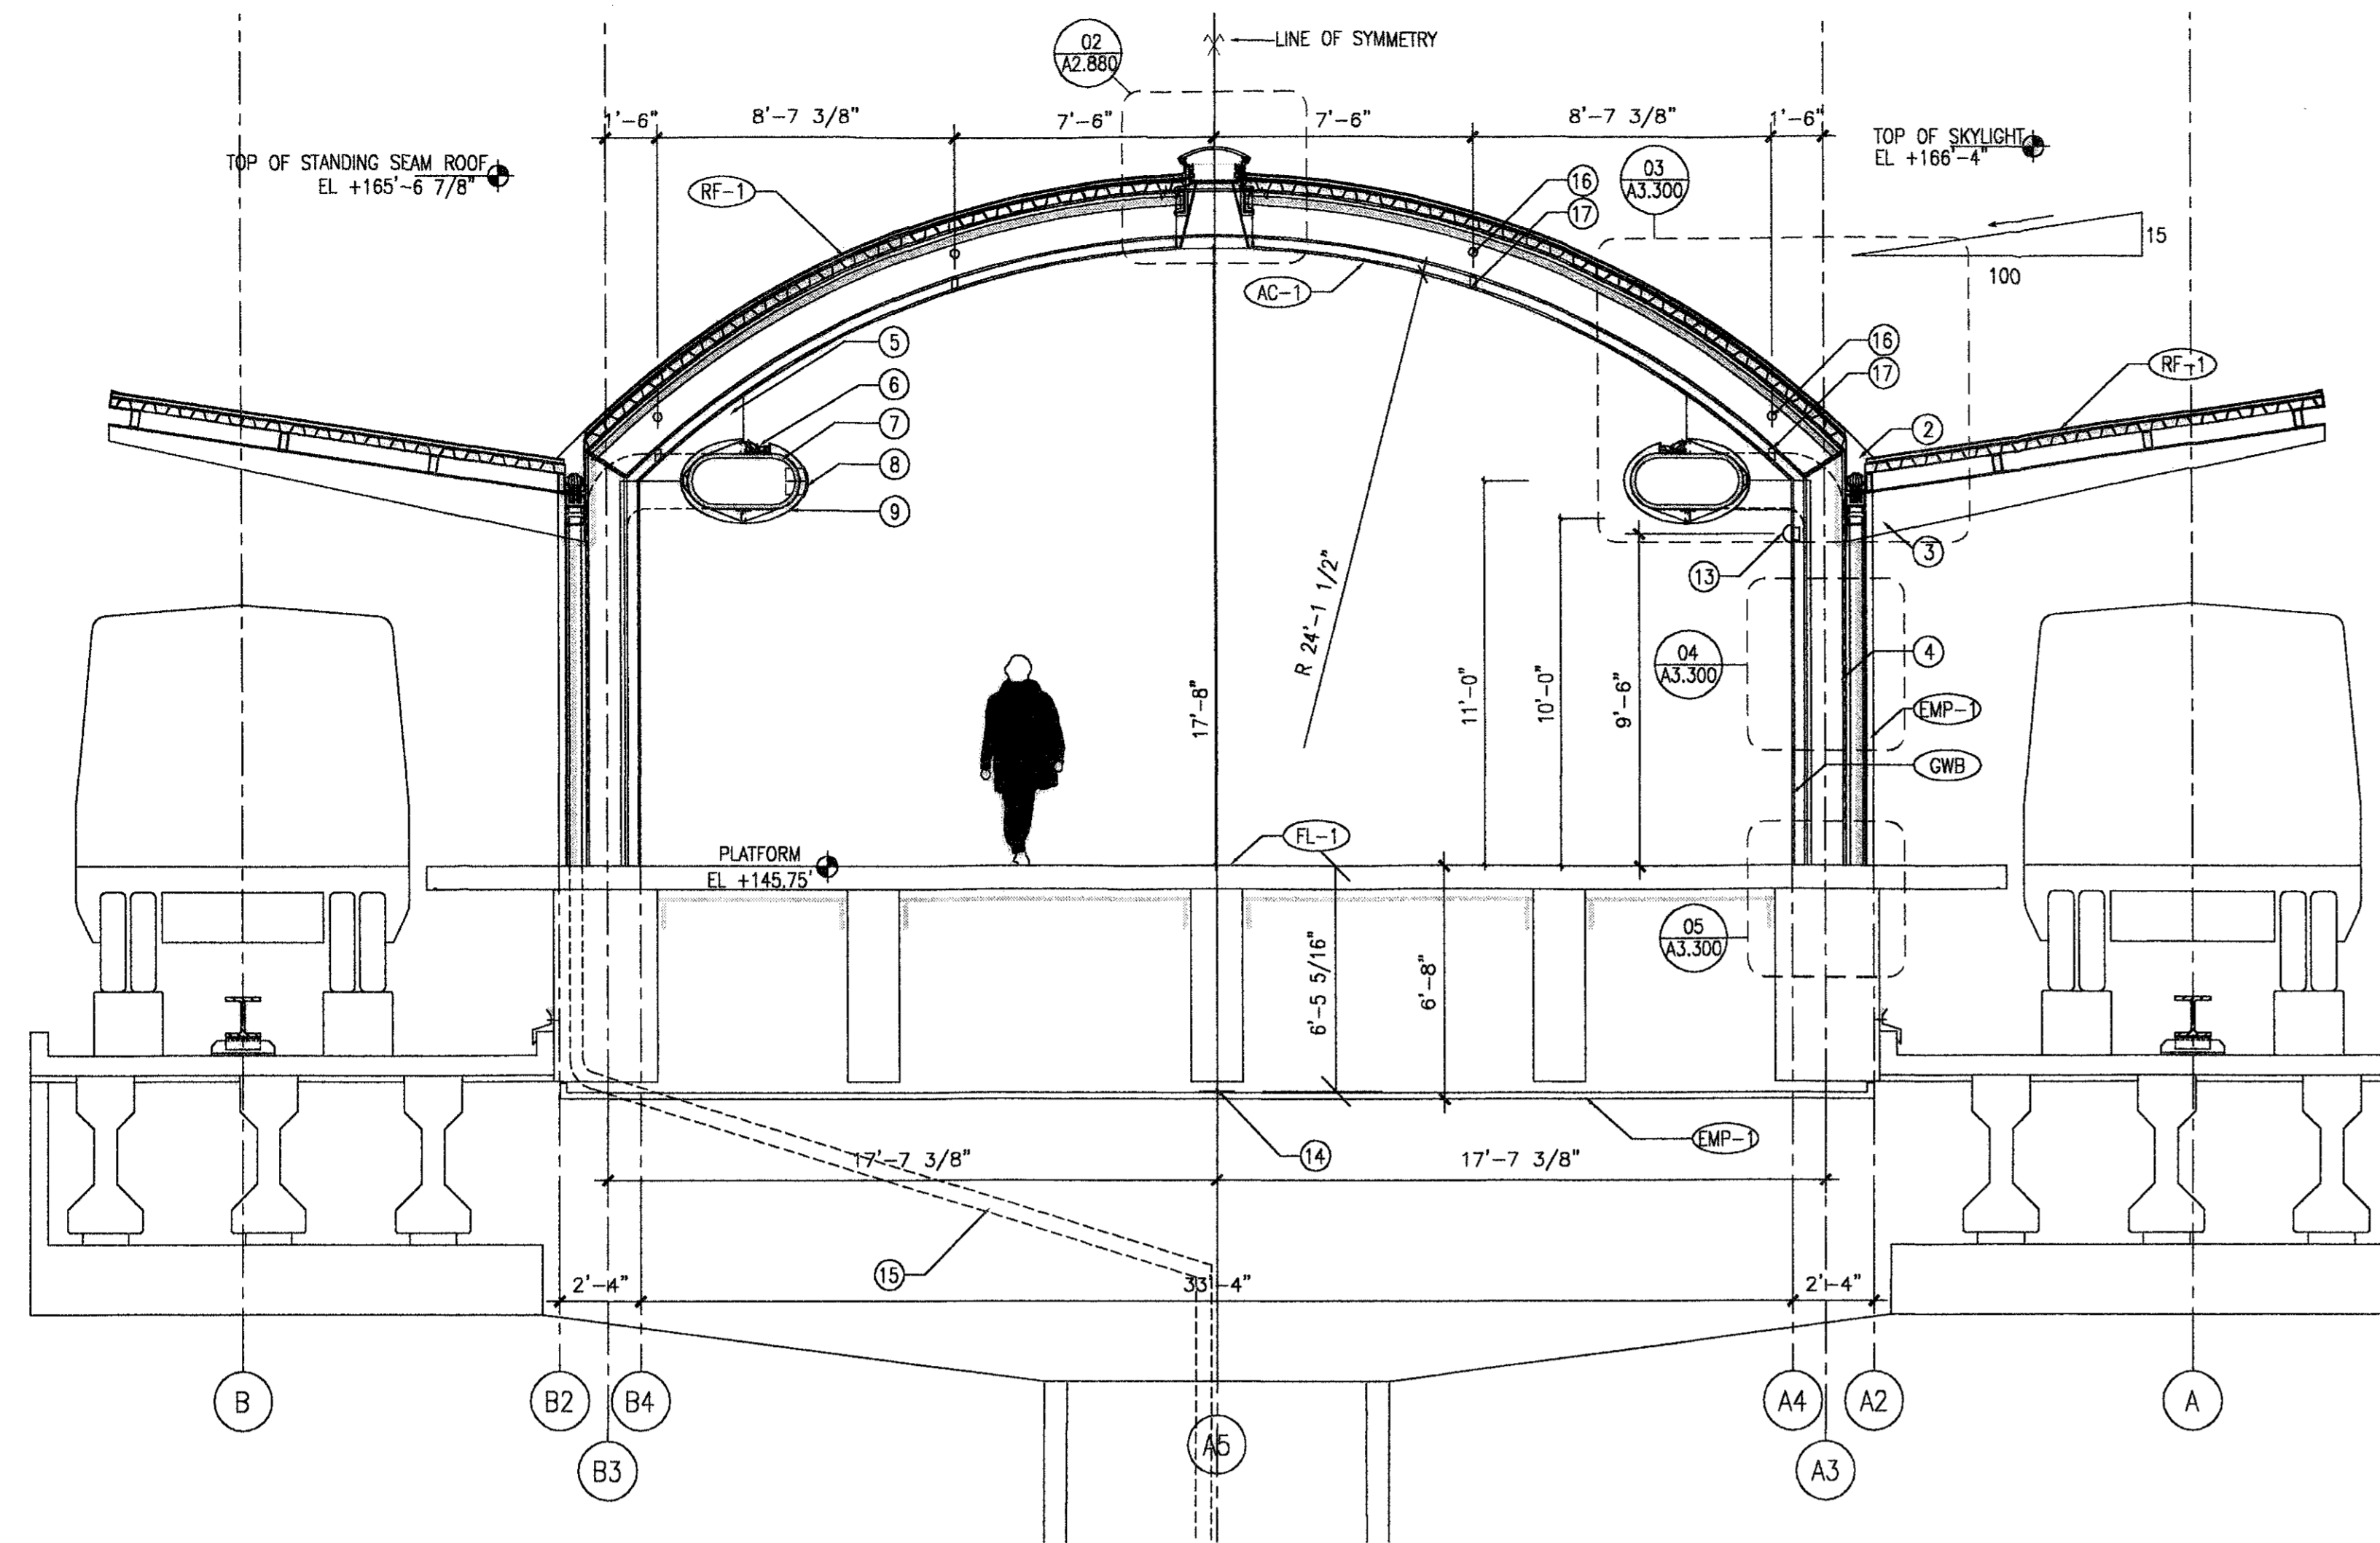

**CROSS SECTION @ PLATFORM**  
 02  
 A3.200 1/4"=1'-0"

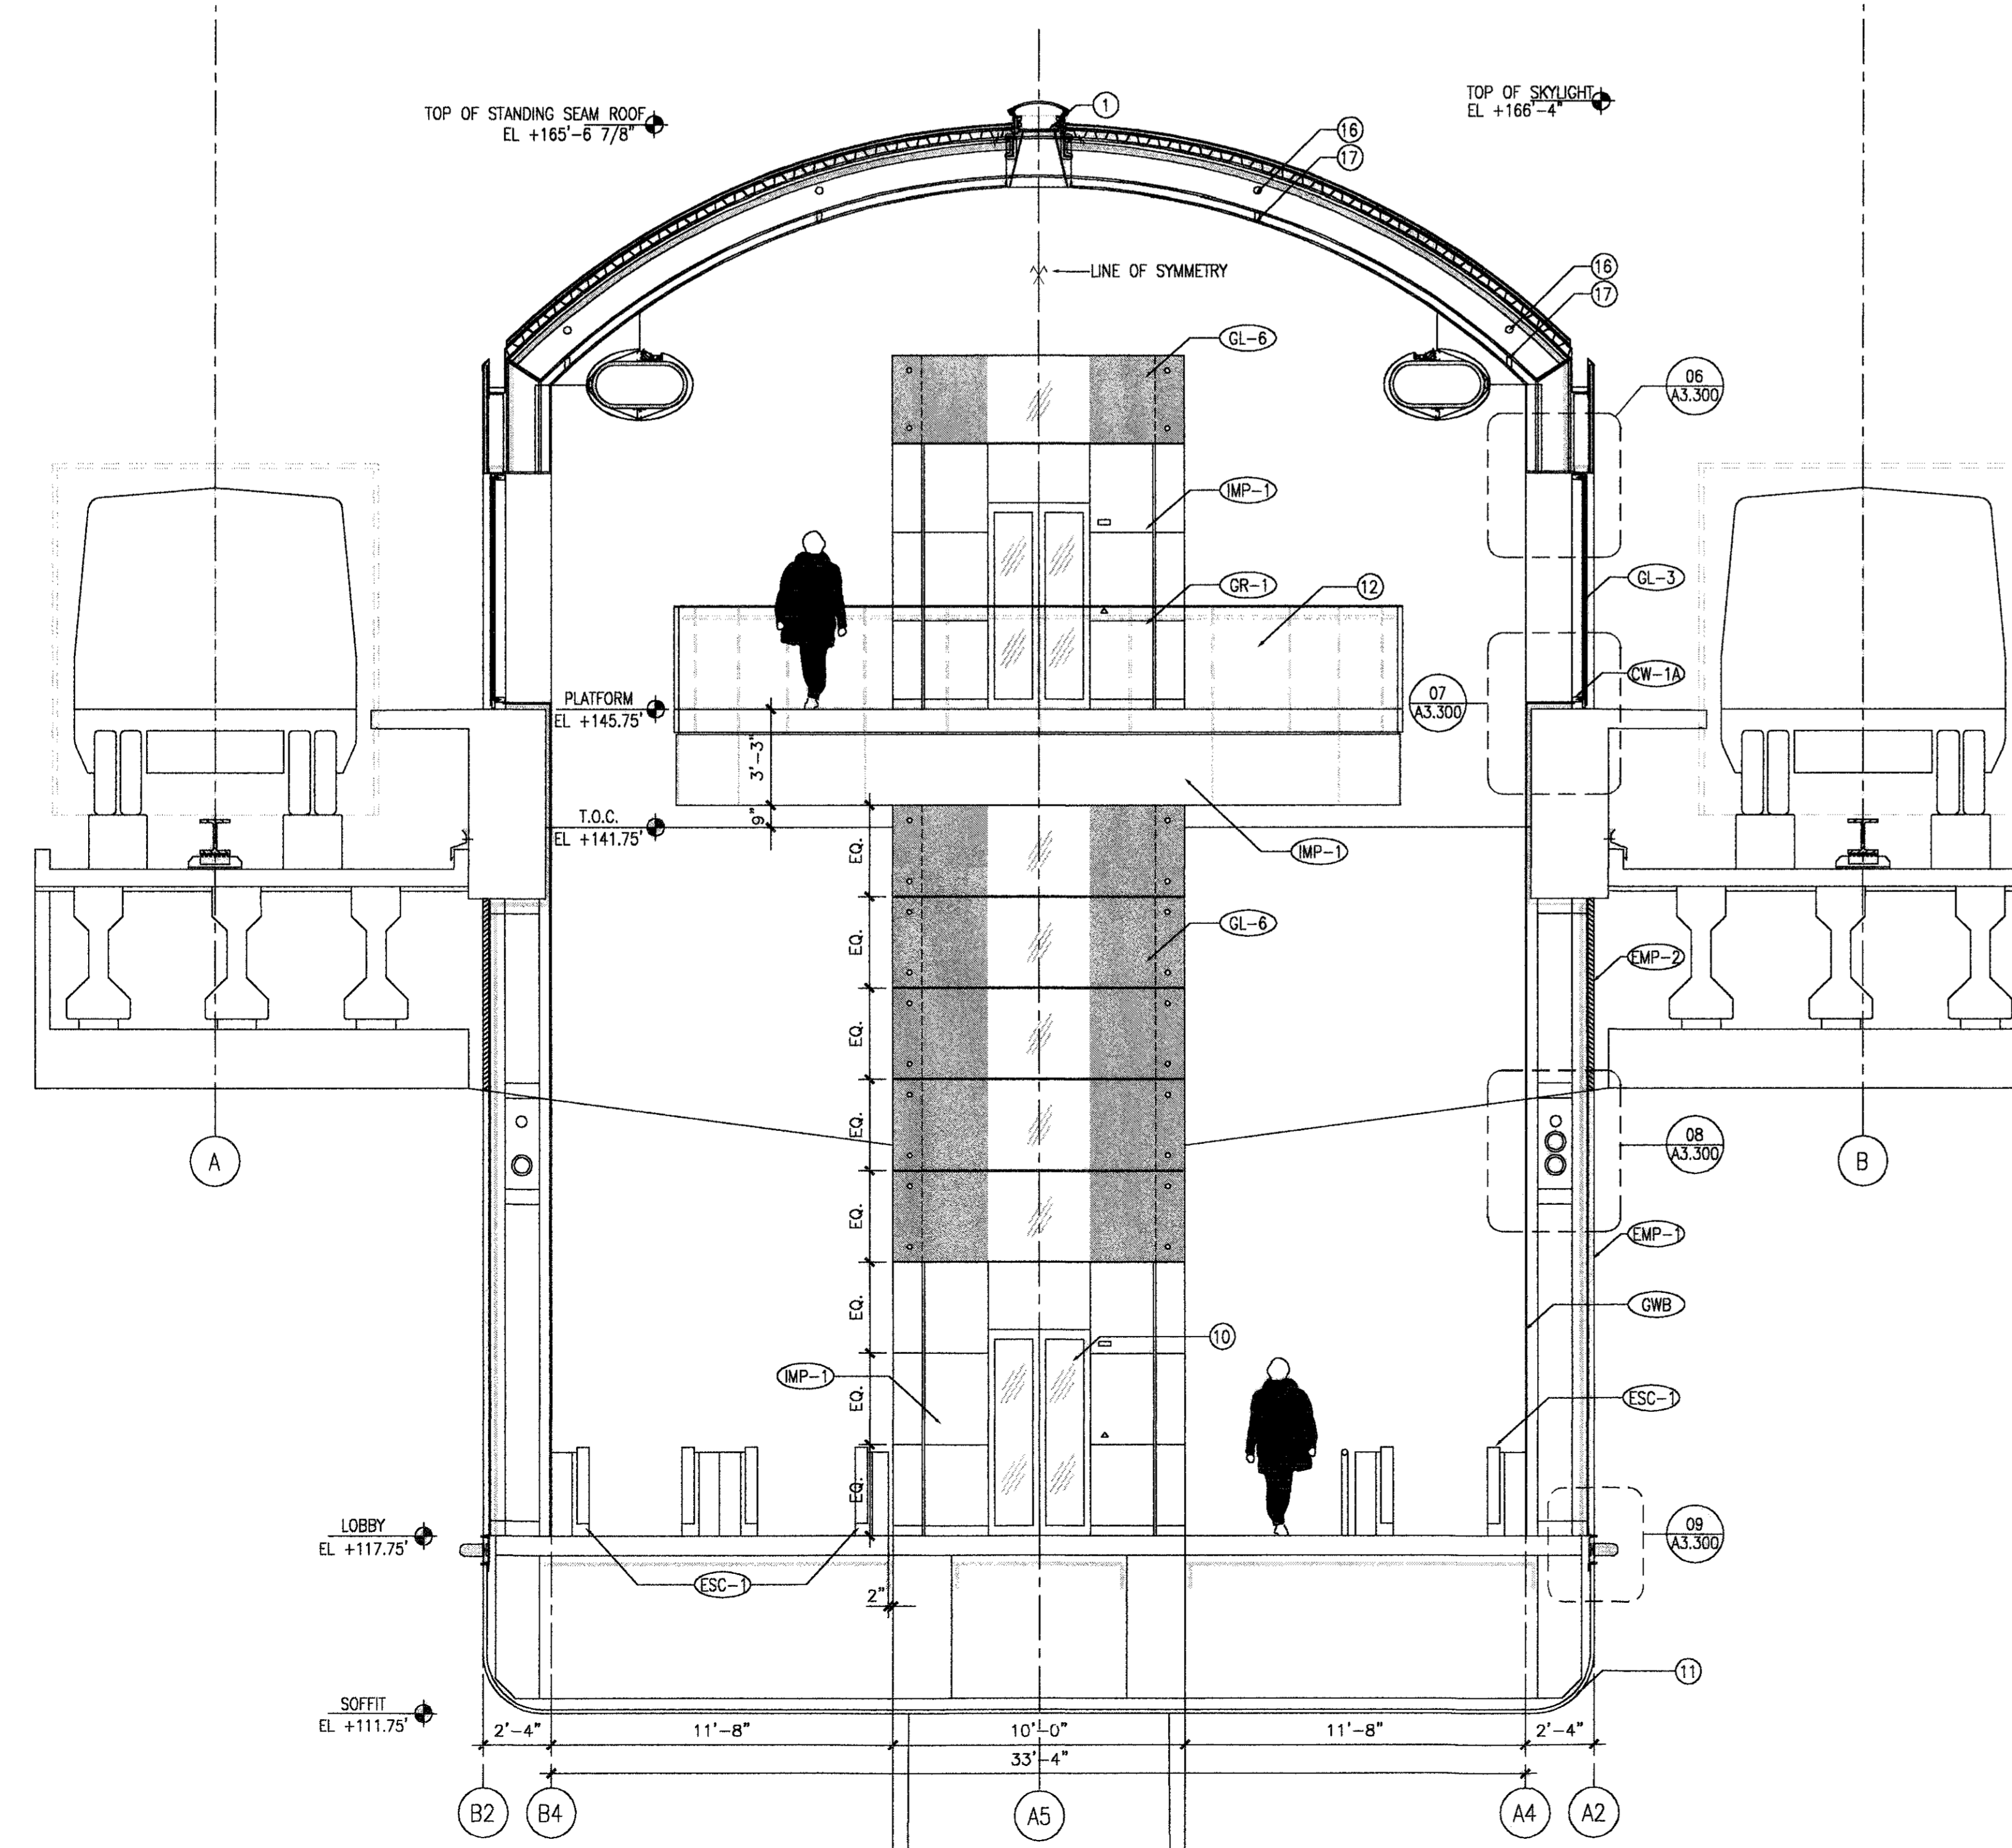

**CROSS SECTION @ LOBBY**  
 01  
 A3.200 1/4"=1'-0"

**GENERAL NOTES:**

- RF-1 STANDING SEAM METAL ROOF - TYPE UC3 FROM UNA-CLAD - COPPER SALES OR EQUAL - WIDTH 1'-0" - POWDERCOAT KYNAR 500: COLOR#2 SILVER METALLIC
- IMP-1 INTERIOR STAINLESS STEEL WALL PANELS MULTI DIRECTIONAL MACHINE POLISH
- EMP-1 EXTERIOR POWDERCOAT METAL PANEL - ALUMINIUM PANEL 1/8" THICK - TYPE SERIES 3000 MODIFIED FROM UNA-CLAD - COPPER SALES OR EQUAL POWDERCOAT KYNAR 500 - FOR COLOR RE. SCHEDULE SHEET A2.800
- CW-1A INTEGRATED STRUCTURAL CURTAINWALL SYSTEM TYPE 1A - RE WINDOW SCHEDULE SHEET A2.850
- GL-3 1" INSULATED GLAZING UNIT WITH FRIT.
- GL-6 1/2" THK LAMINATED GLASS WITH PARTIAL WHITE INTERLAYER
- AC-1 PRE-FINISHED CURVED, PERFORATED METAL CEILING PANEL - TYPE ALUMA VAULT SYSTEM 1000 BY GORDON MANUFACTURER - OR EQUAL WITH BLACK NON WOVEN ACOUSTICAL MAT
- CWB PAINT GYPSUM BOARD
- FL-1 TERRAZZO FLOOR
- GR-1 GLASS GUARDRAIL - CURVED @ ELLIPTICAL BALCONY
- ESC-1 MONTGOMERY KONE TRANSIT ESCALATOR WITH GLASS BALUSTRADE

**KEYED NOTES:**

- 1 SKYLIGHT - RE A2.880
- 2 SSTL GUTTER - RE A8.020
- 3 CANOPY STEEL STRUCTURE - HIGH PERFORMANCE PAINTING
- 4 STEEL COLUMN WITH 3HR FIREPROOFING
- 5 SSTL METAL CLAD - 1/16" THK - MULTI DIRECTIONAL MACHINE POLISH
- 6 INDIRECT LIGHT - RE: ELECTRICAL
- 7 OVAL A/C DUCT - RE MECHANICAL
- 8 ALUMINIUM LINEAR SLOT DIFFUSER - RE: MECHANICAL
- 9 ELLIPTICAL SSTL CLAD - 1/16" THK - MULTI DIRECTIONAL MACHINE POLISH - RE A9.000
- 10 GLAZED DOOR - 7/16" LAMINATED GLASS
- 11 CURVED METAL PANEL - TYPE EMP-1 - RADIUS 2'
- 12 CURVED GLASS AND HANDRAIL @ ELLIPTICAL BALCONY
- 13 WALL MOUNT FIXED CAMERA - RE SECURITY
- 14 CENTER POINT OF CURVED ROOF AND CEILING
- 15 DOWNSPOUT IN CONC. BENT - RE PLUMBING AND STRUCTURAL
- 16 3" HOLES IN ALL CURVED W16 BEAM FOR SPRINKLER PIPING
- 17 PROPOSED SPRINKLER HEAD LOCATION

**RECORD DRAWINGS**  
 DO NOT MODIFY  
 Roy de la Reza Architects, Inc.  
 13 May 2005

Note: Information used to develop these documents was taken from Record of the Work Drawings prepared by the construction contractor, Clark Construction Group - Texas. The information provided by the contractor was not verified by the design firm named above.


NOTE: REFER TO GRAPHIC SCALE IF ACTUAL SHEET SIZE IS OTHER THAN 30"x42".  
 0' 2' 4' 8' 12'  
 SCALE: 1/4" = 1'-0"

REVISIONS		
NO.	DESCRIPTION	DATE
1	ISSUED FOR BID	10/19/01
2	RECORD SET	05/13/05 EM

INTERNATIONAL SERVICES EXPANSION PROGRAM  
**APM STATION + PLATFORM**  
 CROSS SECTIONS

PROJECT MGR: HEM  
 DESIGNER: SG  
 DRAWN BY: SEM  
 CHECKED BY: AB  
 DRAWING STANDARD: ISIP 07.20.2000


SCALE: 1/4"=1'-0"  
 DATE: 09/14/05

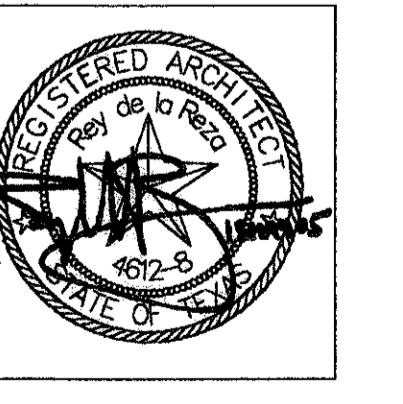


APPROVED BY: DATE:  
 DIRECTOR  
 HOUSTON AIRPORT SYSTEM

PROJECT NO. 1140  
 C.I.P. NO. A-0364  
 H.A.S. NO. 536C  
 SHEET NO.




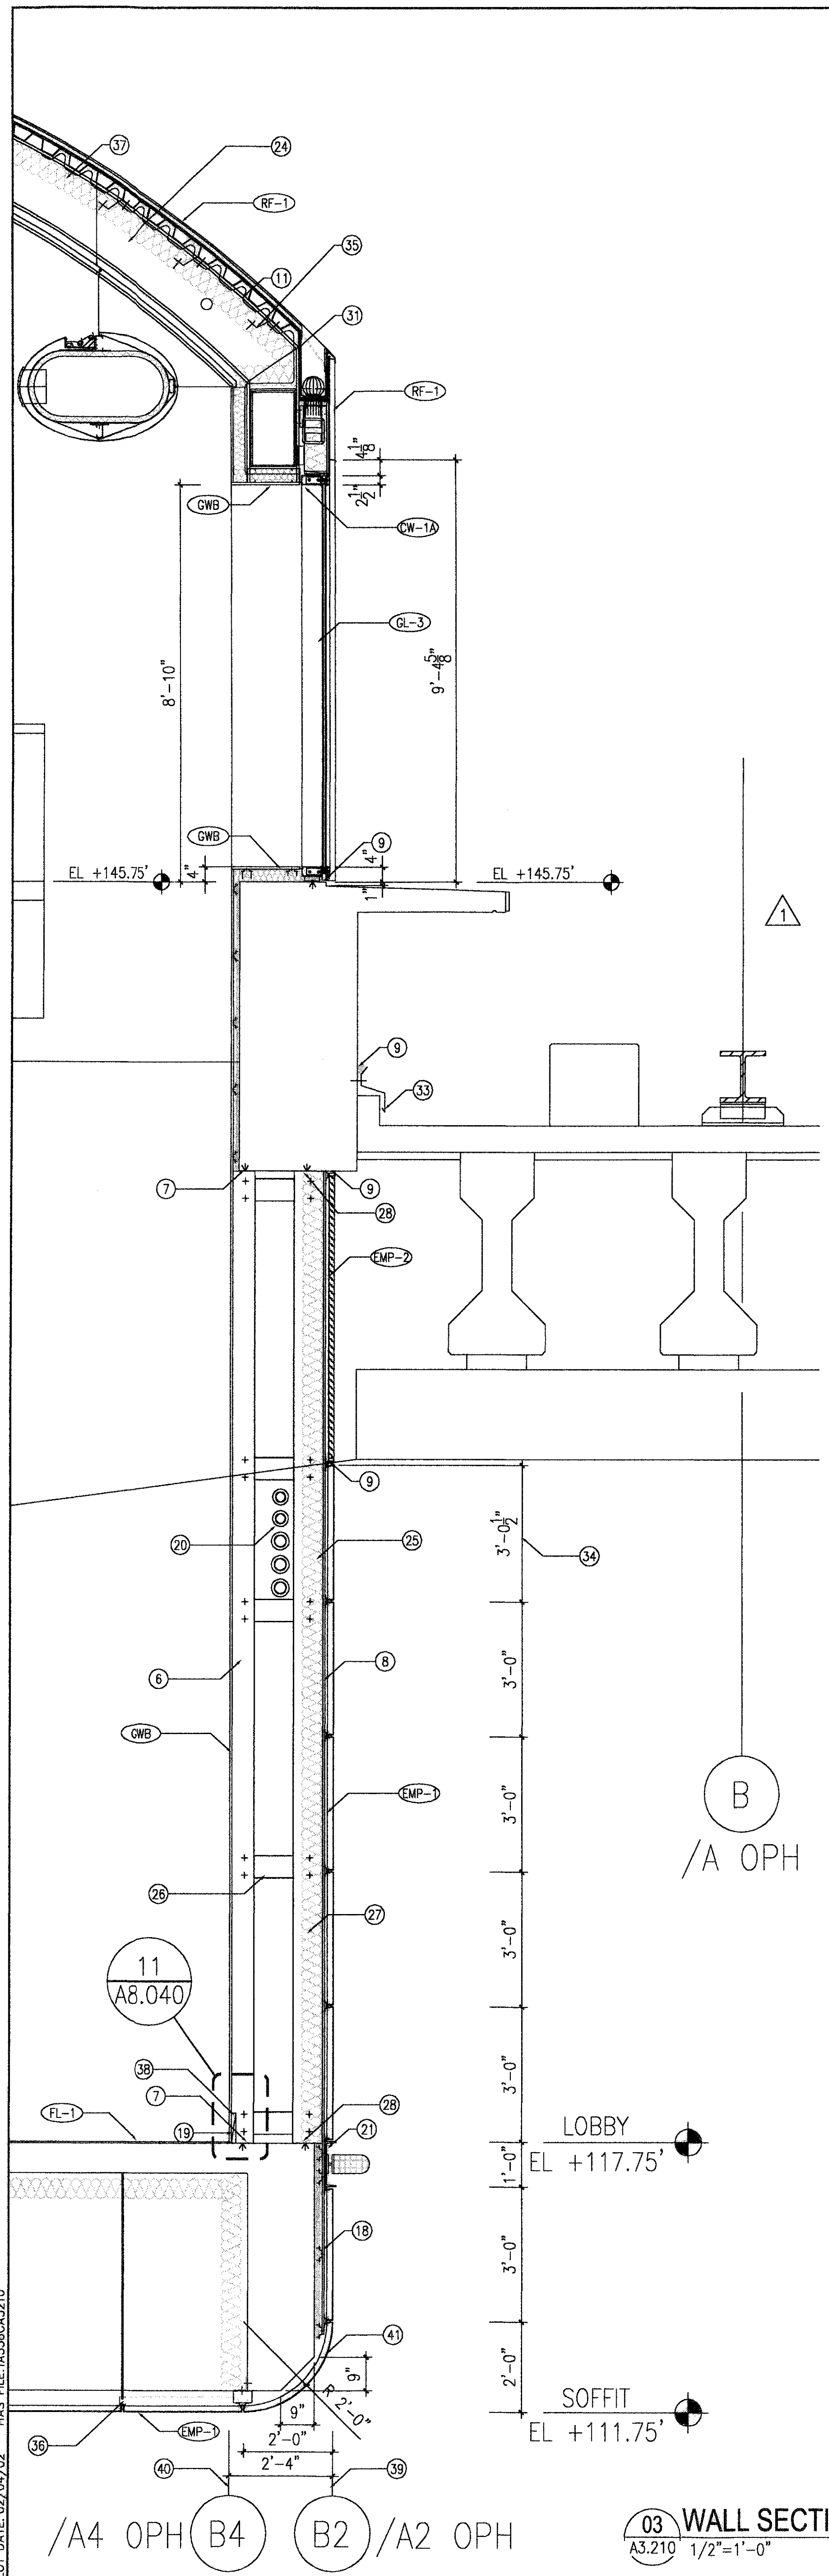

**03 WALL SECTION 03**  
A3.210 1/2"=1'-0"

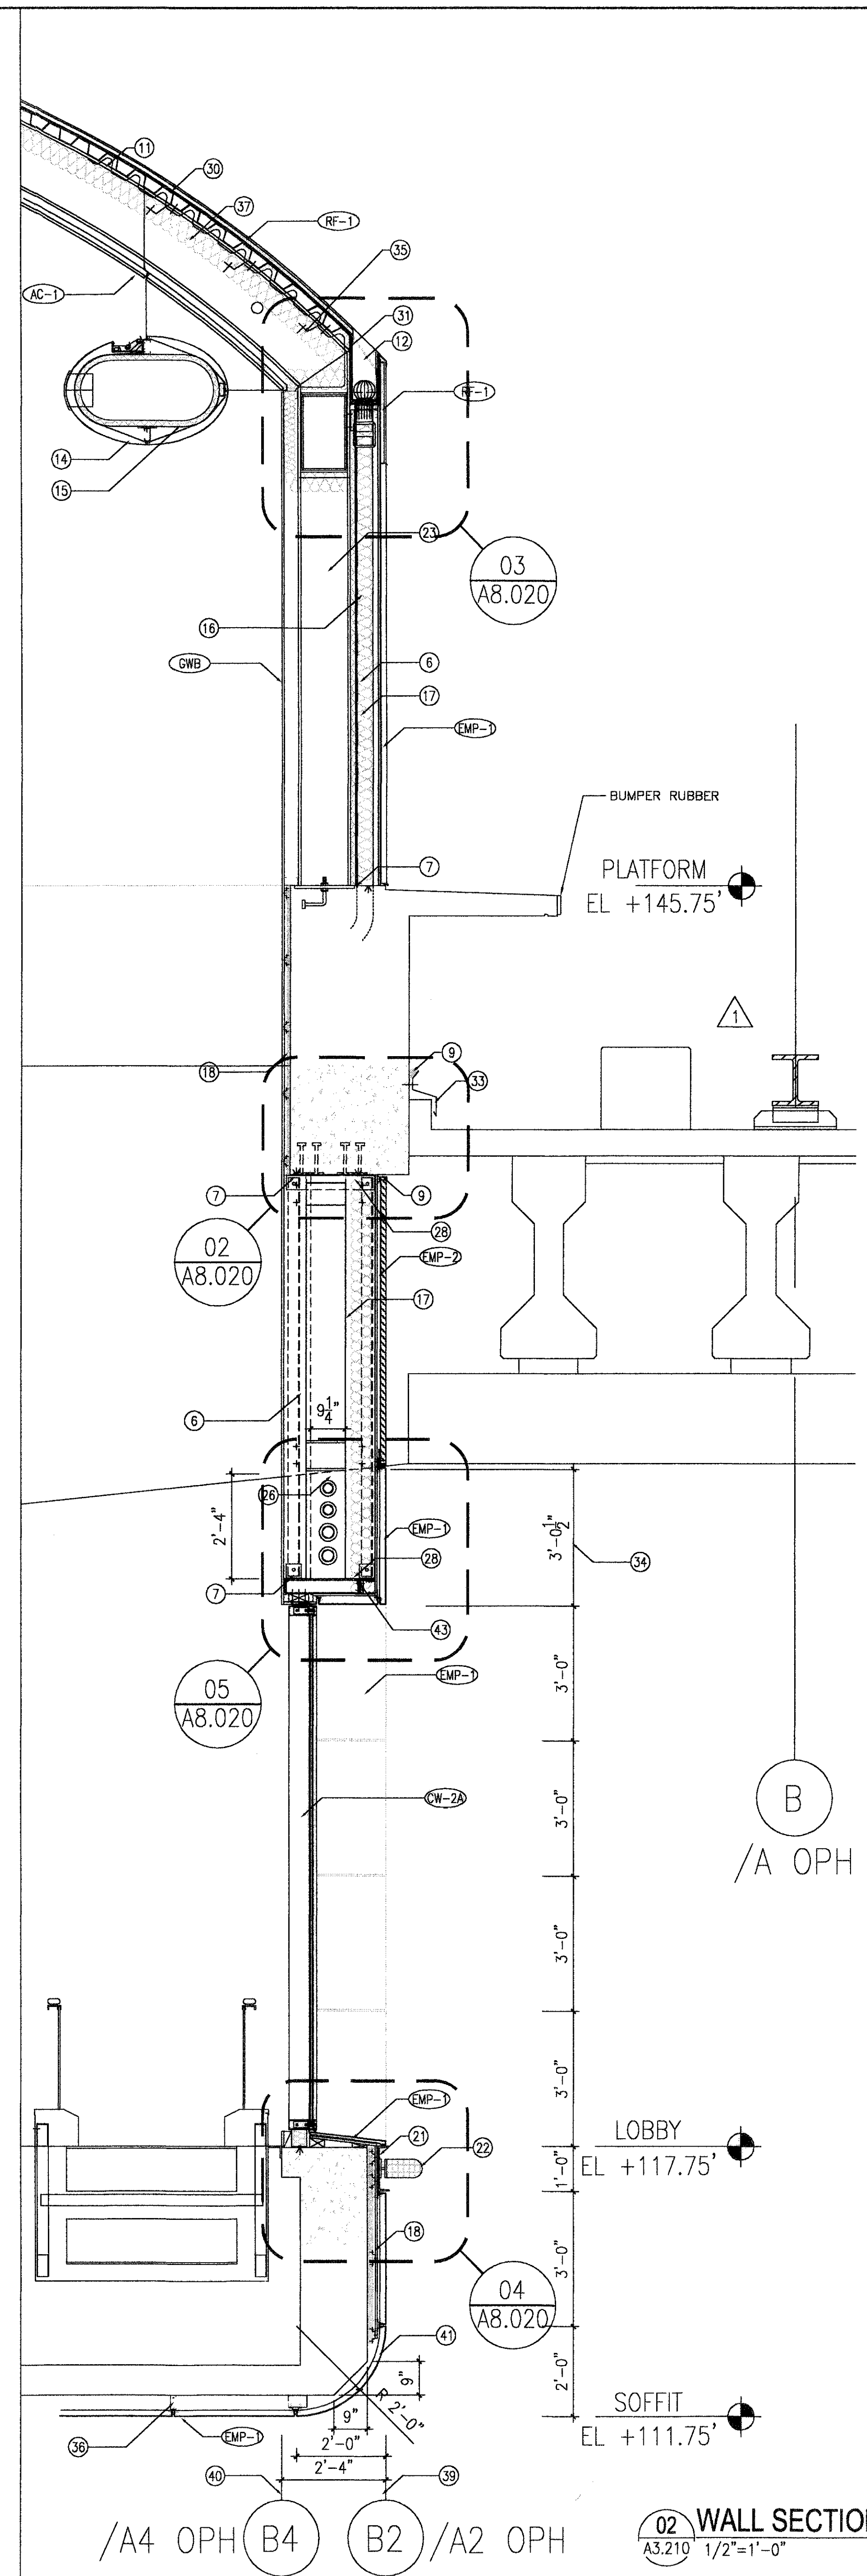

**02 WALL SECTION 02**  
A3.210 1/2"=1'-0"

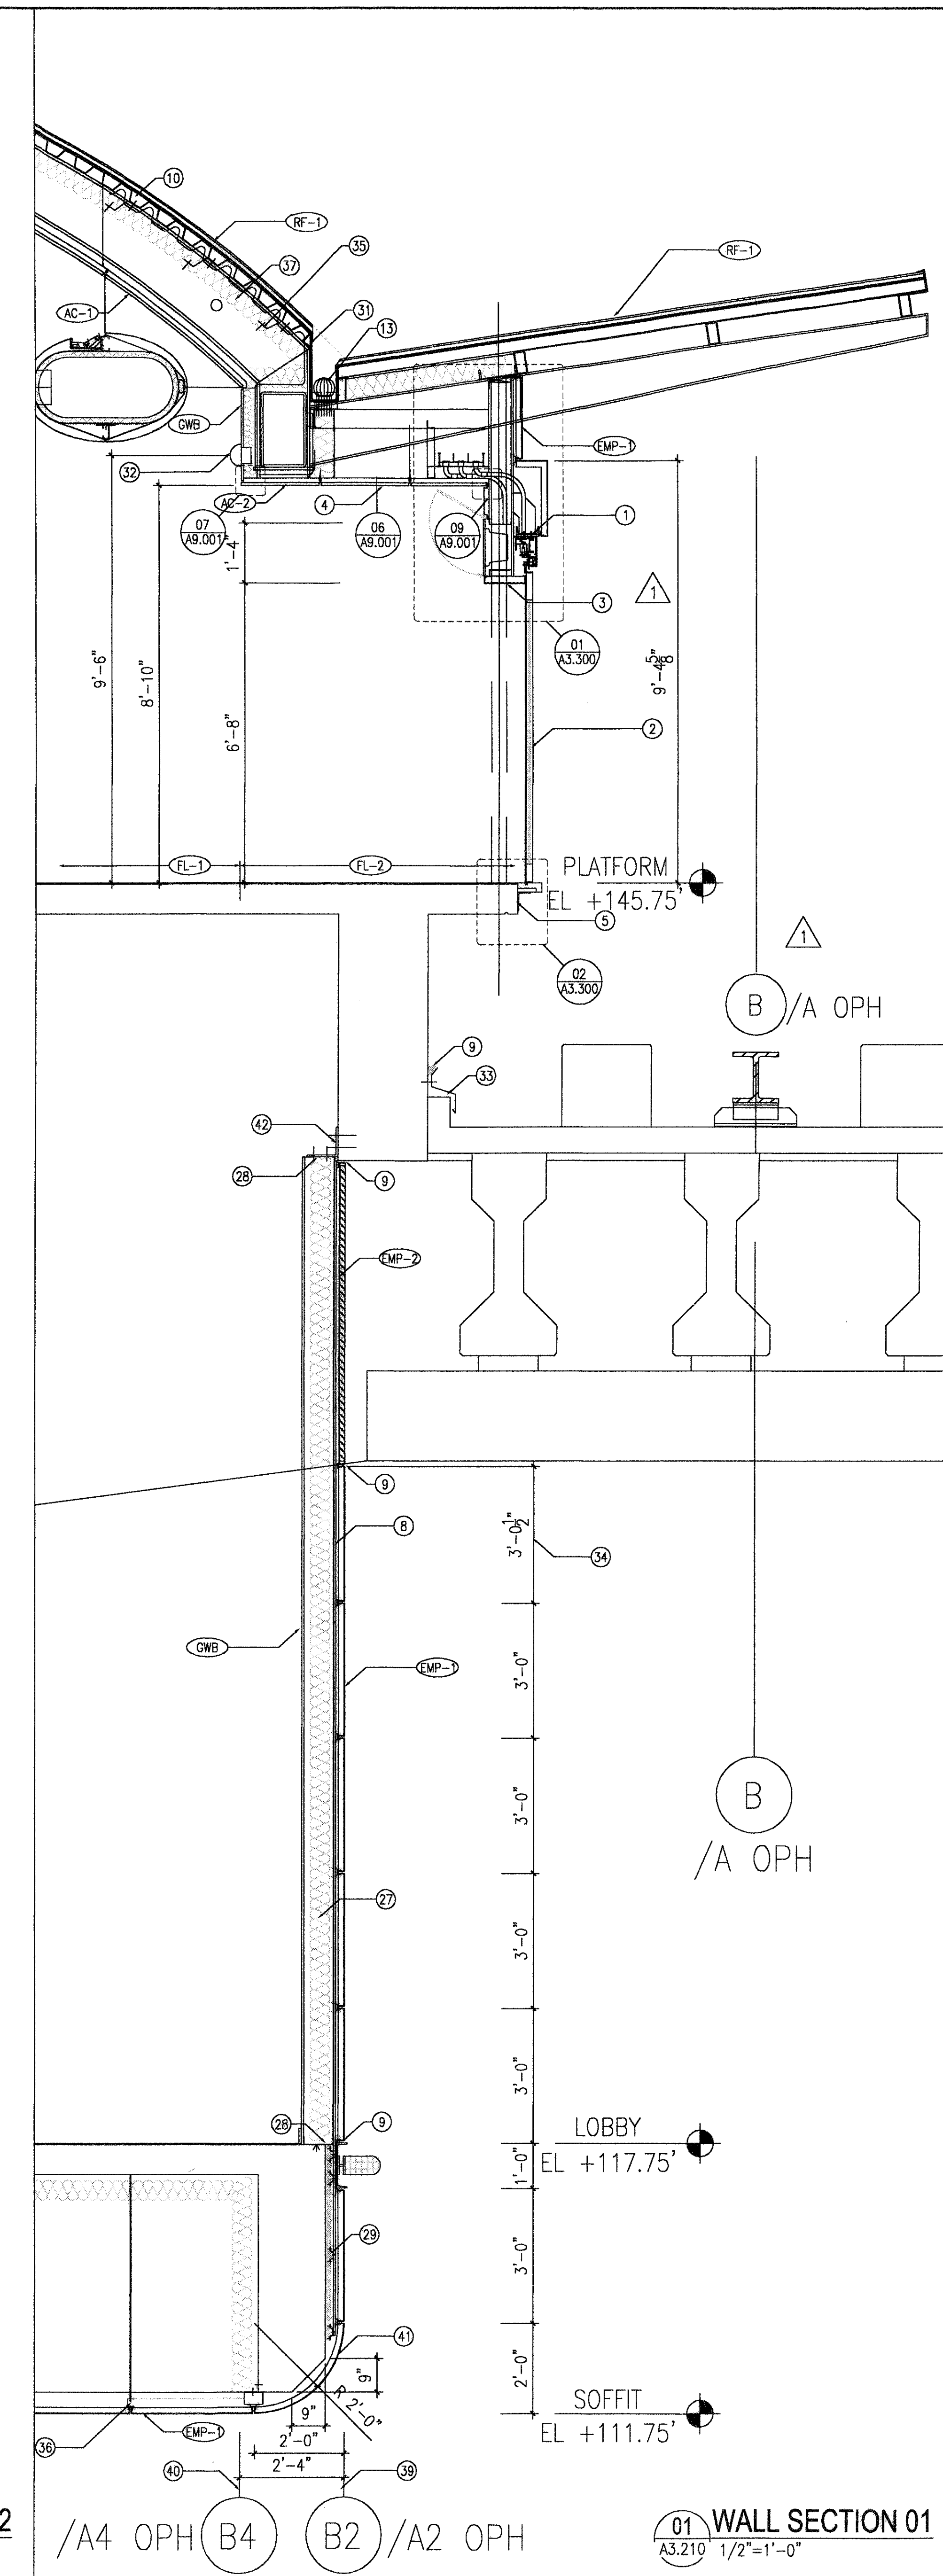


**01 WALL SECTION 01**  
A3.210 1/2"=1'-0"

**GENERAL NOTES:**

- Ⓢ-1A INTEGRATED STRUCTURAL CURTAINWALL SYSTEM  
TYPE 1A - RE WINDOW SCHEDULE
- Ⓢ-2A INTEGRATED STRUCTURAL CURTAINWALL SYSTEM  
TYPE 2A - RE WINDOW SCHEDULE A2.850
- Ⓢ-3 1" INSULATED GLAZING UNIT WITH FRITL. RE WINDOW  
AND GLASS SCHEDULE A2.850
- Ⓢ-1P EXTERIOR POWDERCOATED WALL METAL PANELS - ALUMINUM PANEL 1/8" THICK  
- TYPE SERIES 3000 MODIFIED FROM UNA-CLAD - COPPER SALES OR EQUAL  
- POWDERCOATED KYMAR 500
- Ⓢ-2P POWDERCOATED ALUMINUM LOUVERS  
- WITH INSECT MESH WHEN USED BY MECHANICAL  
- CLOSED WITH 1/8" THK ALUMINUM SHEET WELDED CONTINUOUSLY TO FRAME  
WHEN NOT USED BY MECHANICAL - RE MECHANICAL FOR OPENINGS
- Ⓢ-1R STANDING SEAM METAL ROOF - TYPE UC3 FROM UNA-CLAD - COPPER SALES OR  
EQUAL - POWDERCOATED KYMAR 500; COLOR #2 SILVER METALLIC
- Ⓢ-1C PAINT 5/8" HI-IMPACT GYPSUM BOARD ON METAL  
STUDS
- Ⓢ-1V PRE-FINISHED CURVED, PERFORATED METAL CEILING PANEL - TYPE ALUMA VAULT  
SYSTEM 1000 BY GORDON MANUFACTURER - WITH BLACK NON WOVEN  
ACOUSTICAL MAT
- Ⓢ-2R REMOVABLE SSTL CEILING PANELS  
SSTL MULTI DIRECTIONAL MACHINE POLISH
- Ⓢ-1T TERRAZZO FLOOR TYPE 1
- Ⓢ-2T TERRAZZO FLOOR TYPE 2

**KEYED NOTES:**

- 1 6" STEEL CHANNEL FIXED ON METAL POSTS - RE SHEET A8.040
- 2 SLIDING DOOR BY OTHERS 5360 - N.I.C. - DIMENSIONS TO BE COORDINATED WITH 5360
- 3 STAINLESS STEEL HEAD
- 4 REMOVABLE SSTL CEILING PANELS TYPE AC-2
- 5 STEEL ANGLE ANCHOR TO CONCRETE SLAB - SUPPORT OF SLIDING DOORS THRESHOLD
- 6 6" METAL STUD @ 16" O.C 16 GA.
- 7 6" STEEL RUNNER
- 8 1/2" SHEATHING
- 9 SEALANT & BACKER ROD
- 10 5/8" GYPSUM SHEATHING TYPE X
- 11 3" METAL DECK + 1HR SPRAY APPLIED FIREPROOFING
- 12 SSTL GUTTER - 16 GA
- 13 BASKET STRAINER
- 14 ALUM. CLAD - POWDERCOATED
- 15 A/C DUCT - RE MECHANICAL
- 16 DOWNSPOUT - RE PLUMBING
- 17 BATT INSULATION
- 18 RIGID INSULATION
- 19 SCHEDULED BASE - RECESSED - ALIGNED WITH FINISH FACE OF WALL
- 20 CHS, CHR, HWR, FWS, DUCTS AND SPRINKLER SUPPLY - REFER TO MEP PLANS
- 21 12" ALUMINUM CHANNEL - POWDERCOATED COLOR #1 - FASTENERS NOT VISIBLE;  
ANCHORED TO STRUCTURE BY ALUM PLATES WELDED @ CHANNEL BACK SIDE
- 22 BLUE SAFETY LIGHT
- 23 STEEL COLUMN + 3HR FIREPROOFING
- 24 STEEL BEAM + 3HR FIREPROOFING
- 25 UNDERLAYMENT
- 26 BRACING
- 27 8" METAL STUD JOIST @ 16" O.C 10 GA.
- 28 8" STEEL RUNNER
- 29 SHIM + SUBGIRT - SECURE TO CONCRETE
- 30 ROOFING UNDERLAYMENT TYPE VYCOR ULTRA FROM GRACE MANUFACTURER OR EQUAL
- 31 1/4" BENT STEEL PLATE - WELD TO STRUCTURE
- 32 FIXED CAMERA - RE SECURITY
- 33 EXTRUDED ALUMINUM FLASHING - POWDERCOAT FINISH
- 34 PANEL DIMENSION TO BE FIELD VERIFIED  
ALL METAL PANELS PERFECTLY ALIGNED
- 35 3" Z CLIP - 20 GA @ 24" O.C. - SECURE TO DECK  
BEFORE APPLYING SPRAY FIREPROOFING
- 36 SOFFIT SUSPENSION GRID: METAL STUDS AND 1/4" SUSPENSION RODS -  
STUD BRACING AS REQUIRED
- 37 BATT INSULATION @ ROOF FIXED TO STEEL Z CLIP
- 38 WOOD BLOCKING BEFORE APPLYING SPRAY FIREPROOFING
- 39 COLUMN LINE B2: EXT. METAL PANELS FINISH FACE - A2 @ OPH
- 40 COLUMN LINE B4: INT. FINISH FACE - A4 @ OPH
- 41 CURVED METAL PANEL TYPE EMP-1 - R 2'-0"
- 42 8"x8" STEEL ANGLE - ANCHORED TO CONCRETE BEAM
- 43 20"x4" STEEL TUBE - RE STRUCTURAL

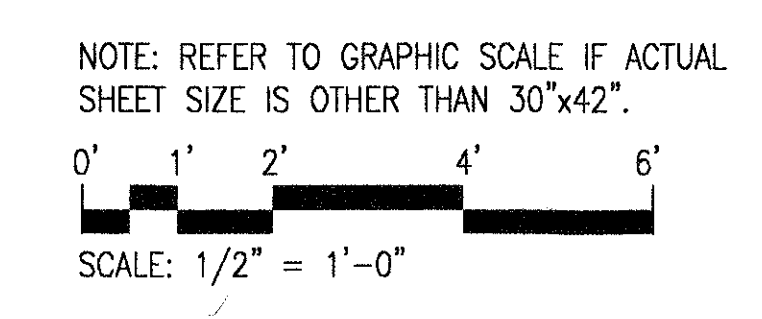

NO.	DESCRIPTION	DATE	BY
1	ISSUED FOR BID	10/19/01	
2	REVISION #1	01/27/03	SG
3	RECORD SET	05/13/05	EM

PROJECT MGR:	HEM
DESIGNER:	SG
DRAWN BY:	SEM
CHECKED BY:	AB
DRAWING STANDARD:	ISP 07.20.2000
SCALE:	1/2"=1'-0"
DATE:	09/14/01



APPROVED BY:	DATE:
DIRECTOR	
HOLSTON AIRPORT SYSTEM	
PROJECT NO.	1140
C.I.P. NO.	A-0354
H.A.S. NO.	536C
SHEET NO.	




REVISIONS			
NO.	DESCRIPTION	DATE	BY
ISSUED FOR BID		10/19/01	
REVISION #		01/27/03	SG
RECORD SET		05/13/05	EM

INTERNATIONAL SERVICES • EXPANSION • PROGRAM

**APM STATION + PLATFORM**

WALL SECTIONS

PROJECT MGR:	HEM
DESIGNER:	SG
DRAWN BY:	SEM
CHECKED BY:	AB
DRAWING STANDARD:	ISSP 07.20.2000
SCALE:	1/2"=1'-0"
DATE:	09/14/01

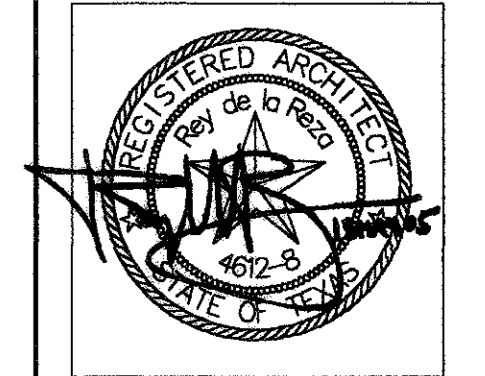


APPROVED BY:	DATE:
DIRECTOR	
HOUSTON AIRPORT SYSTEM	
PROJECT NO.	1140
C.I.P. NO.	A-0354
H.A.S. NO.	638C
SHEET NO.	A3.220

**GENERAL NOTES:**

- OVERALL DIMENSIONS @ SLIDING DOORS TO BE COORDINATED WITH HAS 5360
- (CW-4) INTEGRATED STRUCTURAL CURTAINWALL SYSTEM TYPE 4 - RE WINDOW SCHEDULE SHEET A2.850
- (GL-1) 1" INSULATED GLAZING
- (MP-1) EXTERIOR POWDERCOATED WALL METAL PANELS - ALUMINUM PANEL 1/8" THICK - TYPE SERIES 3000 MODIFIED FROM UNA-CLAD - COPPER SALES OR EQUAL - POWDERCOATED KYNAR 500
- (MP-2) POWDERCOATED ALUMINUM LOUVERS - WITH INSECT MESH WHEN USED BY MECHANICAL - CLOSED WITH 1/8" THK ALUMINUM SHEET WELDED CONTINUOUSLY TO FRAME WHEN NOT USED BY MECHANICAL - RE: MECHANICAL FOR OPENINGS
- (RF-1) STANDING SEAM METAL ROOF - TYPE UC3 FROM UNA-CLAD - COPPER SALES OR EQUAL - POWDERCOATED KYNAR 500; COLOR#2 SILVER METALLIC
- (GWB) PAINT 5/8" HI-IMPACT GYPSUM BOARD ON METAL STUDS
- (AC-1) PRE-FINISHED CURVED, PERFORATED METAL CEILING PANEL - TYPE ALUMA VAULT SYSTEM 1000 BY GORDON MANUFACTURER - WITH BLACK NON WOVEN ACOUSTICAL MAT
- (FL-1) TERRAZO FLOOR
- (MP-3) INTERIOR STAINLESS STEEL WALL PANELS SSSL MULTI DIRECTIONAL MACHINE POLISH

**KEYED NOTES:**



- 1 6" METAL STUD @ 16" O.C. 16 GA.
- 2 6" STEEL RUNNER
- 3 1/2" SHEATING
- 4 SEALANT & BACKER ROD
- 5 5/8" GYPSUM SHEATING TYPE X
- 6 3" METAL DECK + 1HR FIREPROOFING
- 7 SSSL GUTTER - 18 GA
- 8 BASKET STRAINER
- 9 STAINLESS STEEL CLAD - MULTI DIRECTIONAL MACHINE POLISH
- 10 A/C DUCT - RE MECHANICAL
- 11 DOWNSPOUT - RE PLUMBING
- 12 BATT INSULATION
- 13 4"x12" STEEL TUBE - SUPPORT OF 2 HR ROLLING DOOR - WITH 2 HR FIREPROOFING
- 14 SCHEDULED BASE - RECESSED - ALIGNED WITH SSSL PANELS
- 15 12" ALUMINUM CHANNEL - THERMOCOATED COLOR #1 - FASTENERS NOT VISIBLE; ANCHORED TO STRUCTURE BY ALUM PLATES WELDED @ CHANNEL BACK SIDE
- 16 BLUE SAFETY LIGHT
- 17 STEEL COLUMN + 3HR FIREPROOFING
- 18 STEEL BEAM + 3HR FIREPROOFING
- 19 UNDERLAYMENT
- 20 6" METAL STUD JOIST @ 16" O.C. 20 GA.
- 21 6" STEEL RUNNER
- 22 ROOFING UNDERLAYMENT TYPE VYCOR ULTRA FROM GRACE MANUFACTURER OR SIMILAR
- 23 1/4" BENT STEEL PLATE - WELDED TO STRUCTURE
- 24 PREFINISHED FLASHING POWDERCOATED - COLOR# 2
- 25 PERFORATED ALUMINUM SHEET - 1/8" THK - POWDERCOATED COLOR# 2 SECURED TO DECK BY POP RIVETS - ALL RIVETS ALIGNED - GRID TO BE DETERMINED
- 26 CANOPY STEEL STRUCTURE - PAINT
- 27 GALVANIZED STEEL DECK
- 28 6" ALUMINUM CHANNEL - ANODIZED - MIRROR POLISHED - FASTENERS NOT VISIBLE
- 29 METAL STUD CONSTRUCTION - SECURED TO STEEL STRUCTURE BY Z CLIPS BRACING AS REQUIRED
- 30 2HR FIRE RATED ROLLING DOOR - SAFESCAPE T2500 FIRE DOOR BY MC KEON MANUFACTURER - RE DOOR SCHEDULE
- 31 20"x8" STEEL TUBE WITH 3HR FIREPROOFING
- 32 2 1/2"x10" VERTICAL MULLION WITH STEEL REINFORCEMENT
- 33 2 1/2"x7 1/2" HORIZONTAL MULLION
- 34 2 1/2"x10 1/2" HORIZONTAL MULLION
- 35 2 1/2"x10 1/2" CURVED MULLION - SAME CURVE THAN CEILING
- 36 SWINGING EGRESS DOOR FROM 2HR FIRE RATED DOOR SYSTEM - POCKETED IN WALL SSSL CLADDING FINISH ON VISIBLE FACES INCLUDING FRAME PUSHING BAR AND DOOR ALIGNED WITH WALL FINISH FACE
- 37 STEEL Z @ EDGE OF ROOF - 1/8" THK - CURVED
- 38 FIS SECURE BRIDGE COLUMN GRID LINE - PROJECT 500F-1 LOCATION TO BE COORDINATED WITH HAS 500F-1
- 39 DOWNLIGHT
- 40 SSSL CEILING - TYPE AC-2
- 41 HONEYCOMBED ALUMINUM PANEL - 1/2" THK - POWDERCOATED COLOR #2
- 42 ALUMINUM FLASHING - POWDERCOATED COLOR #2
- 43 STEEL CLIP SECURE TO BEAM
- 44 DILATION JOINT BY OTHERS - 500F-1 CONCRETE SLAB DETAIL @ STATION TO BE COORDINATED WITH 500F-1
- 45 STEEL TUBES 4"x12" WELDED TO BEAM 20"x12" @ 24" O.C. - 2 HR FIREPROOFING
- 46 EXTRUDED ALUMINUM FLASHING - POWDERCOATED
- 47 SHEET METAL CLADDING - POWDERCOATED COLOR #2
- 48 2 HR GYPSUM PARTITION TYPE 2 UL # U411

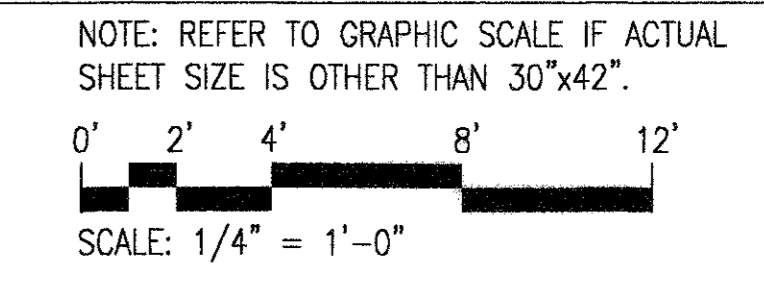


**RECORD DRAWINGS**  
 DO NOT MODIFY  
 Rey de la Reza Architects, Inc.  
 13 May 2005

Note: Information used to develop these documents was taken from Record of the Work Drawings prepared by the construction contractor, Clark Construction Group - Texas. The information provided by the contractor was not verified by the design firm named above.

**WALL SECTION 01 @ CANOPY**  
 A3.220 1/2"=1'-0"

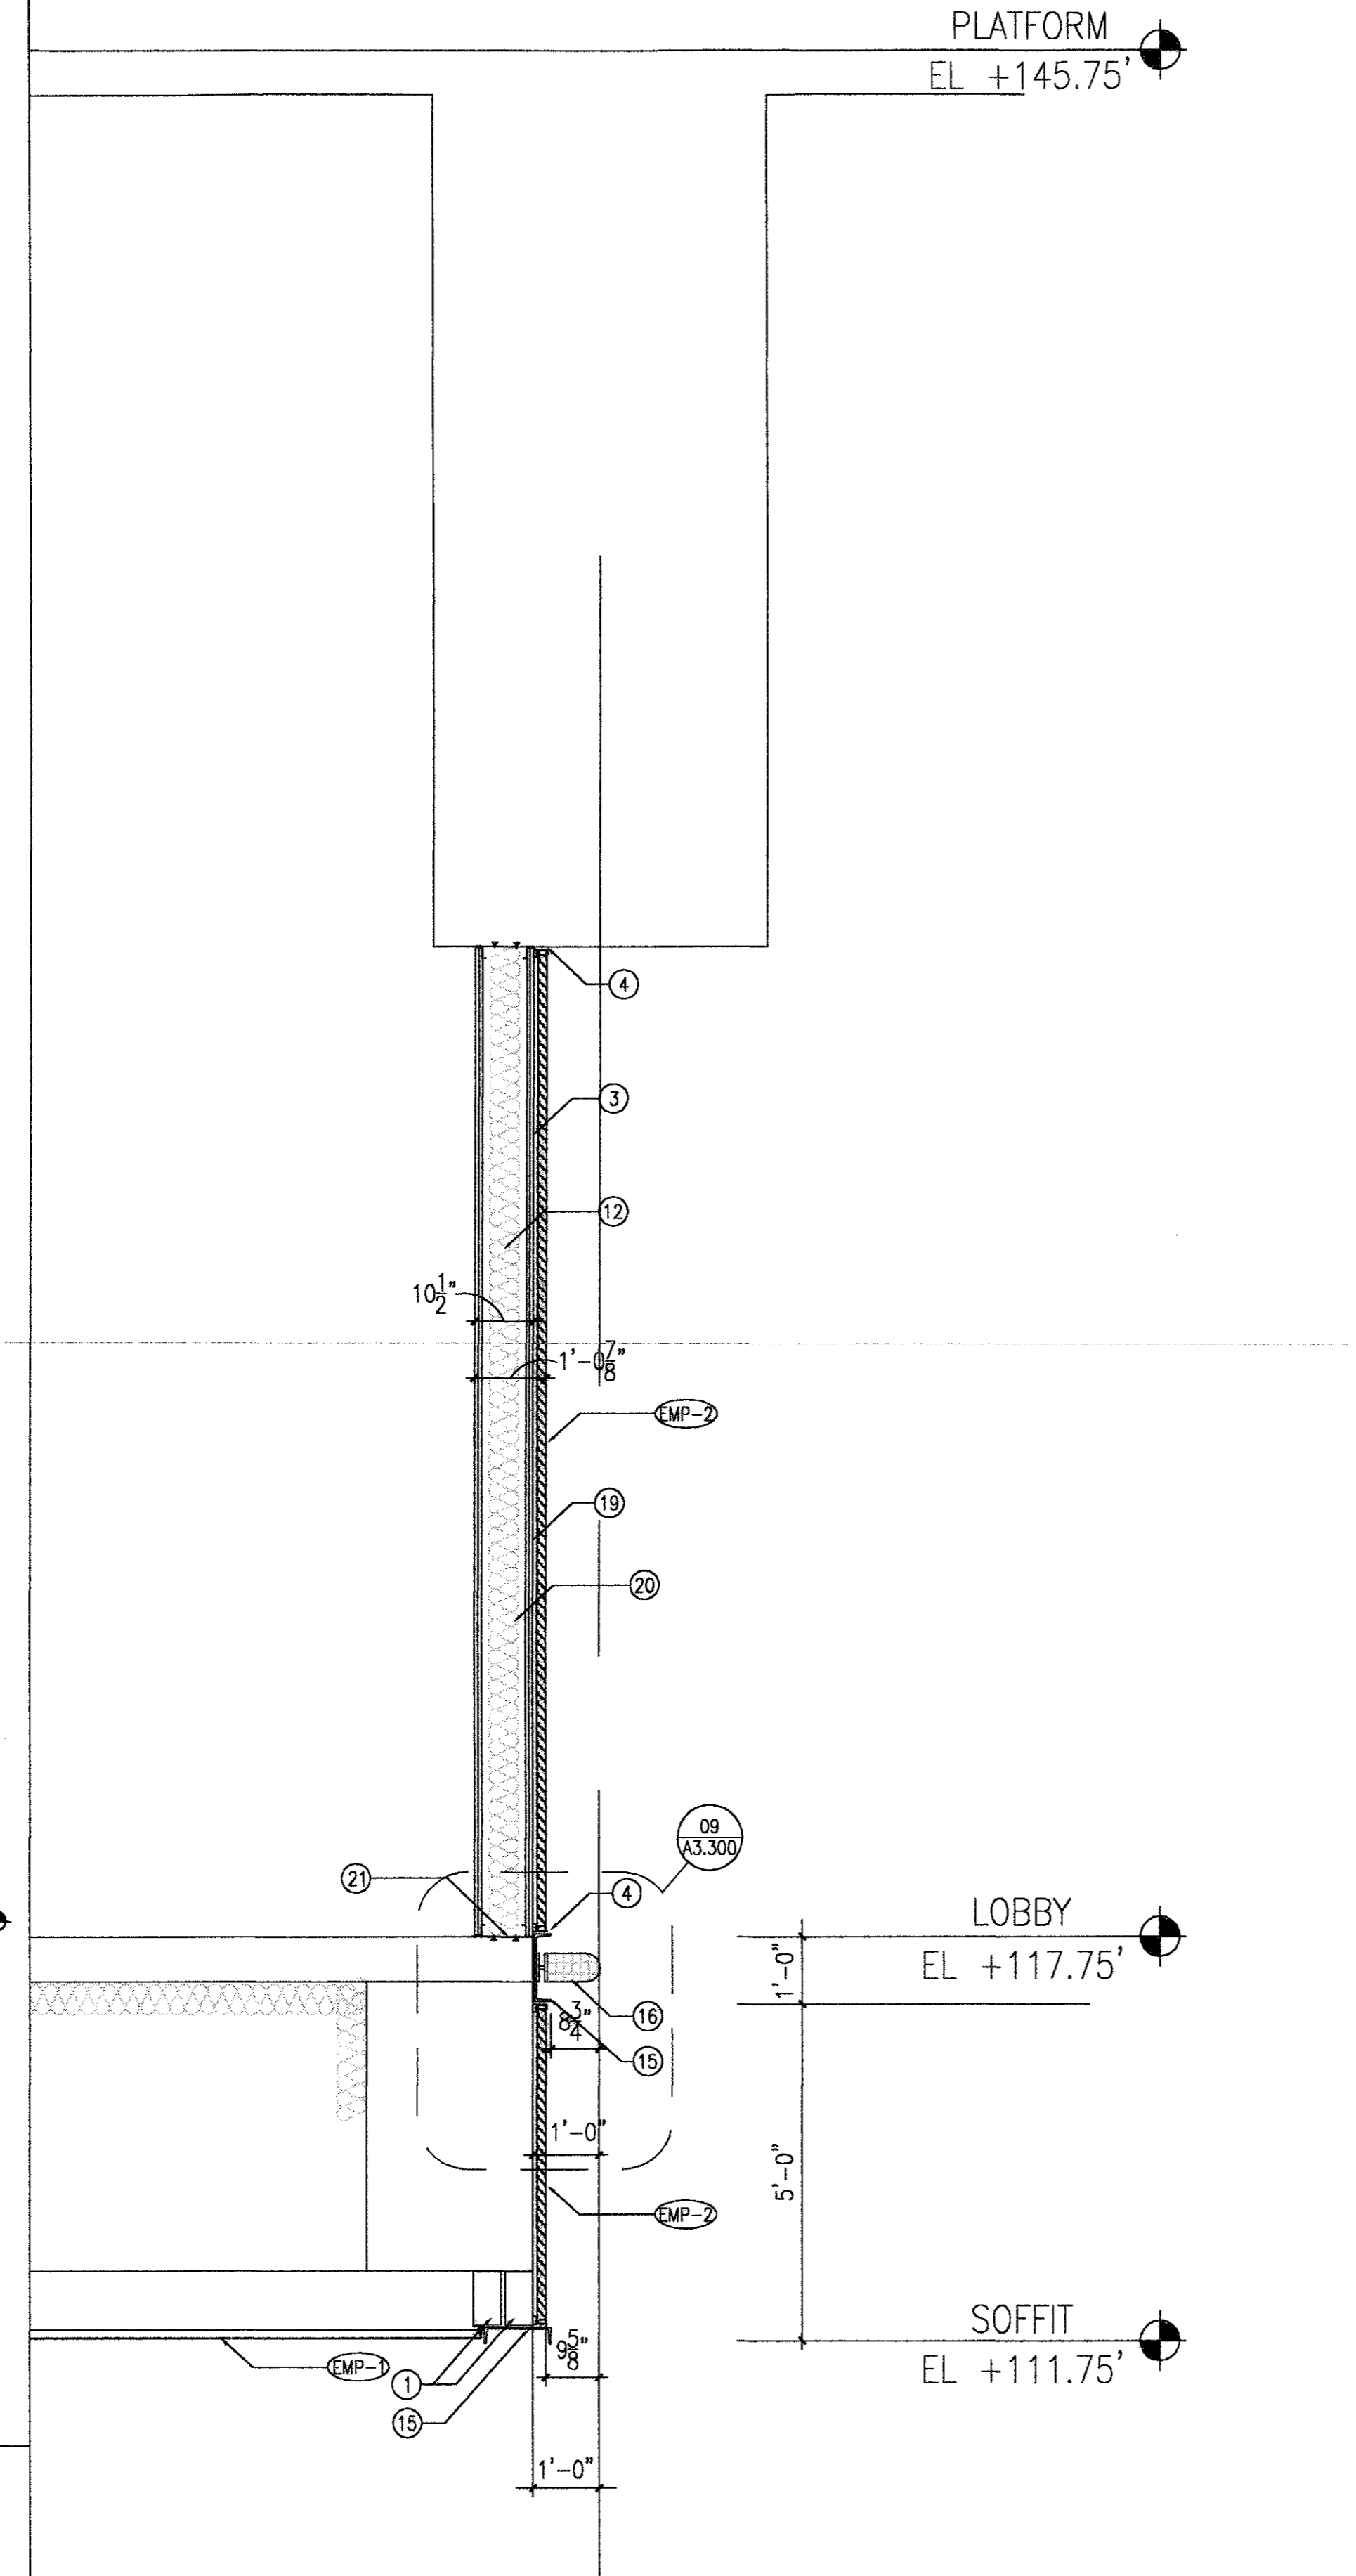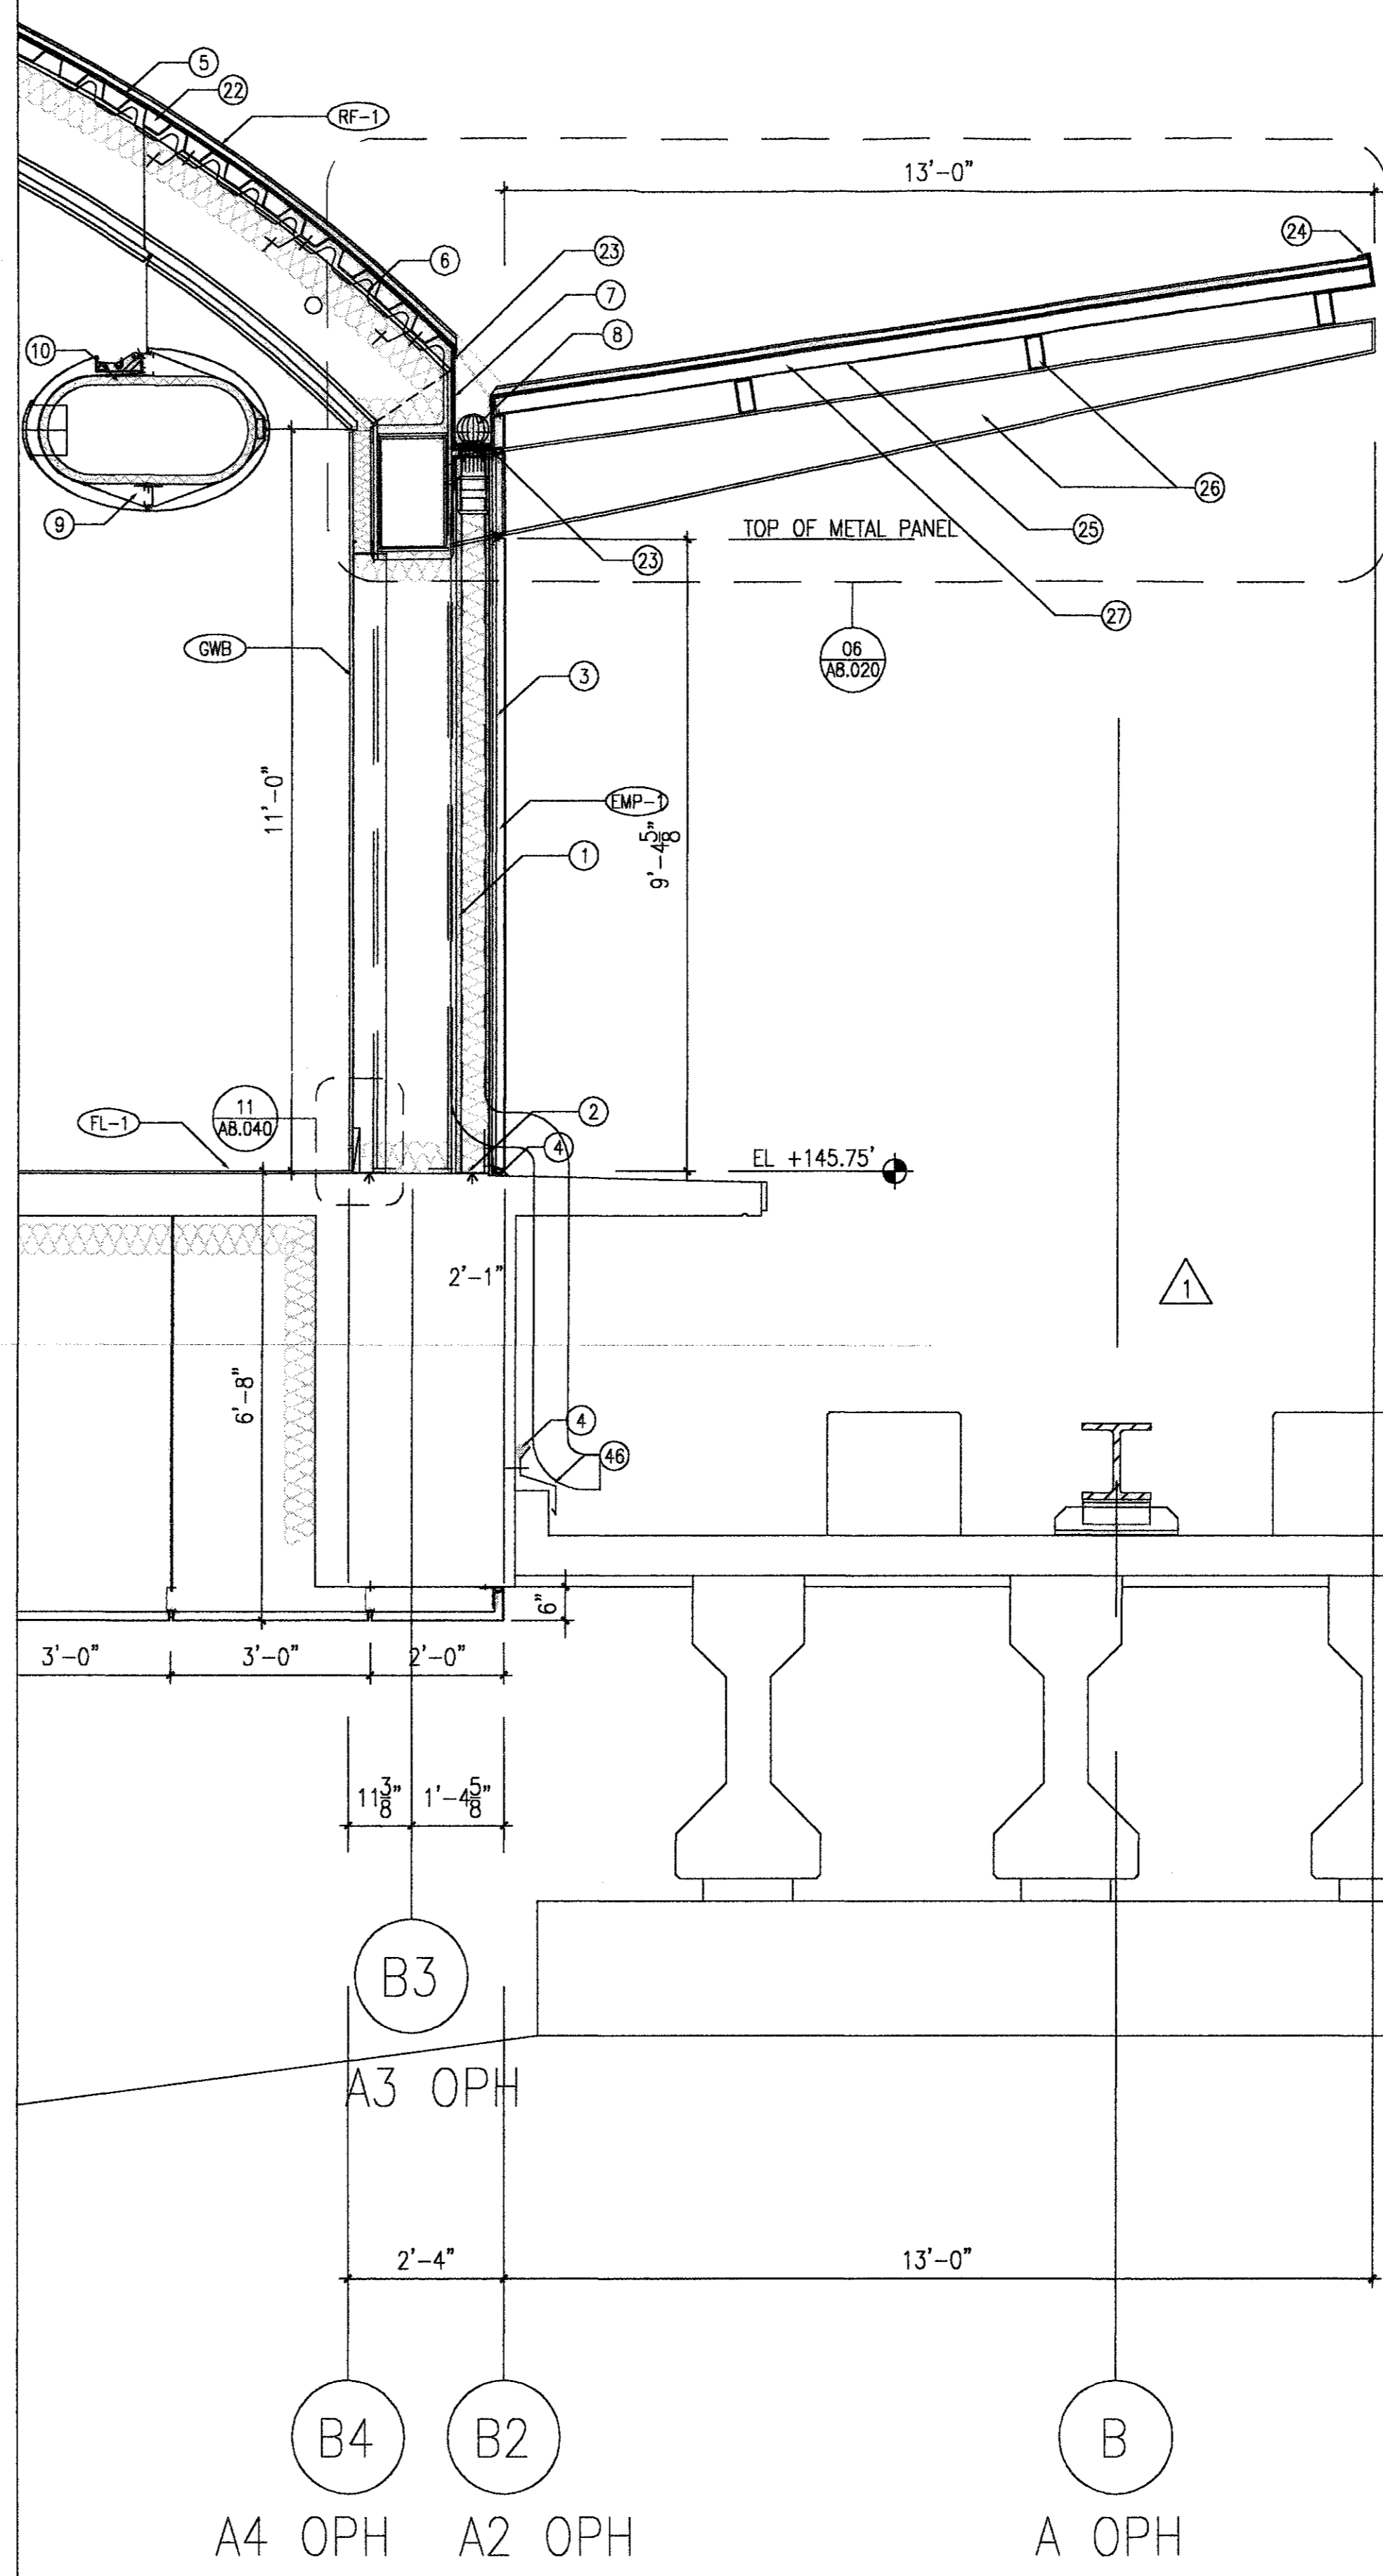



**WALL SECTION 02 @ MECHANICAL ROOM**  
 A3.220 1/2"=1'-0"

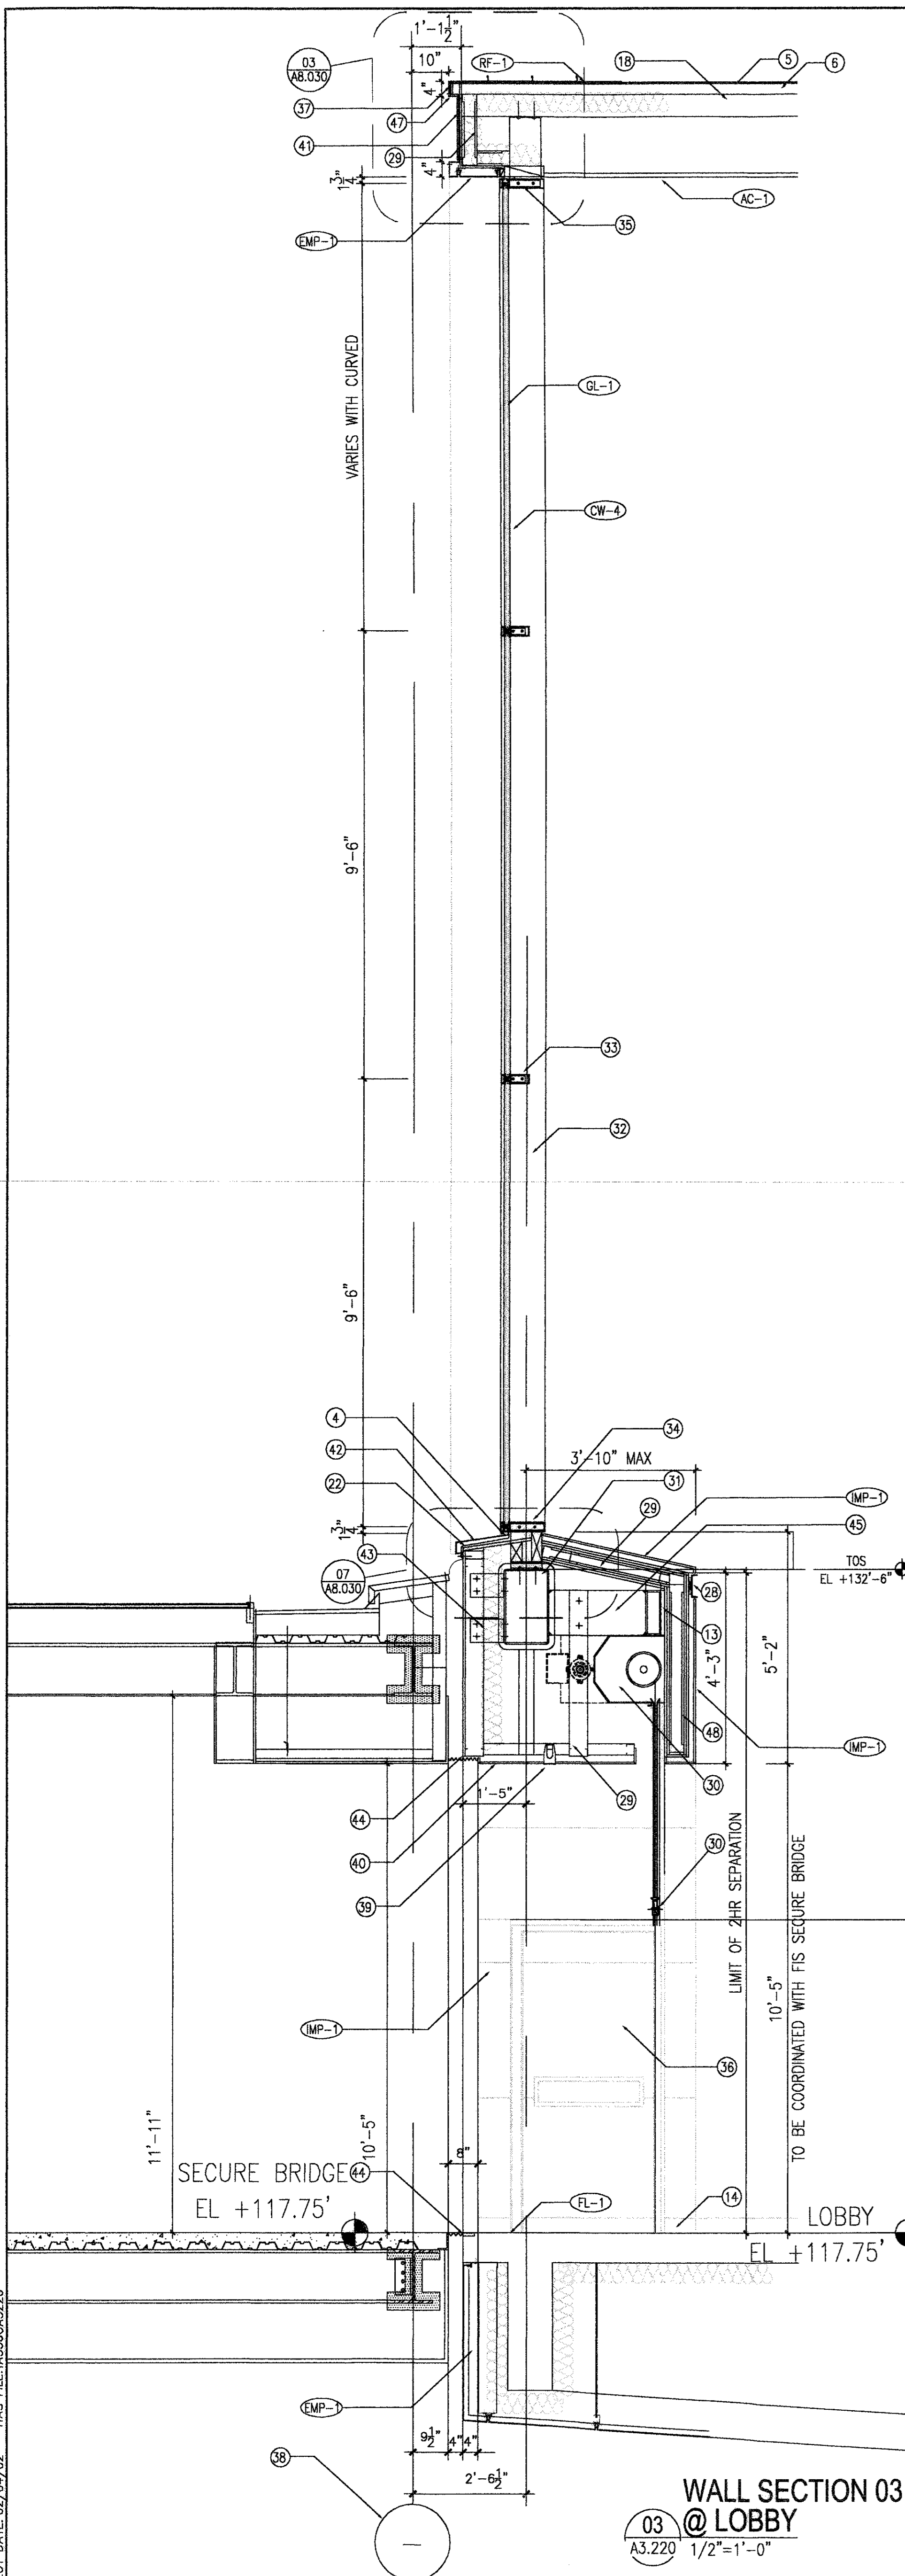

**WALL SECTION 03 @ LOBBY**  
 A3.220 1/2"=1'-0"

PLOT DATE: 02/04/02 HAS FILE: A3386A3320



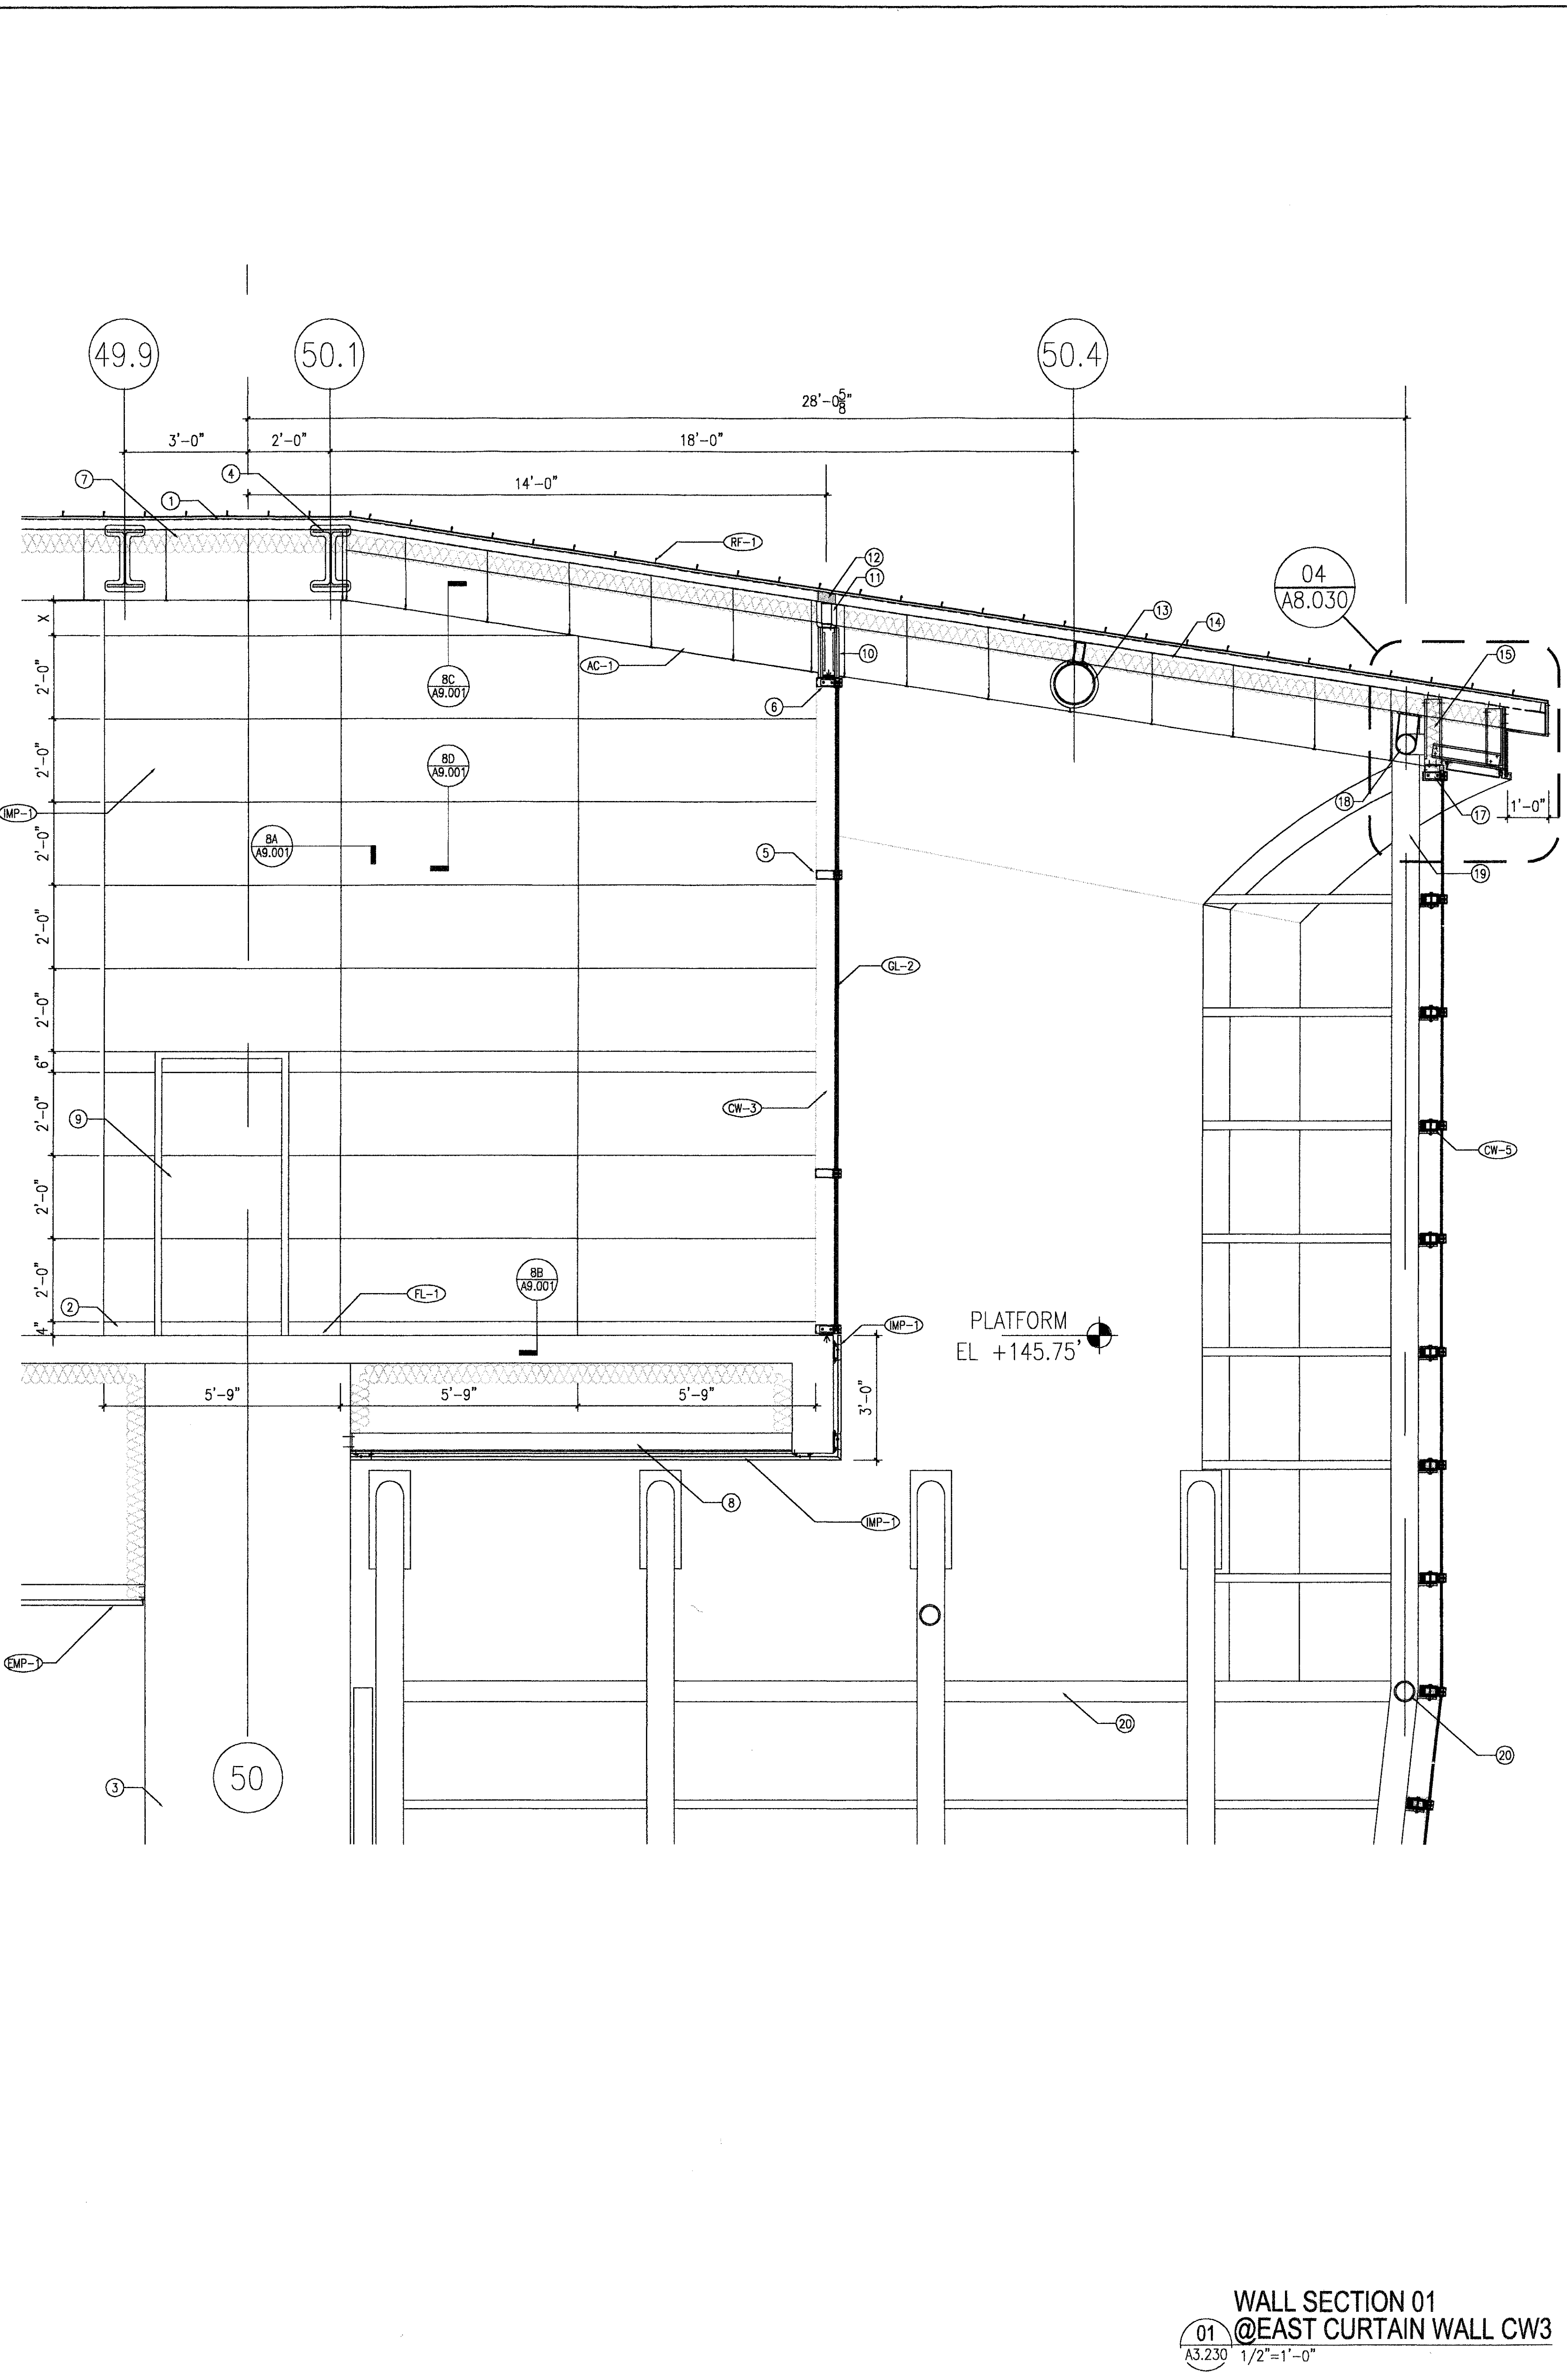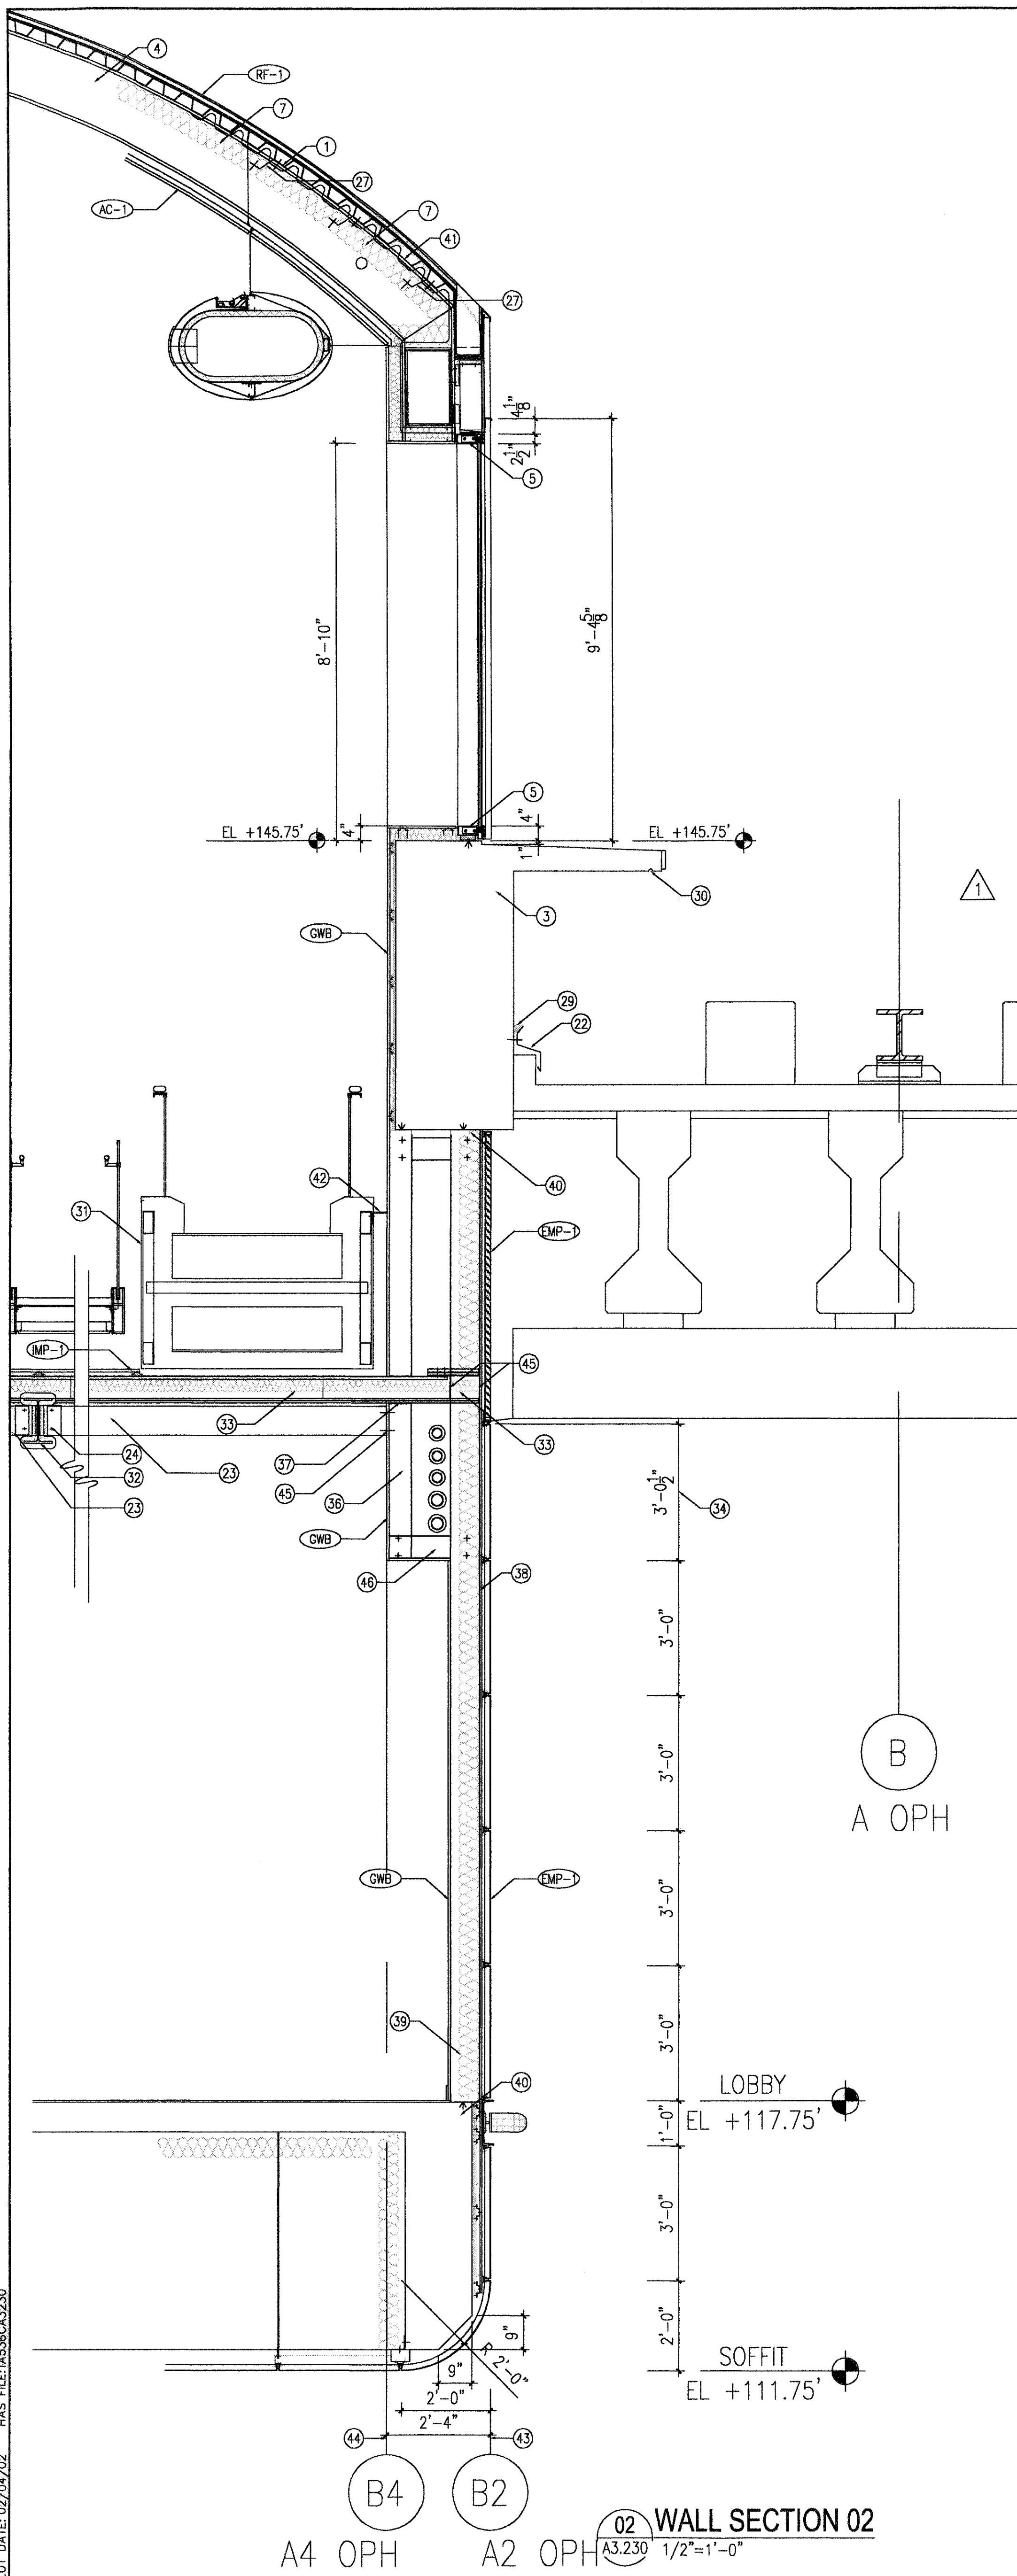

**GENERAL NOTES:**

- (CW-3) INTEGRATED STRUCTURAL CURTAINWALL SYSTEM TYPE 3 - RE WINDOW SCHEDULE SHEET A2.850
  - (CW-5) INTEGRATED STRUCTURAL CURTAINWALL SYSTEM TYPE 5 - RE WINDOW SCHEDULE SHEET A2.850
  - (GL-2) 1" INSULATED GLAZING
  - (EMP-1) EXTERIOR POWDERCOATED WALL METAL PANELS - ALUMINUM PANEL 1/8" THICK - TYPE SERIES 3000 MODIFIED FROM UNA-CLAD - COPPER SALES OR EQUAL - POWDERCOATED KYNAR 500
  - (EMP-2) POWDERCOATED ALUMINUM LOUVERS - WITH INSECT MESH WHEN USED BY MECHANICAL - CLOSED WITH 1/8" THK ALUMINUM SHEET WELDED CONTINUOUSLY TO FRAME WHEN NOT USED BY MECHANICAL - RE MECHANICAL FOR OPENINGS
  - (RF-1) STANDING SEAM METAL ROOF - TYPE UC3 FROM UNA-CLAD - COPPER SALES OR EQUAL - POWDERCOATED KYNAR 500; COLOR #2 SILVER METALLIC
  - (CWB) PAINT 5/8" HI-IMPACT GYPSUM BOARD ON METAL STUDS
  - (AC-1) PRE-FINISHED CURVED, PERFORATED METAL CEILING PANEL - TYPE ALUMA VAULT SYSTEM 1000 BY GORDON MANUFACTURER - WITH BLACK NON WOVEN ACOUSTICAL MAT
  - (FL-1) TERRAZZO FLOOR
  - (MP-1) INTERIOR STAINLESS STEEL WALL PANELS MULTI DIRECTIONAL MACHINE POLISH
- FOR CLARITY, STAIR #2 NOT REPRESENTED IN SECTION 01

**KEYED NOTES:**

- 1 3" METAL DECK + 1HR FIREPROOFING
- 2 SSSL BASE - ALIGN WITH SSSL PANELS FINISH FACE
- 3 CONCRETE BEAM
- 4 STEEL BEAM + 1HR FIREPROOFING - RE STRUCTURAL
- 5 2 1/2"x7 1/2" HORIZONTAL MULLION
- 6 2 1/2"x7 1/2" CURVED MULLION - SAME CURVE AS CEILING
- 7 BATT INSULATION ON Z CLIPS
- 8 METAL STUD CONSTRUCTION - SUPPORT OF SSSL PANELS
- 9 SCHEDULED DOOR - SSSL FINISH BOTH SIDE - SSSL FRAME
- 10 2 HR GYPSUM PARTITION TYPE 2 UL# U411
- 11 3"x6" STEEL TUBES WELD BETWEEN LONGITUDINAL BEAMS @ TOP OF CURTAIN WALL CW-3 2 HR SPRAY APPLIED FIREPROOFING
- 12 FIRESTOP ASSEMBLY UL HW-D-0045
- 13 12" DIAM. CURVED PIPE WITH 3 HR FIREPROOFING - RE STRUCTURAL
- 14 6" STEEL TUBES WITH 3HR FIREPROOFING- RE STRUCTURAL
- 15 6" STUDS SECURE TO DECK AND TO 1/4" GUSSETS WELDED TO 6" TUBE
- 16 GALVANIZED STEEL Z CLIP - 20 GA
- 17 CURVED MULLION
- 18 6" STEEL PIPE WITH 3 HR SPRAY APPLIED FIREPROOFING
- 19 8" STEEL PIPE - PAINT
- 20 6" STEEL HORIZONTAL PIPE - PAINT
- 21 NOT USED
- 22 EXTRUDED ALUMINUM FLASHING - POWDERCOATED
- 23 8" GALVANIZED STEEL STUD 10 GA @ 2' O.C. - SECURED TO W12 BEAM AND TO 8" RUNNER @ WALL - TO SUSPEND CABLE TRAYS AND CONDUITS IN EQUIPMENT ROOM
- 24 GALVANIZED STEEL ANGLE 20 GA TO SECURE 8" STUD TO W12 BEAM
- 25 NOT USED
- 26 SUPPORT OF METAL PANELS TYPE EMP-1
- 27 CURVED METAL PANEL TYPE EMP-1
- 28 3" GALVANIZED STEEL Z CLIP - 20 GA @ 24 O.C. SECURE TO DECK BEFORE FIREPROOFING
- 29 NOT USED
- 30 SEALANT & BACKER ROD
- 31 1" REVEAL DRIP UNDER SIDEWALK SLAB
- 32 SSSL CLAD - MULTI DIRECTIONAL MACHINE POLISH
- 33 W12 BEAM - WITH 3 HR FIREPROOFING
- 34 2 HR PARTITION - TYPE 3 UL # U438 - 6" STUDS 20 GA @ 24 O.C. EXTEND TO EXT. SHEATHING
- 35 PANEL DIMENSION TO BE FIELD VERIFIED ALL METAL PANELS PERFECTLY ALIGNED
- 36 Z CLIP 20 GA @ CONNECTION WITH BEAM
- 37 6" METAL STUD @ 10" O.C. 16 GA.
- 38 6" STEEL RUNNER
- 39 1/2" SHEATHING
- 40 8" METAL STUD JOIST @ 10" O.C. 10 GA.
- 41 8" STEEL RUNNER
- 42 5/8" GYPSUM SHEATHING TYPE X
- 43 SSSL CLAD 16 GA - SIMILAR DETAIL @ OPH SECTION
- 44 COLUMN LINE B2: EXT. METAL PANELS FINISH FACE - A2 @ OPH
- 45 COLUMN LINE B4: INT. FINISH FACE - A4 @ OPH
- 46 J TRACK - 20 GA - 3" LEG. SECURE TO 8" STUDS
- 47 CHASE AROUND PIPES IN EQUIPMENT ROOM

**RECORD DRAWINGS**  
DO NOT MODIFY  
Ray de la Raza Architects, Inc.  
13 May 2005

Note: Information used to develop these documents was taken from Record of the Work Drawings prepared by the construction contractor, Clark Construction Group - Texas. The information provided by the contractor was not verified by the design firm named above.

NOTE: REFER TO GRAPHIC SCALE IF ACTUAL SHEET SIZE IS OTHER THAN 30"x42".  
SCALE: 1/4" = 1'-0"

**WALL SECTION 01**  
**@ EAST CURTAIN WALL CW3**  
A3.230 1/2"=1'-0"

**Houston Airport System**  
GEORGE BUSH  
INTERCONTINENTAL AIRPORT  
HOUSTON TEXAS

**Ray de la Raza Architects, Inc.**  
1099 W. RANDOLPH MILL RD.  
HOUSTON, TX 77061  
Tel: 817.261.1446  
Tel: 817.881.3288

**REVISIONS**

NO.	DESCRIPTION	DATE	BY
1	ISSUED FOR BID	10/19/01	
2	REVISION #1	01/27/03	SG
3	RECORD SET	05/13/05	EM

INTERNATIONAL • SERVICES • EXPANSION • PROGRAM • WALL SECTIONS

**ARM STATION + PLATFORM**

PROJECT MGR: HEM  
DESIGNER: SG  
DRAWN BY: SEM  
CHECKED BY: AB  
DRAWING STANDARD: ISEP 07.20.2000  
SCALE: 1/2"=1'0"  
DATE: 09/14/01










APPROVED BY: DATE:

PROJECT NO. 1140  
C.I.P. NO. A-038  
H.A.S. NO. 536C  
SHEET NO. 29 A3.230







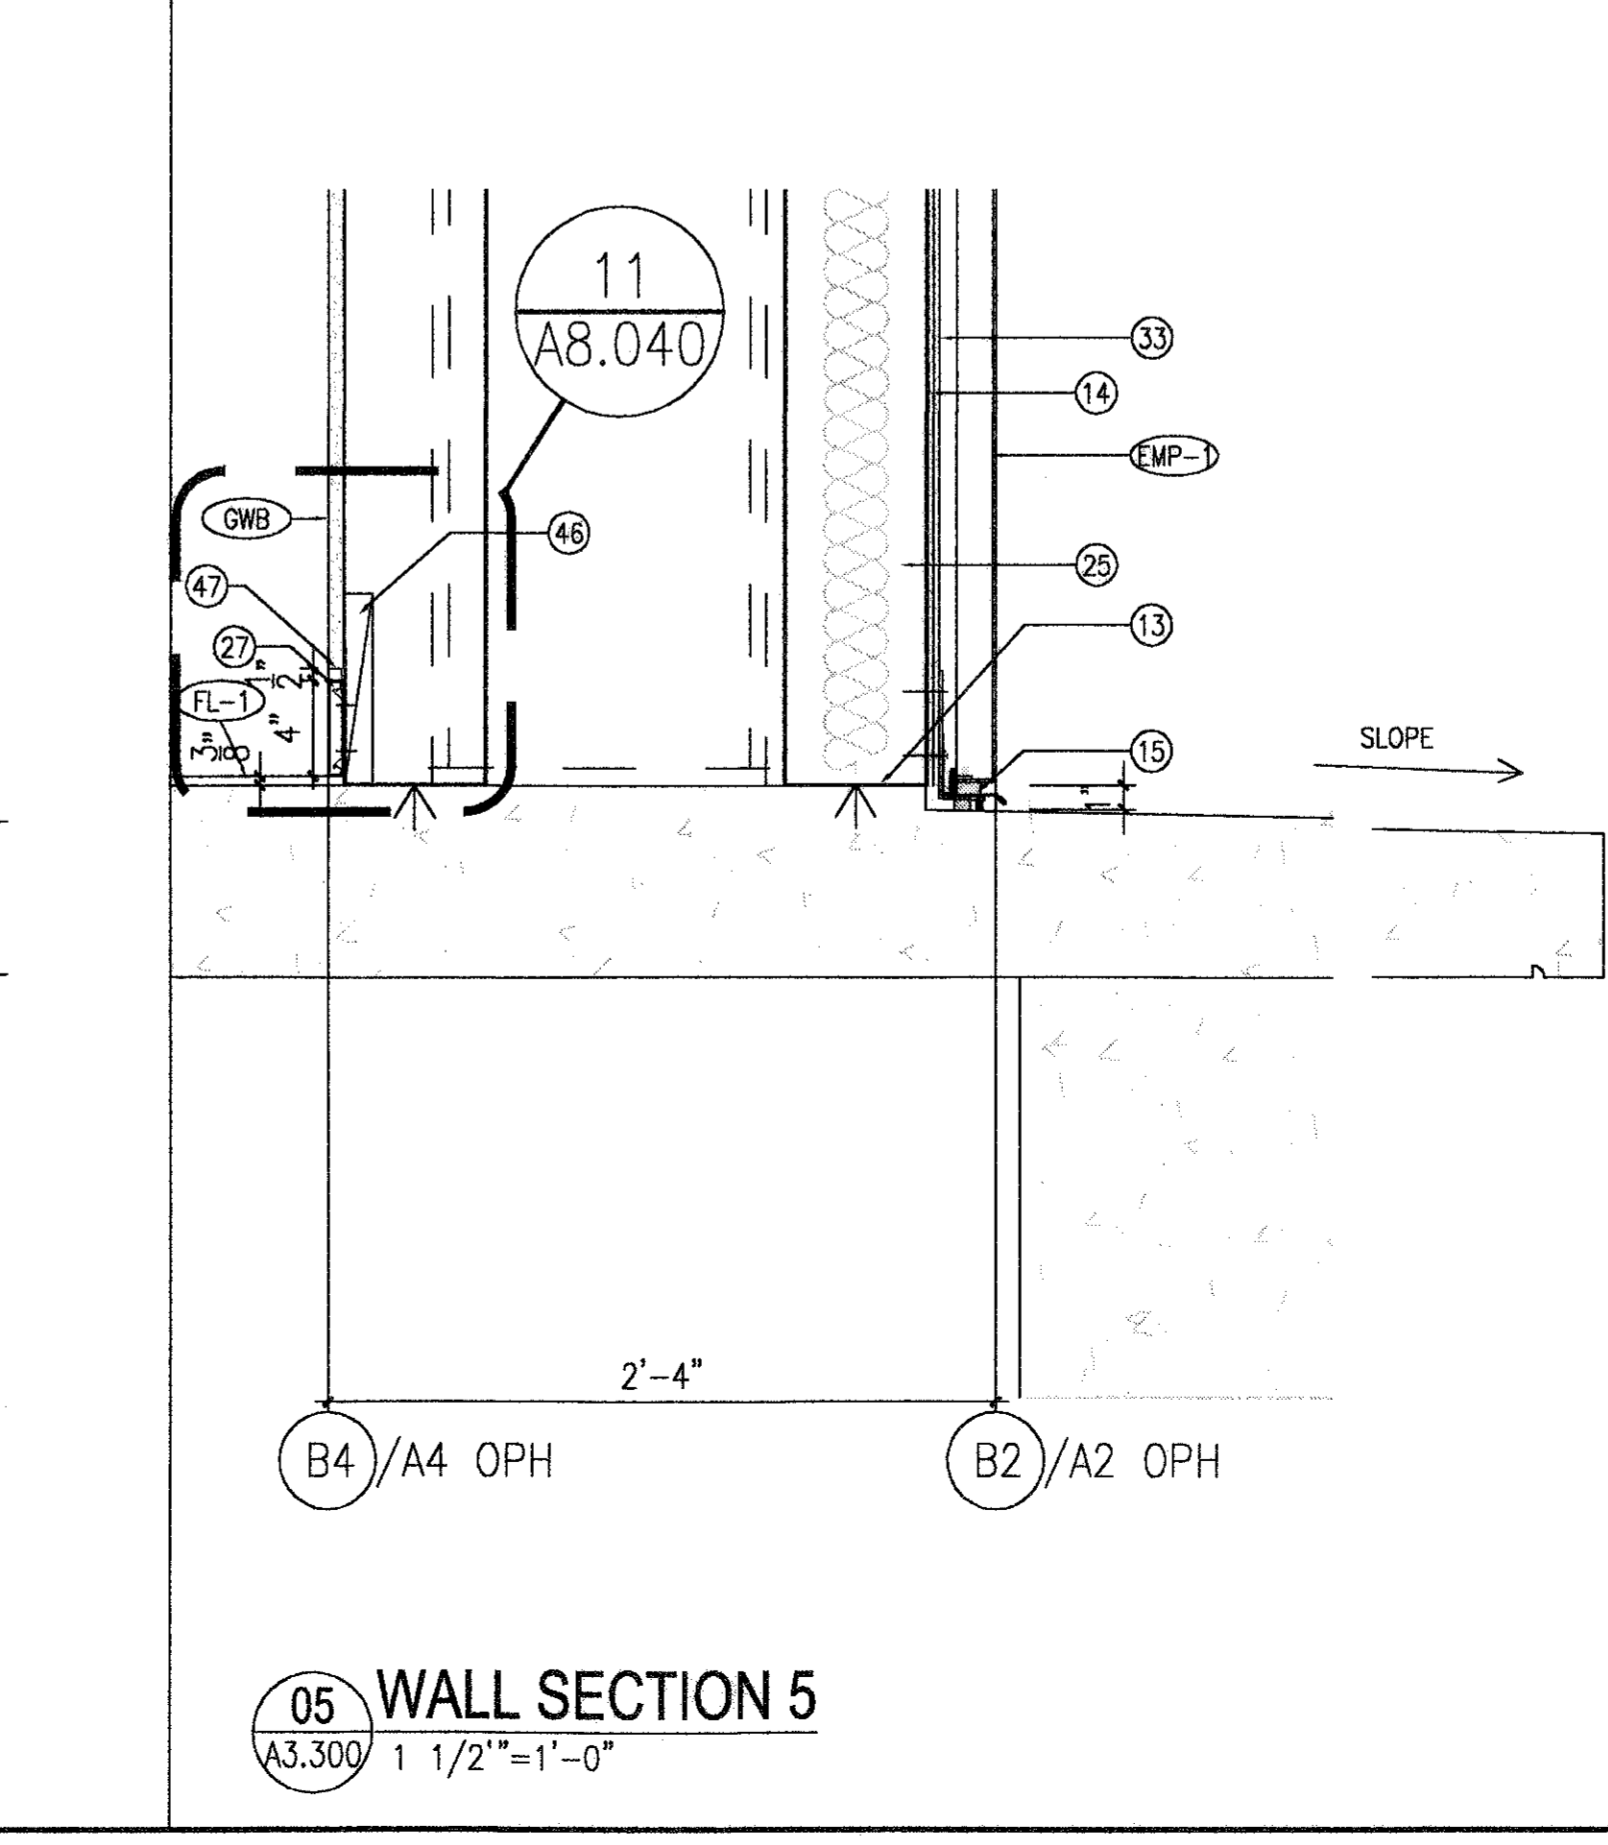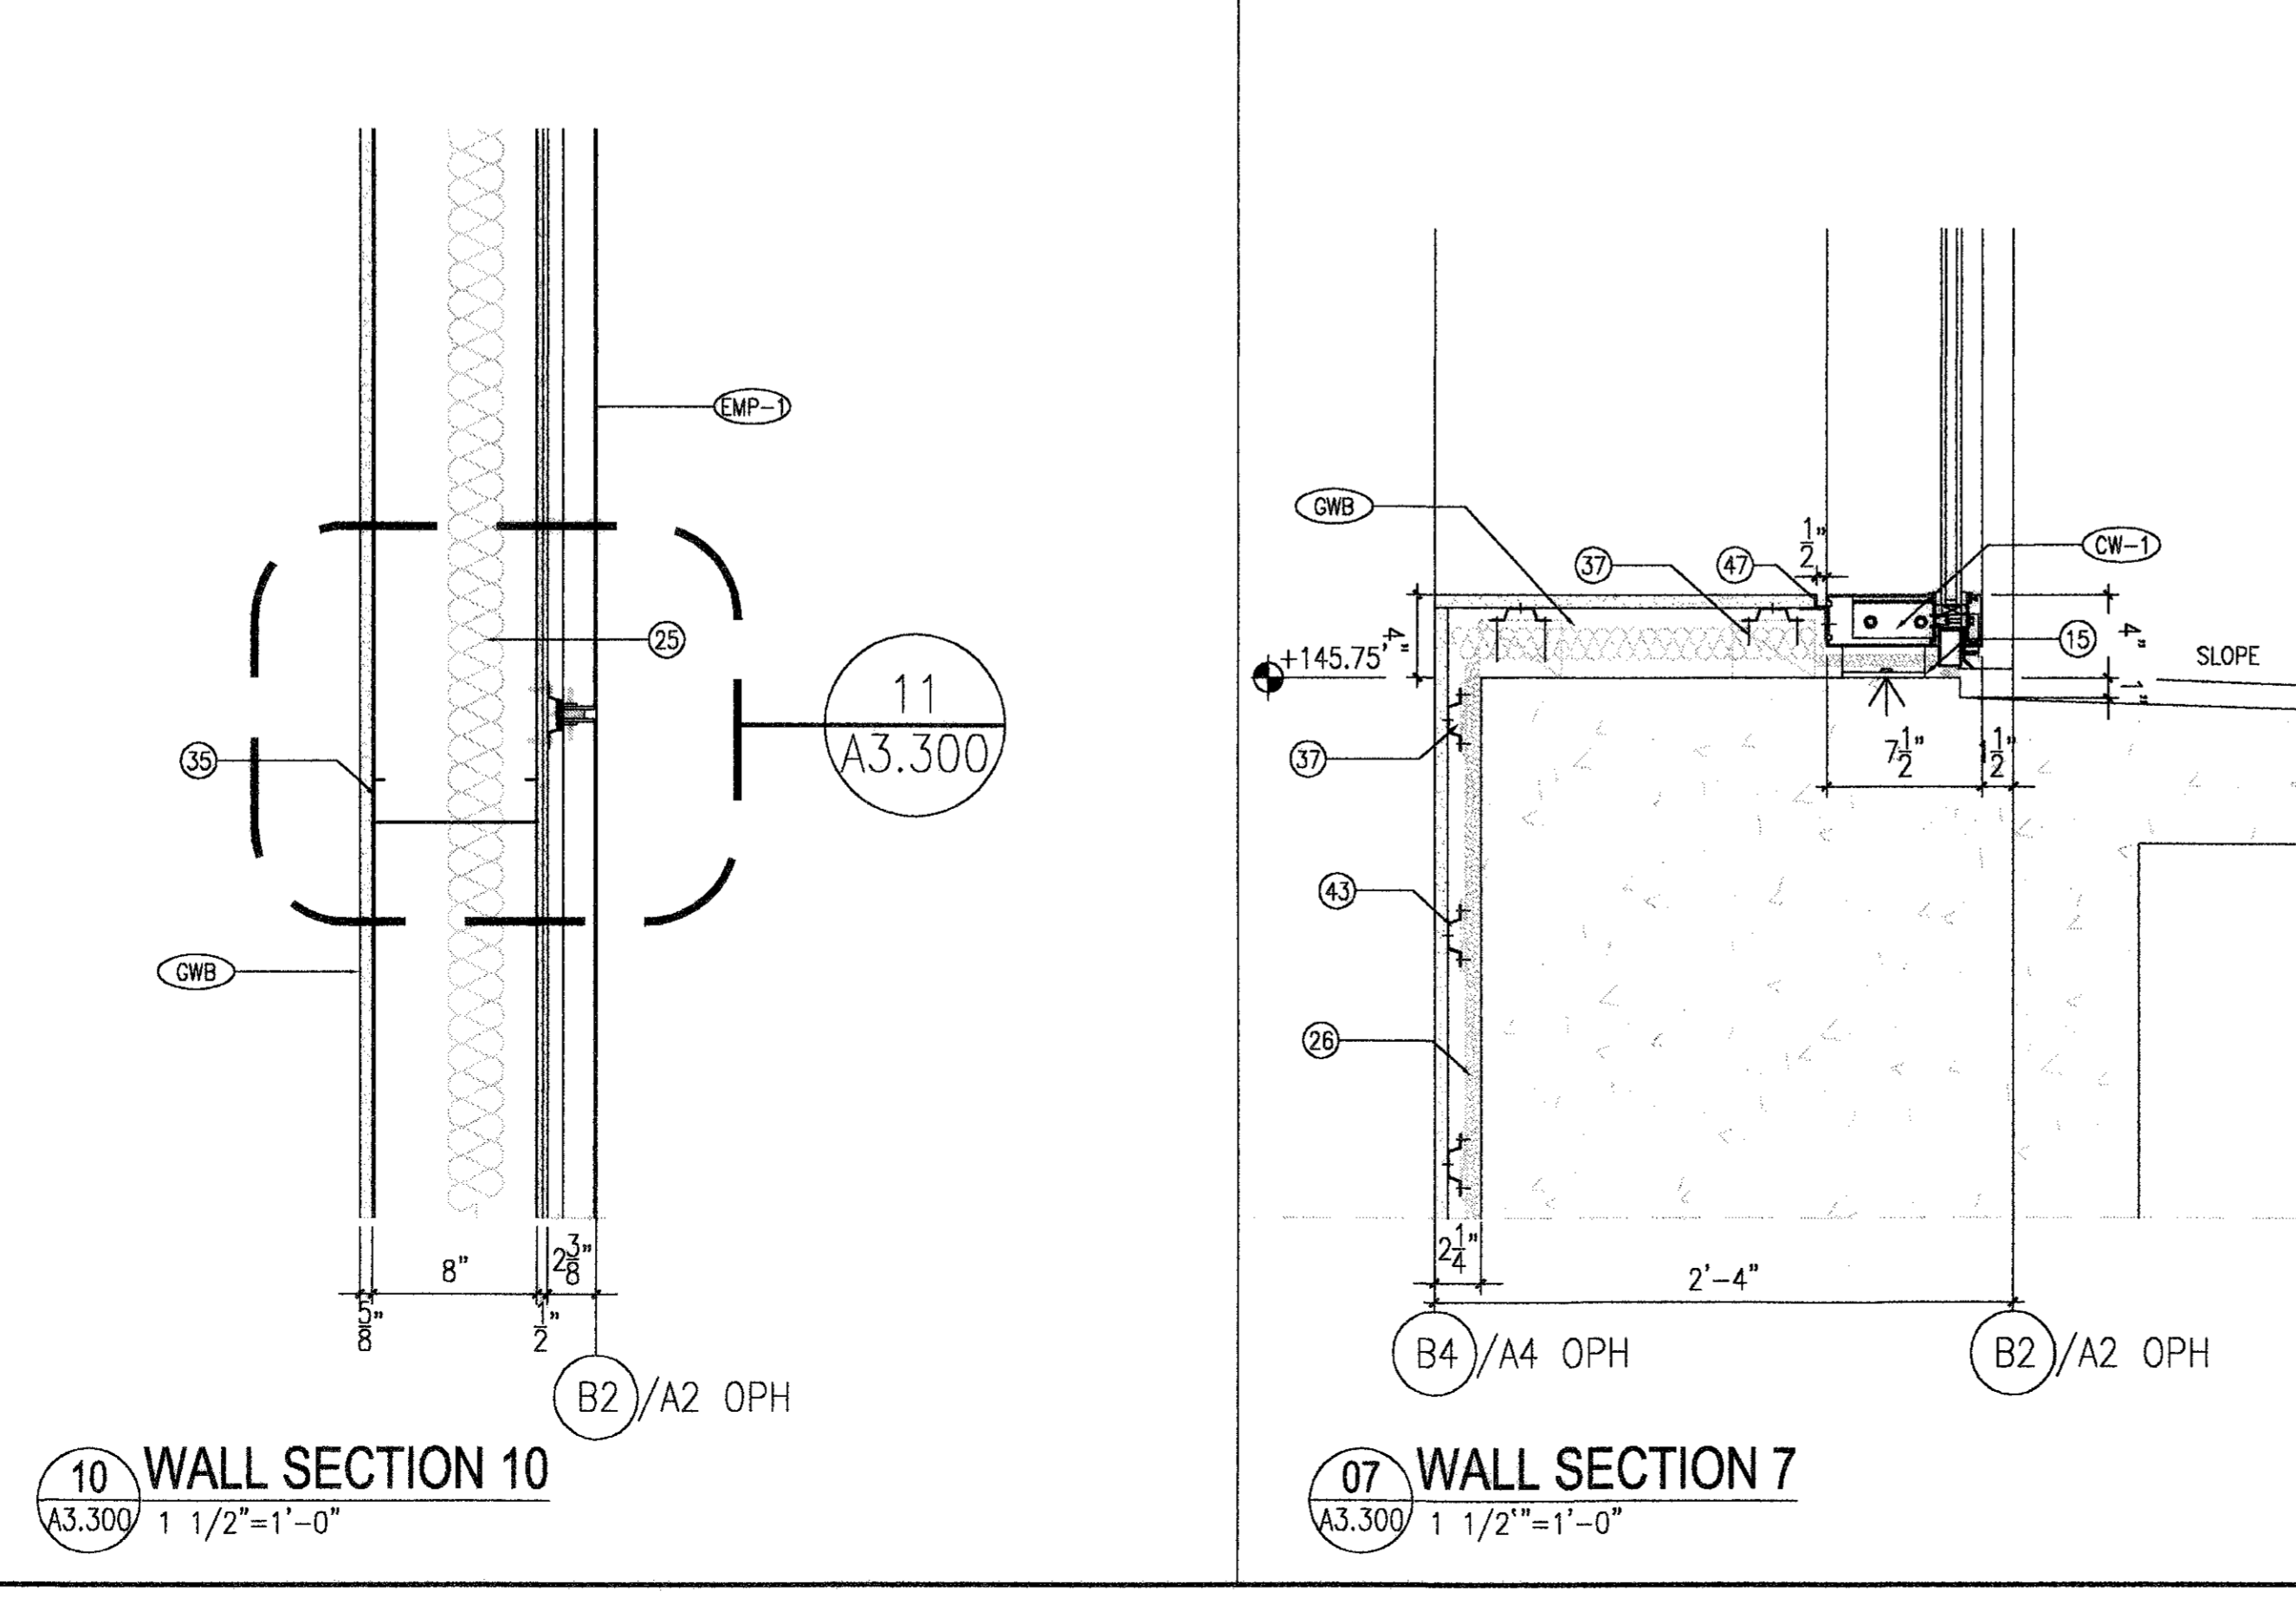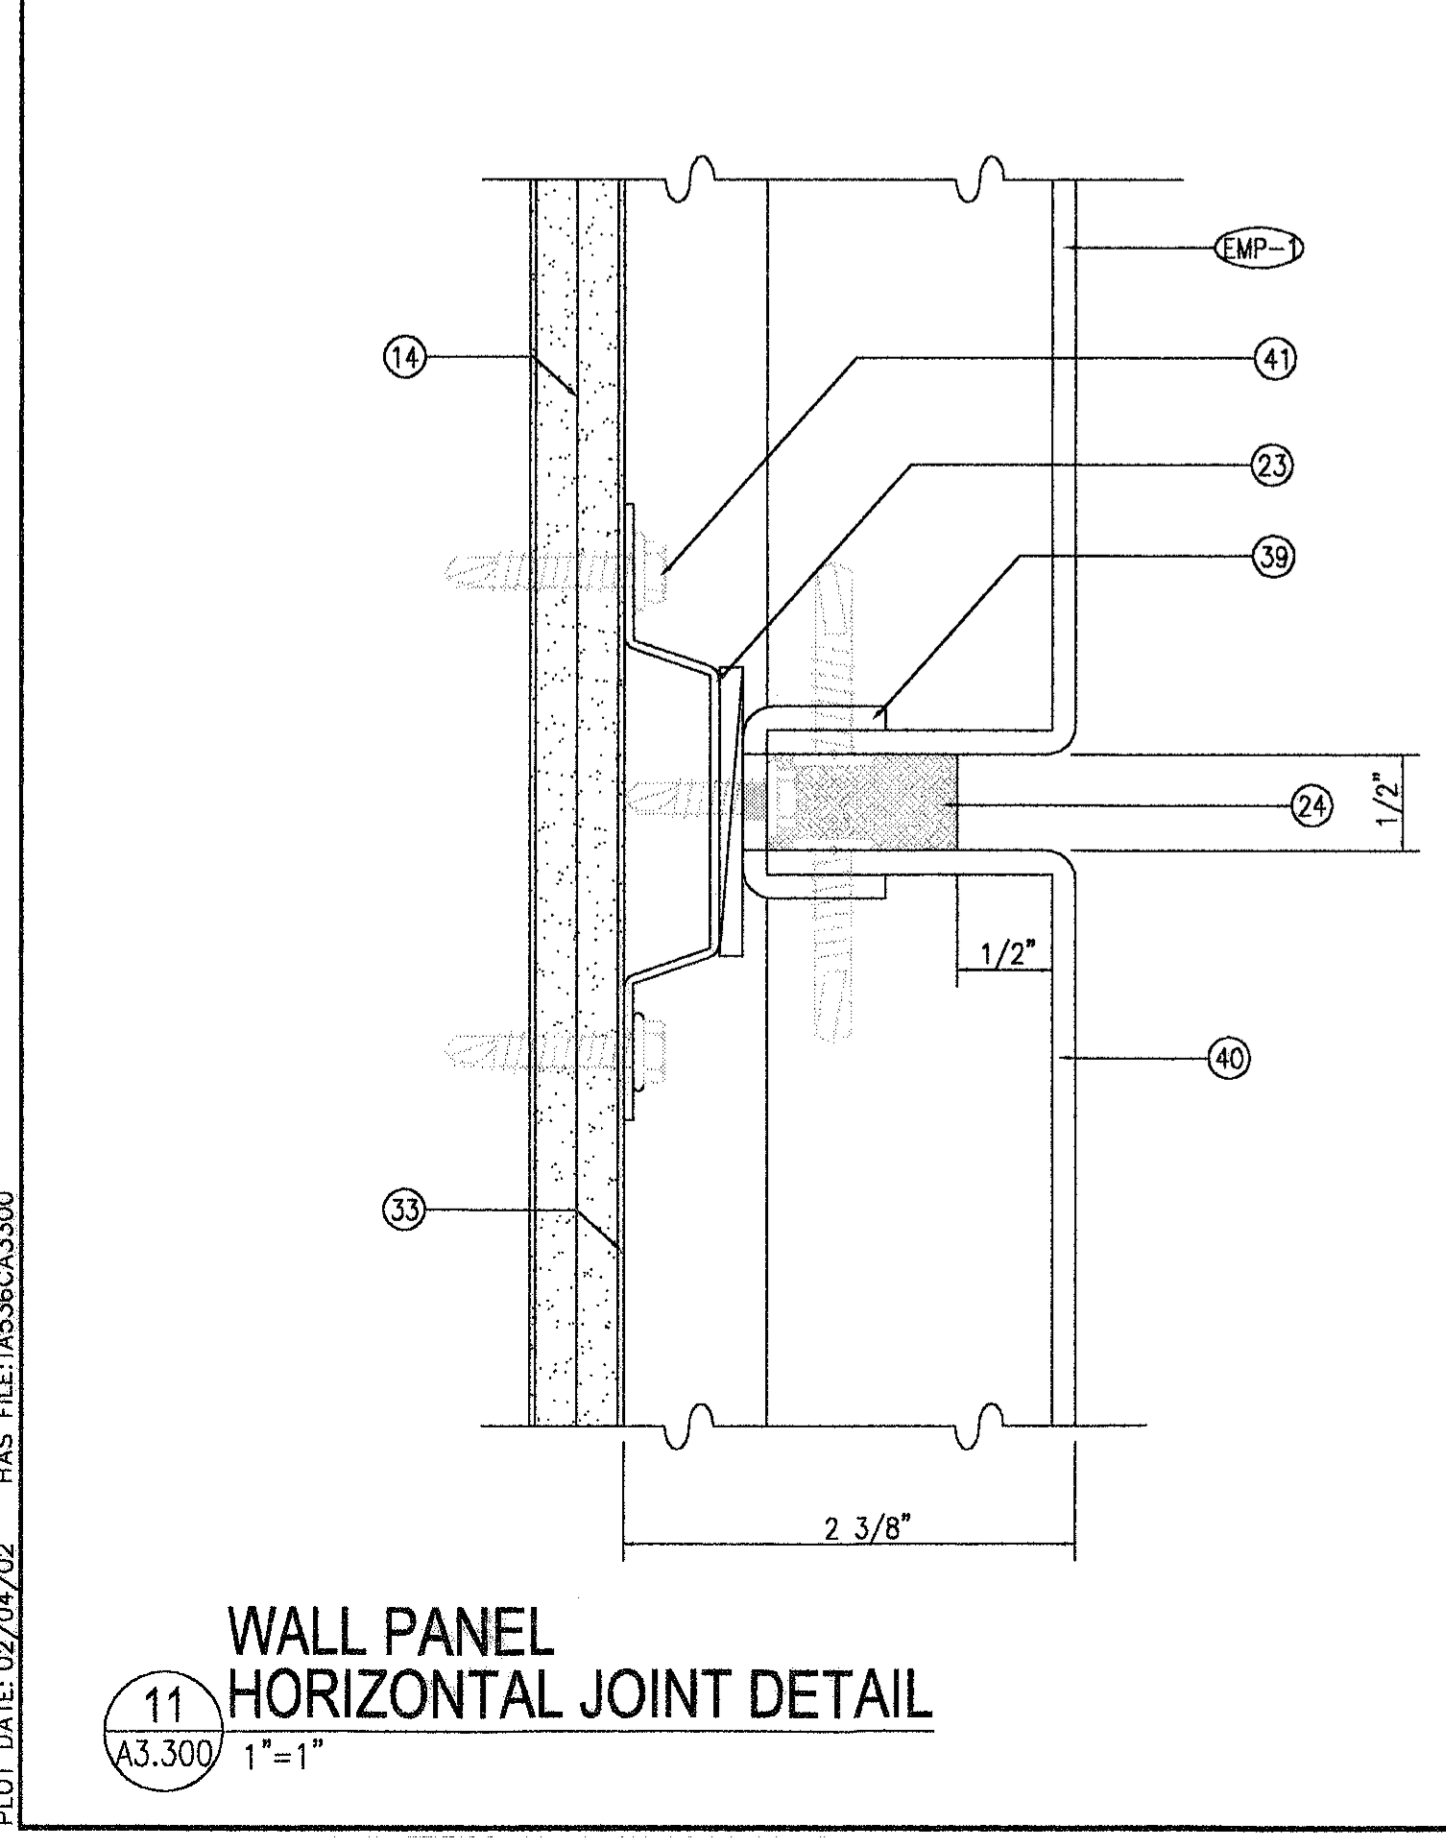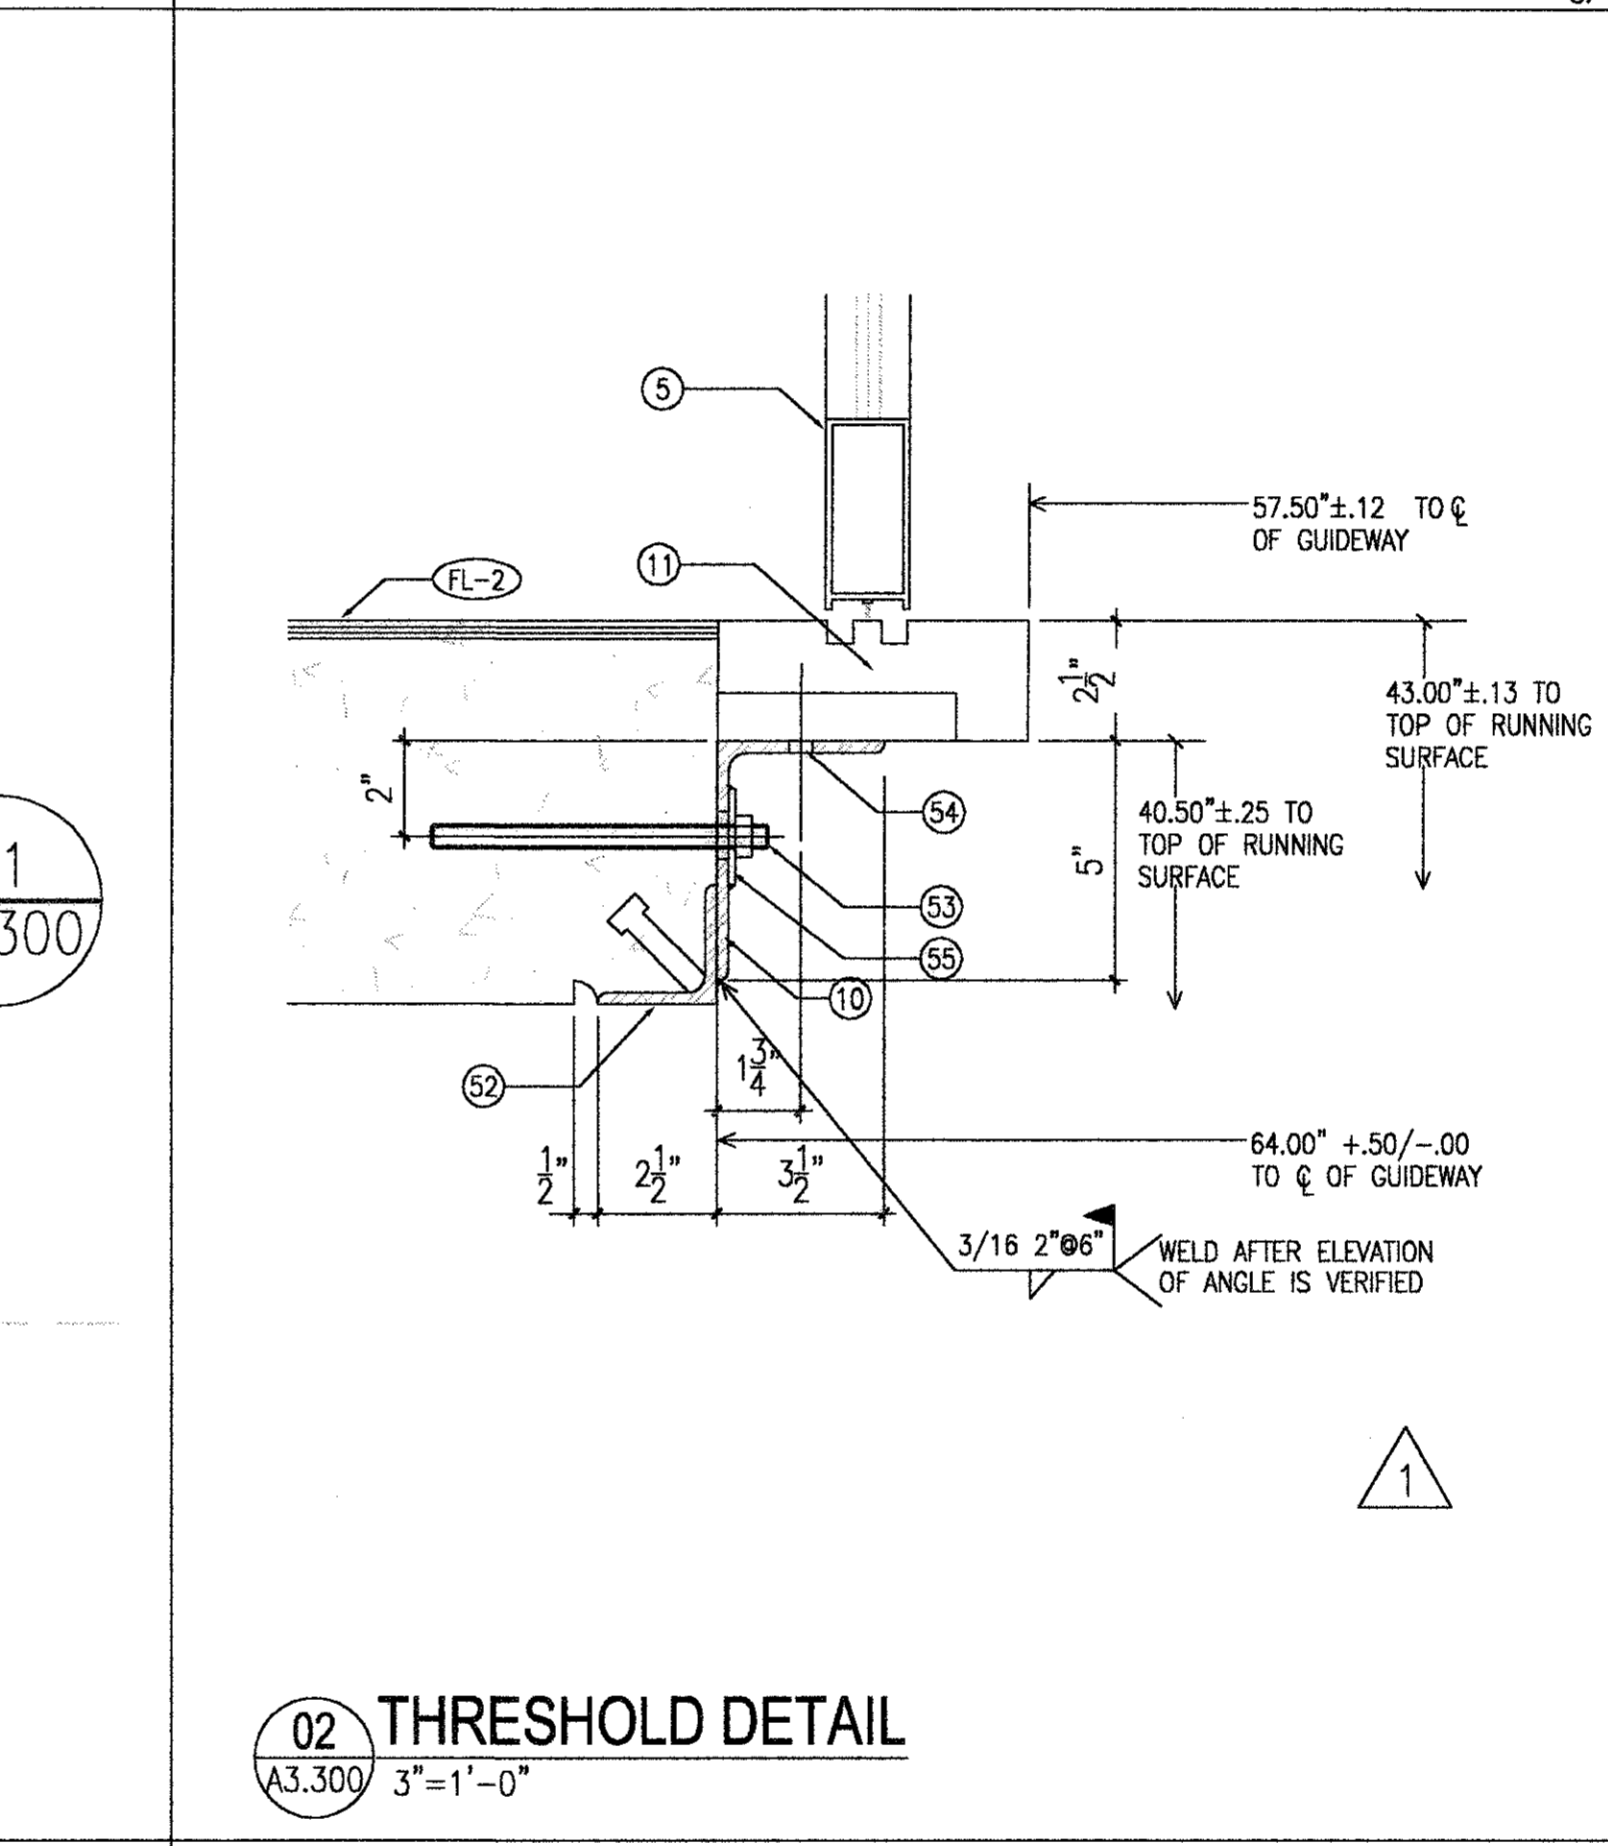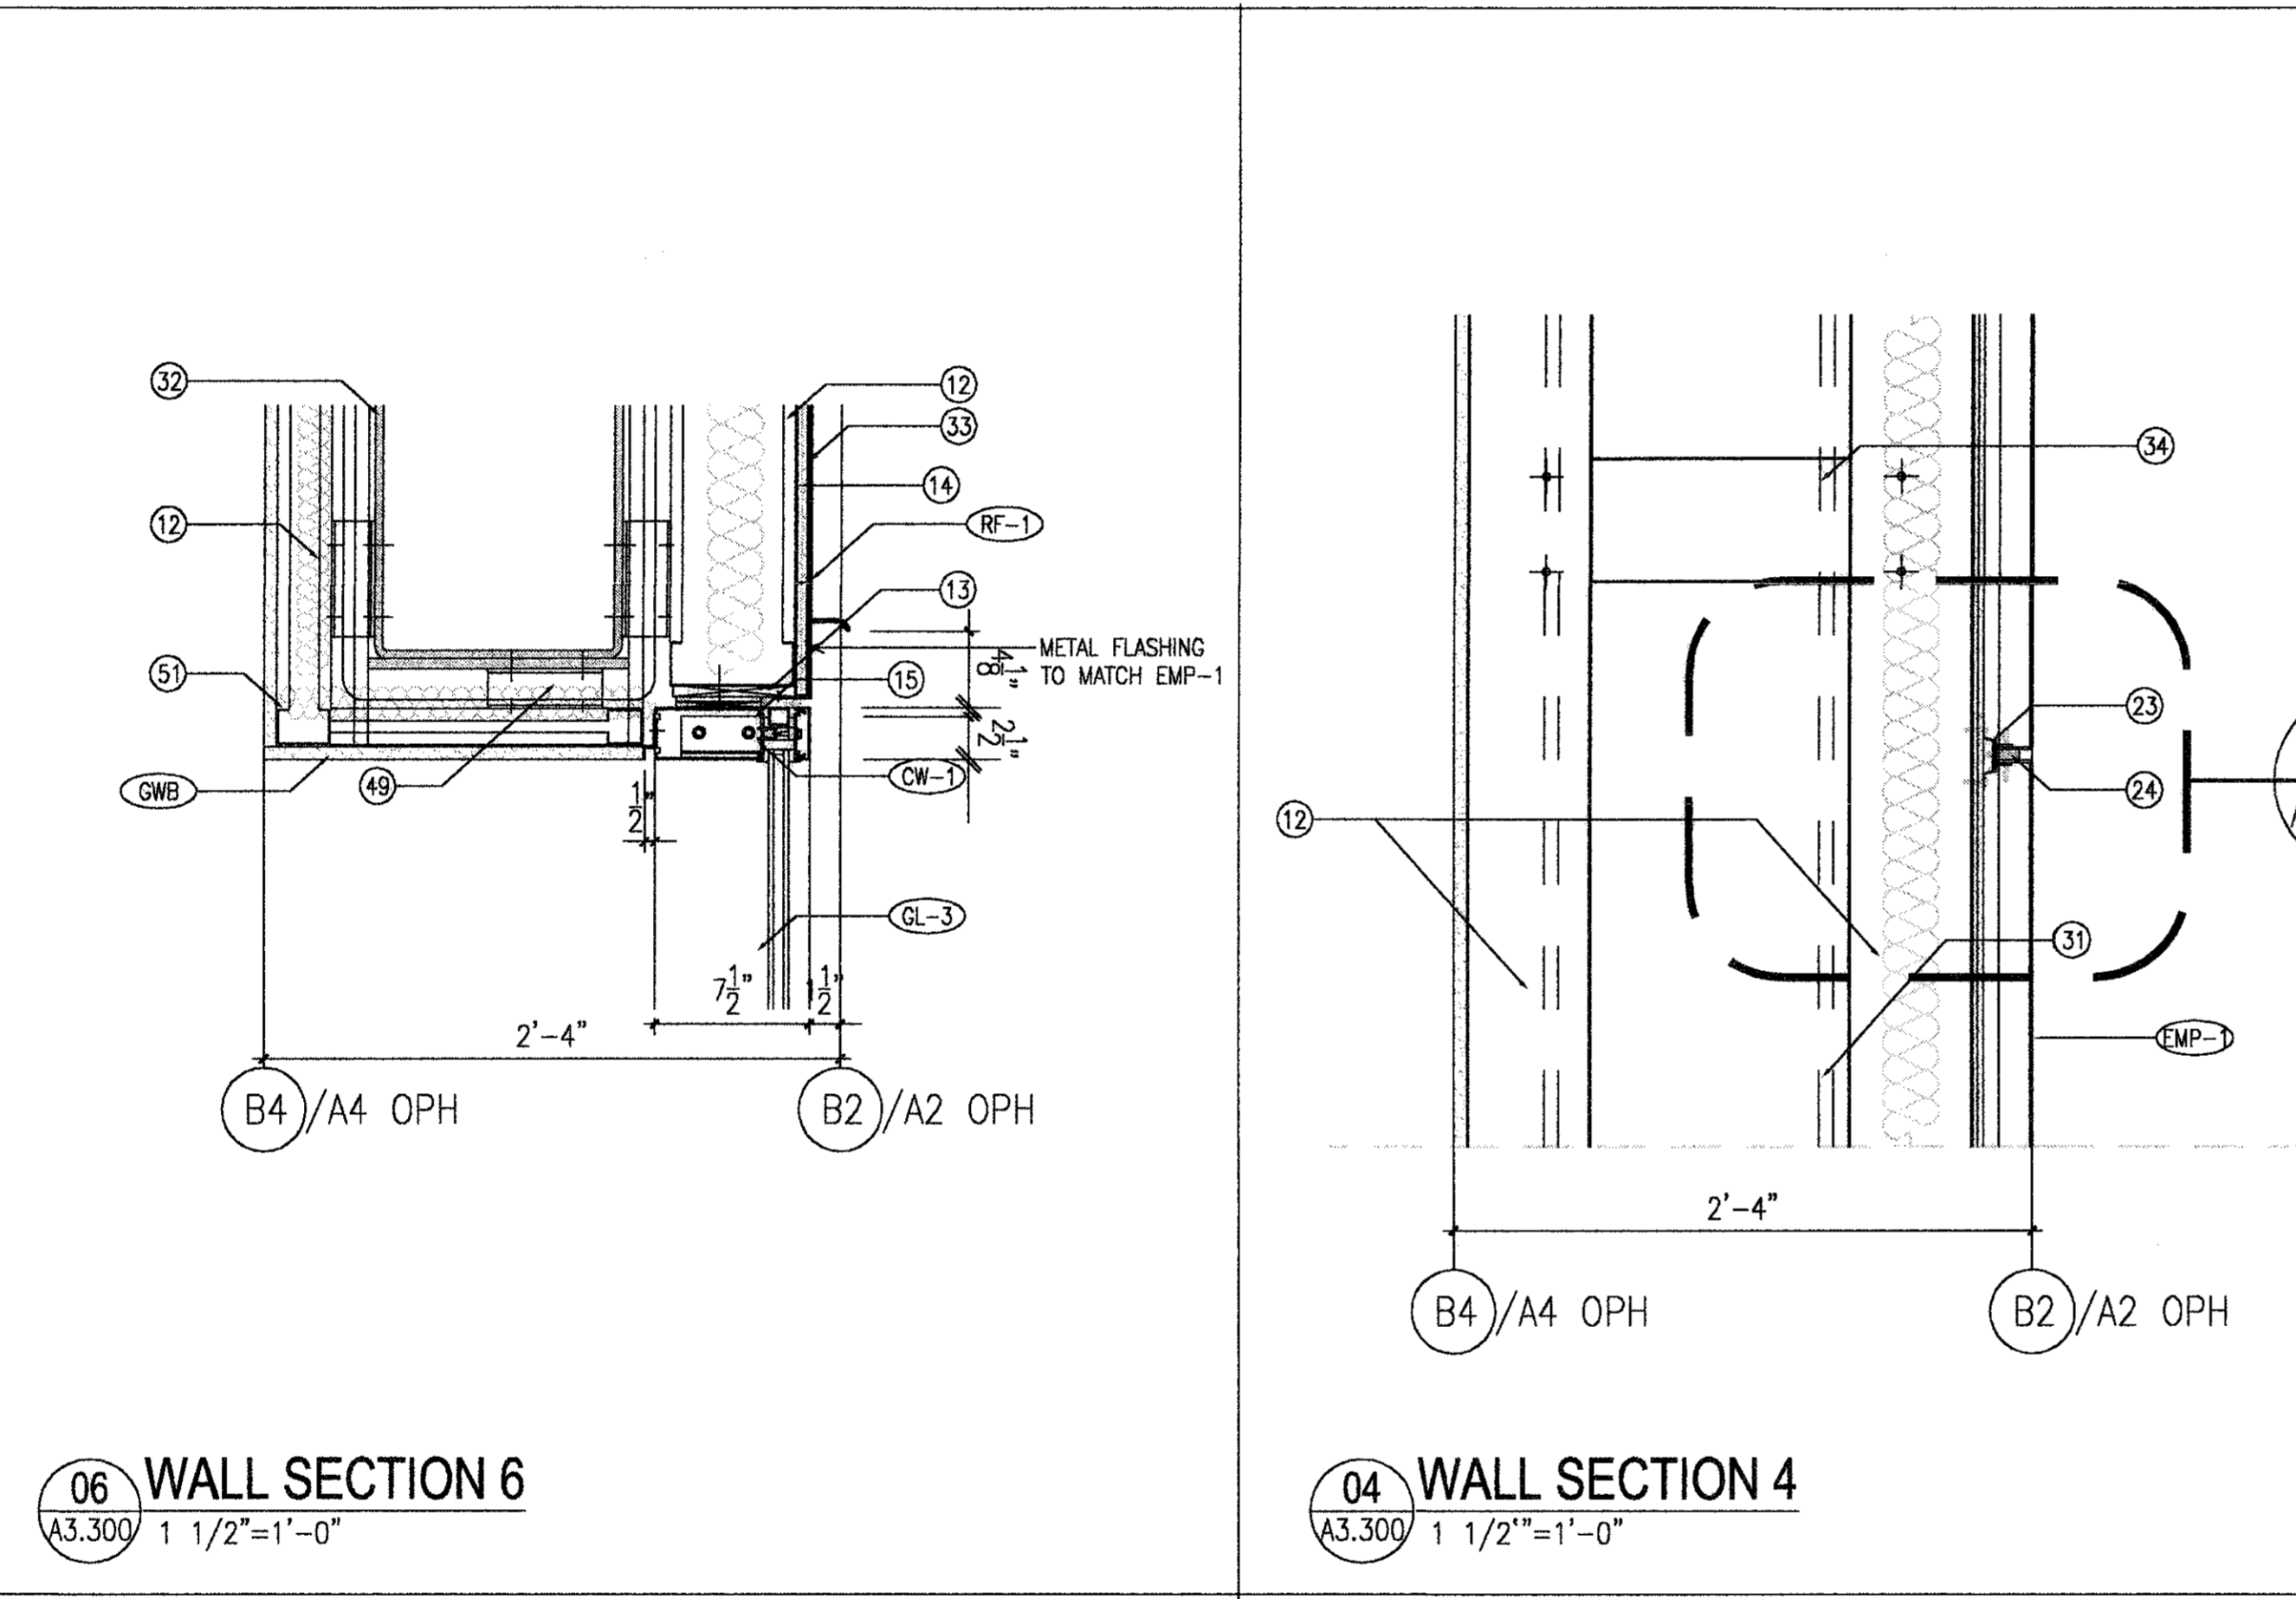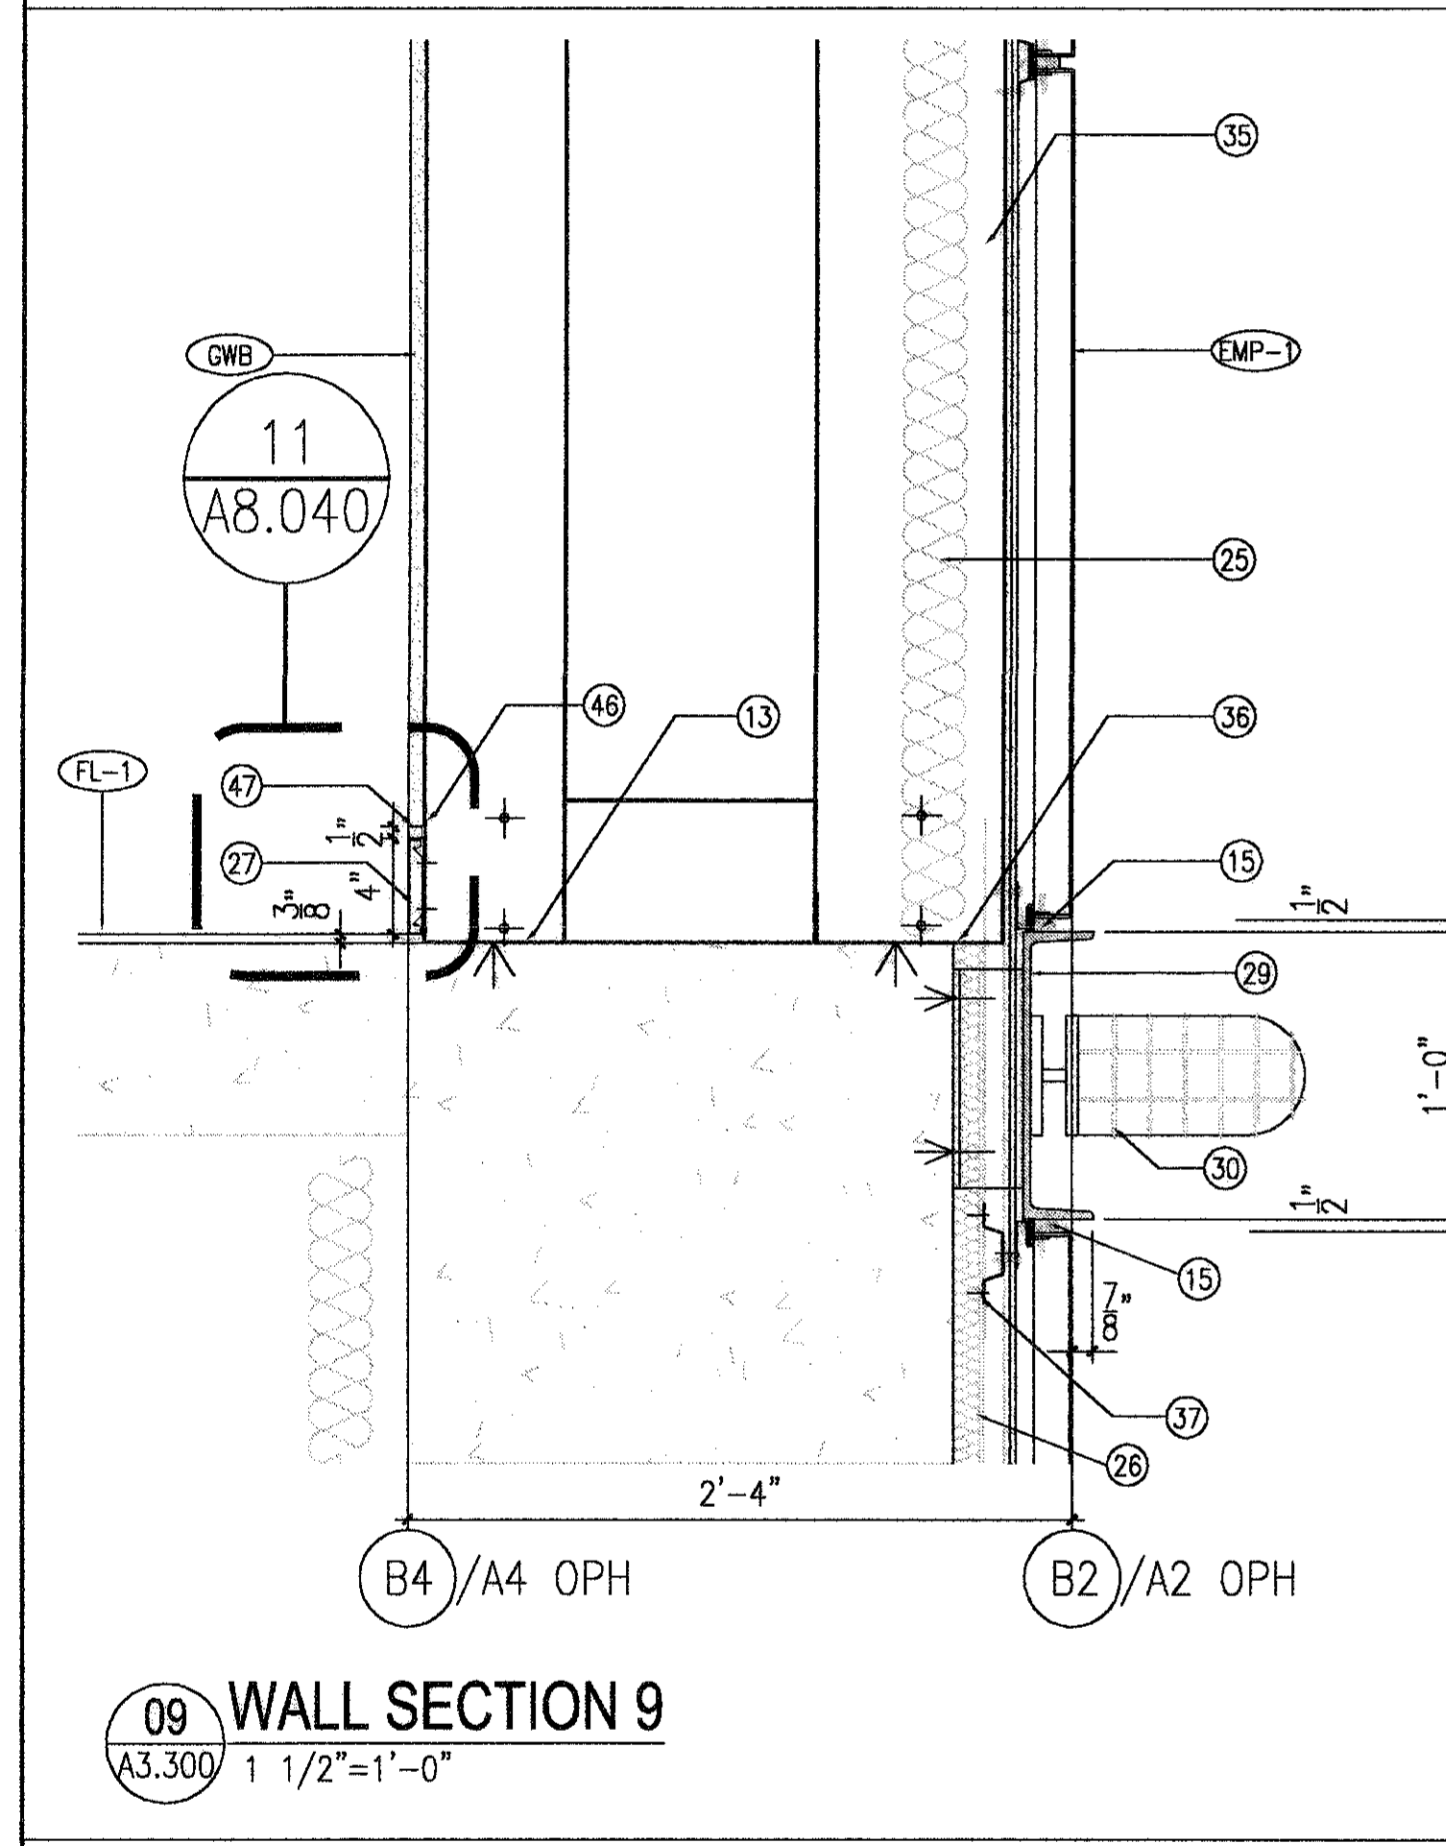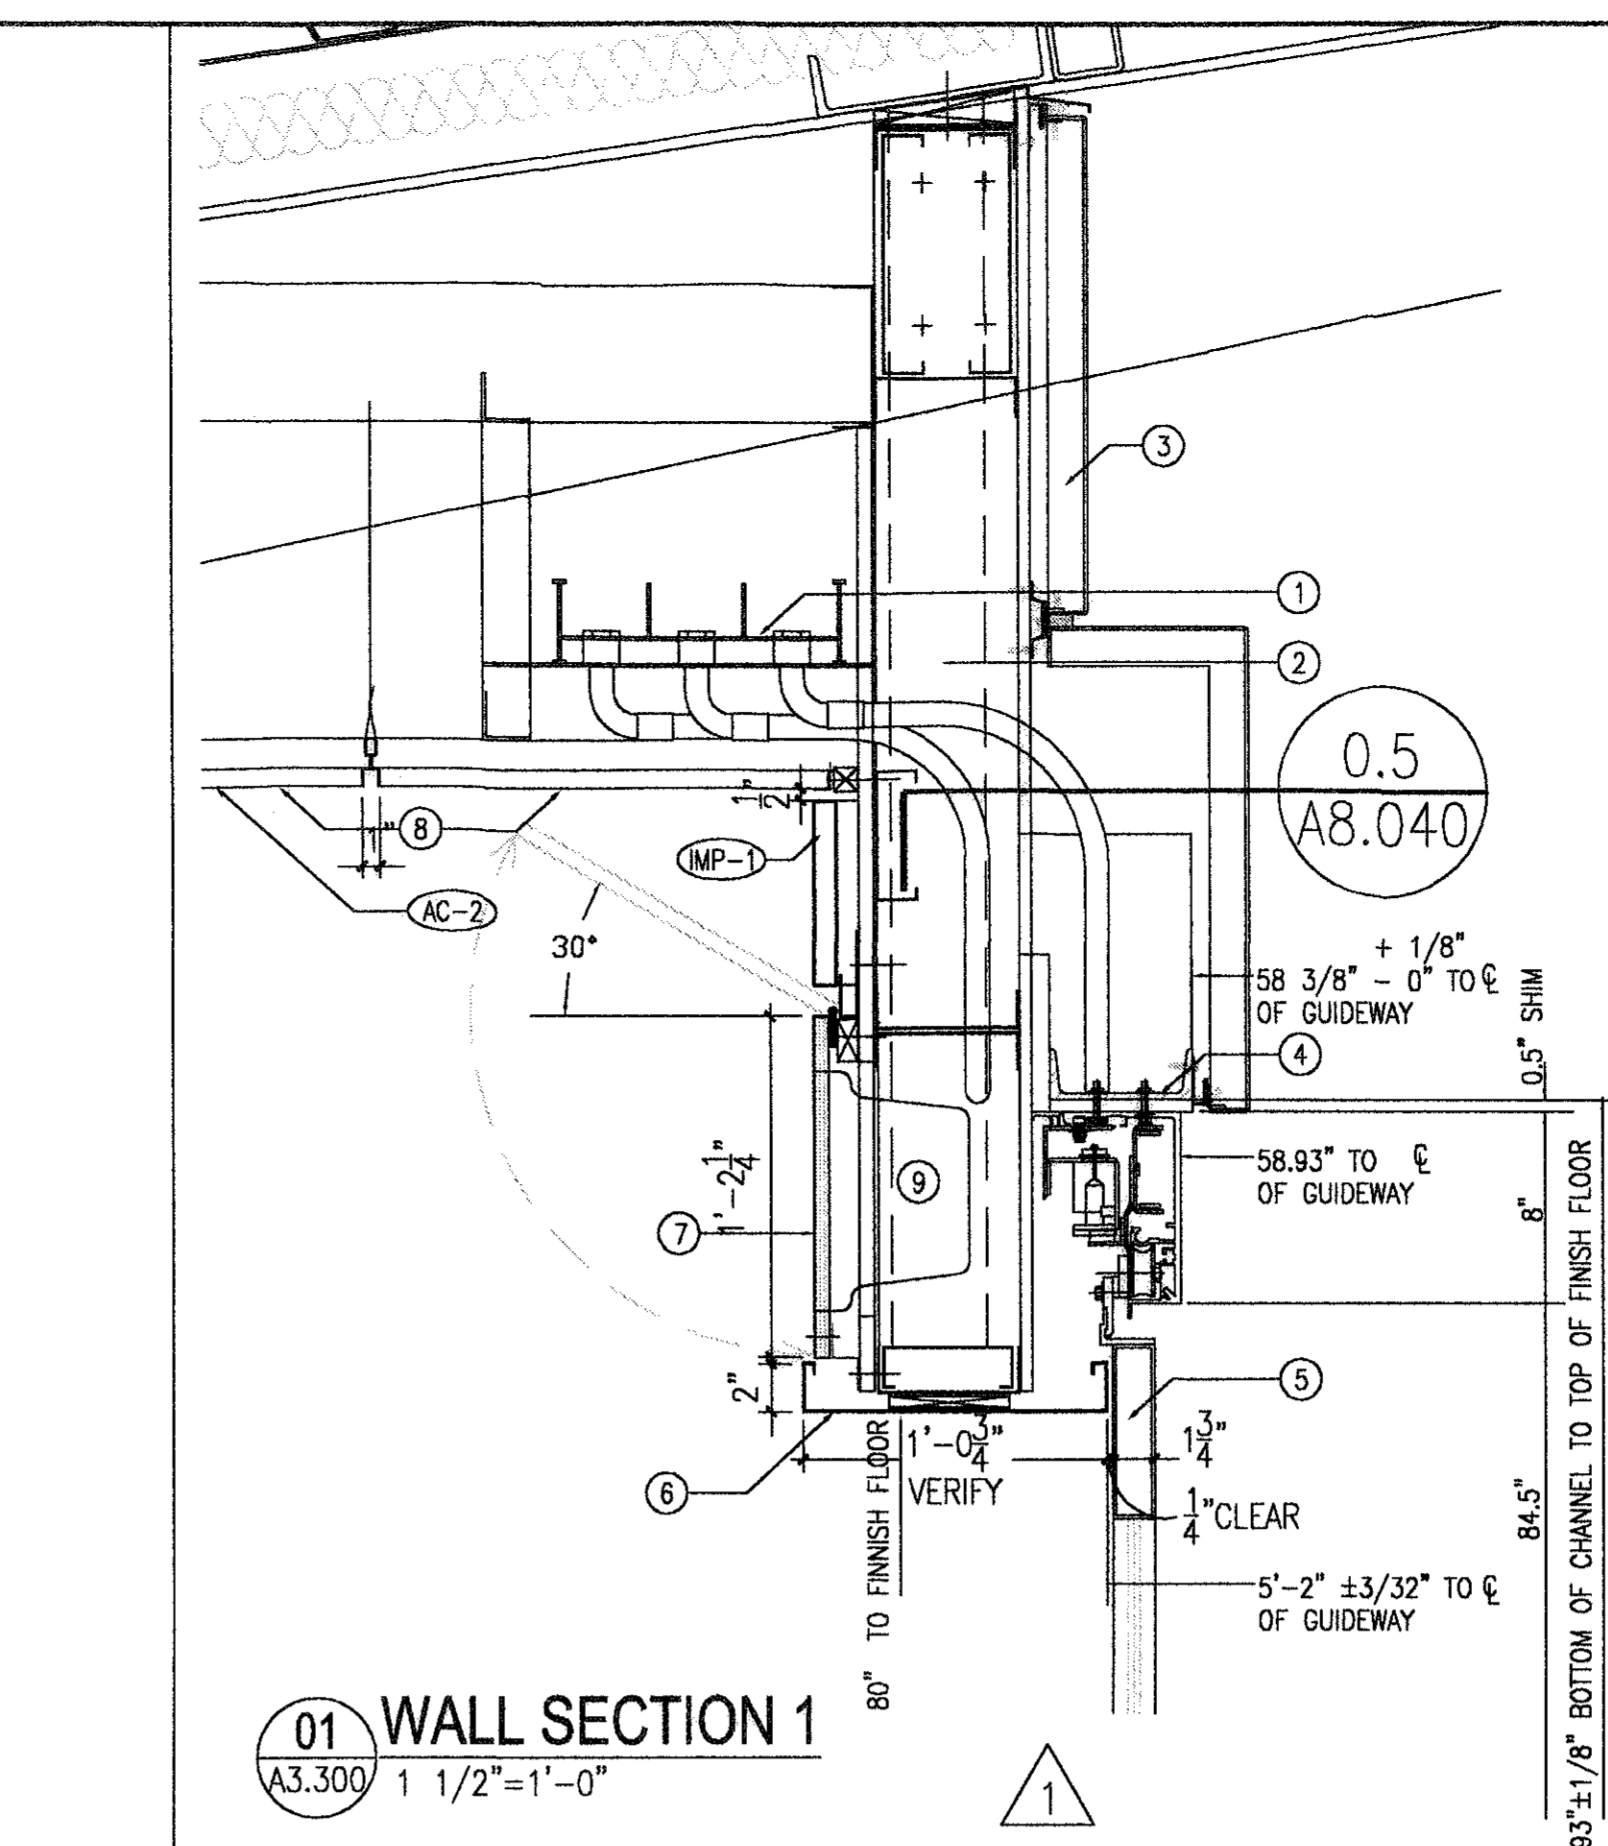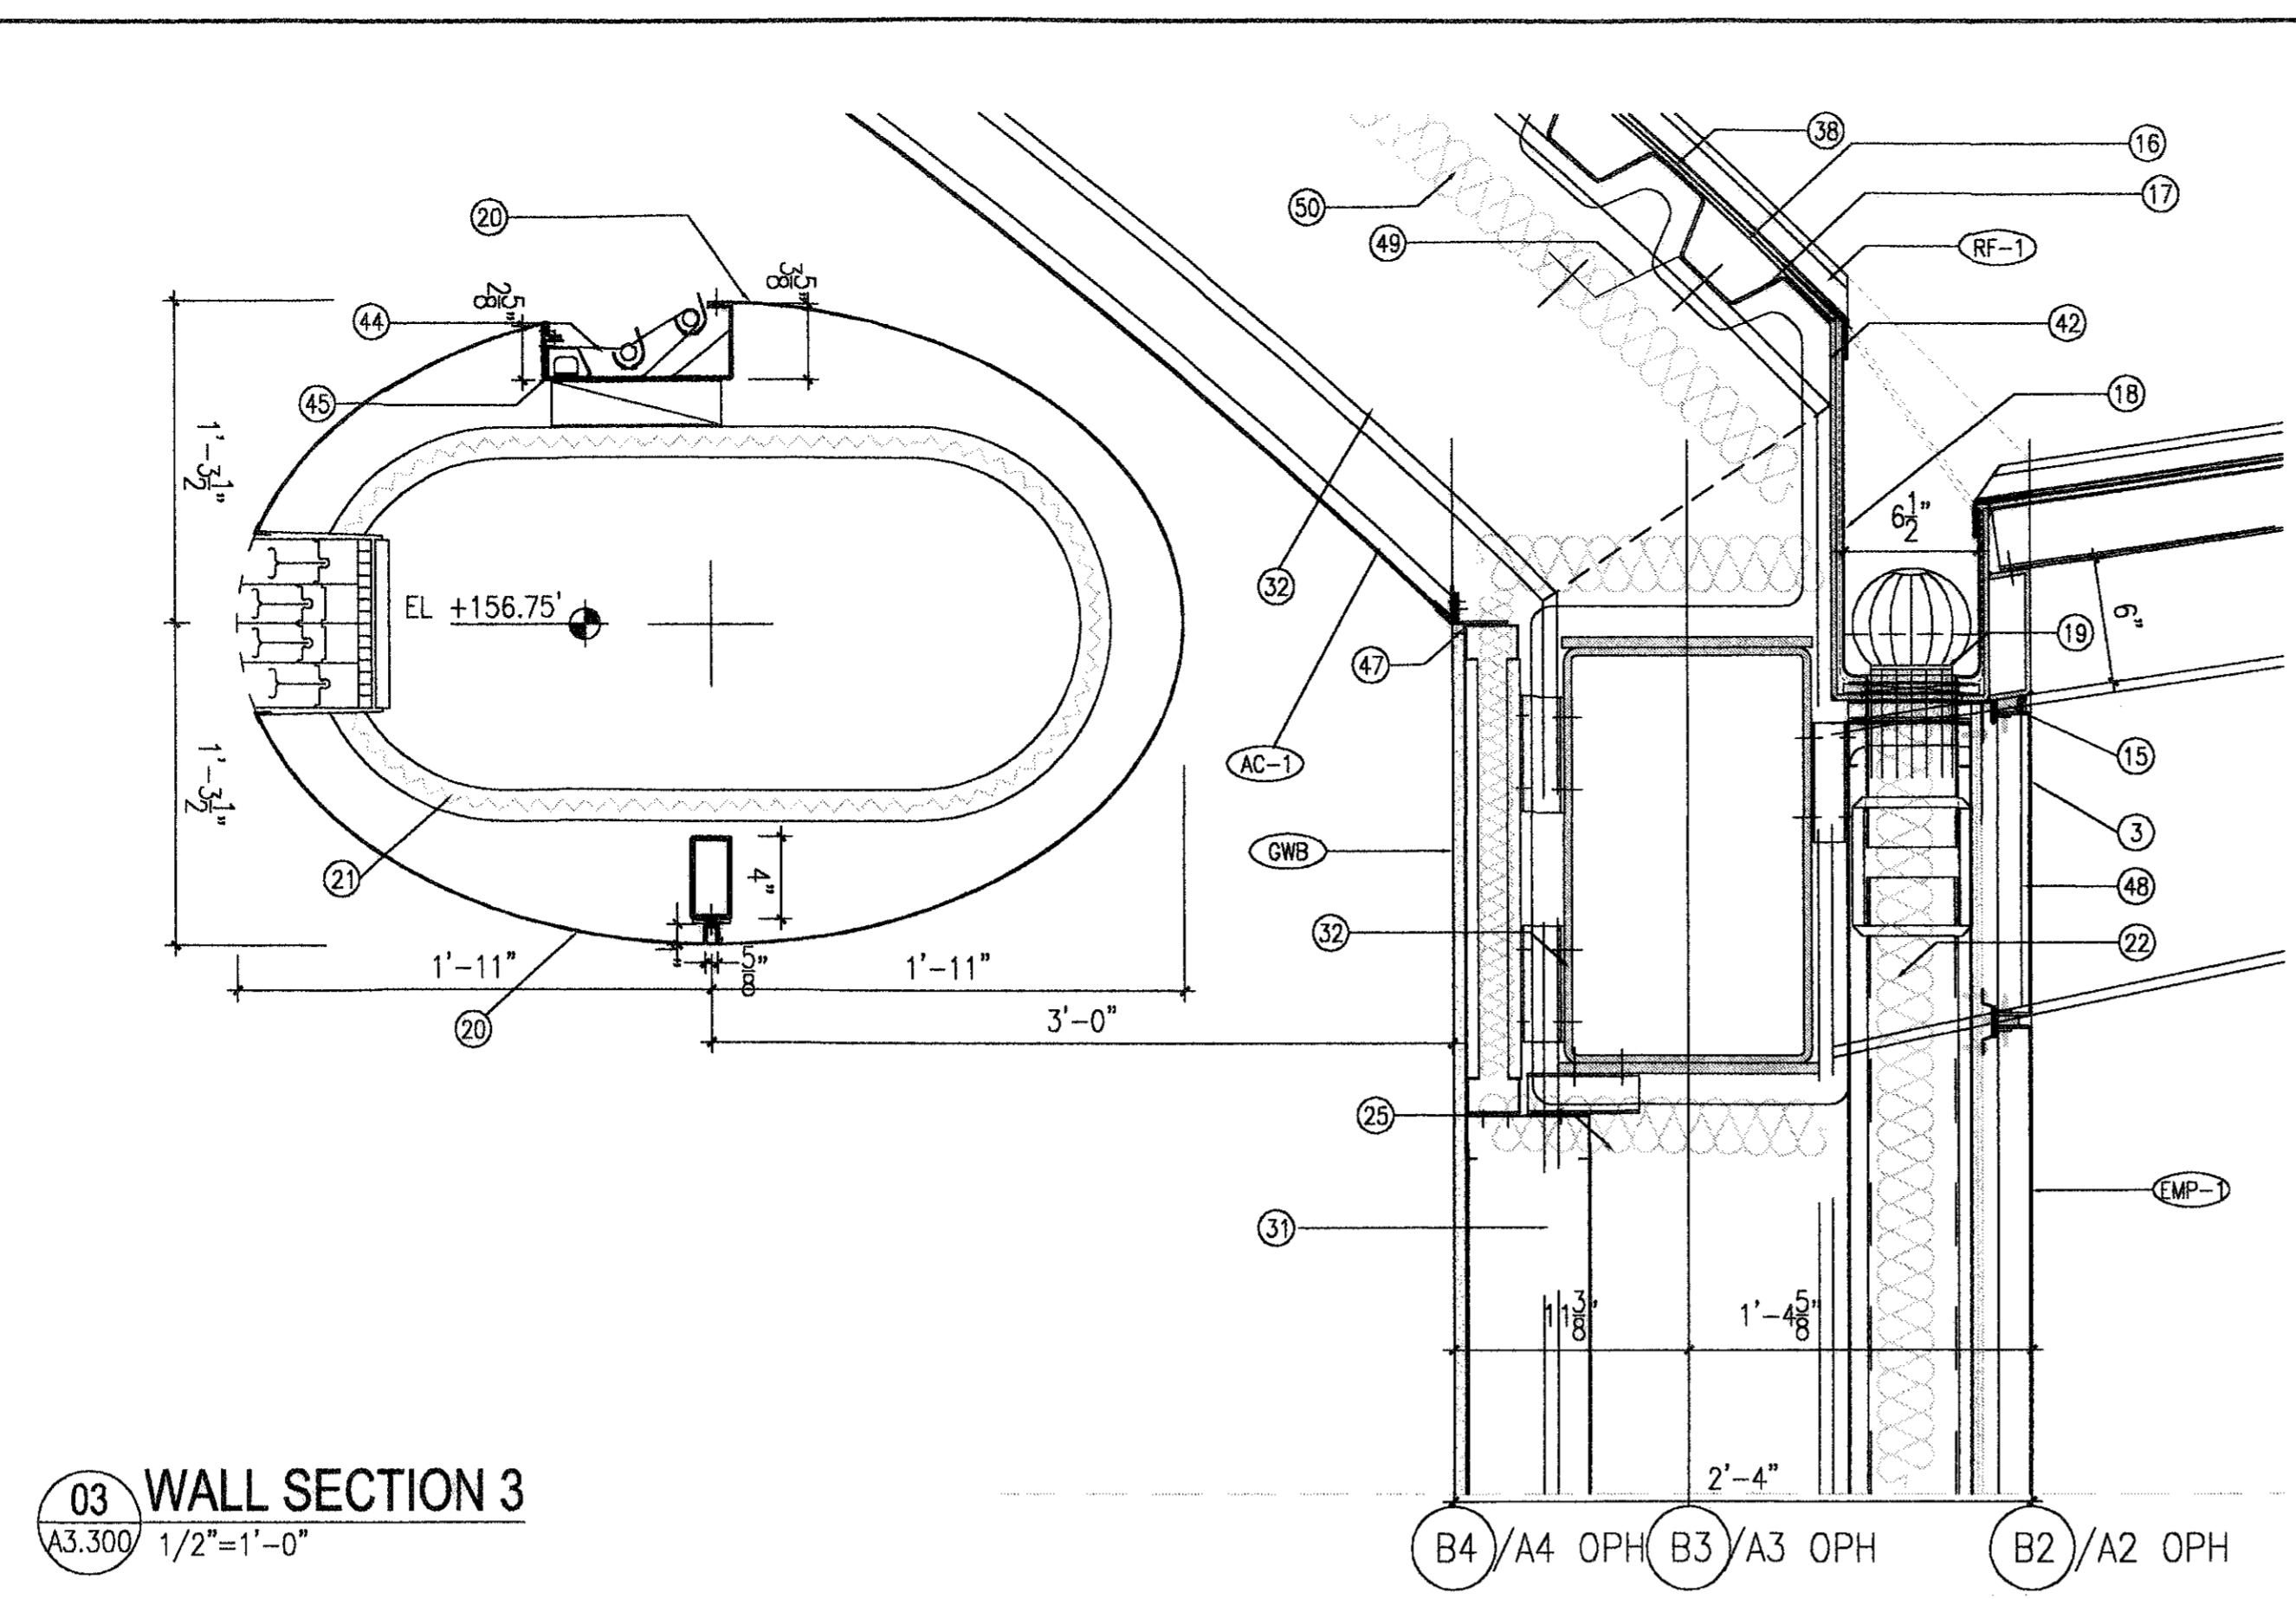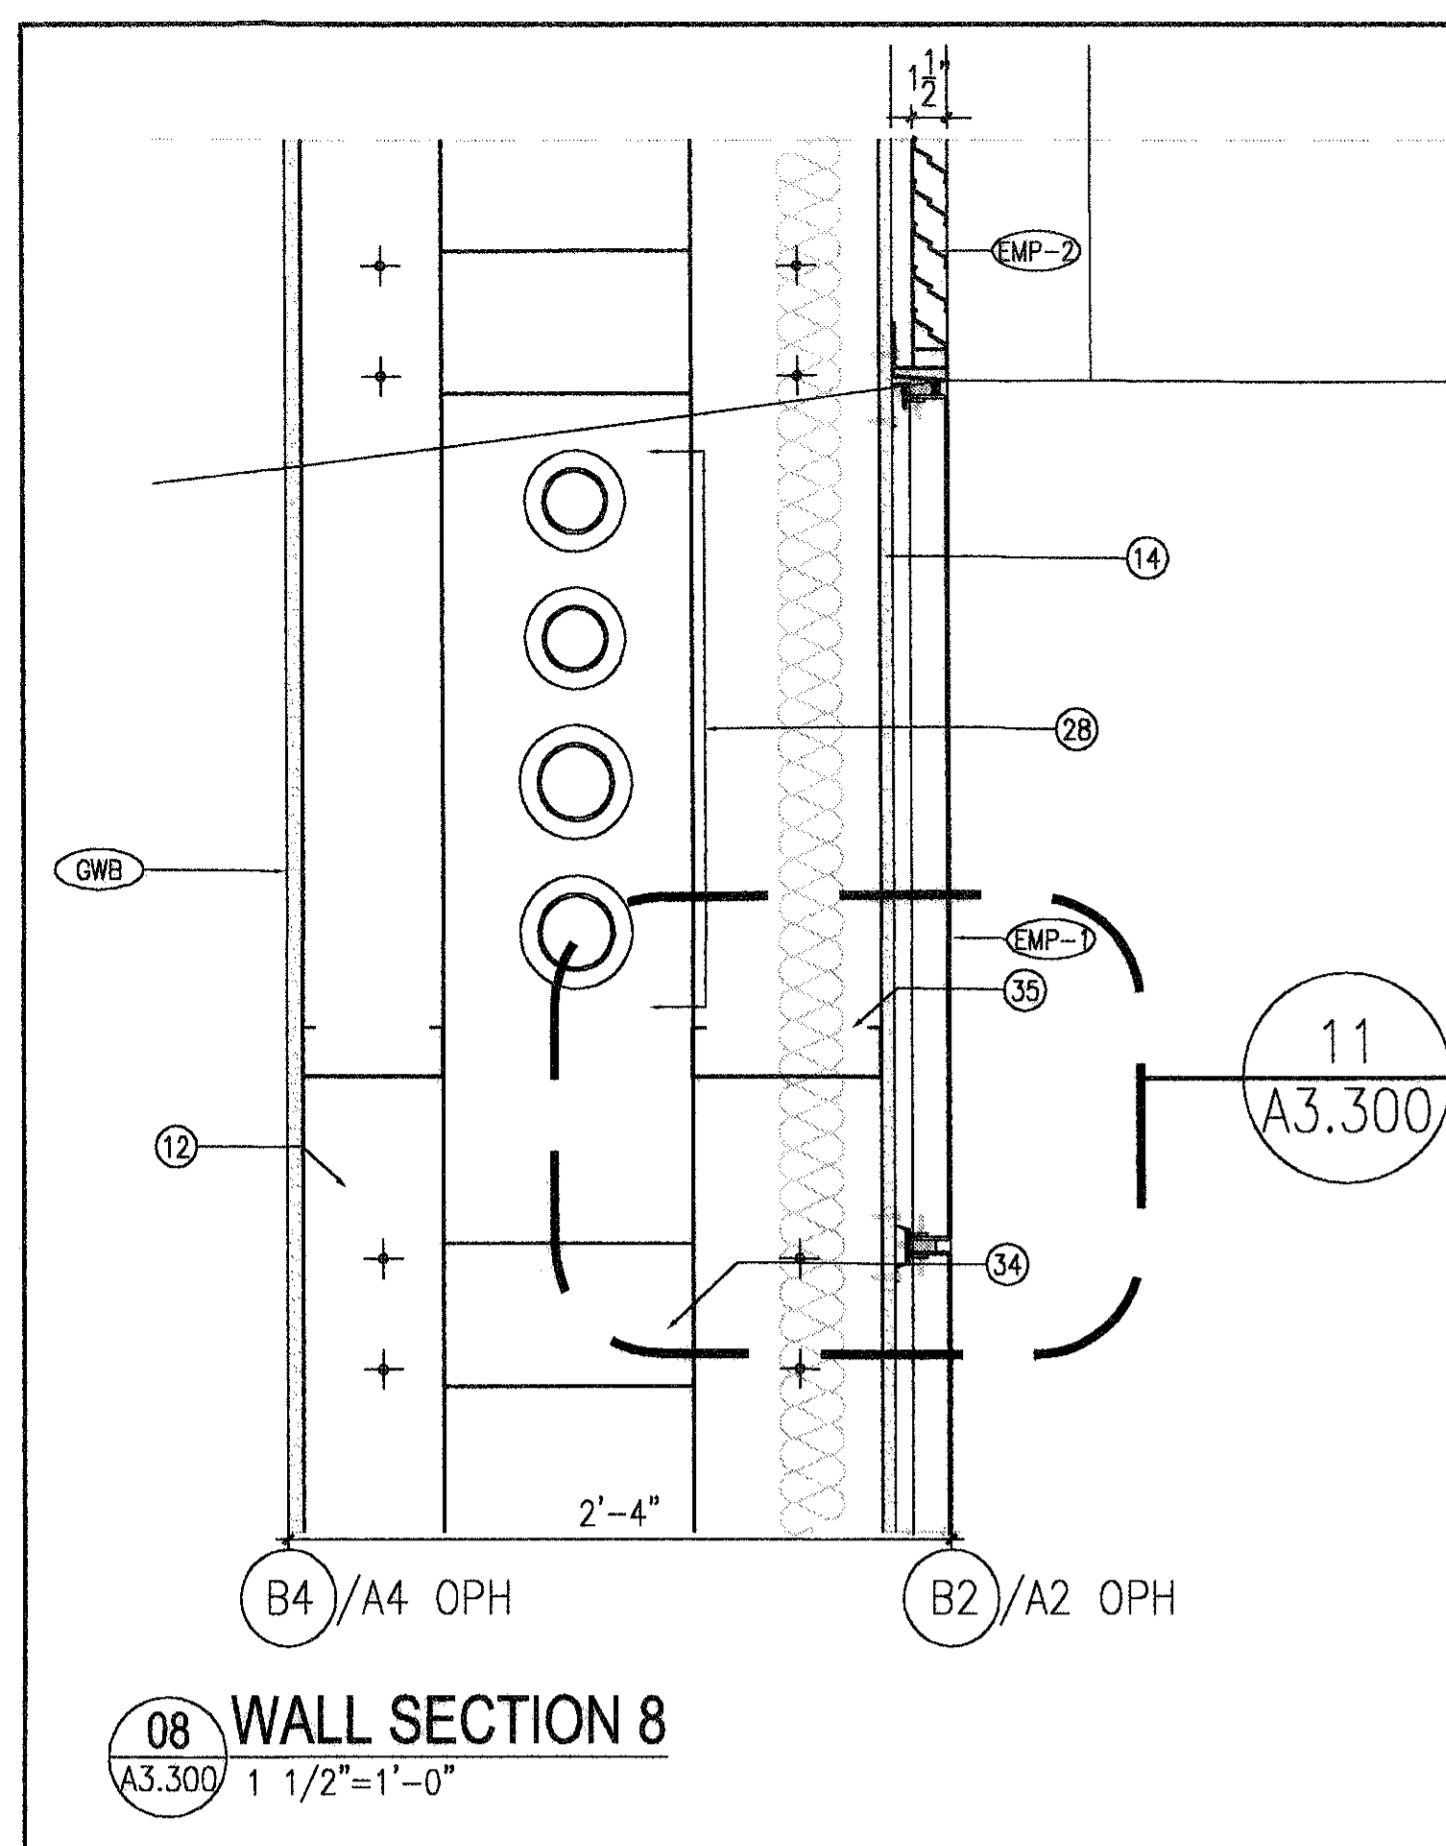

**GENERAL NOTES:**

- OVERALL DIMENSIONS @ SLIDING DOORS TO BE COORDINATED WITH HAS 5360
- INTEGRATED STRUCTURAL CURTAINWALL SYSTEM TYPE 1A
- EXTERIOR POWDERCOATED WALL METAL PANELS - ALUMINUM PANEL 1/8" THICK - TYPE SERIES 3000 MODIFIED FROM UNA-CLAD - COPPER SALES OR EQUAL - POWDERCOATED KYNAR 500
- POWDERCOATED ALUMINUM LOUVERS - WITH INSECT MESH WHEN USED BY MECHANICAL - CLOSED WITH 1/8" THK ALUMINUM SHEET WELDED CONTINUOUSLY TO FRAME WHEN NOT USED BY MECHANICAL - RE MECHANICAL FOR OPENINGS
- STANDING SEAM METAL ROOF - TYPE UC3 FROM UNA-CLAD - COPPER SALES OR EQUAL - THERMOCLAD KYNAR 500: COLOR#2 SILVER METALLIC
- PAINT 5/8" HI-IMPACT GYPSUM BOARD ON METAL STUDS
- PRE-FINISHED CURVED, PERFORATED METAL CEILING PANEL - TYPE ALUMA VAULT SYSTEM 1000 BY GORDON MANUFACTURER - WITH BLACK NON WOVEN ACCUSTICAL MAT
- REMOVABLE SSSL CEILING PANELS - SSSL MULTI DIRECTIONAL MACHINE POLISH
- TERRAZZO FLOOR TYPE 1
- TERRAZZO FLOOR TYPE 2
- INTERIOR STAINLESS STEEL WALL PANELS

**KEYED NOTES:**

- CABLE TRAY IN CEILING BY OTHERS N.I.C. - HAS PROJECT 5360
- SLIDING DOOR POST - RE STRUCTURAL - RE: DET 6, 7, & 8 SHEET A8.040
- EXTERIOR METAL PANELS - TYPE EMP-1 - DIMS TO BE FIELD VERIFIED
- 6" STEEL CHANNEL FIXED ON METAL POSTS - RE DET 6, 7 & 8 SHEET A8.040
- SLIDING DOOR BY OTHERS N.I.C. - HAS PROJECT 5360
- STAINLESS STEEL DOOR FRAME - 16 GA
- OPERABLE PANEL - STAINLESS STEEL CLAD ON 1/2" PLYWOOD - 16GA - FOR HARDWARE: RE SIMILAR CONSTRUCTION @ STATION C - TO BE COORDINATED WITH 5360
- REMOVABLE SSSL CEILING PANELS - TYPE AC-2
- SIGNAGE PANEL OR SPEAKER - N.I.C. - 5360
- 5"x3 1/2"x1/4" CONT. STEEL ANGLE ANCHOR TO CONCRETE SLAB AND WELD TO EMBEDDED ANGLE AFTER ELEVATION IS VERIFIED. INSTALL AFTER RUNNINGS BEAMS ARE INSTALLED
- INSTALL 77"-4" LONG OF STEEL ANGLE AT NORTH AND SOUTH GUIDEWAYS (TOTAL LENGTH 154'-8") CENTER B/W SLIDING DOORS
- SILL BY OTHERS N.I.C. - HAS PROJECT 5360
- 6" METAL STUD @ 16" O.C. 16 GA
- 6" STEEL RUNNER
- 1/2" SHEATHING
- SEALANT & BACKER ROD - COLOR OF SEALANT MATCH COLOR OF PANELS
- 5/8" GYPSUM SHEATHING TYPE X
- 3" METAL DECK + 1 HR FIREPROOFING
- SSSL GUTTER - 16GA
- BASKET STRAINER
- ALUM. CLAD - POWDERCOATED
- A/C DUCT
- DOWNSPOUT
- ISOLATOR SHIM + 1/2" HAT CHANNEL
- PRECOMPRESSED EXPANDING FOAM SEALANT TYPE COLORSEAL BY EMSIEAL OR EQUAL. STANDARD COLOR TO MATCH COLOR OF METAL PANELS
- BAIT INSULATION
- RIGID INSULATION
- SSSL BASE - 14 GA - RECESSED ALIGNED WITH WALL FINISH FACE
- CHS, CHR, HWR, HWS, DUCTS - REFER TO MEP DWG.
- 12" ALUMINUM CHANNEL - POWDERCOATED - COLOR #1 - FASTENERS NOT VISIBLE - ANCHOR TO STRUCTURE BY 1/4" ALUM. PLATE WELDED @ BACK OF CHANNEL - TYPICAL LENGTH 20' SLICING @ JOINTS MATCH COLOR OF FINISH
- BLUE SAFETY LIGHT
- STEEL COLUMN + 3HR FIREPROOFING
- STEEL BEAM + 3HR FIREPROOFING
- UNDERLAYMENT
- BRACING AS REQUIRED
- 8" METAL STUD JOIST @ 16" O.C. 10 GA
- 8" STEEL RUNNER
- SHIM + SUBGRIT ANCHOR TO CONCRETE
- ROOFING UNDERLAYMENT TYPE VYCOR ULTRA FROM GRACE MANUFACTURER OR EQUAL
- 3/4"x3/4" ALUMINUM CLIP WITH SELF TAPPING SCREWS OR RIVETS
- 1/8" ALUMINUM - POWDERCOATED
- SELF TAPPING FASTENERS
- STEEL PLATE - 1/4" THK - WELD TO STRUCTURE
- FURRING CHANNELS SECURE TO CONCRETE
- SCHEDULED LIGHT FIXTURE - RE ELECTRICAL
- BENT STEEL PLATE - 1/8" THICK - RE SHEET A9.000
- SUPPORT OF LIGHT FIXTURE AND SSSL DUCT-CLADDING - PERFECTLY HORIZONTAL AND ALIGNED
- 6" GALVANIZED STEEL PLATE 20 GA - FASTENED TO STUD @ BASE
- 1/2" EXTRUDED ALUM. PROFILE @ REVEAL - PRE-FINISHED
- 1/2" STEEL PLATE - WELD @ FLANGE OF CANOPY BEAM - PAINT
- Z CLIP @ 2" O.C. - GALVANIZED STEEL - 20GA
- BAIT INSULATION FIX TO Z CLIPS
- 2 1/2" METAL STUD - 20GA @ 16" O.C.
- CONT. L 2 1/2"x2 1/2"x1/4" W/ 5/8" DIA. HEADED CONC. ANCHORS, 4" LONG @ 2'-0" O.C.
- 5/8" DIA A325 TREATED ROD IN VERT. SLOTTED HOLE @ 2'-0" O.C. INSTALL W/ EPOXY GROUT 16" MIN EMBEDMENT. WELD NUT TO WASHER AND WASHER TO ANGLE AFTER ELEVATION VERIFIED
- 0.562"x1.25" SLOTTED HOLES @ 18.00" C.C MAX
- 2" O.D. WASHER WELD TO NUT AND TO ANGLE WHEN ELEVATION OF ANGLE IS VERIFIED

**RECORD DRAWINGS**  
DO NOT MODIFY  
Ray de la Reza Architects, Inc.  
13 May 2005

Note: Information used to develop these documents was taken from Record of the Work Drawings prepared by the construction contractor, Clark Construction Group - Texas. The information provided by the contractor was not verified by the design firm named above.

**Houston Airport System**  
GEORGE BUSH  
INTERCONTINENTAL AIRPORT  
HOUSTON TEXAS

**Lea+Elliot**  
1008 W RANDOL WILL RD  
HOUSTON, TX 77042  
Tel: 817.881.1445  
Tel: 817.881.3286

**REV DE LA REZA ARCHITECTS, INC.**  
ARCHITECT OF RECORD  
1245 WEST 10TH ST.  
HOUSTON, TX 77008  
Tel: 713.888.3121  
Tel: 713.882.0112

REVISIONS  
NO. DESCRIPTION DATE BY  
ISSUED FOR BID 10/19/01  
REVISION #1 01/27/03 SG  
RECORD SET 05/11/05 EM

INTERNATIONAL SERVICES • EXPANSION • PROGRAM  
**APM STATION + PLATFORM**  
WALL DETAILS

PROJECT MGR: HEM  
DESIGNER: SG  
DRAWN BY: SEM  
CHECKED BY: AB  
DRAWING STANDARD: FSP 07.20.2000  
SCALE: AS NOTED  
DATE: 08/14/01





APPROVED BY: \_\_\_\_\_ DATE: \_\_\_\_\_  
DIRECTOR  
HOUSTON AIRPORT SYSTEM

PROJECT NO. 1140  
CLIP. NO. A-0354  
H.A.S. NO. 5365  
SHEET NO. 31

PLOT DATE: 02/04/02 HAS FILE: HASRCA3300



REVISIONS			
NO.	DESCRIPTION	DATE	BY
1	ISSUED FOR BID	10/19/01	
2	RECORD SET	05/13/05	EM

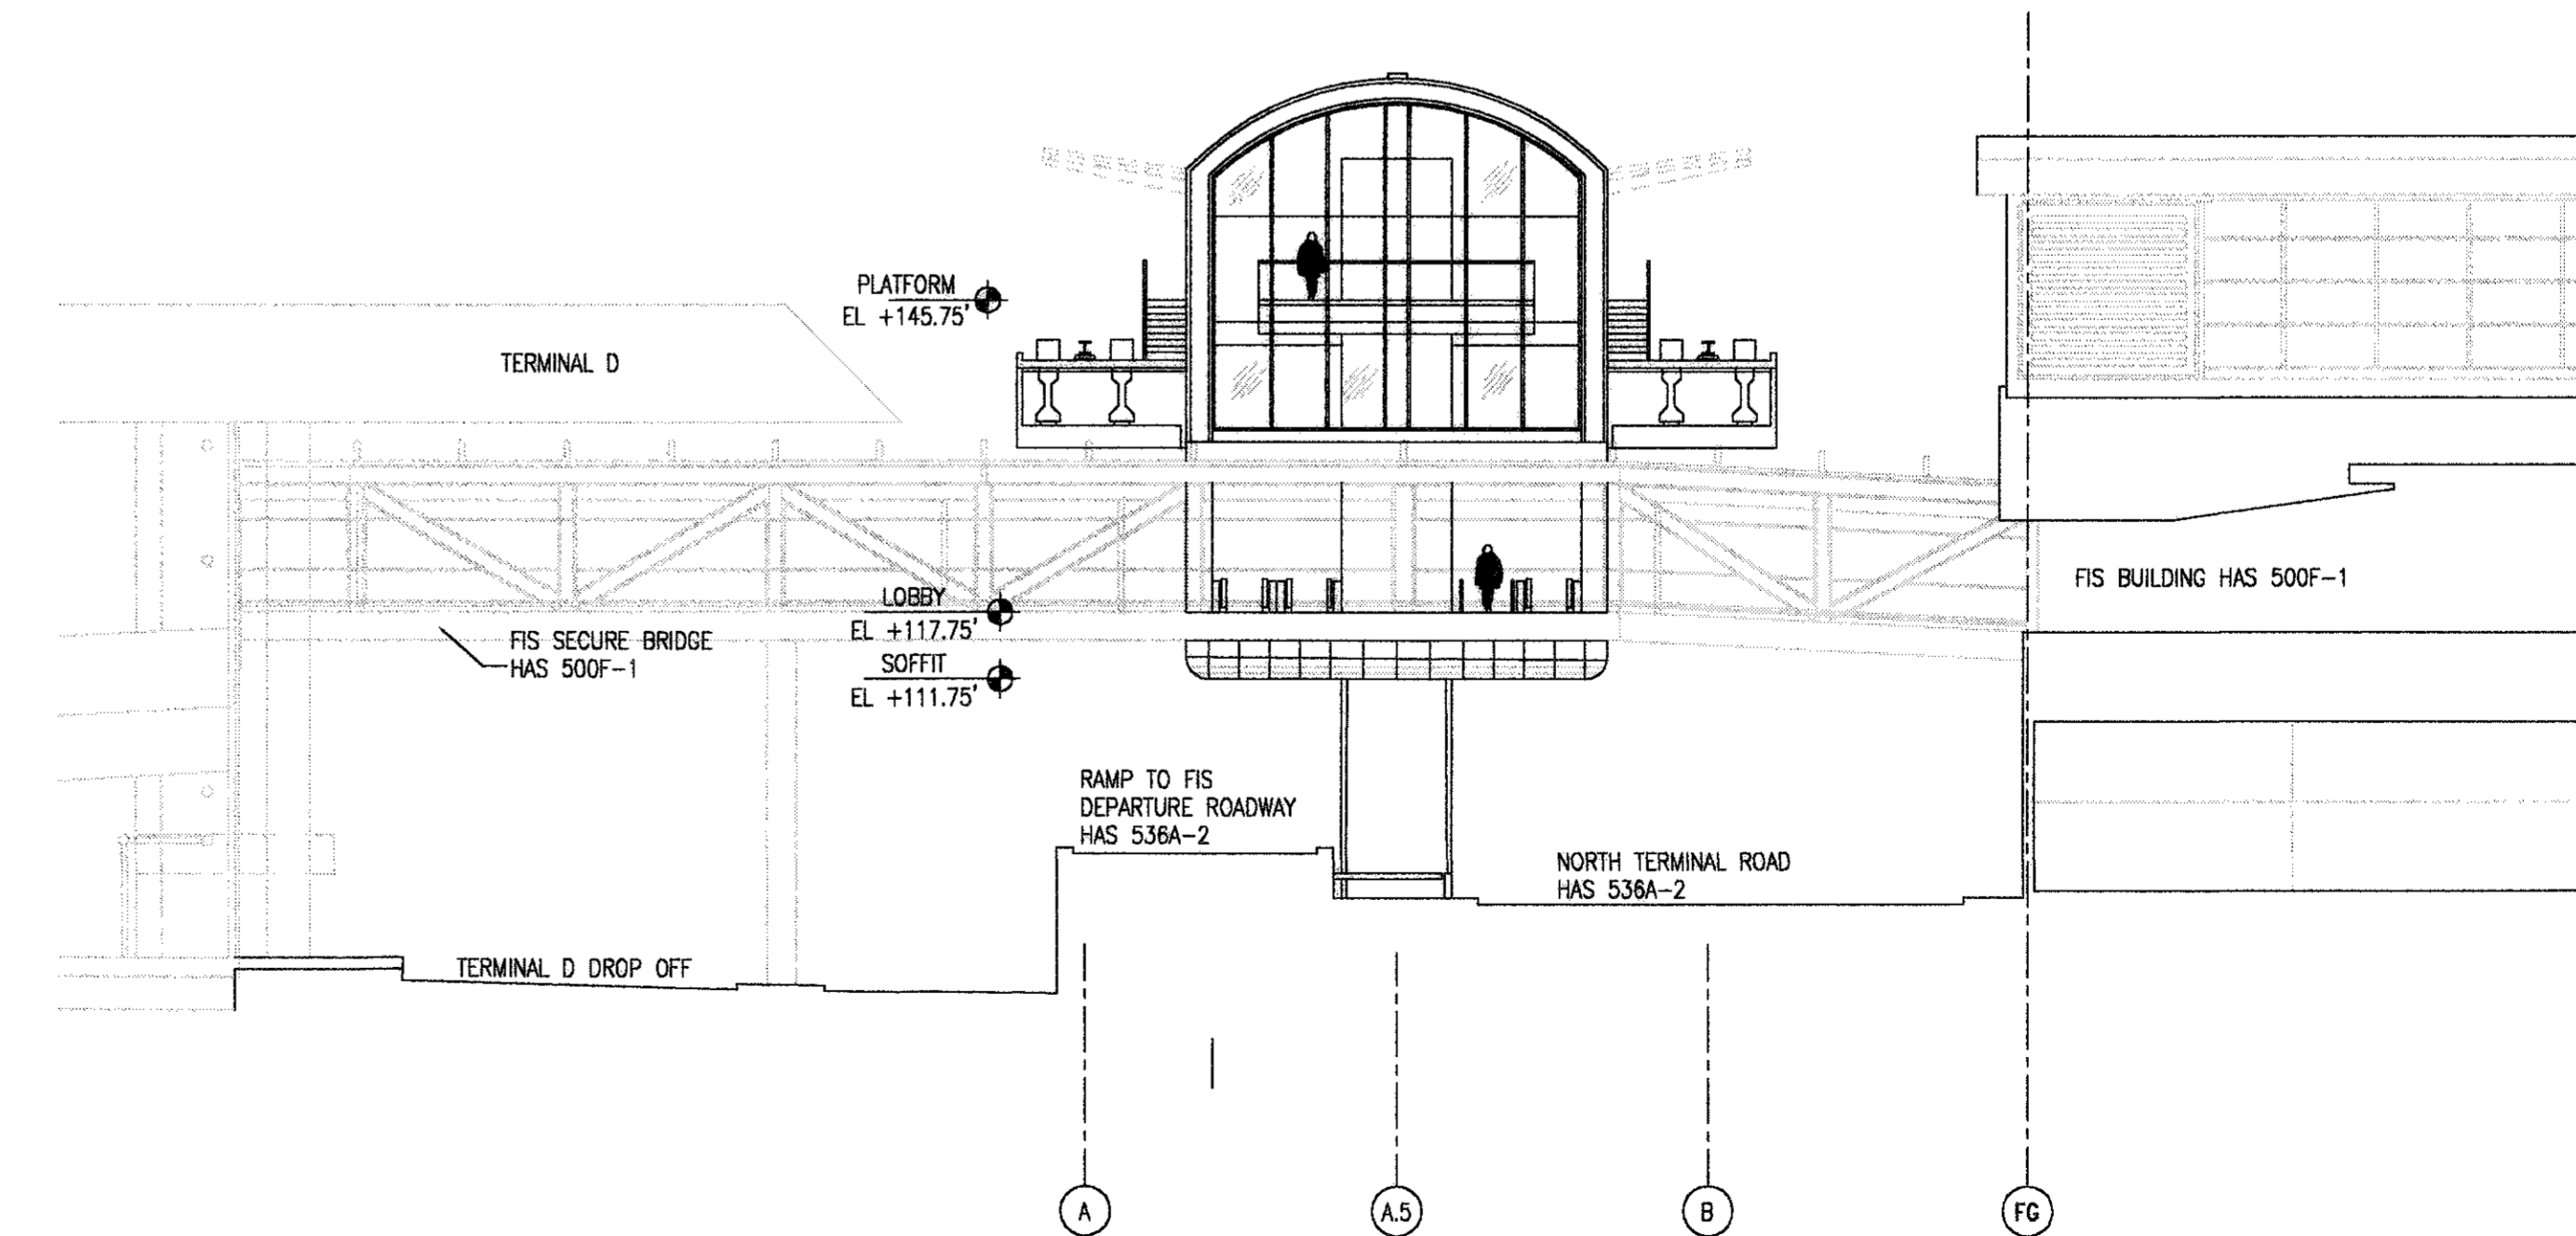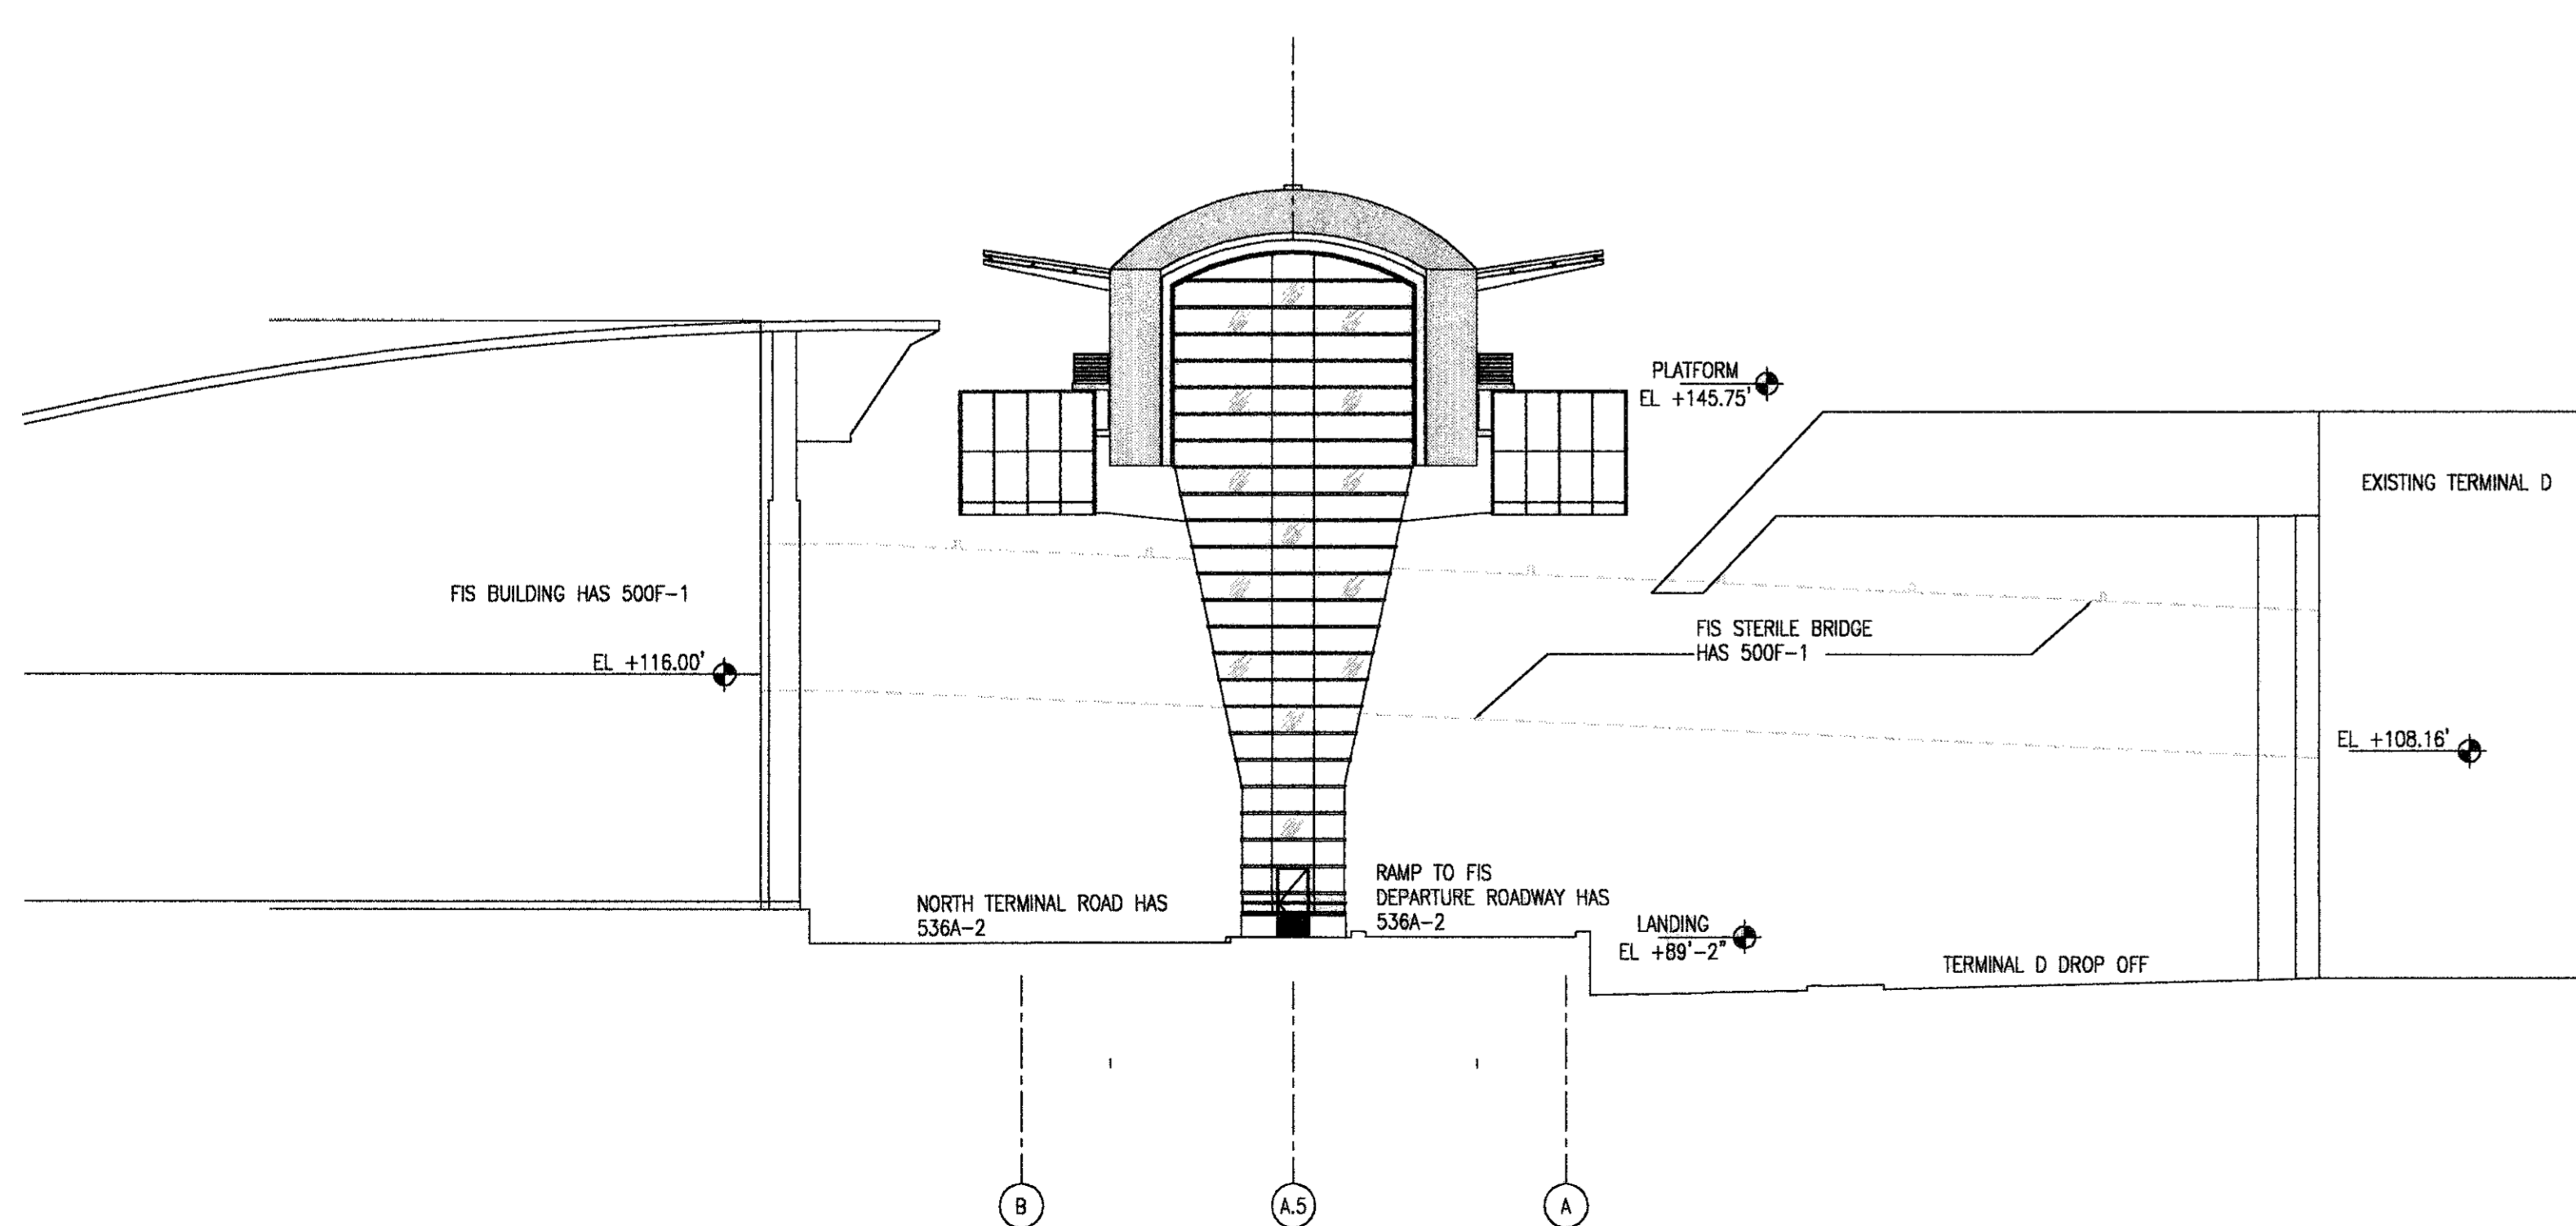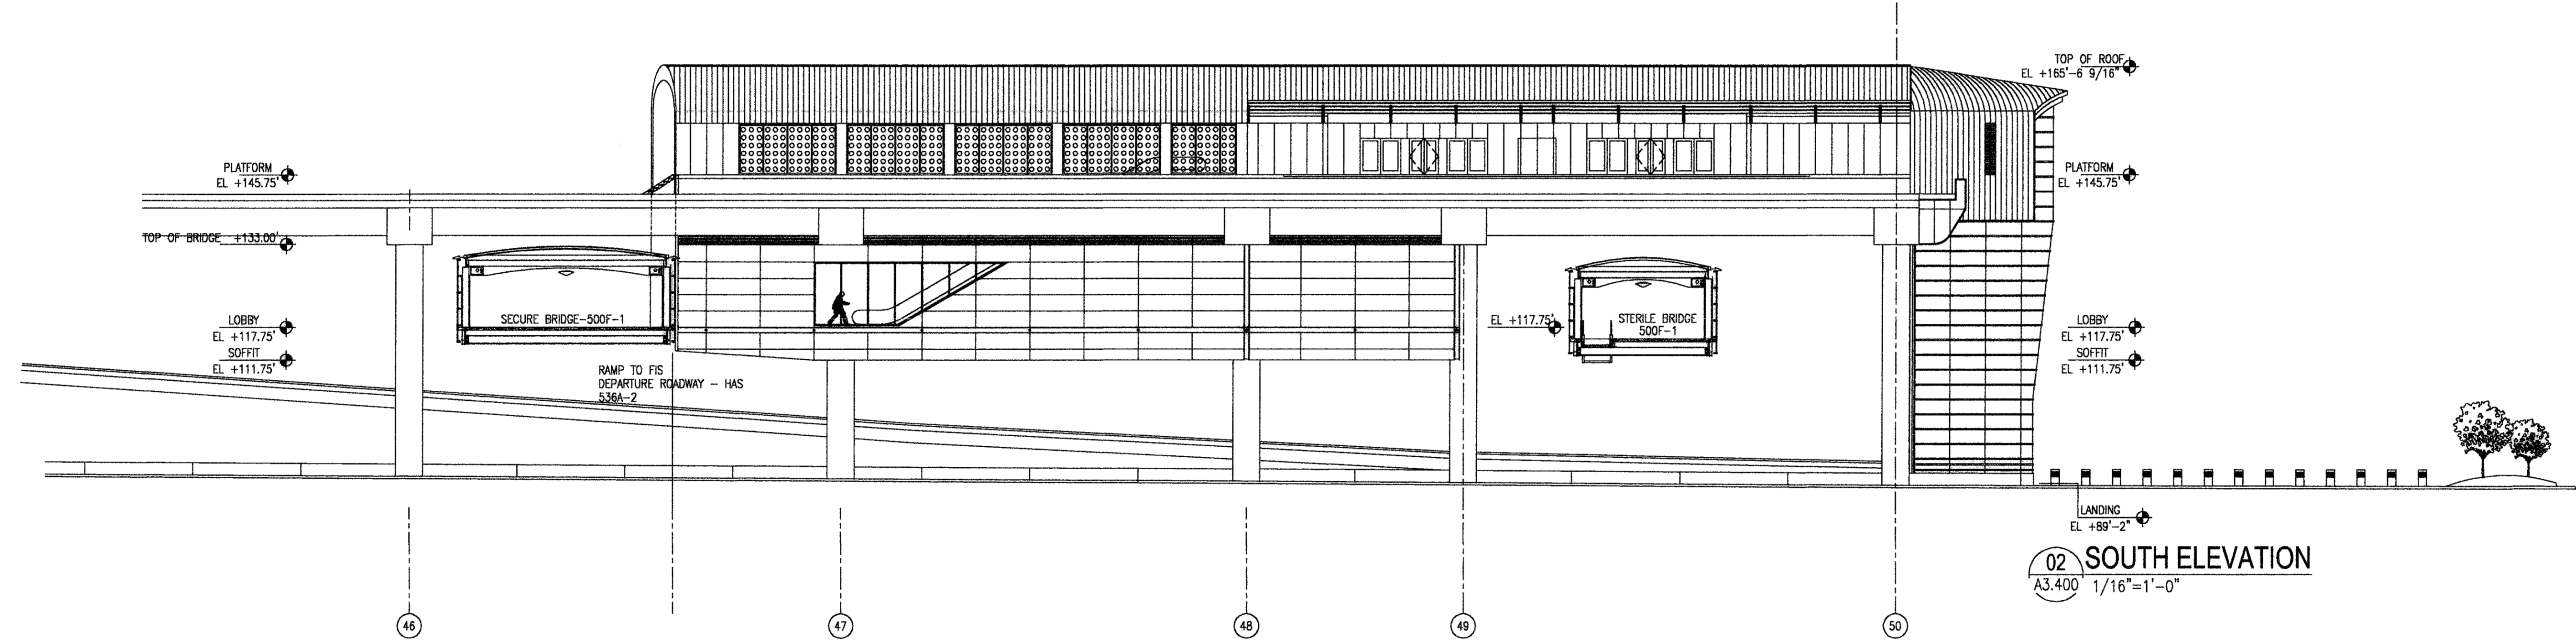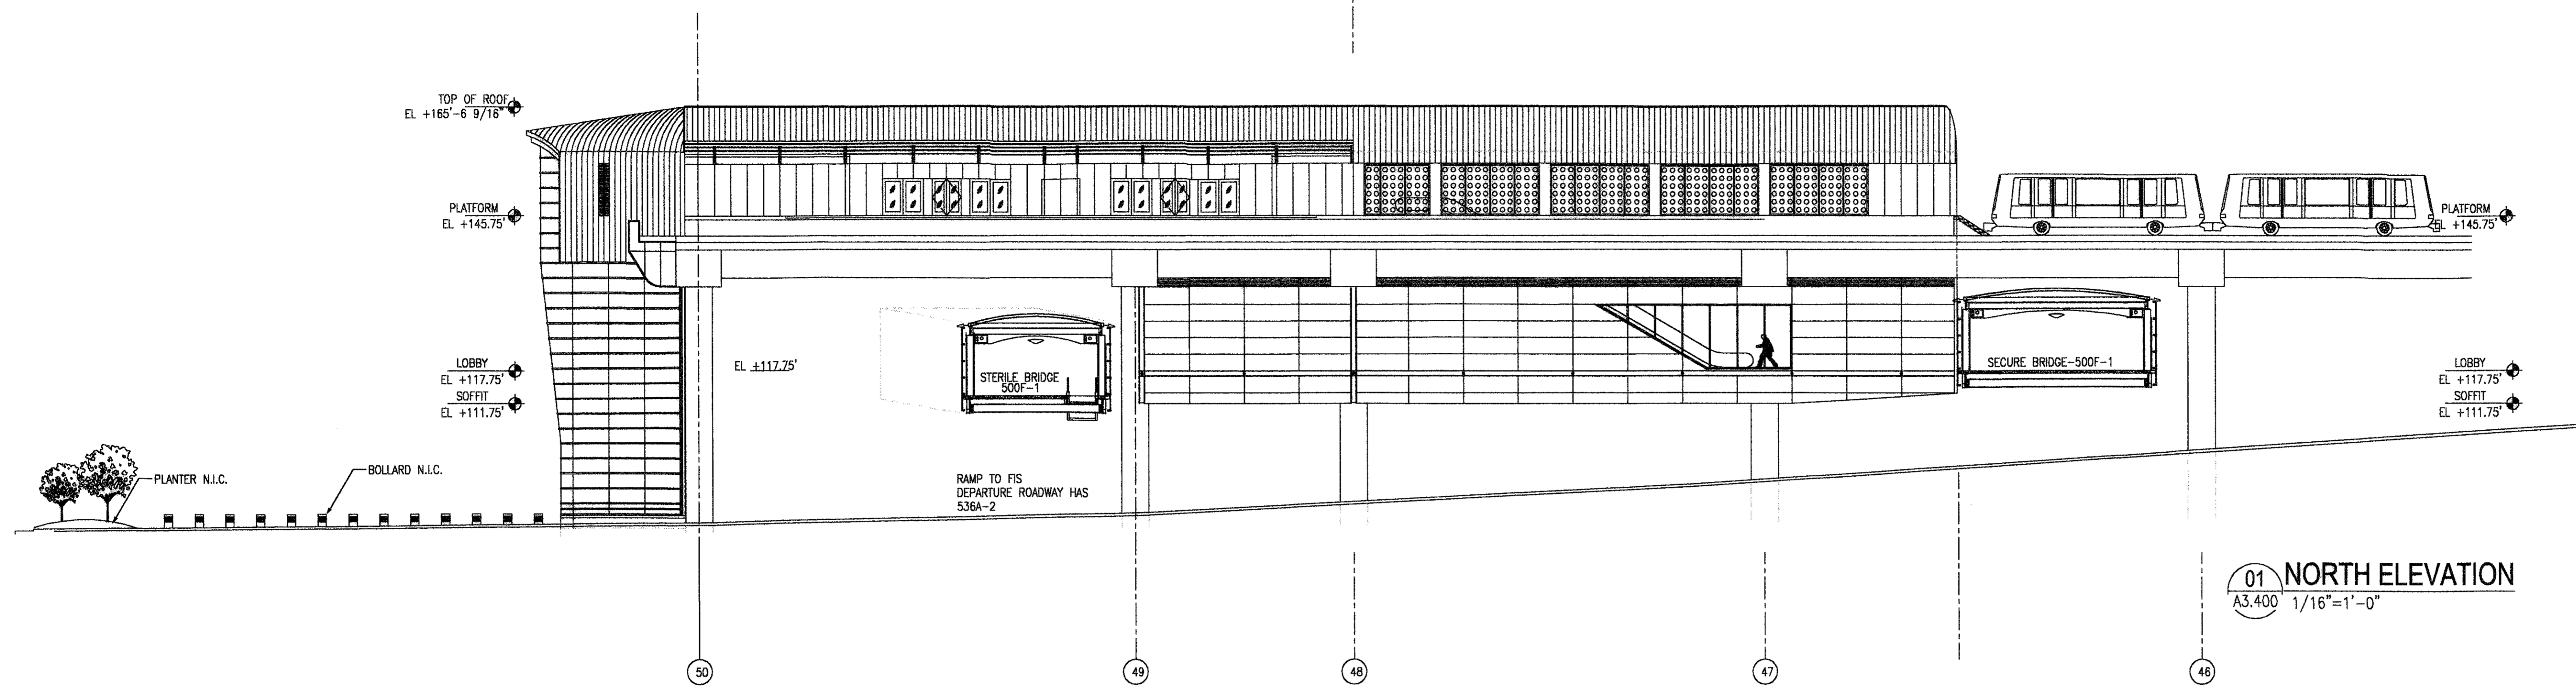


**RECORD DRAWINGS**  
 DO NOT MODIFY  
 Ray de la Reza Architects, Inc.  
 13 May 2005

Note: Information used to develop these documents was taken from Record of the Work Drawings prepared by the construction contractor, Clark Construction Group - Texas. The information provided by the contractor was not verified by the design firm named above.

INTERNATIONAL • SERVICES • EXPANSION • PROGRAM  
**APM STATION + PLATFORM**  
 ELEVATIONS

PROJECT MGR:	NEM
DESIGNER:	SG
DRAWN BY:	SEM
CHECKED BY:	AB
DRAWING STANDARD:	ISP 07.20.2000
SCALE:	1/16"=1'-0"
DATE:	09/14/01

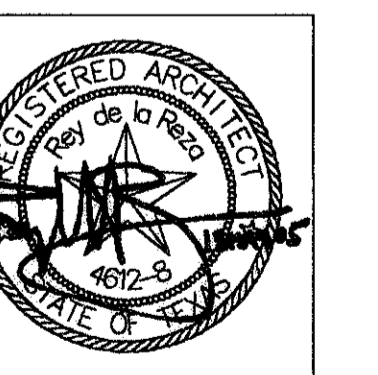


APPROVED BY: \_\_\_\_\_ DATE: \_\_\_\_\_  
 DIRECTOR  
 HOLSTON AIRPORT SYSTEM

PROJECT NO.	1140
C.I.P. NO.	A-0354
H.A.S. NO.	536C
SHEET NO.	



NO.	DESCRIPTION	DATE	BY
1	ISSUED FOR BID	10/19/01	
2	REVISION #1	01/27/03	SG
3	RECORD SET	05/13/05	EM

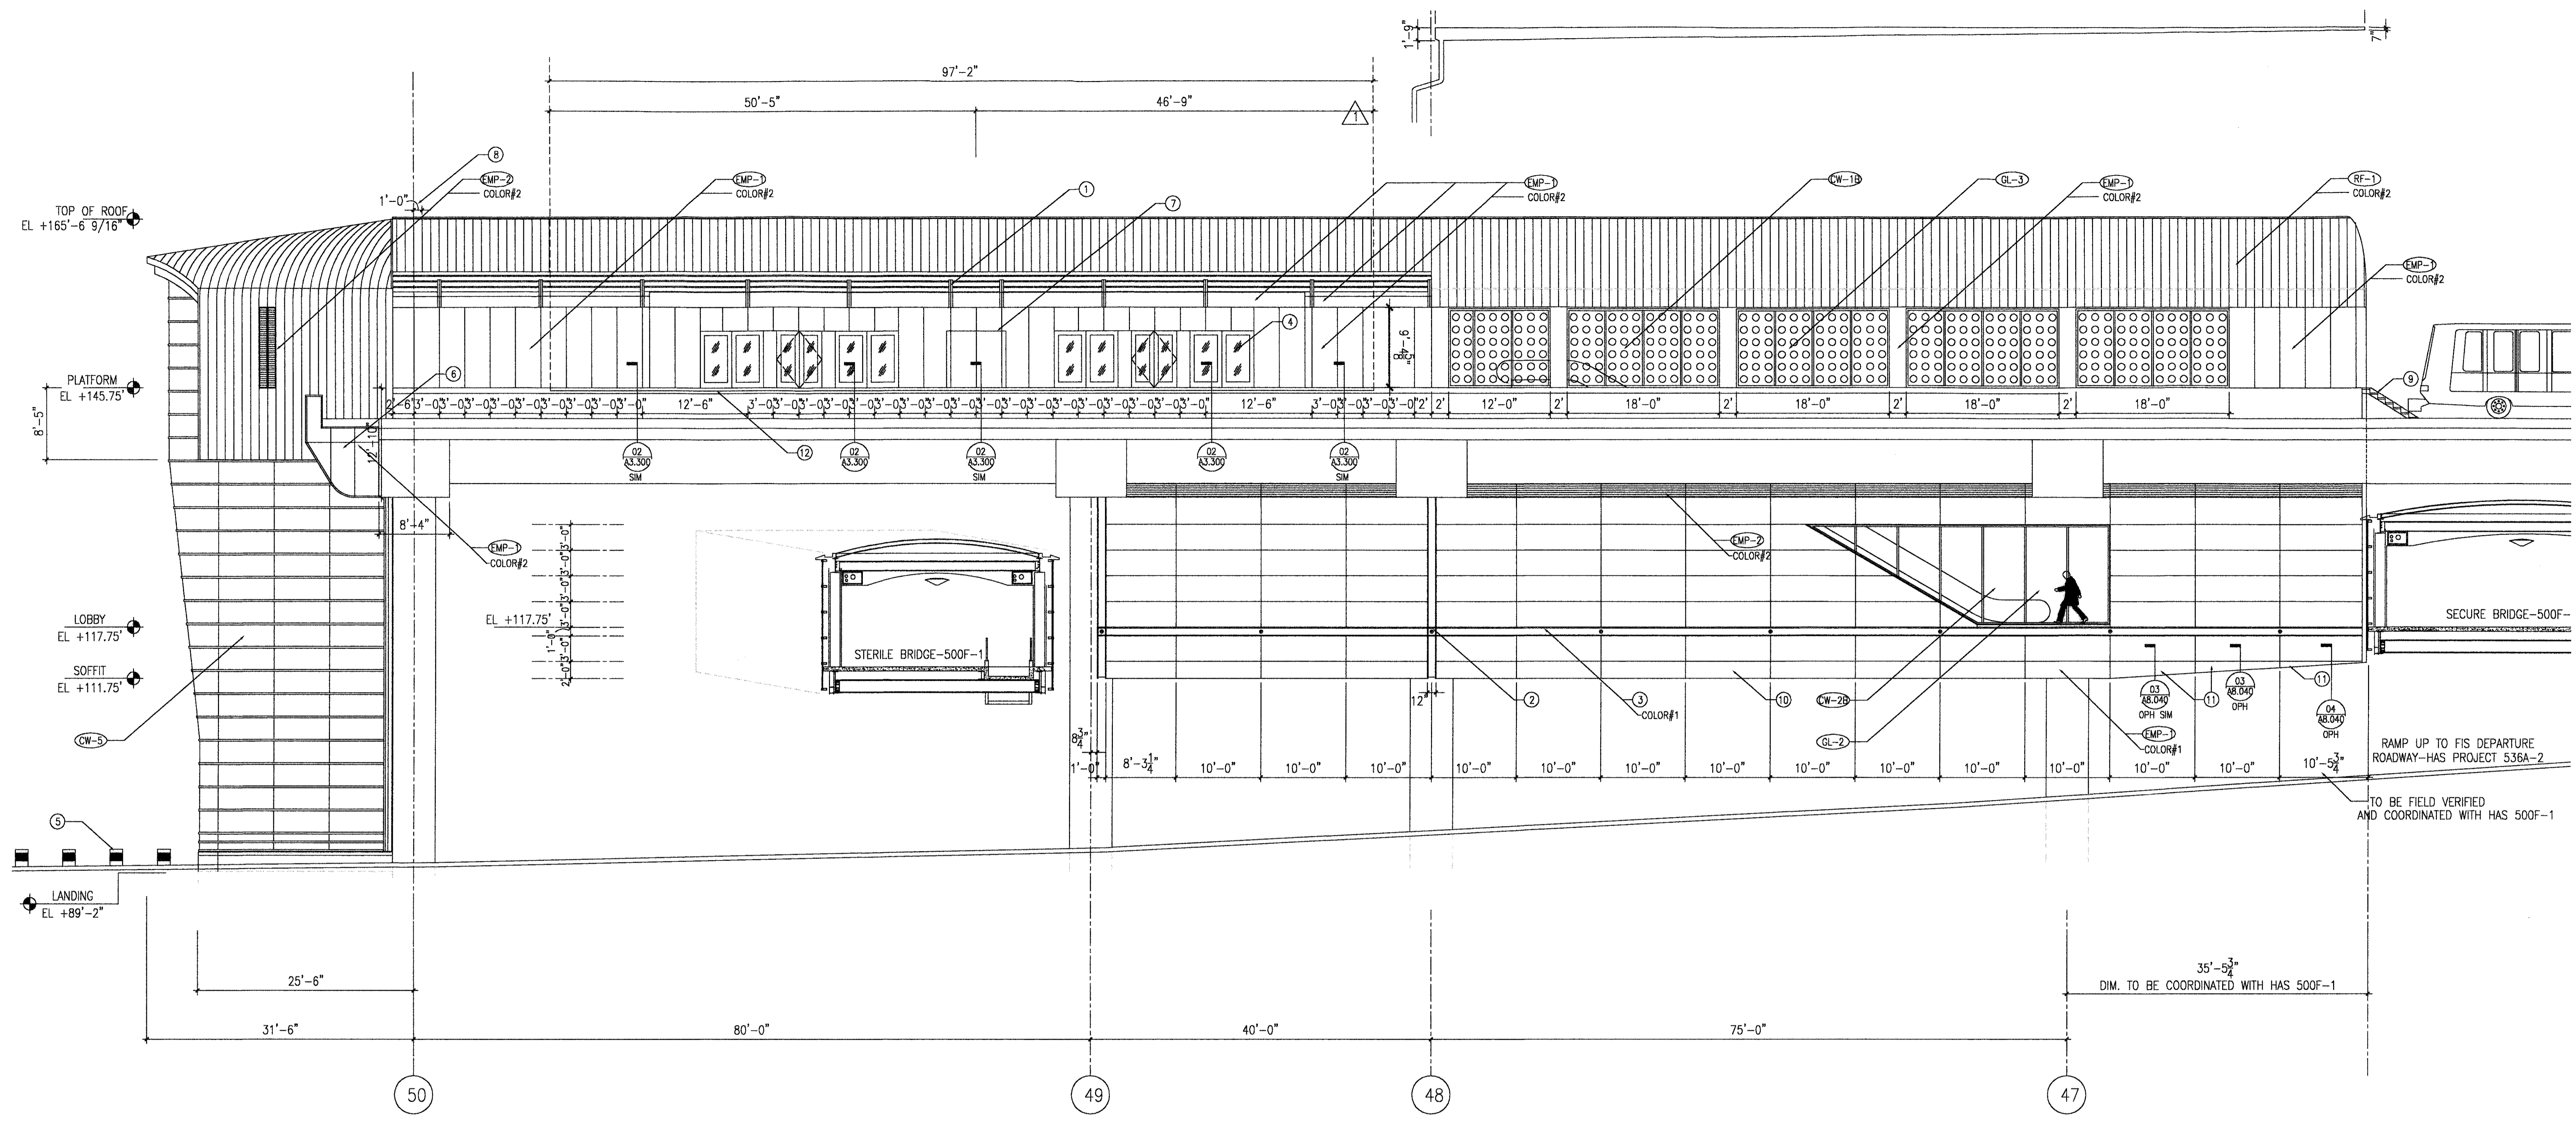

01 NORTH ELEVATION  
 A3.500 1/8"=1'-0"


INTERNATIONAL SERVICES • EXPANSION • PROGRAM  
**APM STATION + PLATFORM**  
 NORTH ELEVATION

**KEYED NOTES:**

- ① CANOPY ABOVE CARS
- ② BLUE SAFETY LIGHT - RE ELECTRICAL
- ③ 12" ALUMINIUM CHANNEL POWDERCOATED COLOR#1
- ④ STATION SLIDING DOOR N.I.C. HAS PROJECT 536D
- ⑤ BOLLARDS N.I.C. - HAS LANDSCAPING PROJECT
- ⑥ BUFFER'S STRUCTURE-METAL CLAD
- ⑦ SOFFIT BETWEEN DOORS: EXTERIOR ALUMINIUM PANEL TYPE EMP-1
- ⑧ TYPICAL WIDTH OF STANDING SEAM ROOFPANELS 1'. ROOFPANELS PERFECTLY ALIGNED WITH BUILDING GRID
- ⑨ STAIR N.I.C. 536A-1
- ⑩ CURVED METAL PANEL TYPE EMP-1 R. 2'-0"
- ⑪ PARTIALLY CURVED PANEL WELDED TO FLAT PANEL @ SLOPED SOFFIT RE SHEET AB.040
- ⑫ STEEL ANGLE FOR THRESHOLD SUPPORT RE 02/A3.300

**GENERAL NOTES:**


- CW-1A** CURTAINWALL SYSTEM TYPE 1A - RE WINDOW SCHEDULE SHEET A2.850
- CW-1B** CURTAINWALL SYSTEM TYPE 1B - RE WINDOW SCHEDULE SHEET A2.850
- CW-2A** CURTAINWALL SYSTEM TYPE 2A - RE WINDOW SCHEDULE SHEET A2.850
- CW-2B** CURTAINWALL SYSTEM TYPE 2B - RE WINDOW SCHEDULE SHEET A2.850
- GL-2** 1" INSULATED GLAZING UNIT- INTERIOR AND EXTERIOR GLASS TEMPERED - RE GLASS SCHEDULE SHEET A2.850
- GL-3** 1" INSULATED GLAZING UNIT WITH FRIT. RE GLASS SCHEDULE SHEET A2.850
- EMP-1** EXTERIOR POWDERCOATED METAL WALL- PANEL- ALUMINIUM PANEL 1/8" THICK - TYPE SERIES 3000 MODIFIED FROM UNA-CLAD - COPPER SALES OR EQUAL POWDERCOATED KYMAR 500 - FOR COLOR RE. SCHEDULE SHEET A2.800
- EMP-2** POWDERCOATED ALUMINIUM LOUVERS -WITH INSECT MESH WHEN USED BY MECHANICAL -CLOSED WITH ALUMINIUM SHEET WELDED TO FRAME WHEN NOT USED BY MECHANICAL. RE: MECHANICAL FOR OPENINGS
- RF-1** STANDING SEAM METAL ROOF- TYPE UC3 FROM UNA-CLAD - COPPER SALES OR EQUAL -WIDTH 1' - POWDERCOATED KYMAR 500 - COLOR#2 SILVER METALLIC
- CW-5** INTEGRATED STRUCTURAL CURTAIN WALL SYSTEM TYPE 5 - RE WINDOW SCHEDULE SHEET A2.850

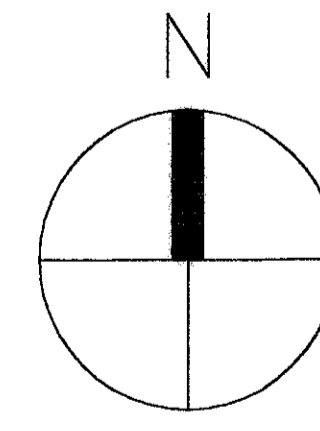

**RECORD DRAWINGS**  
 DO NOT MODIFY  
 Rey de la Reza Architects, Inc.  
 13 May 2005  
 Note: Information used to develop these documents was taken from Record of the Work. Drawings prepared by the construction contractor, Clark Construction Group, Texas. The information provided by the contractor was not verified by the design firm named above.

NOTE: REFER TO GRAPHIC SCALE IF ACTUAL SHEET SIZE IS OTHER THAN 30"x42".  
 0' 4' 8' 16' 24'  
 SCALE: 1/8" = 1'-0"


PROJECT MGR:	HDM
DESIGNER:	SG
DRAWN BY:	SDM
CHECKED BY:	AB
DRAWING STANDARD:	IBSP 07.20.2000
SCALE:	1/8"=1'-0"
DATE:	09/14/01

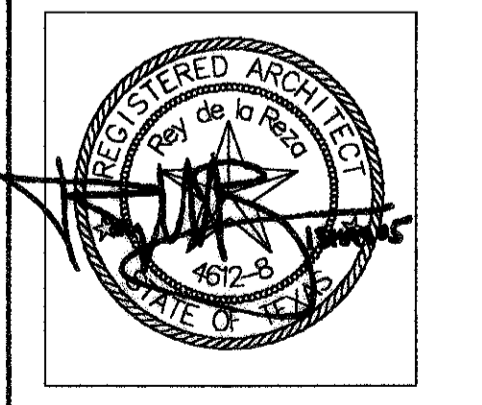

APPROVED BY:	DATE:
DIRECTOR	
HOUSTON AIRPORT SYSTEM	
PROJECT NO.	1140
C.I.P. NO.	A-0354
H.A.S. NO.	536C
SHEET NO.	



REVISIONS	NO.	DESCRIPTION	DATE	BY
	NO.	ISSUED FOR BID	10/19/01	
	REVISION #1	01/27/03	SG	
	RECORD SET	05/13/05	EM	

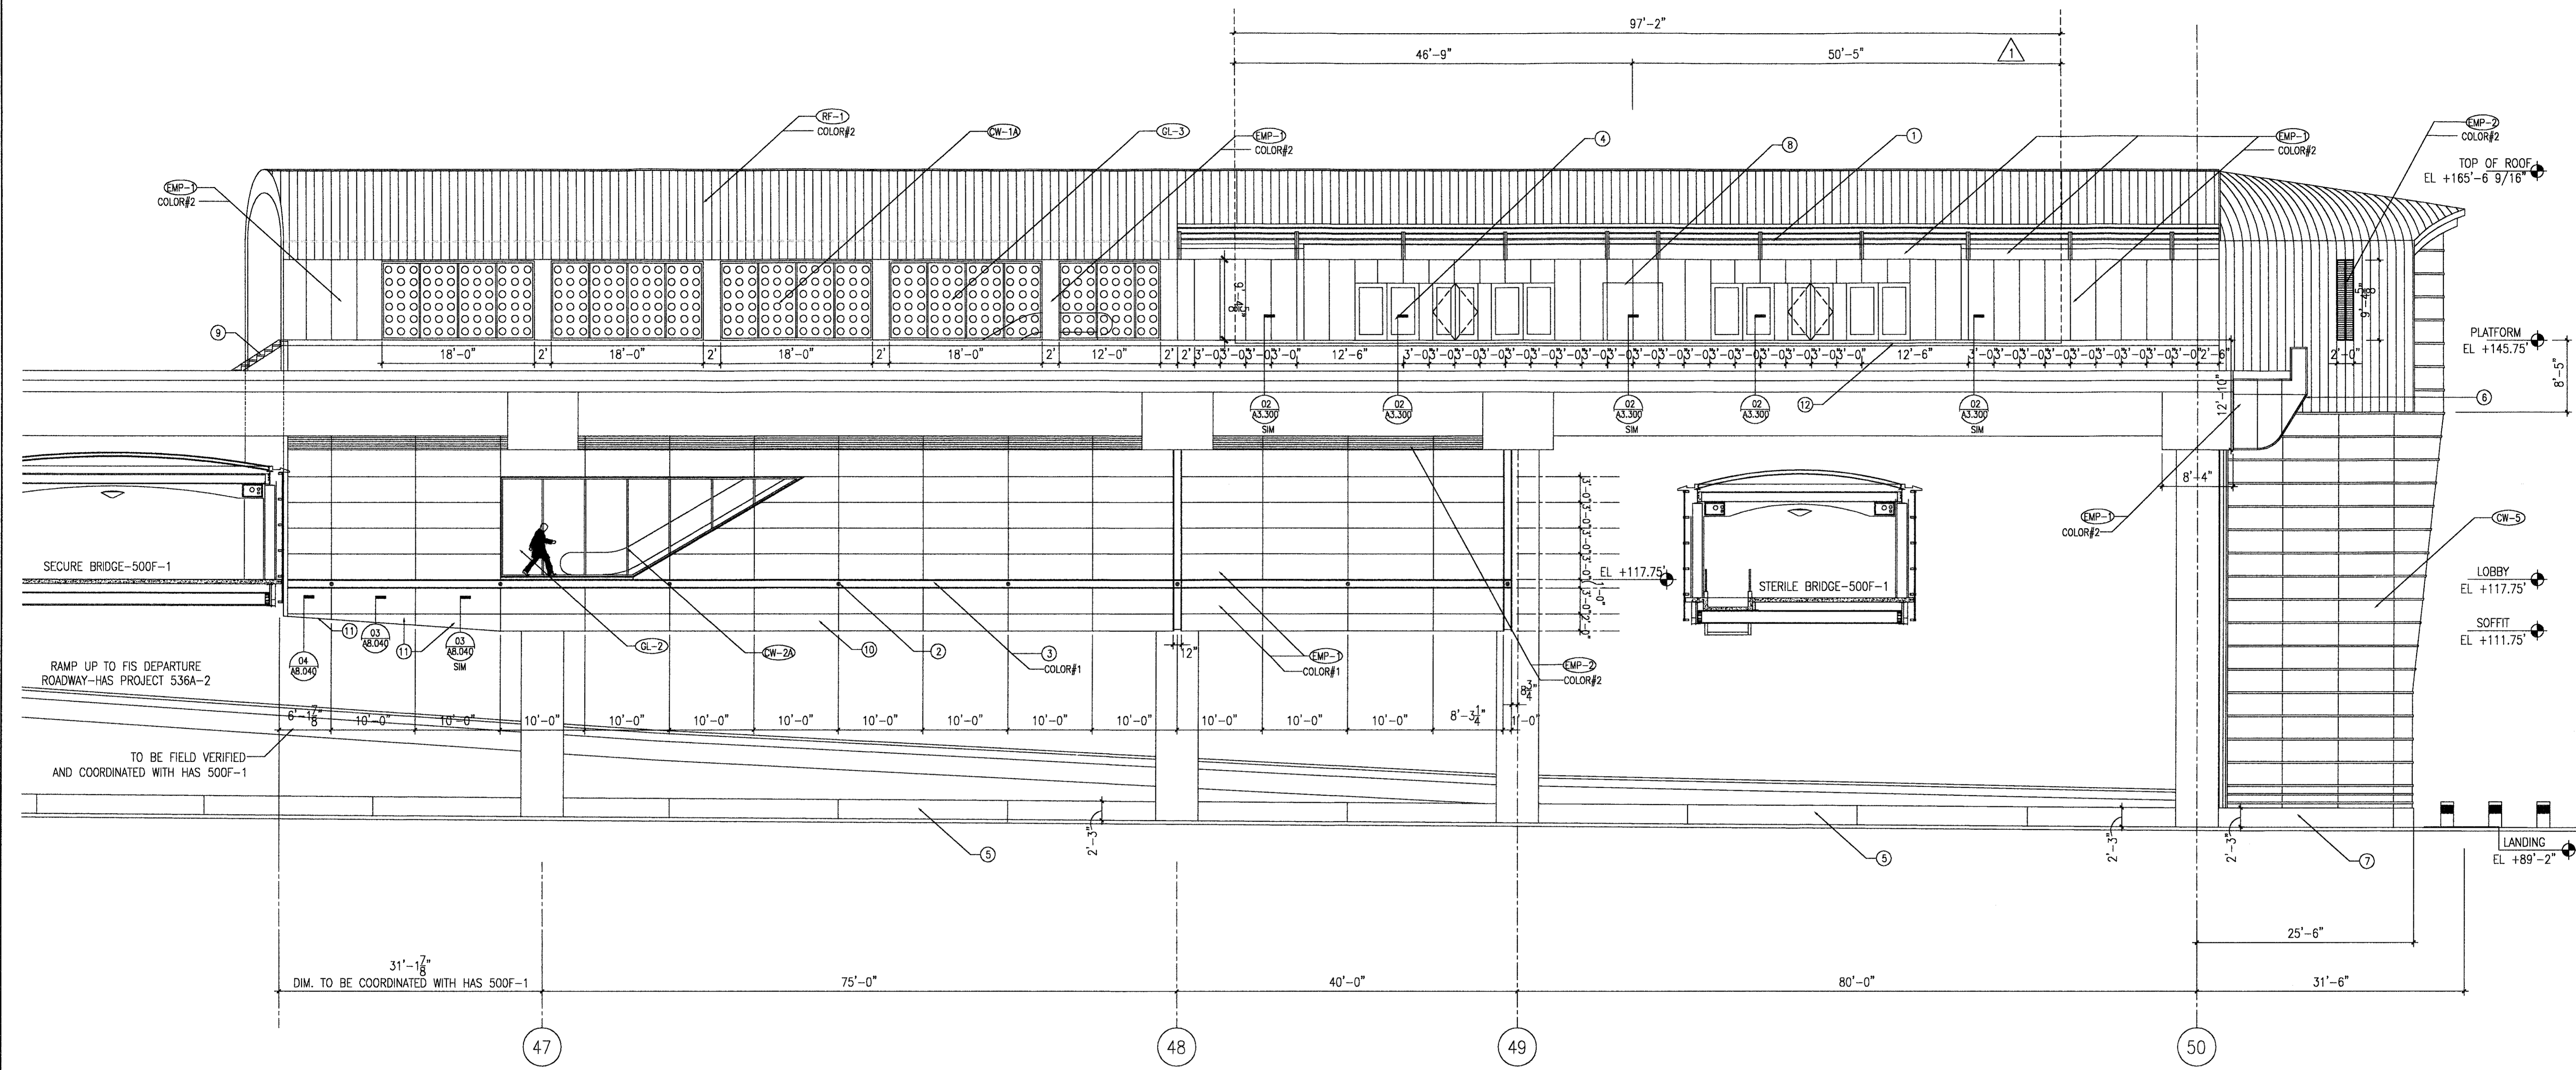

**01 SOUTH ELEVATION**  
 A3.501 1/8"=1'-0"


INTERNATIONAL SERVICES EXPANSION PROGRAM  
**APM STATION + PLATFORM**  
 SOUTH ELEVATION

**KEYED NOTES:**

- ① CANOPY ABOVE CARS
- ② BLUE SAFETY LIGHT - RE ELECTRICAL
- ③ 12" ALUMINUM CHANNEL POWDERCOATED COLOR#1
- ④ STATION SLIDING DOOR N.I.C. HAS PROJECT 5360
- ⑤ PRECAST CONCRETE WALL BTW 10' CONC. COLUMNS - N.I.C. - HAS PROJECT 536A-2
- ⑥ BUFFER'S STRUCTURE - METAL CLAD
- ⑦ 2'-3" HIGH C.I.P. CONCRETE WALL @ STAIR#2 - ARCHITECTURAL CONCRETE
- ⑧ SOFFIT BETWEEN DOORS: EXTERIOR ALUMINUM PANEL TYPE EMP-1
- ⑨ STAIR N.I.C. 536A-1
- ⑩ CURVED METAL PANEL TYPE EMP-1 R. 2'-0"
- ⑪ PARTIALLY CURVED PANEL WELDED TO FLAT PANEL @ SLOPED SOFFIT RE SHEET AB.040
- ⑫ STEEL ANGLE FOR THRESHOLD SUPPORT RE 02/A3.300

**GENERAL NOTES:**

- CW-1A** CURTAINWALL SYSTEM TYPE 1A - RE WINDOW SCHEDULE SHEET A2.850
- CW-1B** CURTAINWALL SYSTEM TYPE 1B - RE WINDOW SCHEDULE SHEET A2.850
- CW-2A** CURTAINWALL SYSTEM TYPE 2A - RE WINDOW SCHEDULE SHEET A2.850
- CW-2B** CURTAINWALL SYSTEM TYPE 2B - RE WINDOW SCHEDULE SHEET A2.850
- GL-2** 1" INSULATED GLAZING UNIT - INTERIOR AND EXTERIOR GLASS TEMPERED - RE GLASS SCHEDULE SHEET A2.850
- GL-3** 1" INSULATED GLAZING UNIT WITH FRIT, RE GLASS SCHEDULE SHEET A2.850
- EMP-1** EXTERIOR POWDERCOATED METAL WALL PANEL - ALUMINUM PANEL 1/8" THICK - TYPE SERIES 3000 MODIFIED FROM UNA-CLAD - COPPER SALES OR EQUAL POWDERCOATED KYNAR 500 - FOR COLOR RE SCHEDULE SHEET A2.800
- EMP-2** POWDERCOATED ALUMINUM LOUVERS - WITH INSECT MESH WHEN USED BY MECHANICAL - CLOSED WITH 1/8" THK ALUMINUM SHEET WELDED CONTINUOUSLY TO FRAME WHEN NOT USED BY MECHANICAL RE: MECHANICAL FOR OPENINGS
- RF-1** STANDING SEAM METAL ROOF - TYPE UC3 FROM UNA-CLAD - COPPER SALES OR EQUAL - WIDTH 1" - POWDERCOATED KYNAR 500 - COLOR#2 SILVER METALLIC
- CW-5** INTEGRATED STRUCTURAL CURTAIN WALL SYSTEM TYPE 5 - RE WINDOW SCHEDULE SHEET A2.850

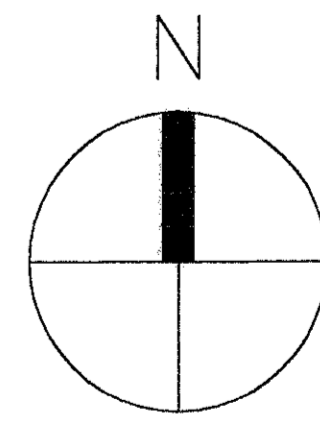


**RECORD DRAWINGS**  
 DO NOT MODIFY  
 Rey de la Reza Architects, Inc.  
 13 May 2006

Note: Information used to develop these documents was taken from Record of the Work Drawings prepared by the construction contractor, Cain Construction Group - Texas. The information provided by the contractor was not verified by the design firm named above.

NOTE: REFER TO GRAPHIC SCALE IF ACTUAL SHEET SIZE IS OTHER THAN 30"x42".

SCALE: 1/8" = 1'-0"

PROJECT MGR: HEM  
 DESIGNER: SG  
 DRAWN BY: SEM  
 CHECKED BY: AB  
 DRAWING STANDARD: ISEP 07.20.2000  
 SCALE: 1/8"=1'-0"  
 DATE: 09/14/01

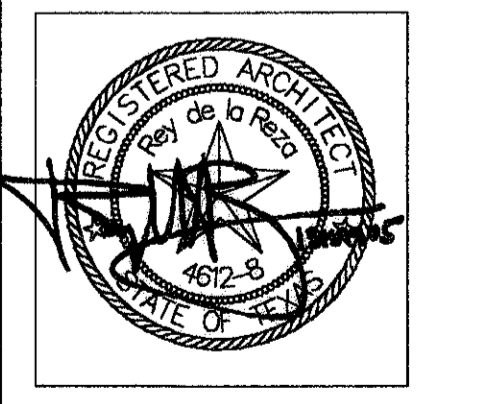

APPROVED BY: \_\_\_\_\_ DATE: \_\_\_\_\_  
 DIRECTOR  
 HOUSTON AIRPORT SYSTEM

PROJECT NO. 1140  
 C.I.P. NO. A-0354  
 H.A.S. NO. 536C  
 SHEET NO. 34

**A3.501**




REVISIONS		
NO.	DESCRIPTION	DATE
1	ISSUED FOR BID	10/19/01
2	ADDENDUM 1	02/01/02 SG
3	RECORD SET	05/13/05 EM

INTERNATIONAL SERVICES • EXPANSION • PROGRAM  
**APM STATION + PLATFORM**  
 WEST + EAST ELEVATIONS

PROJECT MGR: HEM  
 DESIGNER: SG  
 DRAWN BY: SEM  
 CHECKED BY: AB  
 DRAWING STANDARD: SEP 07.20.2000

SCALE: 1/8"=1'-0"  
 DATE: 06/14/01

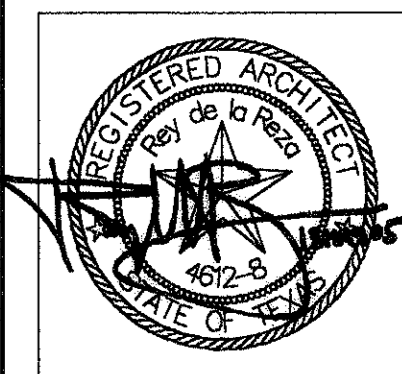

APPROVED BY: DATE:

DIRECTOR  
 HOUSTON AIRPORT SYSTEM

PROJECT NO. 1140

C.I.P. NO. A-0364

H.A.S. NO. 536C

SHEET NO.


33 **A3.600**

**GENERAL NOTES:**


- (CW-4) CURTAIN WALL SYSTEM  
TYPE 4 - RE WINDOW SCHEDULE SHEET A2.850
- (CW-5) CURTAIN WALL SYSTEM  
TYPE 5 - RE WINDOW SCHEDULE SHEET A2.850
- (EMP-1) EXTERIOR POWDERCOATED METAL WALL PANEL - ALUMINUM PANEL 1/8" THICK - TYPE SERIES 3000 MODIFIED FROM UNA-CLAD - COPPER SALES OR EQUAL. POWDERCOATED KYNAR 500 - FOR COLOR RE. SCHEDULE SHEET A2.800
- (RF-1) STANDING SEAM METAL ROOF - TYPE UC3 FROM UNA-CLAD - COPPER SALES OR EQUAL - WIDTH 1' - POWDERCOATED KYNAR 500 - COLOR#2 SILVER METALLIC

**KEYED NOTES:**

- ① EXT. CLADDING - PERFORMED POWDERCOATED METAL SHEET - COLOR#2
- ② 2'-3" HIGH C.I.P. CONCRETE WALL - ARCHITECTURAL CONCRETE
- ③ RIGID HONEYCOMBED ALUMINUM PANEL 1/2" THICK - POWDERCOATED COLOR #2
- ④ PRECAST CONCRETE WALL BTW 10' CONC. COLUMNS - N.I.C. - HAS PROJECT 536A-2
- ⑤ PAVING N.I.C. - HAS LANDSCAPING PROJECT
- ⑥ STEEL GUARDRAIL - SIMILAR TO GUARDRAIL @ STAIR#2 - PAINT COLOR#2
- ⑦ SCHEDULE LIGHT FIXTURE - RE ELECTRICAL

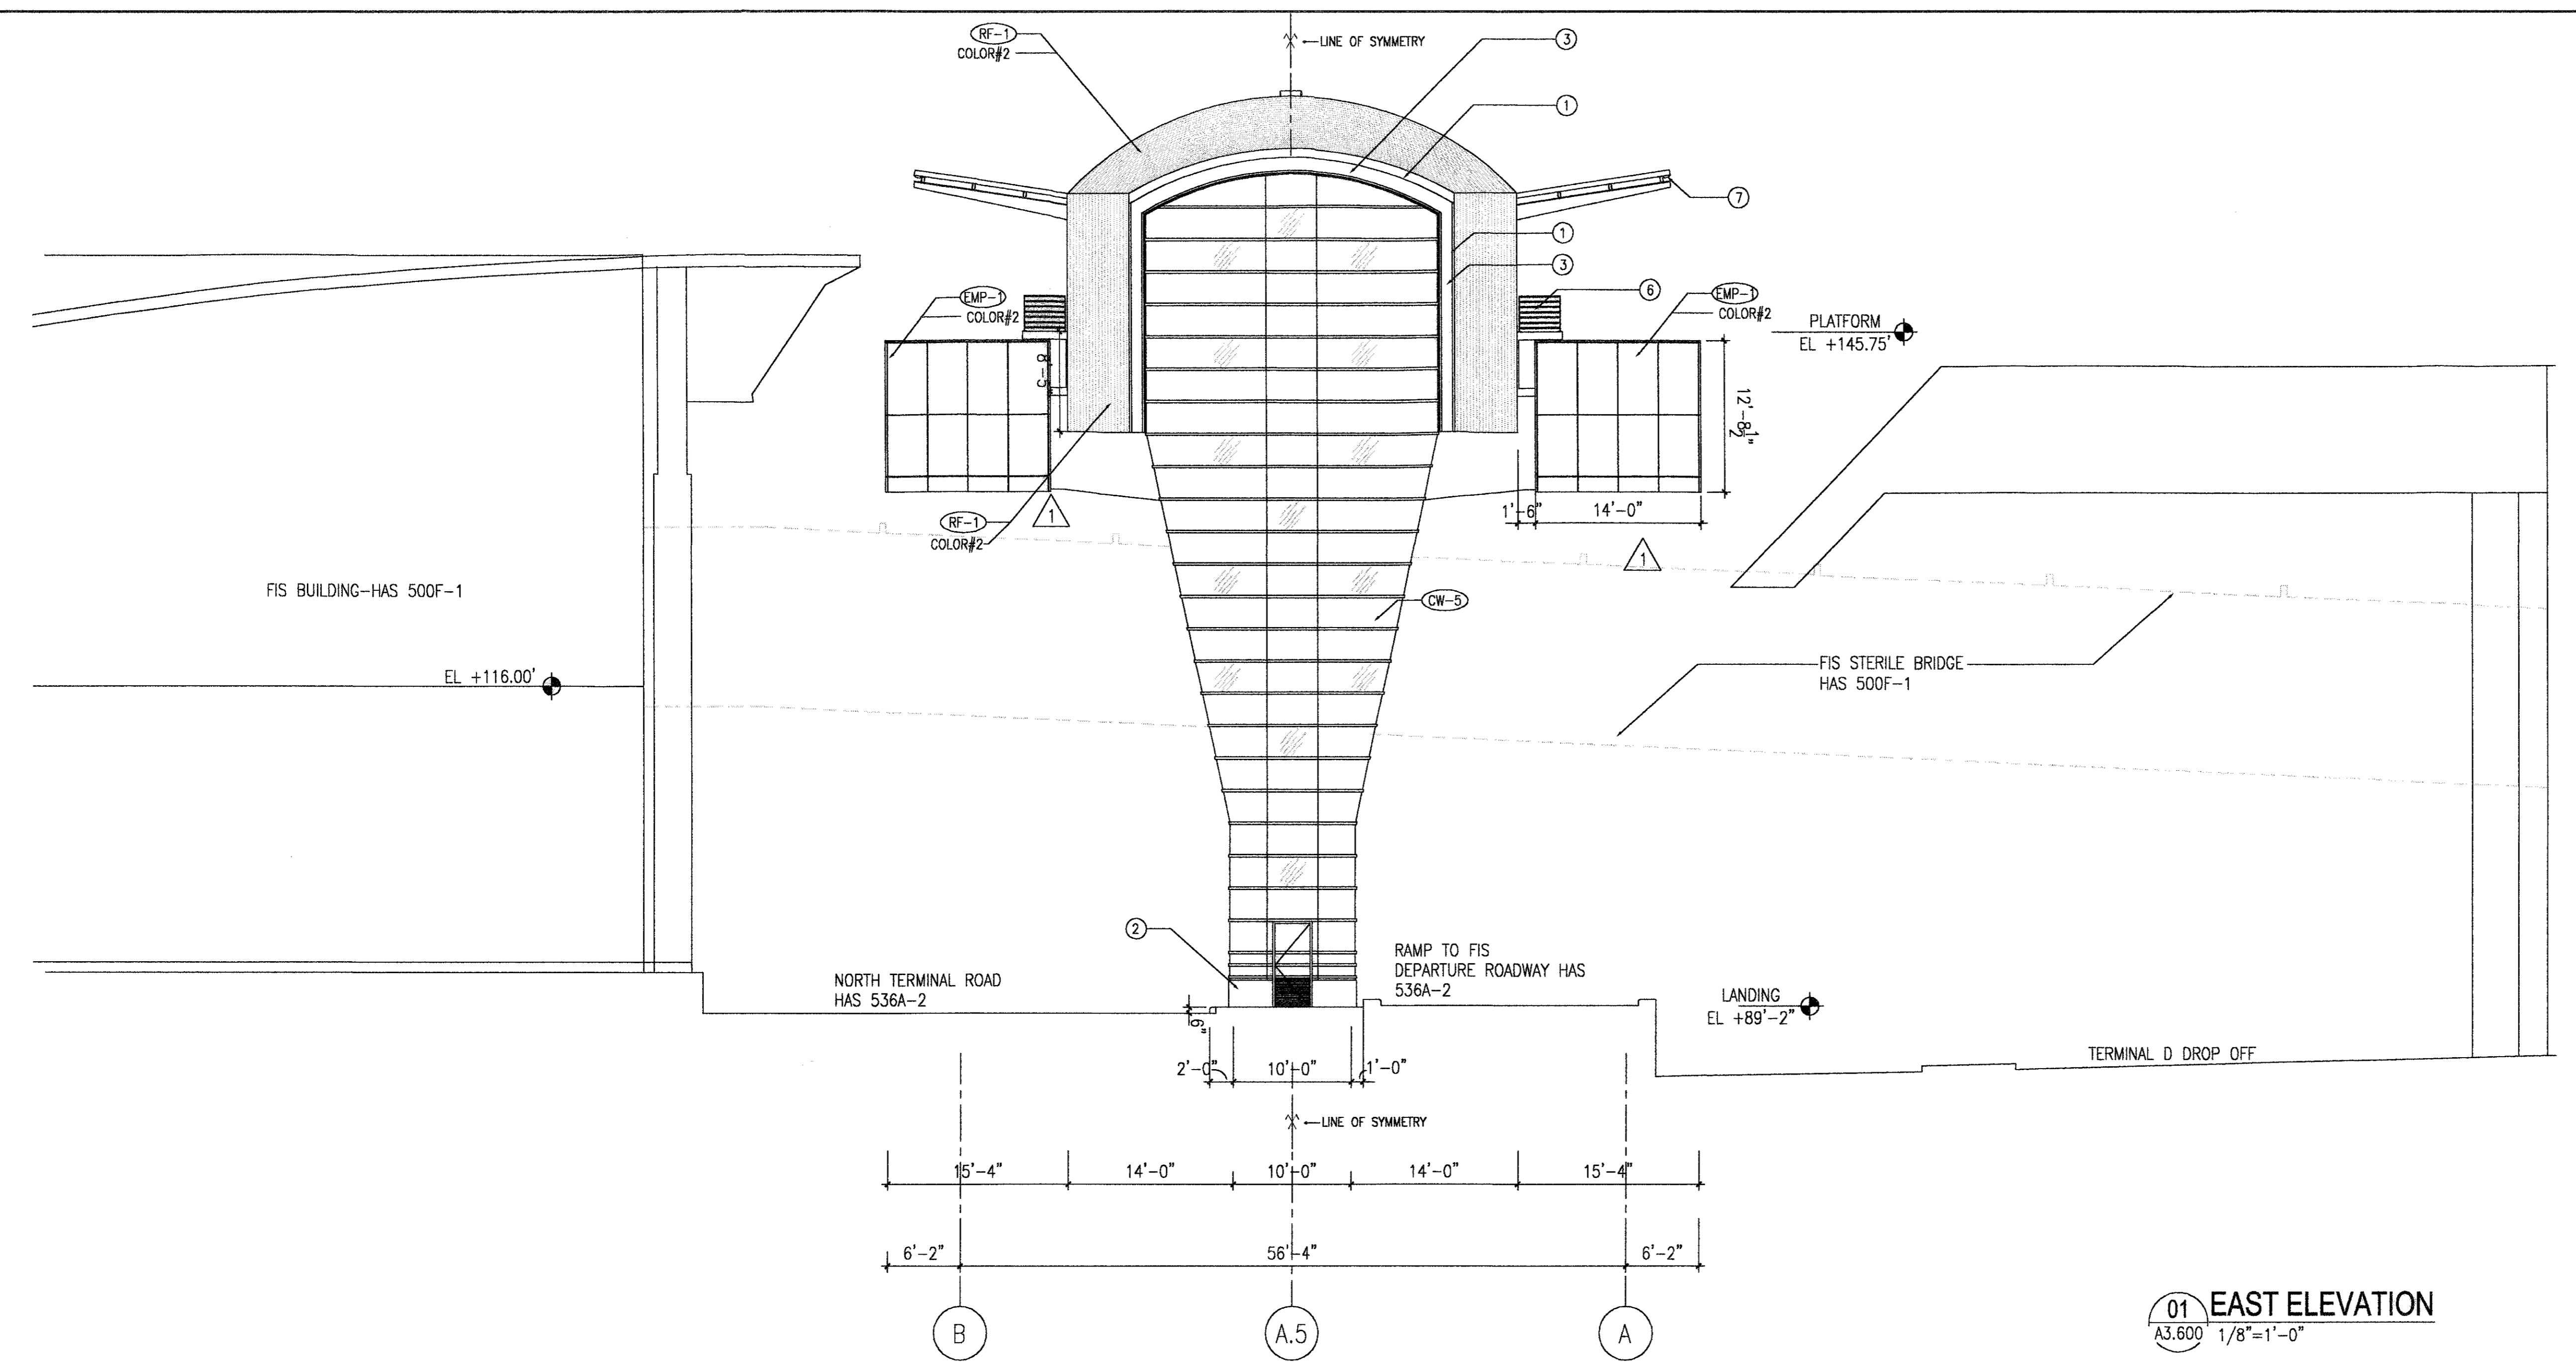

**01 EAST ELEVATION**  
 A3.600 1/8"=1'-0"

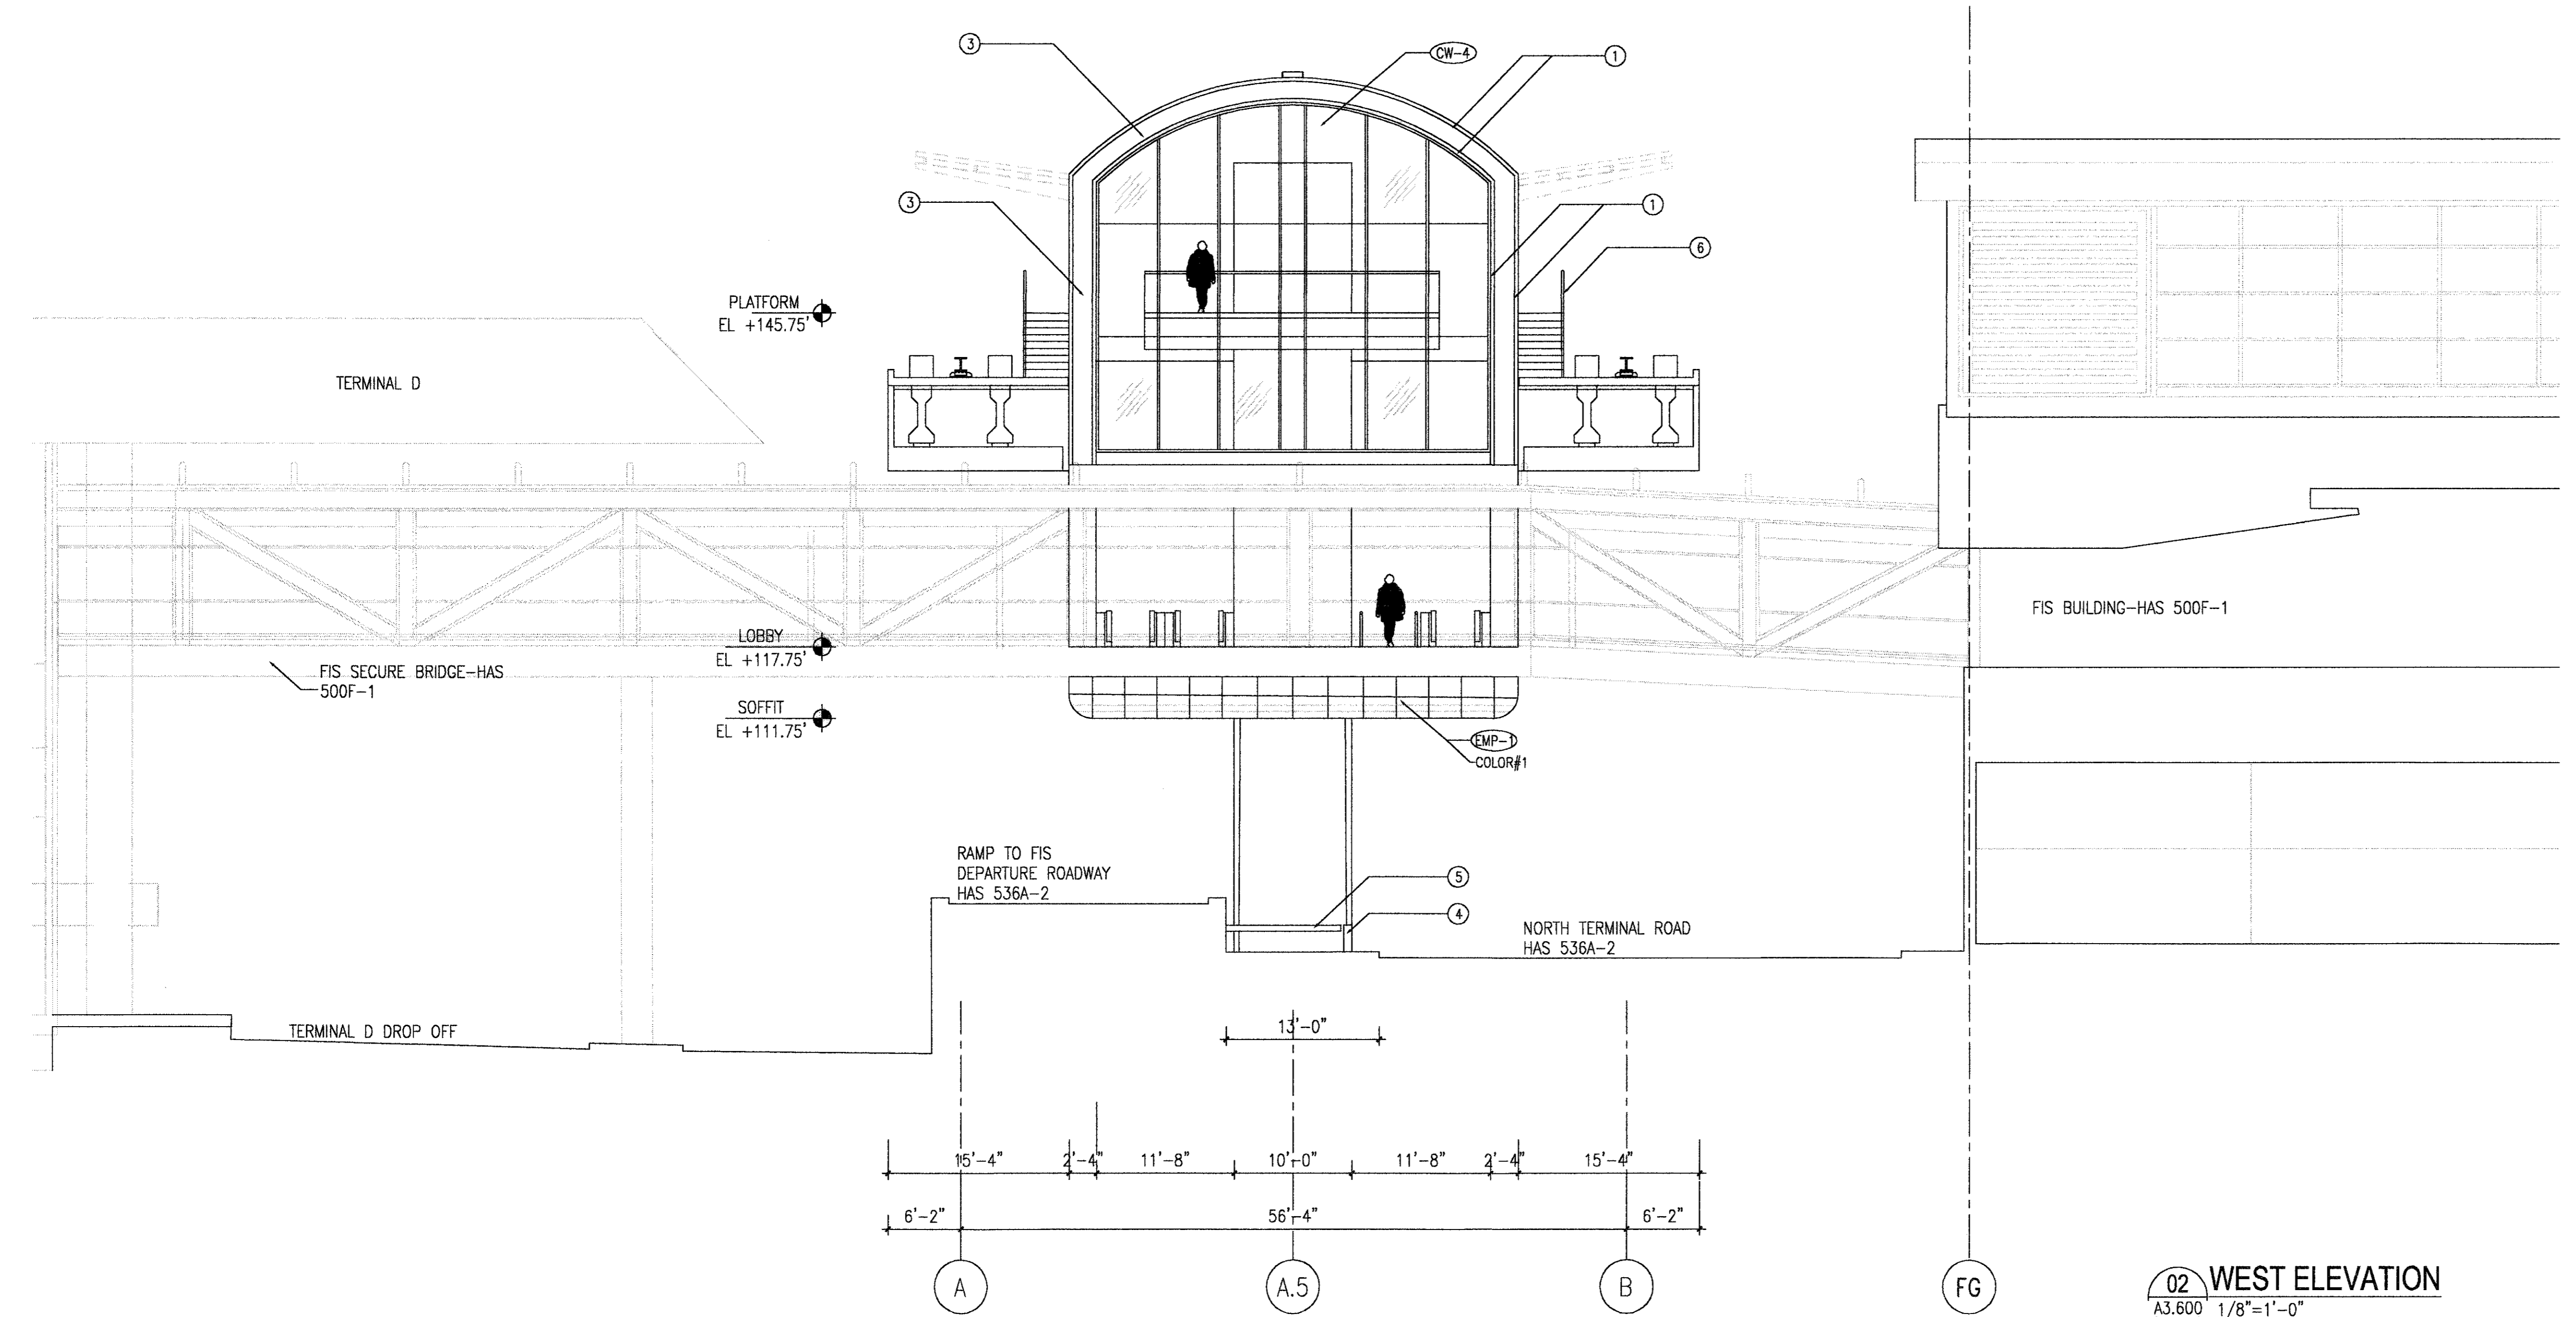

**02 WEST ELEVATION**  
 A3.600 1/8"=1'-0"




**RECORD DRAWINGS**  
 DO NOT MODIFY  
 Rey de la Reza Architects, Inc.  
 13 May 2005  
 Note: Information used to develop these documents was taken from Record of the Work Drawings prepared by the construction contractor, Cash Construction Group - Texas. The information provided by the contractor was not verified by the design firm named above.

NOTE: REFER TO GRAPHIC SCALE IF ACTUAL SHEET SIZE IS OTHER THAN 30"x42".  
 0' 4' 8' 16' 24'  
 SCALE: 1/8" = 1'-0"

PLOT DATE: 02/04/02 HAS FILE: A3.600.A3.600



NO.	DESCRIPTION	DATE	BY
ISSUED FOR BID	10/19/01		
ADDENDUM 1	02/01/02	SG	
RECORD SET	05/13/05	EM	

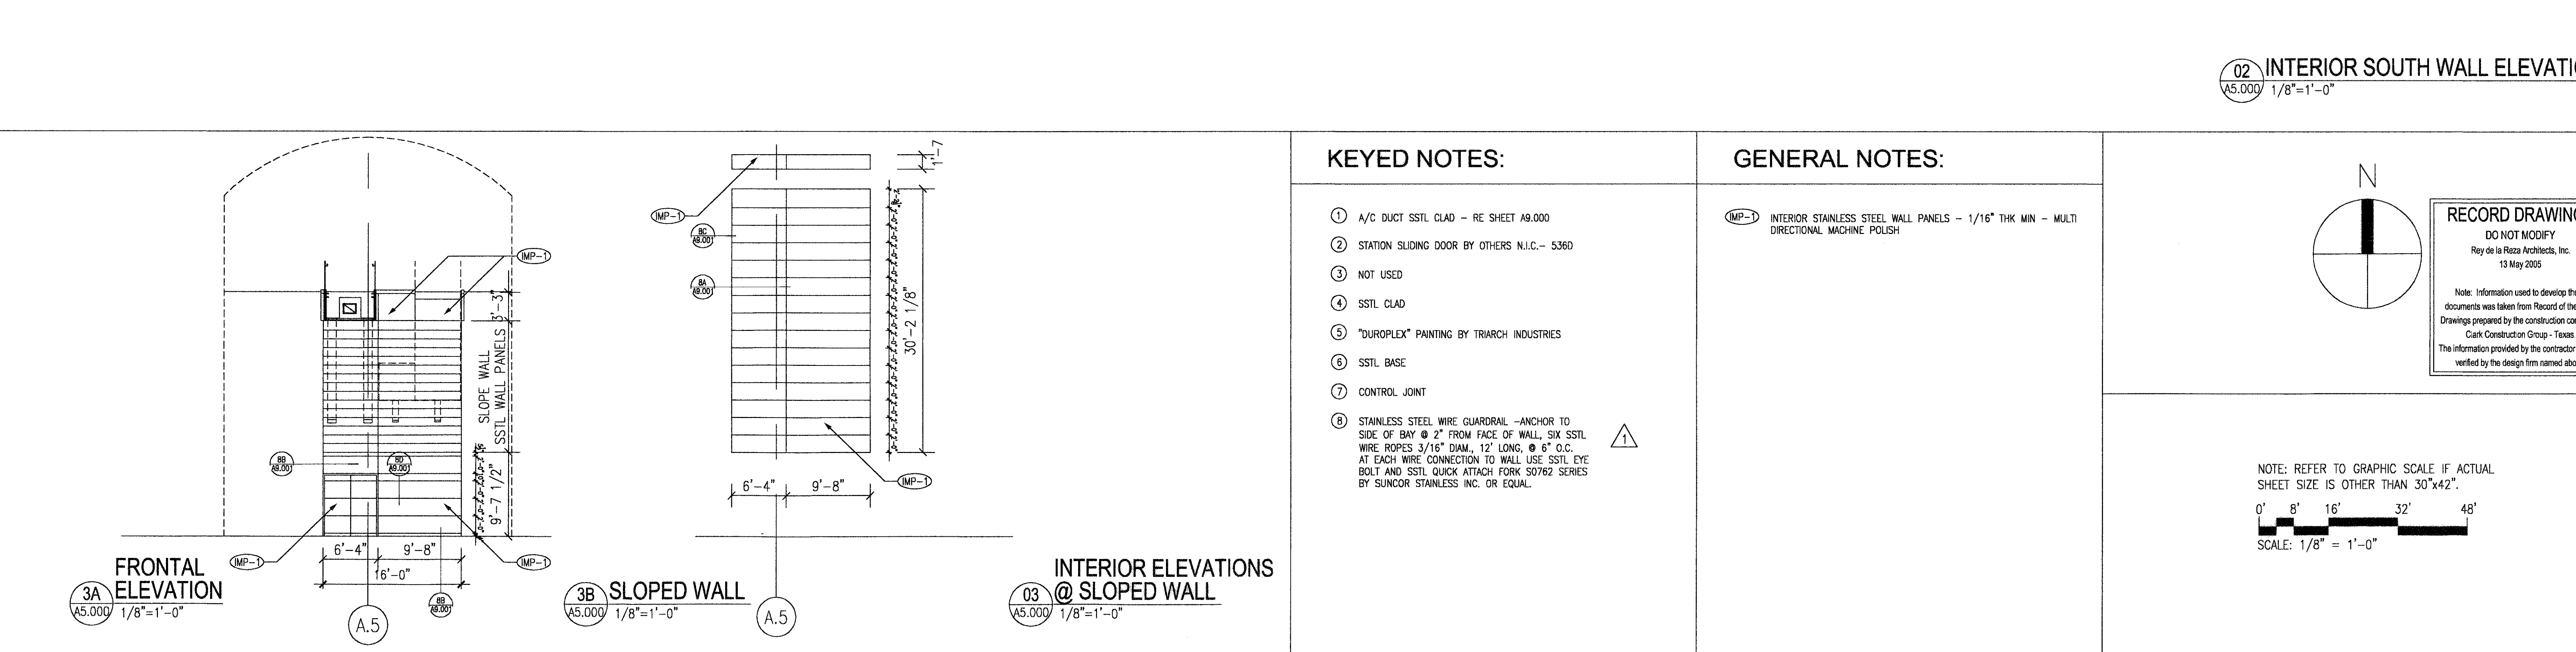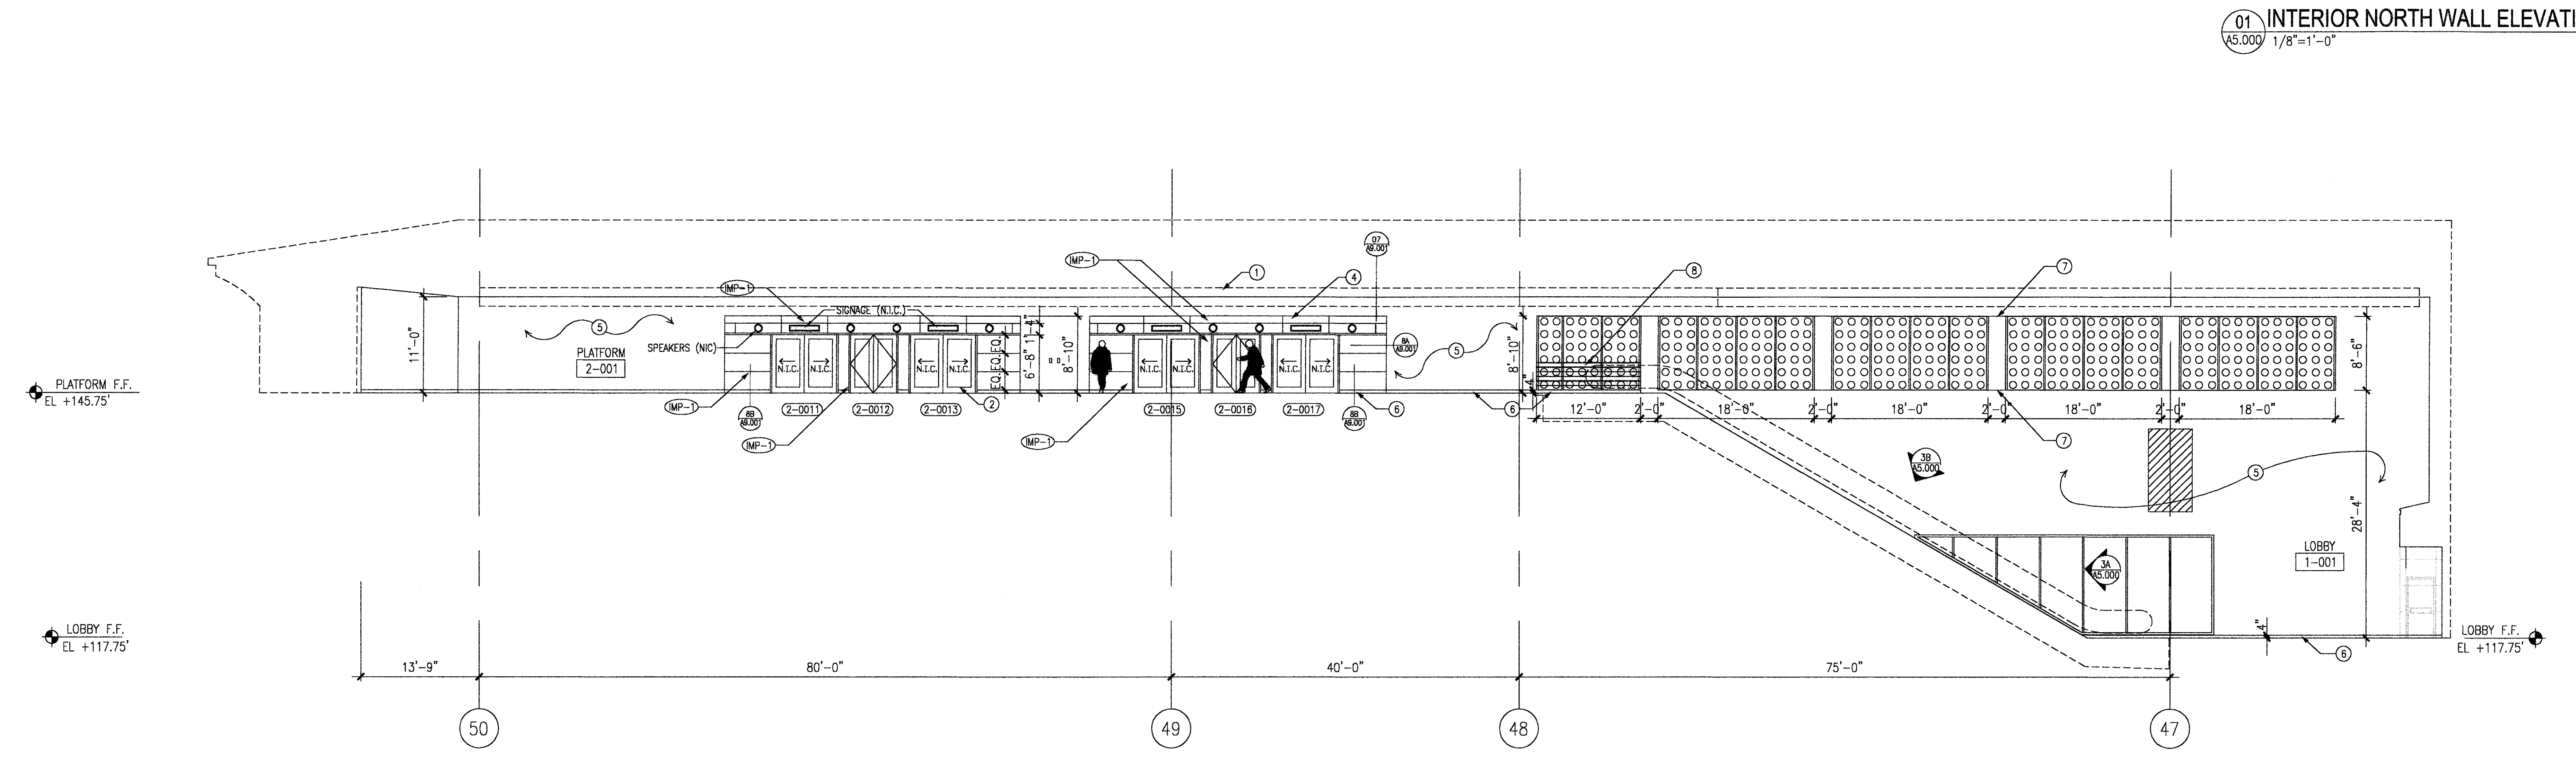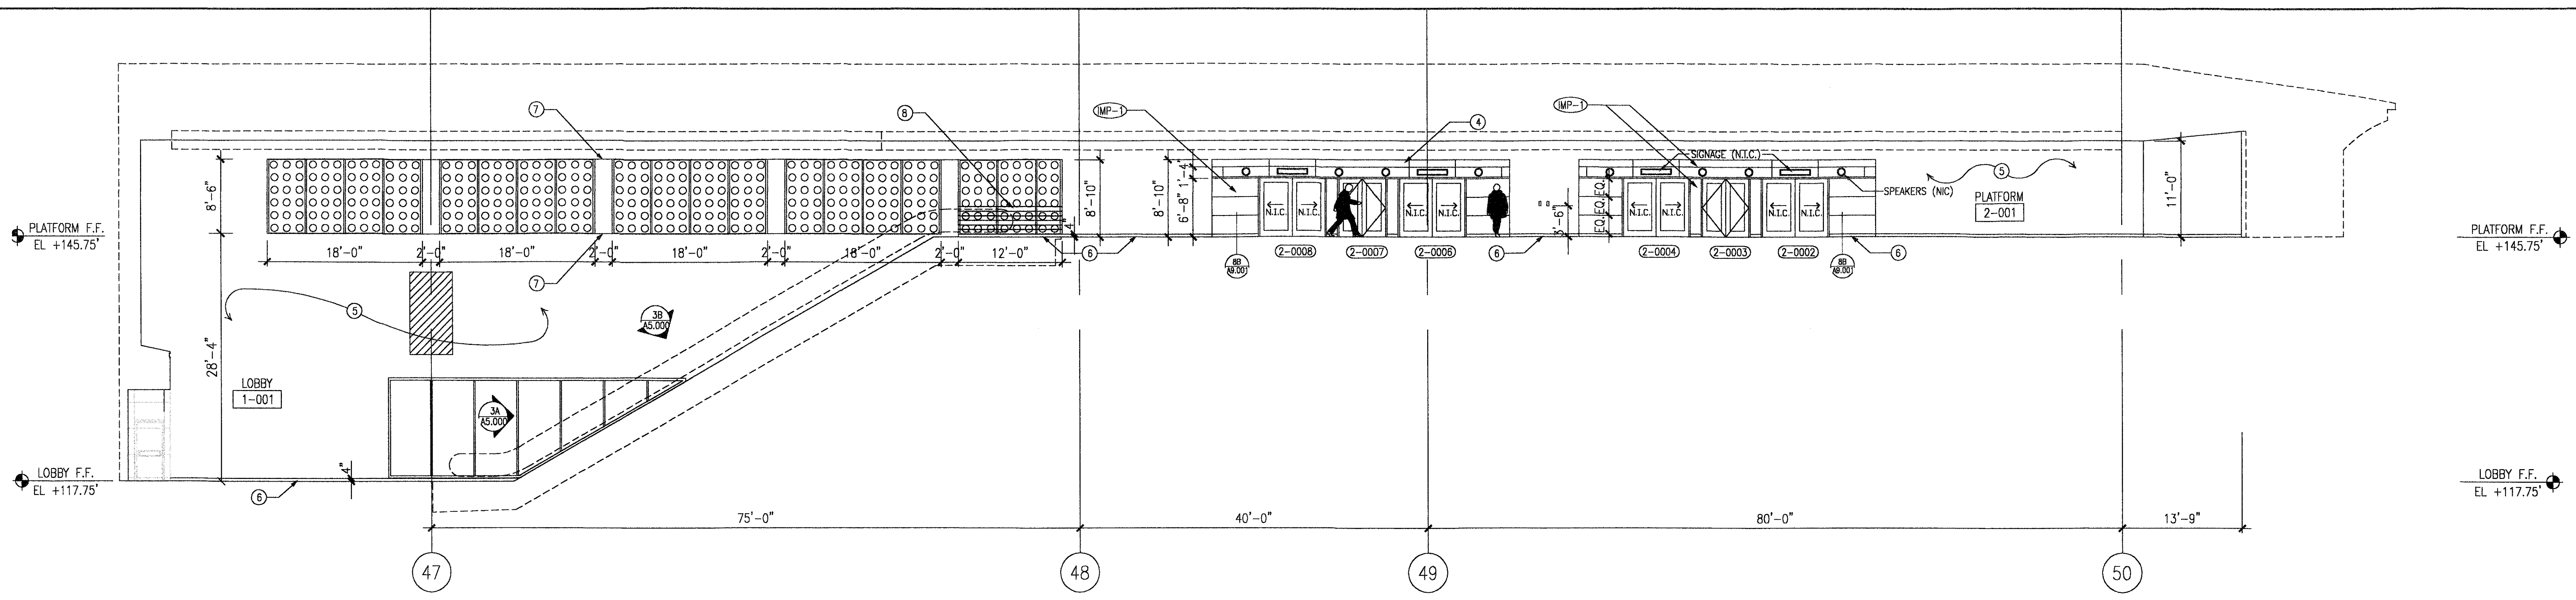


KEYED NOTES:

- 1 A/C DUCT SSTL CLAD - RE SHEET A9.000
- 2 STATION SLIDING DOOR BY OTHERS N.I.C. - 536D
- 3 NOT USED
- 4 SSTL CLAD
- 5 "DUROPLEX" PAINTING BY TRIARCH INDUSTRIES
- 6 SSTL BASE
- 7 CONTROL JOINT
- 8 STAINLESS STEEL WIRE GUARDRAIL - ANCHOR TO SIDE OF BAY @ 2" FROM FACE OF WALL, SIX SSTL WIRE ROPES 3/16" DIAM, 12' LONG, @ 6" O.C. AT EACH WIRE CONNECTION TO WALL USE SSTL EYE BOLT AND SSTL QUICK ATTACH FORK S0762 SERIES BY SUNCOR STAINLESS INC. OR EQUAL.


GENERAL NOTES:

(MP-1) INTERIOR STAINLESS STEEL WALL PANELS - 1/16" THK MIN - MULTI DIRECTIONAL MACHINE POUISH

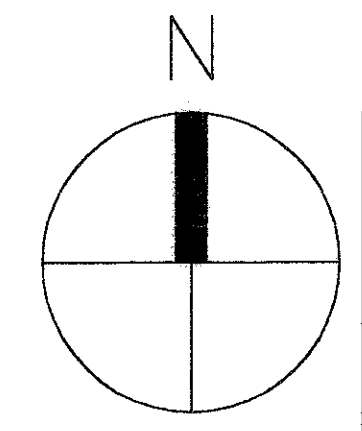

**RECORD DRAWINGS**  
DO NOT MODIFY  
Rey de la Riza Architects, Inc.  
13 May 2005

Note: Information used to develop these documents was taken from Record of the Work.  
Drawings prepared by the construction contractor, Clark Construction Group - Texas.  
The information provided by the contractor was not verified by the design firm named above.

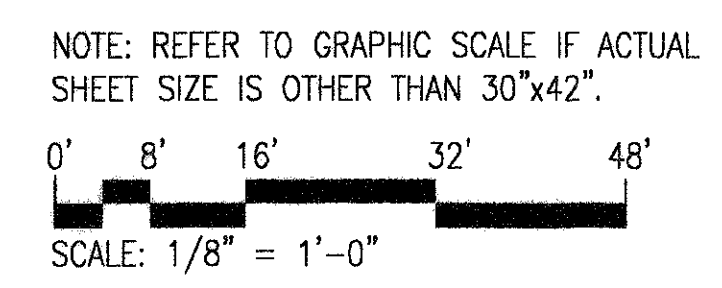

INTERNATIONAL SERVICES • EXPANSION • PROGRAM

**APM STATION + PLATFORM**

INTERIOR ELEVATIONS


PROJECT MGR: MEM  
DESIGNER: SG  
DRAWN BY: SEM  
CHECKED BY: AB  
DRAWING STANDARD: ISEP 07.20.2000  
SCALE: 1/8" = 1'-0"  
DATE: 05/14/01

APPROVED BY: \_\_\_\_\_ DATE: \_\_\_\_\_  
DIRECTOR  
HOUSTON AIRPORT SYSTEM

PROJECT NO. 1140  
C.I.P. NO. A-0364  
H.A.S. NO. 536C  
SHEET NO. 3/6 **A5.000**



REVISIONS			
NO.	DESCRIPTION	DATE	BY
ISSUED FOR BID		10/19/01	
RECORD SET		05/13/05	EM

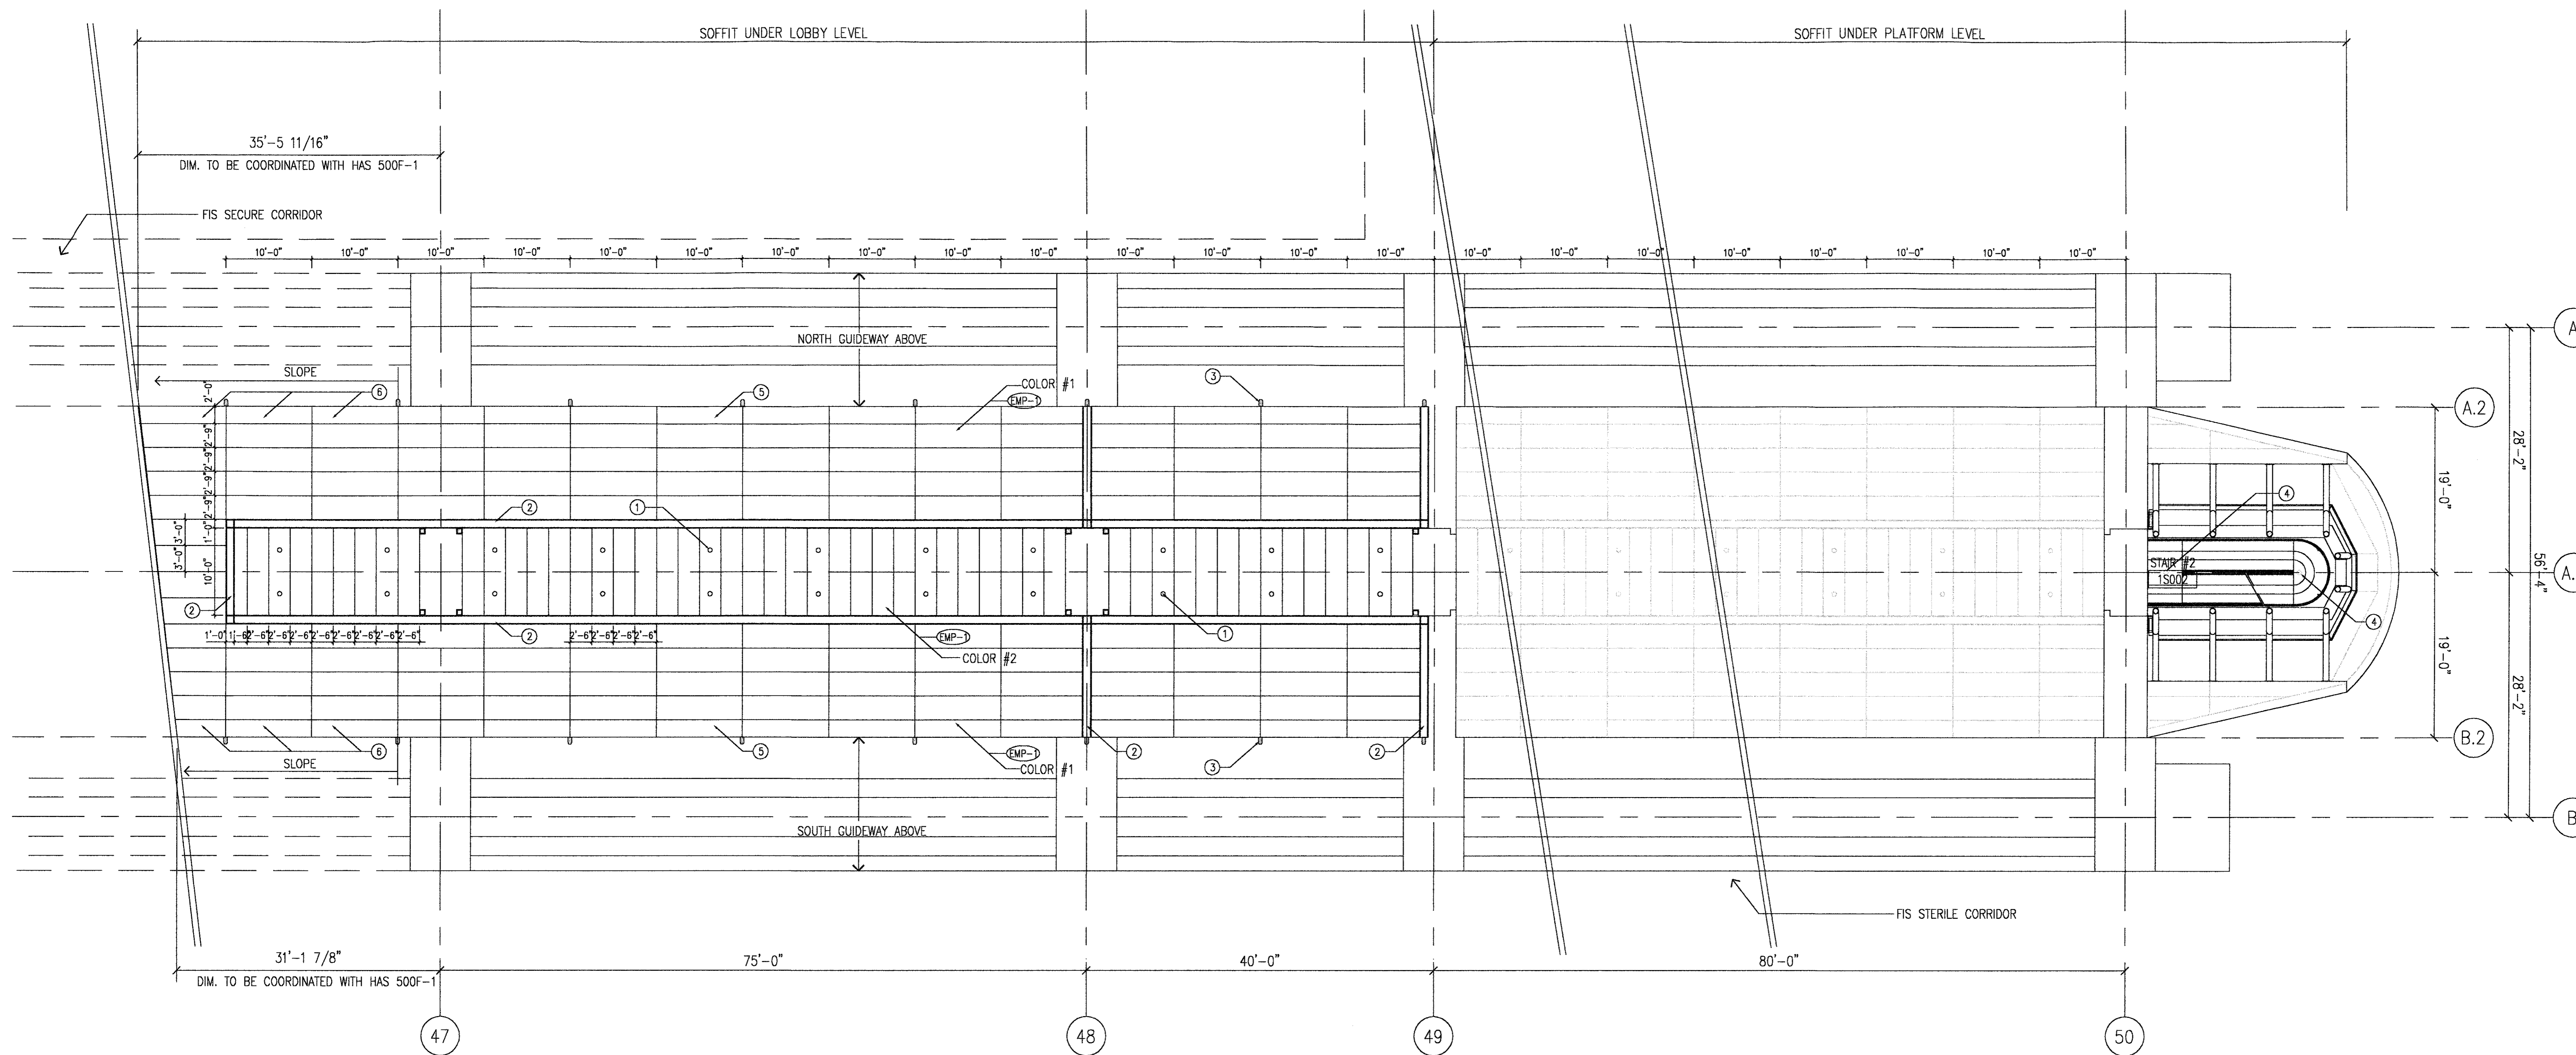

**01 REFLECTED CEILING PLAN @ GROUND LEVEL**  
 A6.000 1/8" = 1'-0"


INTERNATIONAL SERVICES • EXPANSION • PROGRAM  
**APM STATION + PLATFORM**  
 REFLECTED CEILING PLAN • GROUND LEVEL

**KEYED NOTES:**

- ① DOWNLIGHT - RE: ELECTRICAL
- ② 12" ALUMINUM CHANNEL POWDERCOATED - KYNAR 500 - COLOR #1
- ③ BLUE SAFETY LIGHT - RE: ELECTRICAL
- ④ SCHEDULE LIGHT FIXTURE UNDER STAIR LANDING - RE: ELECTRICAL
- ⑤ CURVED PANELS TYPE EMP-1 R. 2'-0"
- ⑥ PARTIALLY CURVED PANEL WELD TO FLAT PANEL @ SLOPE SOFFIT RE: A6.040

**GENERAL NOTES:**

- OVERALL DIMENSIONS @ SECURE BRIDGE TO BE COORDINATED WITH HAS PROJECT 500F-1 - AND FIELD VERIFIED
- EMP-3 EXTERIOR POWDERCOATED METAL WALL PANEL - ALUMINUM PANEL 1/8" THICK - TYPE SERIES 3000 MODIFIED FROM UNA-CLAD - COPPER SALES OR EQUAL  
 POWDERCOATED KYNAR 500 - FOR COLOR RE SCHEDULE SHEET A2.800

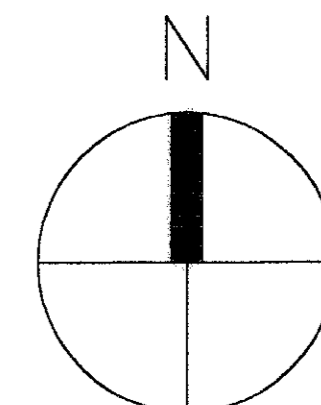


**RECORD DRAWINGS**  
 DO NOT MODIFY  
 Ray de la Reza Architects, Inc.  
 13 May 2005  
 Note: Information used to develop these documents was taken from Record of the Work. Drawings prepared by the construction contractor, Clark Construction Group - Texas. The information provided by the contractor was not verified by the design firm named above.

NOTE: REFER TO GRAPHIC SCALE IF ACTUAL SHEET SIZE IS OTHER THAN 30"x42".  
 0' 4' 8' 16' 24'  
 SCALE: 1/8" = 1'-0"

PROJECT MGR:	HEM
DESIGNER:	SC
DRAWN BY:	SEM
CHECKED BY:	AB
DRAWING STANDARD:	ISEP 07.20.2000

SCALE: 1/8" = 1'-0"  
 DATE: 09/14/01

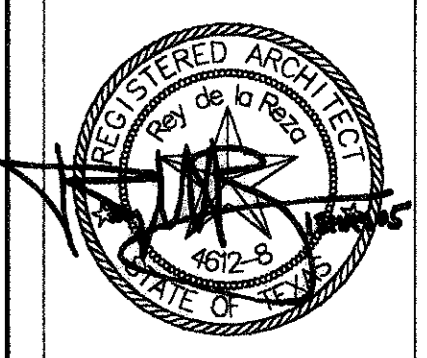


APPROVED BY: DATE:

PROJECT NO. 1140  
 C.I.P. NO. A-0354  
 H.A.S. NO. 536C  
 SHEET NO.


**A6.000**



REVISIONS			
NO.	DESCRIPTION	DATE	BY
1	ISSUED FOR BID	10/19/01	

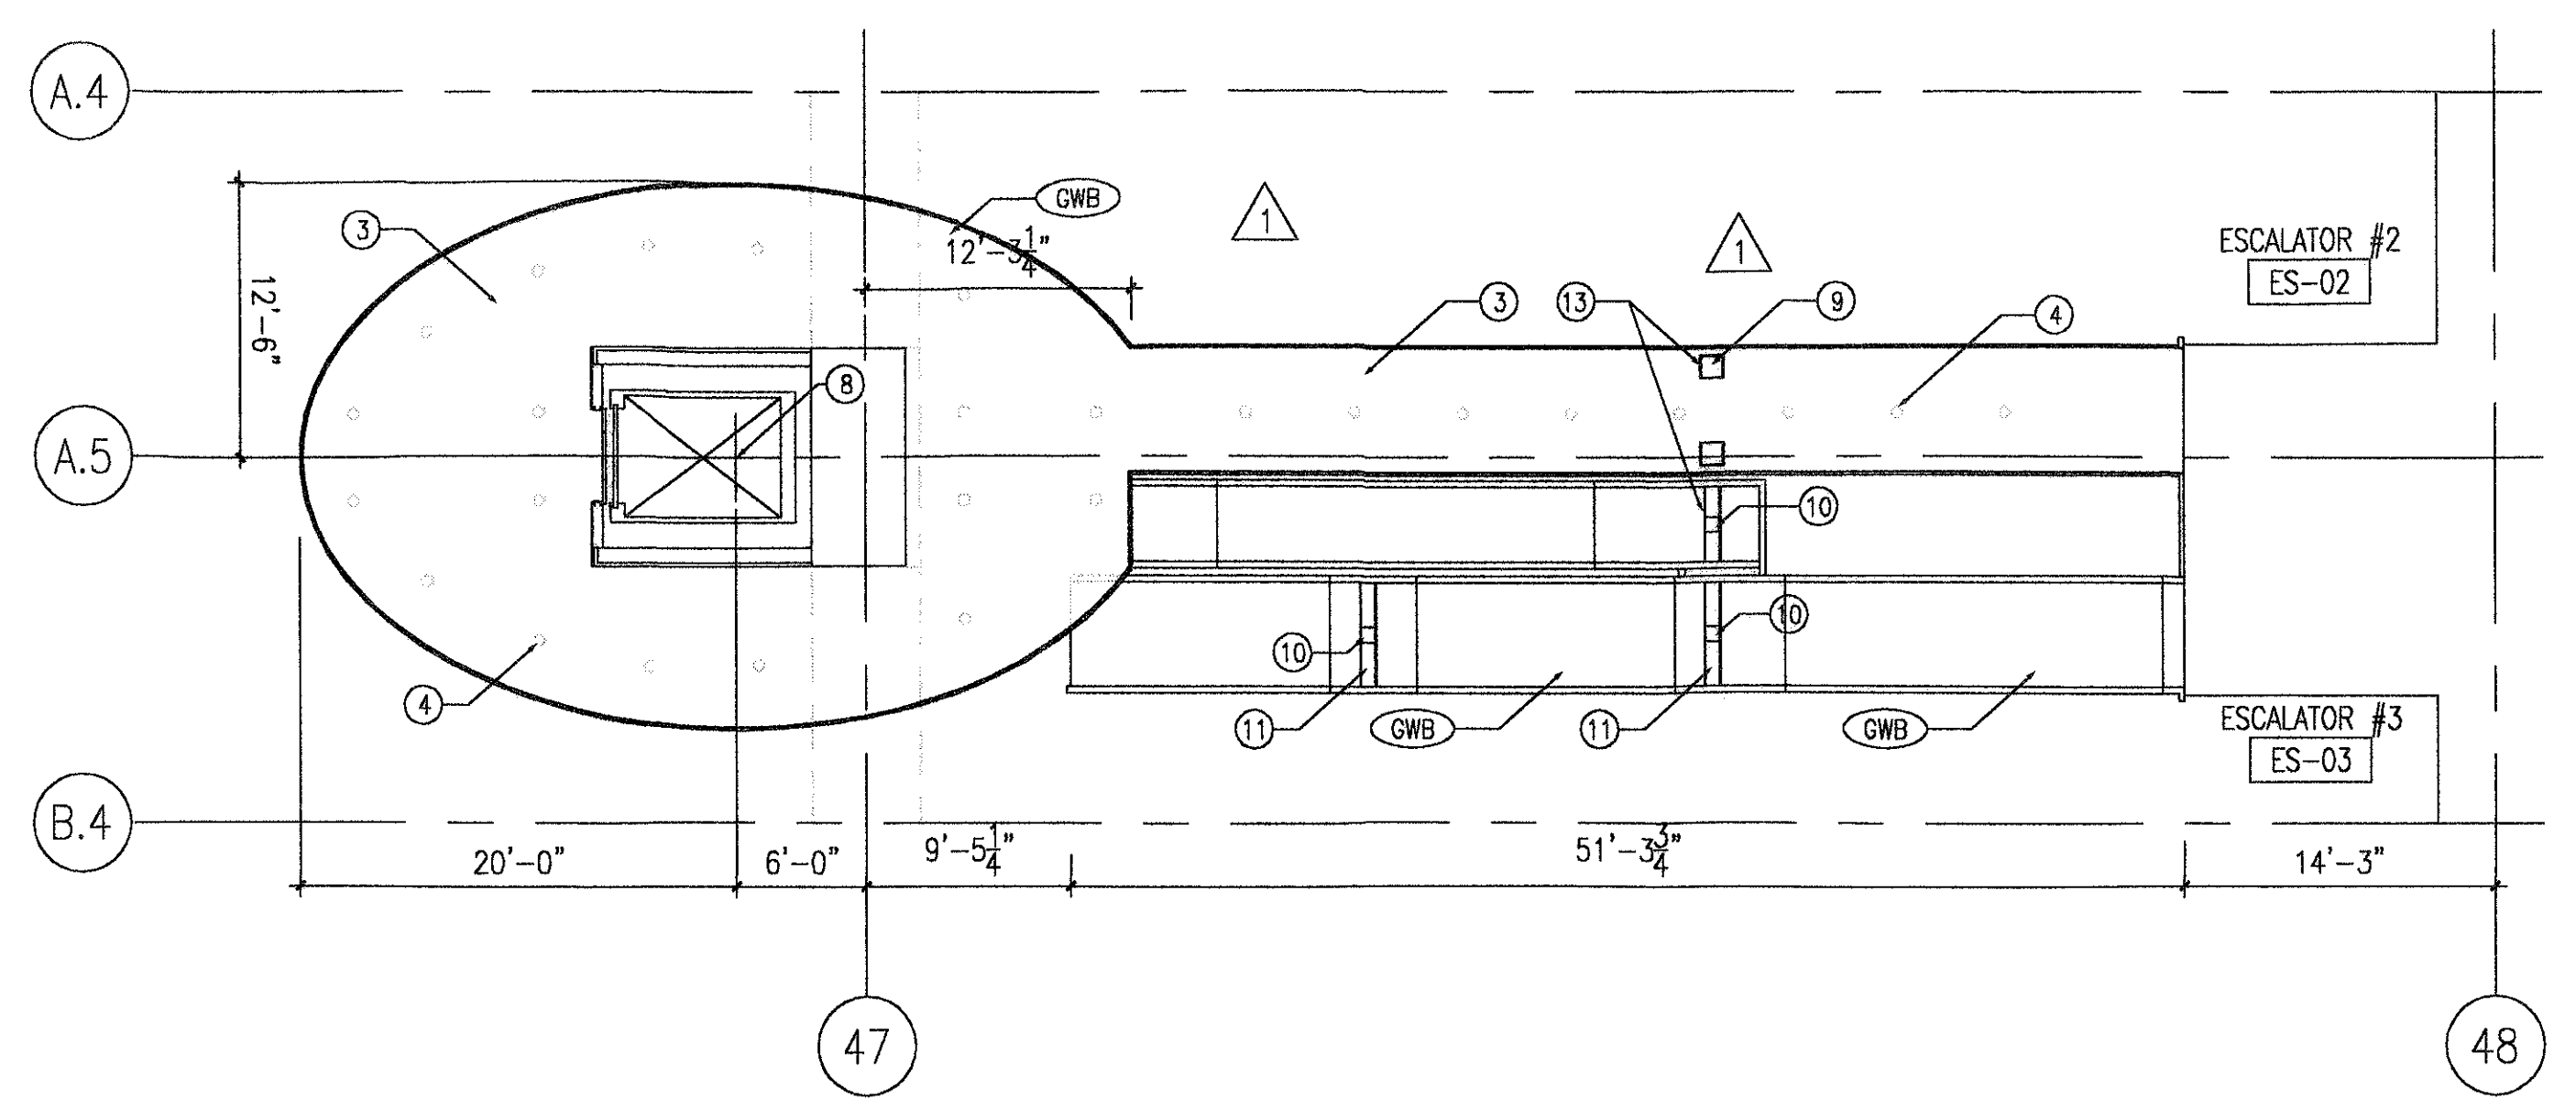

**CEILING @ BALCONY, CATWALK AND STAIRS**  
 02  
 A6.100 1/8"=1'-0"

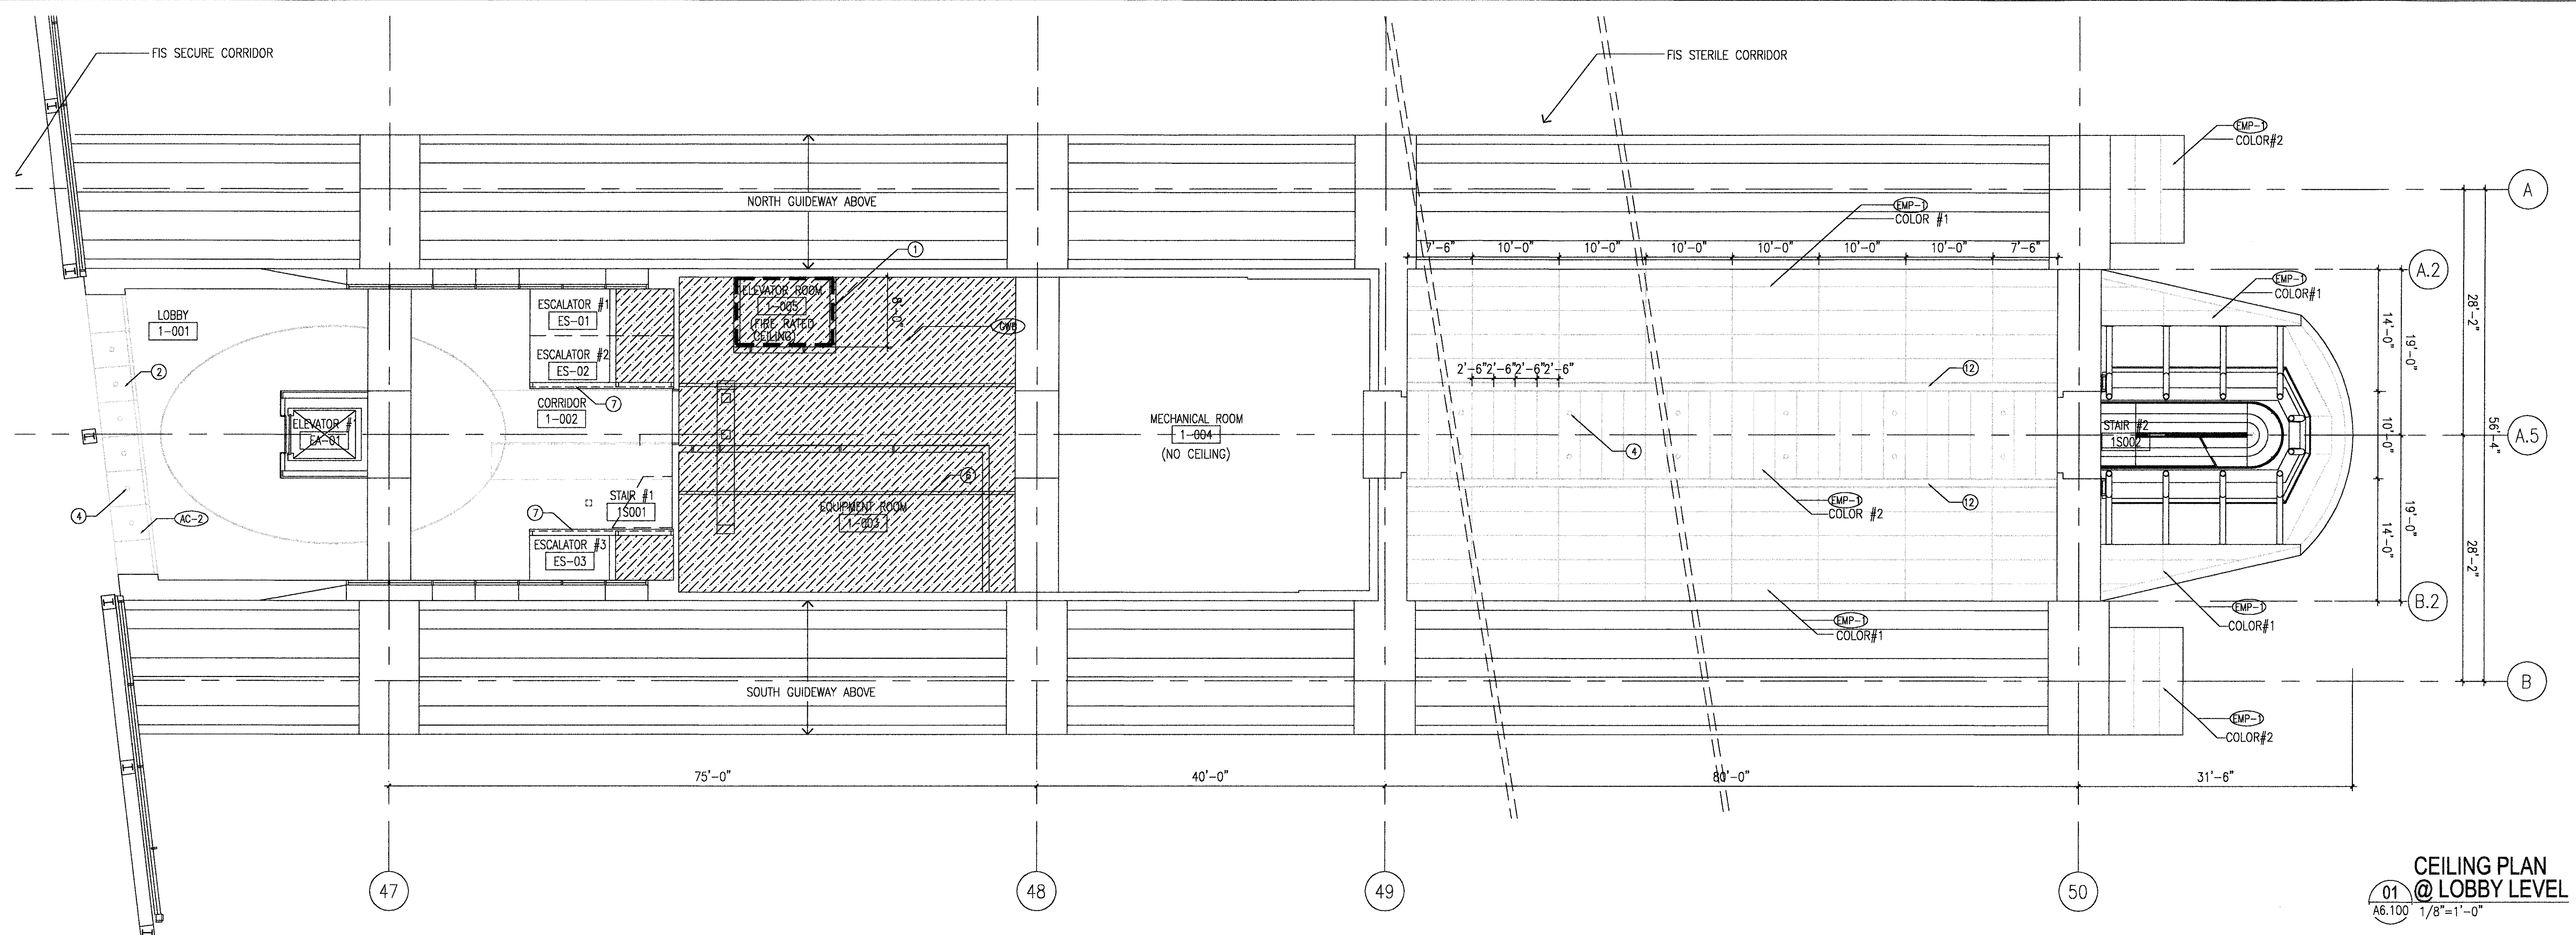

**CEILING PLAN @ LOBBY LEVEL**  
 01  
 A6.100 1/8"=1'-0"

INTERNATIONAL SERVICES • EXPANSION • PROGRAM

**APM STATION + PLATFORM**

REFLECTED CEILING PLAN • LOBBY LEVEL


**LEGEND:**

2 HOUR FIRE RATED SLOPE WALL RE: 3/A2.700

DOWNLIGHT

- KEYED NOTES:**
- 2 HOUR CEILING U/L #1436 @ ELEVATOR ROOM - RE: LONGITUDINAL SECTION A3.000
  - REMOVABLE CEILING PANEL - TYPE AC-2
  - GYPSUM CEILING - PAINTED
  - DOWNLIGHT - RE: ELECTRICAL
  - NOT USED
  - STEEL BEAM - (RE STRUCTURAL) WITH 3HR FIREPROOFING SUPPORT OF SLOPE WALL
  - POWDERCOATED METAL LOUVERS - COLOR #2
  - CENTER OF ELLIPSE
  - CONCRETE COLUMN UNDER CATWALK - ARCHITECTURAL CONCRETE - RE: STRUCTURAL
  - 8" STEEL COLUMN @ LANDINGS - PAINTED
  - STEEL BEAM @ LANDINGS PAINTED
  - 12" ALUMINUM CHANNEL - POWDERCOATED COLOR #1
  - 1/2" X 1/2" REVEAL AROUND 12" CONCRETE COLUMNS AND ALONG EVERY EDGE OF GYPSUM CEILING, WITH ALUM. ANGLE PREFINISHED

- GENERAL NOTES:**
- GWB** PAINT GYPSUM BOARD
  - EMP-1** EXTERIOR POWDERCOATED WALL METAL PANELS - ALUMINUM PANEL 1/8" THICK - TYPE SERIES 3000 MODIFIED FROM UNA-CLAD - COPPER SALES OR EQUAL - POWDERCOATED KYMAR 500
  - AC-2** REMOVABLE SSTL CEILING PANELS - EXPOSED SUSPENSION SYSTEM WITH 1"x1" REVEAL @ JOINTS - FROM BAKER METAL PRODUCTS INC. OR EQUAL - SSTL MULTI DIRECTIONAL MACHINE POLISH

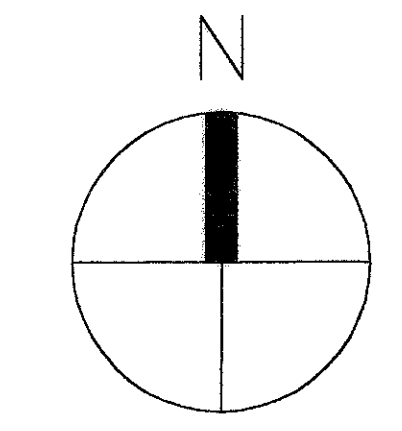

NOTE: REFER TO GRAPHIC SCALE IF ACTUAL SHEET SIZE IS OTHER THAN 30"x42".

SCALE: 1/8" = 1'-0"

PROJECT MGR: HEM  
 DESIGNER: SD  
 DRAWN BY: SEM  
 CHECKED BY: AB  
 DRAWING STANDARD: ISEP 07.20.2000  
 SCALE: 1/8"=1'-0"  
 DATE: 08/14/01


APPROVED BY: \_\_\_\_\_ DATE: \_\_\_\_\_

PROJECT NO. 1140  
 C.I.P. NO. A-0354  
 H.A.S. NO. 536C  
 SHEET NO. 3/8

PLOT DATE: 02/04/02 HAS FILE: A636CAB100



REVISIONS			
NO.	DESCRIPTION	DATE	BY
ISSUED FOR BID		10/19/01	
ADDENDUM 1		02/01/02	SG
RECORD SET		05/13/05	EM

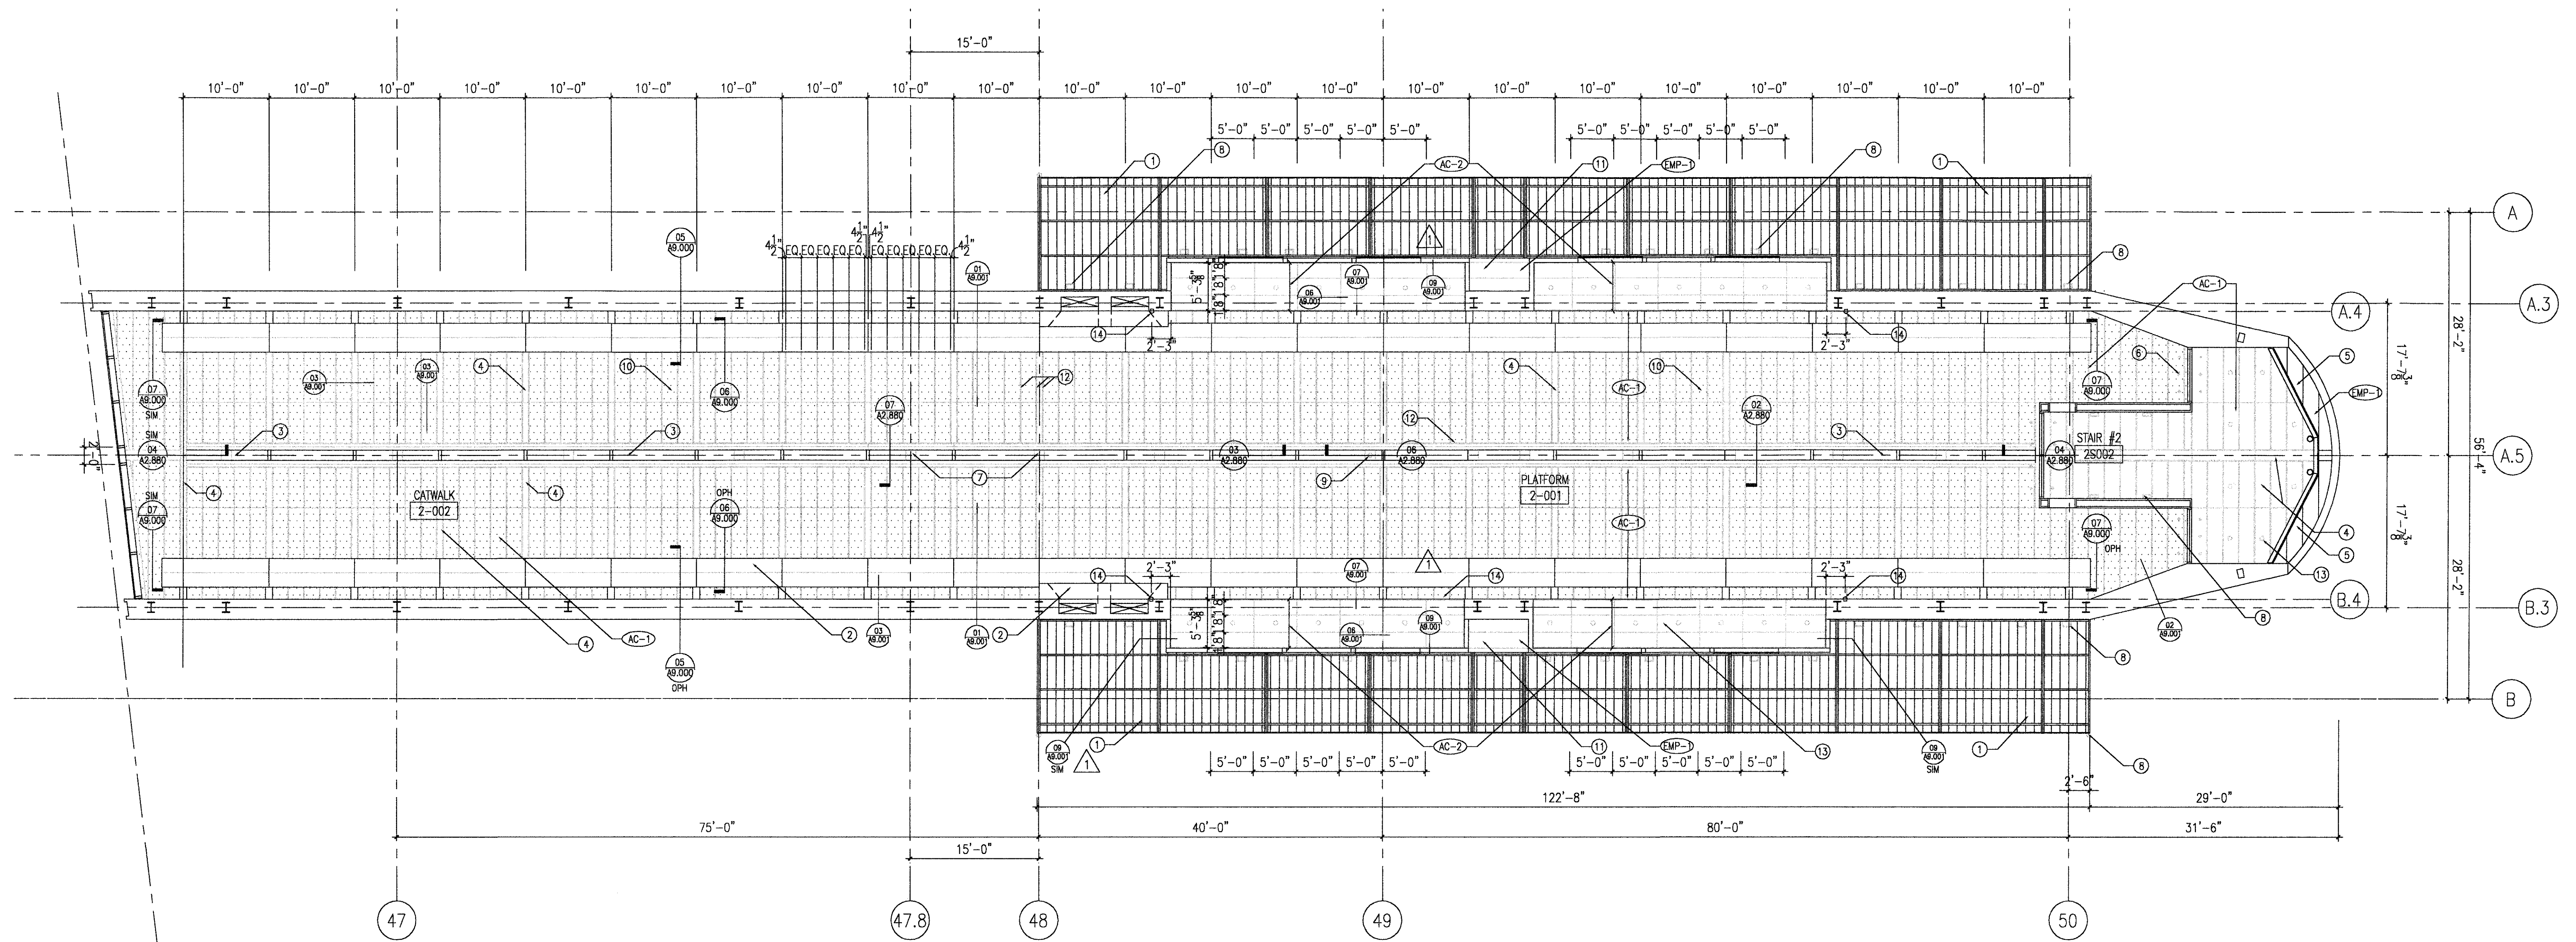

REFLECTED CEILING PLAN  
 @ PLATFORM LEVEL  
 01  
 A6.200 1/8"=1'-0"


INTERNATIONAL SERVICES EXPANSION PROGRAM  
 APM STATION + PLATFORM  
 REFLECTED CEILING PLAN • PLATFORM LEVEL

KEYED NOTES:

- 1 CANOPY: BOTTOM FACE PERFORATED ALUMINUM SHEET - 1/8" THICK - POWDERCOATED COLOR #2 - FIXED TO STRUCTURE BY POP RIVETS
- 2 A/C DUCT - CLAD - RE SHEET A9.000
- 3 SKYLIGHT - RE SHEET A2.880
- 4 CURVED METAL CEILING PANEL TYPE AC-1 NON PERFORATED
- 5 EXTERIOR ALUMINUM PANELS TYPE EMP-1 CURVED - ALIGNED WITH INTERIOR CEILING PANELS
- 6 SPRINKLERS ON BOTH SIDES OF THE CURTAIN WALL ALLOWING A 2HR FIRE RATING
- 7 METAL CLAD AROUND W BEAMS- POWDERCOATED - RE SHEET 3/A2.880
- 8 SCHEDULED LIGHT FIXTURE - RE: ELECTRICAL
- 9 PTZ CAMERA IN BEAM CLADDING - RE SECURITY RE 6/A2.880
- 10 PERFORATED ALUMINUM PANEL CURVED - TYPE AC-1
- 11 EXT. SOFFIT - BETWEEN SLIDING DOOR AREA - METAL PANEL EMP-1
- 12 1" ALUMINUM COVER CURVED - POWDERCOATED
- 13 DOWNLIGHT - RE ELECTRICAL CENTER IN PANEL
- 14 CAMERA - RE SECURITY

GENERAL NOTES:

- AC-1 PRE-FINISHED CURVED, PERFORATED METAL CEILING PANEL - TYPE ALUMA VAULT SYSTEM 1000 BY GORDON MANUFACTURER OR EQUAL - 0.032 GAGE - WITH BLACK NON WOVEN ACOUSTICAL MAT
- AC-2 REMOVABLE SSSL CEILING PANELS - HOOK-ON CONCEALED PLANK FROM HUNTERDOUGLAS PRODUCT INC. OR EQUAL - 24 GA. SSSL MULTI DIRECTIONAL MACHINE POLISH
- EMP-1 EXTERIOR POWDERCOATED WALL METAL PANELS - ALUMINUM PANEL 1/8" THICK - TYPE SERIES 3000 MODIFIED FROM UNA-CLAD - COPPER SALES OR EQUAL - POWDERCOATED KYNAR 500

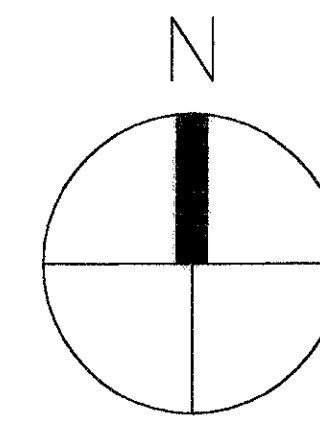


**RECORD DRAWINGS**  
 DO NOT MODIFY  
 Rey de la Reza Architects, Inc.  
 13 May 2005  
 Note: Information used to develop these documents was taken from Record of the Work. Drawings prepared by the construction contractor, Clark Construction Group - Texas. The information provided by the contractor was not verified by the design firm named above.

NOTE: REFER TO GRAPHIC SCALE IF ACTUAL SHEET SIZE IS OTHER THAN 30"x42".  
 0' 4' 8' 16' 24'  
 SCALE: 1/8" = 1'-0"

PROJECT MGR: HEM  
 DESIGNER: SG  
 DRAWN BY: SEM  
 CHECKED BY: AB  
 DRAWING STANDARD:


DATE: 05/14/01

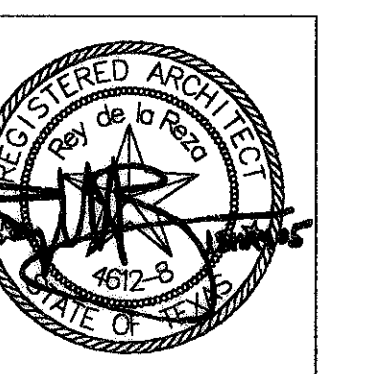

APPROVED BY: \_\_\_\_\_ DATE: \_\_\_\_\_  
 DIRECTOR  
 HOUSTON AIRPORT SYSTEM

PROJECT NO. 1140  
 C.L.P. NO. A-0354  
 H.A.S. NO. 536C  
 SHEET NO.



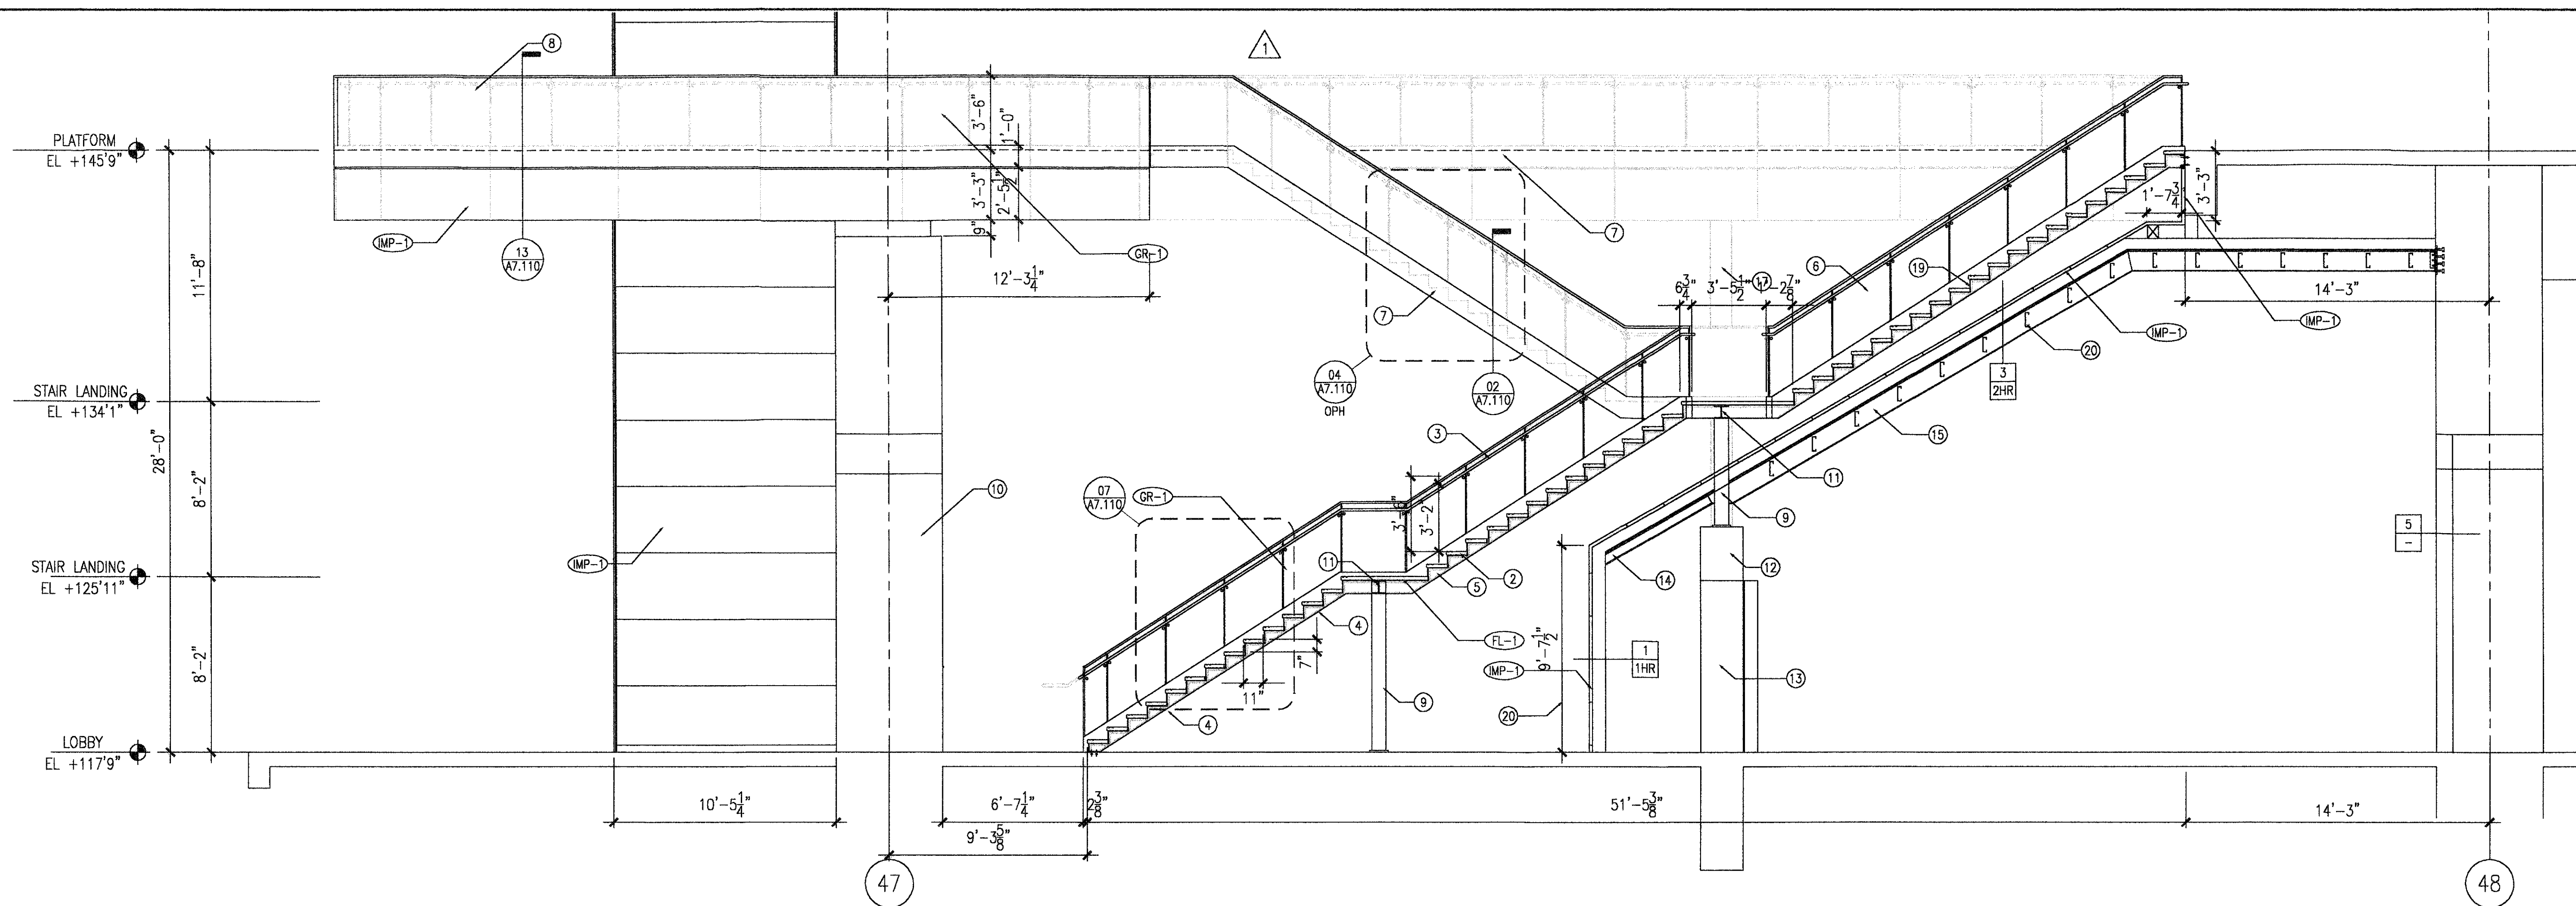

**03 STAIRS #1 & #3 SECTION**  
A7.100 1/4"=1'-0"

**GENERAL NOTES:**

- (GR-1) GLASS GUARDRAIL
- (FL-1) TERRAZZO FLOOR
- (MP-1) INTERIOR STAINLESS STEEL WALL PANELS - MULTI DIRECTIONAL MACHINE POLISH

**Houston Airport System**  
GEORGE BUSH  
INTERCONTINENTAL AIRPORT  
HOUSTON TEXAS


**Lea Elliott**  
1009 W RANDOL MILL RD  
HOUSTON TX 77052  
Tel: 817.281.1466  
Tel: 817.861.3288

**REY DE LA REZA ARCHITECTS, INC.**  
ARCHITECTS PLANNERS INTERIOR DESIGN  
1242 WEST 15TH ST.  
HOUSTON TX 77008  
Tel: 713.868.3121  
Tel: 713.862.0112

NO.	DESCRIPTION	DATE	BY
NO.	ISSUED FOR BID	10/9/01	
ADDENDUM 1	02/01/02	SG	
RECORD SET	05/13/05	DM	

REVISIONS


NO.	DESCRIPTION	DATE	BY
NO.	ISSUED FOR BID	10/9/01	
ADDENDUM 1	02/01/02	SG	
RECORD SET	05/13/05	DM	

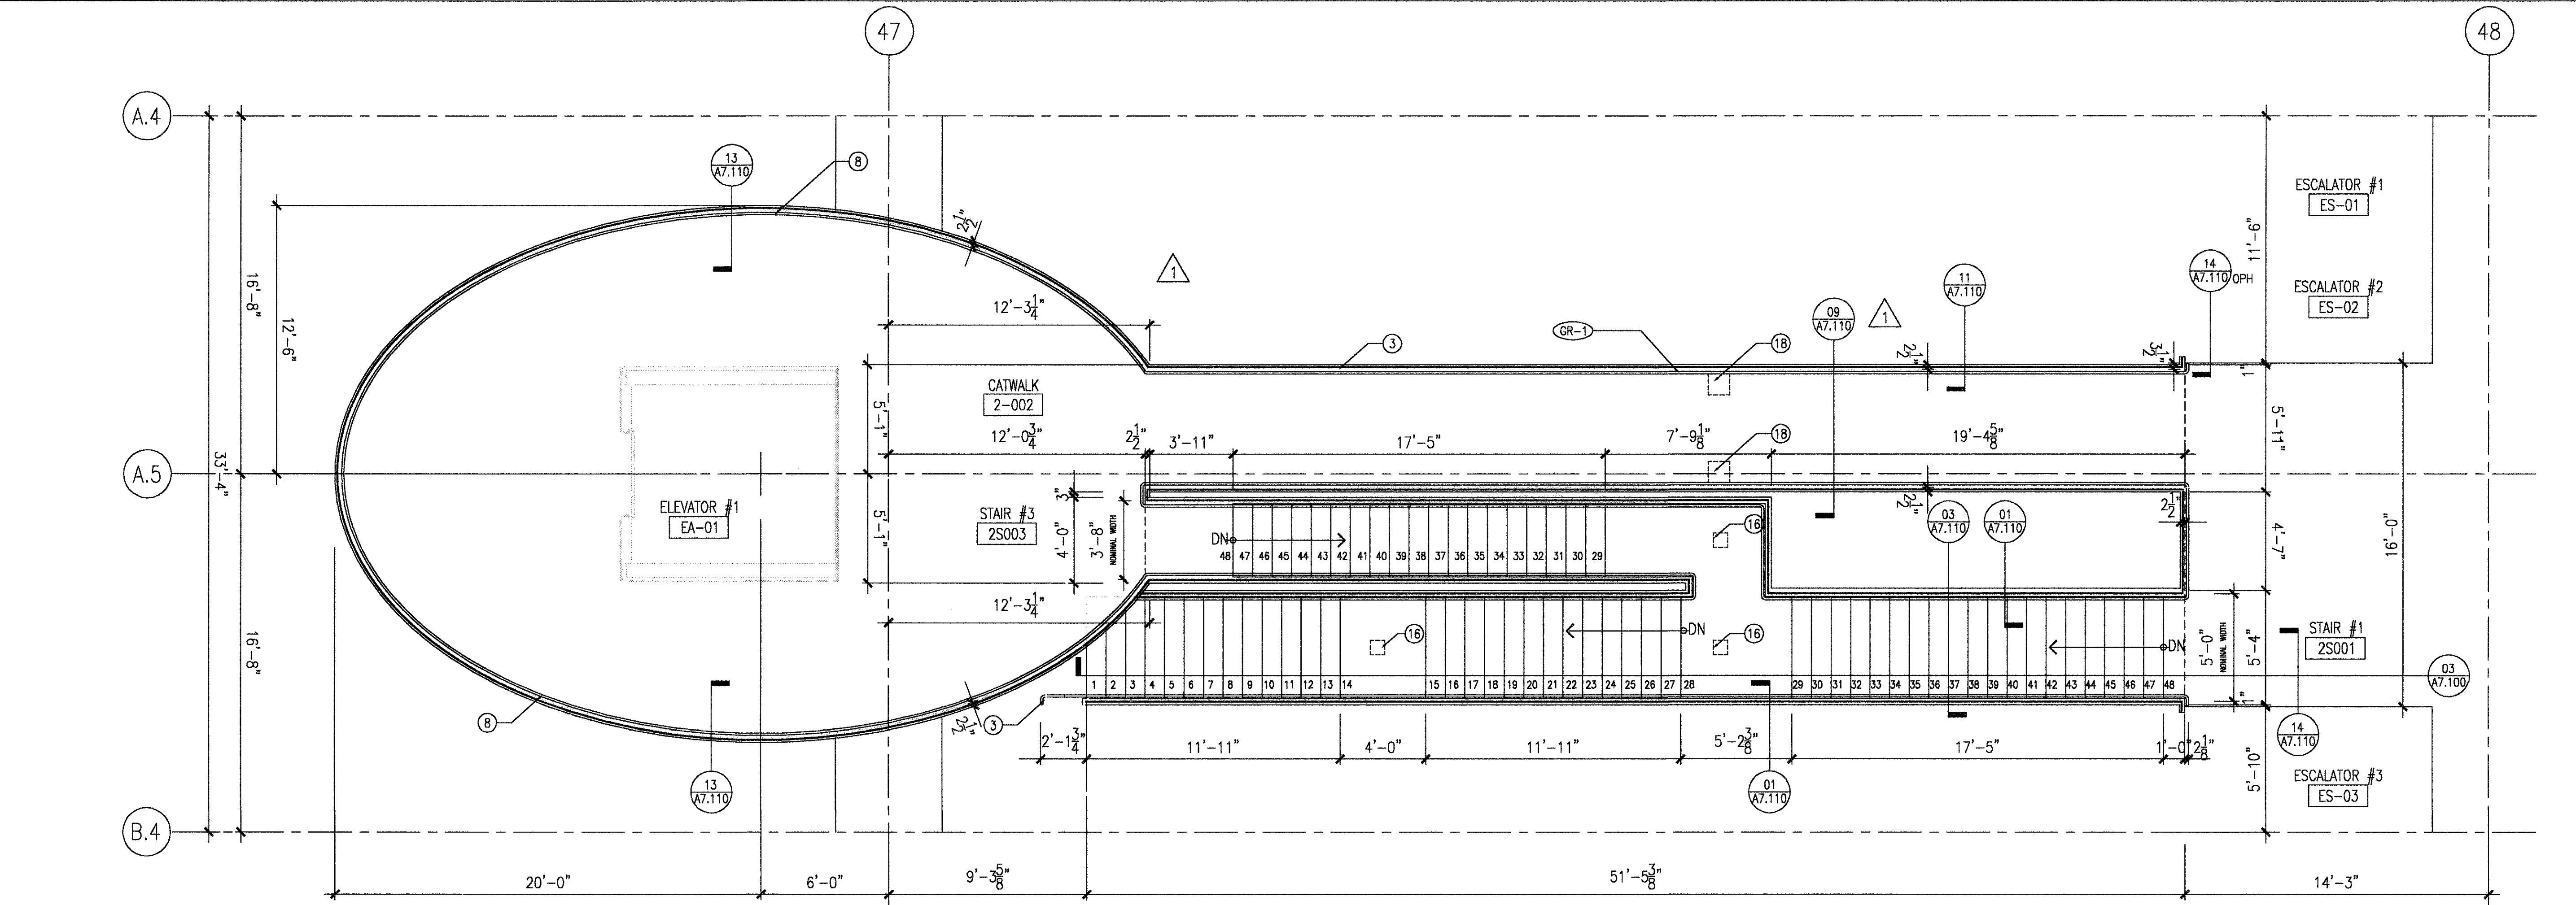

**02 STAIR #1 & #3 PLAN- PLATFORM LEVEL**  
A7.100 1/4"=1'-0"

**KEYED NOTES:**


- 1 GLASS GATE. RE DETAIL 12/A8.040
- 2 PRECAST TERRAZZO TREAD ON STEEL STAIR
- 3 1 1/4" Ø STAINLESS STEEL HANDRAIL
- 4 PAINT GYPSUM UNDER FLIGHTS OF STAIR, BALCONY AND CATWALK
- 5 12" STEEL BOXED STRINGER - SSTL CLAD
- 6 1/2" TEMPERED GLASS
- 7 SSTL CLAD - MULTI DIRECTIONAL MACHINE POLISH
- 8 CURVED GUARDRAIL PANELS ALONG ELLIPTICAL BALCONY
- 9 STEEL TUBES 8"x8" SUPPORT OF STAIR LANDING. CONNECTED TO BEAM IN LANDING
- 10 CONCRETE COLUMN - ARCHITECTURAL CONCRETE
- 11 W BEAM WELDED BETWEEN STAIR STRINGERS
- 12 CONCRETE BEAM - RE STRUCTURAL
- 13 CONCRETE COLUMN - RE STRUCTURAL
- 14 WALL TYPE 3 - 2HR - UL# U438
- 15 W12 STEEL BEAM - RE STRUCTURAL - WITH 3HR FIREPROOFING
- 16 STEEL COLUMN 8"x8" BELOW LANDING
- 17 CONCRETE COLUMN - PAINT - RE STRUCTURAL
- 18 CONCRETE COLUMN BELOW CATWALK
- 19 SSTL CLADDING @ FACE OF RISER - 1/16" THK - MULTI DIRECTIONAL MACHINE POLISH
- 20 8" STEEL STUDS - 10 GA @ 2'-0" O.C. - SECURED TO W12 BEAM AND RUNNER @ WALL
- 21 RETURN SSTL HANDRAIL TO GROUND AND ANCHOR TO FLOOR

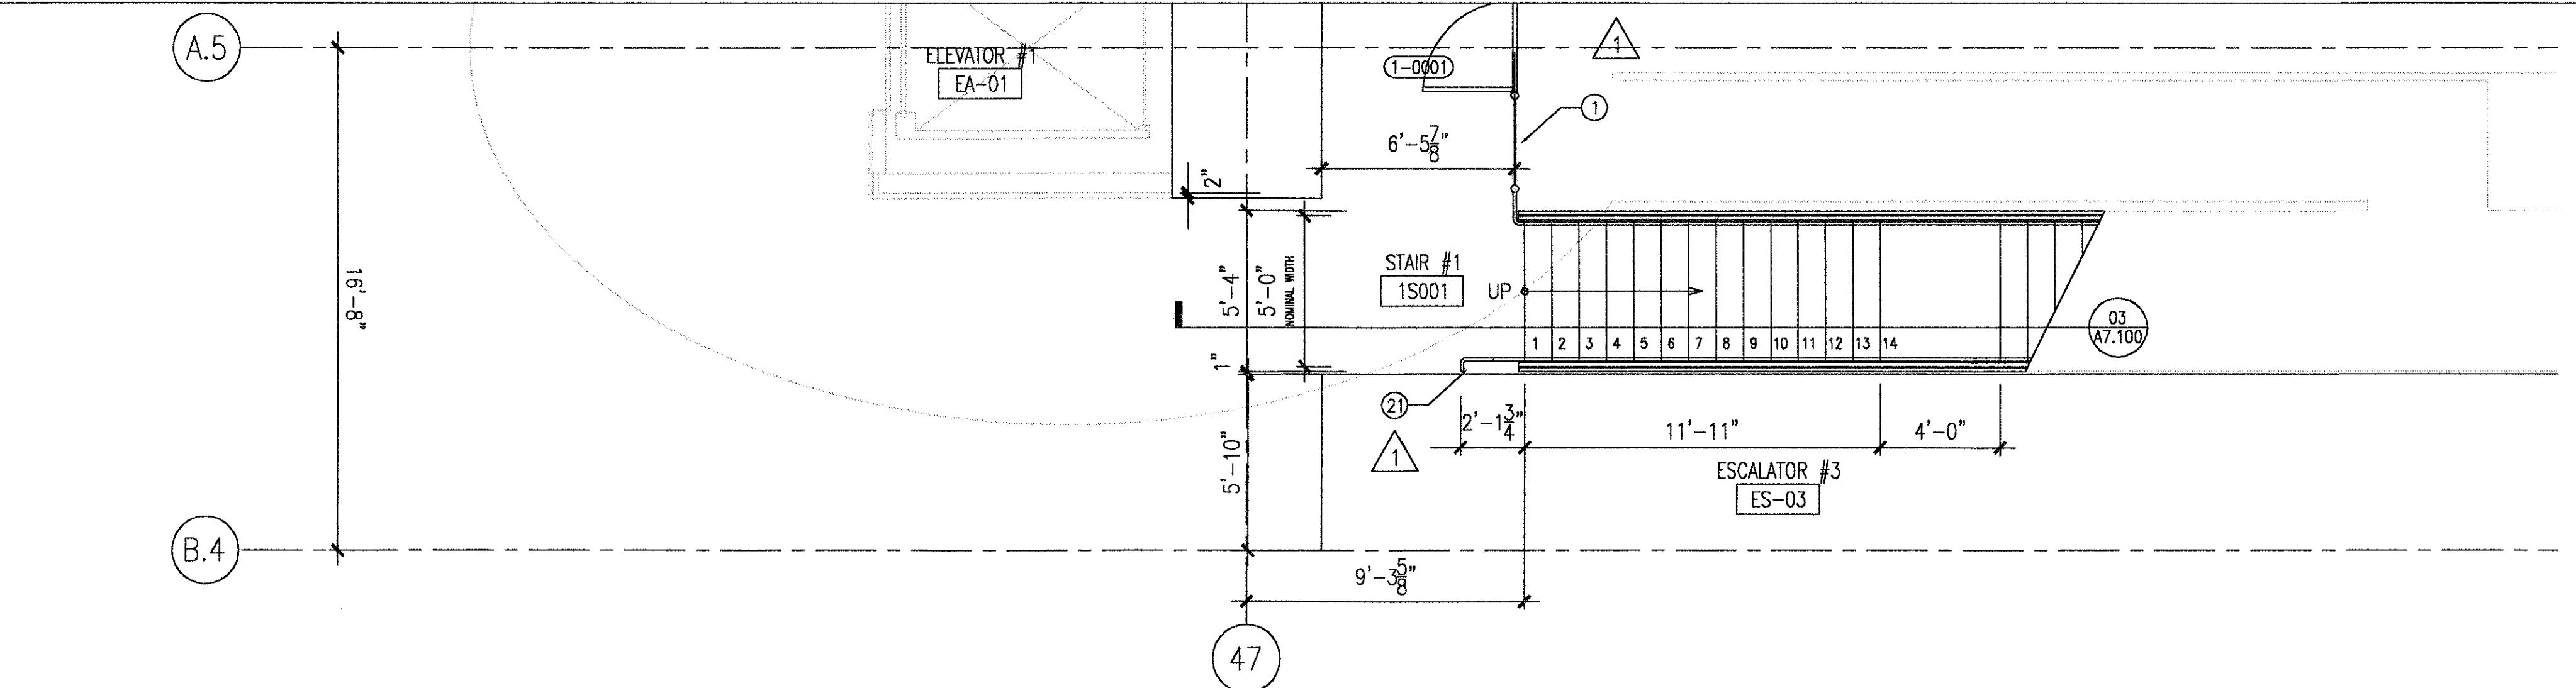

**01 STAIR #1 PLAN - LOBBY LEVEL**  
A7.100 1/4"=1'-0"

**RECORD DRAWINGS**  
DO NOT MODIFY  
Rey de la Reza Architects, Inc.  
13 May 2005

Note: Information used to develop these documents was taken from Record of the Work Drawings prepared by the construction contractor, Clark Construction Group - Texas. The information provided by the contractor was not verified by the design firm named above.

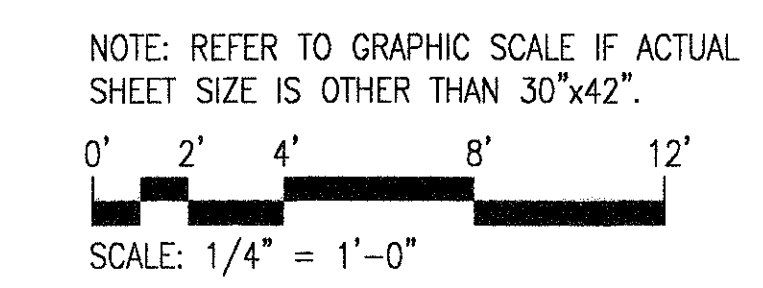


INTERNATIONAL SERVICES EXPANSION PROGRAM

**APM STATION + PLATFORM**  
**STAIR #1 AND STAIR #3**  
**PLANS AND SECTION**

PROJECT MGR:	HDM
DESIGNER:	SG
DRAWN BY:	SDM
CHECKED BY:	AB
DRAWING STANDARD:	ISDP 07.20.2000

SCALE: 1/4"=1'-0"  
DATE: 09/14/01

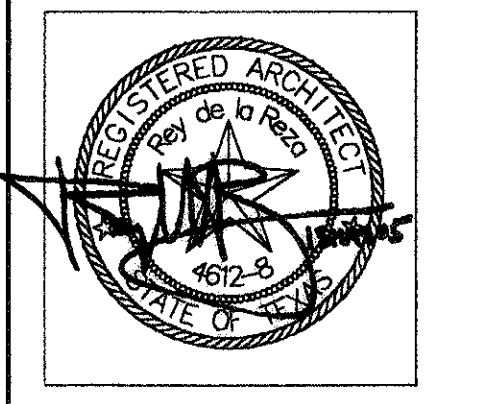


APPROVED BY: \_\_\_\_\_ DATE: \_\_\_\_\_

PROJECT NO.	1140
C.I.P. NO.	A-0384
H.A.S. NO.	538C
SHEET NO.	


**A7.100**

PLOT DATE: 02/04/02 HAS FILE: A13K6CA710D



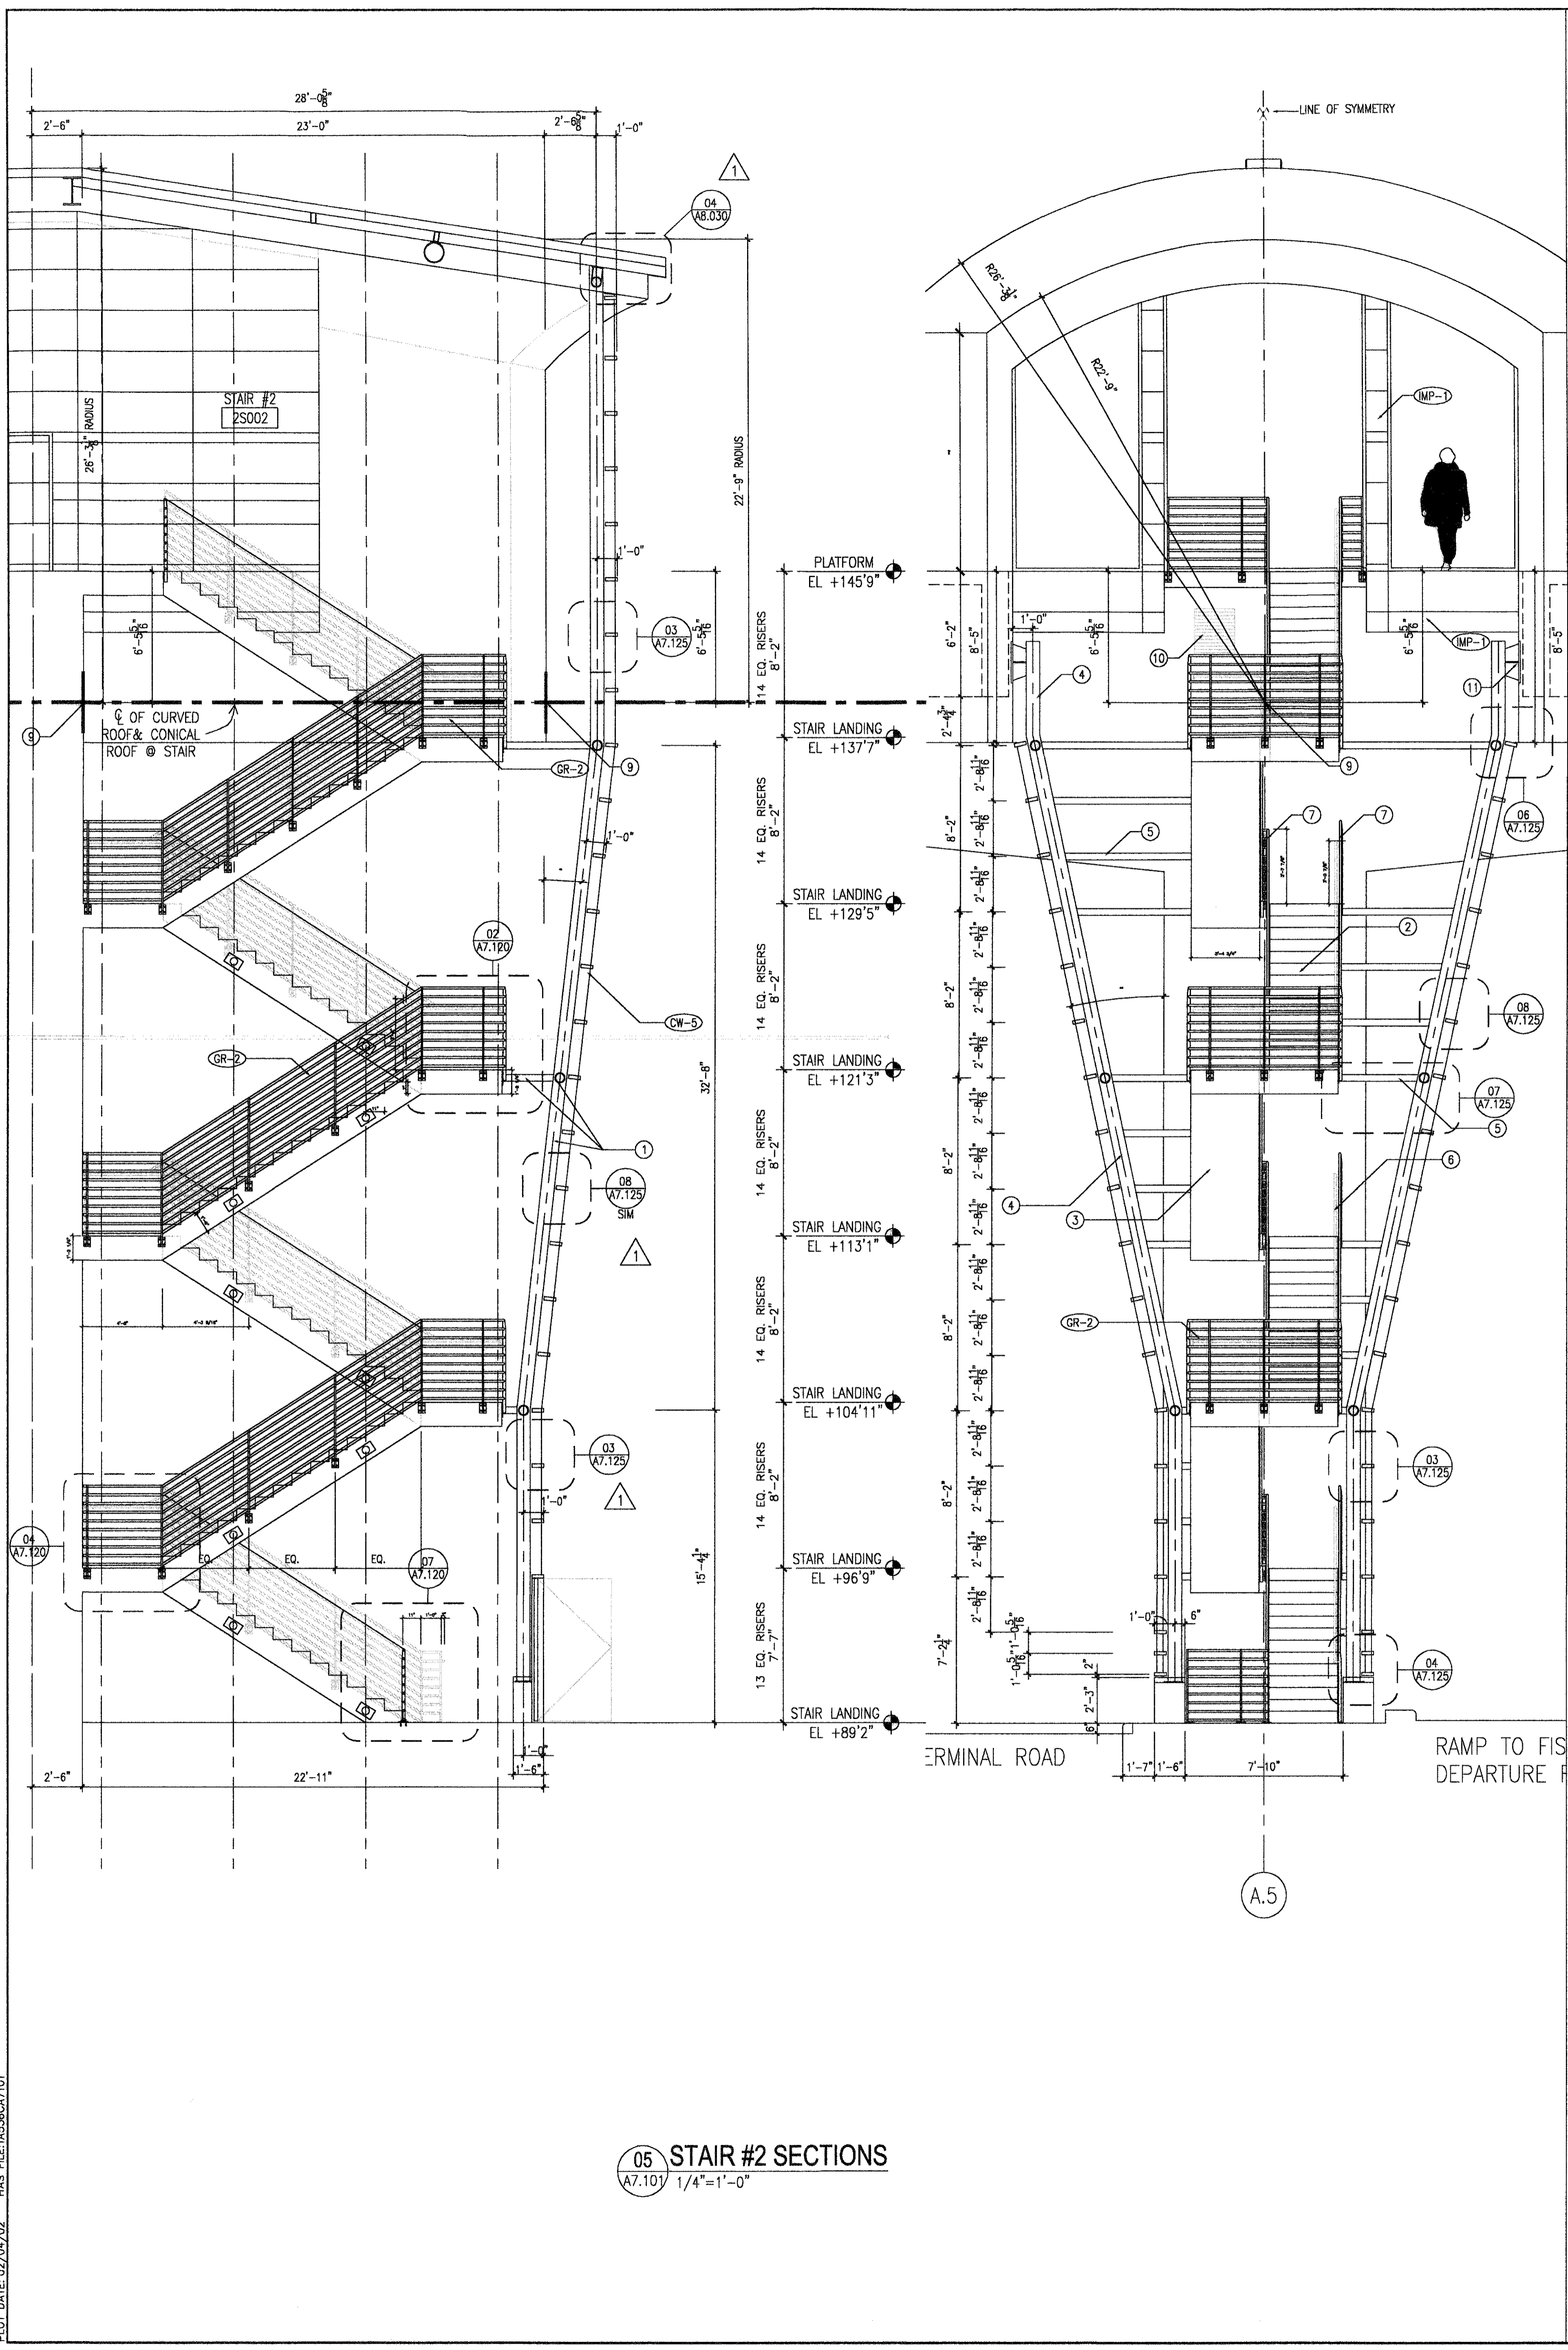

05 STAIR #2 SECTIONS  
A7.101 1/4"=1'-0"

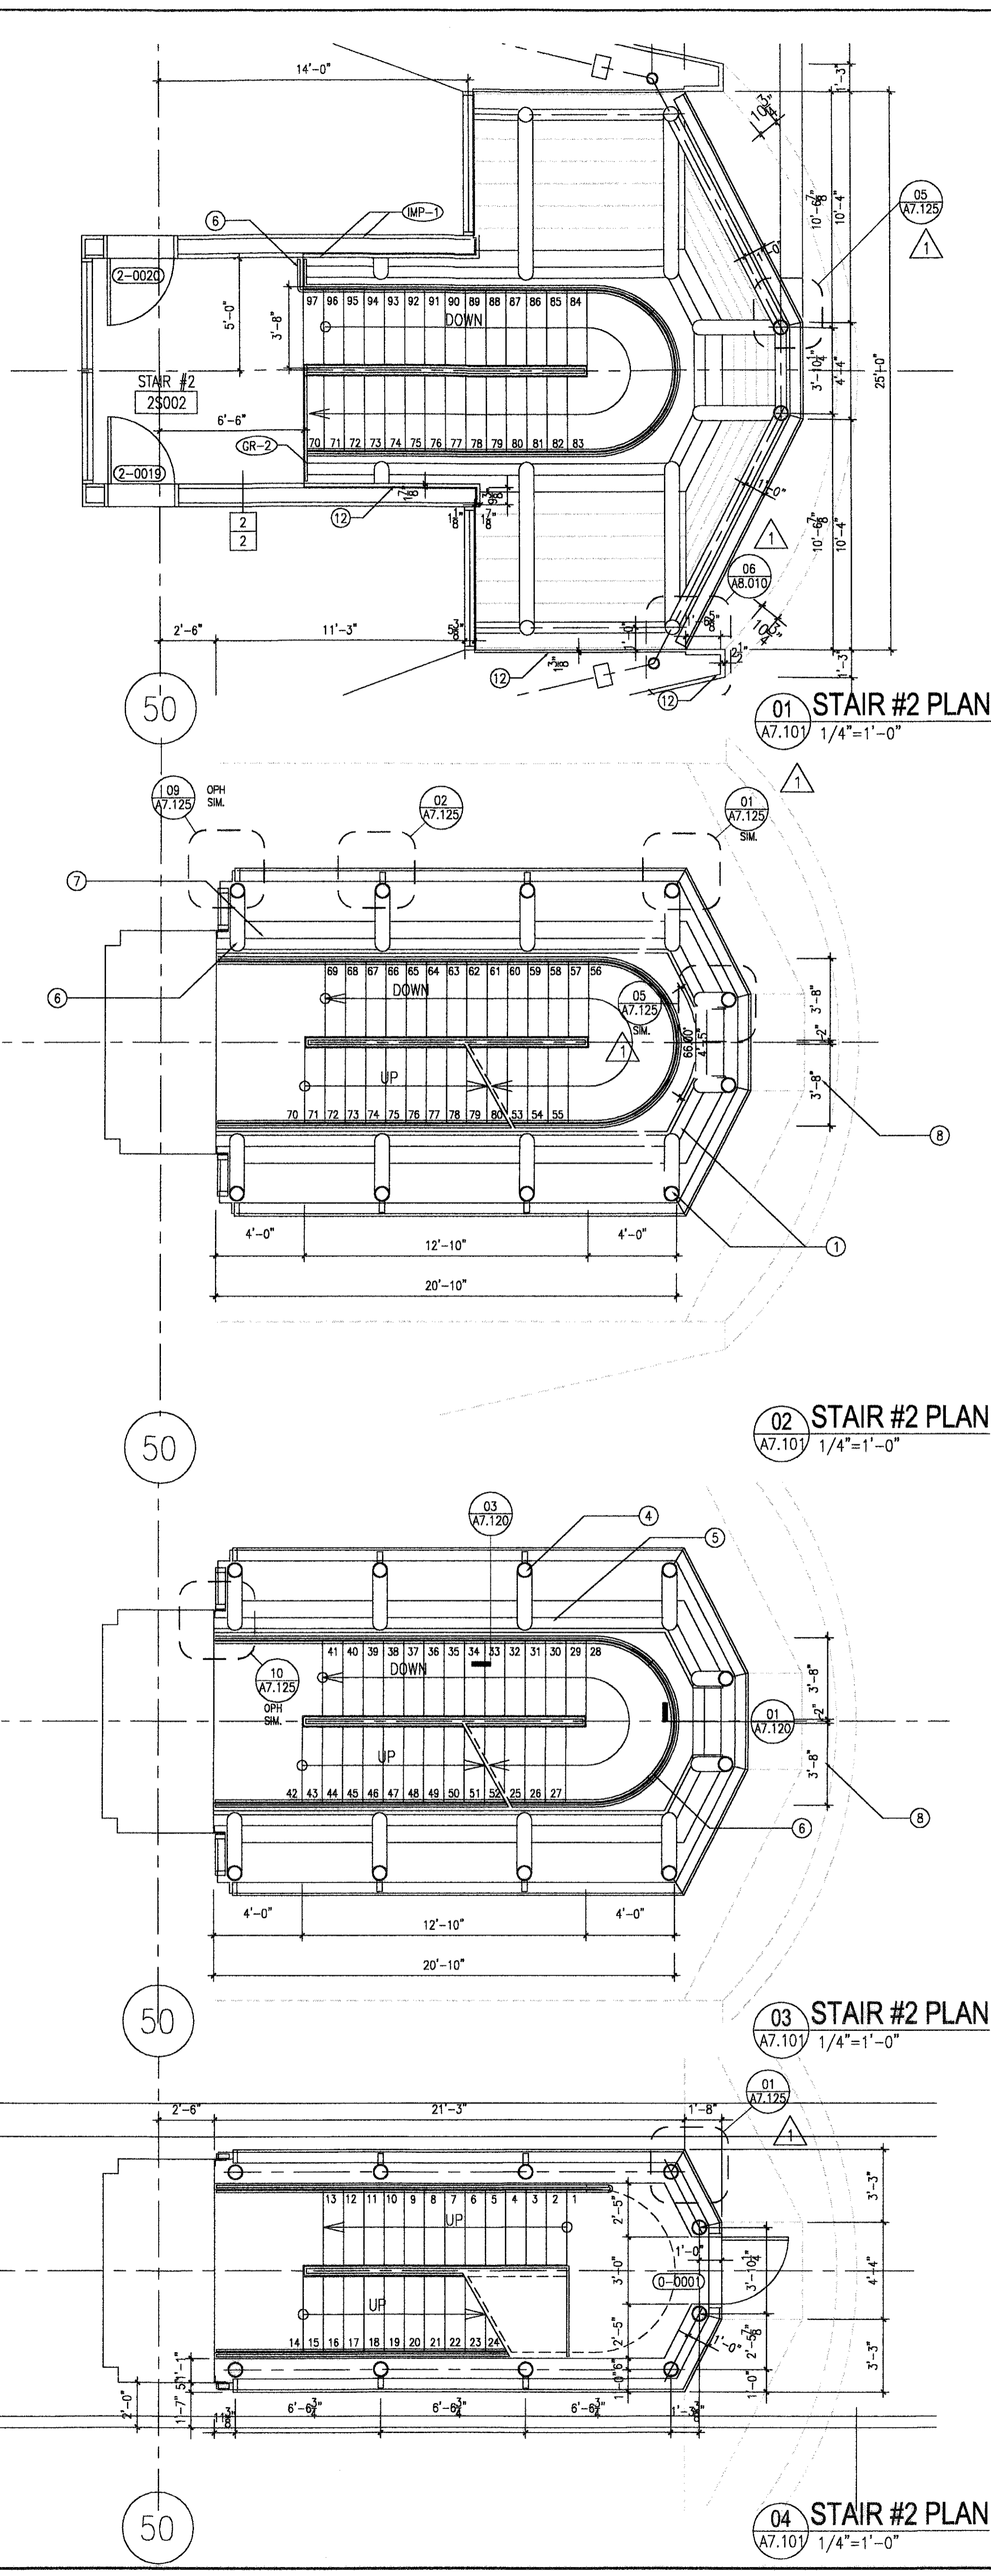

01 STAIR #2 PLAN  
A7.101 1/4"=1'-0"

02 STAIR #2 PLAN  
A7.101 1/4"=1'-0"

03 STAIR #2 PLAN  
A7.101 1/4"=1'-0"

04 STAIR #2 PLAN  
A7.101 1/4"=1'-0"

GENERAL NOTES:

- GR-2 STEEL GUARDRAIL PAINT
- CW-5 CURTAIN WALL TYPE 5 - RE WINDOW SCHEDULE SHEET A2.850
- MP-1 INTERIOR STAINLESS STEEL WALL PANELS - NGAGE SYSTEM BY BAKER METAL PRODUCTS INC. OR EQUAL - 1/16" THK MIN - MULTI DIRECTIONAL MACHINE POLISH

HOUSTON AIRPORT SYSTEM  
GEORGE BUSH  
INTERCONTINENTAL AIRPORT  
HOUSTON TEXAS

Lea Elcott  
1009 W RANDOL WILL RD  
HOUSTON, TX 77032  
Tel: 817.261.1468  
Tel: 817.861.3298

REY DE LA REZA ARCHITECTS, INC.  
ARCHITECTS PLANNERS INTERIOR DESIGNERS  
1242 WEST 15TH ST.  
HOUSTON, TX 77038  
Tel: 713.866.3121  
Tel: 713.862.0112


REVISIONS		
NO.	DESCRIPTION	DATE
1	ISSUED FOR BID	10/19/01
2	ADDENDUM 1	02/01/02 SG
3	RECORD SET	05/13/05 EM

KEYED NOTES:

- 1 STEEL STRUCTURAL FRAME - RE STRUCTURAL - PAINT
- 2 CONCRETE STAIR - ARCHITECTURAL CONCRETE - PAINT
- 3 CONCRETE FLIGHT OF STAIR - PAINT
- 4 8" STEEL PIPE - RE STRUCTURAL
- 5 4" HORIZONTAL STEEL PIPE - WELD TO POST AND ANCHOR TO STAIR
- 6 1 1/4" Ø STEEL PIPE HANDRAIL
- 7 1 1/4" Ø STEEL PIPES GUARDRAIL - POST 1 3/4"x3/4" STEEL PLATE
- 8 NOMINAL STAIR WIDTH
- 9 CENTER OF CURVED ROOF
- 10 LOUVERS TYPE EMP-2 @ A/C DUCT - POWDERCOATED
- 11 BASE PLATE WITH STIFFENERS - ANCHOR TO CONCRETE RE STRUCTURAL
- 12 EDGE OF CONCRETE

**RECORD DRAWINGS**  
DO NOT MODIFY  
Rey de la Reza Architects, Inc.  
13 May 2005

Note: Information used to develop these documents was taken from Record of the Work Drawings prepared by the construction contractor, Clark Construction Group, Texas. The information provided by the contractor was not verified by the design firm named above.

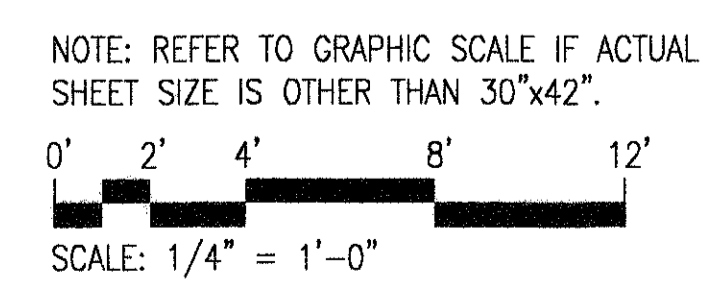

INTERNATIONAL SERVICES EXPANSION PROGRAM

APM STATION + PLATFORM  
STAIR #2  
PLANS AND SECTION

PROJECT MGR: HEM  
DESIGNER: SO  
DRAWN BY: SEM  
CHECKED BY: AB  
DRAWING STANDARD: ISEP 07.20.2000

SCALE: 1/4"=1'-0"  
DATE: 09/14/01

APPROVED BY: \_\_\_\_\_ DATE: \_\_\_\_\_

HOUSTON AIRPORT SYSTEM

PROJECT NO. 1140  
C.I.P. NO. A-0354  
H.A.S. NO. 538C  
SHEET NO. \_\_\_\_\_


PLOT DATE: 02/04/02 HAS FILE: A3624701



REVISIONS			
NO.	DESCRIPTION	DATE	BY
	ISSUED FOR BID	10/18/01	
▲	ADDENDUM 1	02/01/02	SG
▲	RECORD SET	05/13/05	EM

INTERNATIONAL SERVICES EXPANSION PROGRAM  
**APM STATION + PLATFORM**  
 STAIR DETAILS

PROJECT MGR:	HEM
DESIGNER:	SG
DRAWN BY:	SEM
CHECKED BY:	AS
DRAWING STANDARD:	ISDP 07.20.2000
SCALE:	AS NOTED
DATE:	09/14/01

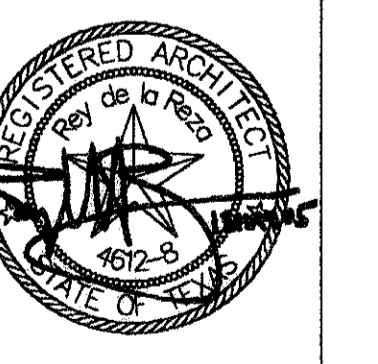

APPROVED BY:	DATE:
DIRECTOR	
HOUSTON AIRPORT SYSTEM	
PROJECT NO.	1140
C.I.P. NO.	A-0354
H.A.S. NO.	5360
SHEET NO.	


**GENERAL NOTES:**

- GR-1 GLASS GUARDRAIL
- FL-1 TERRAZZO FLOOR
- MP-2 INTERIOR STAINLESS STEEL WALL PANELS - MULTI DIRECTIONAL MACHINE POLISH


**KEYED NOTES:**

- 1 PRECAST TERRAZZO TREAD ON STEEL STAIR
- 2 1 1/4" STAINLESS STEEL HANDRAIL
- 3 PAINT GYPSUM BOARD UNDER FLIGHTS OF STAIR, BALCONY AND CATWALK
- 4 12" STEEL BOXED STRINGER - 3/8" THICK STEEL PLATES - WELD
- 5 1/2" THICK STEEL PLATE - WELD TO STRINGER
- 6 STAINLESS STEEL CLADDING - 1/16" THICK - MULTI DIRECTIONAL MACHINE POLISH
- 7 CONTINUOUS ALUMINIUM BASE - SIM CURVED @ ELLIPTICAL BALCONY
- 8 1/2" TEMPERED GLASS - SIM CURVED @ ELLIPTICAL BALCONY
- 9 HOLES DRILLED IN GLASS PRIOR TO TEMPERING
- 10 STAINLESS STEEL BRACKET
- 11 NOT USED
- 12 ABRASIVE INSERT
- 13 SECURE BASE TO STRUCTURE
- 14 2 1/2" METAL STUD SECURE TO STRINGER
- 15 NOT USED
- 16 3/8" STEEL PLATE WITH STEEL STUDS EMBED IN CONCRETE - SIM CURVED @ ELLIPTICAL BALCONY
- 17 STAINLESS STEEL TOP CAP - ADHERE TO GLASS BY STRUCTURAL SILICONE - ALL EDGES POLISHED
- 18 2 1/2" x 3 1/2" x 3/8" CONT. STEEL ANGLE - WELD TO STEEL PLATE
- 19 NOT USED
- 20 1/2" TEMPERED GLASS - CURVED AT BALCONY
- 21 STAINLESS STEEL HANDRAIL CURVED AT ELLIPTICAL BALCONY
- 22 CURVED ALUMINIUM BASE AT ELLIPTICAL BALCONY
- 23 SSSL HANDRAIL RETURN TO GROUND @ ALL TERMINATIONS AND ANCHOR TO FLOOR
- 24 GLASS CUT OUT @ ESCALATOR GUARDRAIL
- 25 SSSL CLADDING 1/16" THICK - FACE OF RISER
- 26 VERTICAL EDGES OF GLASS PANELS CHAMFERED AND POLISHED
- 27 6" METAL STUDS 20 GA. @ 16" O.C. SECURE TO CONCRETE SLAB
- 28 A/C DUCT - RE MECHANICAL
- 29 3/4" x 3/4" REVEAL IN SSSL CLADDING
- 30 1/2" x 1/2" REVEAL @ EDGE OF GYPSUM CEILING, ALUMINIUM, SHOP PAINTED
- 31 1/4" THICK SSSL BASE PLATE, WELDED TO BOTTOM OF HANRAIL @ FLOOR, SANDED GRANT SMOOTH ANCHORED TO CONC. SLAB


**RECORD DRAWINGS**  
 DO NOT MODIFY  
 Rey de la Reza Architects, Inc.  
 13 May 2005  
 Note: Information used to develop these documents was taken from Record of the Work Drawings prepared by the construction contractor, Clark Construction Group - Texas.  
 The information provided by the contractor was not verified by the design firm named above.

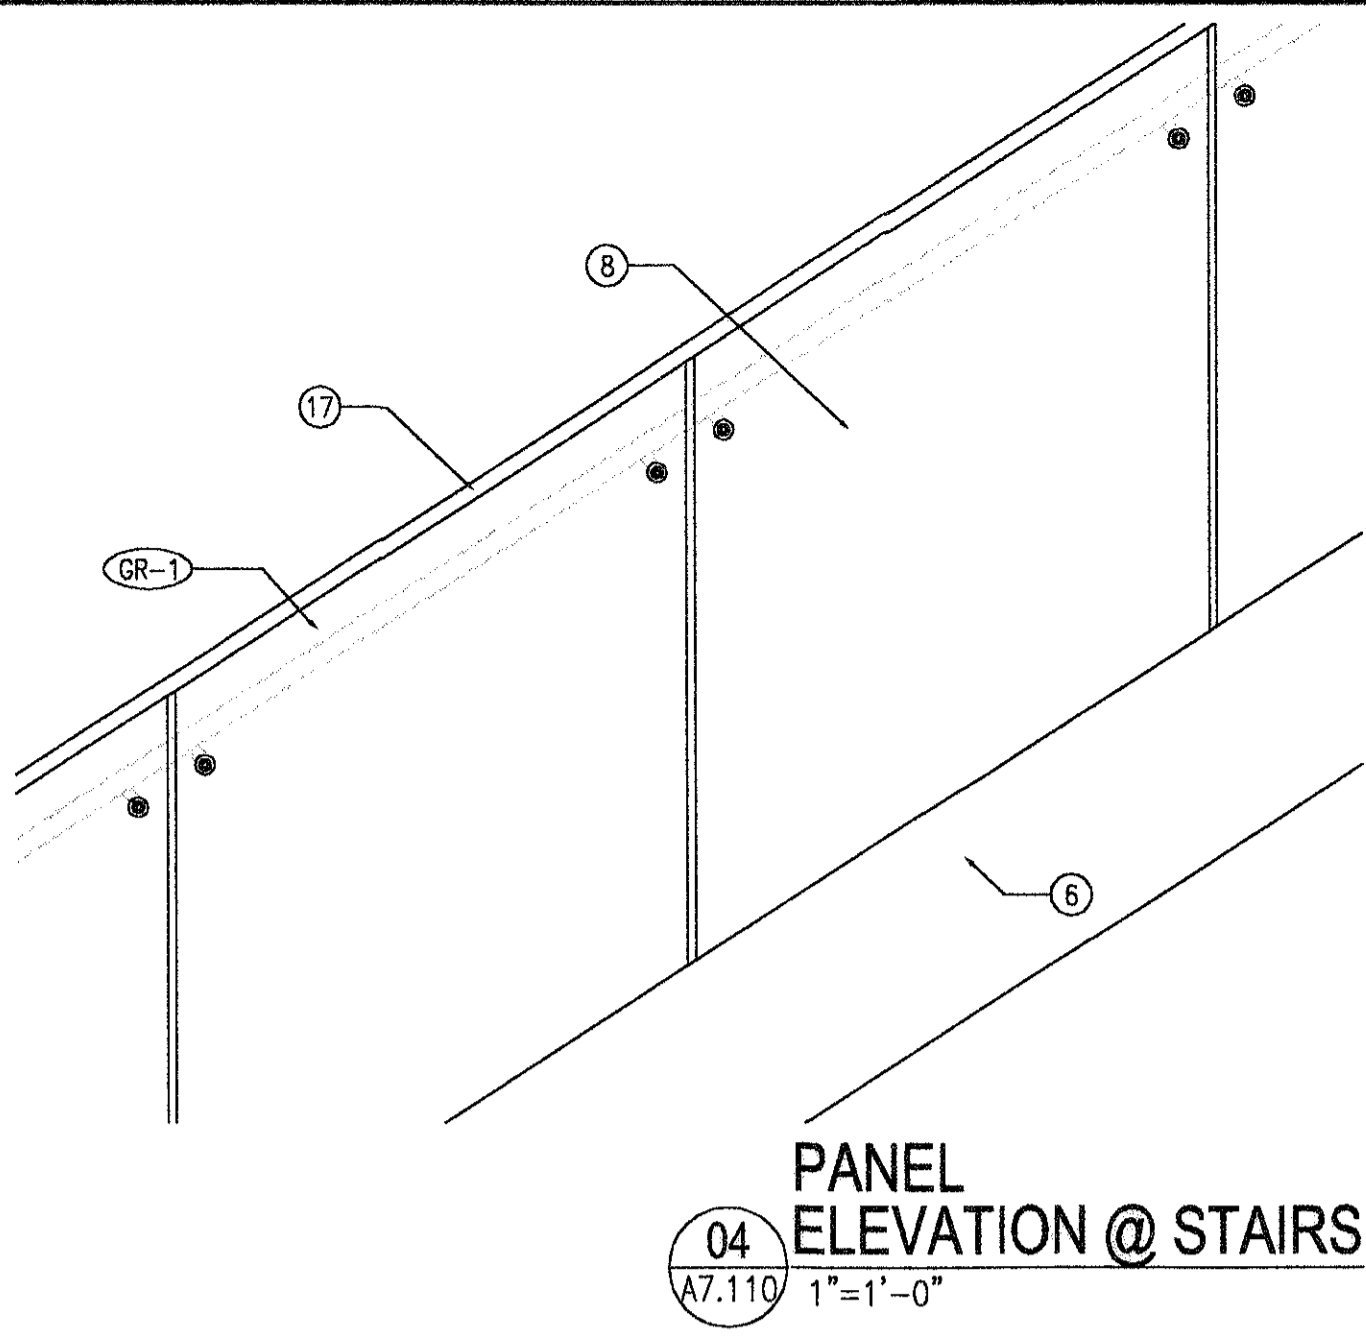


04 PANEL ELEVATION @ STAIRS  
 A7.110 1"=1'-0"

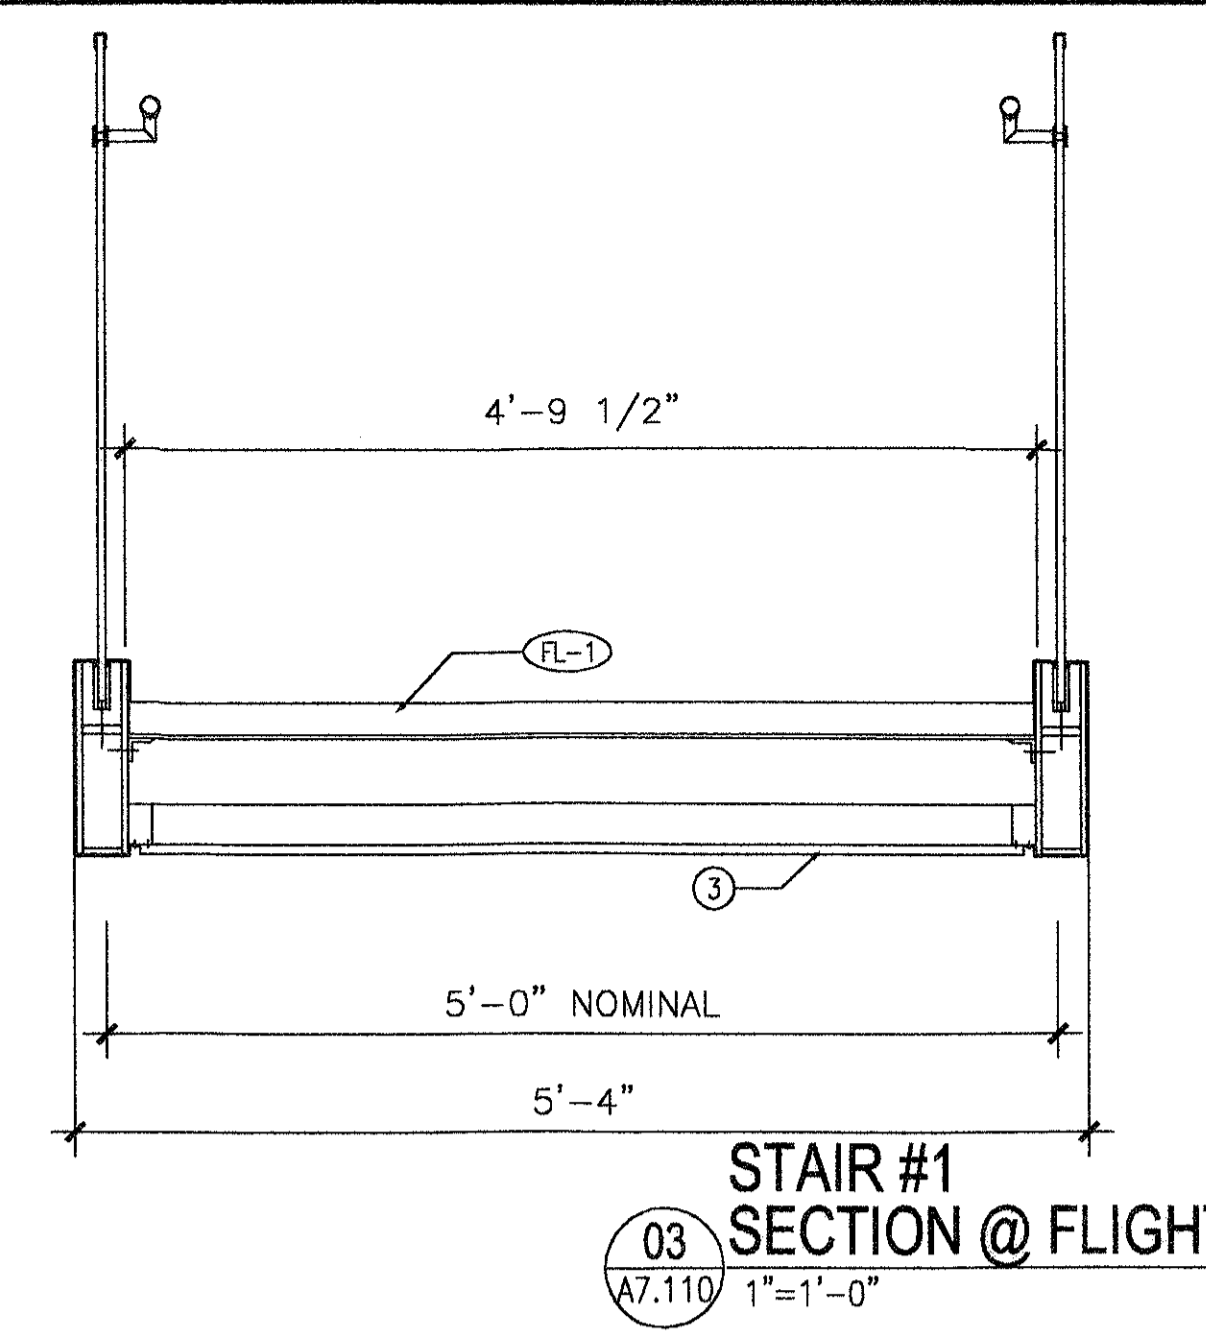


03 STAIR #1 SECTION @ FLIGHT  
 A7.110 1"=1'-0"

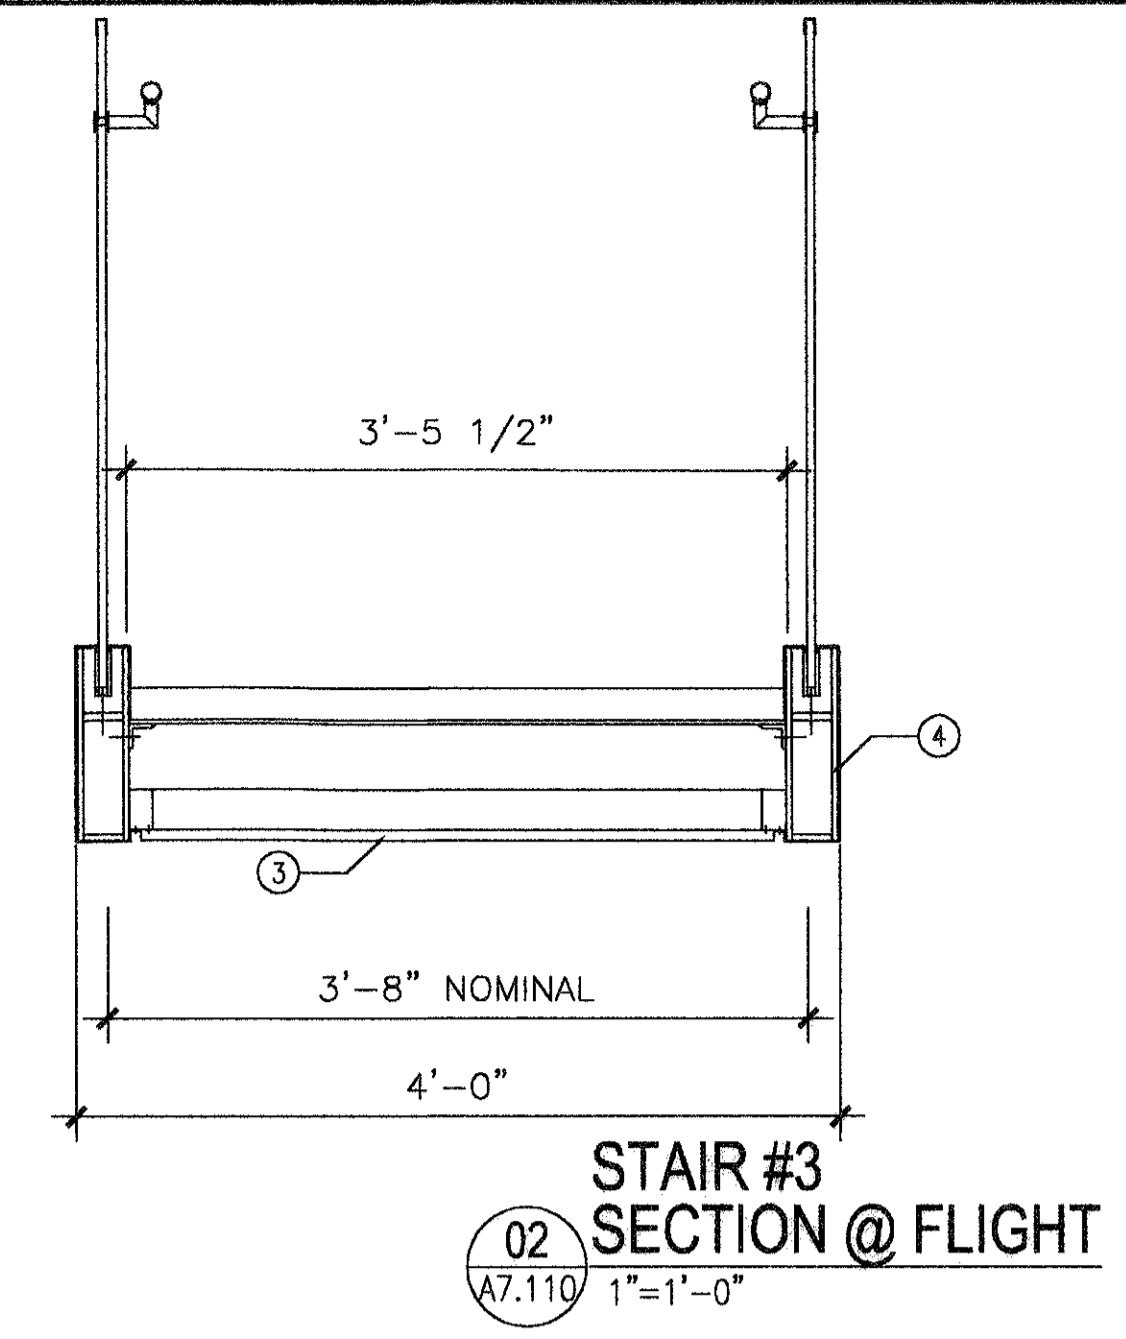


02 STAIR #3 SECTION @ FLIGHT  
 A7.110 1"=1'-0"

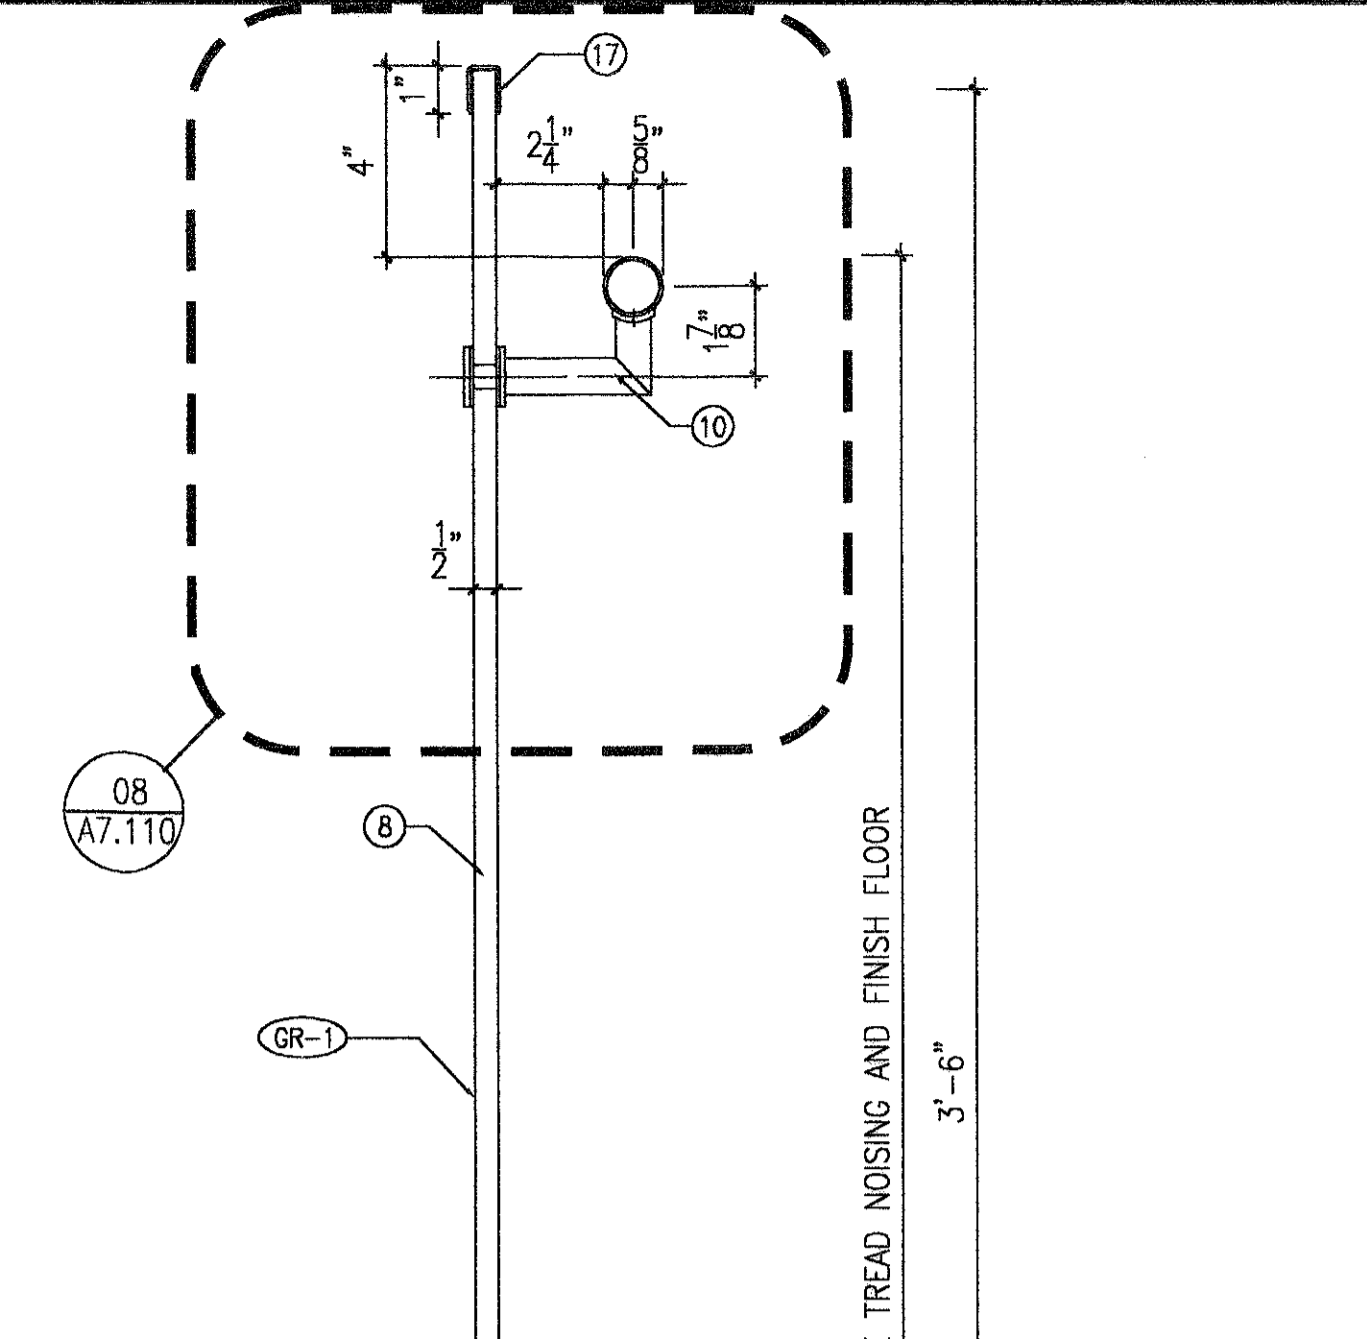


08 GUARDRAIL SECTION @ FLIGHT  
 A7.110 3"=1'-0"

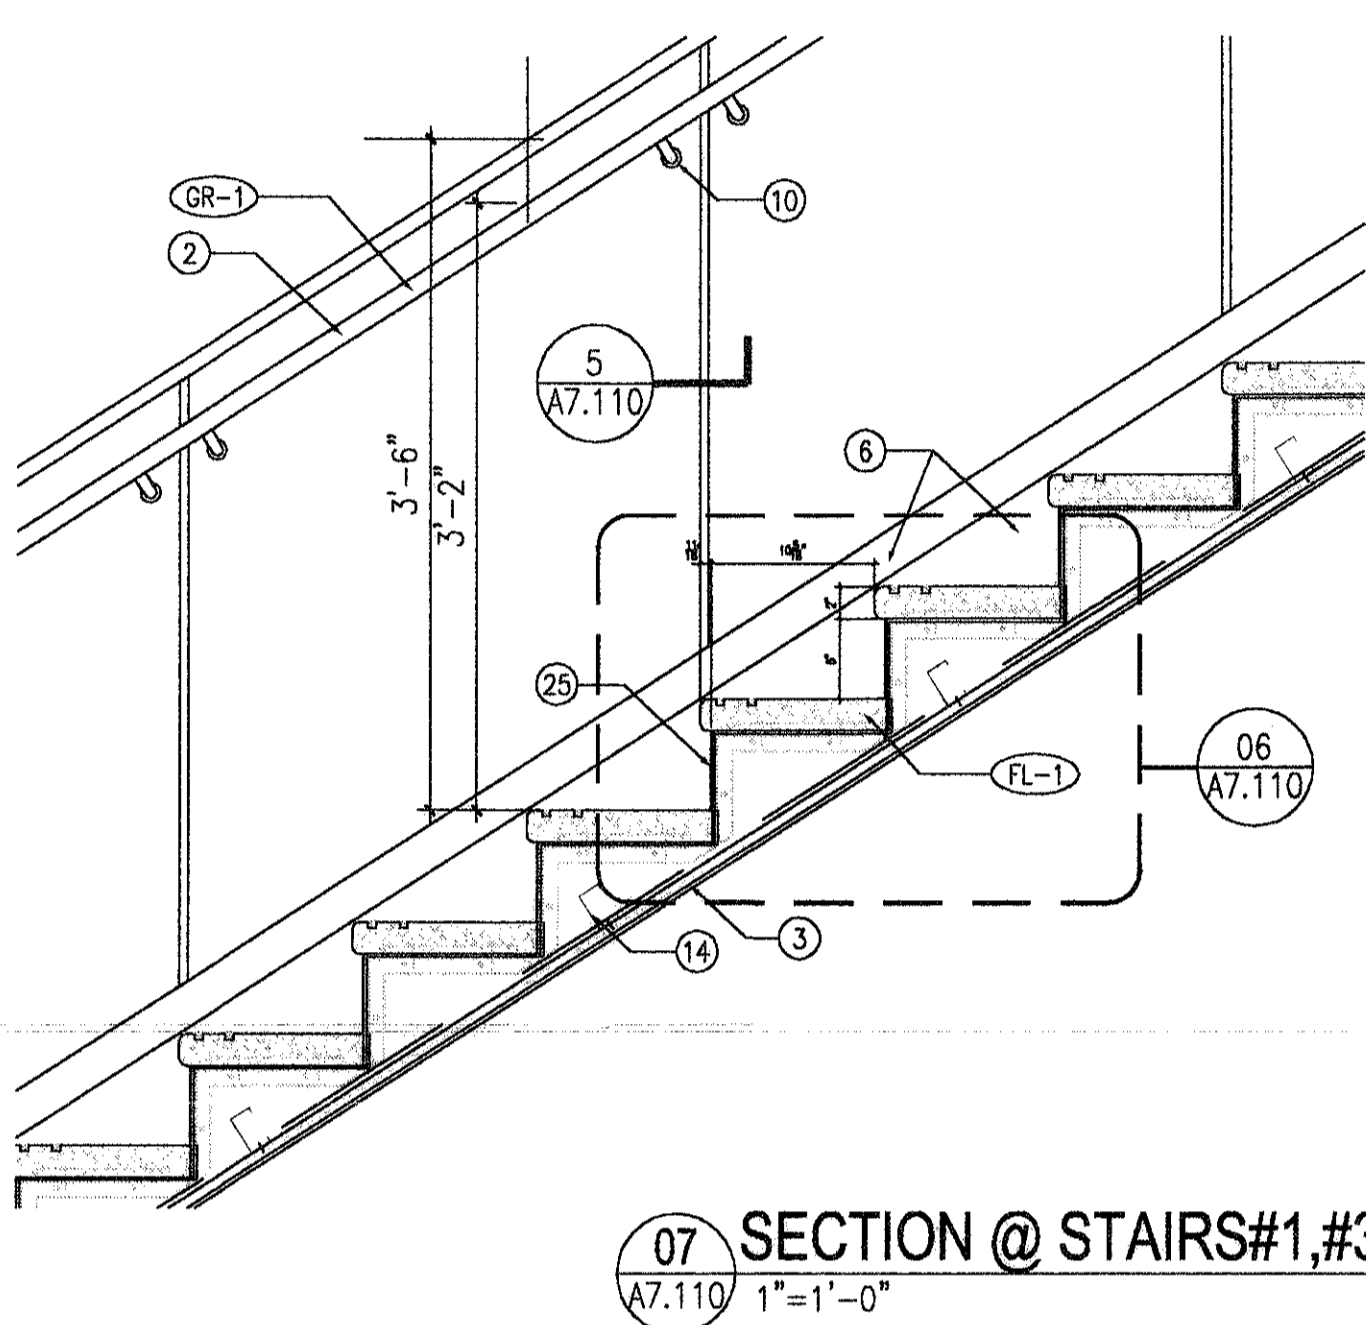


07 SECTION @ STAIRS #1, #3  
 A7.110 1"=1'-0"

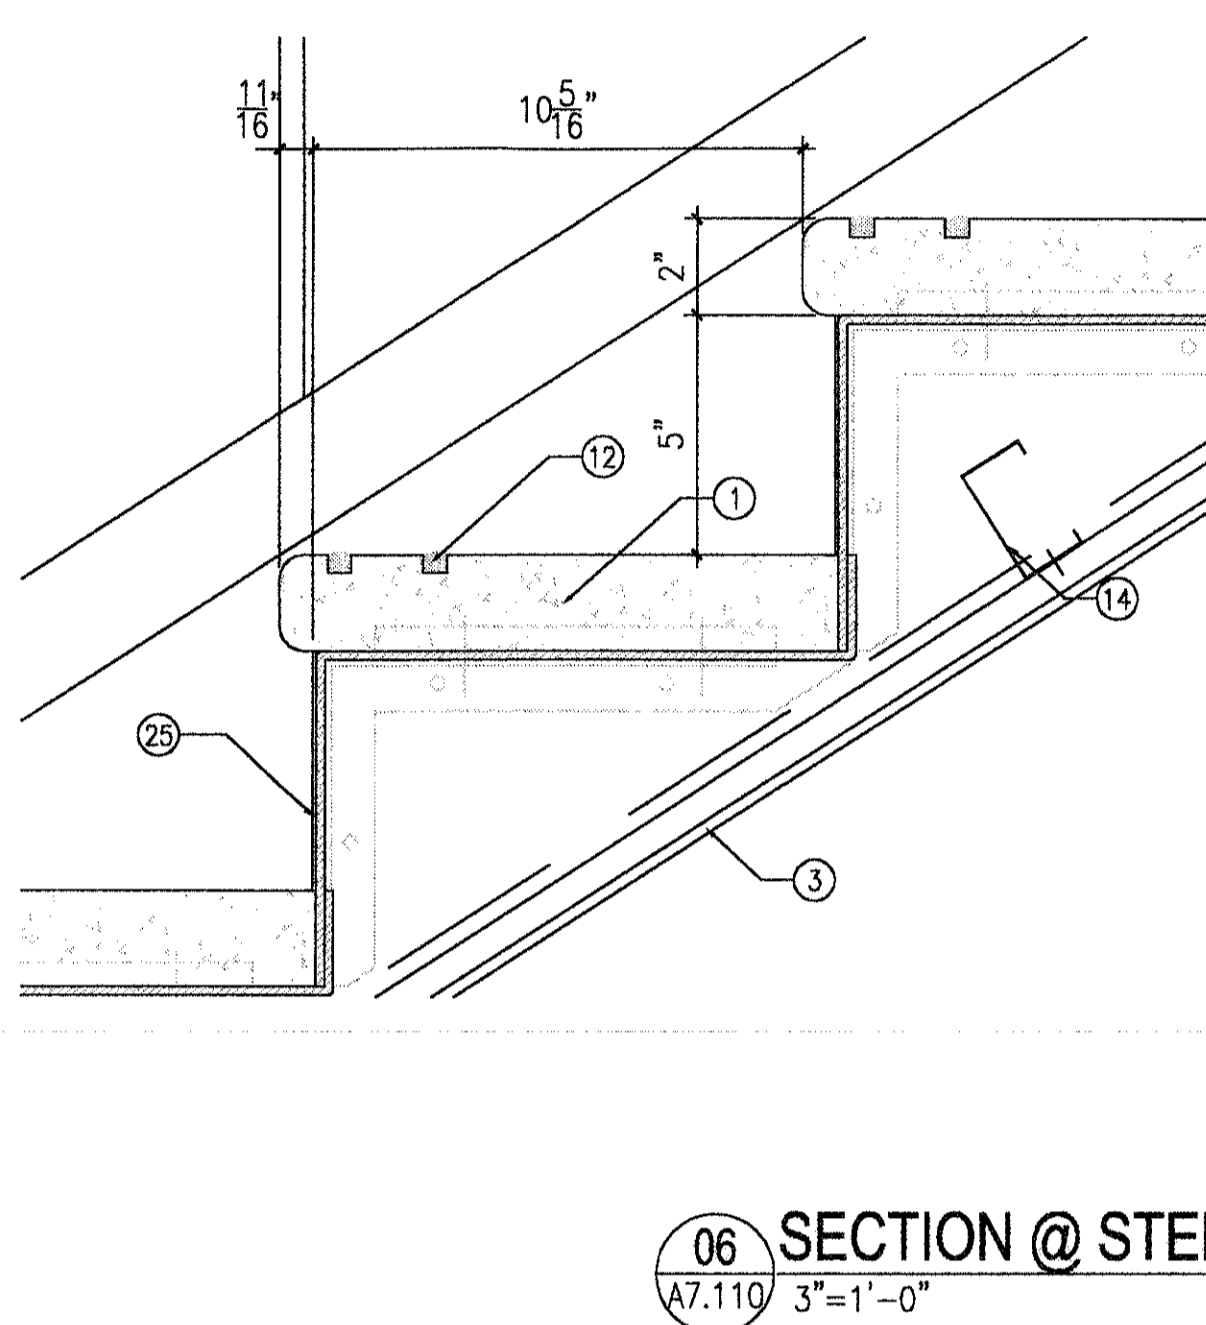


06 SECTION @ STEP  
 A7.110 3"=1'-0"

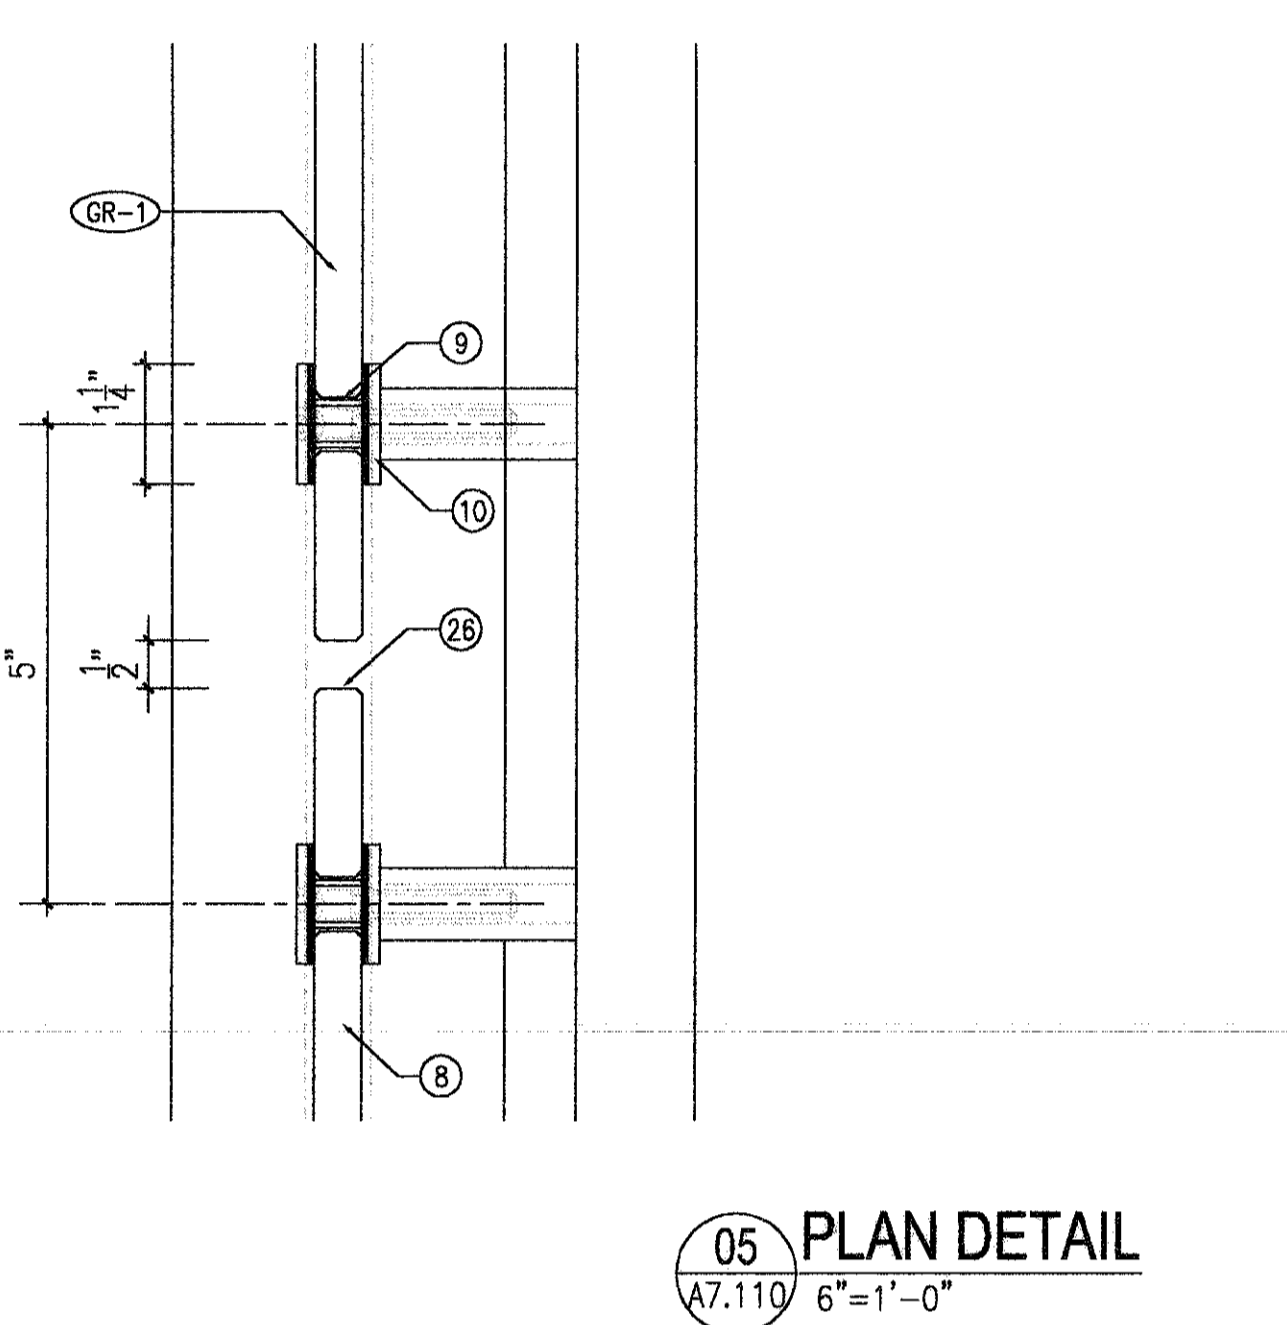


05 PLAN DETAIL  
 A7.110 6"=1'-0"

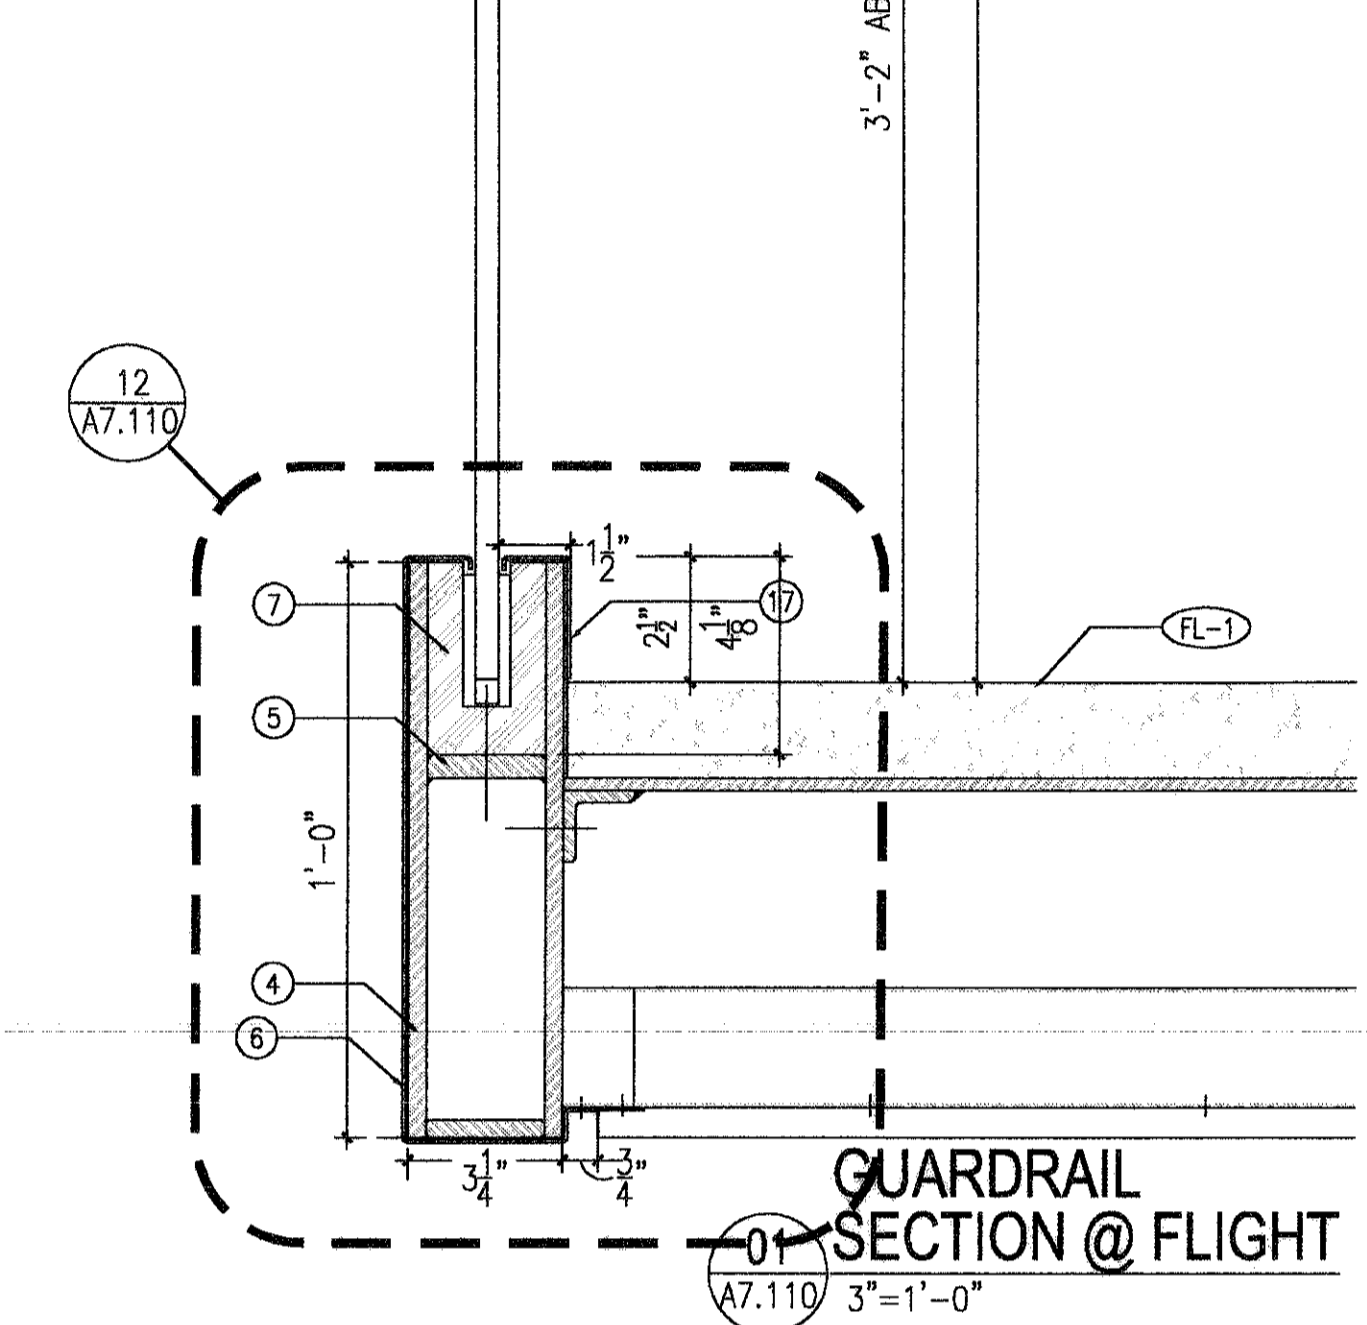


12 GUARDRAIL SECTION @ FLIGHT  
 A7.110 3"=1'-0"

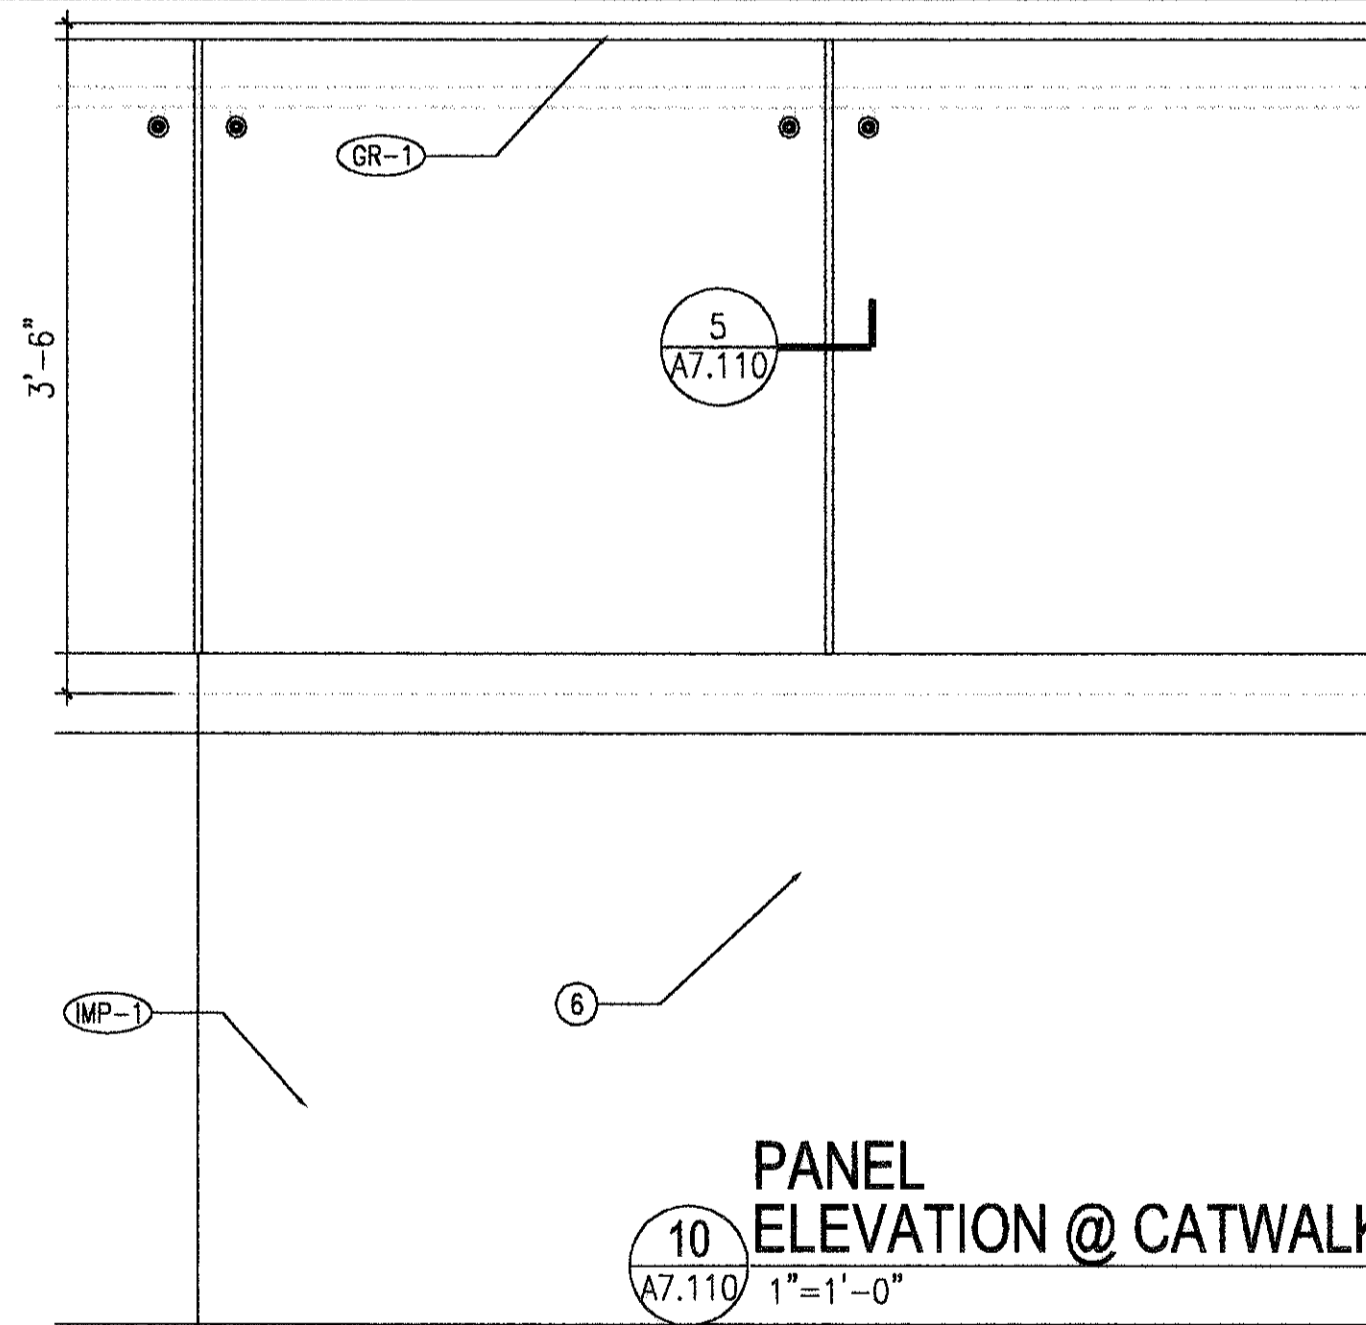


10 PANEL ELEVATION @ CATWALK  
 A7.110 1"=1'-0"

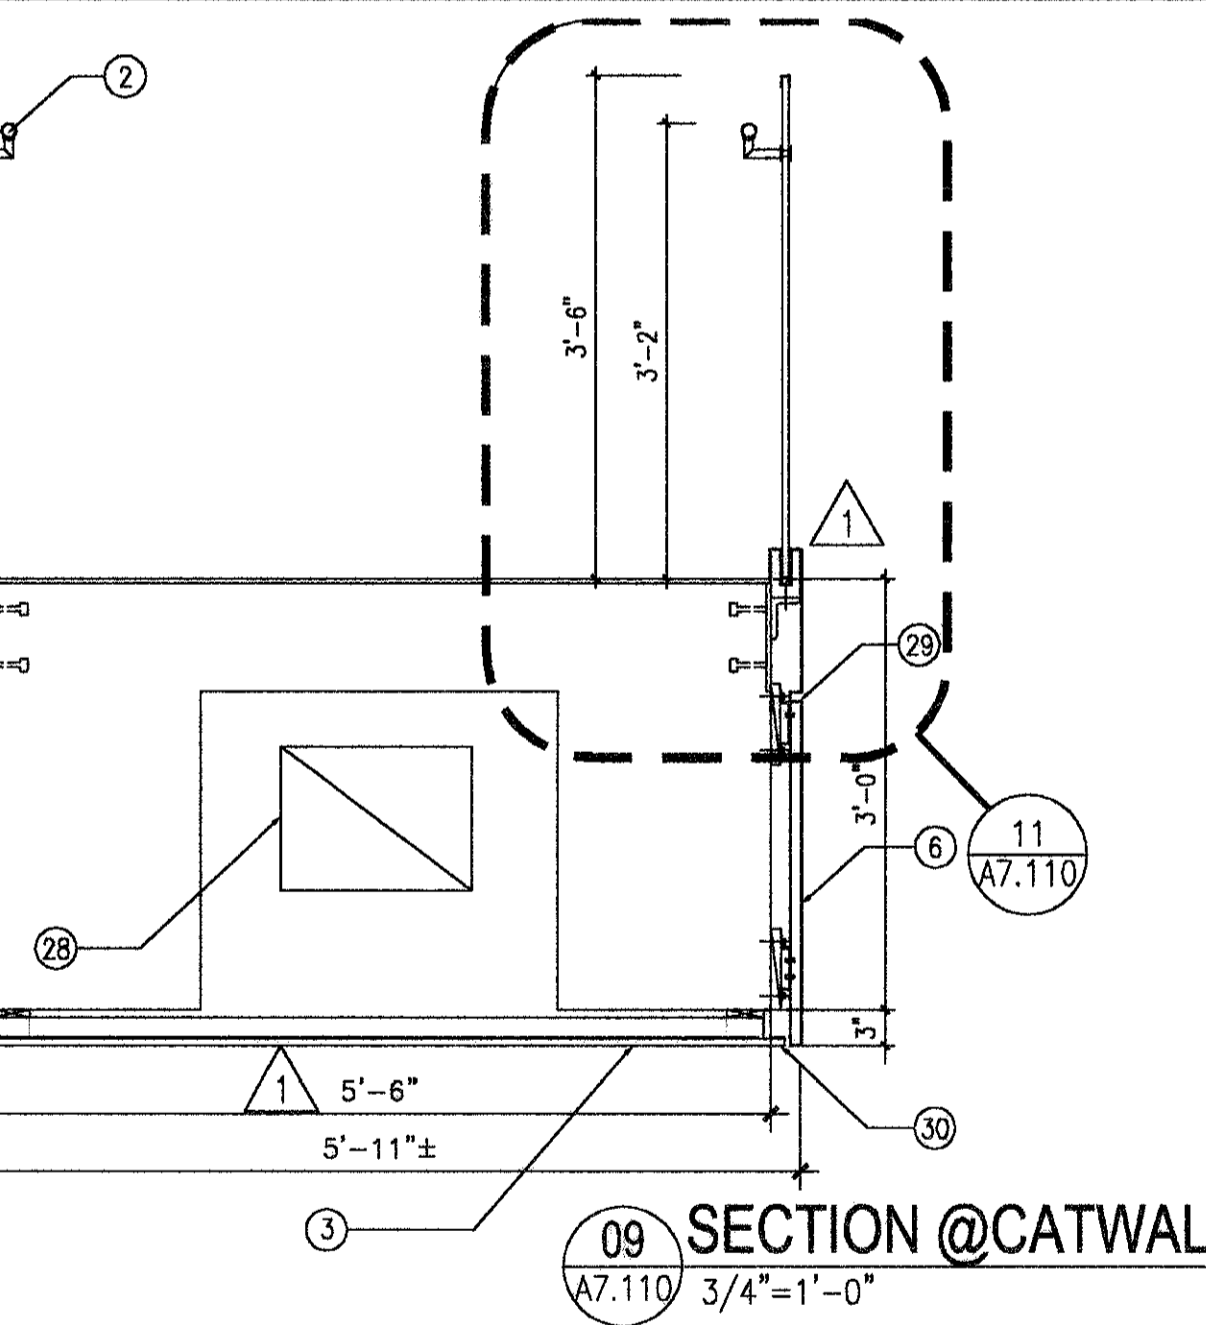


09 SECTION @ CATWALK  
 A7.110 3/4"=1'-0"

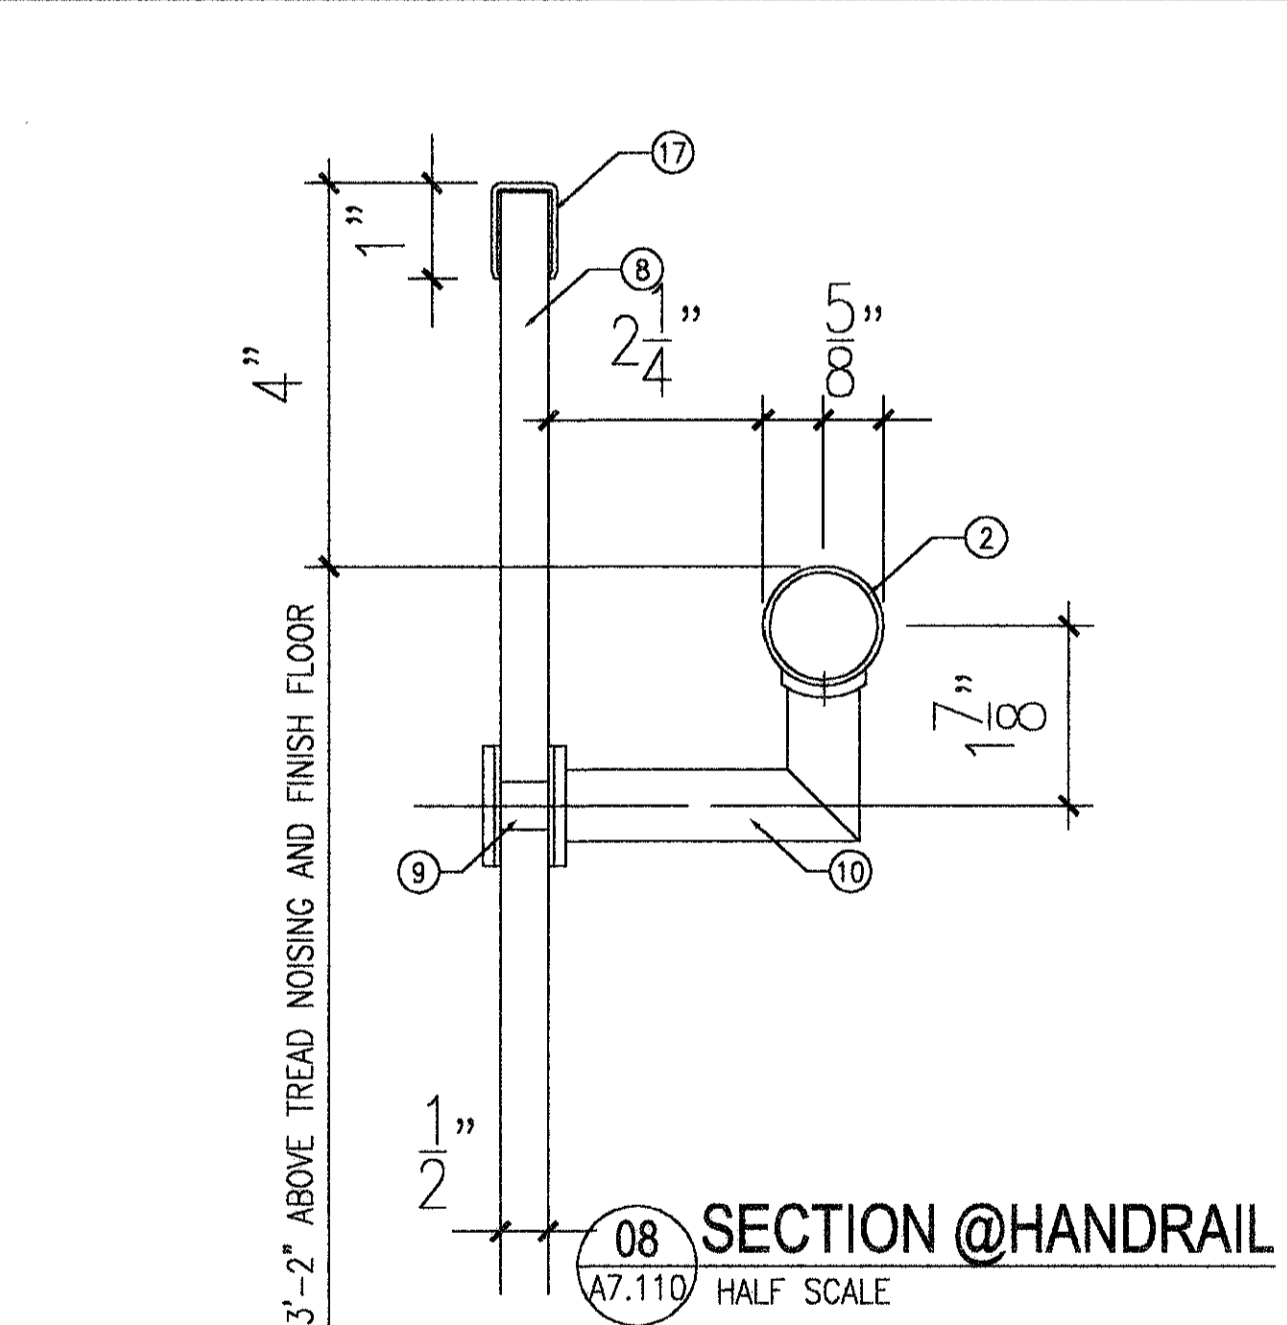

08 SECTION @ HANDRAIL  
 A7.110 HALF SCALE

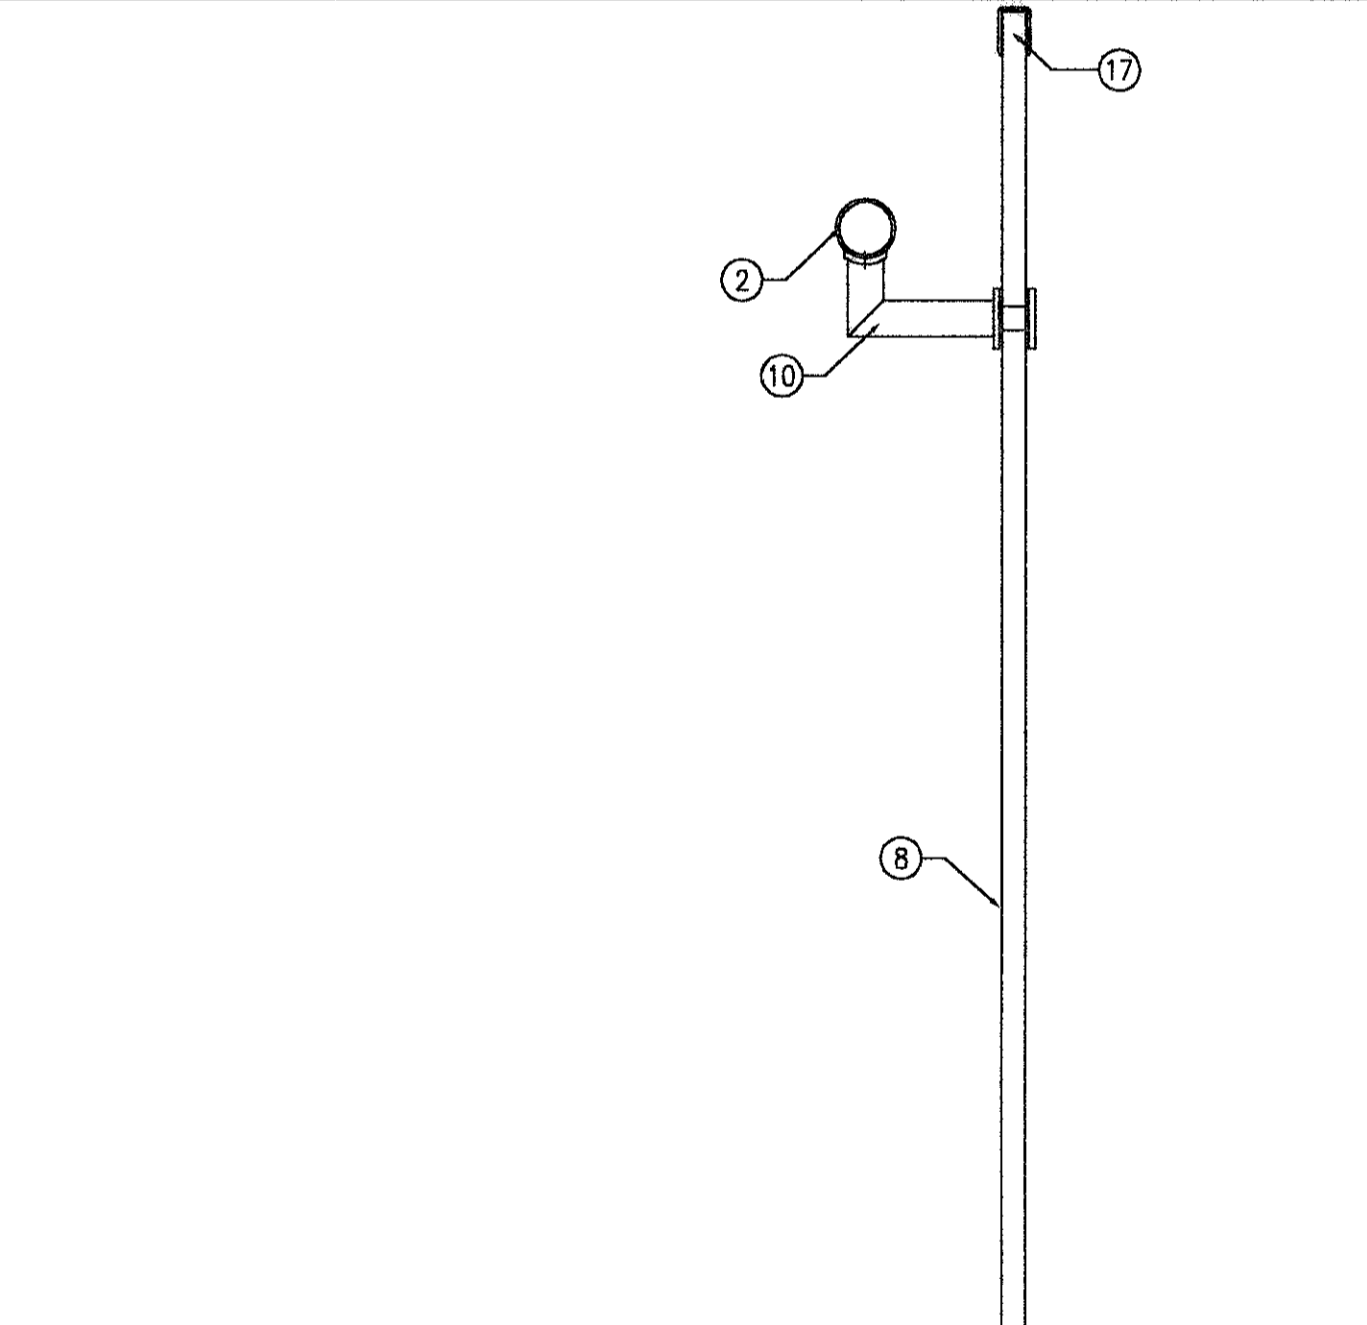


11 GUARDRAIL @ CATWALK  
 A7.110 3"=1'-0"

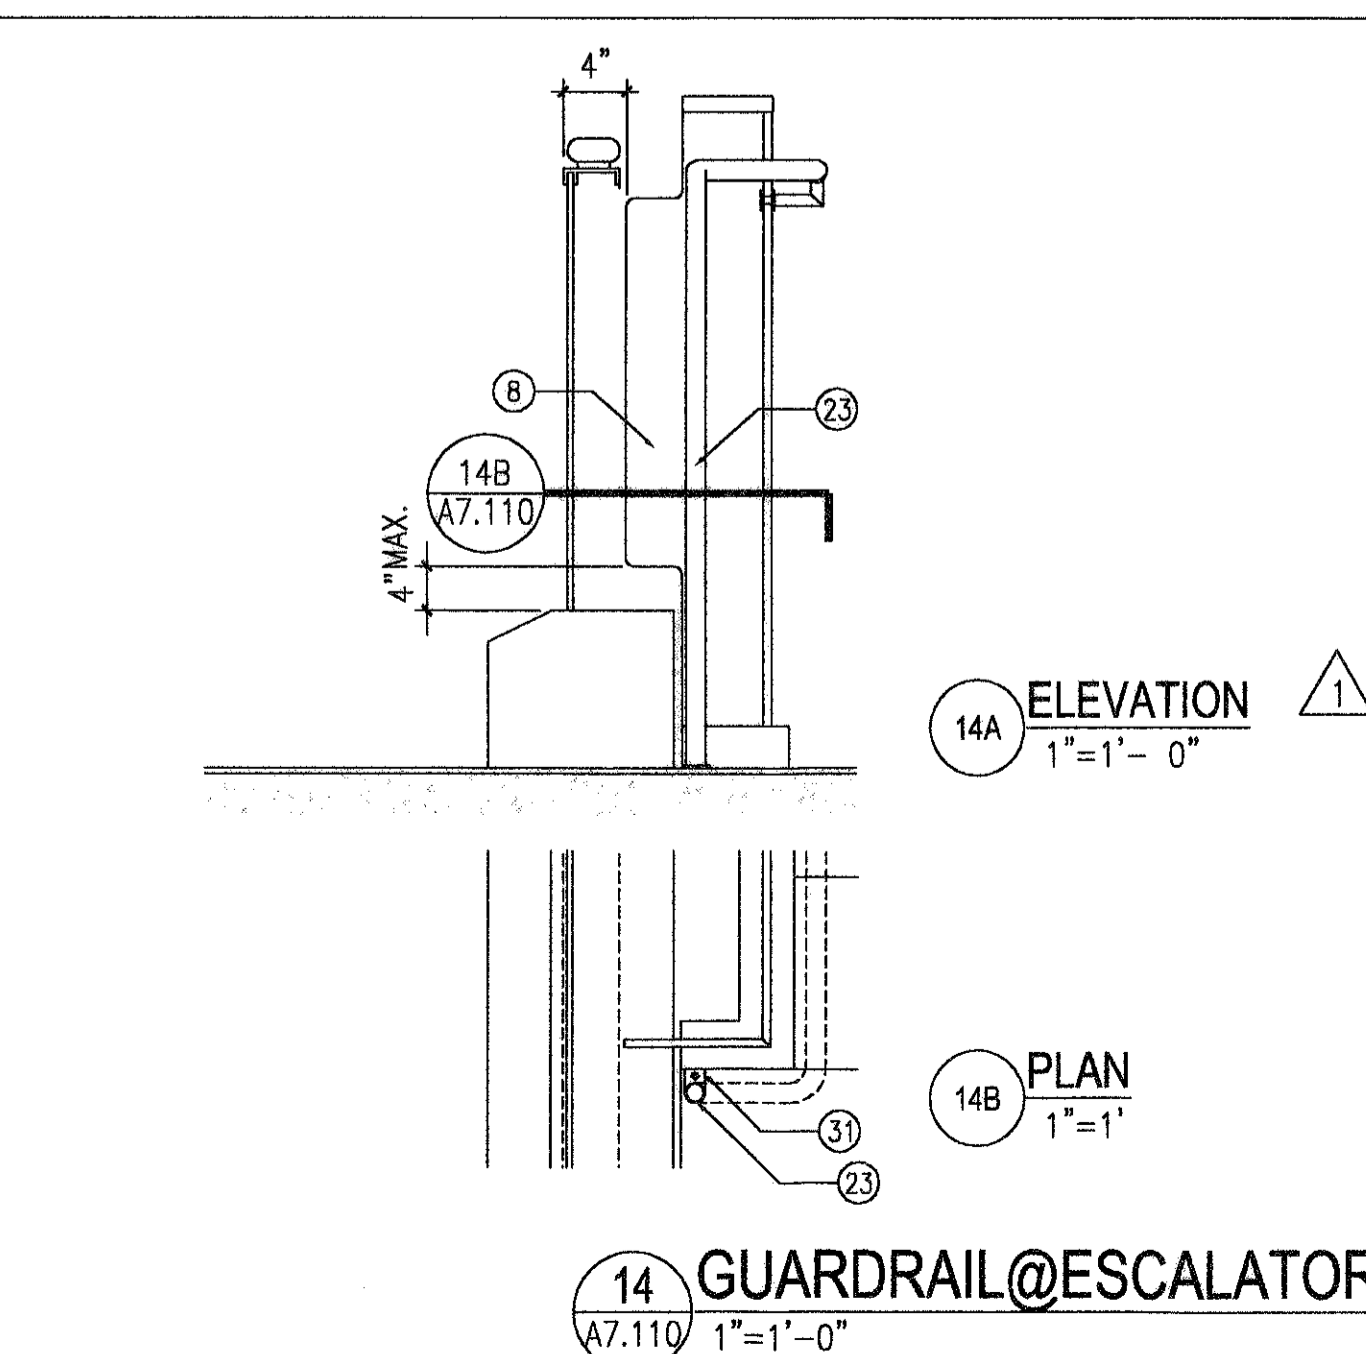


14A ELEVATION  
 1"=1'-0"

14B PLAN  
 1"=1'


14 GUARDRAIL @ ESCALATOR  
 A7.110 1"=1'-0"

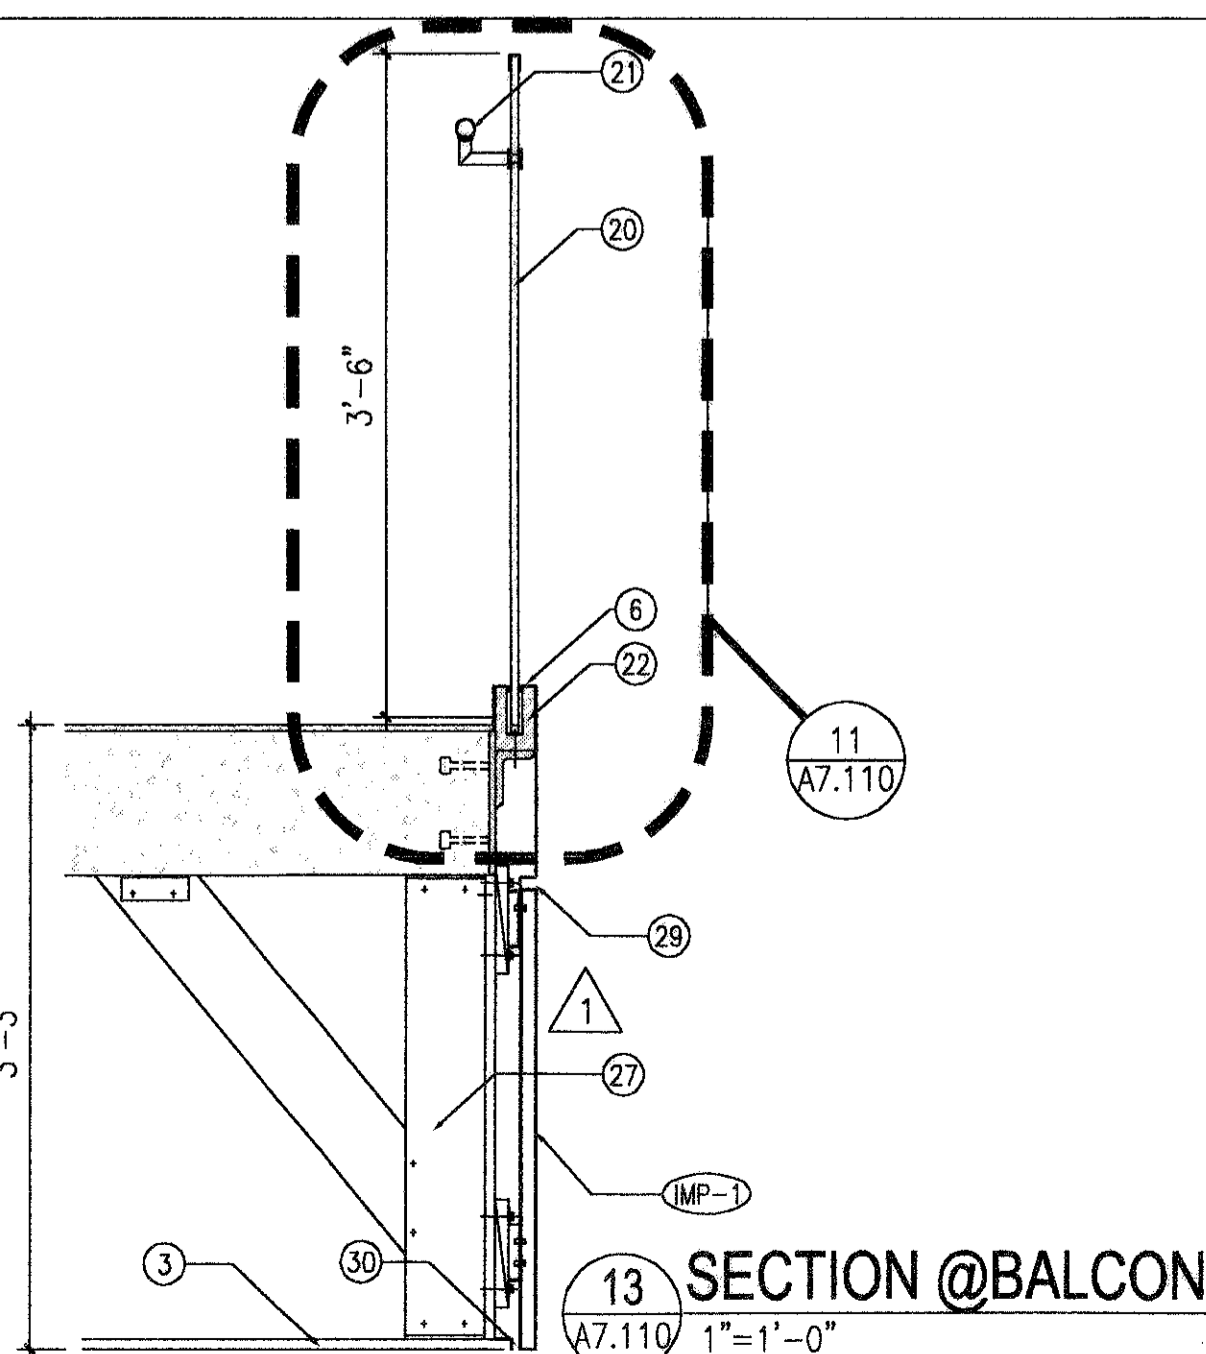

13 SECTION @ BALCONY  
 A7.110 1"=1'-0"

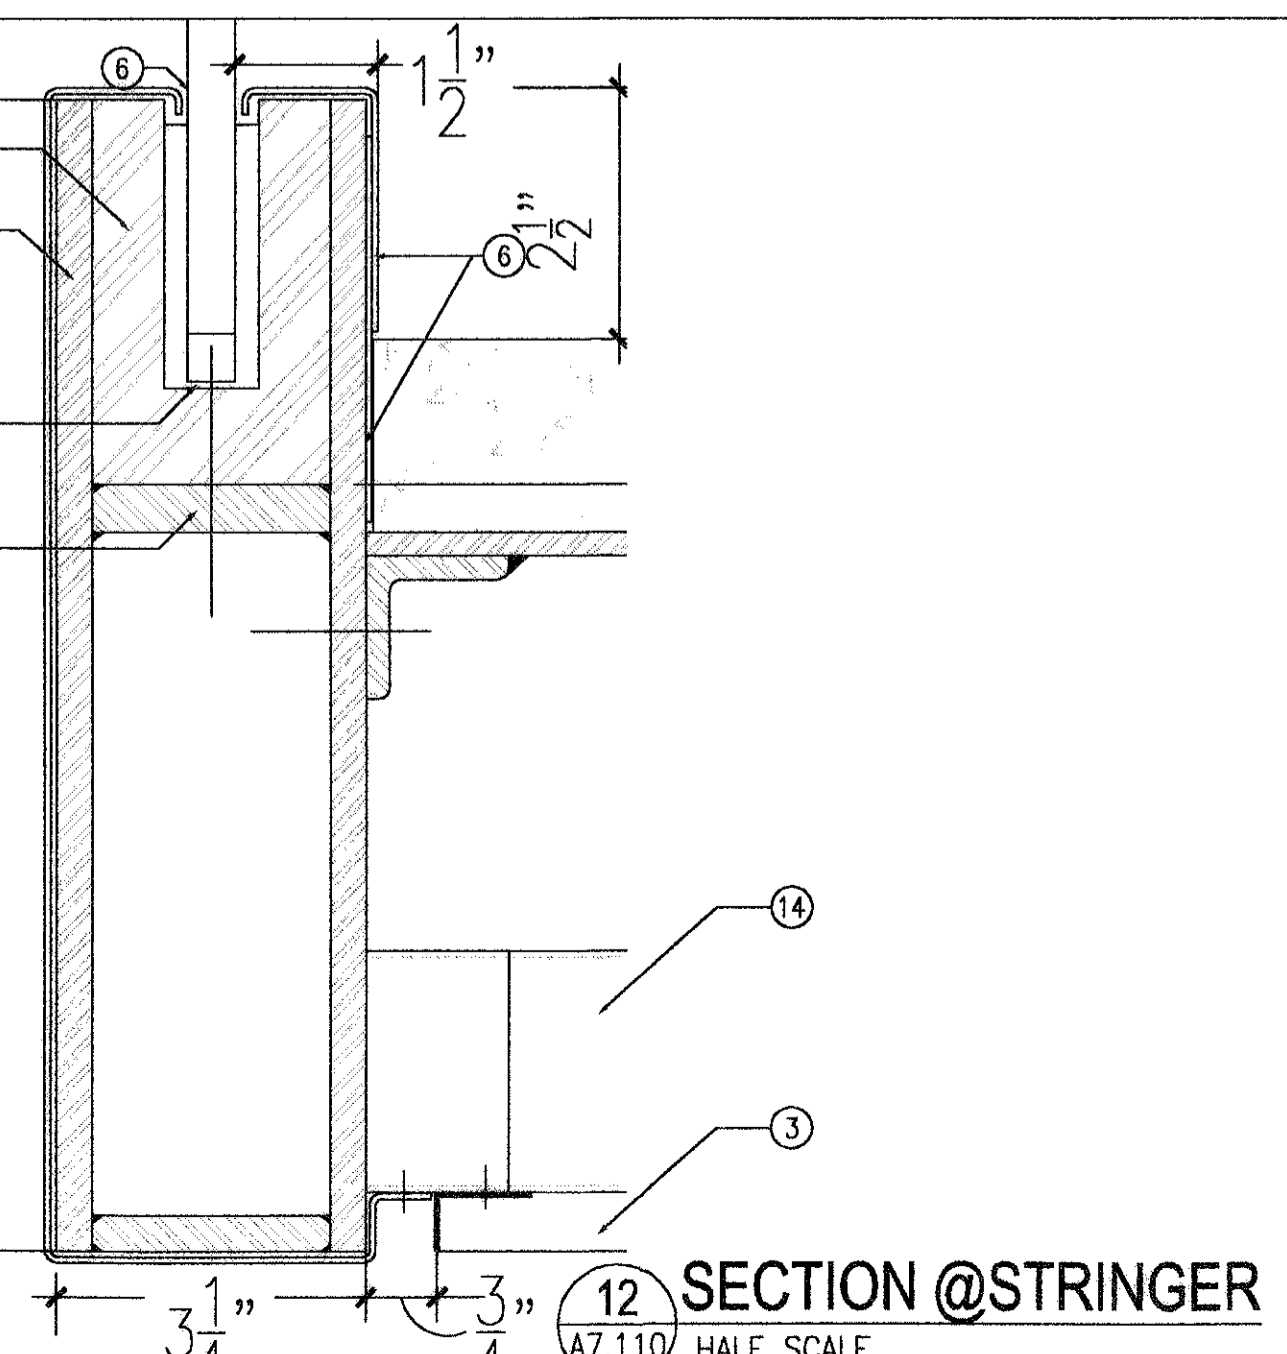


12 SECTION @ STRINGER  
 A7.110 HALF SCALE

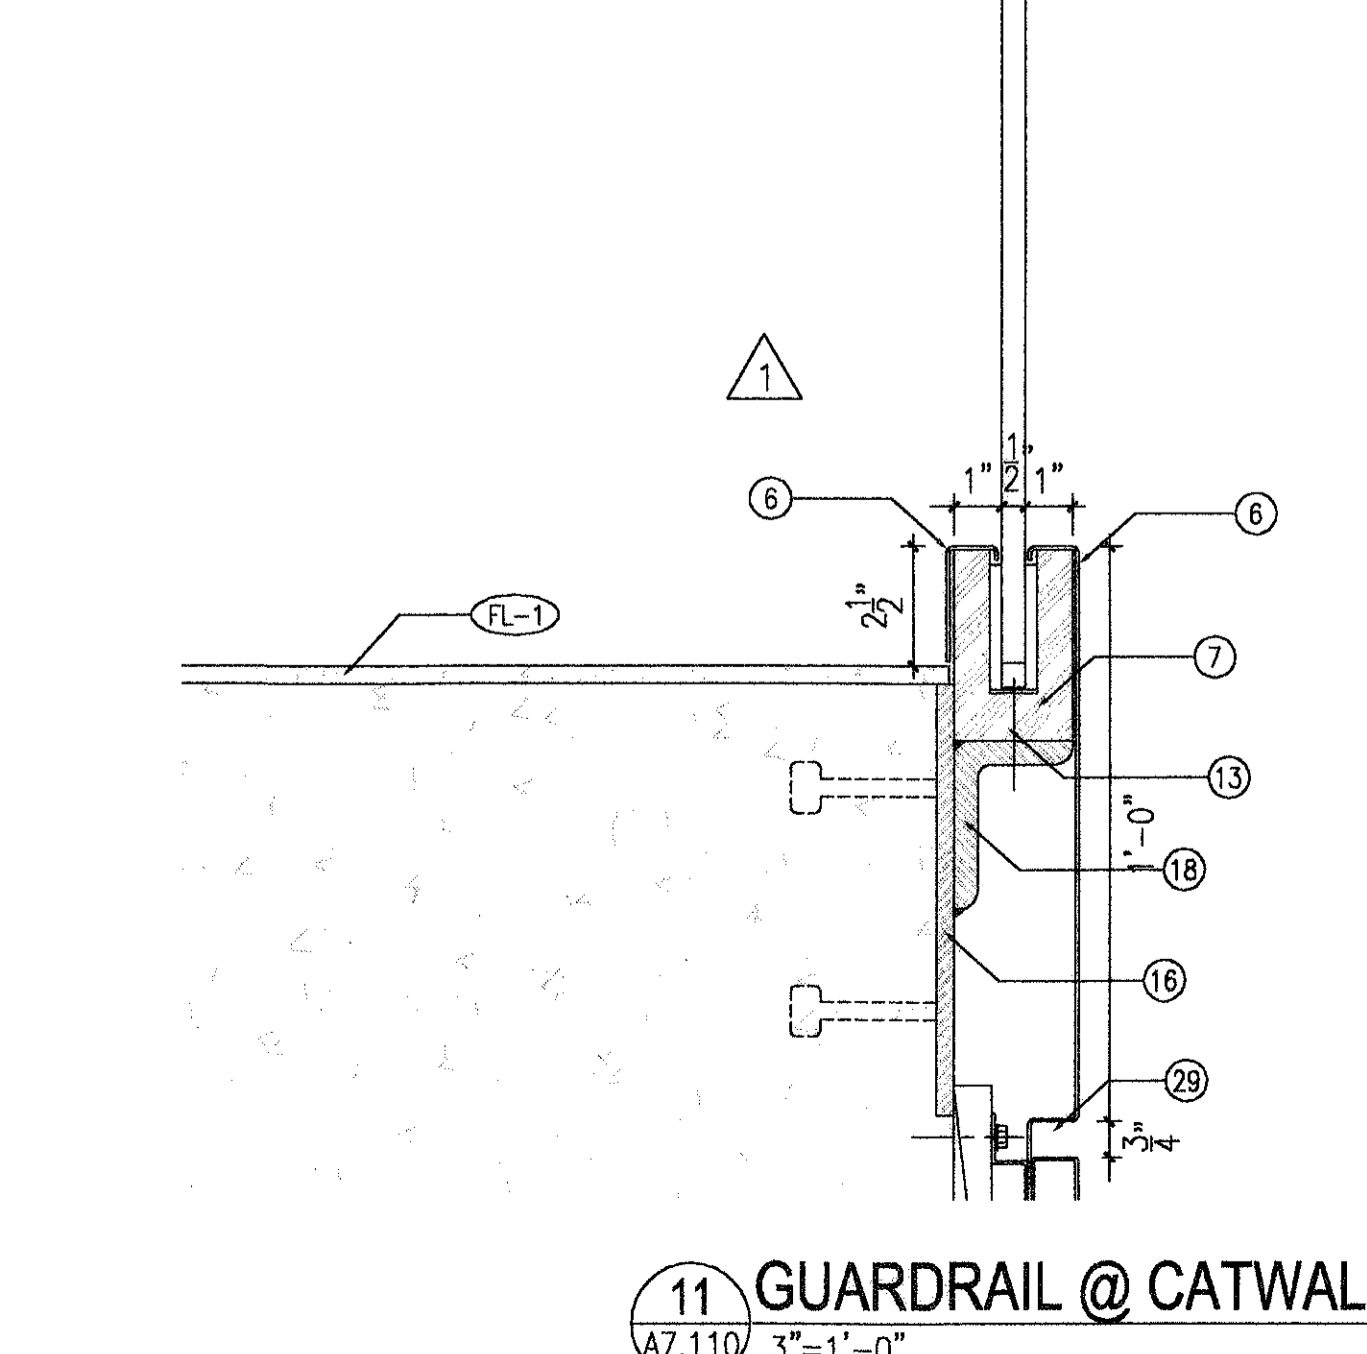


11 GUARDRAIL @ CATWALK  
 A7.110 3"=1'-0"

PLOT DATE: 02/04/02 HAS FILE: HASRCA7110




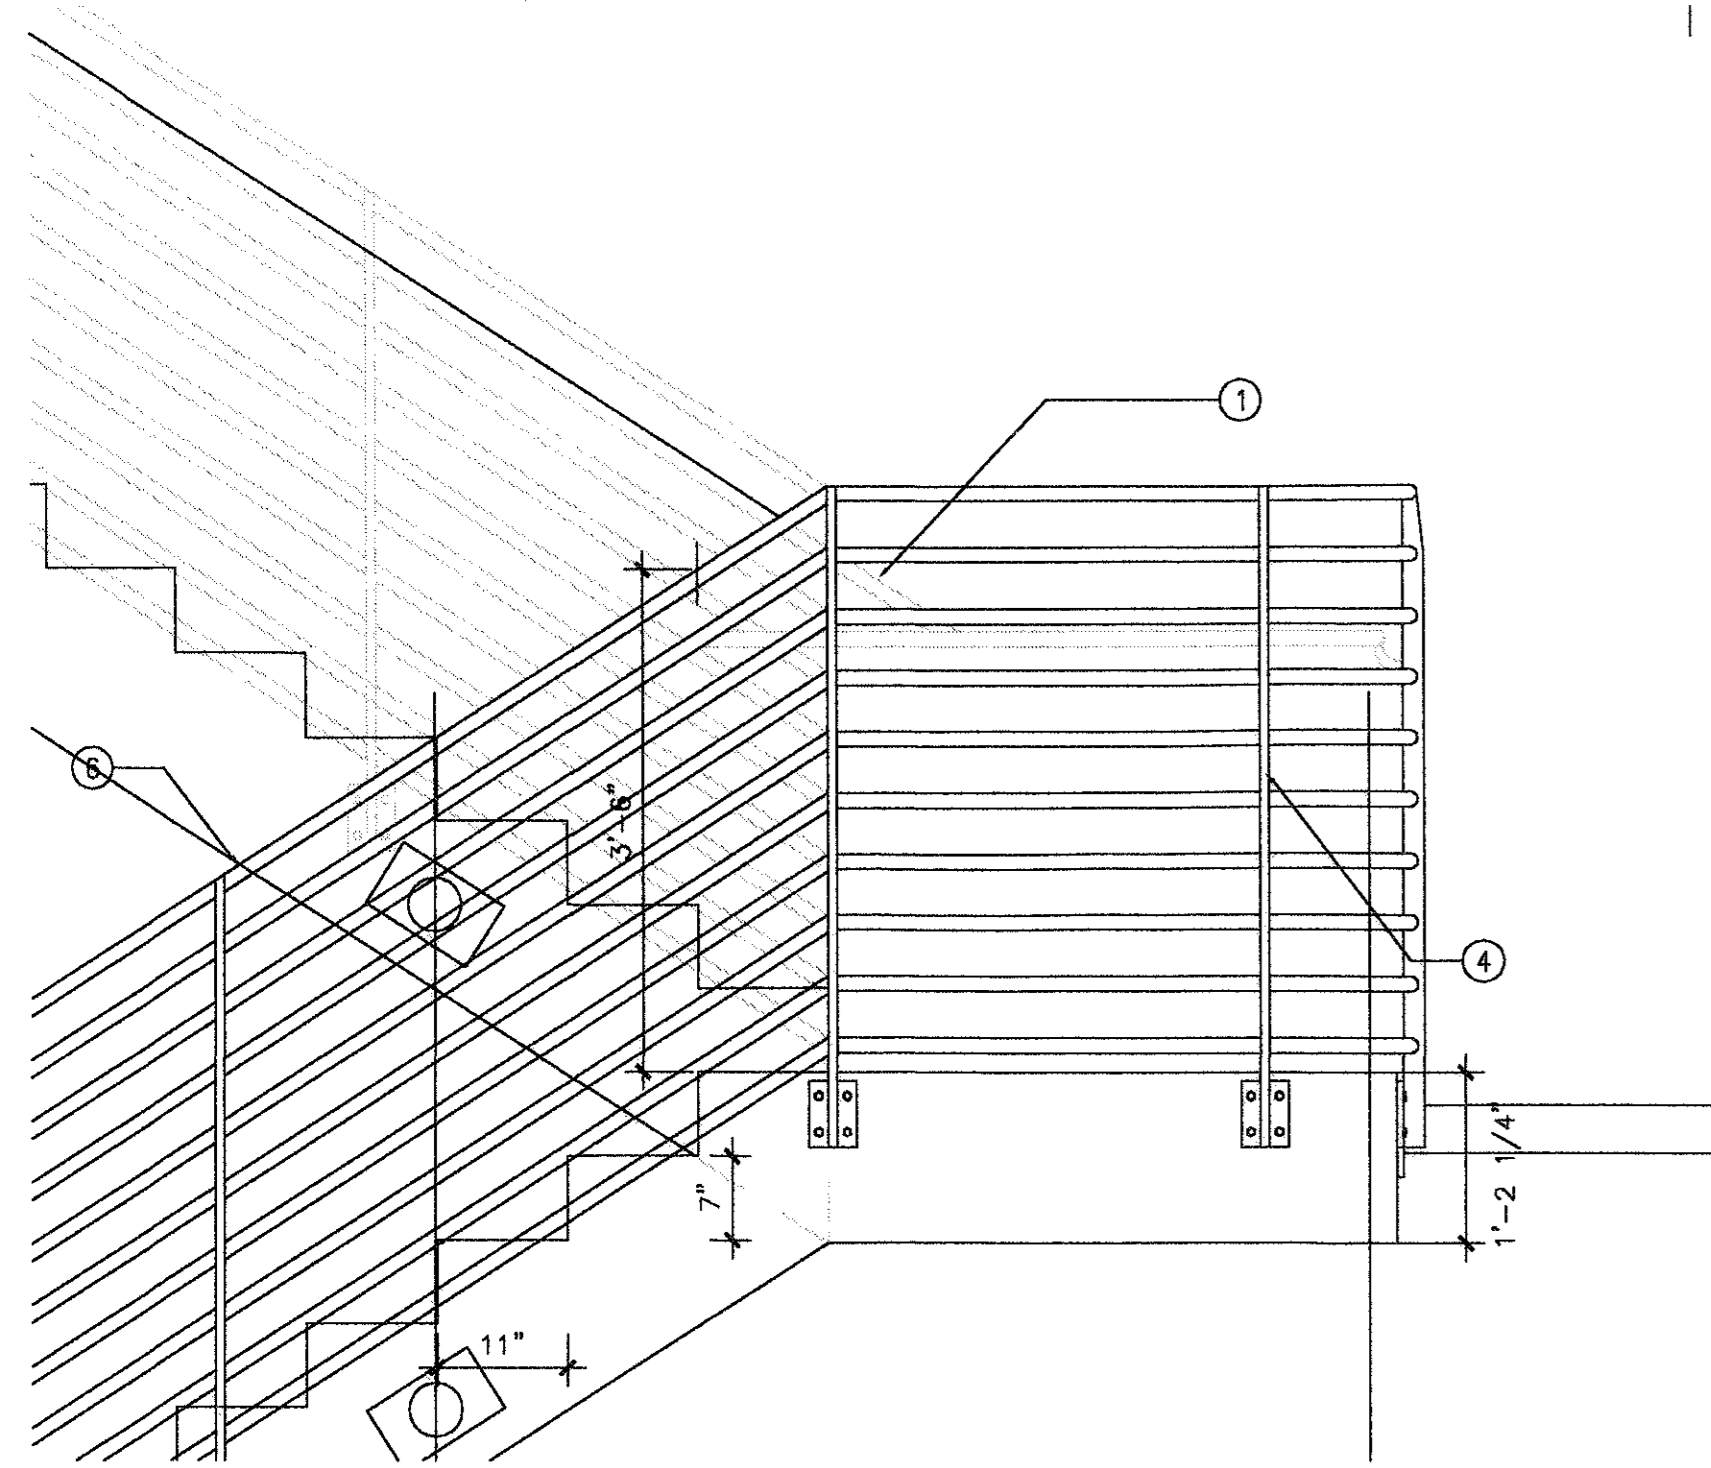


**ELEVATION @ LANDING  
STAIR #2**  
02  
A7.120 3/4"=1'-0"

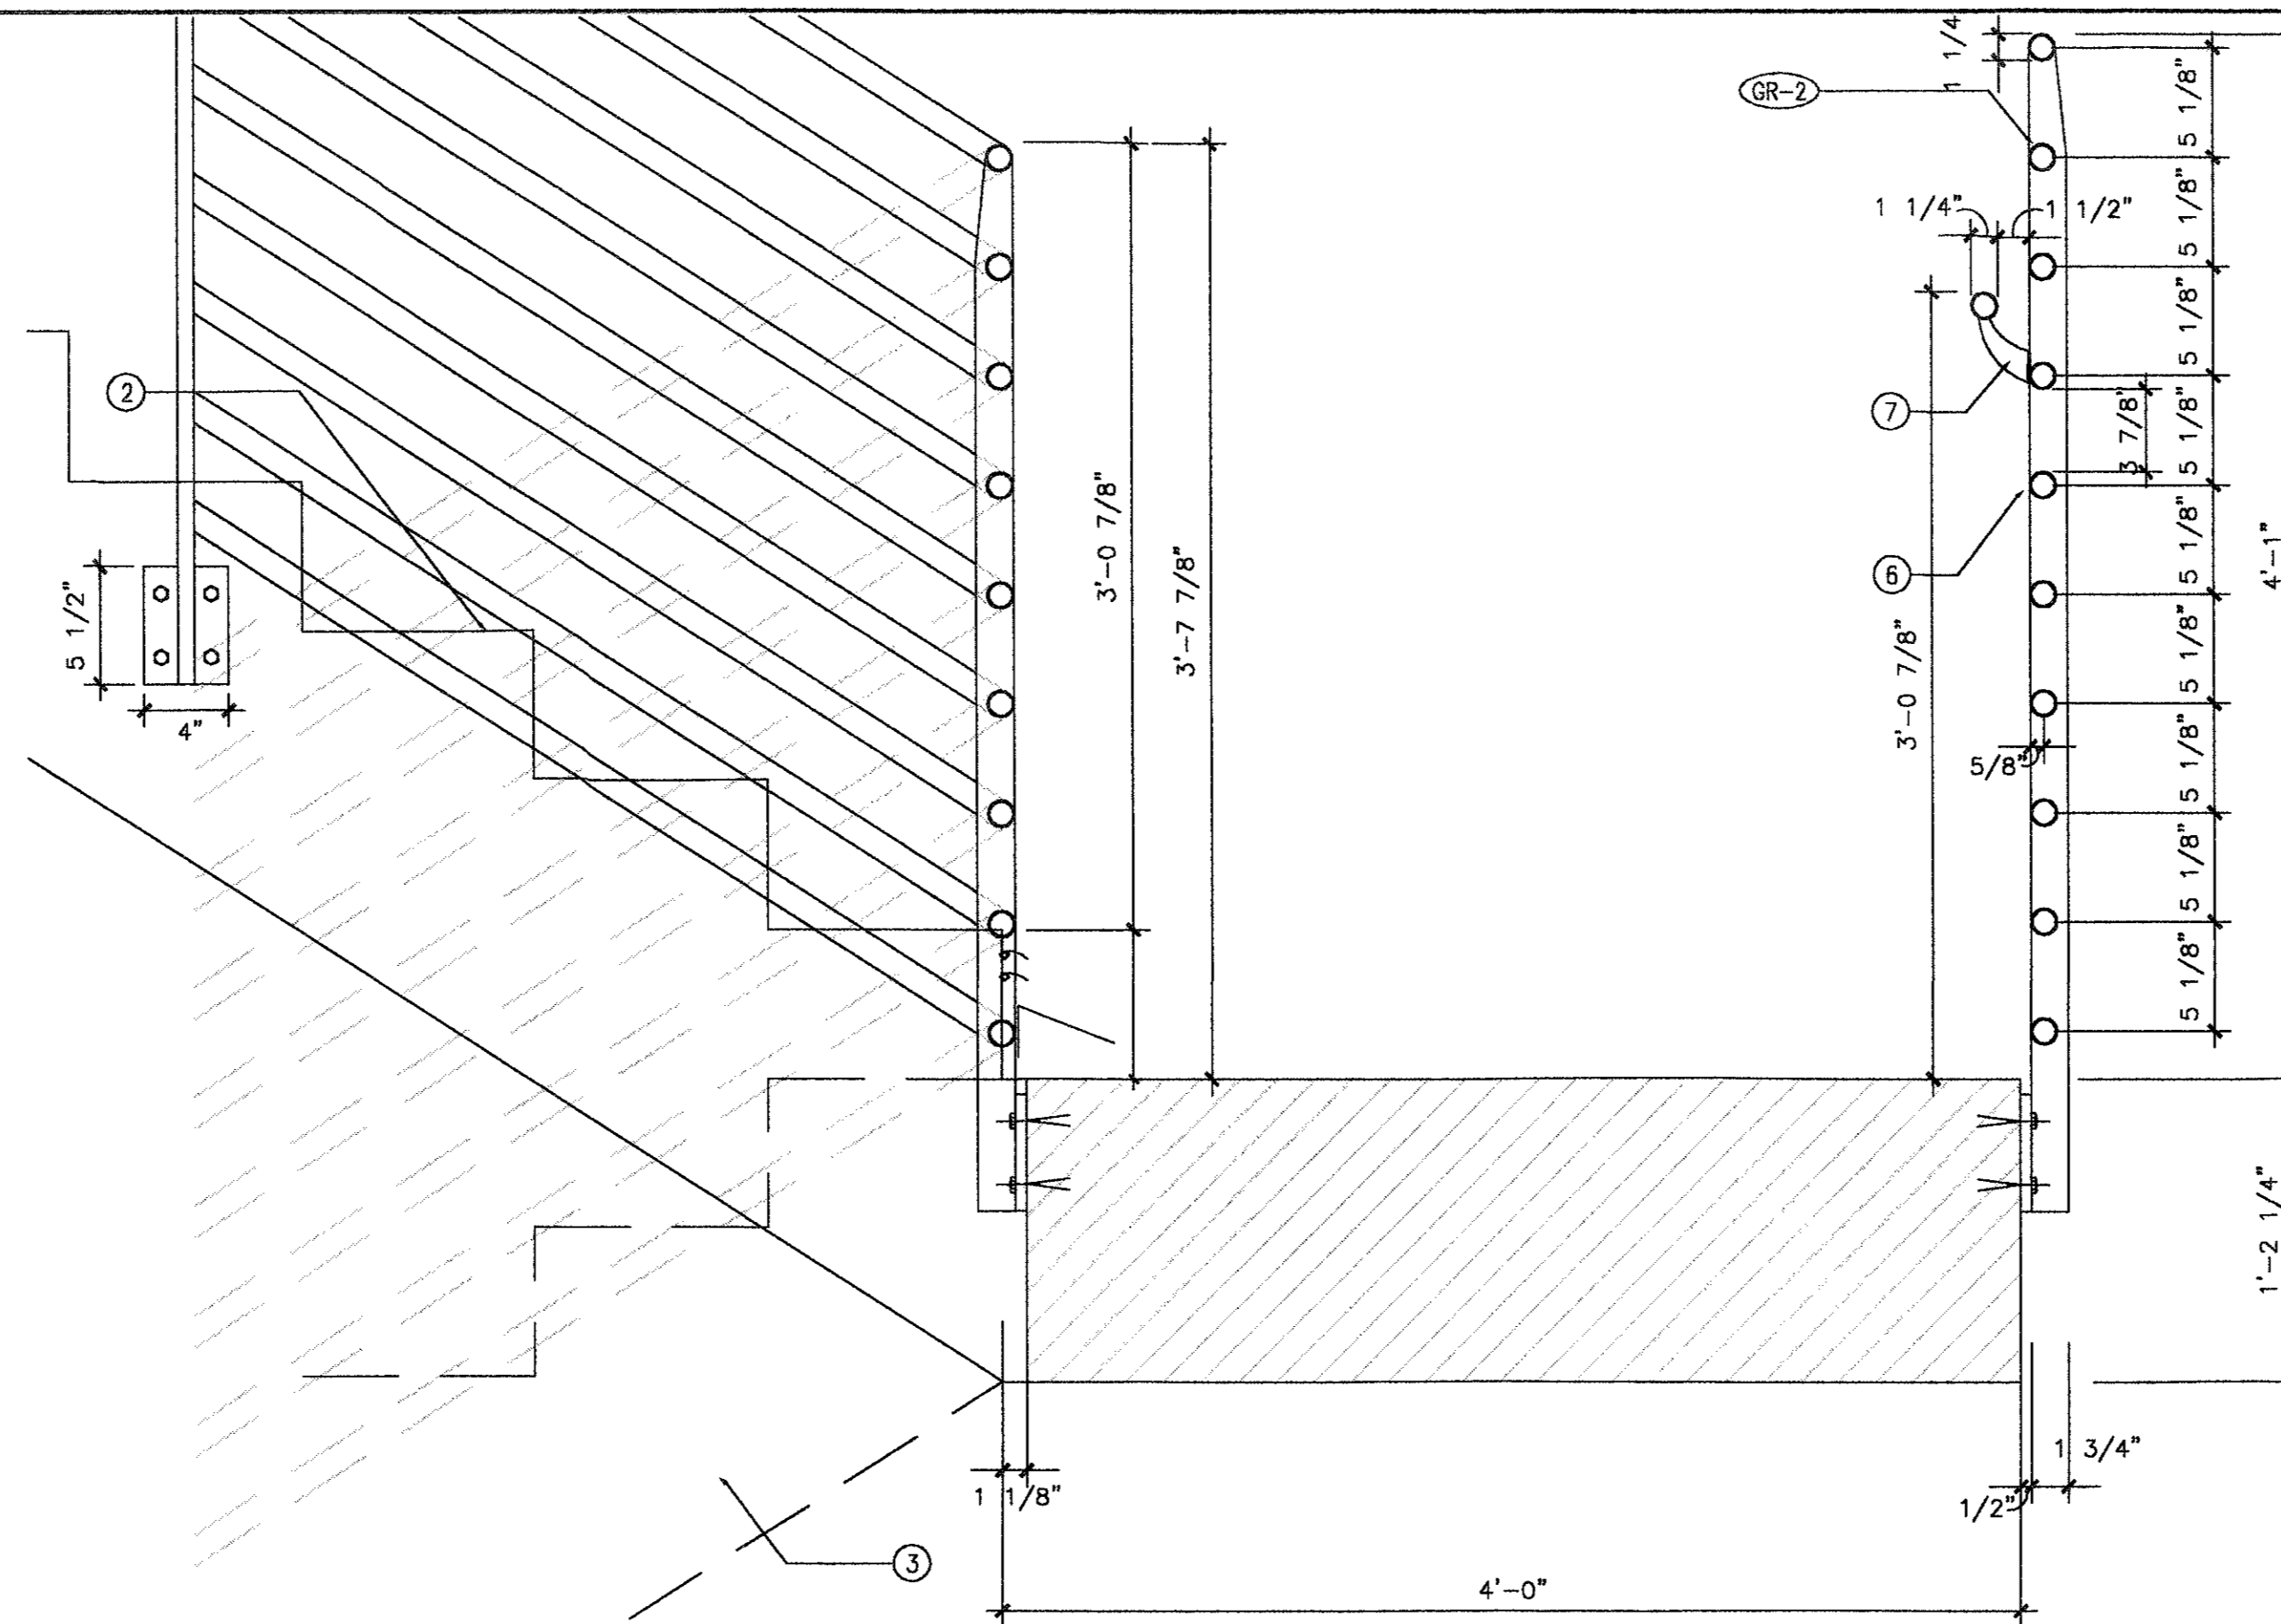


**SECTION @ LANDING  
STAIR #2**  
01  
A7.120 1 1/2"=1'-0"

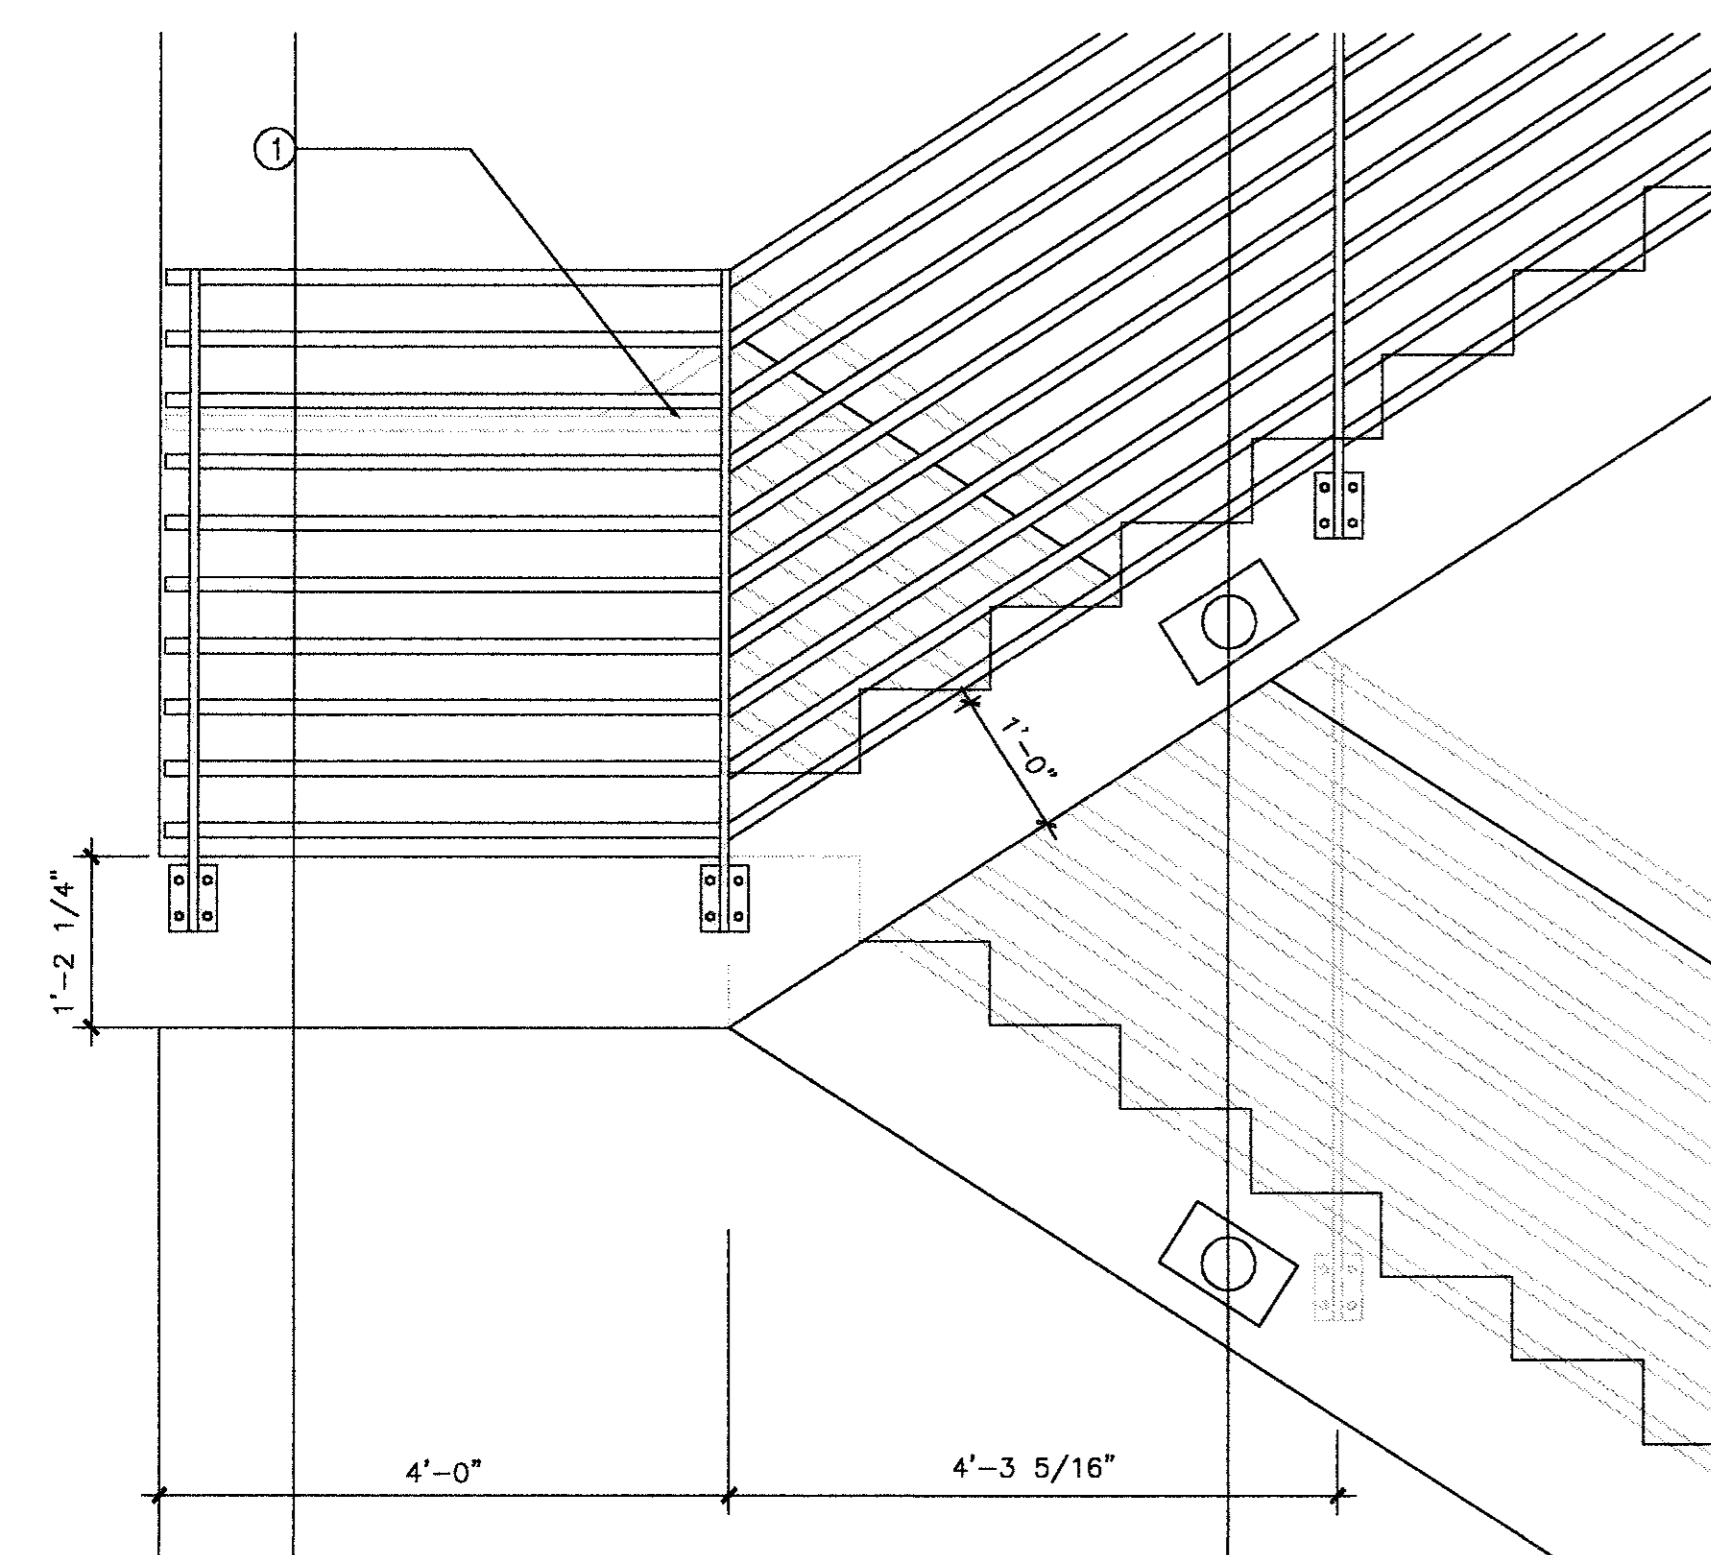


**ELEVATION @ LANDING  
STAIR #2**  
04  
A7.120 3/4"=1'-0"

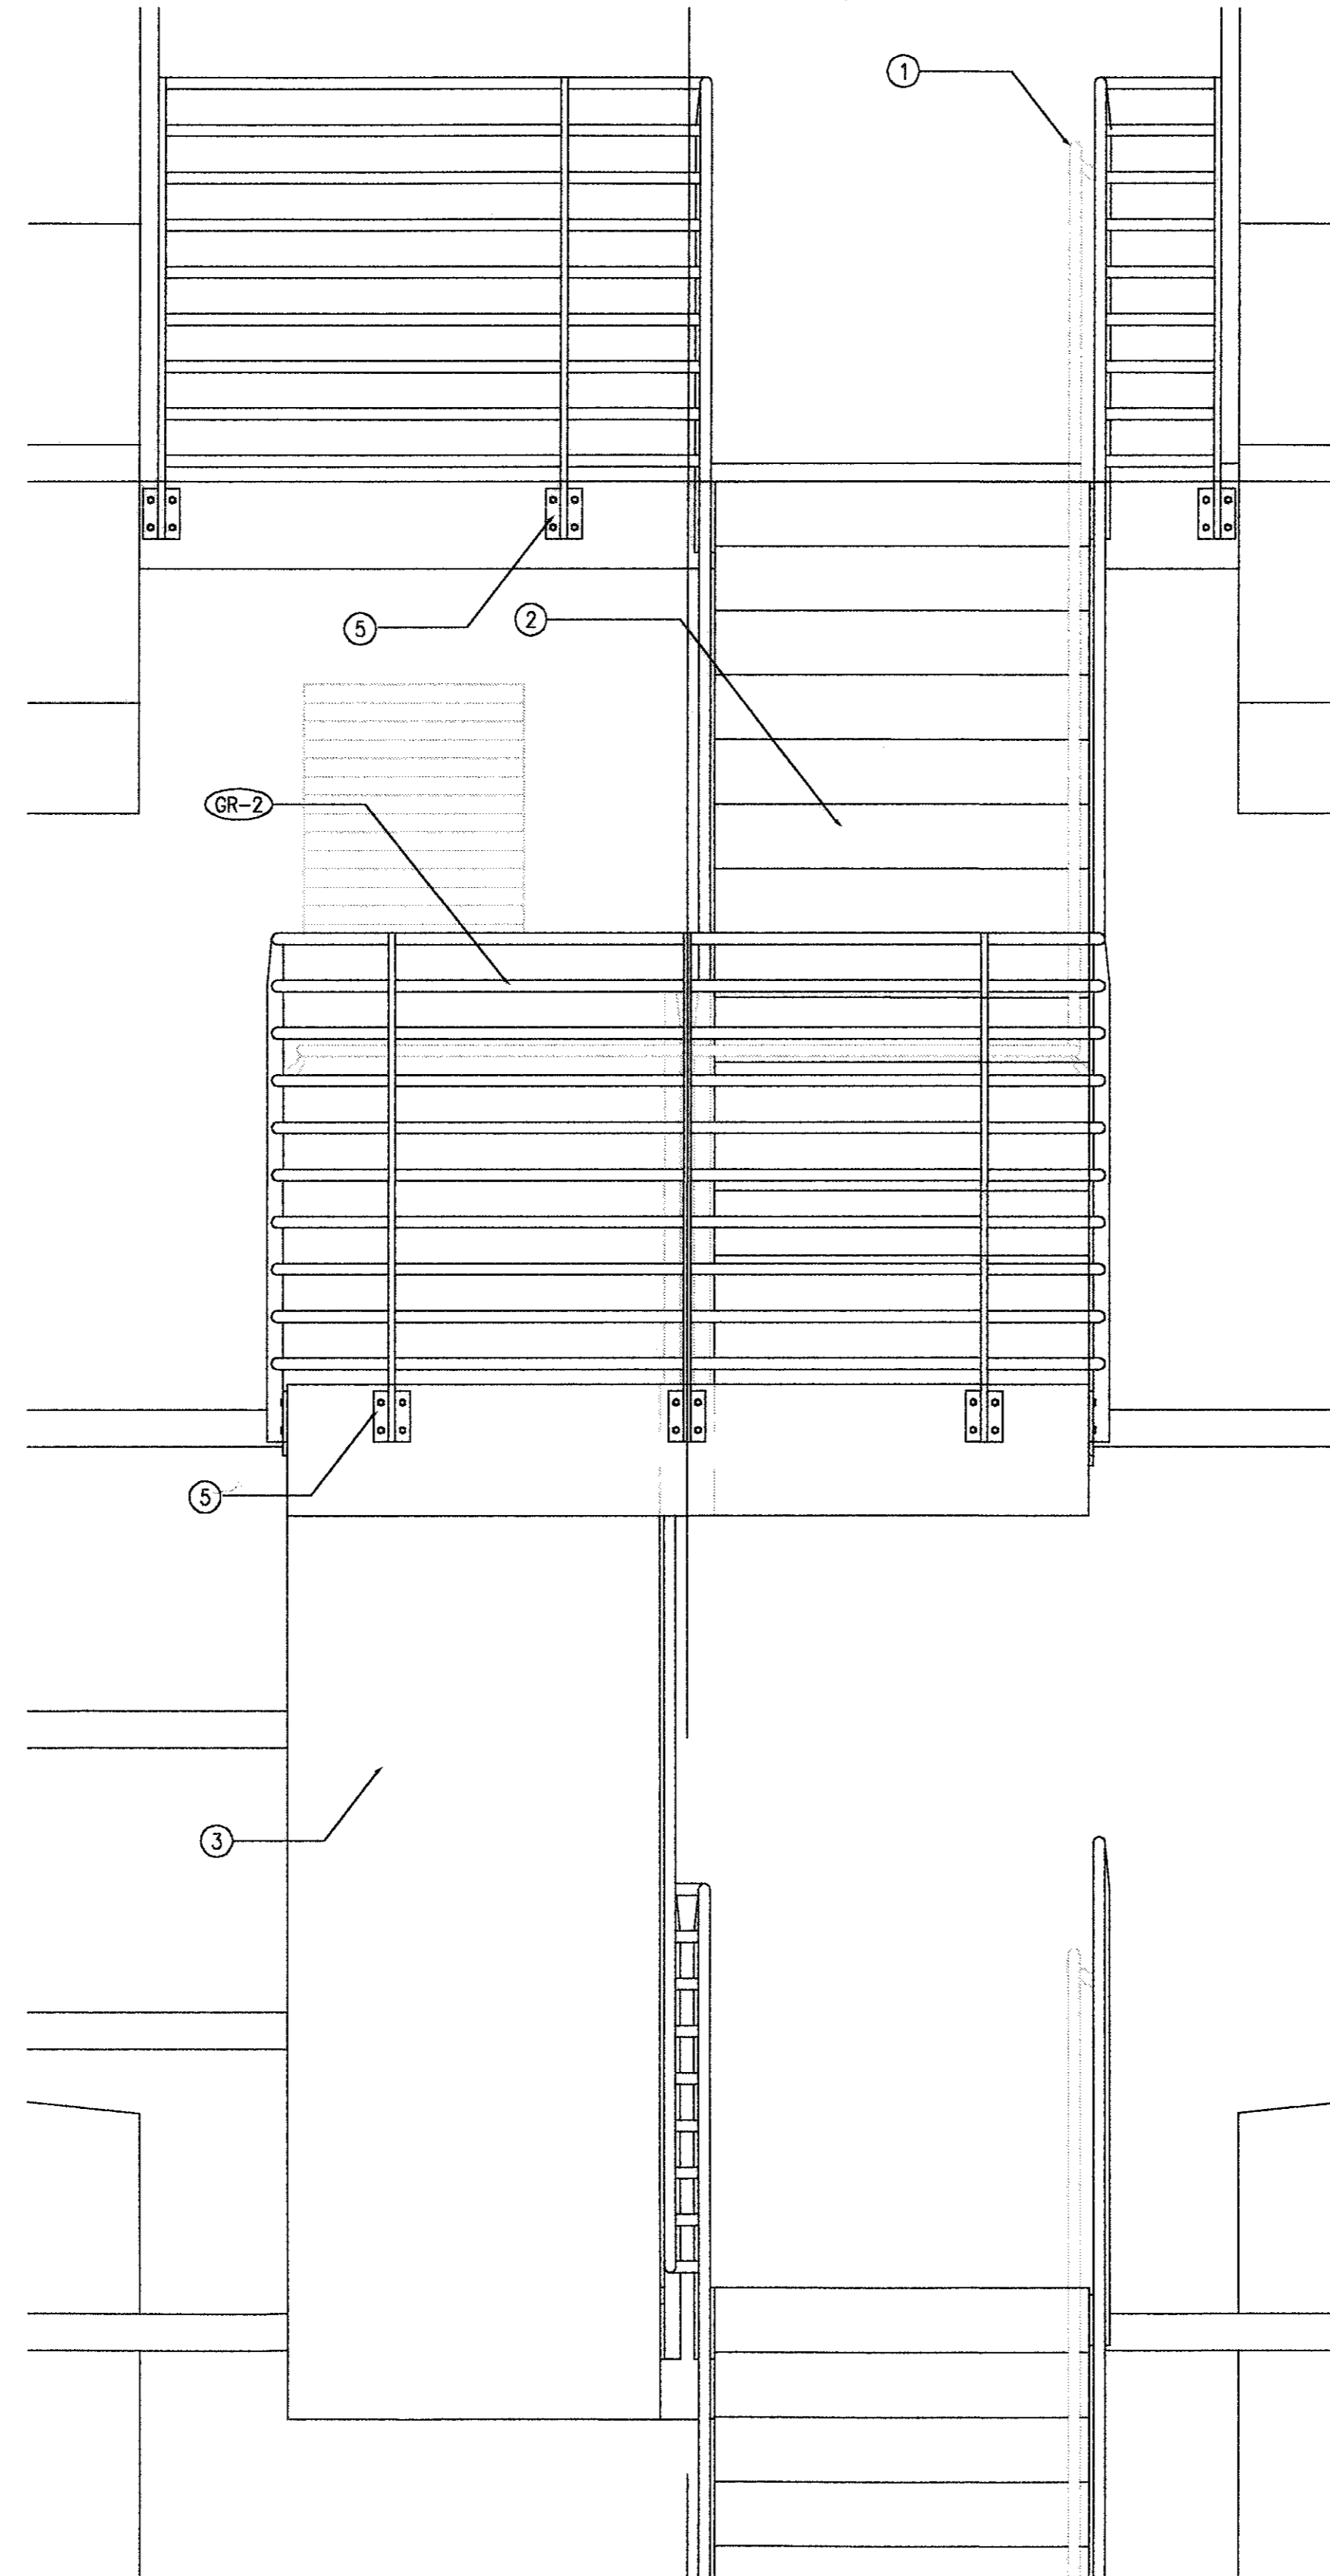


**FRONT ELEVATION  
STAIR #2**  
06  
A7.120 3/4"=1'-0"

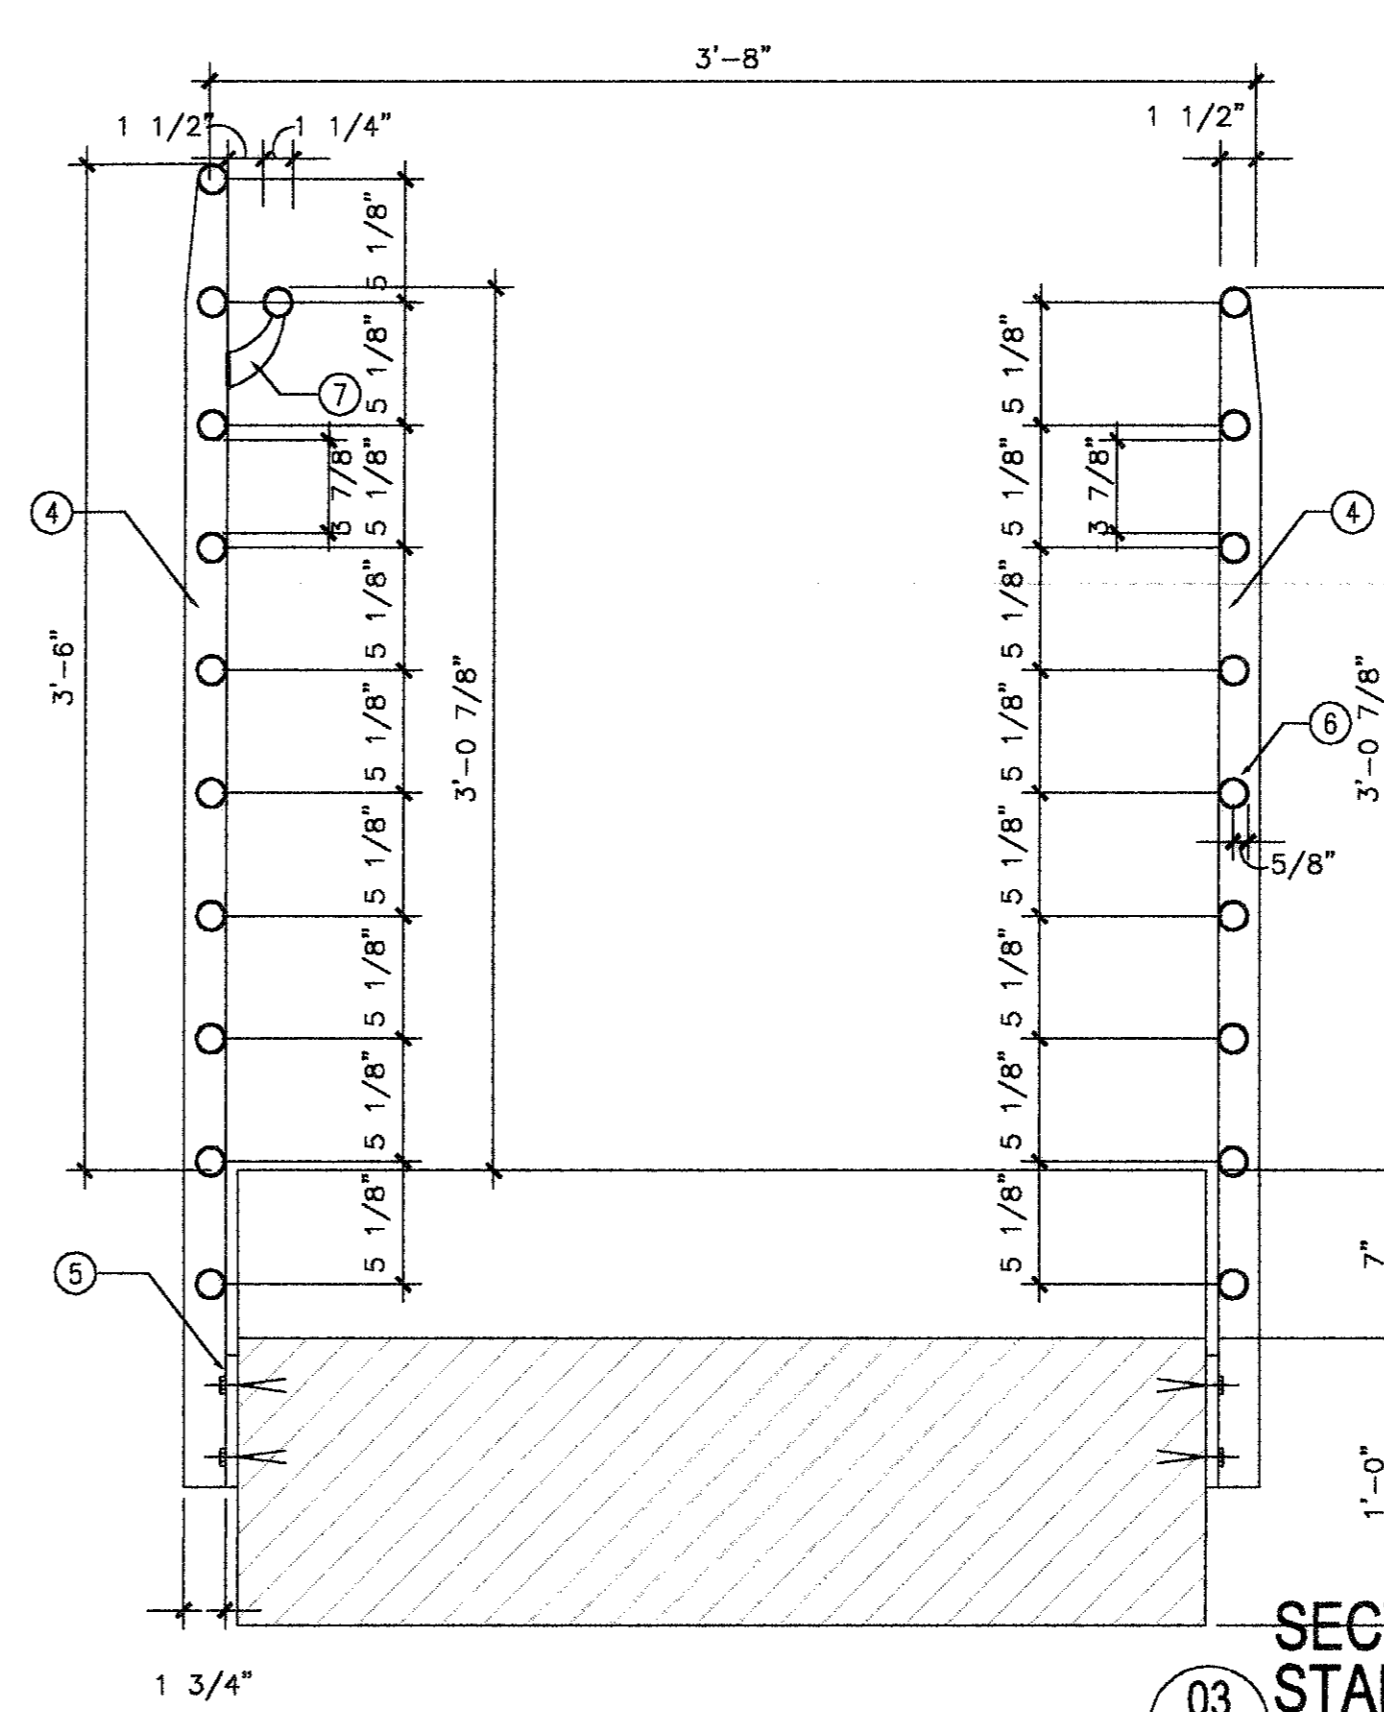

**SECTION @ FLIGHT  
STAIR #2**  
03  
A7.120 1 1/2"=1'-0"

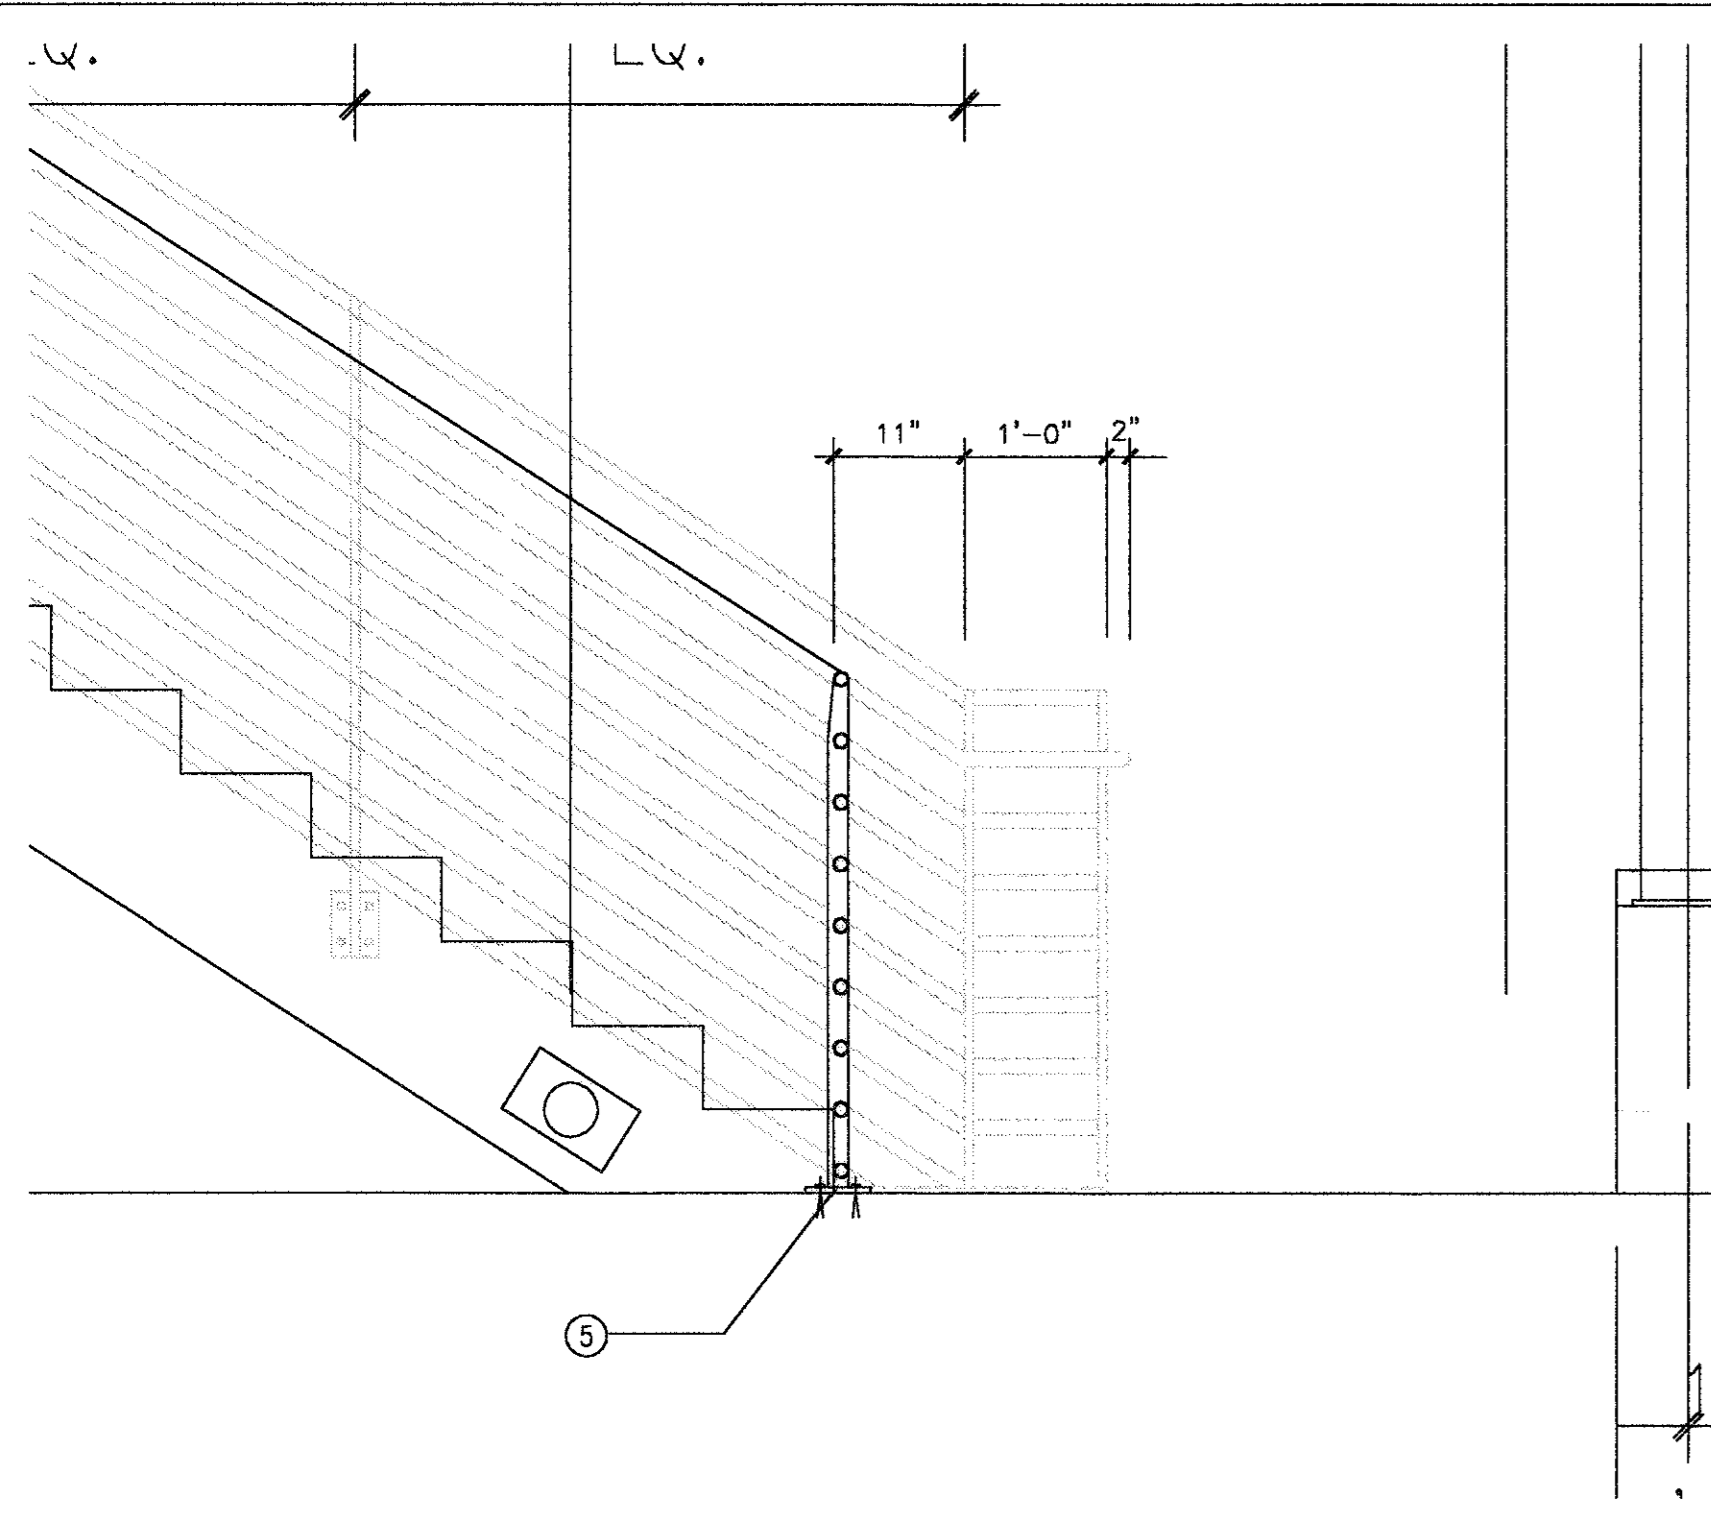

**ELEVATION @ LANDING  
STAIR #2**  
07  
A7.120 3/4"=1'-0"

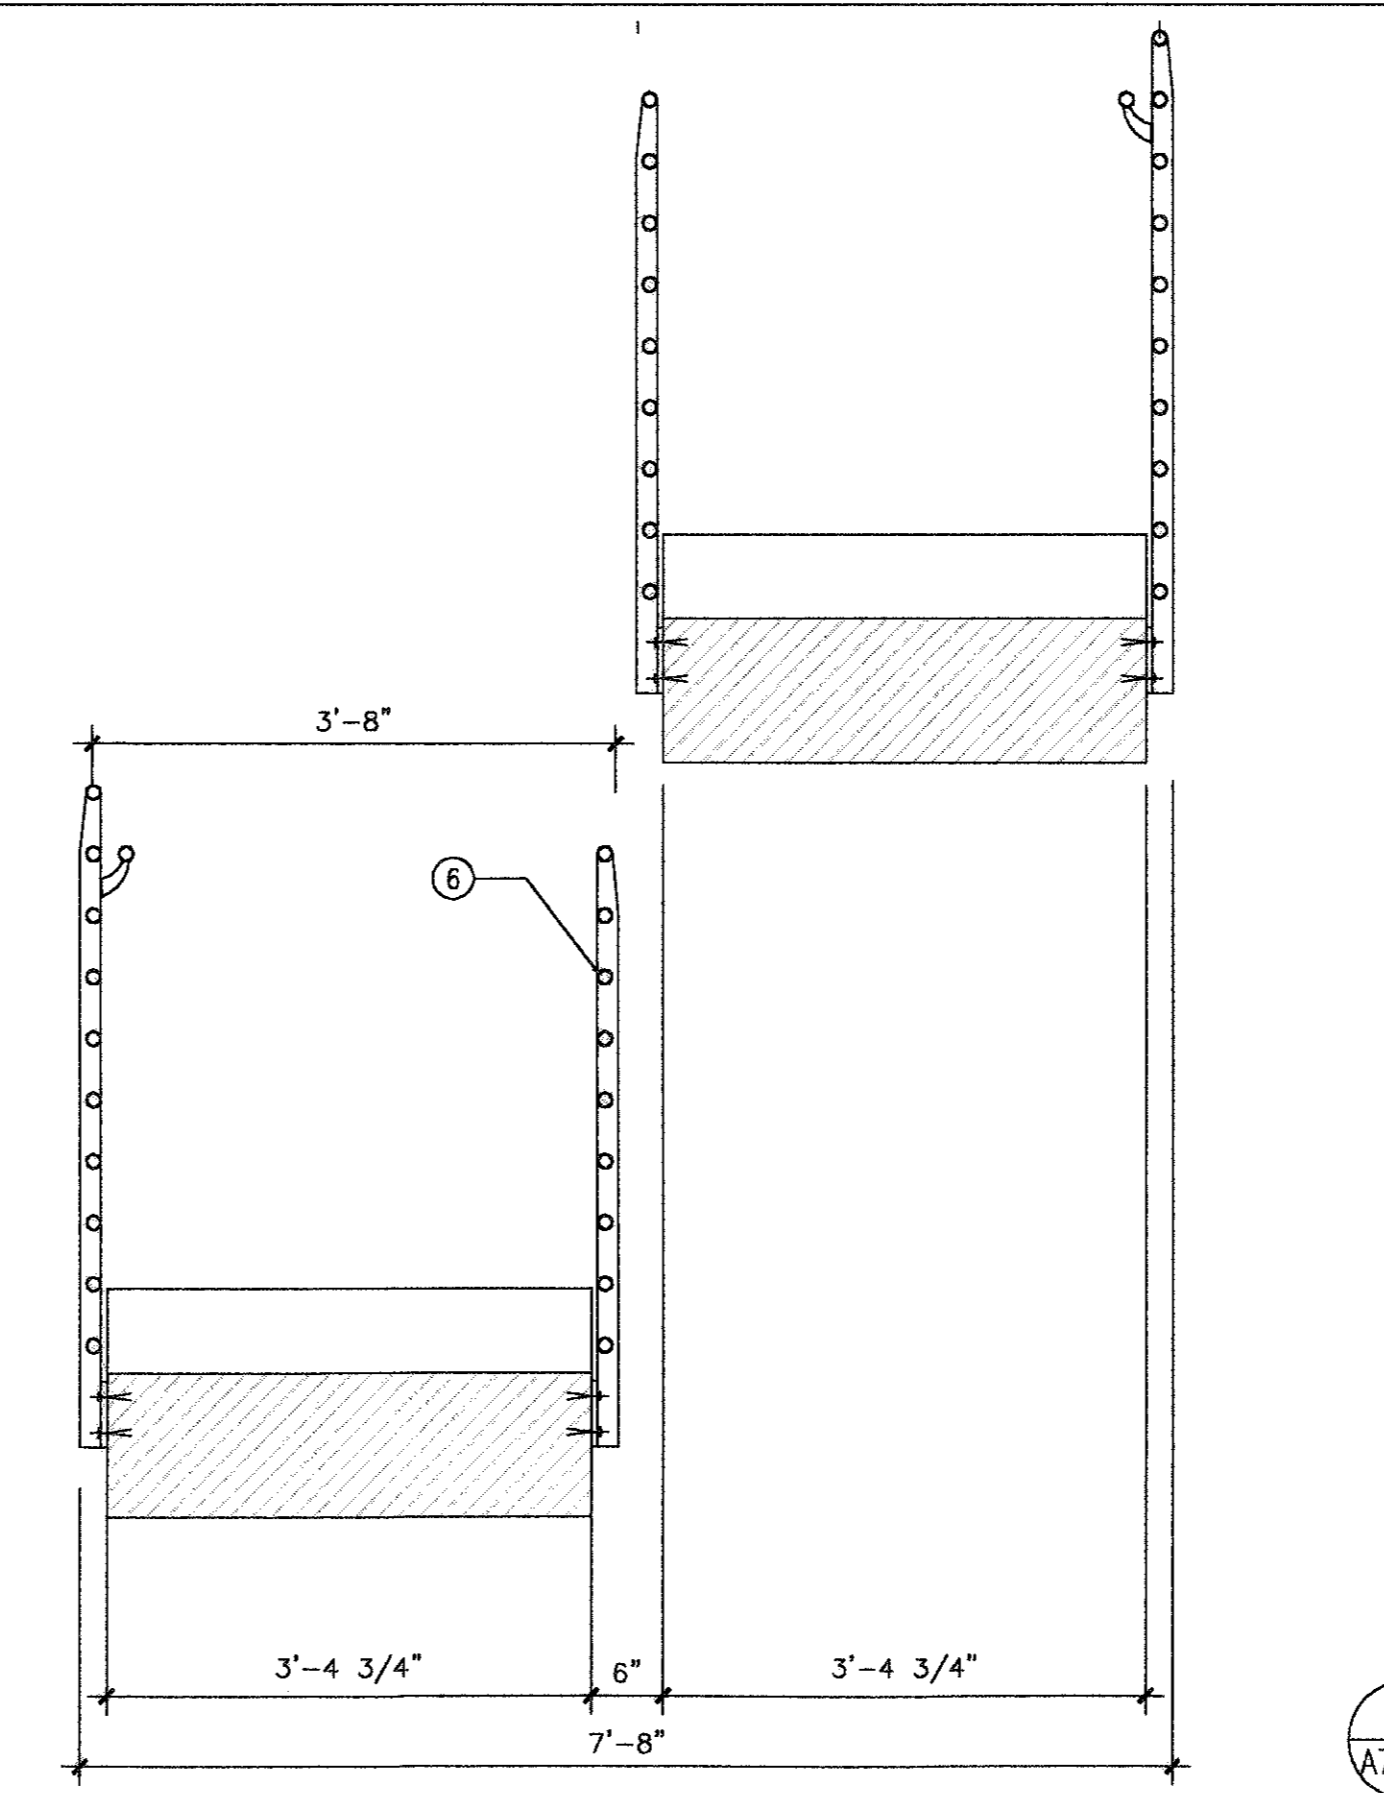

**SECTION  
STAIR #2**  
05  
A7.120 3/4"=1'-0"


**GENERAL NOTES:**

- ALL WELDING CONTINUOUS AND GROUND SMOOTH
- GR-2 STEEL GUARDRAIL - PAINT

**KEYED NOTES:**

- 1 1/4" Ø HANDRAIL - STEEL PIPE - PAINT
- CONCRETE STAIR - PAINT
- CONCRETE FLIGHT OF STAIR - PAINT
- POST - 1 3/4"x3/4" PLATE - PAINT
- 1/2" THK STEEL PLATE - WELD TO POST - ANCHOR IN CONCRETE - PAINT
- 1 1/4" Ø STEEL PIPE - WELD TO RAIL POST - PAINT
- HANDRAIL SUPPORT - 1/2" PLATE - WELD TO RAIL POST AND HANDRAIL


**RECORD DRAWINGS**  
DO NOT MODIFY  
Rey de la Reza Architects, Inc.  
13 May 2005  
Note: Information used to develop these documents was taken from Record of the Work Drawings prepared by the construction contractor, Clark Construction Group - Texas. The information provided by the contractor was not verified by the design firm named above.

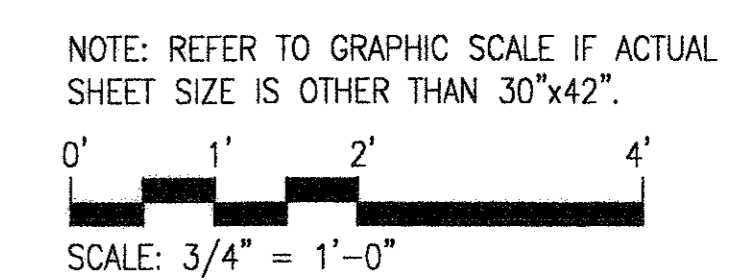

NO.	DESCRIPTION	DATE	BY
ISSUED FOR BID	10/19/01		
RECORD SET	05/13/05	EM	

PROJECT MGR:	HEM
DESIGNER:	SO
DRAWN BY:	SEM
CHECKED BY:	AB
DRAWING STANDARD:	SEP 07.20.2000

SCALE:	AS NOTED
DATE:	09/14/01

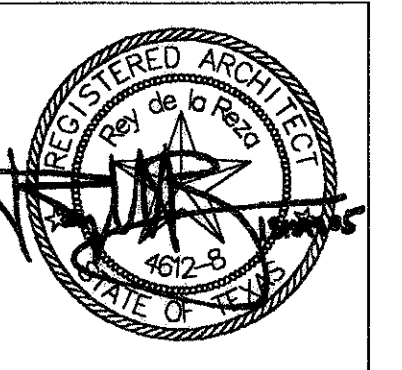

APPROVED BY: \_\_\_\_\_ DATE: \_\_\_\_\_

HOUSTON AIRPORT SYSTEM

PROJECT NO. 1140

C.I.P. NO. A-0364

H.A.S. NO. 536C

SHEET NO. 43 **A7.120**



REVISIONS			
NO.	DESCRIPTION	DATE	BY
	ISSUED FOR BID	10/19/01	
1	ADDENDUM 1	02/01/02	SG
	RECORD SET	05/13/05	EM

**GENERAL NOTES:**


- BUTT GLAZING @ VERTICAL JOINT - WITH CUSTOM EXTRUDED MULLIONS @ ANGLES
- SELECT SILICONE SEALANT COMPATIBLE WITH PVB INTERLAYER
- FIELD VERIFY CONCRETE AND STEEL STRUCTURE, ALL DIMENSIONS OF CURTAIN WALL AND ANGLES
- CW-5 CURTAIN WALL TYPE 5  
 RE TO SCHEDULE SHEET A2.850
- EMP-1 EXTERIOR POWDERCOATED WALL METAL PANELS - ALUMINUM PANEL 1/8" THICK  
 - TYPE SERIES 3000 MODIFIED FROM UNA-CLAD - COPPER SALES OR EQUAL  
 - POWDERCOATED KYMAR 500

**KEYED NOTES:**

- STEEL PIPE STRUCTURAL FRAME CLAD WITH CURTAIN WALL CW-5 - PAINT
- CONCRETE STAIR - PAINT
- CONCRETE BEAM UNDER FLIGHT OF STAIR
- 8" STRUCTURAL STEEL PIPE COLUMN - PAINT
- 6" HORIZONTAL STEEL PIPE WELDED TO MAIN POST - PAINT
- GLASS TYPE GL-4 REFER TO GLASS SCHEDULE A2.850
- SILICONE WEATHER SEAL - MATCH COLOR OF GLASS INTERLAYER
- CUSTOM EXTRUDED MULLION @ ANGLE
- STRUCTURAL SILICONE AND SPACER BARS - MATCH COLOR OF GLASS INTERLAYER
- STEEL ANGLE ANCHORED IN CONCRETE COLUMN - PAINT
- 1/2" STEEL PLATE WELDED TO 6" PIPE ANCHORED TO CONCRETE PAINT
- VERTICAL MULLION WITH BUTT GLAZING
- U SHAPE STEEL CLIP- 1/4" THICK - WELD TO STEEL COLUMN NUMBER AS REQUIRED (SAME NUMBER AND SAME ELEVATIONS PER COLUMN) - PAINT SLOTTED HOLES - SHIM AS REQUIRED
- 4" HORIZONTAL STEEL PIPE - PAINT
- ALUMINUM CLIP INSIDE HORIZONTAL MULLION - SECURE TO VERTICAL MULLION
- MECHANICAL LOUVER SET INSIDE MULLION
- STEEL REINFORCING AS REQUIRED FOR WIND LOAD
- ALUMINUM COVER - POWDERCOATED
- HORIZONTAL ALUMINUM MULLION 6 1/4" x 2 - 1/2" - POWDERCOATED
- VERTICAL ALUMINUM MULLION 6 1/4" x 2 - 1/2" - POWDERCOATED
- 1/8" THICK ALUMINUM SHEET - BENT - POWDERCOATED
- SEALANT AND BACKER ROD
- SHIM
- 5/8" GYPSUM BOARD - PAINT
- 6" METAL STUD - 16 GA - 16 O.C.
- BRACING AS REQUIRED
- EXPANSION JOINT ASSEMBLY: EPDM MEMBRANE
- ANGLE SLIGHTLY DIFFERENT AT SLOPE CURTAIN WALL @ SIM TO BE FIELD VERIFIED

INTERNATIONAL SERVICES • EXPANSION PROGRAM  
**APM STATION + PLATFORM**  
 STAIR2 - CURTAIN WALL CW-5 DETAILS

PROJECT MGR:	HEM
DESIGNER:	SS
DRAWN BY:	SEM
CHECKED BY:	AB
DRAWING STANDARD:	ISQP 07.20.2003
SCALE:	AS NOTED
DATE:	09/14/01

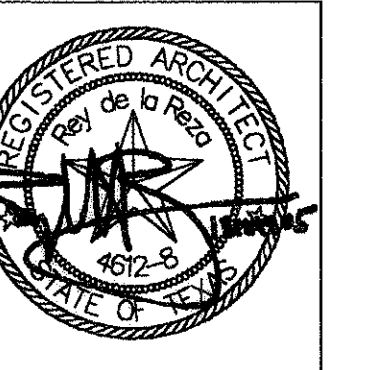

APPROVED BY: \_\_\_\_\_ DATE: \_\_\_\_\_

DIRECTOR  
 HOUSTON AIRPORT SYSTEM


PROJECT NO. 1140

C.I.P. NO. A-0354


H.A.S. NO. 586

SHEET NO. 44


**RECORD DRAWINGS**  
 DO NOT MODIFY  
 Rey de la Reza Architects, Inc.  
 13 May 2005  
 Note: Information used to develop these documents was taken from Record of the Work. Drawings prepared by the construction contractor, Clark Construction Group - Texas. The information provided by the contractor was not verified by the design firm named above.

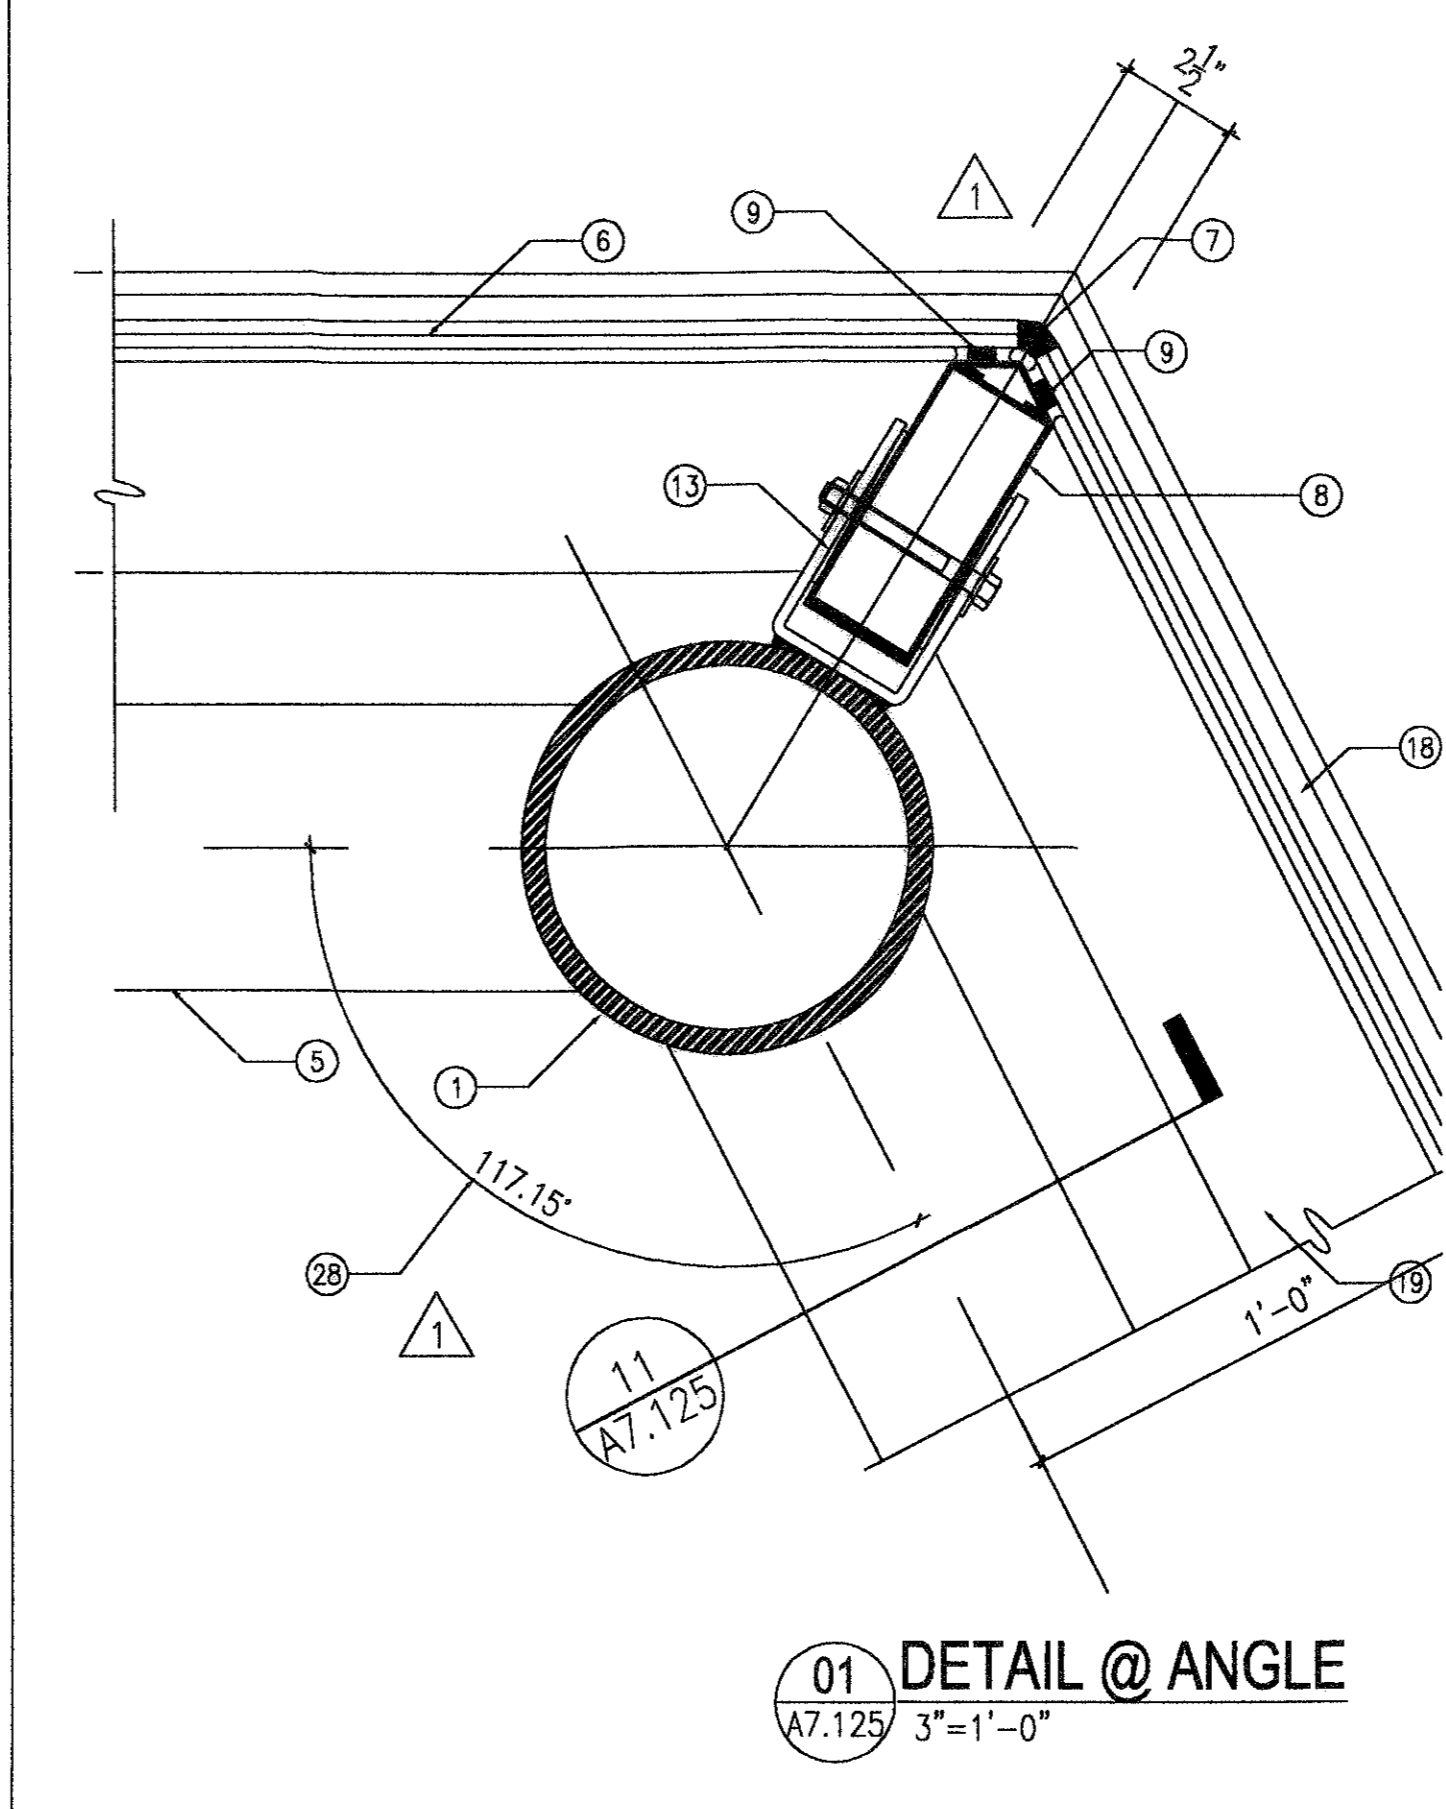


**01 DETAIL @ ANGLE**  
 A7.125 3"=1'-0"

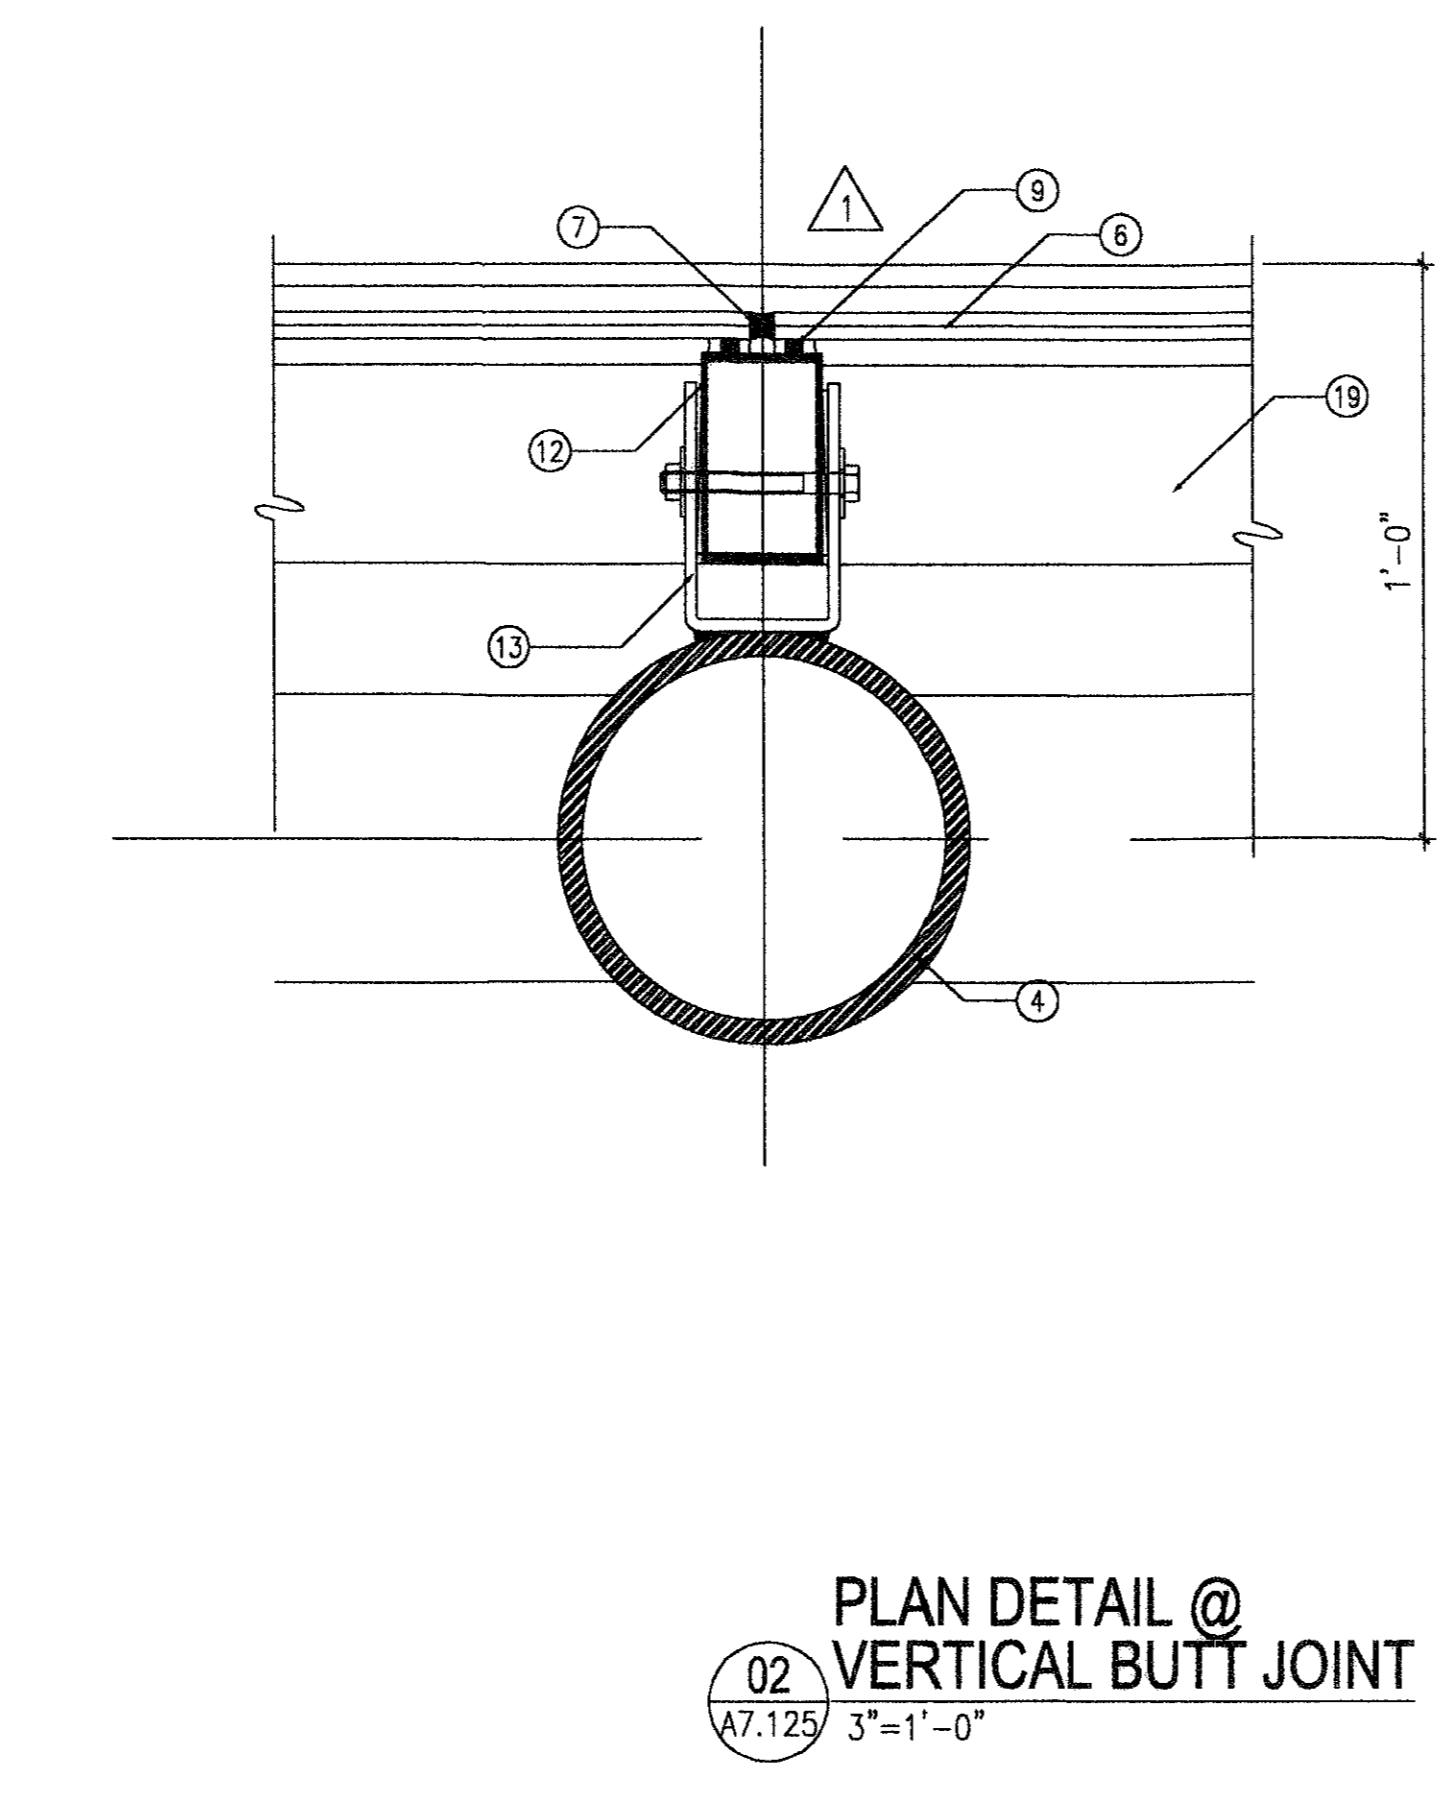


**02 PLAN DETAIL @ VERTICAL BUTT JOINT**  
 A7.125 3"=1'-0"

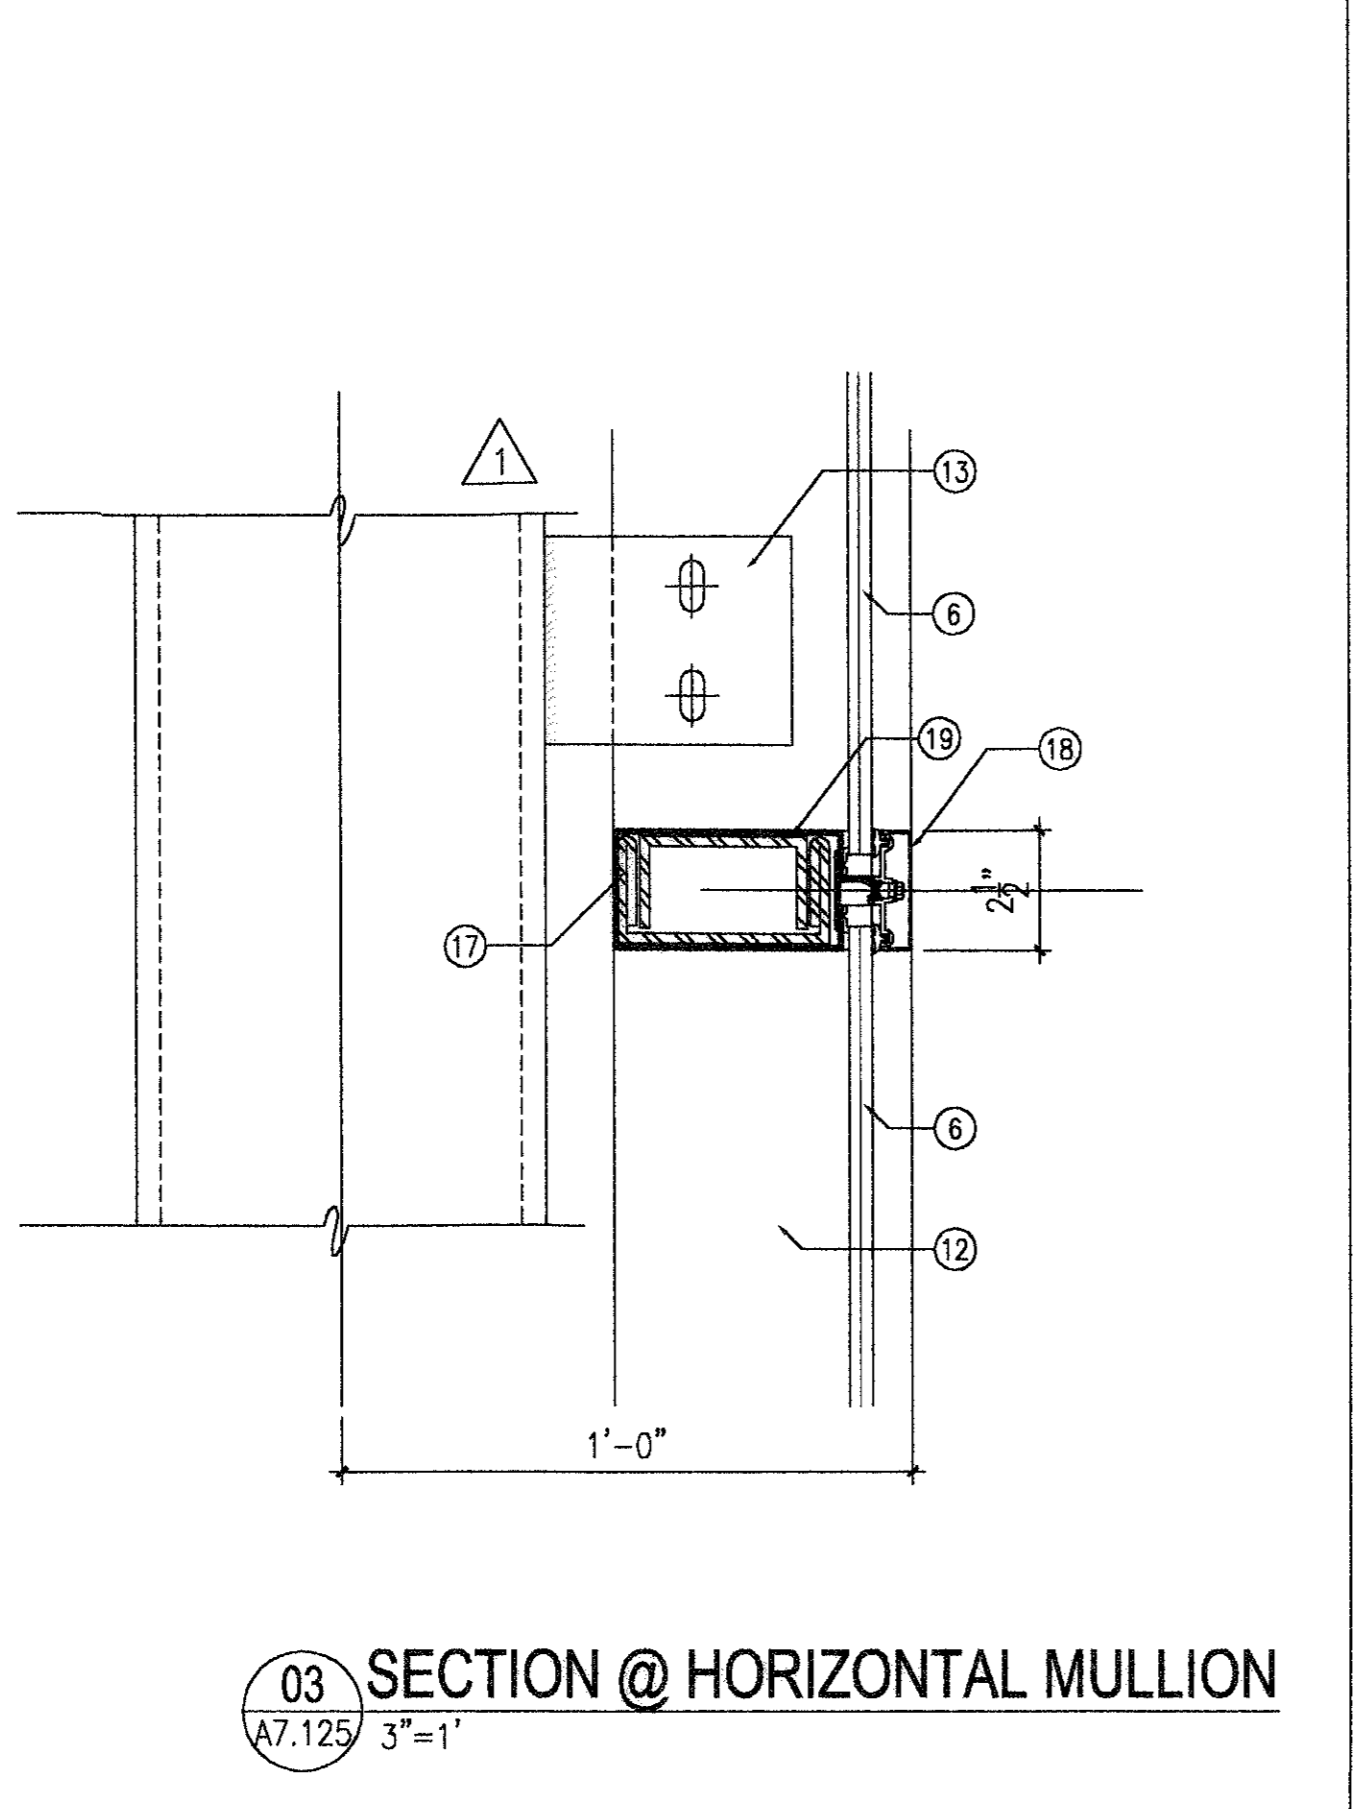


**03 SECTION @ HORIZONTAL MULLION**  
 A7.125 3"=1'-0"

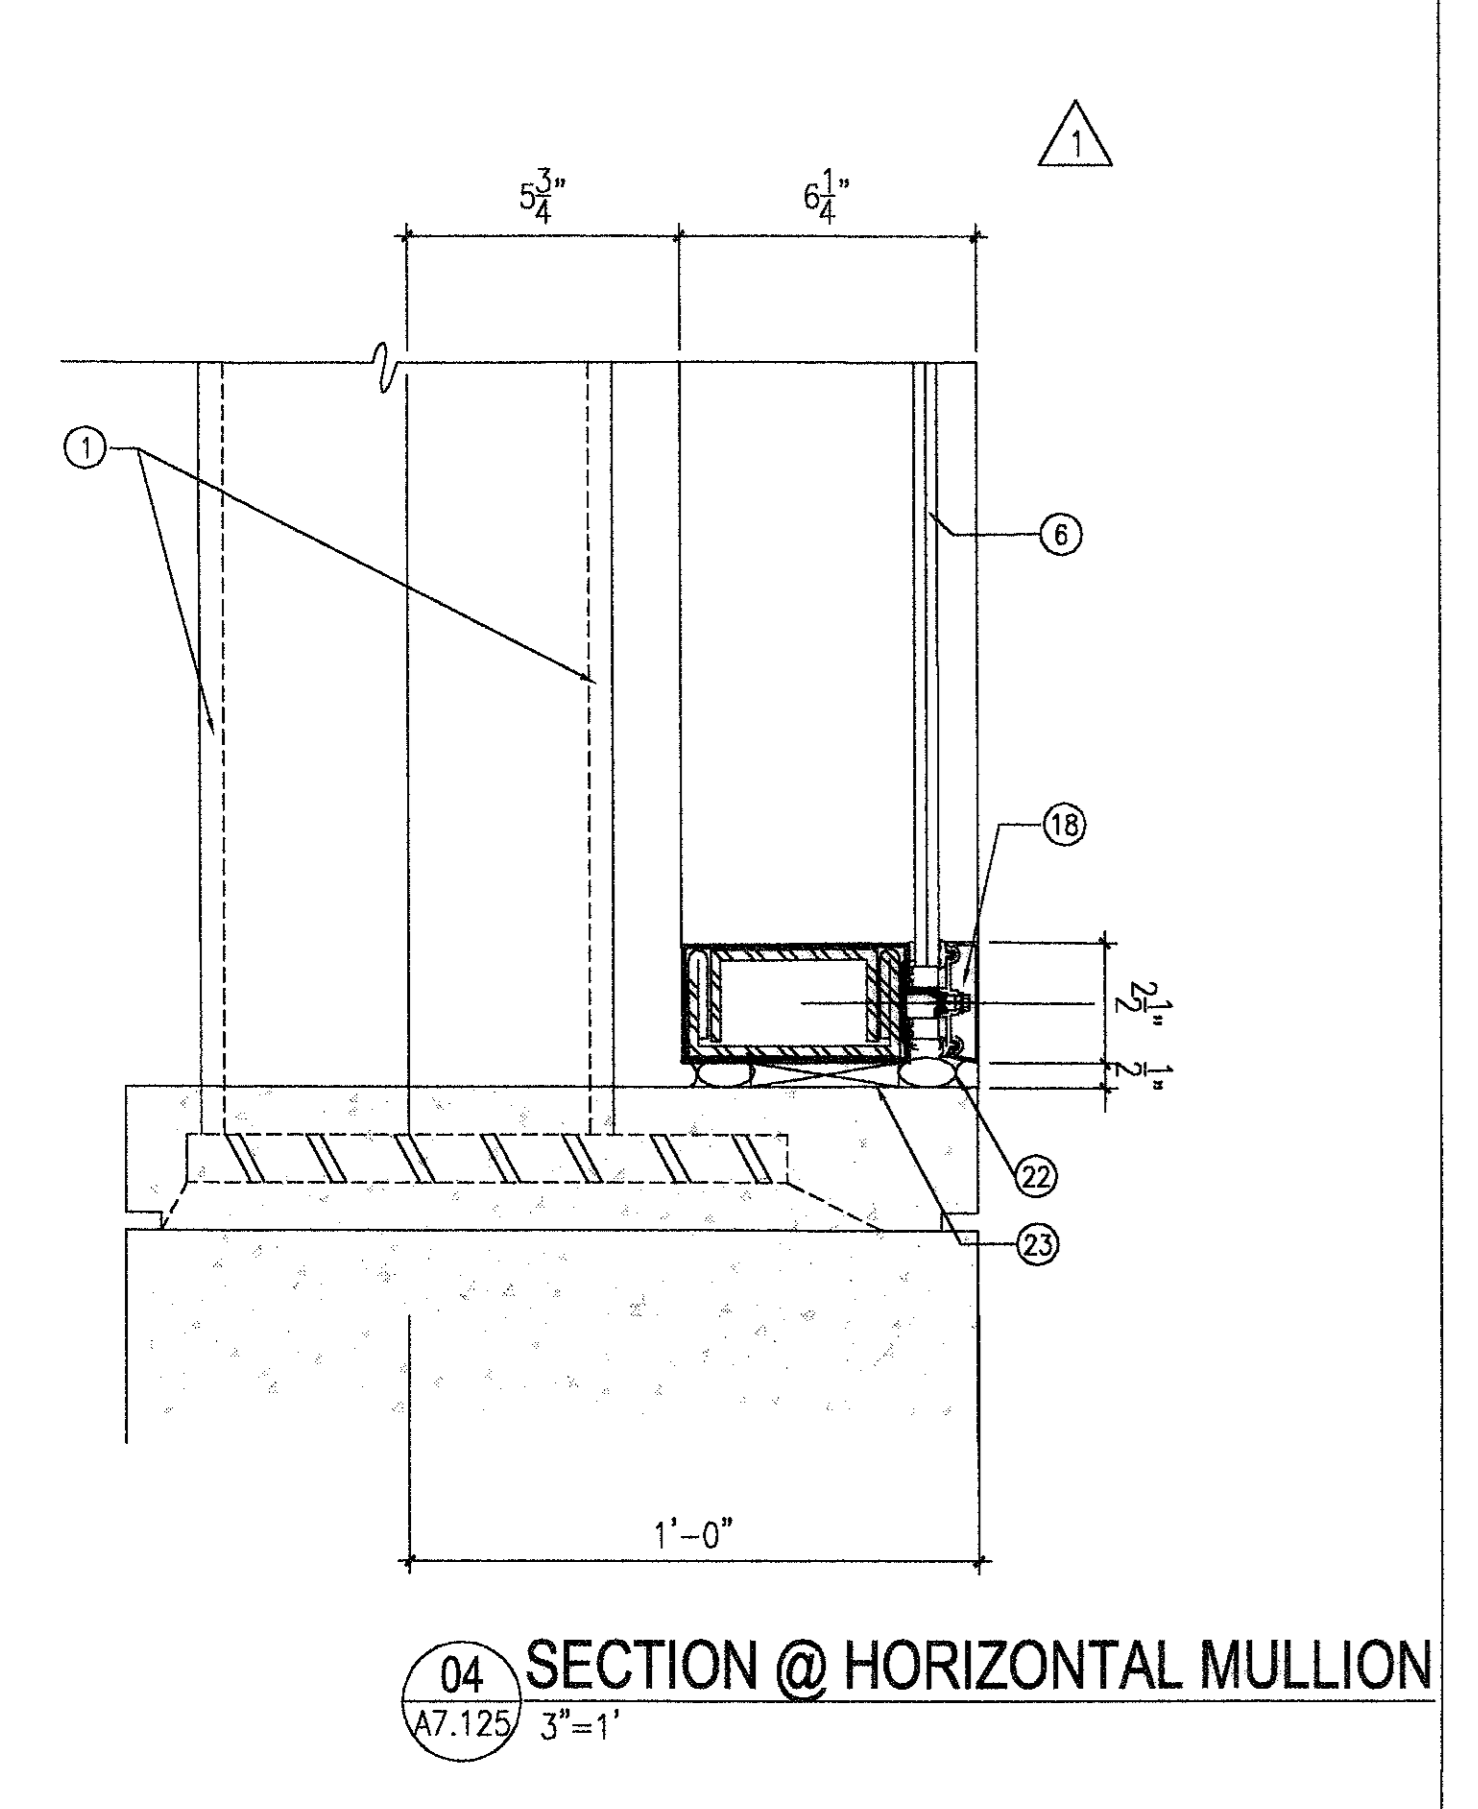


**04 SECTION @ HORIZONTAL MULLION**  
 A7.125 3"=1'-0"

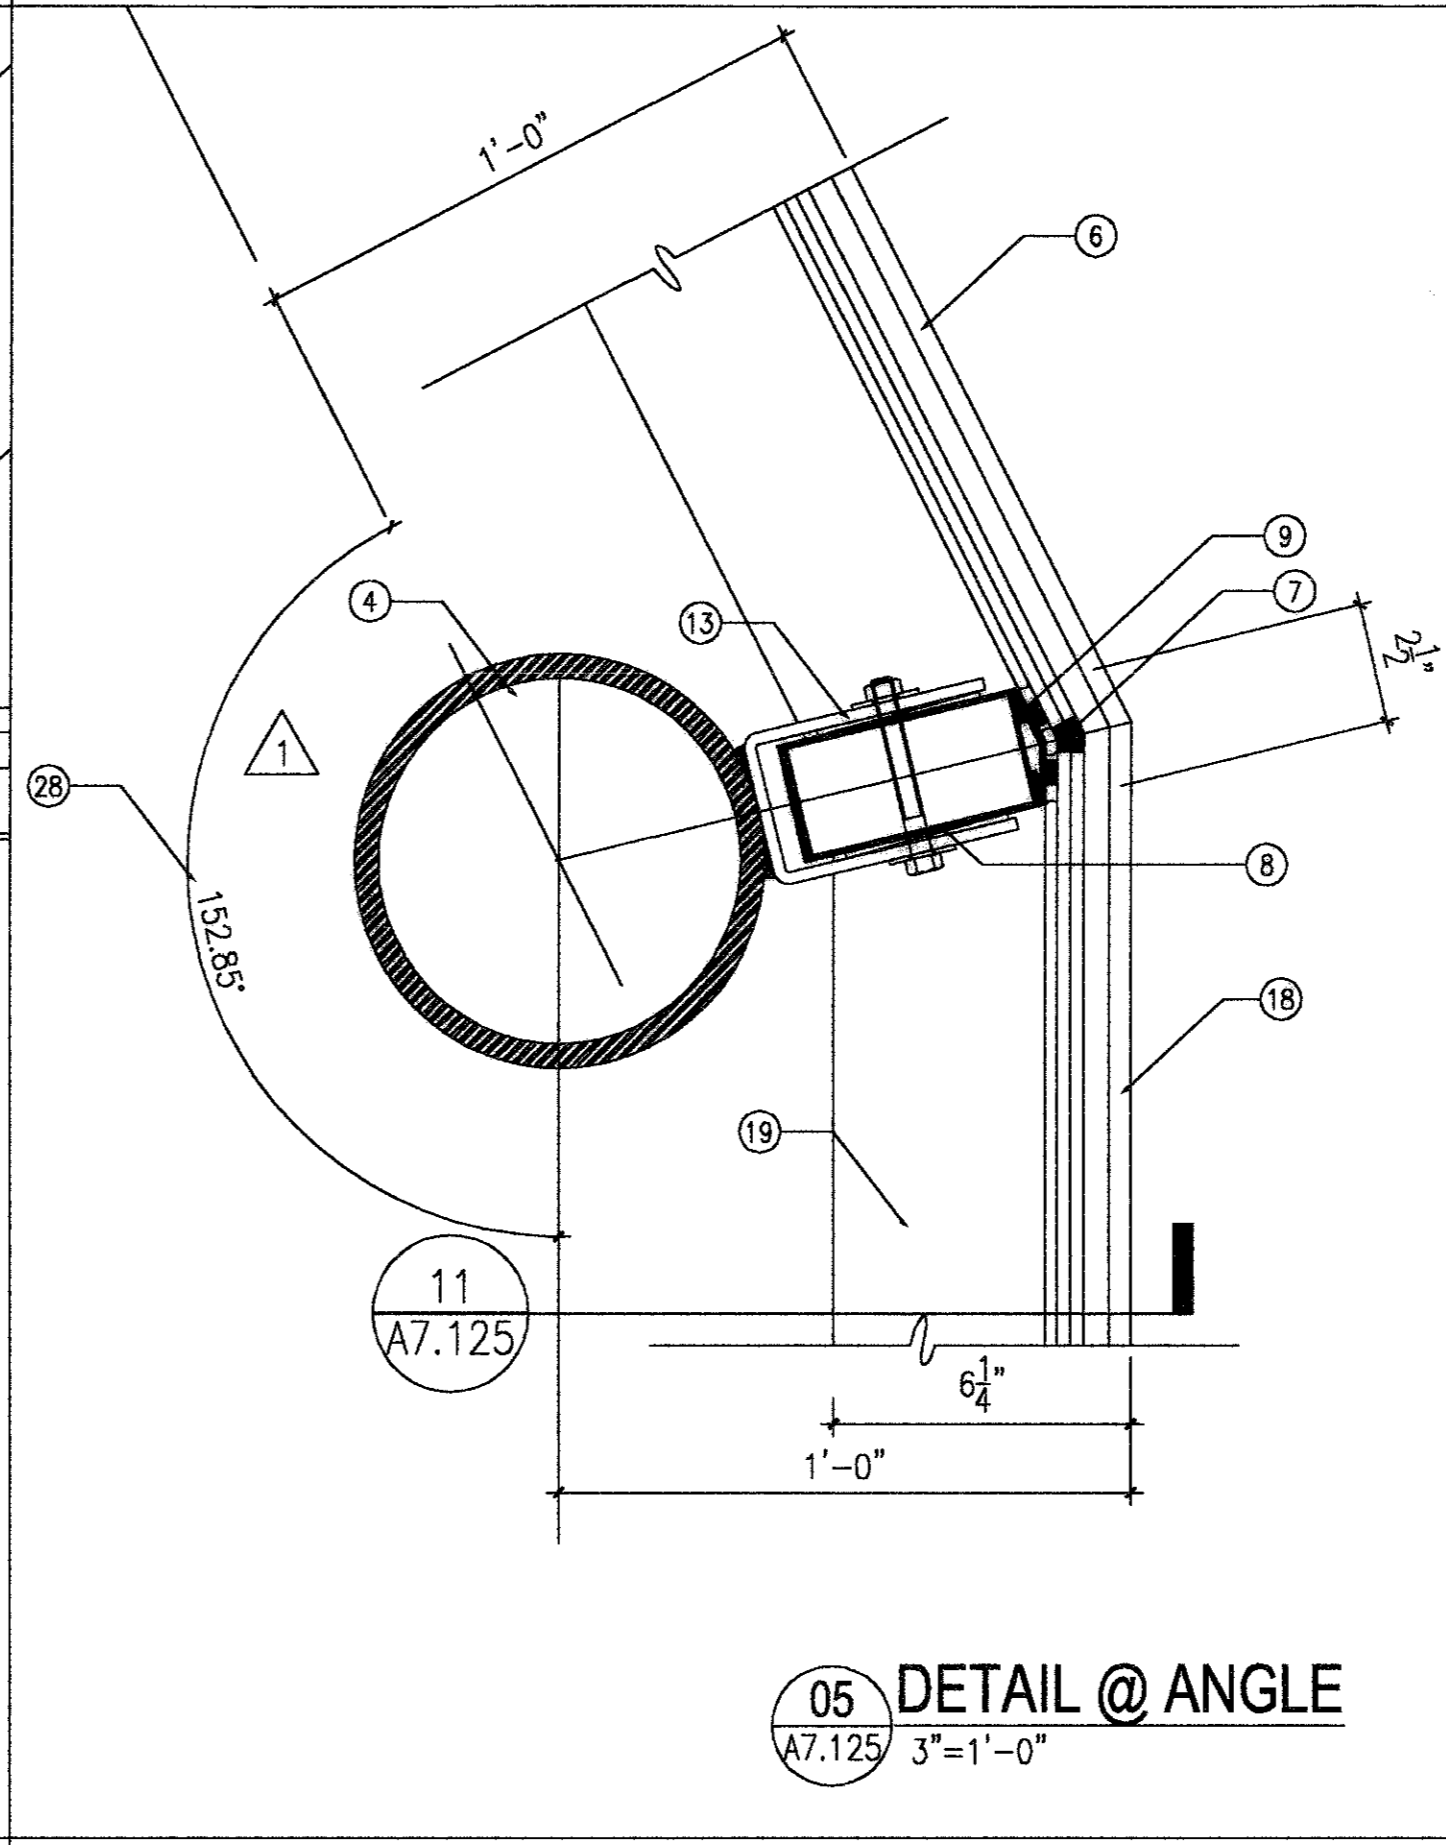


**05 DETAIL @ ANGLE**  
 A7.125 3"=1'-0"

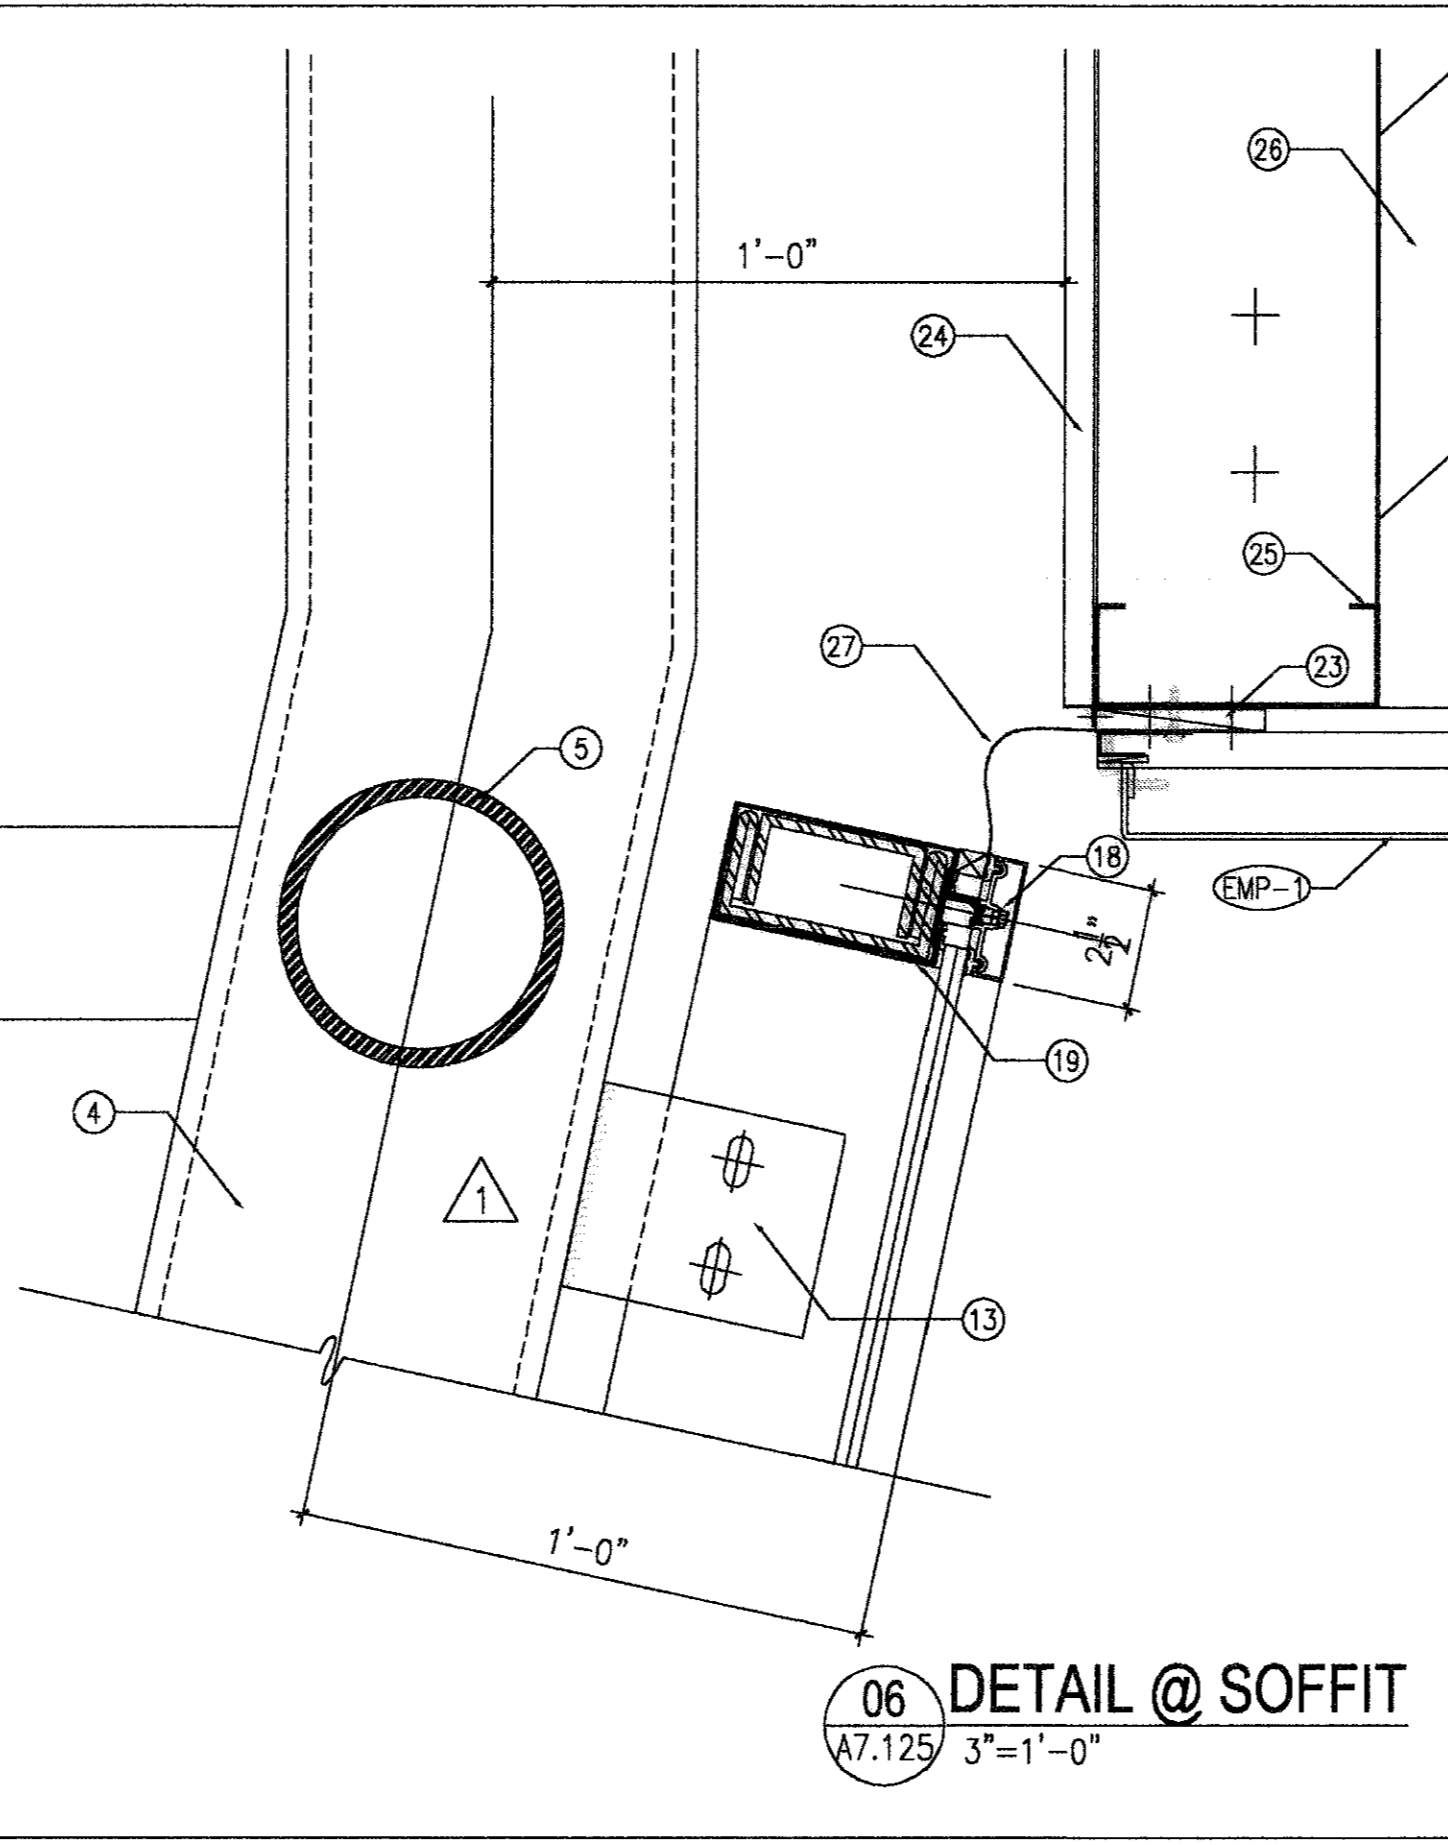


**06 DETAIL @ SOFFIT**  
 A7.125 3"=1'-0"

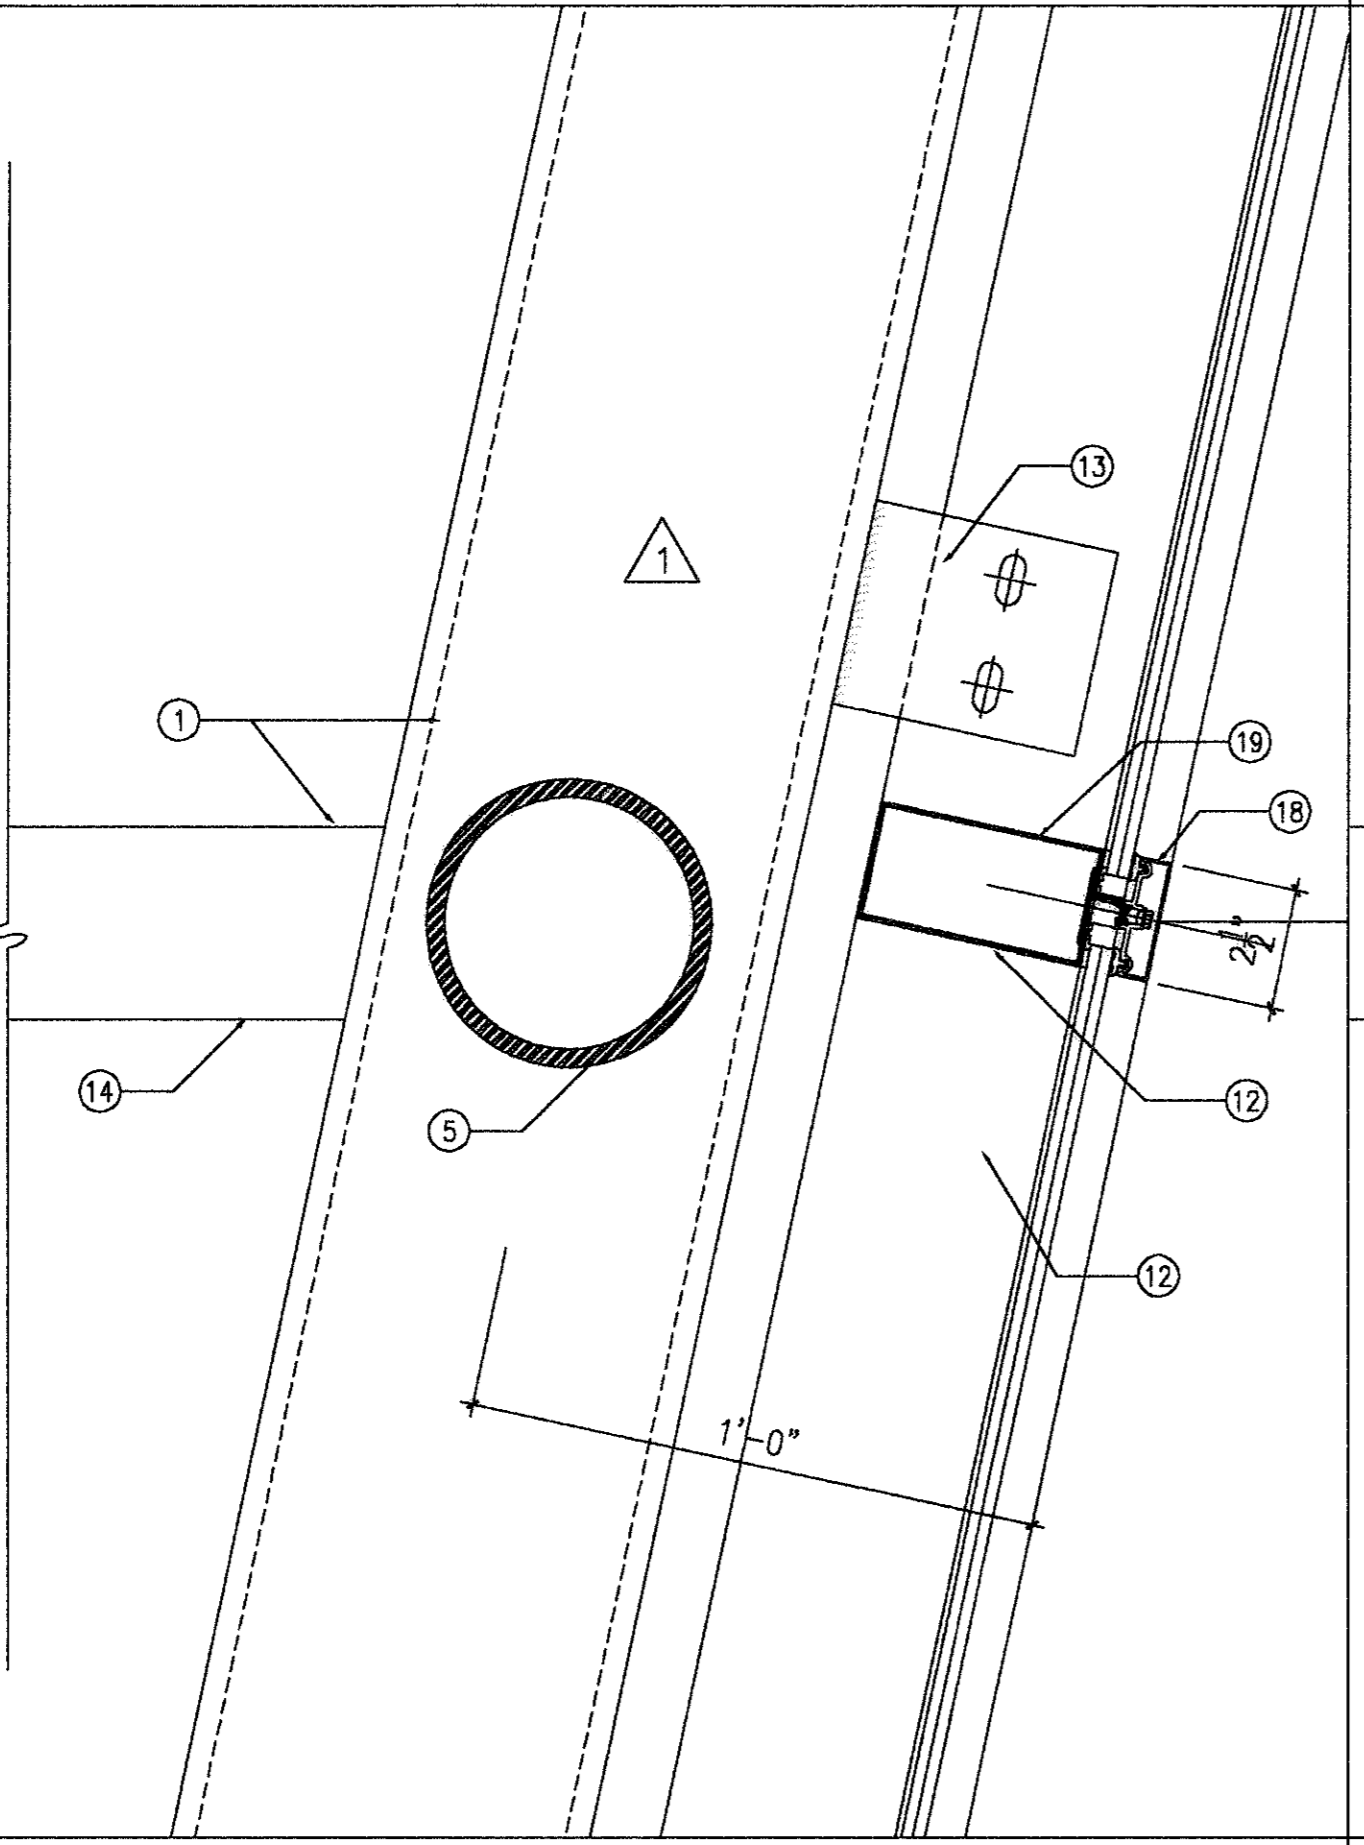


**07 CONNECTION @ STAIR LANDING**  
 A7.125 3"=1'-0"

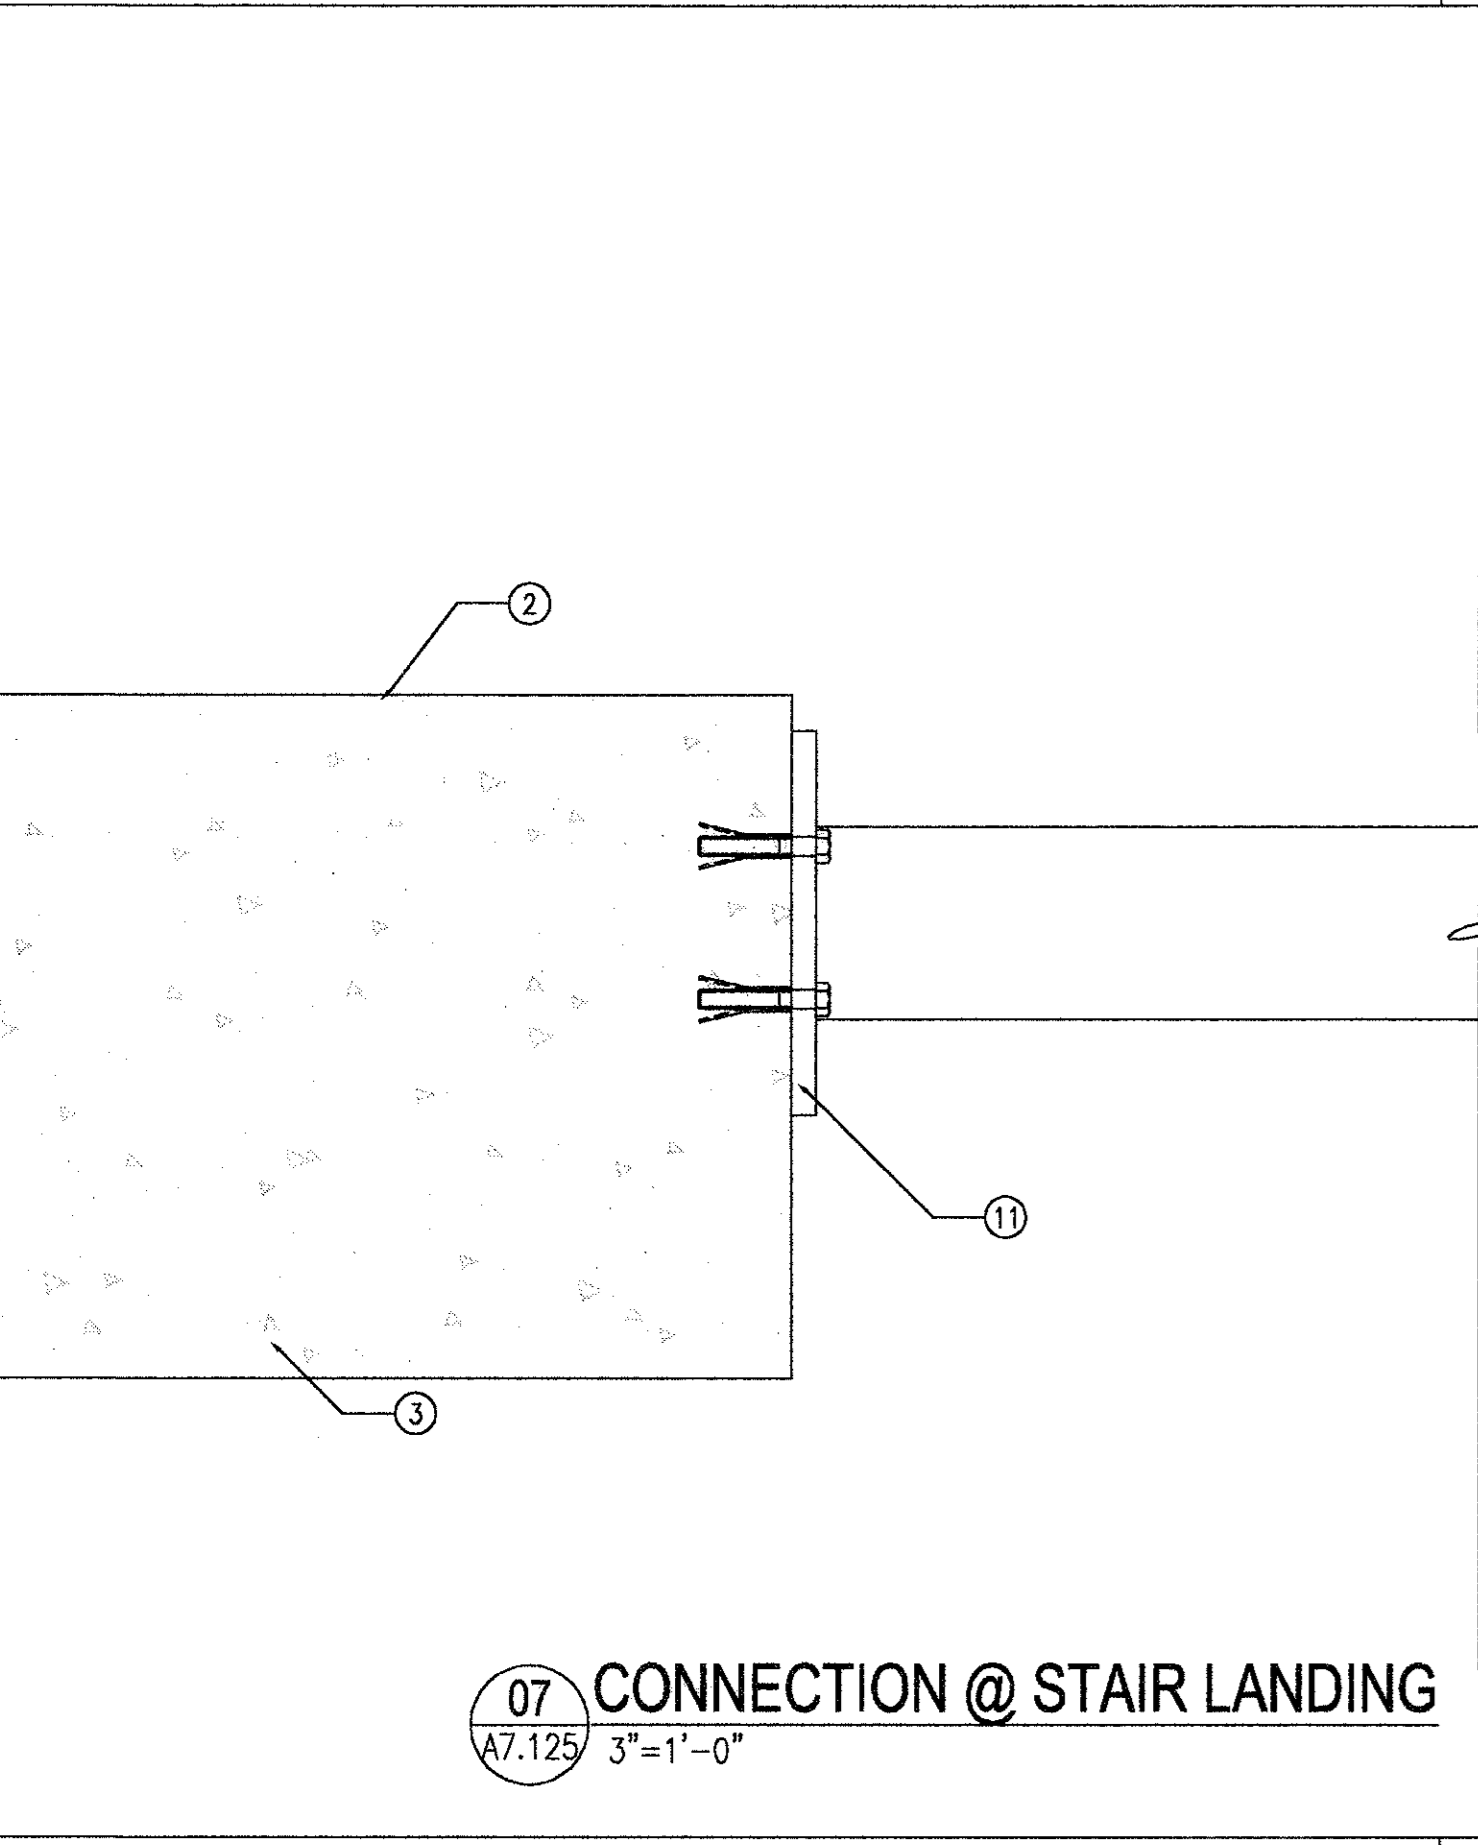


**08 HORIZONTAL MULLION @ SLOPE CURTAIN WALL**  
 A7.125 3"=1'-0"

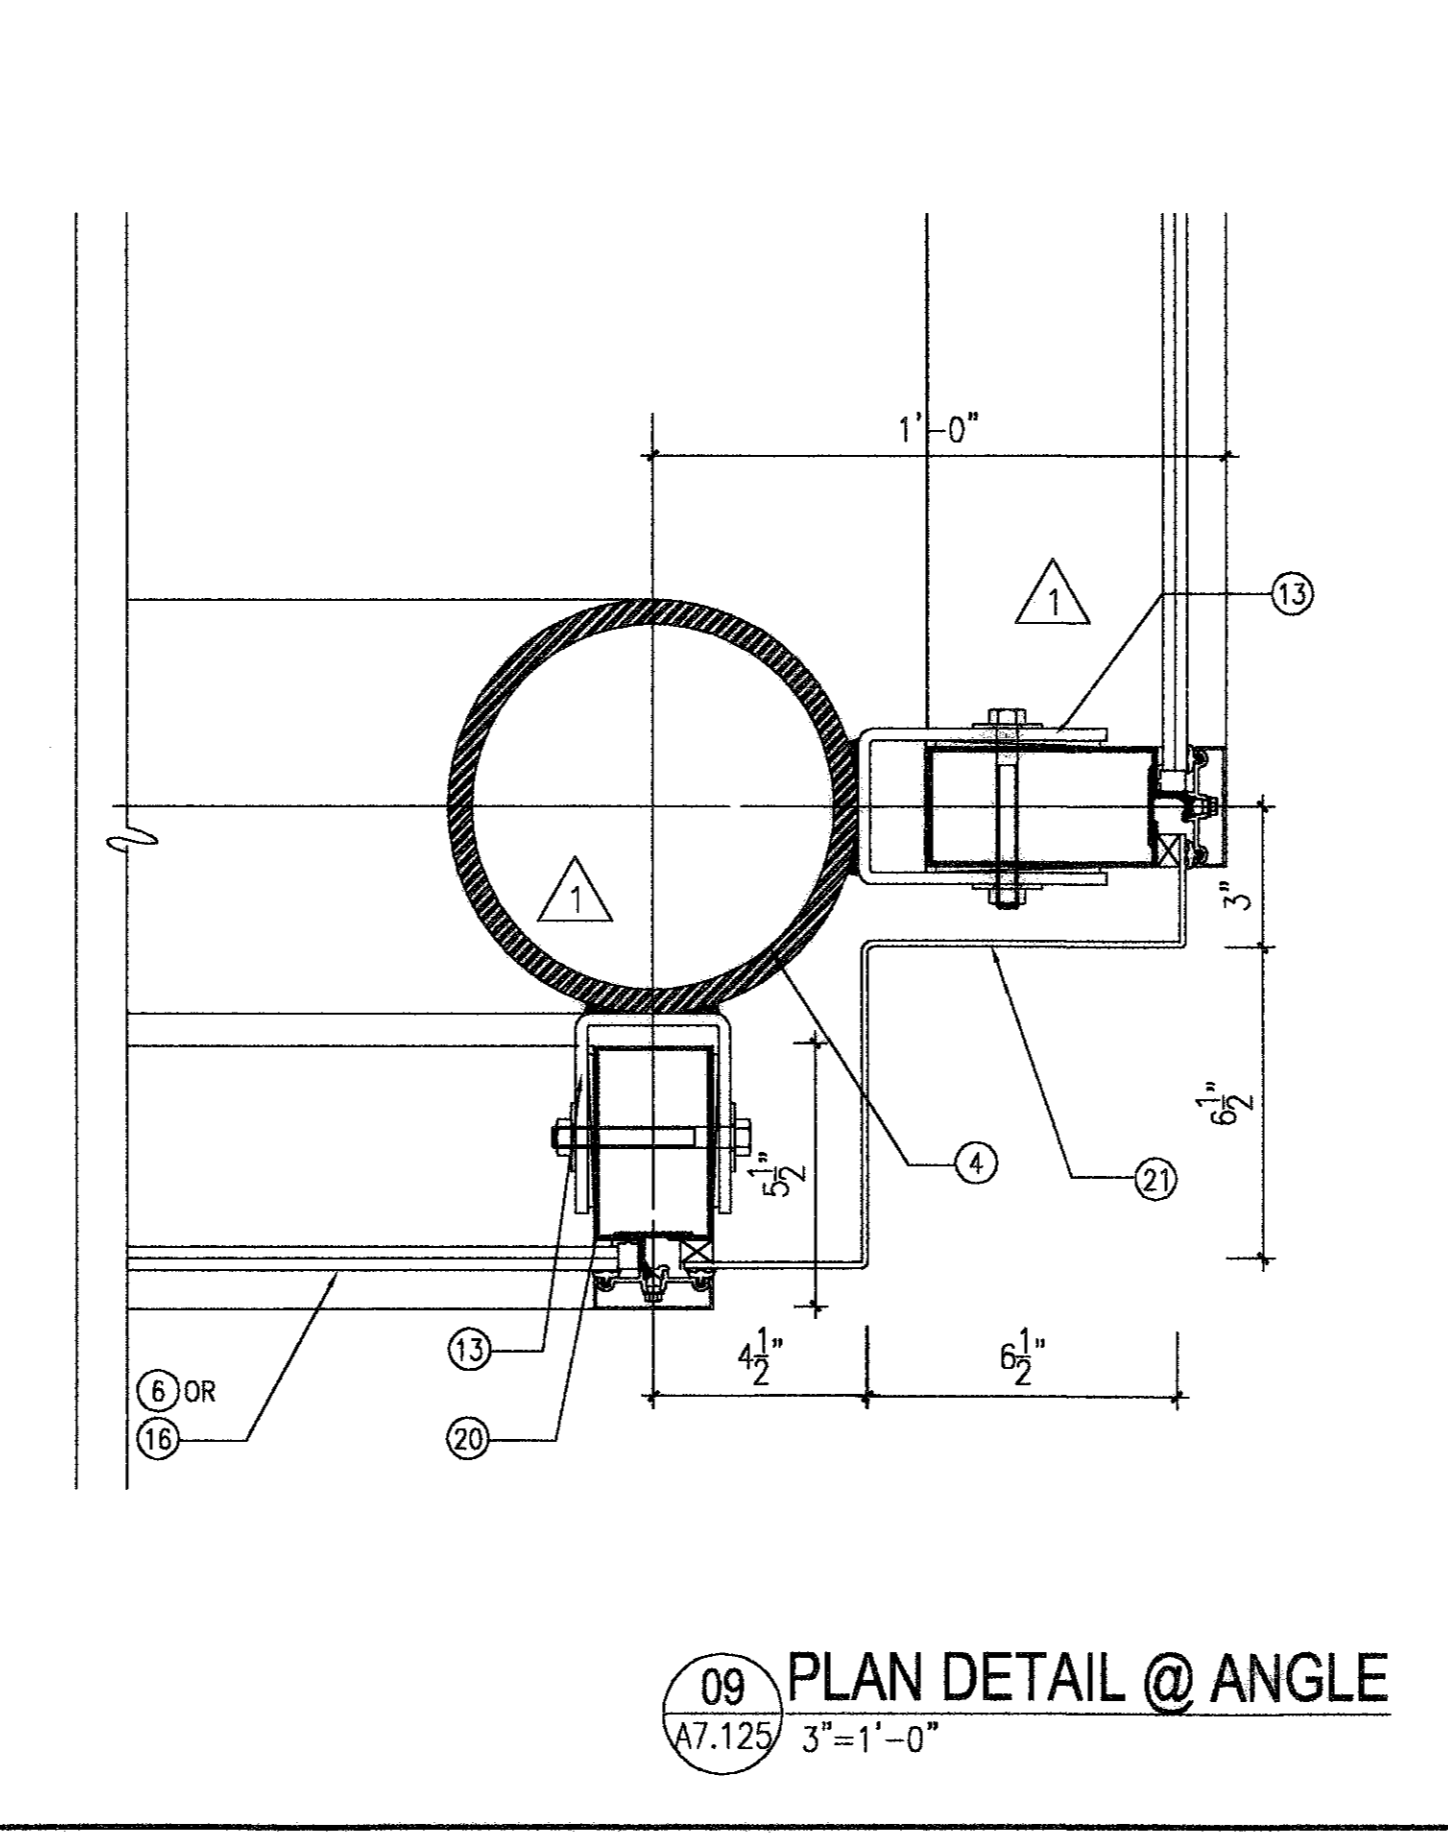

**09 PLAN DETAIL @ ANGLE**  
 A7.125 3"=1'-0"

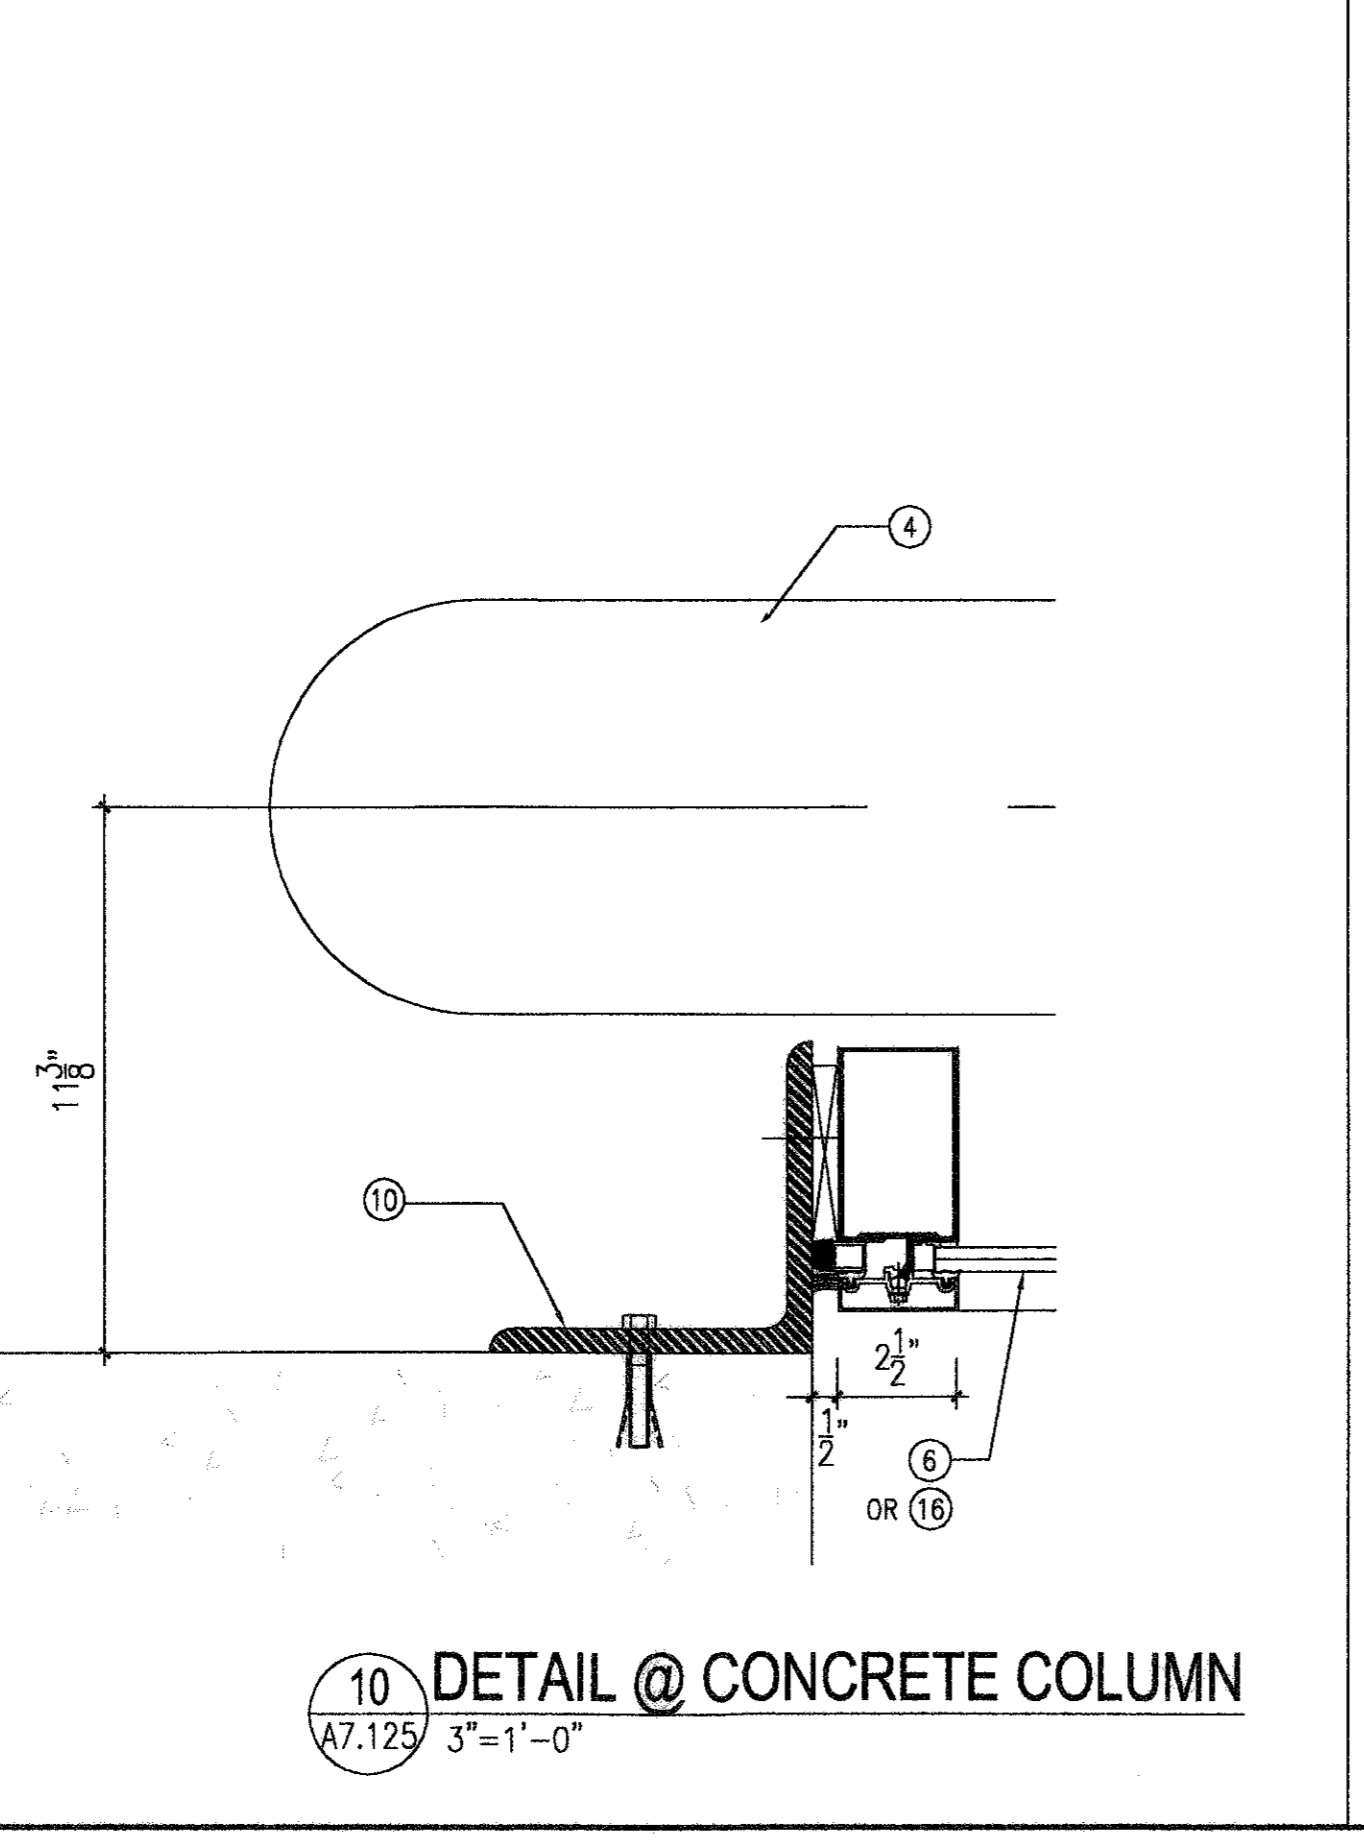


**10 DETAIL @ CONCRETE COLUMN**  
 A7.125 3"=1'-0"

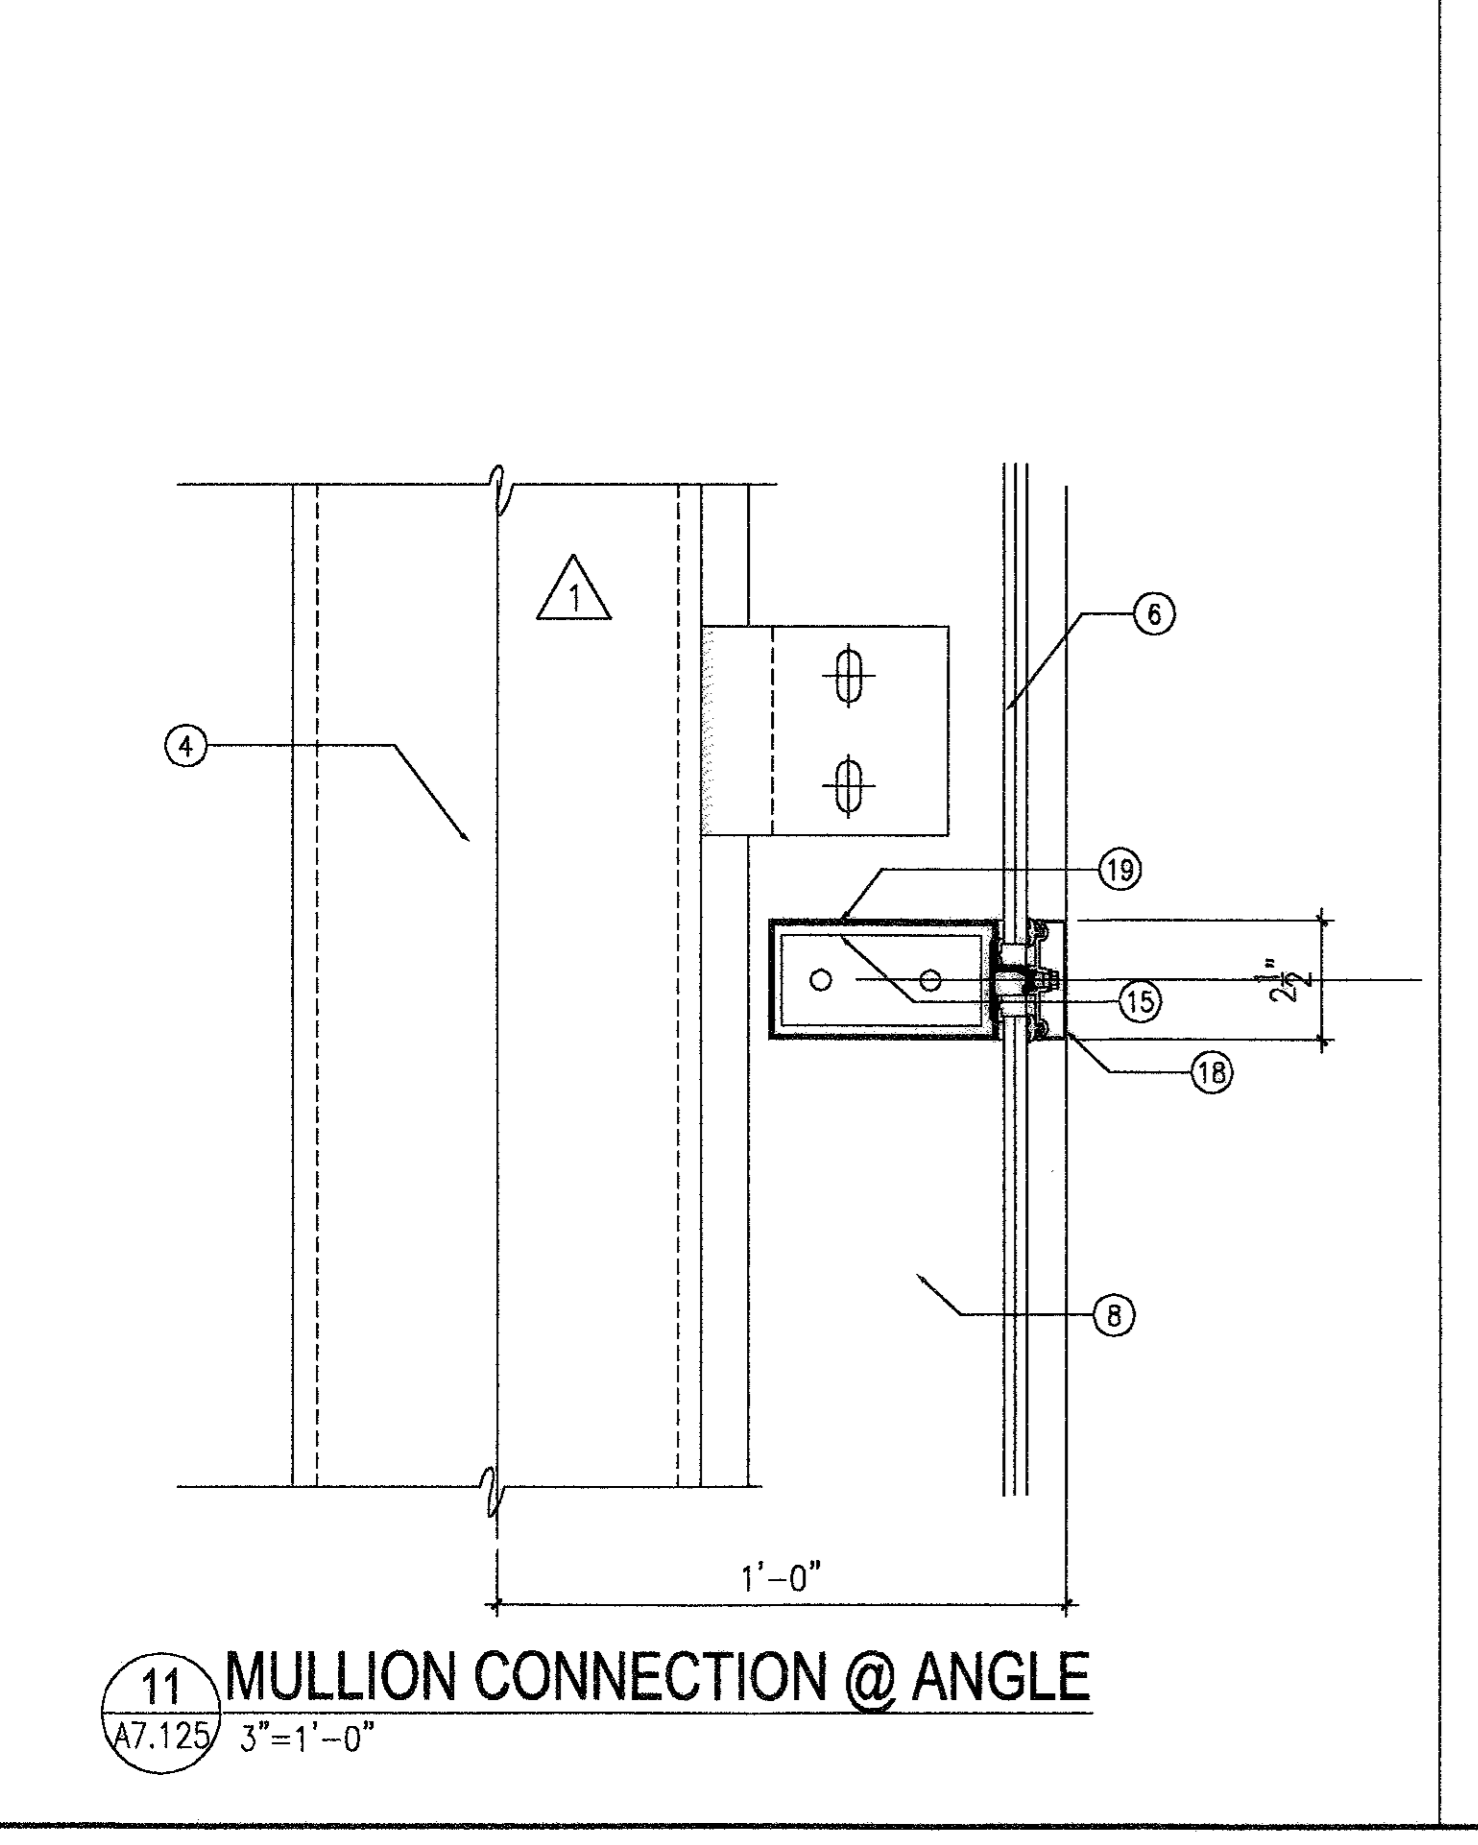

**11 MULLION CONNECTION @ ANGLE**  
 A7.125 3"=1'-0"




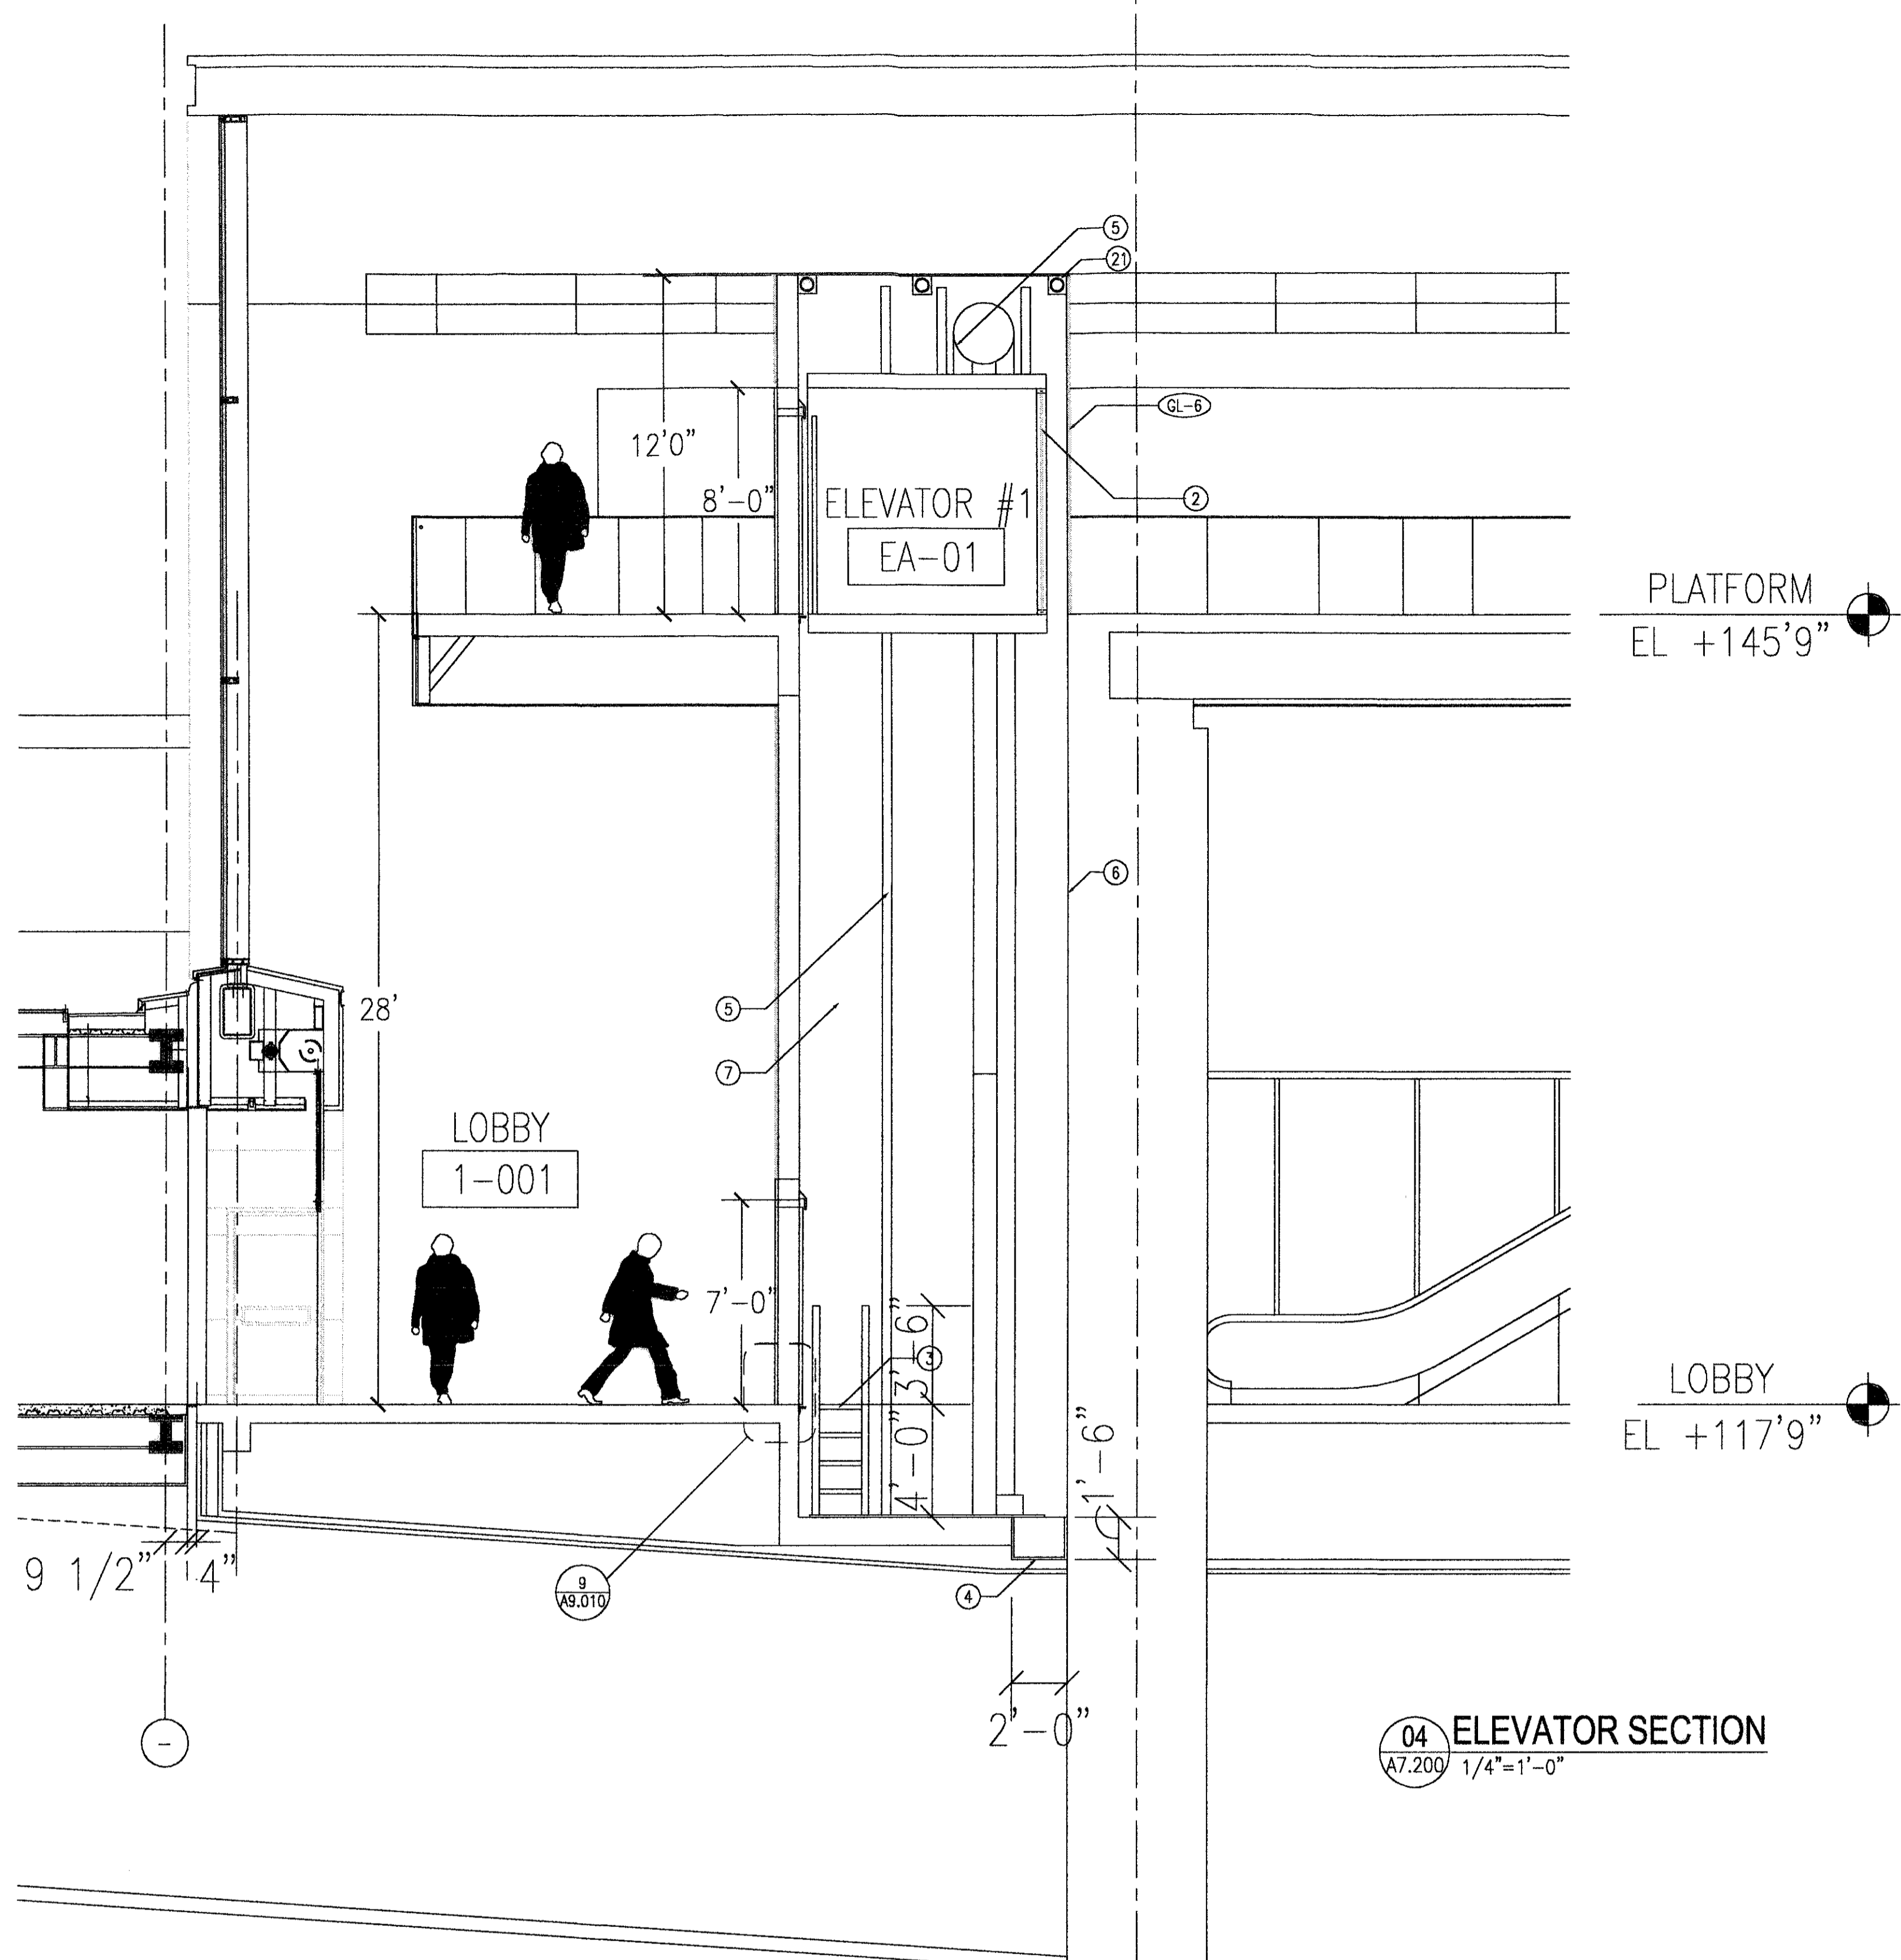


PLATFORM  
EL +145'9"

LOBBY  
EL +117'9"


04 ELEVATOR SECTION  
A7.200 1/4"=1'-0"

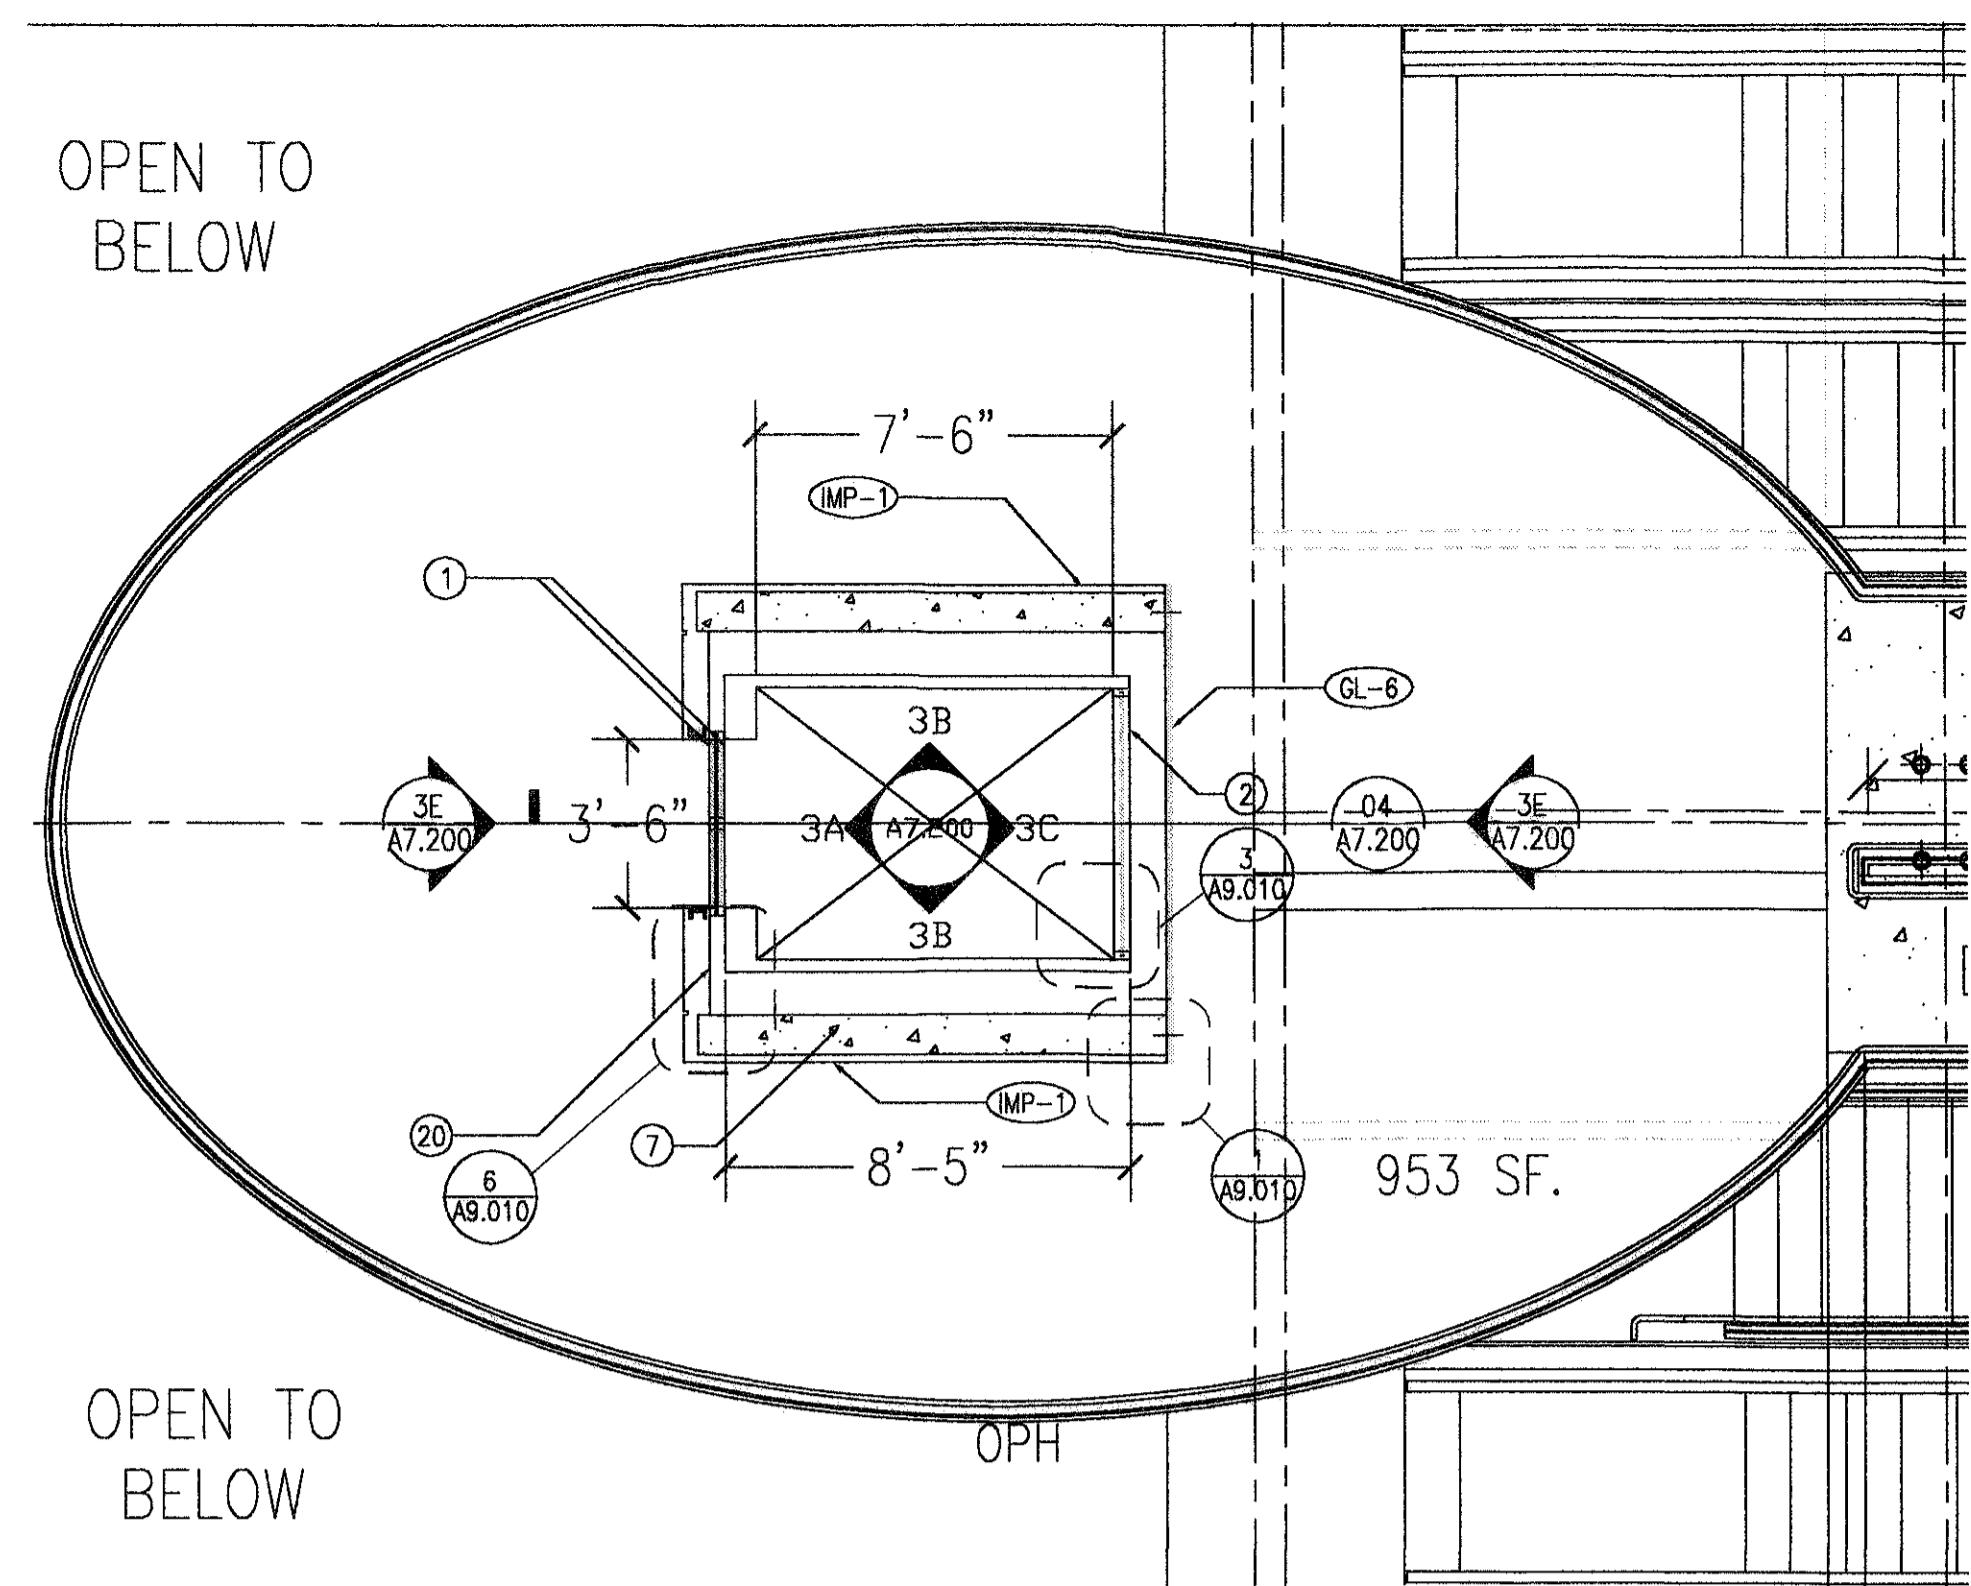

01 ELEVATOR PLAN  
A7.200 1/4"=1'-0"

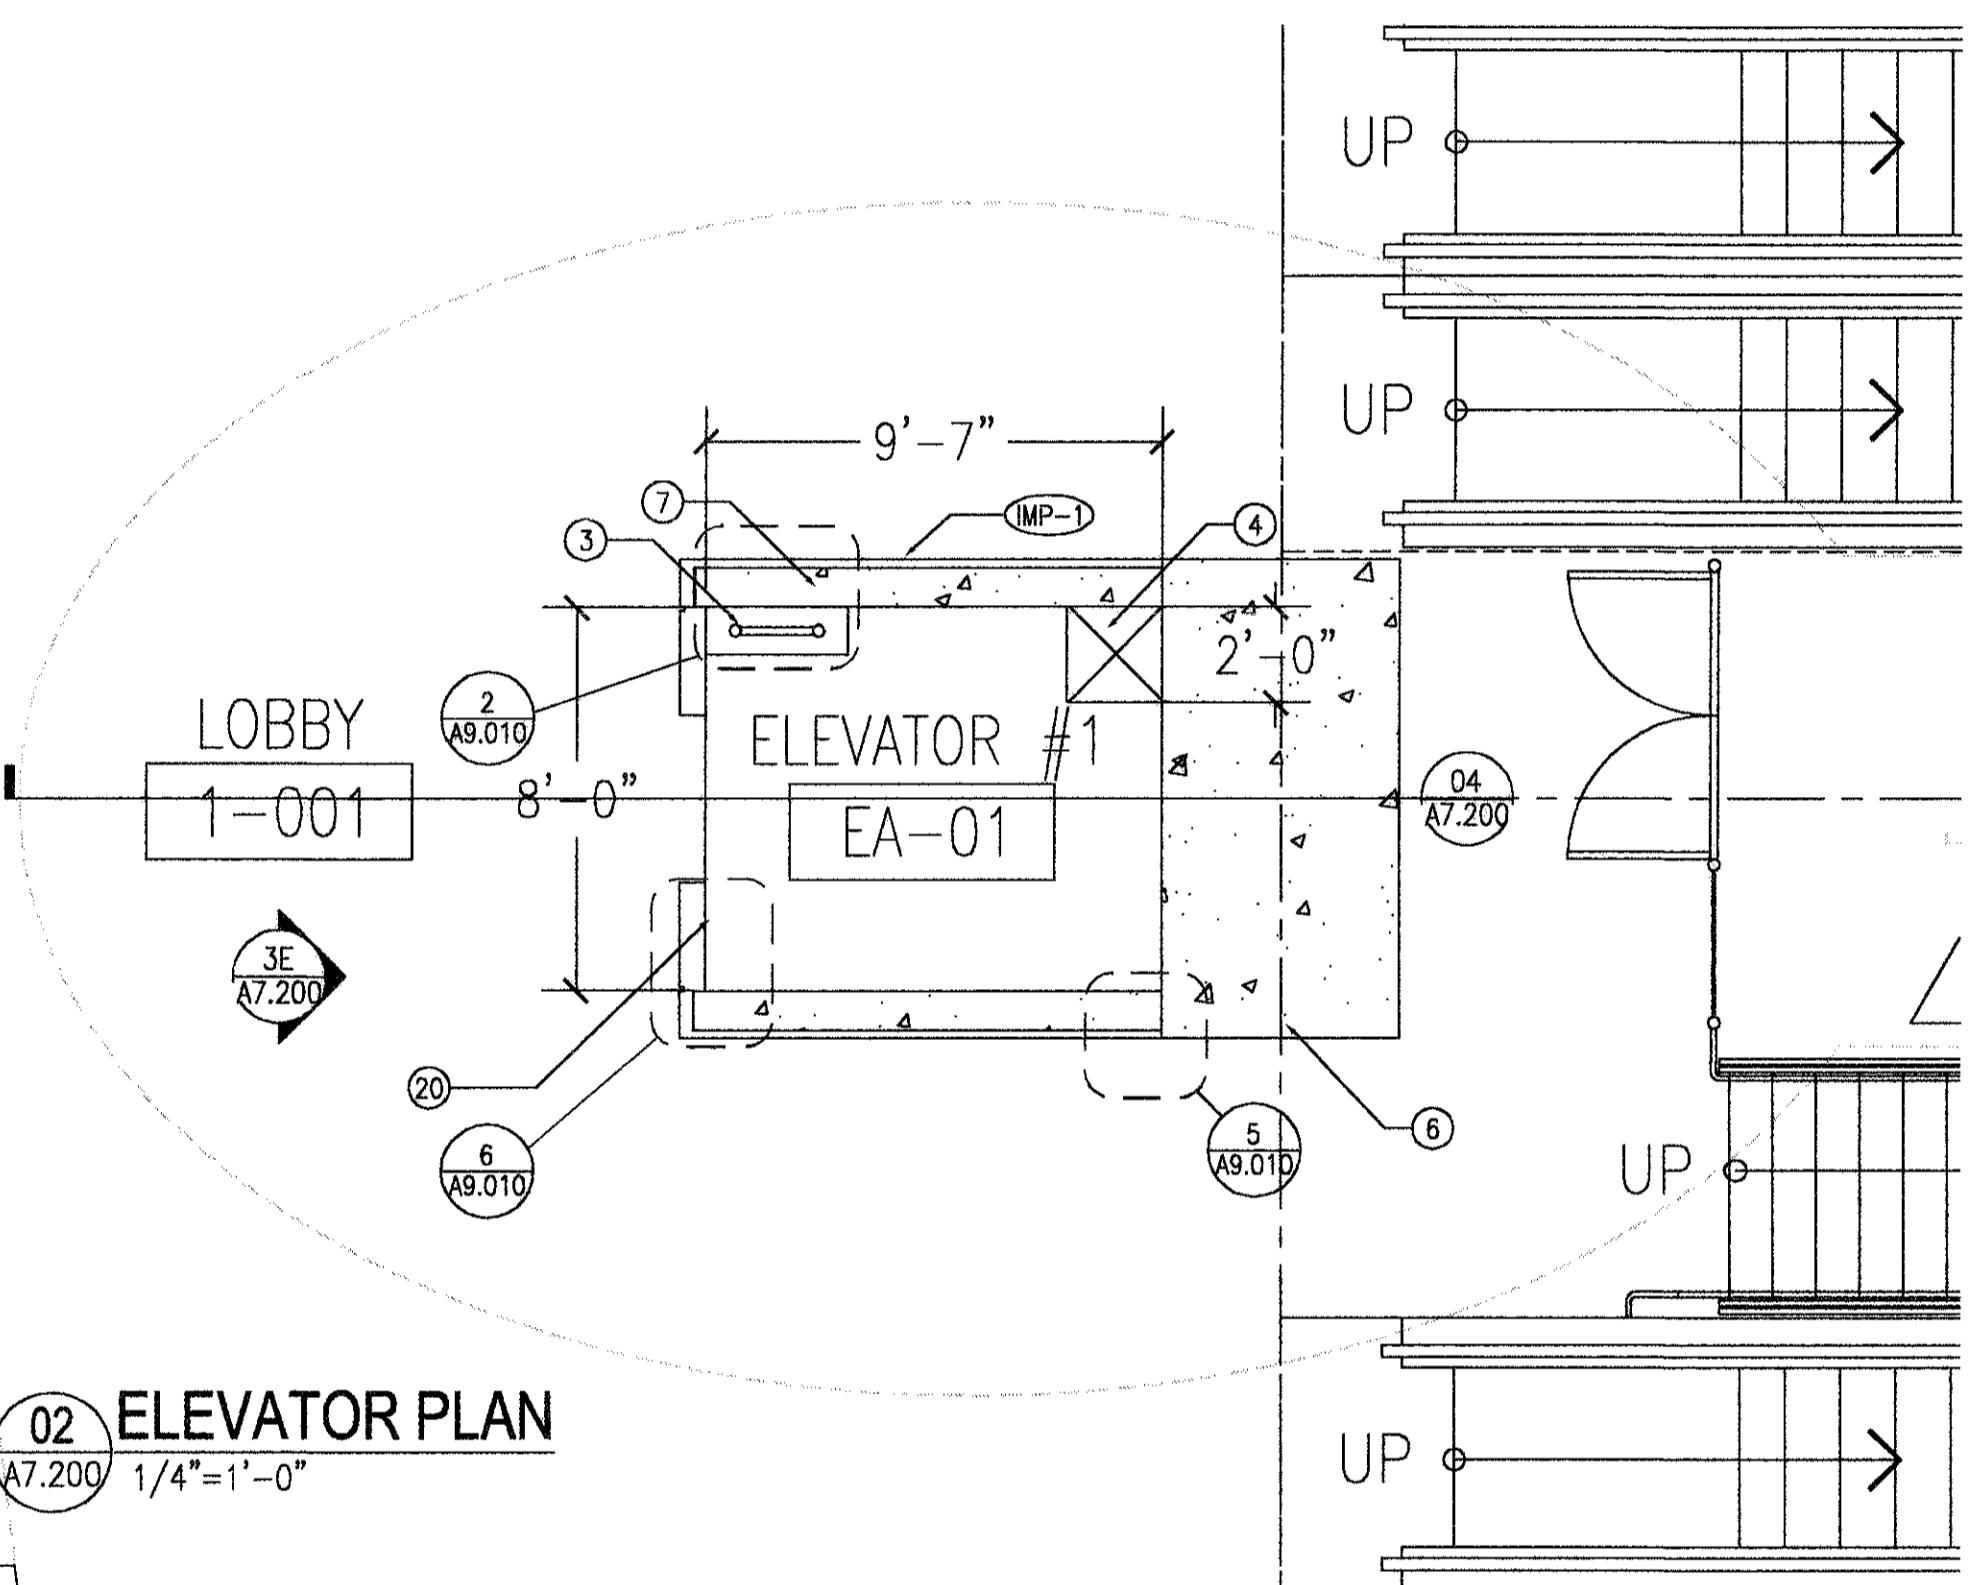


02 ELEVATOR PLAN  
A7.200 1/4"=1'-0"

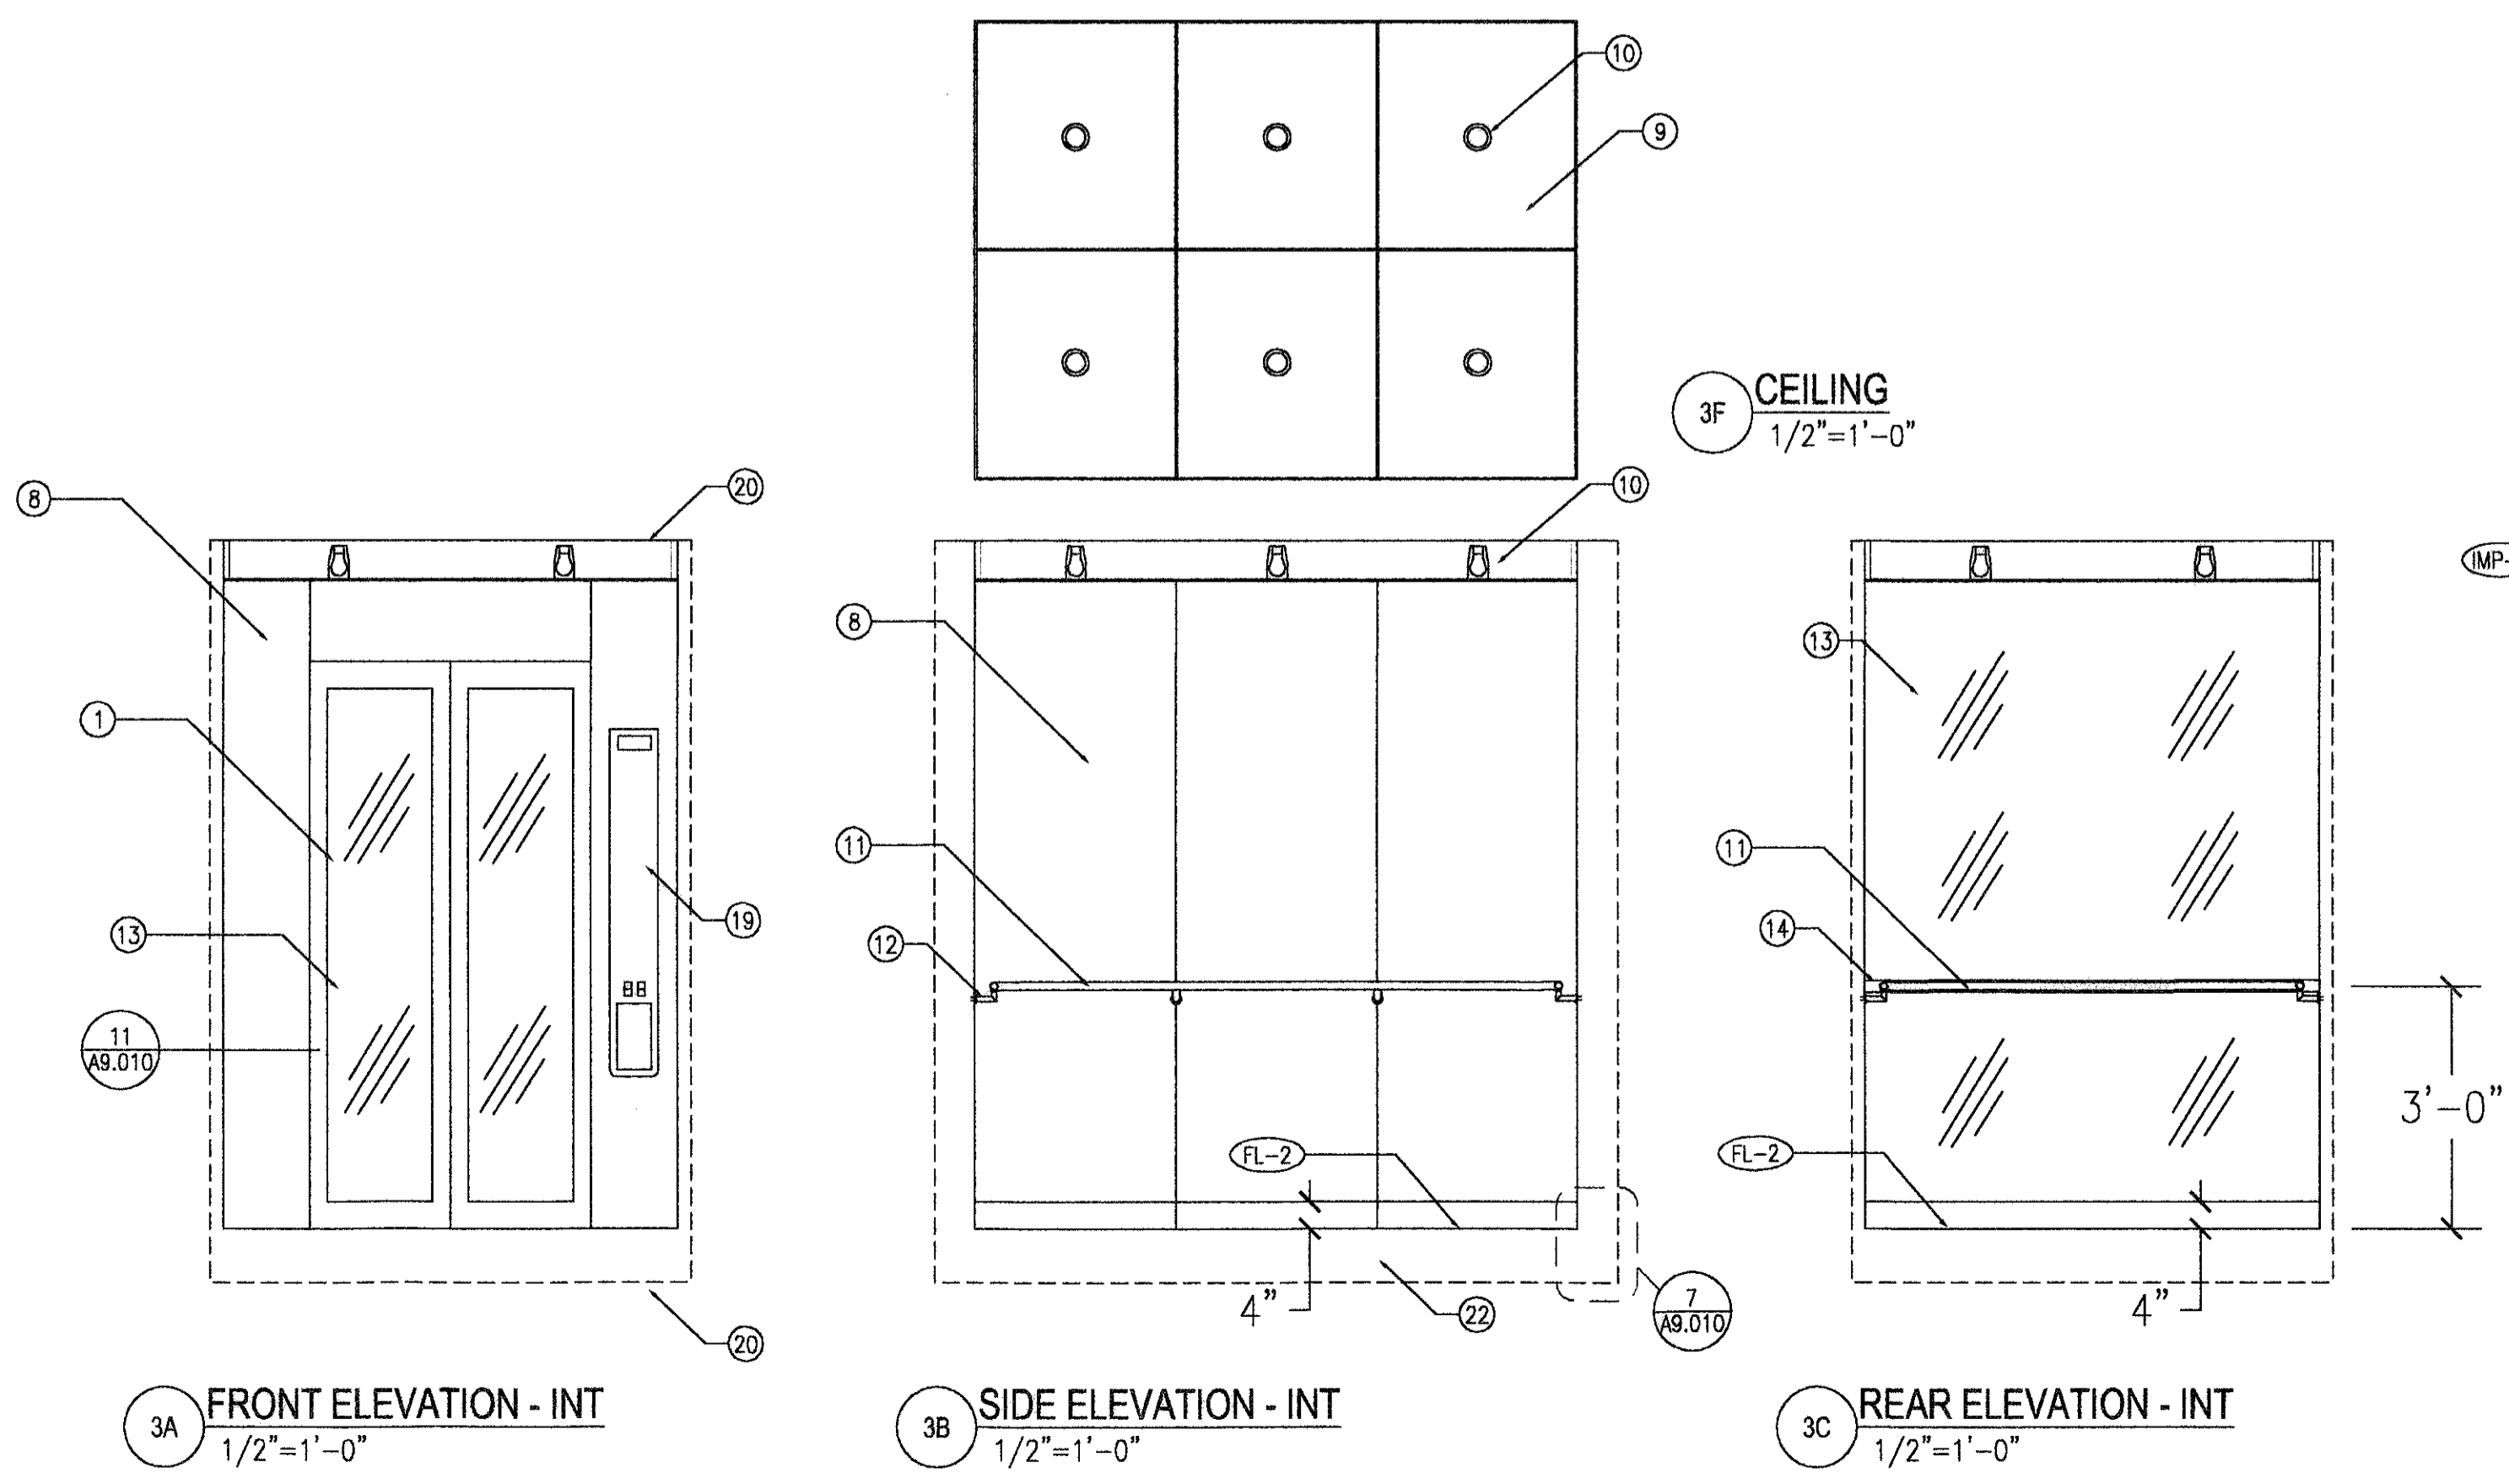

3A FRONT ELEVATION - INT  
1/2"=1'-0"

3B SIDE ELEVATION - INT  
1/2"=1'-0"

3C REAR ELEVATION - INT  
1/2"=1'-0"

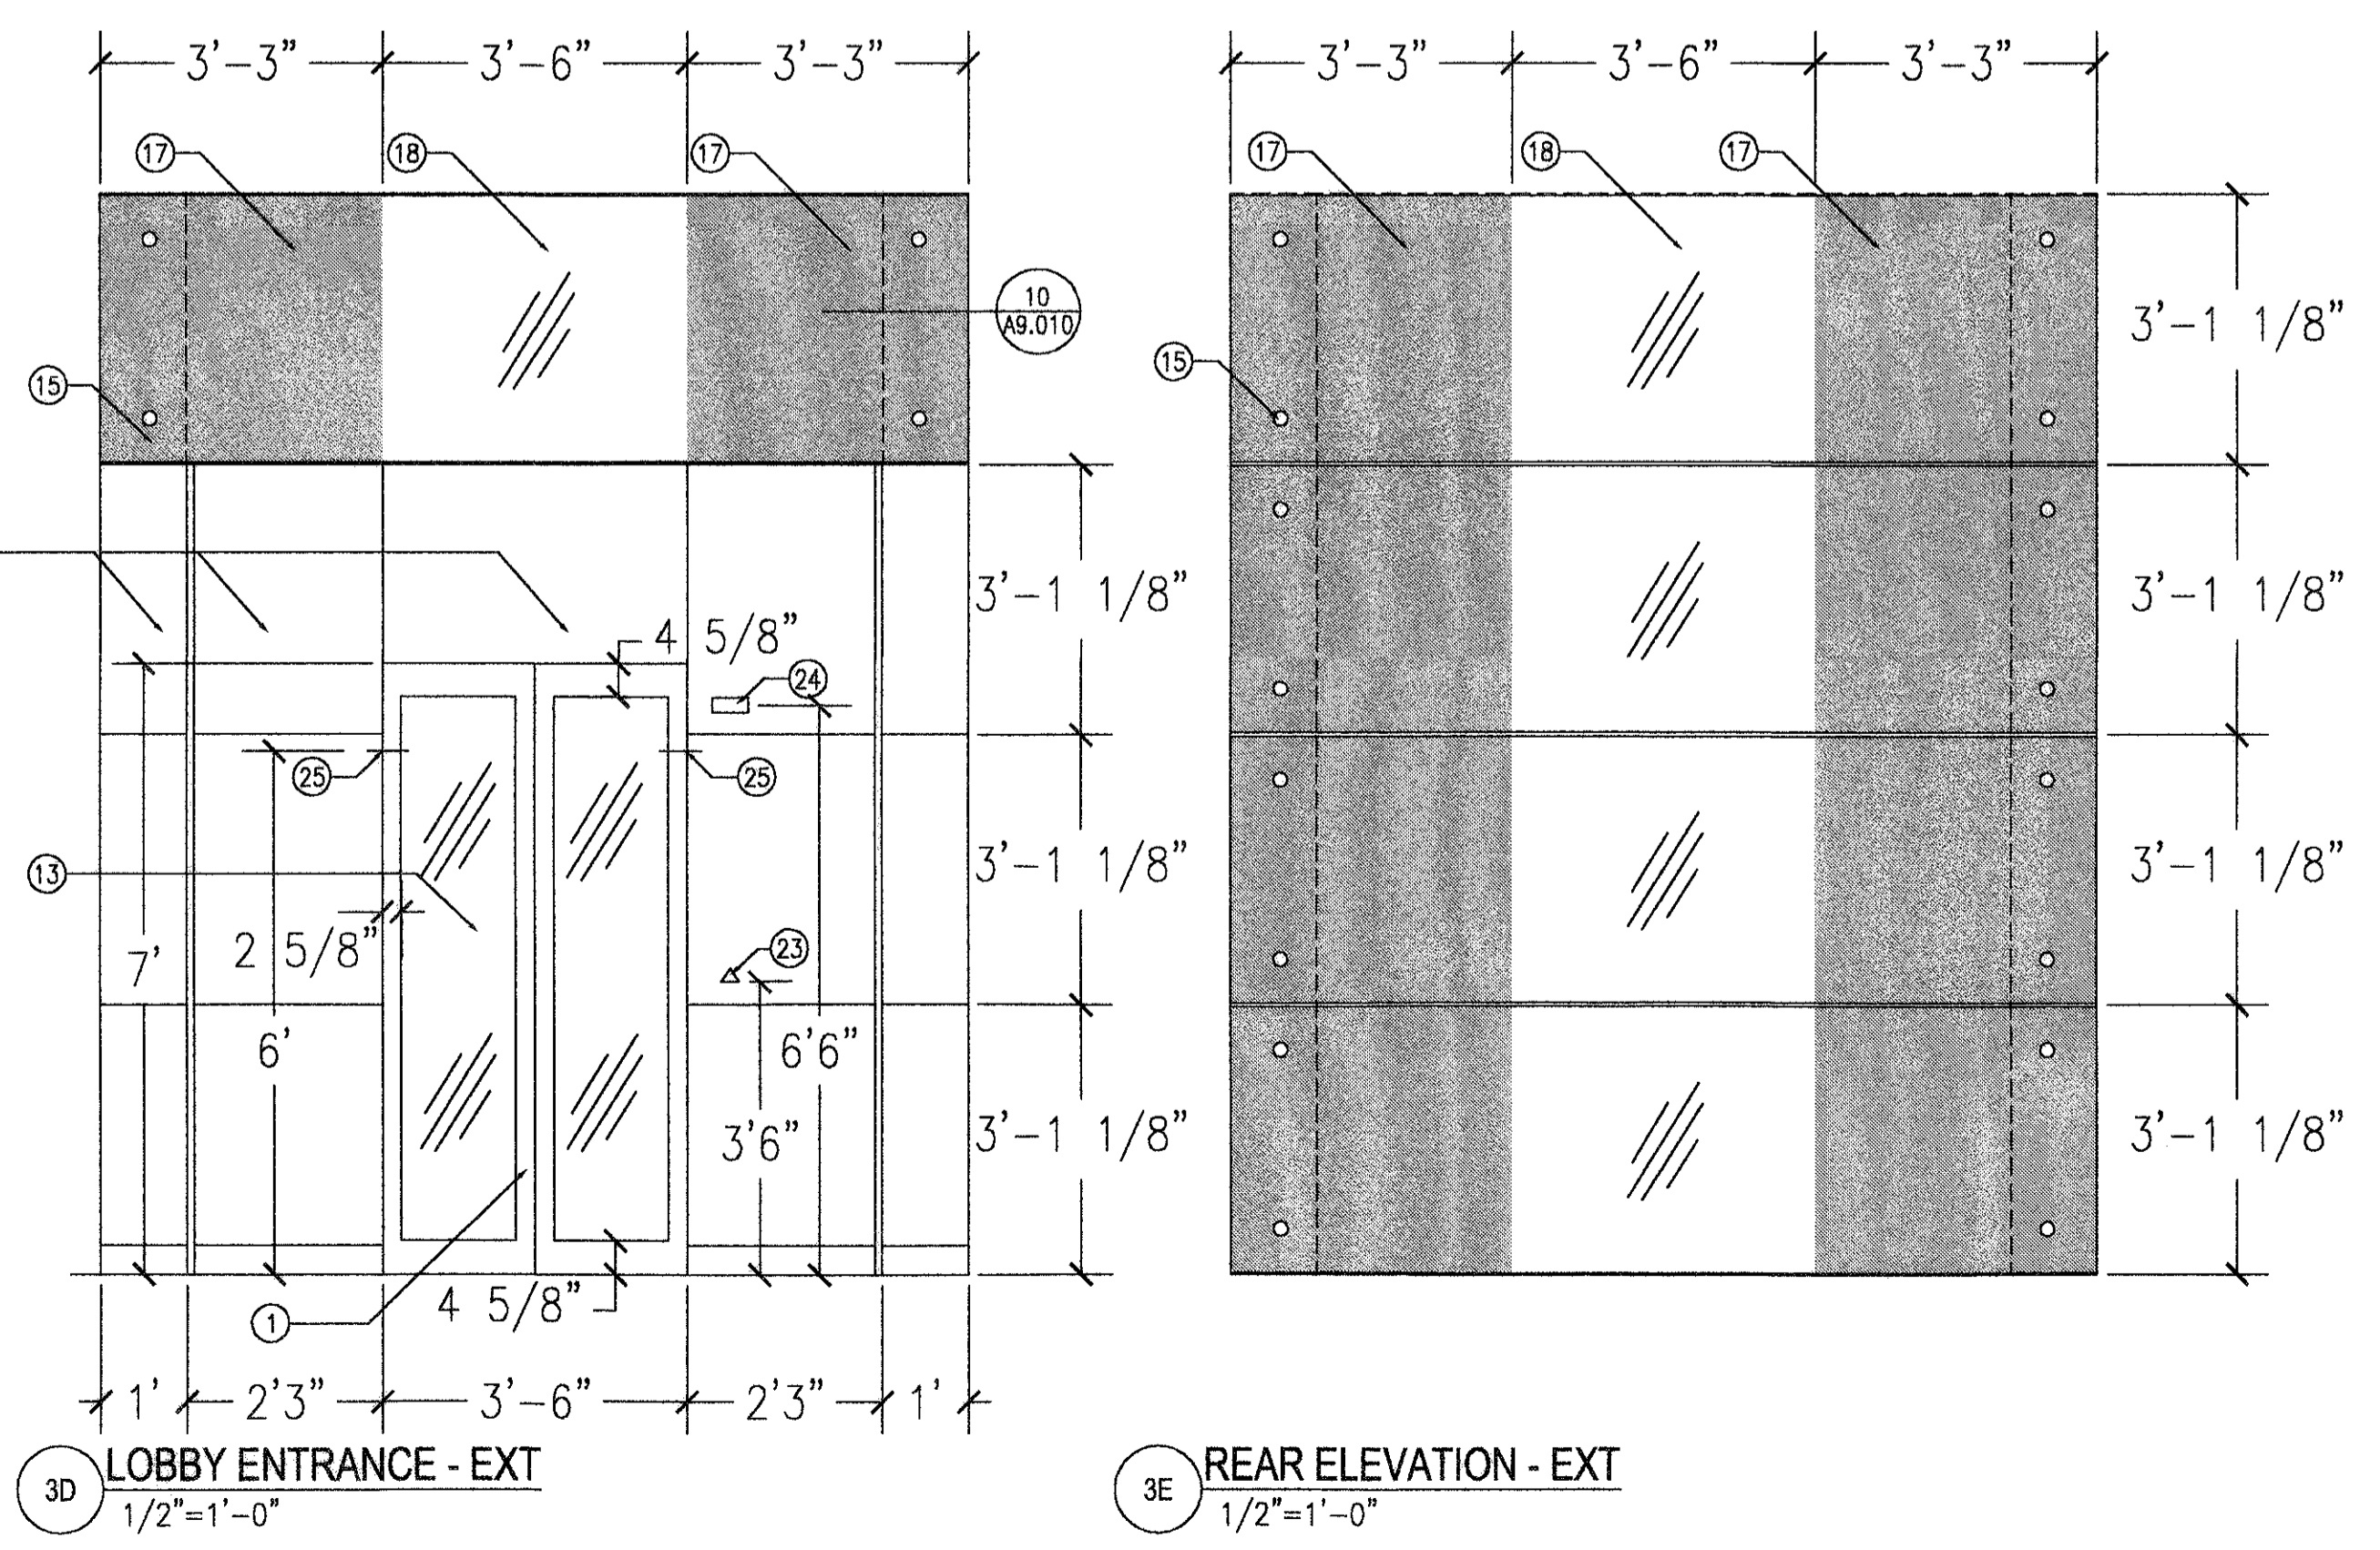

3D LOBBY ENTRANCE - EXT  
1/2"=1'-0"

3E REAR ELEVATION - EXT  
1/2"=1'-0"

03 TYPICAL INTERIOR ELEVATIONS @ ELEVATOR  
A7.200 1/2"=1'-0"

GENERAL NOTES:

- GL-6 1/2" THK LAMINATED GLASS WITH PARTIAL WHITE INTERLAYER
- FL-2 TERRAZZO FLOOR TYPE 2
- IMP-1 INTERIOR STAINLESS STEEL WALL PANELS

KEYED NOTES:

- 1 GLASS DOORS @ HOISTWAY AND CAB - CENTER OPENNING
- 2 GLASS BACK @ CAB
- 3 LADDER - GALVANIZED STEEL-SECURE TO CONCRETE STRUCTURE - RE A9.010
- 4 SUMP PIT
- 5 ALL VISIBLE EQUIPMENT - PAINT
- 6 CONCRETE COLUMN - PAINT
- 7 CONCRETE WALLS - PAINT
- 8 SSSL CLADDING - 1/16" THK MIN - NON- DIRECTIONAL MACHINE POLISH
- 9 STAINLESS STEEL CEILING PANELS
- 10 DOWNLIGHT
- 11 SSSL HANDRAIL
- 12 HANDRAIL SUPPORT - SSSL
- 13 1/2" THK TEMPERED GLASS - CLEAR
- 14 INTERMEDIATE SSSL MULLION
- 15 SSSL GLASS BRACKET - 2" DIA. MAX - SECURE TO CONCRETE WALL.
- 16 NOT USED
- 17 PART OF LAMINATED GLASS PANEL WITH WHITE INTERLAYER
- 18 PART OF LAMINATED GLASS PANEL CLEAR
- 19 CONTROL PANEL- SSSL
- 20 SHEET METAL CLADDING - POWDERCOATED
- 21 STEEL BEAM - RE STRUCTURAL - PAINT
- 22 CAB FRAME BY CAB MANUFACTURER
- 23 CALL BUTTONS
- 24 HALL LANTERN
- 25 TACTILE AND BRAILLE FLOOR SIGN @ BOTH JAMB

**RECORD DRAWINGS**  
DO NOT MODIFY  
Ray de la Reza Architects, Inc.  
13 May 2005  
Note: Information used to develop these documents was taken from Record of the Work Drawings prepared by the construction contractor, Clark Construction Group - Texas. The information provided by the contractor was not verified by the design firm named above.


NOTE: REFER TO GRAPHIC SCALE IF ACTUAL SHEET SIZE IS OTHER THAN 30"x42".  
SCALE: 1/4" = 1'-0"

HOLSTON AIRPORT SYSTEM  
GEORGE BUSH  
INTERCONTINENTAL AIRPORT  
HOUSTON TEXAS  
**Lea Elliott**  
1008 W RANDOL MILL RD.  
HOUSTON, TX 77012  
Tel: 817.261.1445  
Tel: 817.861.3296  
**Ray de la Reza Architects, Inc.**  
1245 WEST 10TH ST.  
HOUSTON, TX 77008  
Tel: 713.868.3121  
Tel: 713.802.0112

NO.	DESCRIPTION	DATE	BY
1	ISSUED FOR BID	10/19/01	SEM
2	RECORD SET	05/13/05	EM

INTERNATIONAL SERVICES EXPANSION PROGRAM  
**APM STATION + PLATFORM**  
ELEVATOR  
PLANS AND SECTION


PROJECT MGR: SEM  
DESIGNER: SD  
DRAWN BY: SEM  
CHECKED BY: AB  
DRAWING STANDARD: ISDP 07.20.2000  
SCALE: 1/4"=1'-0"  
DATE: 05/14/01

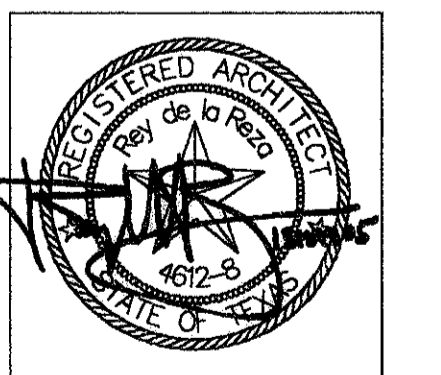

APPROVED BY: \_\_\_\_\_ DATE: \_\_\_\_\_  
DIRECTOR  
HOUSTON AIRPORT SYSTEM  
PROJECT NO. 1140  
C.I.P. NO. A-0584  
H.A.S. NO. 586  
SHEET NO. 415

PLOT DATE: 02/04/02 HAS FILE: A536CA7200



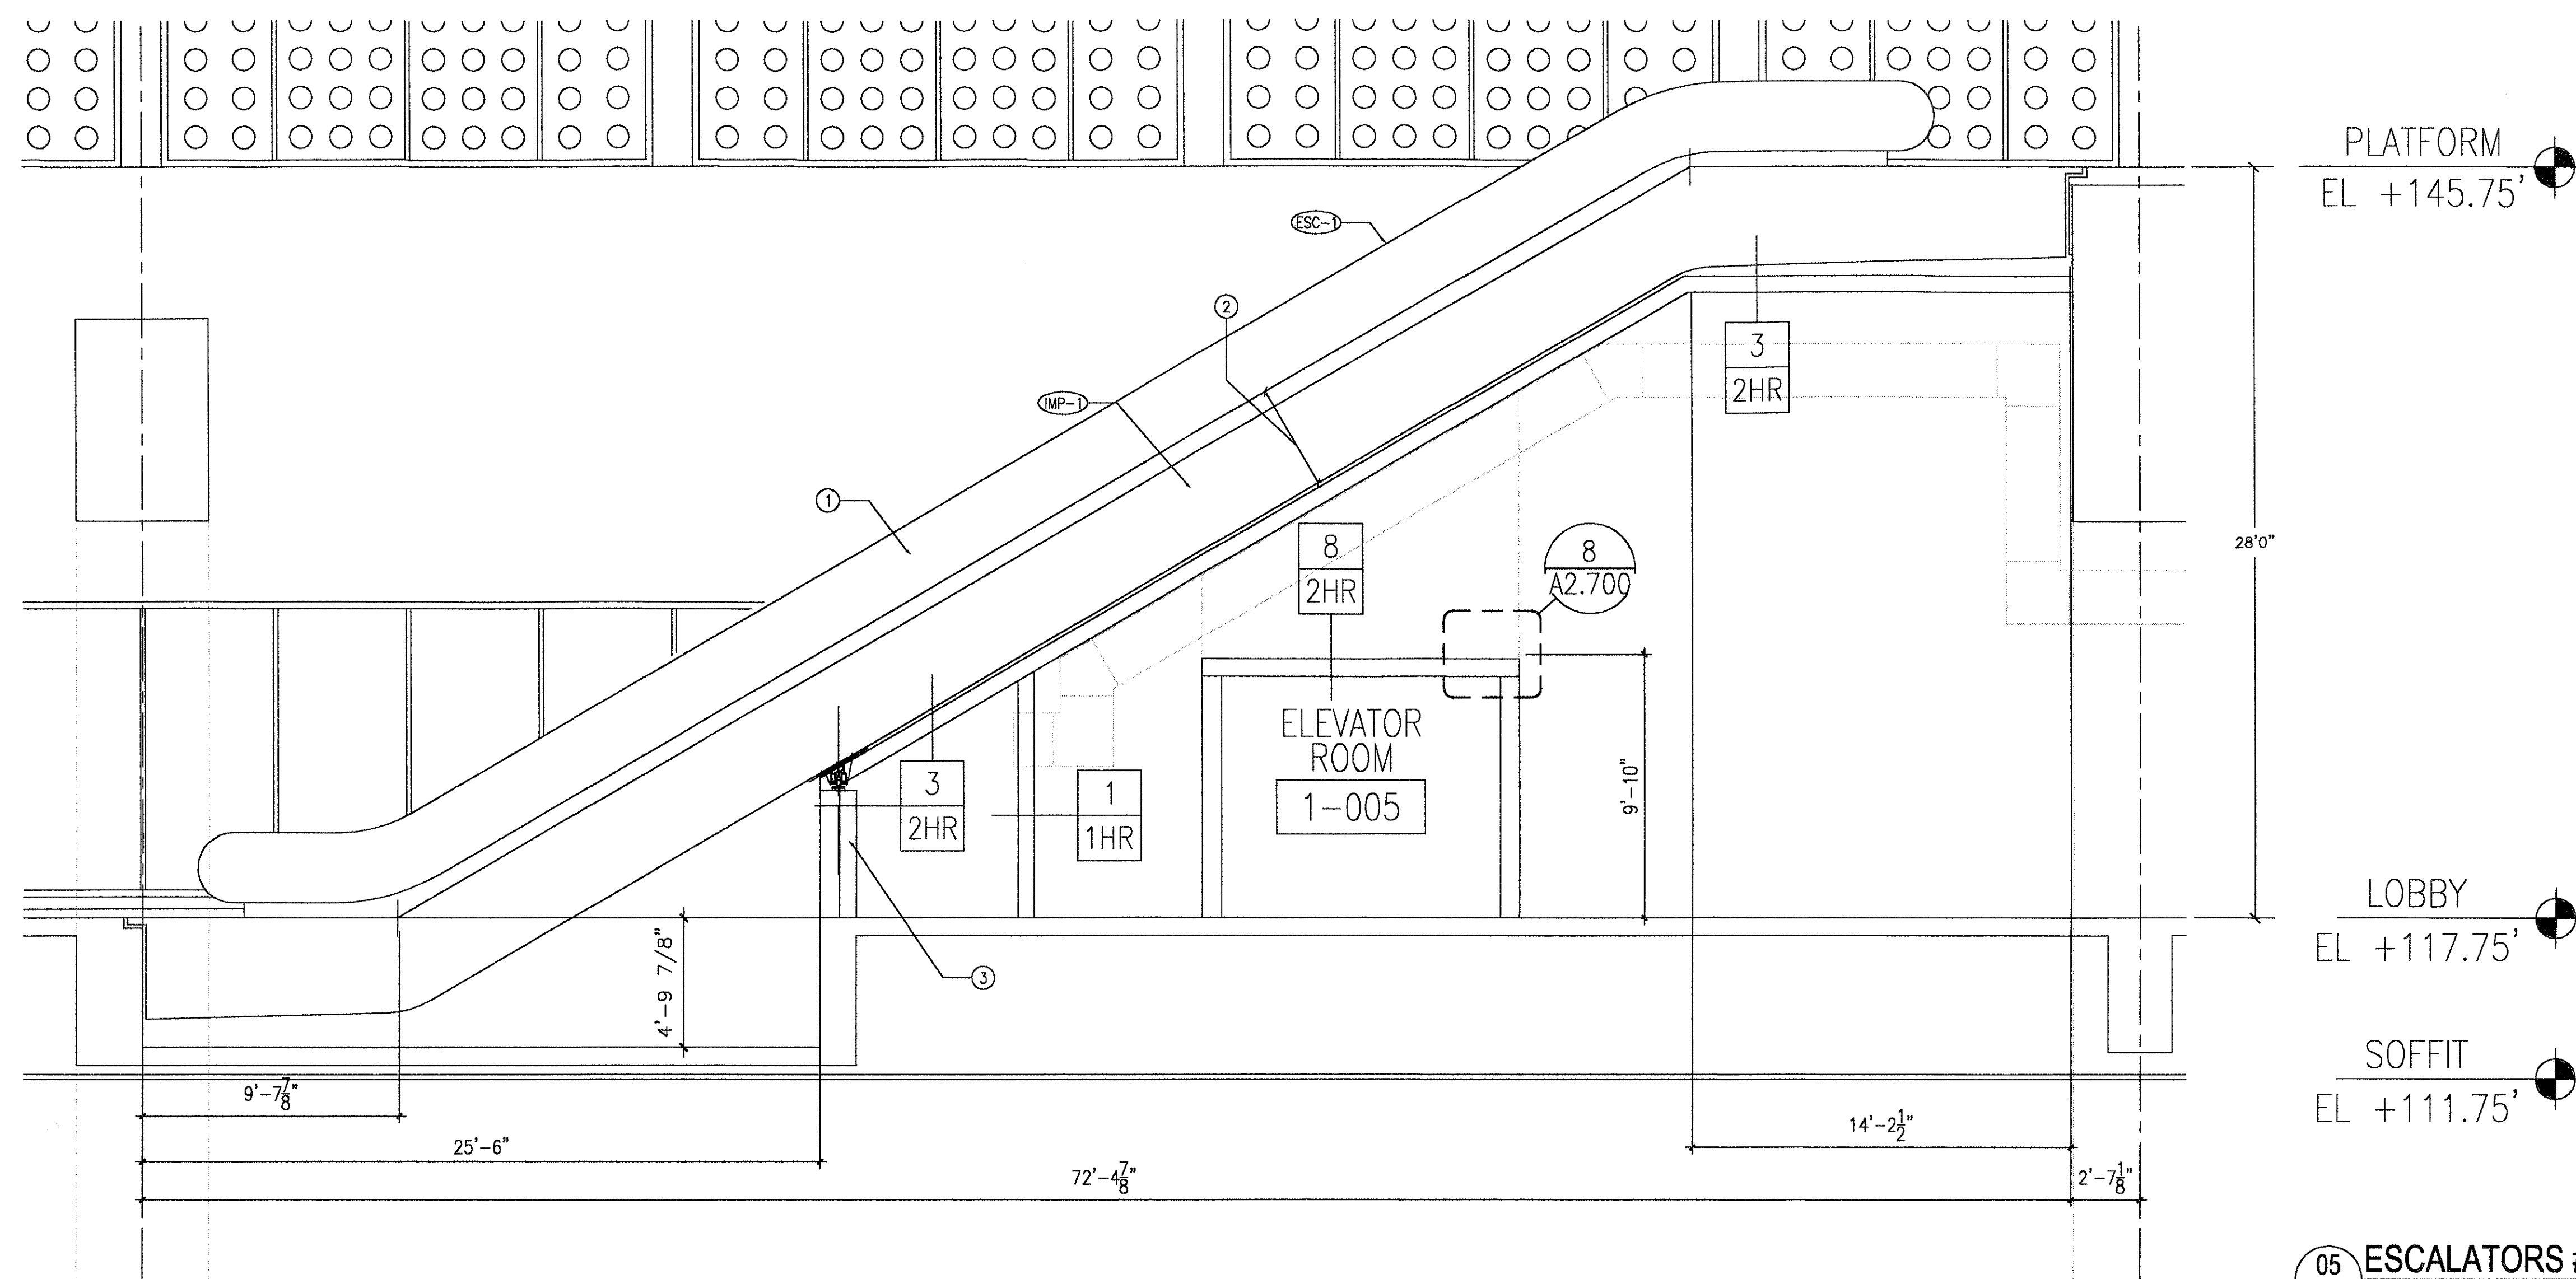

05 ESCALATORS #1, #2 & #3  
A7.300 1/4"=1'-0"

GENERAL NOTES:

- ESC-1 MONTGOMERY KONE TRANSIT ESCALATOR OR EQUAL WITH GLASS BALUSTRADE
- MP-1 INTERIOR STAINLESS STEEL WALL PANELS

**HOUSTON AIRPORT SYSTEM**  
 GEORGE BUSH  
 INTERCONTINENTAL AIRPORT  
 HOUSTON TEXAS


**Lea Elbert**  
 1006 W RANDOL MILL RD  
 WASHINGTON, MO  
 Tel: 817.261.1466  
 Tel: 817.861.3296

**REY DE LA REZA ARCHITECTS, INC.**  
 1345 WEST 18TH ST  
 HOUSTON, TX 77058  
 Tel: 713.868.5121  
 Tel: 713.822.0112


REVISIONS		
NO.	DESCRIPTION	DATE
ISSUED FOR BID		10/19/01
ADDENDUM 1		02/01/02 SG
RECORD SET		05/13/05 EM

KEYED NOTES:


- 1 GLASS BALUSTRADE
- 2 SSSL CLAD ON EVERY VISIBLE FACE
- 3 CONCRETE SUPPORT - RE STRUCTURAL

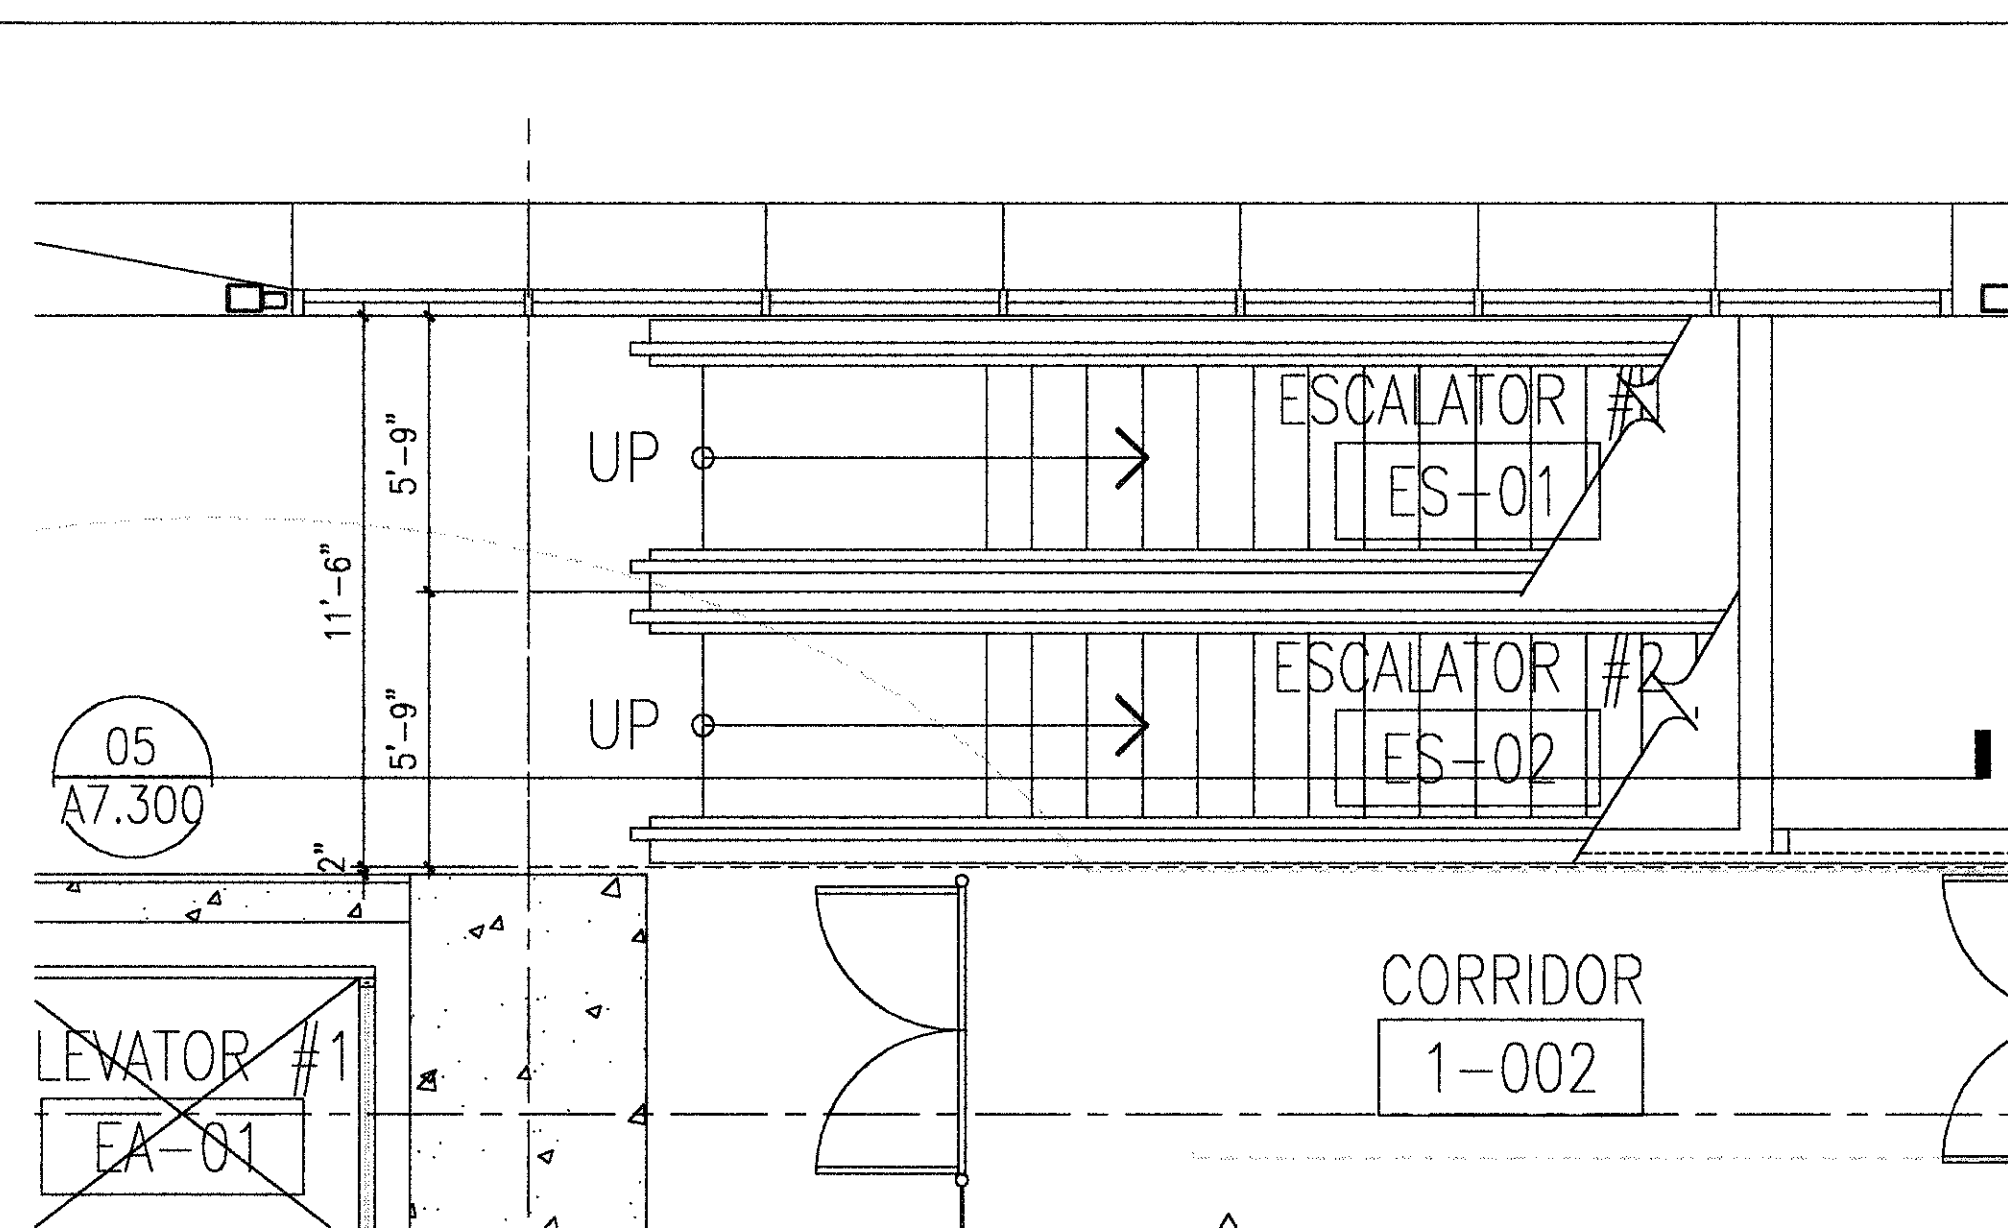


01 ESCALATOR #1 & #2 PLAN  
A7.300 1/4"=1'-0"

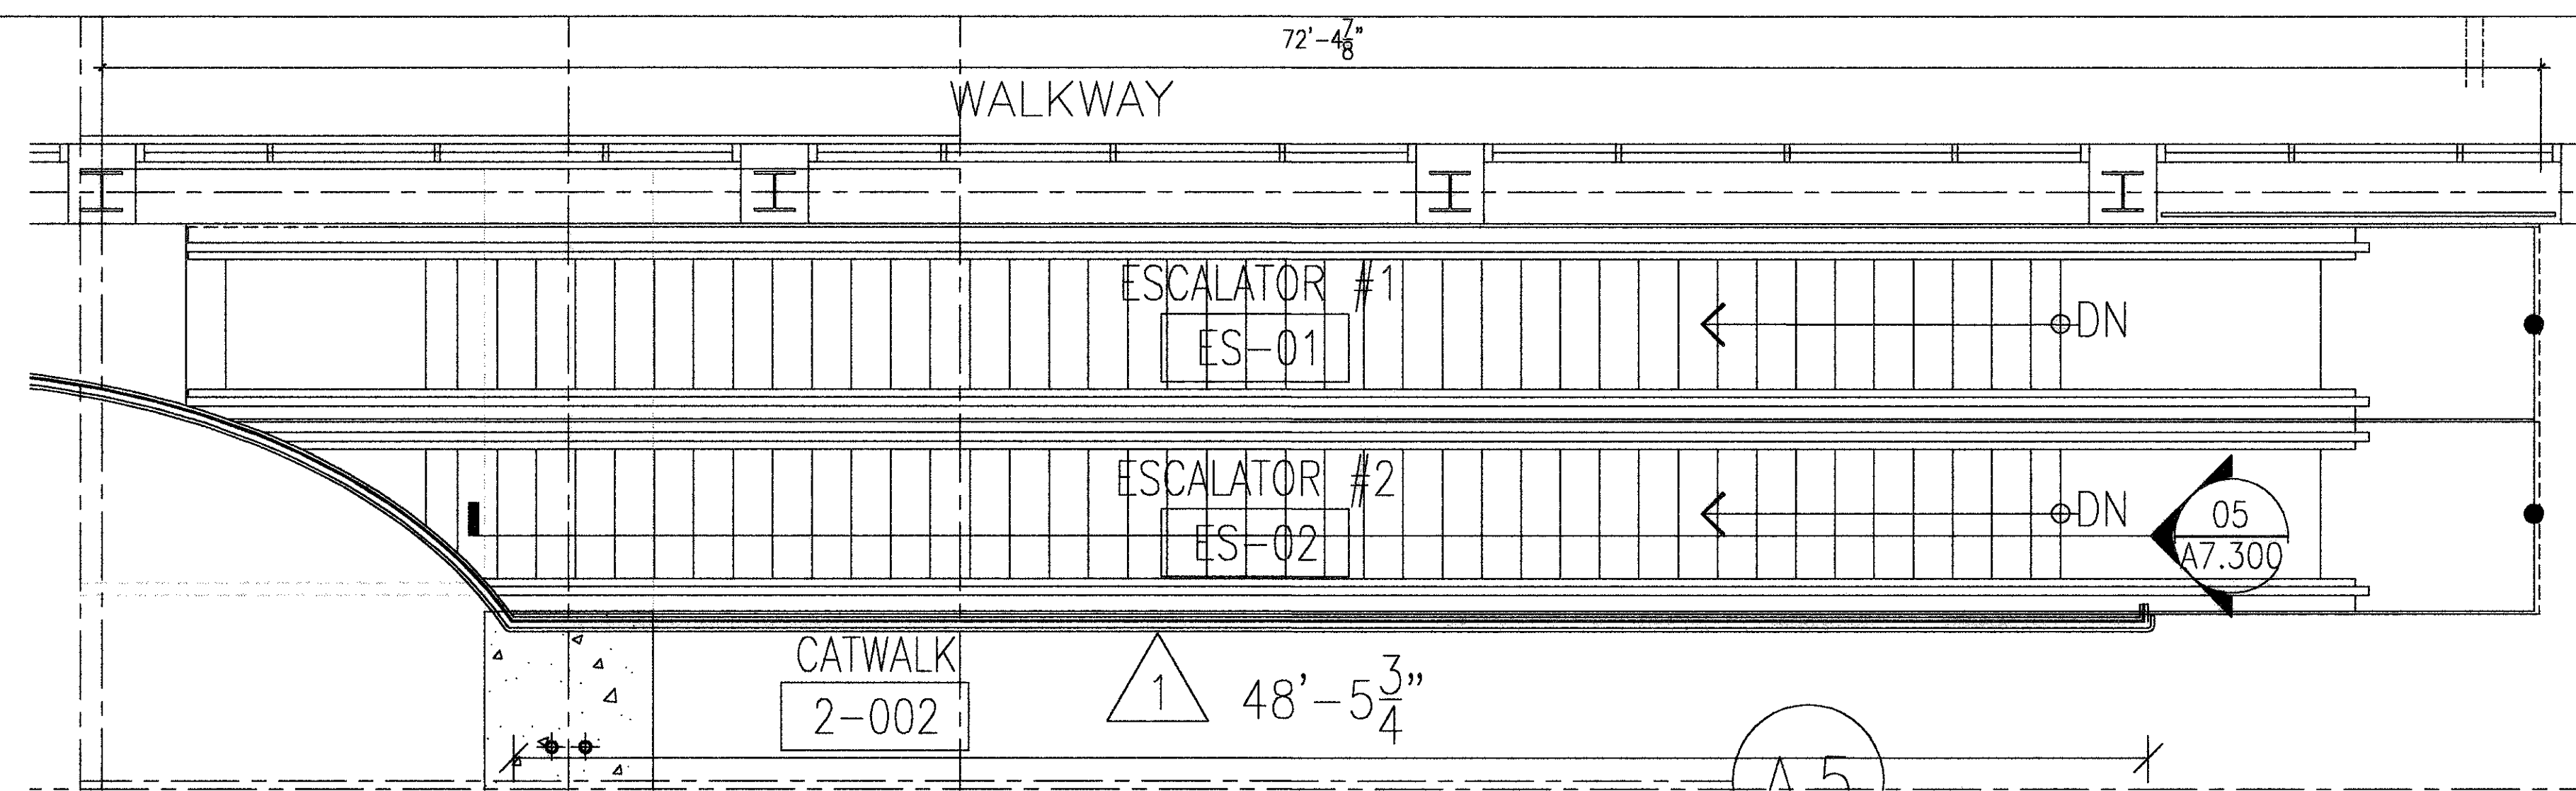

02 ESCALATOR #1 & #2 PLAN  
A7.300 1/4"=1'-0"

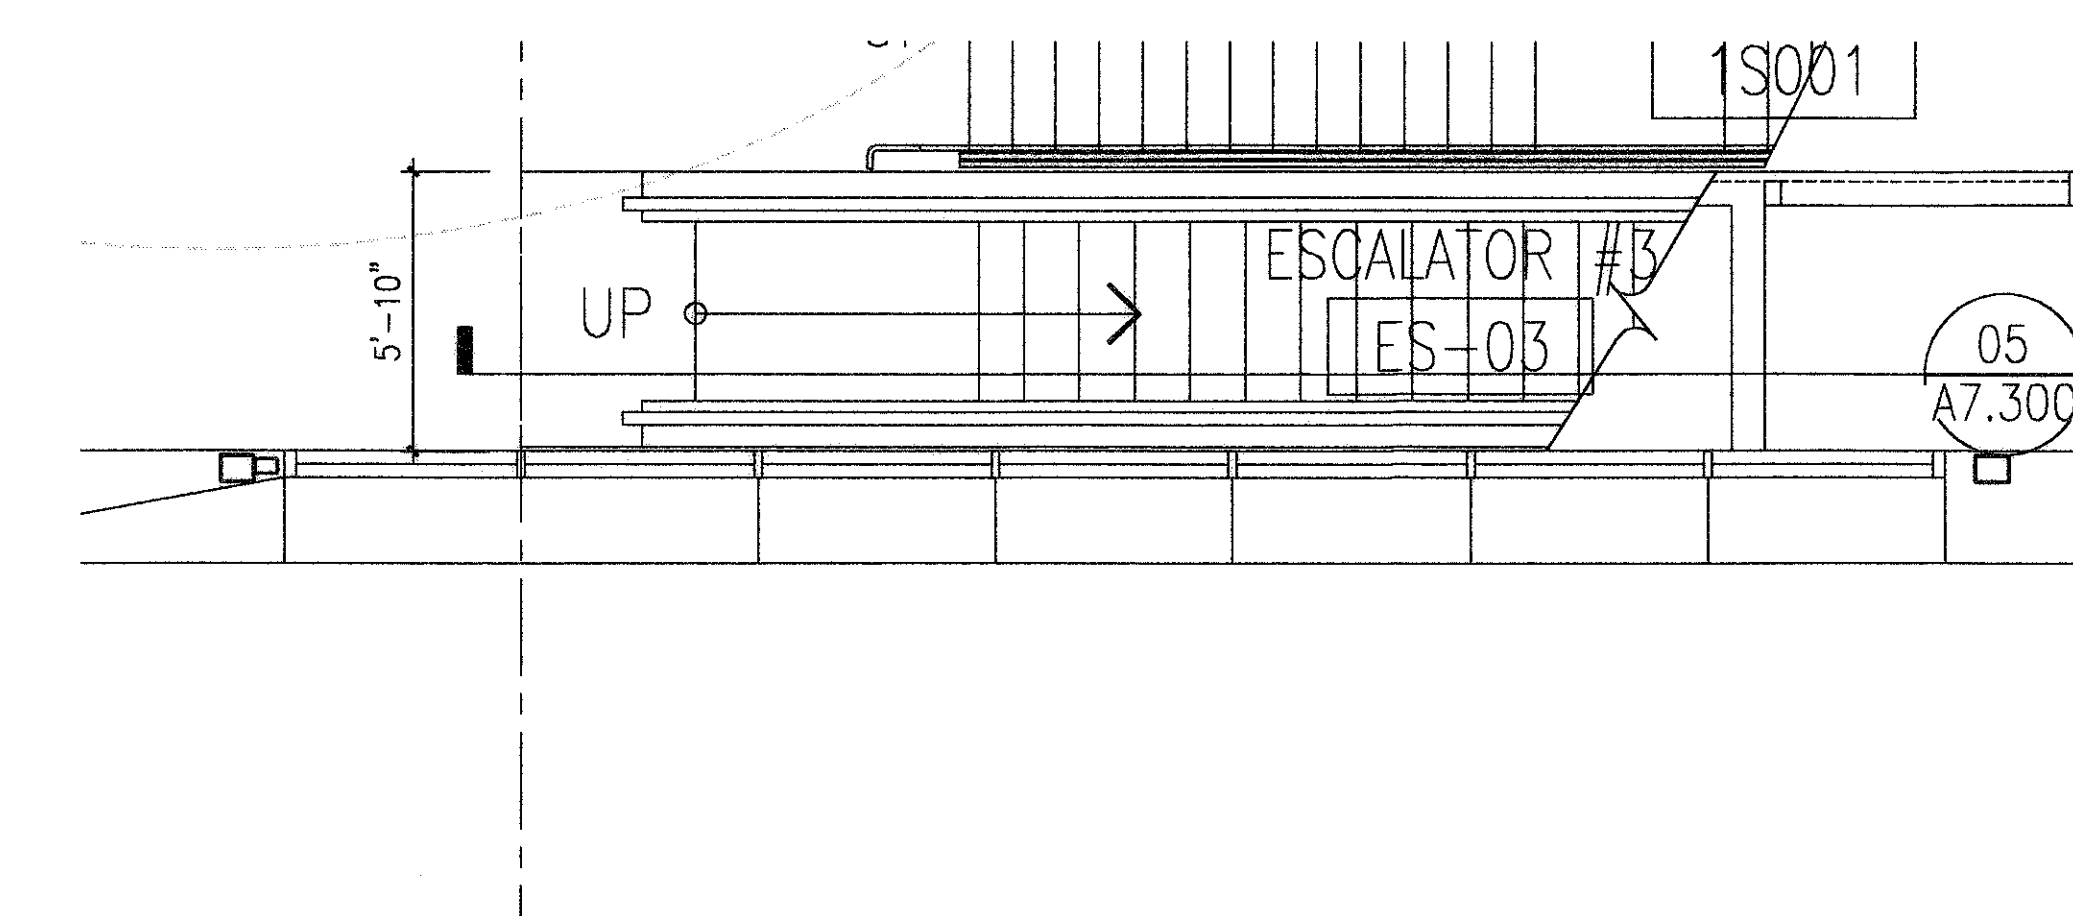

03 ESCALATOR #3 PLAN  
A7.300 1/4"=1'-0"

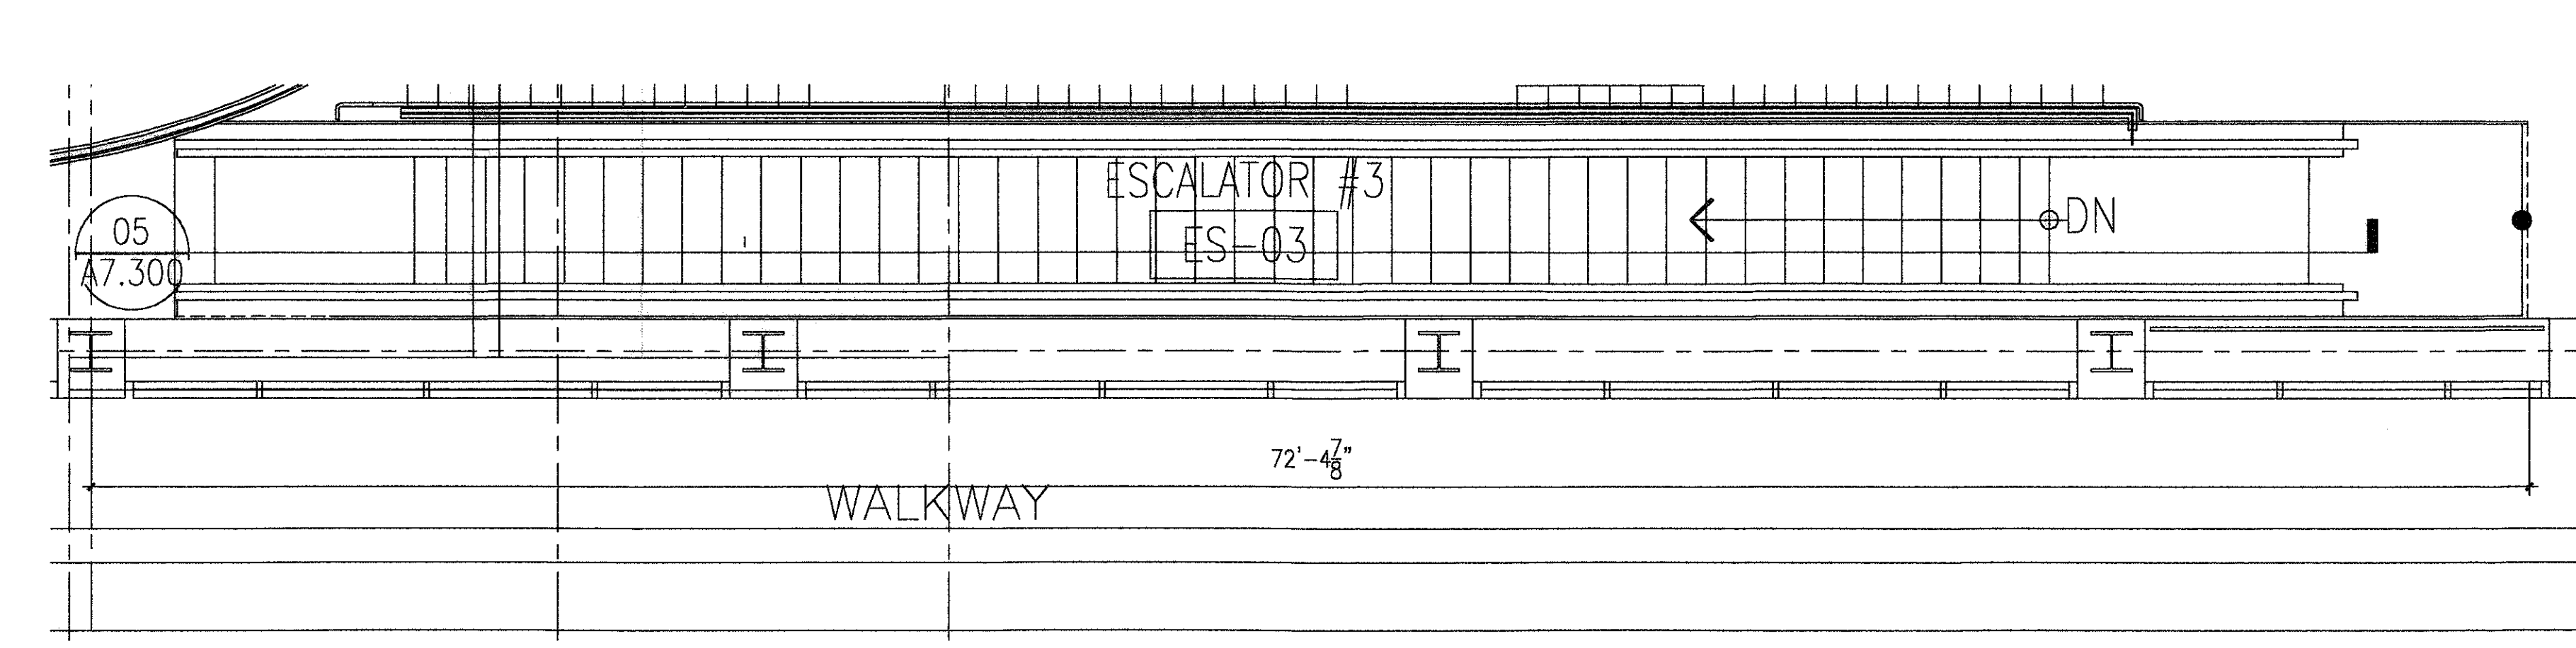


04 ESCALATOR #3 PLAN  
A7.300 1/4"=1'-0"

**RECORD DRAWINGS**  
 DO NOT MODIFY  
 Rey de la Reza Architects, Inc.  
 13 May 2005

Note: Information used to develop these documents was taken from Record of the Work Drawings prepared by the construction contractor, Clark Construction Group, - Texas. The information provided by the contractor was not verified by the design firm named above.

PROJECT MGR: HEM  
 DESIGNER: SG  
 DRAWN BY: SEM  
 CHECKED BY: AB  
 DRAWING STANDARD:

SEP 07.20.2000  
 SCALE: 1/4"=1'-0"  
 DATE: 09/14/01

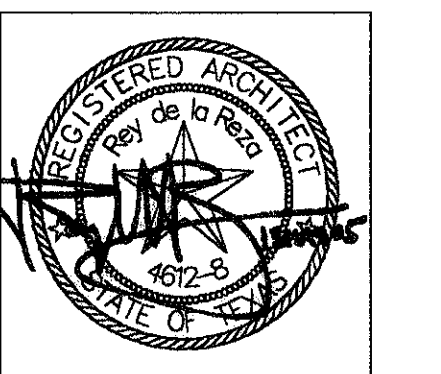

APPROVED BY: DATE:

DIRECTOR  
 HOUSTON AIRPORT SYSTEM

PROJECT NO. 1140

C.I.P. NO. A-0354

H.A.S. NO. 536C

SHEET NO.

NOTE: REFER TO GRAPHIC SCALE IF ACTUAL SHEET SIZE IS OTHER THAN 30"x42".

SCALE: 1/4" = 1'-0"

A10 A7.300

INTERNATIONAL SERVICES EXPANSION PROGRAM  
**APM STATION + PLATFORM**  
 ESCALATORS 1, 2 AND 3  
 PLANS AND SECTION



NO.	DESCRIPTION	DATE	BY
1	ISSUED FOR BID	10/19/01	JM
2	ADDENDUM 1	02/01/02	SG
3	RECORD SET	05/13/05	EM

GENERAL NOTES:


- (CW-2A) CURTAINWALL SYSTEM TYPE 2A - RE WINDOW SCHEDULE SHEET A2.850
- (CW-4) INTEGRATED STRUCTURAL CURTAINWALL SYSTEM TYPE 4 - RE WINDOW SCHEDULE SHEET A2.850
- (EMP-1) EXTERIOR POWDERCOATED WALL METAL PANELS - ALUMINUM PANEL 1/8" THICK - TYPE SERIES 3000 MODIFIED FROM UNA-CLAD - COPPER SALES OR EQUAL - POWDERCOATED KYMAR 500
- (EMP-2) POWDERCOATED ALUMINUM LOUVERS - WITH INSECT MESH WHEN USED BY MECHANICAL - CLOSED WITH 1/8" THK ALUMINUM SHEET WELDED CONTINUOUSLY TO FRAME WHEN NOT USED BY MECHANICAL - RE: MECHANICAL FOR OPENINGS
- (RF-1) STANDING SEAM METAL ROOF - TYPE UC3 FROM UNA-CLAD - COPPER SALES OR EQUAL - POWDERCOATED KYMAR 500; COLOR #2 SILVER METALLIC
- (GWB) PAINT 5/8" HI-IMPACT GYPSUM BOARD ON METAL STUDS
- (IMP-1) INTERIOR STAINLESS STEEL WALL PANELS - NGADE SYSTEM BY BAKER METAL PRODUCTS INC. OR EQUAL - 1/16" THK MIN - MULTI DIRECTIONAL MACHINE POLISH

KEYED NOTES:

- 1 METAL STUD CONSTRUCTION W/ BATT INSULATION
- 2 2 1/2" x 7 1/2" ALUMINUM VERTICAL MULLION - POWDERCOATED - STEEL REINFORCING AS REQUIRED FOR WIND LOADS
- 3 1/2" SHEATHING
- 4 SLOPED METAL PANEL - TYPE EMP-1
- 5 SEALANT & BACKER ROD
- 6 SHIM
- 7 PRECOMPRESSED EXPANDING FOAM SEALANT TYPE COLORSEAL BY EMSEAL OR EQUAL - STANDARD COLOR TO MATCH COLOR OF METAL PANELS
- 8 8" METAL STUD @ 16" O.C. - 16 GA
- 9 12" ALUMINUM CHANNEL - BOLT TO STUDS BY CONNECTING PLATE WELD PRIOR PAINTING TO CHANNEL BACK - POWDERCOATED - JOINTS PERFECTLY ALIGNED WITH CONSTRUCTION GRID - MIN LENGTH FOR HORIZONTAL CHANNEL 20'-0"
- 10 BLUE SAFETY LIGHT
- 11 ALUMINUM SHEET WELD TO FRAME @ BACK OF LOUVERS WHEN LOUVERS NOT USED BY MECHANICAL - RE: MECHANICAL FOR OPENINGS
- 12 CONCRETE COLUMN - PAINT
- 13 STEEL COLUMN & CLADDING @ SECURE BRIDGE N.L.C. BY HAS 500F
- 14 FIR SECURE BRIDGE COLUMN GRID LINE - HAS 500F - LOCATION TO BE COORDINATED WITH HAS 500F
- 15 EDGE OF SECURE BRIDGE SLAB - HAS 500F
- 16 EDGE OF SLAB @ LOBBY
- 17 8" DILATION JOINT - N.L.C. - BY PROJECT 500F
- 18 W COLUMN WITH 3 HR FIREPROOFING
- 19 COMPRESSIBLE JOINT BY OTHERS - 500F - N.L.C.
- 20 SEALANT
- 21 CHS, CHR, HWS, HWR SUPPLY - RE MECHANICAL
- 22 2HR RATED PENETRATION THROUGH 2HR PARTITION - UL SYSTEM N-C-5028
- 23 4" STEEL TUBE SUPPORT OF 2 HR ROLLING DOOR - TO BE COORDINATED WITH ROLLING DOOR MANUFACTURER - WELDED TO 4" X 12" BEAM ABOVE
- 24 MAGNETIC HOLDER
- 25 SWINGING DOOR FRAME - SSTL CLAD ON VISIBLE FACE - RE MC KEON 2HR FIREDOOR
- 26 SWINGING EGRESS DOOR - SSTL CLAD ON VISIBLE FACE - RE MC KEON 2HR FIREDOOR
- 27 2 1/2" x 10 1/2" VERTICAL ALUMINUM MULLION - POWDERCOATED - STEEL REINFORCING AS REQUIRED FOR WIND LOADS
- 28 SHEET METAL - POWDERCOATED - FIXED BY POP RIVETS TO STEEL Z
- 29 STEEL Z @ ANGLE - CURVED @ ROOF - 1/8" THK.
- 30 HONEYCOMBED ALUMINUM PANEL - 1/2" THK - POWDERCOATED
- 31 SPRINKLER, FIRELINE TO FIRE VALVE CABINET, DOMESTIC WATER, ELECTRICAL CONDUIT - RE PLUMBING AND ELECTRICAL
- 32 RECESSED FIRE VALVE CABINET
- 33 FIRE VALVE AND FIRE EXTINGUISHER CABINET
- 34 4" STEEL VALVE COLUMN UP TO CONCRETE BEAMS ABOVE - CURTAIN WALL STRUCTURE - RE STRUCTURAL

INTERNATIONAL SERVICES EXPANSION PROGRAM  
**APM STATION + PLATFORM**  
 PLAN DETAILS

PROJECT MGR:	HEM
DESIGNER:	SG
DRAWN BY:	SEM
CHECKED BY:	AB
DRAWING STANDARD:	ISEP 07.20.2000
SCALE:	AS NOTED
DATE:	09/14/01

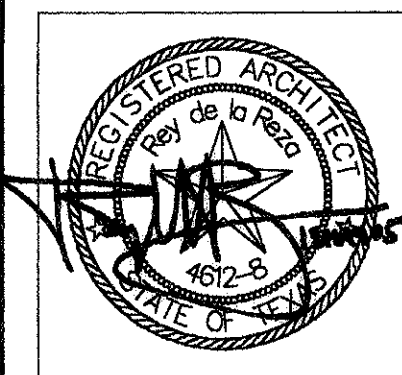


APPROVED BY: \_\_\_\_\_ DATE: \_\_\_\_\_


PROJECT NO.	1140
C.I.P. NO.	A-0354
H.A.S. NO.	538C
SHEET NO.	17

**RECORD DRAWINGS**  
 DO NOT MODIFY  
 Rey de la Reza Architects, Inc.  
 13 May 2005


Note: Information used to develop these documents was taken from Record of the Work Drawings prepared by the construction contractor, Clark Construction Group - Texas. The information provided by the contractor was not verified by the design firm named above.

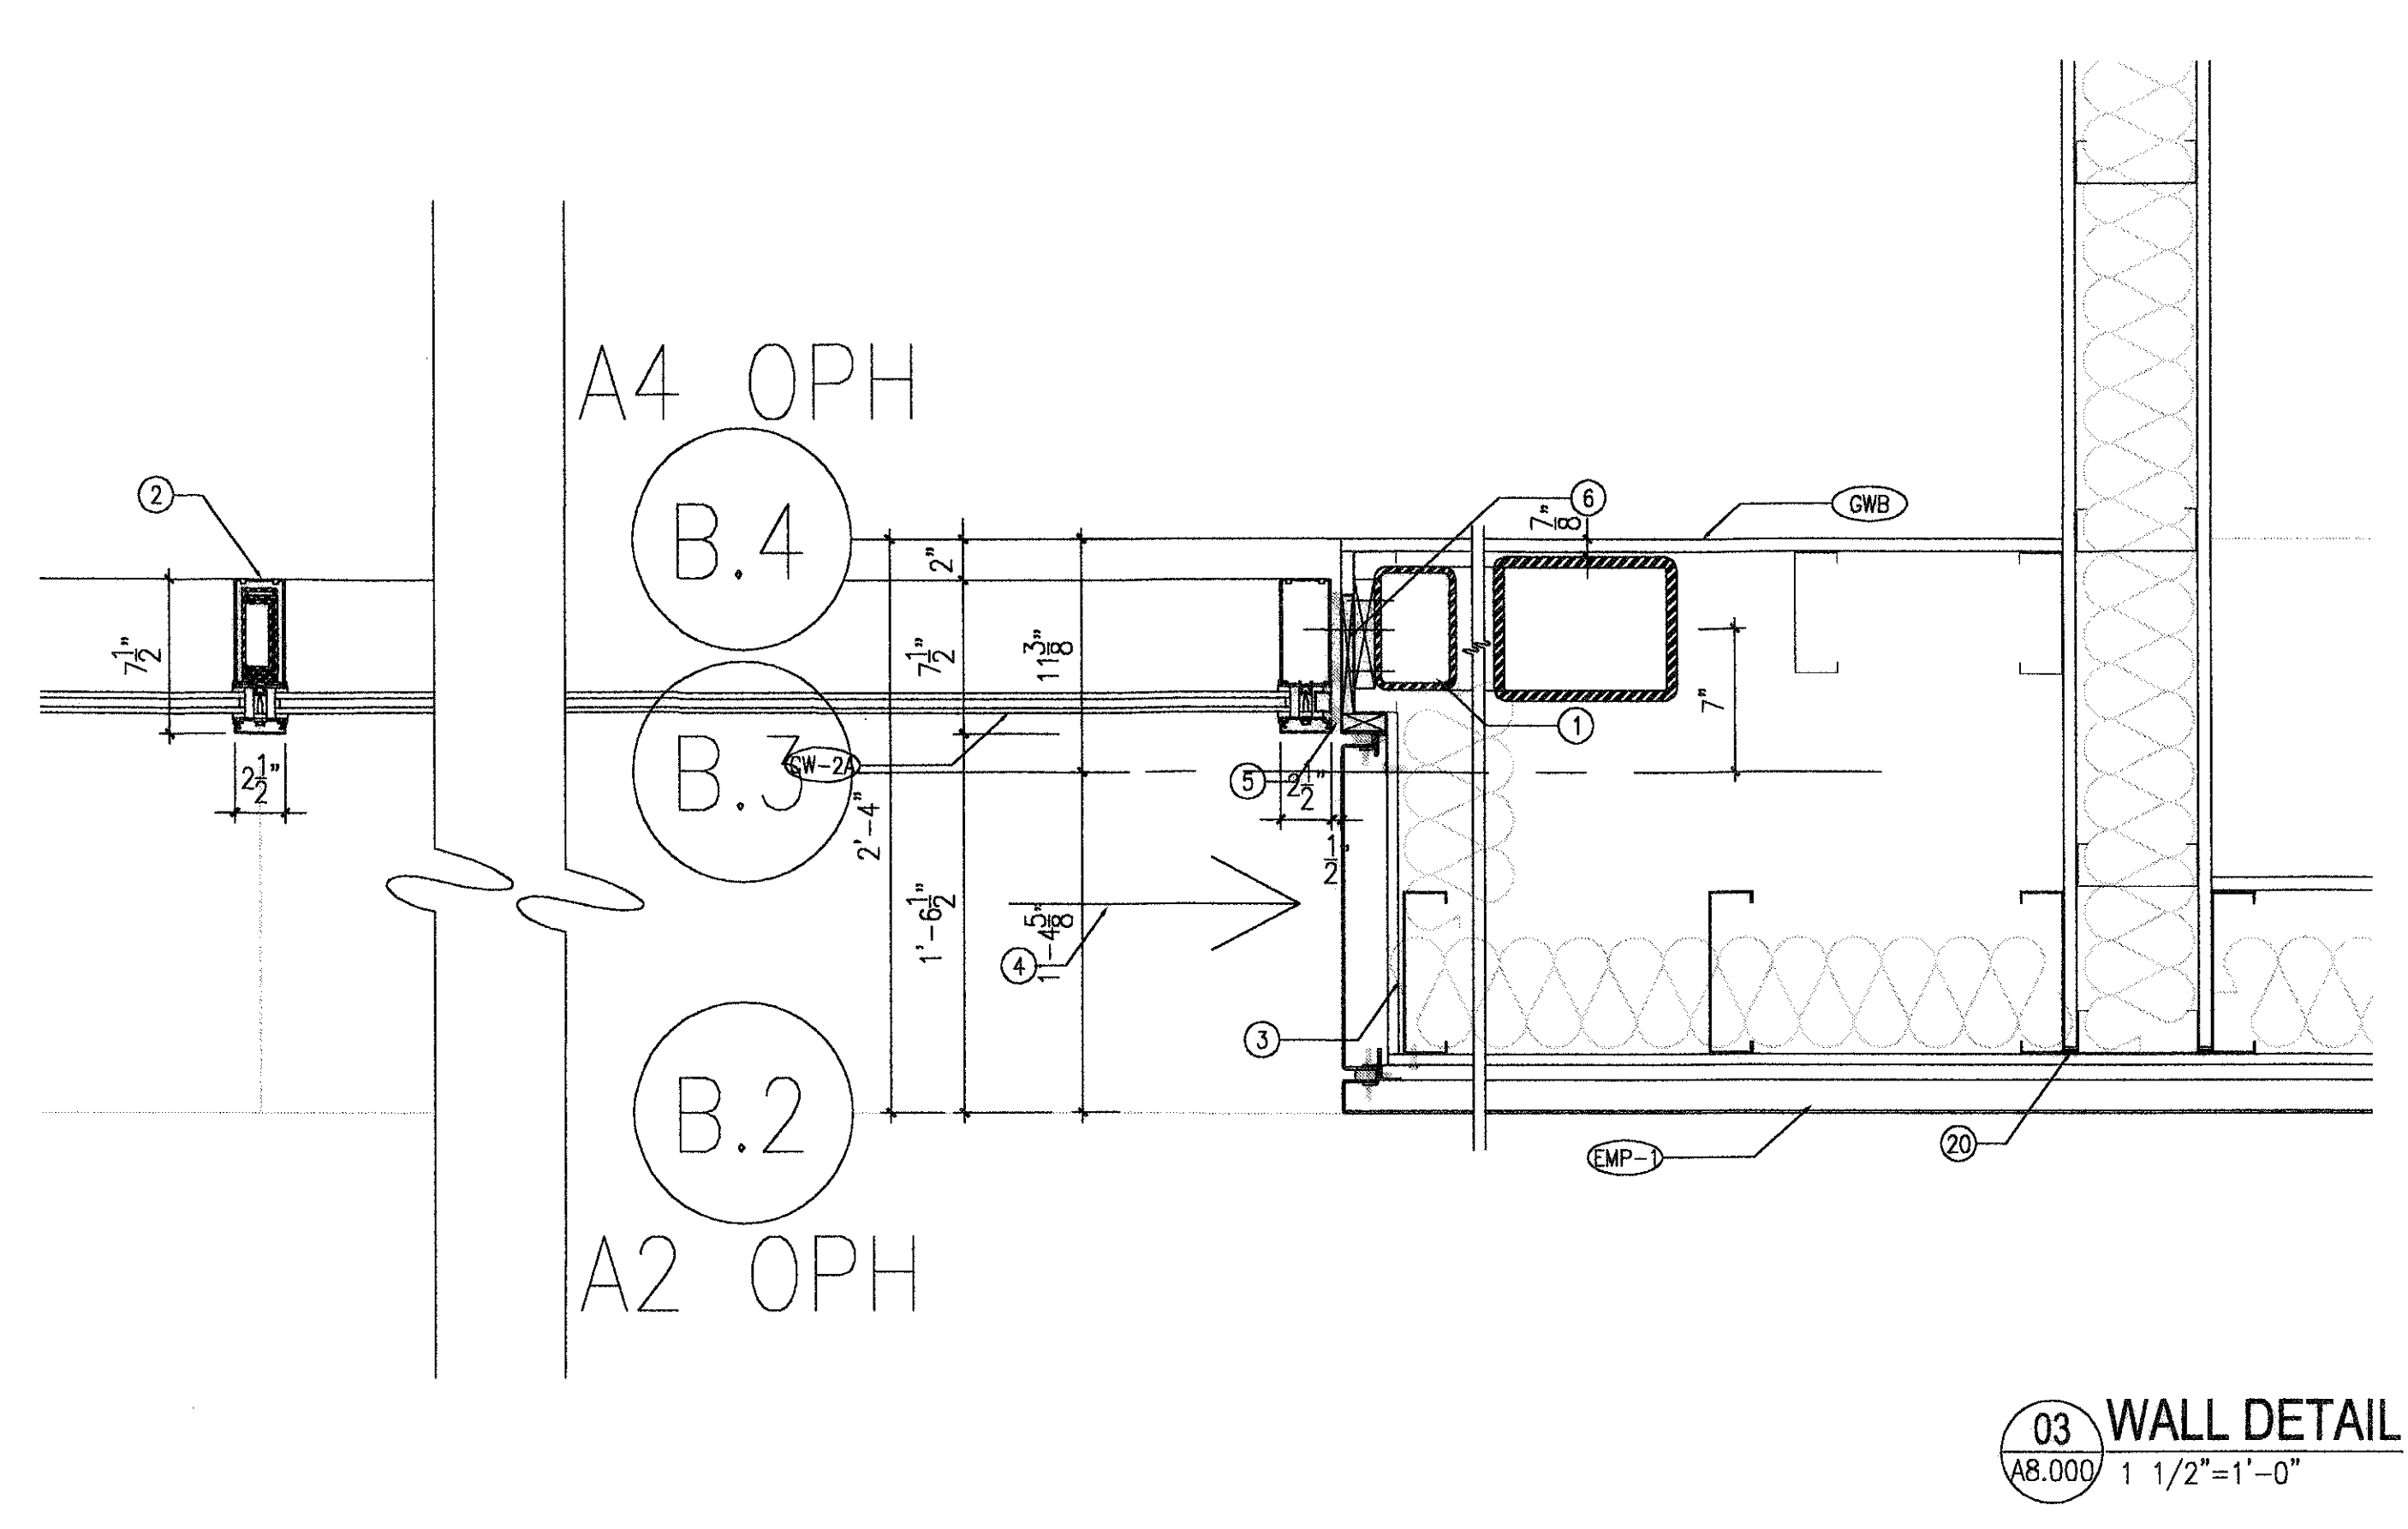


03 WALL DETAIL  
 AB.000 1 1/2"=1'-0"

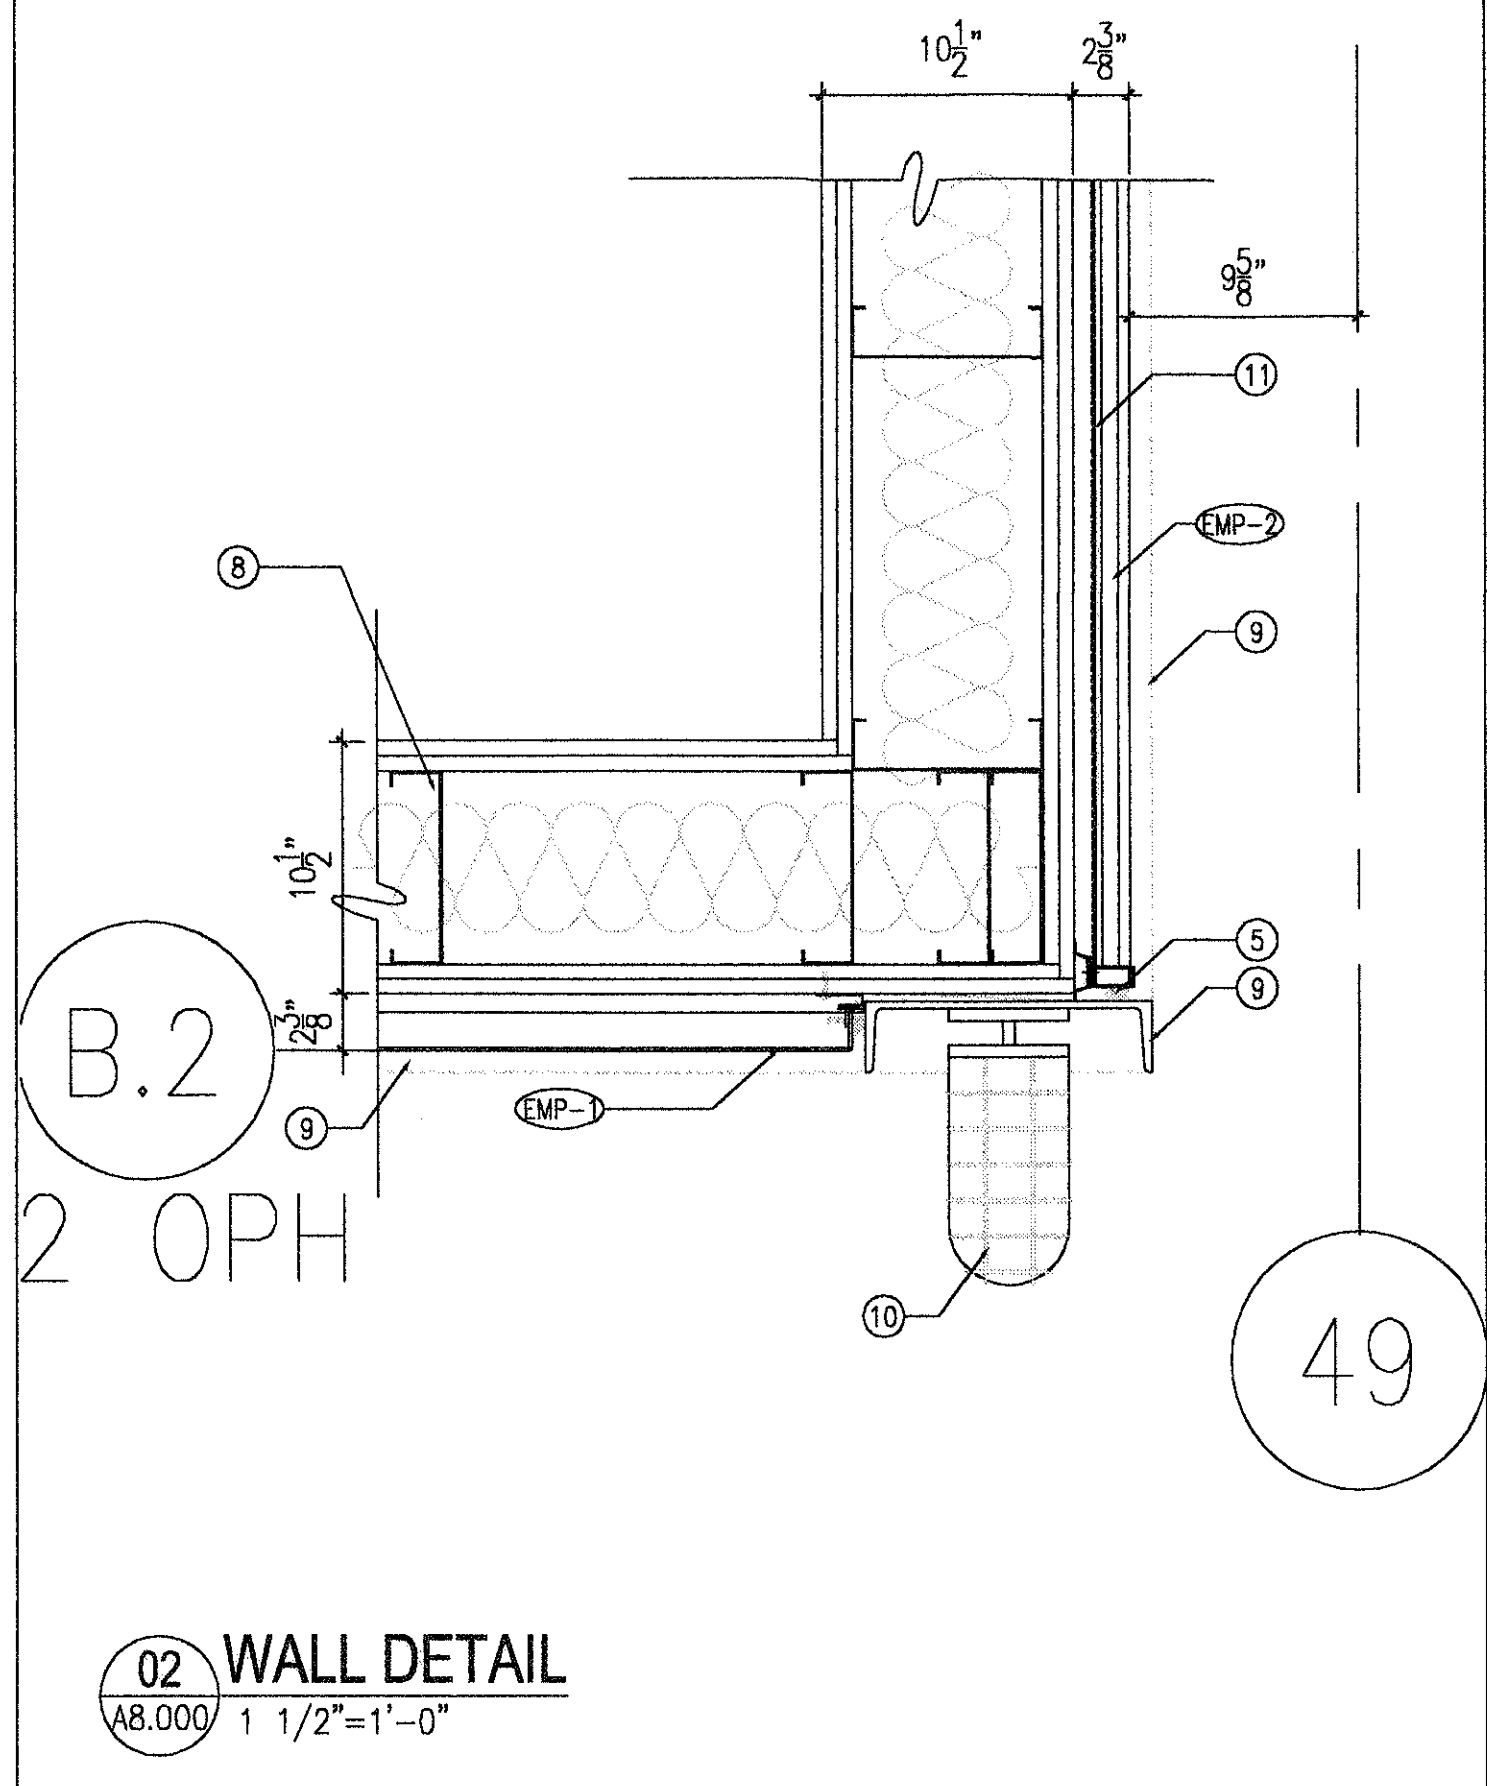


02 WALL DETAIL  
 AB.000 1 1/2"=1'-0"

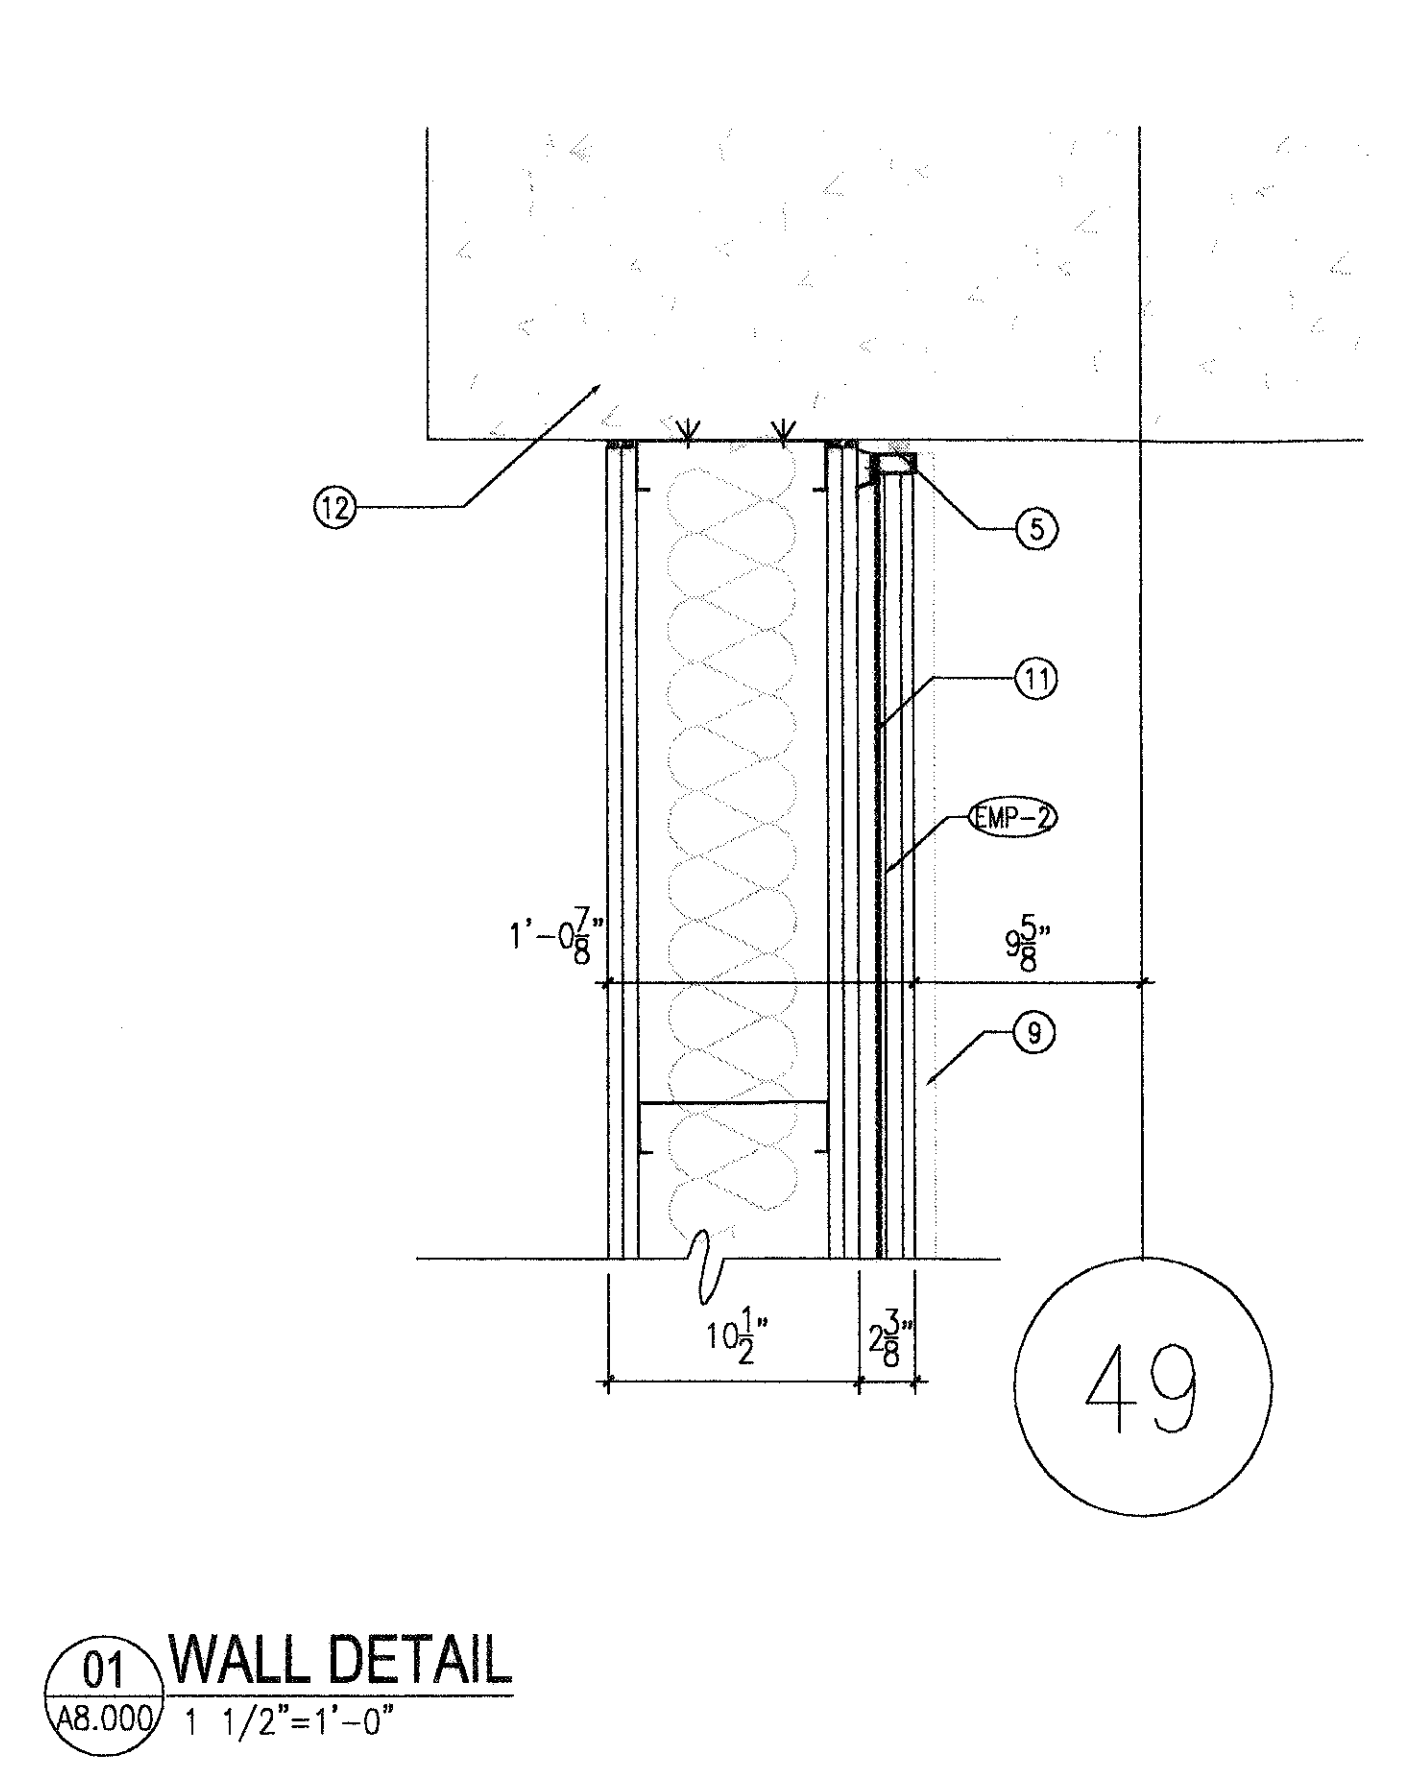


01 WALL DETAIL  
 AB.000 1 1/2"=1'-0"

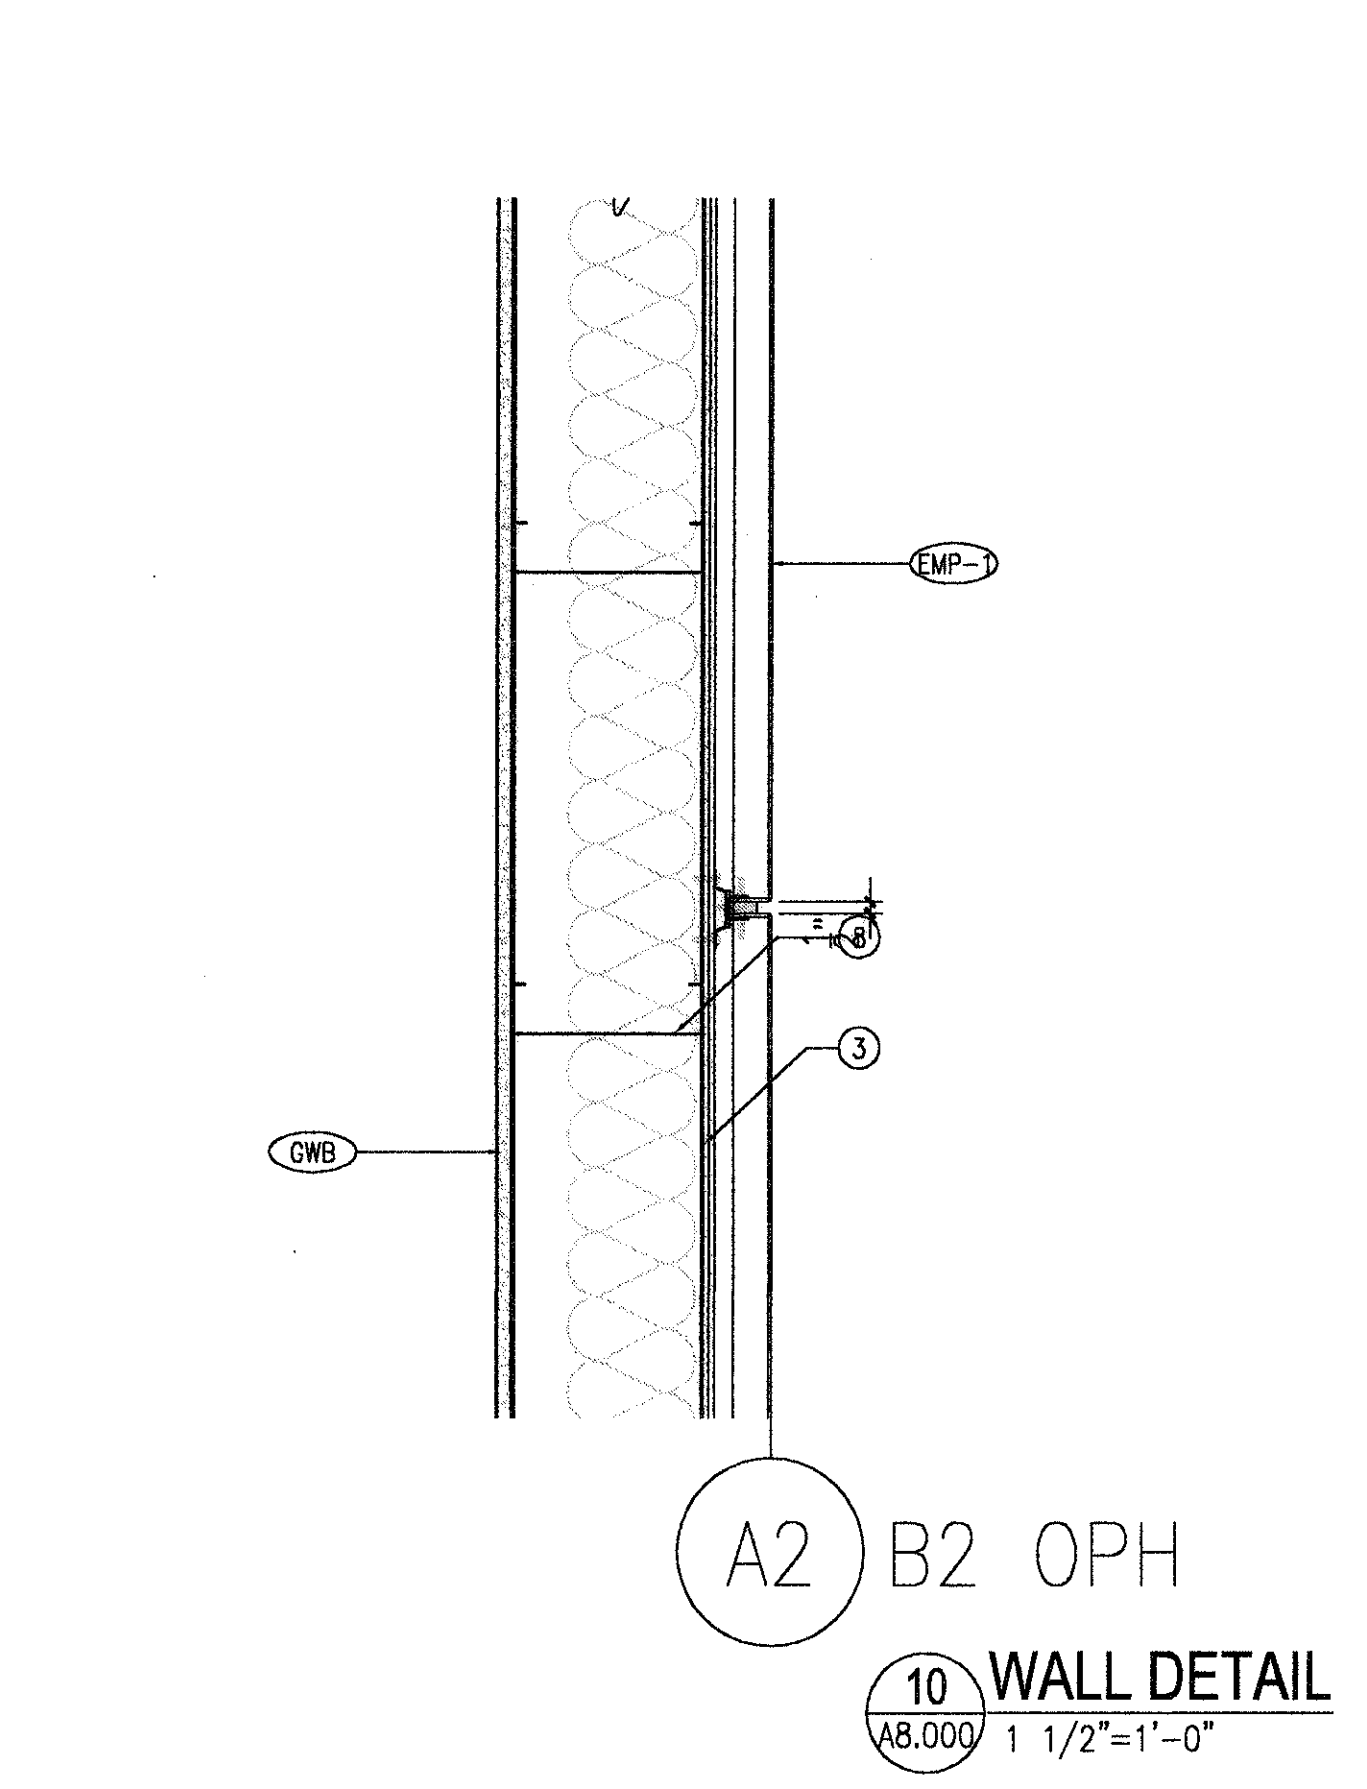


10 WALL DETAIL  
 AB.000 1 1/2"=1'-0"

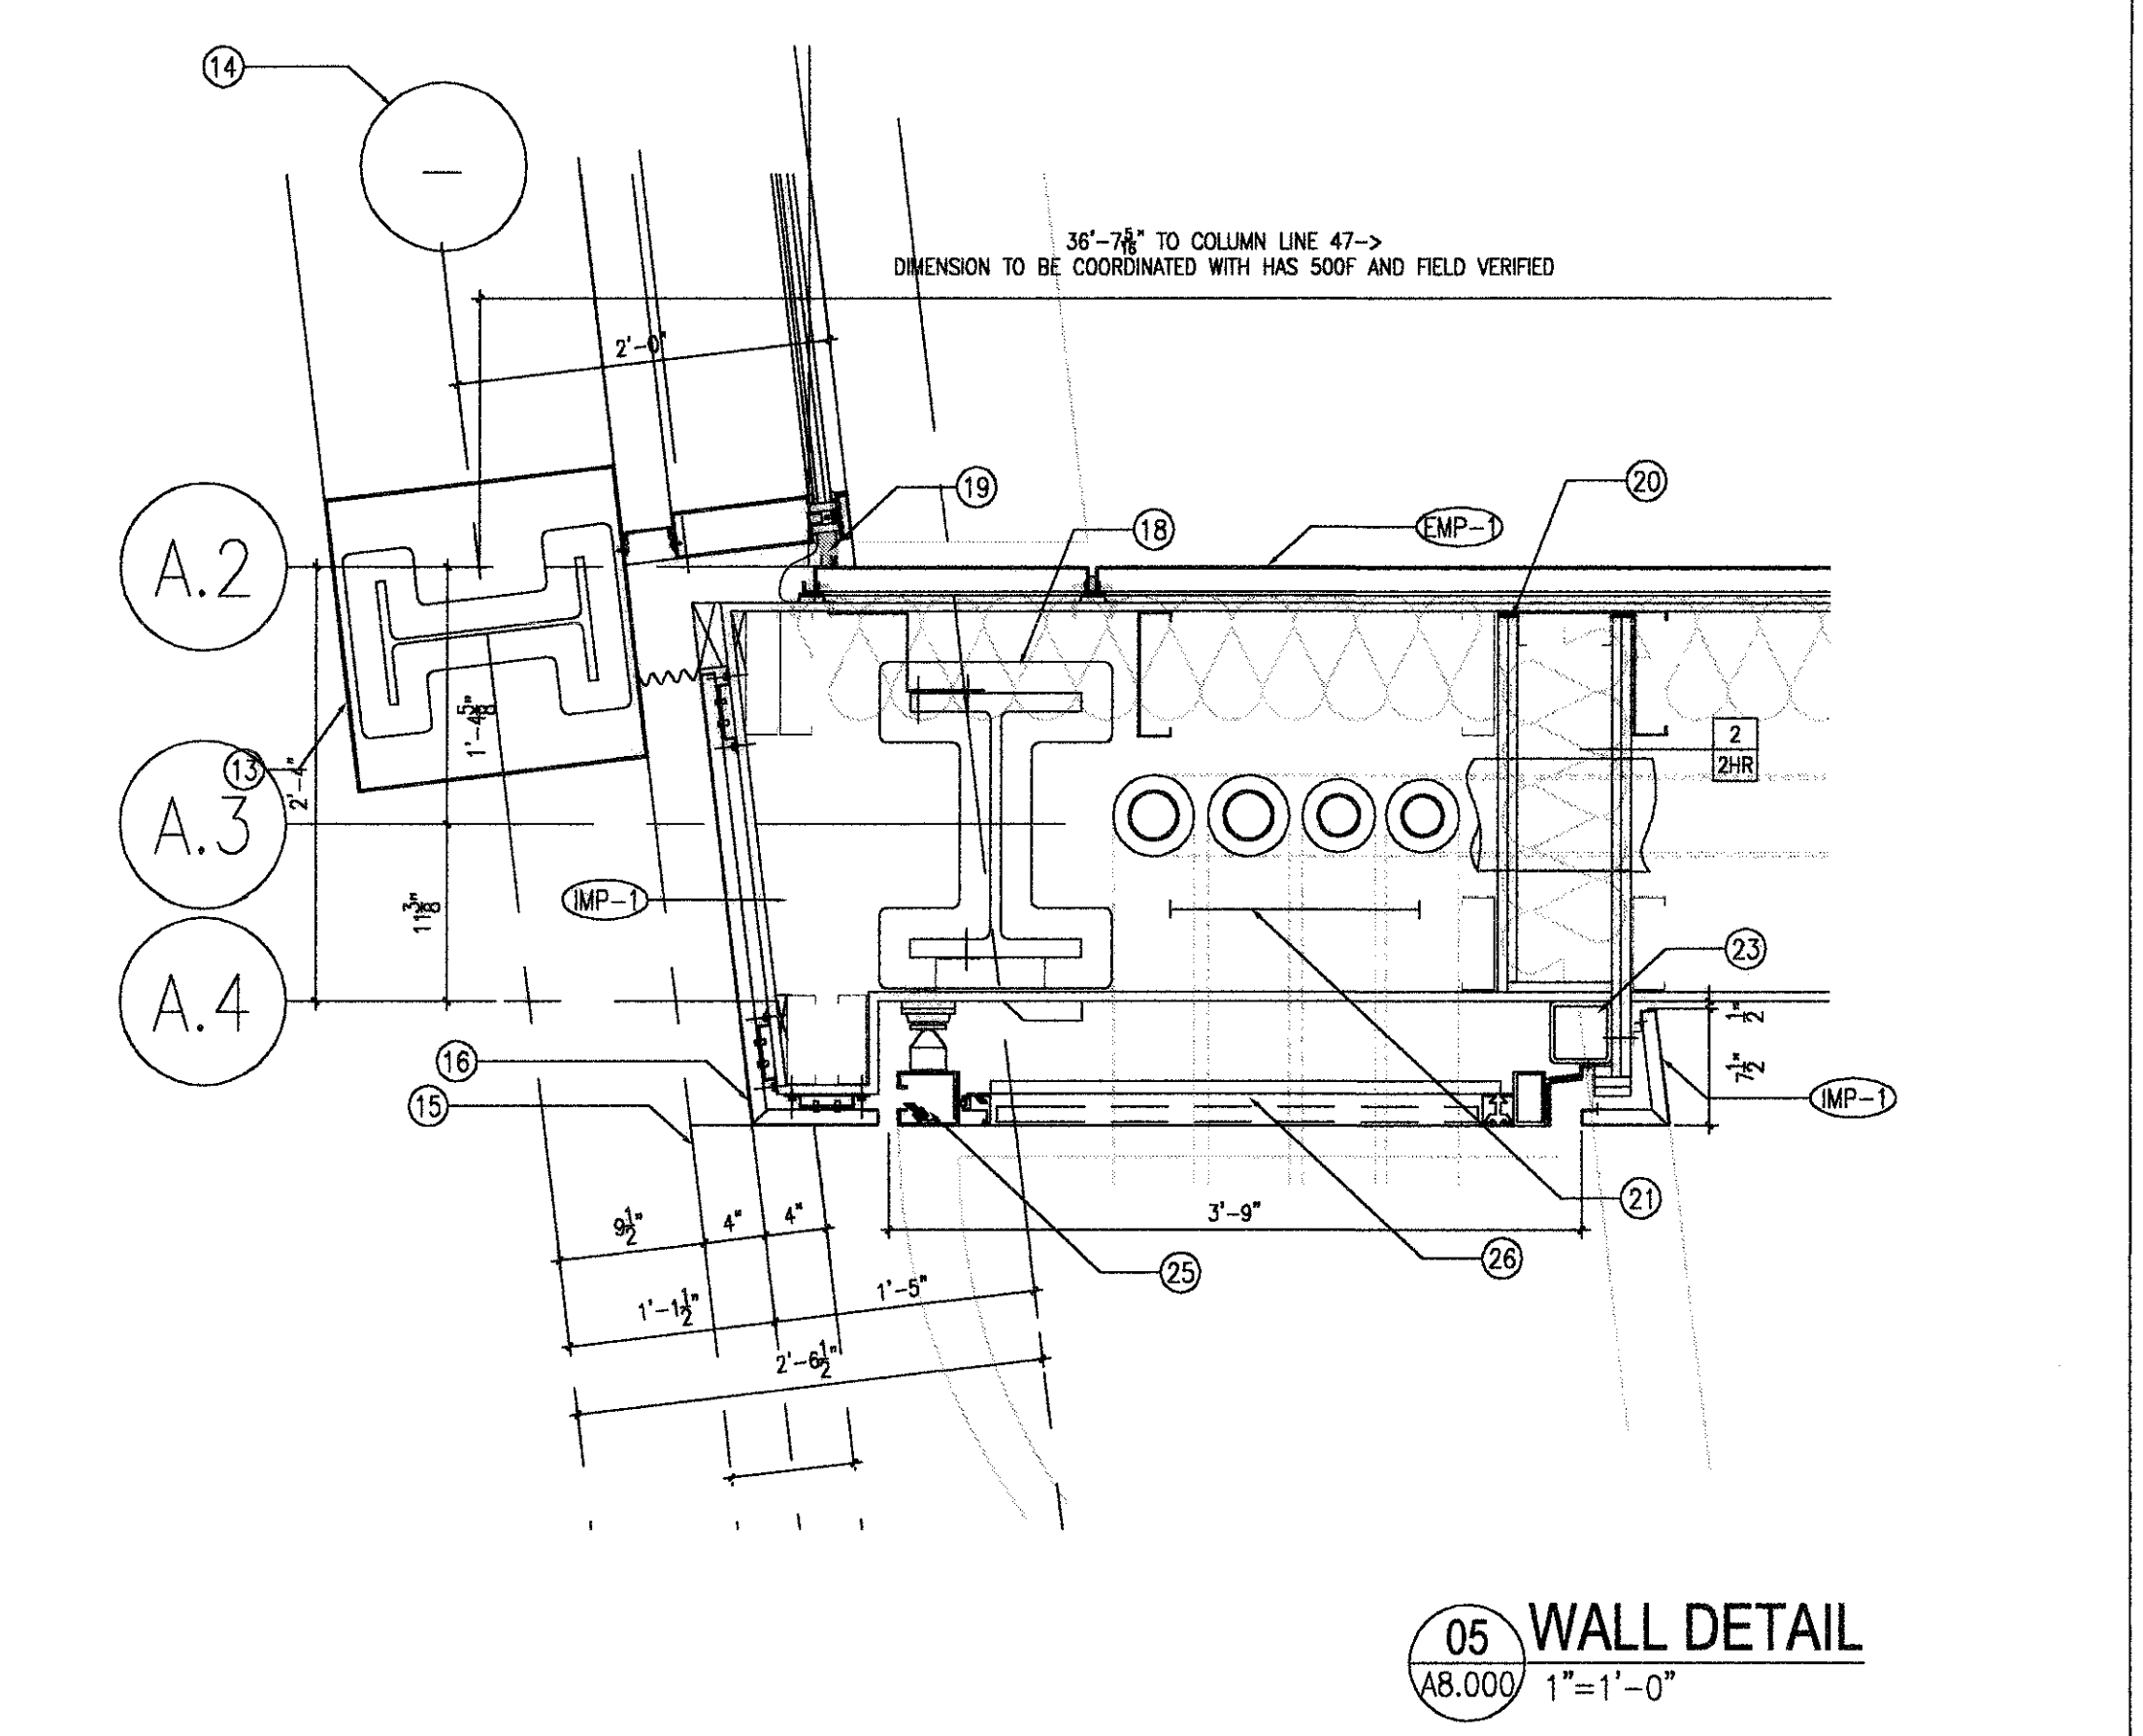


05 WALL DETAIL  
 AB.000 1"=1'-0"

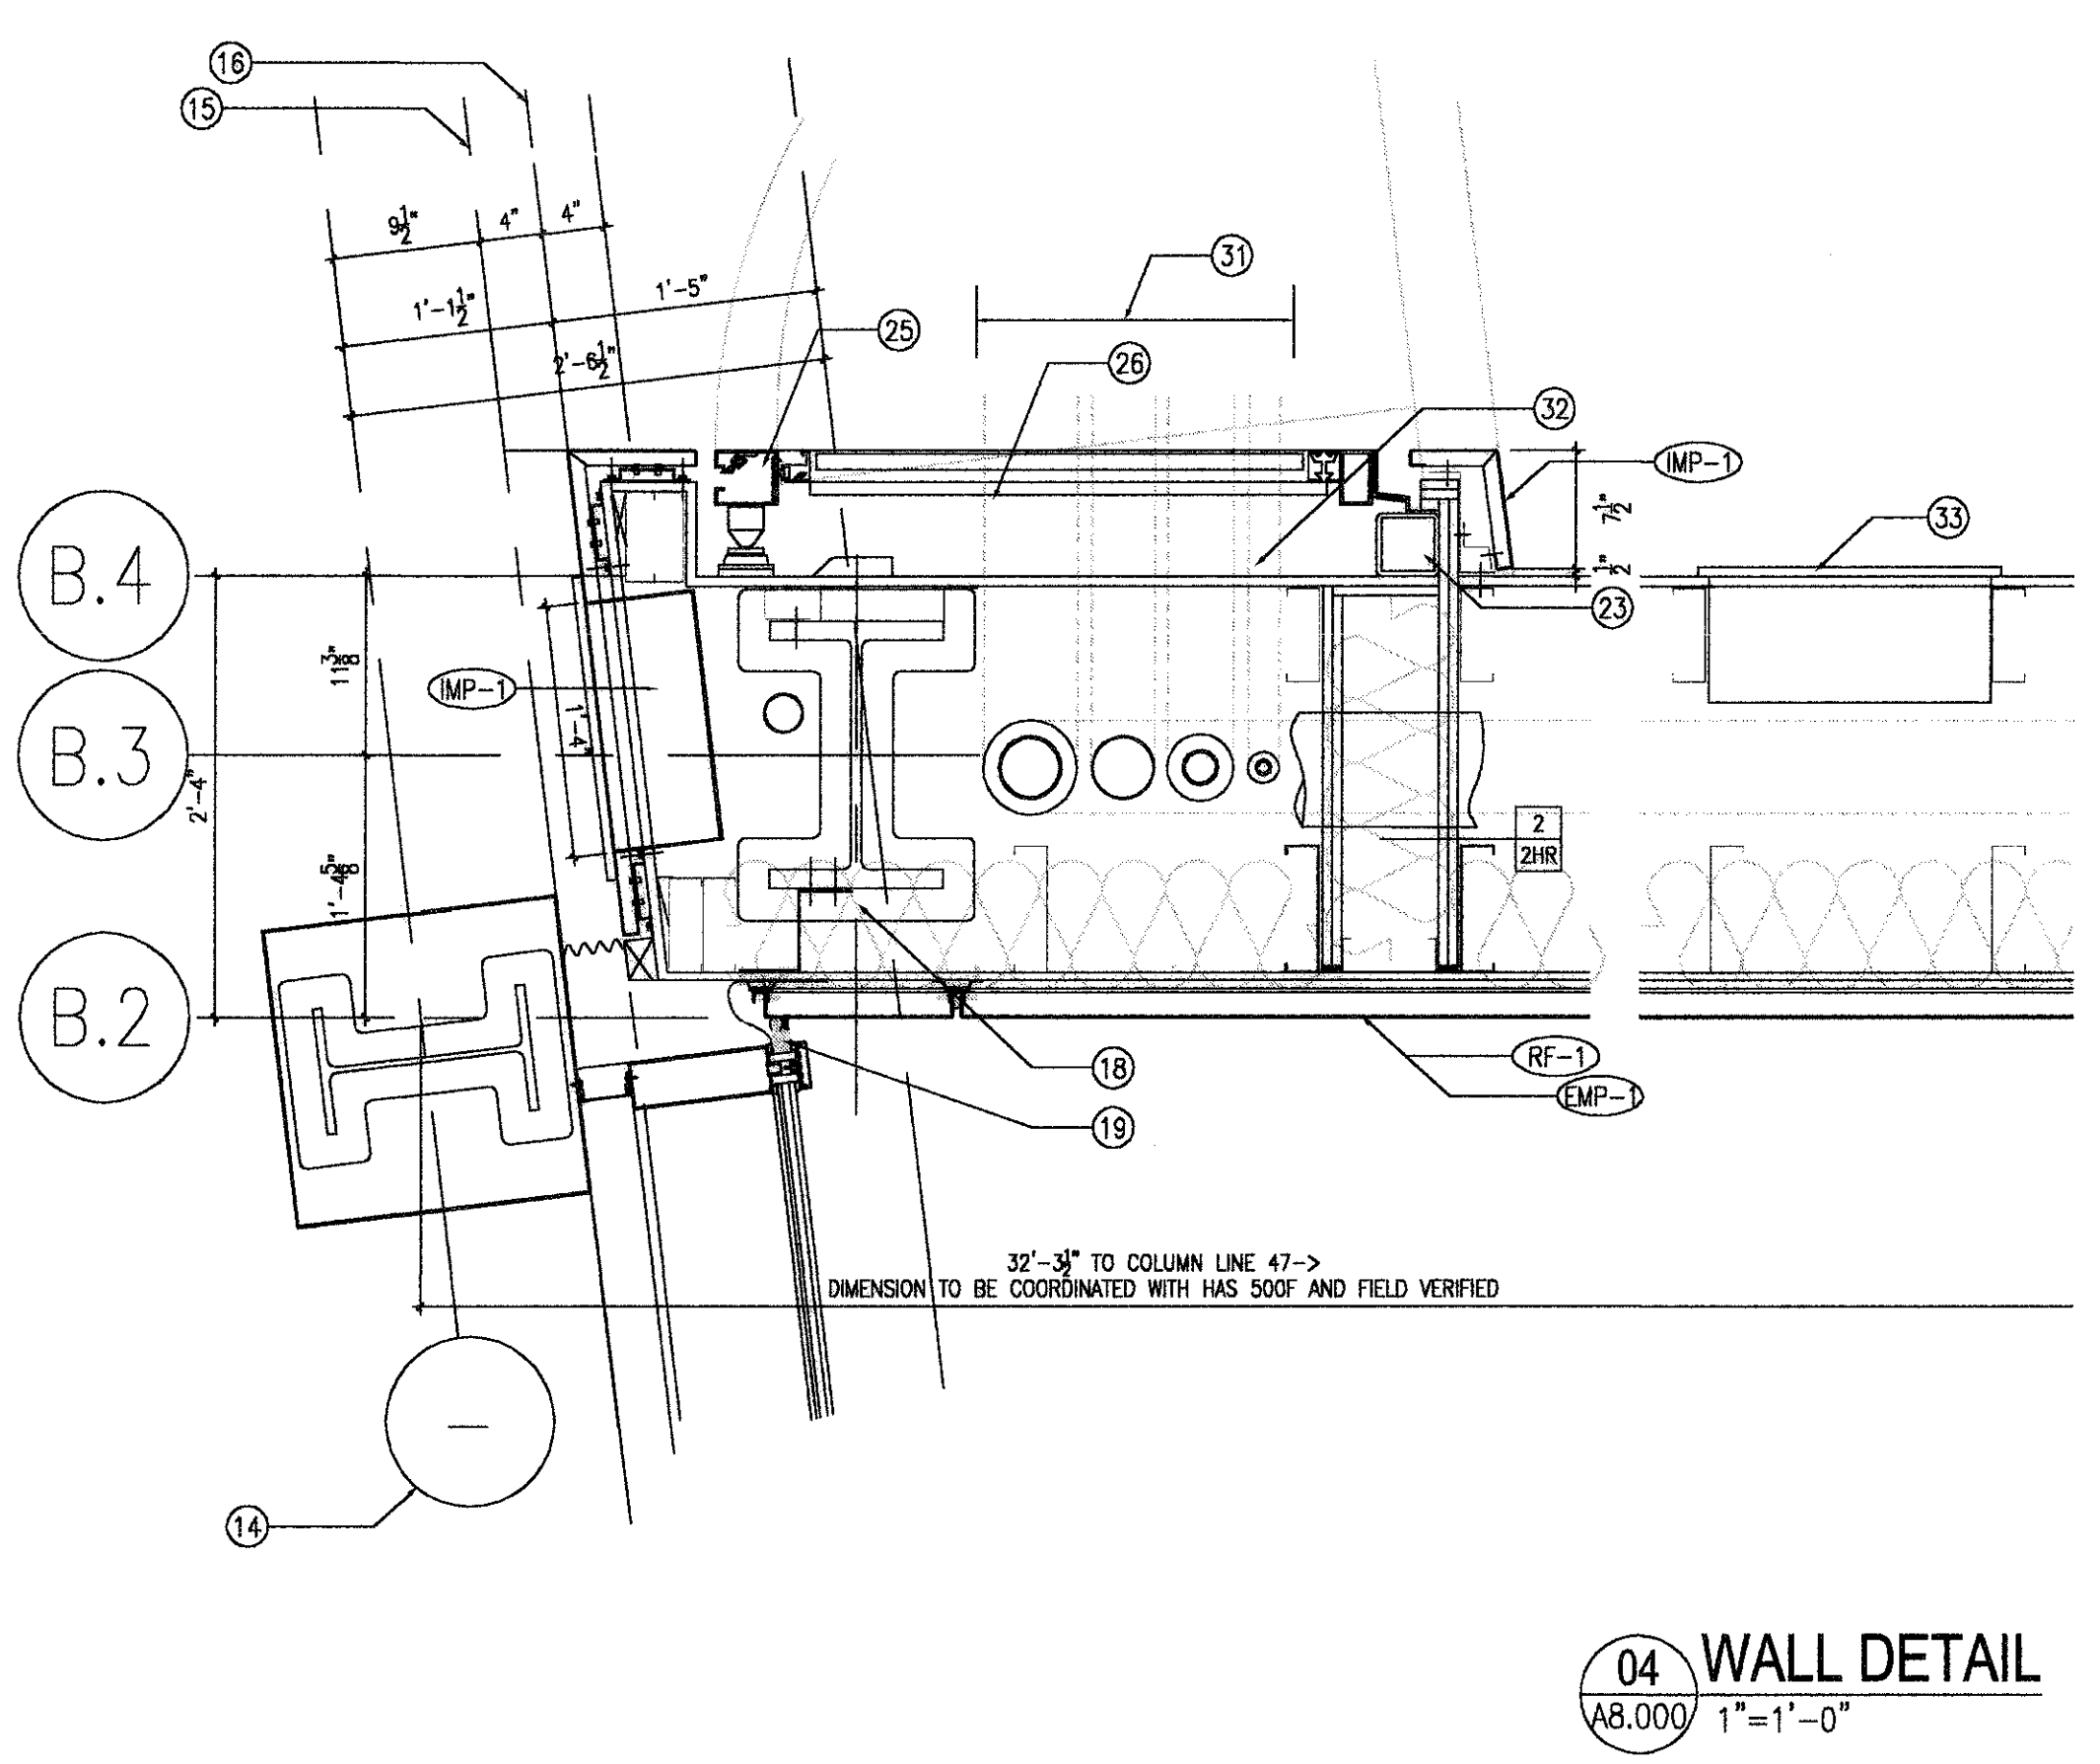


04 WALL DETAIL  
 AB.000 1"=1'-0"

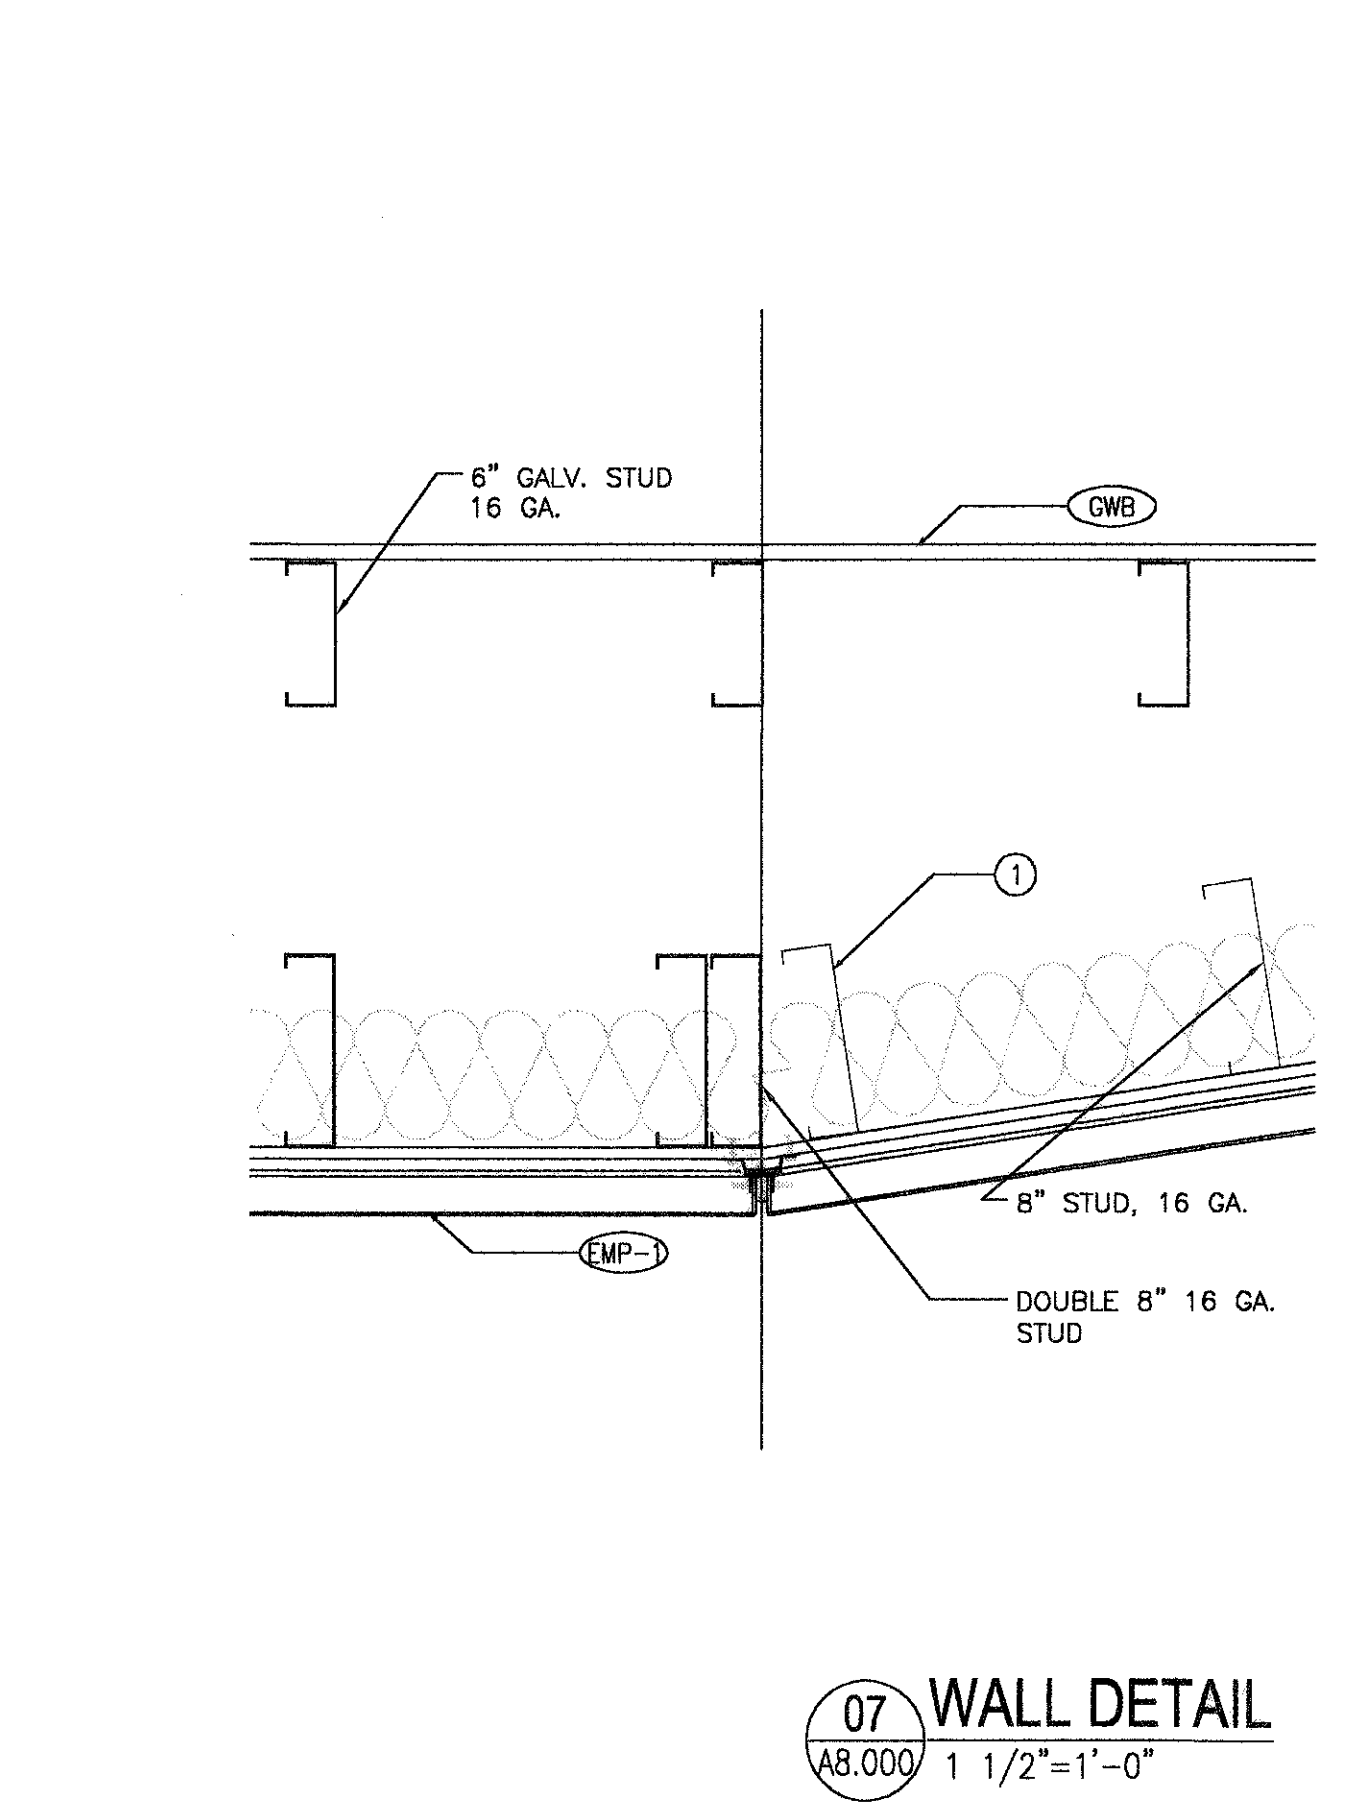


07 WALL DETAIL  
 AB.000 1 1/2"=1'-0"

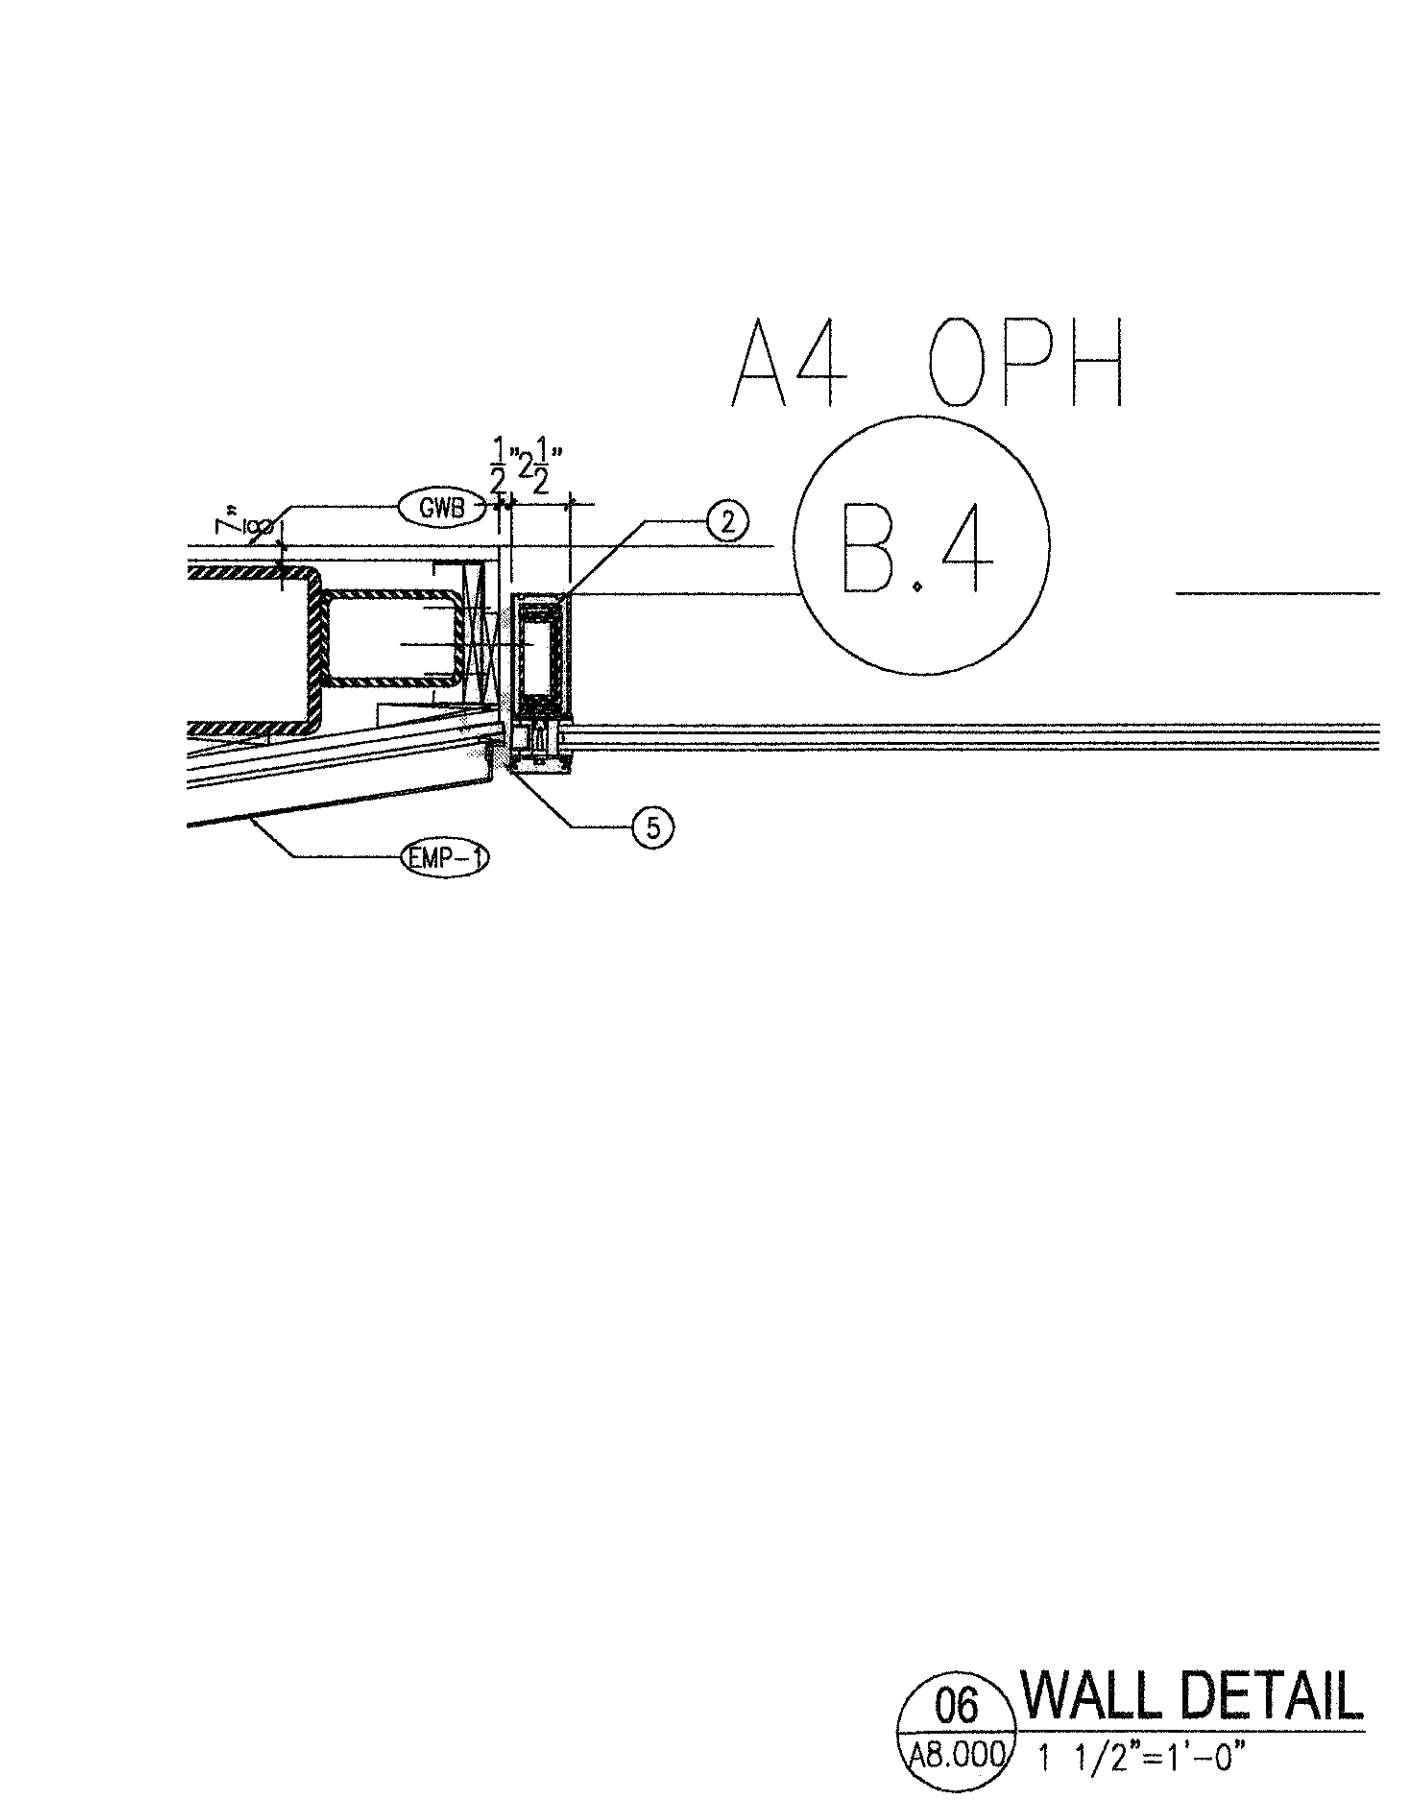

06 WALL DETAIL  
 AB.000 1 1/2"=1'-0"

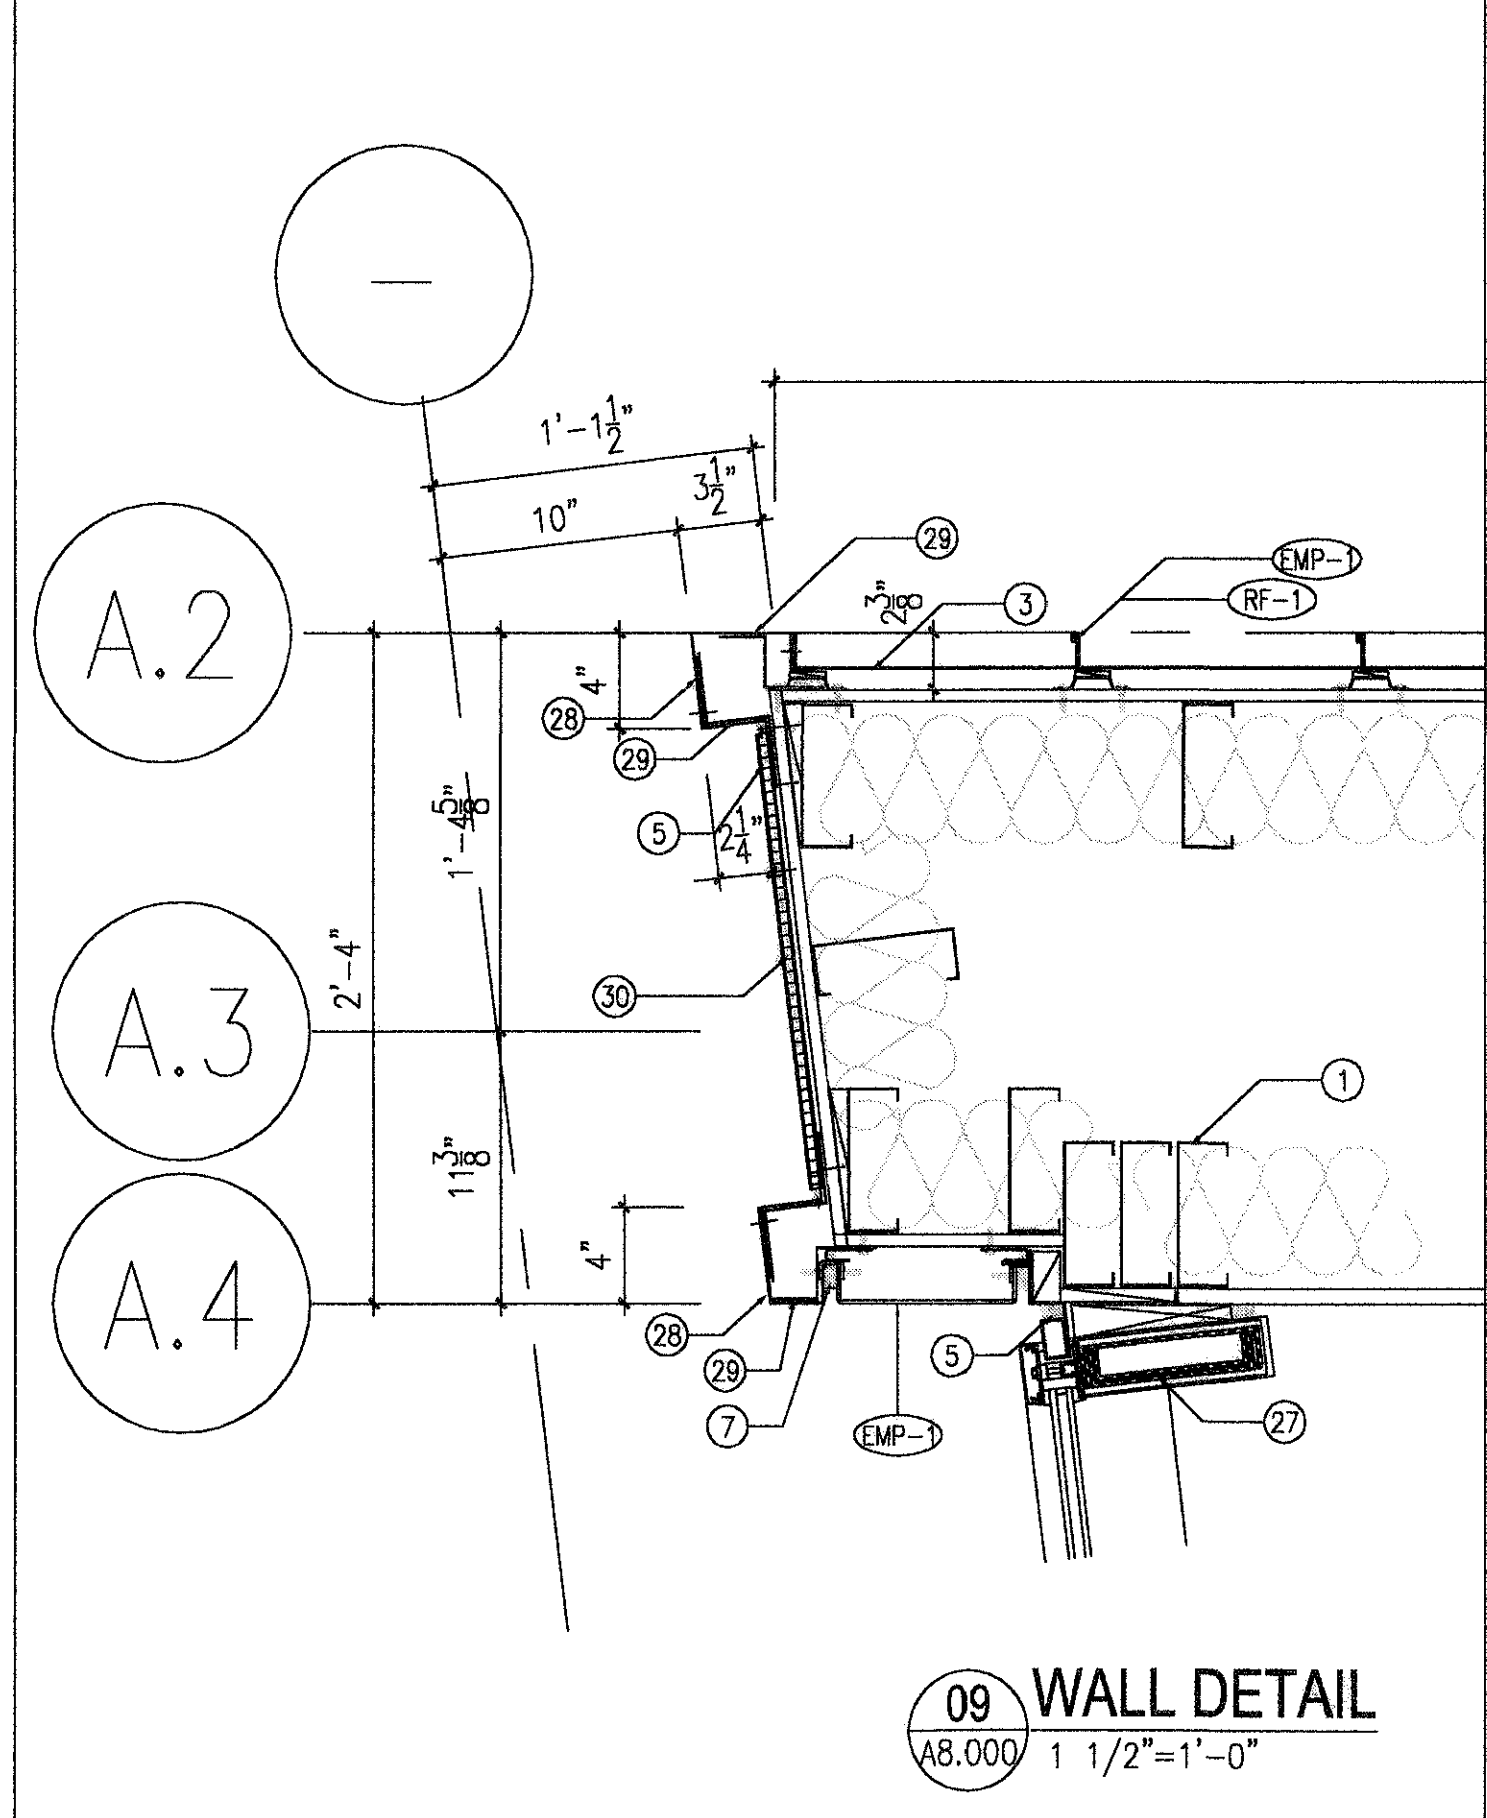

09 WALL DETAIL  
 AB.000 1 1/2"=1'-0"

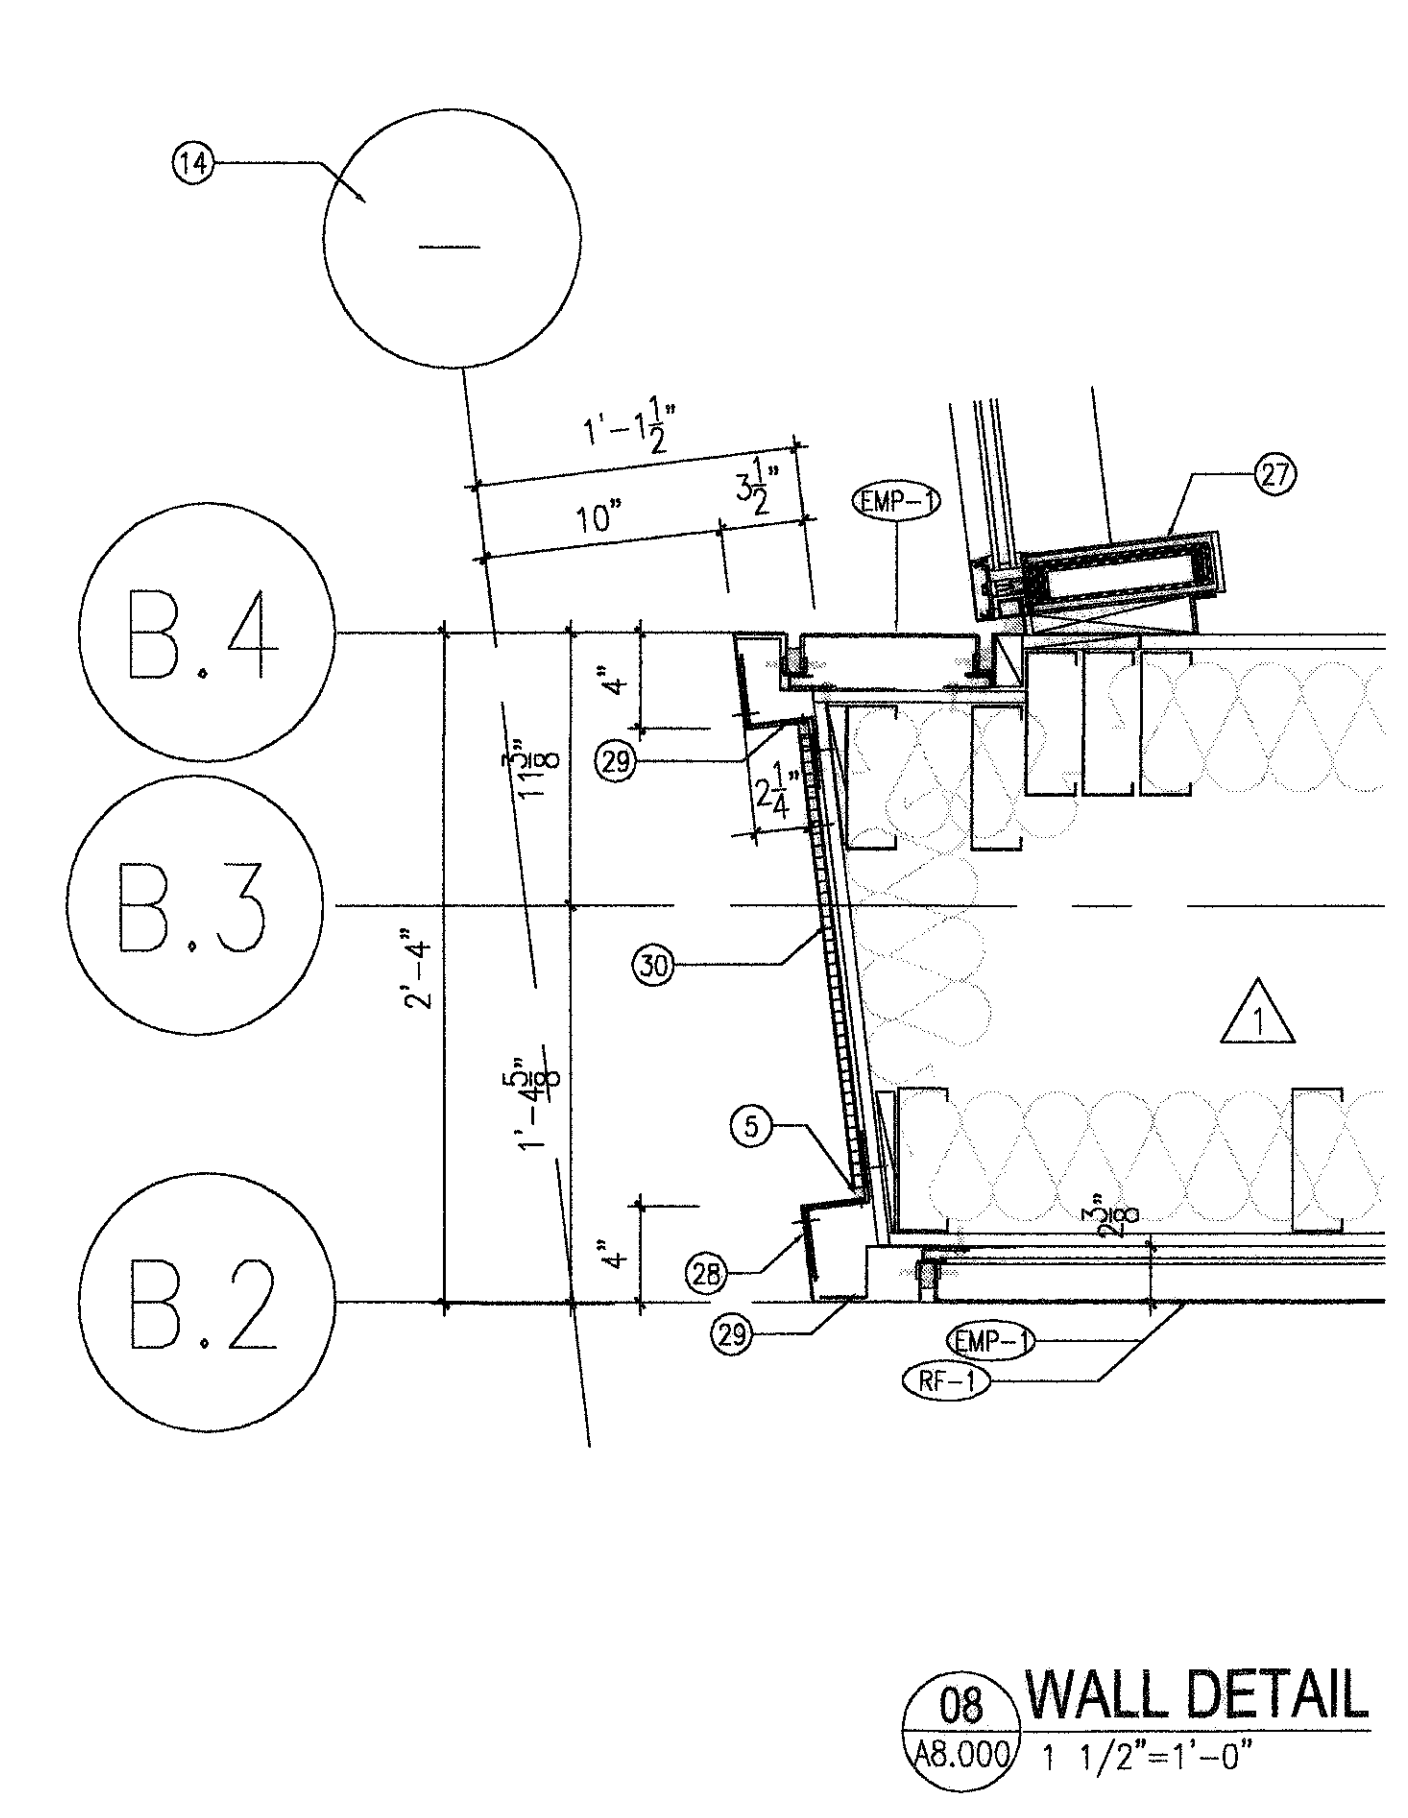

08 WALL DETAIL  
 AB.000 1 1/2"=1'-0"


PLOT DATE: 02/04/02 HAS FILE: A3363CARB000




REVISIONS		
NO.	DESCRIPTION	DATE
1	ISSUED FOR BID	10/19/01
2	ADDENDUM 1	02/01/02 SG
3	RECORD SET	05/13/05 EM

**GENERAL NOTES:**

- (CW-1A) CURTAINWALL SYSTEM TYPE 1A - RE WINDOW SCHEDULE
- (CW-5) CURTAINWALL SYSTEM TYPE 5 - RE WINDOW SCHEDULE
- (EMP-1) EXTERIOR POWDERCOATED WALL METAL PANELS - ALUMINUM PANEL 1/8" THICK - TYPE SERIES 3000 MODIFIED FROM LUNA-CLAD - COPPER SALES OR EQUAL - POWDERCOATED KYNAR 500
- (RF-1) STANDING SEAM METAL ROOF - TYPE UC3 FROM LUNA-CLAD - COPPER SALES OR EQUAL - POWDERCOATED KYNAR 500; COLOR #2 SILVER METALLIC
- (GWB) PAINT 5/8" HI-IMPACT GYPSUM BOARD ON METAL STUDS
- (EMP-2) POWDERCOATED ALUMINUM LOUVERS - WITH INSECT MESH WHEN USED BY MECHANICAL - CLOSED WITH 1/8" THK ALUMINUM SHEET WELDED CONTINUOUSLY TO FRAME WHEN NOT USED BY MECHANICAL - RE: MECHANICAL FOR OPENINGS
- (MP-1) INTERIOR STAINLESS STEEL WALL PANELS - NGAGE SYSTEM BY BAKER METAL PRODUCTS INC. OR EQUAL - 1/16" THK MIN -
- (CW-3) CURTAIN WALL SYSTEMS TYPE 3

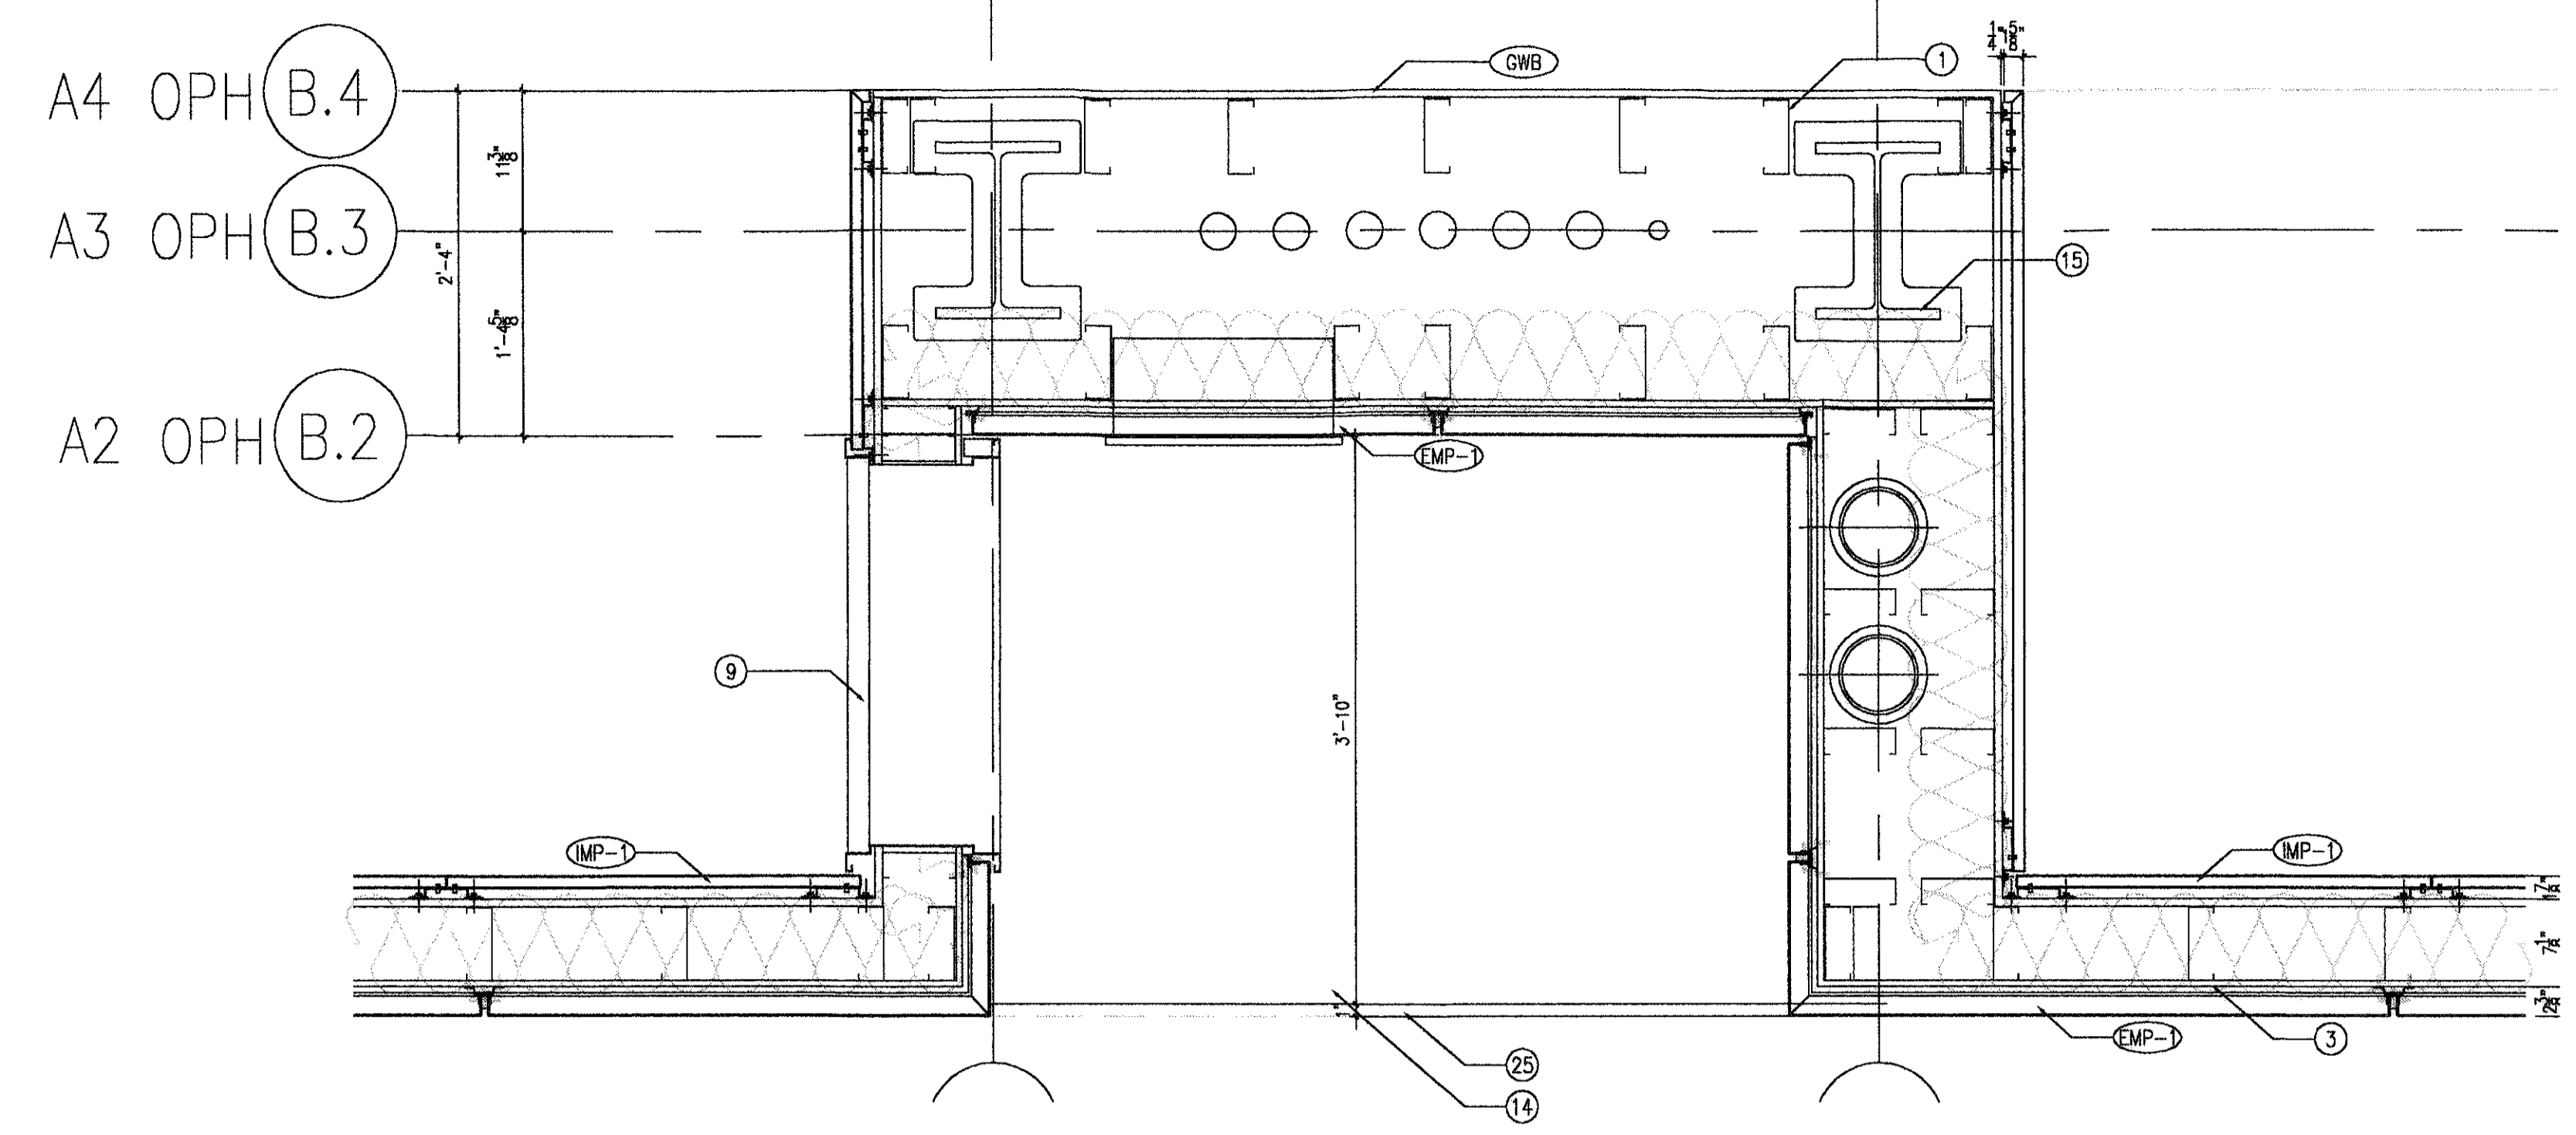


**02 WALL DETAIL**  
 A8.010 1"=1'-0"

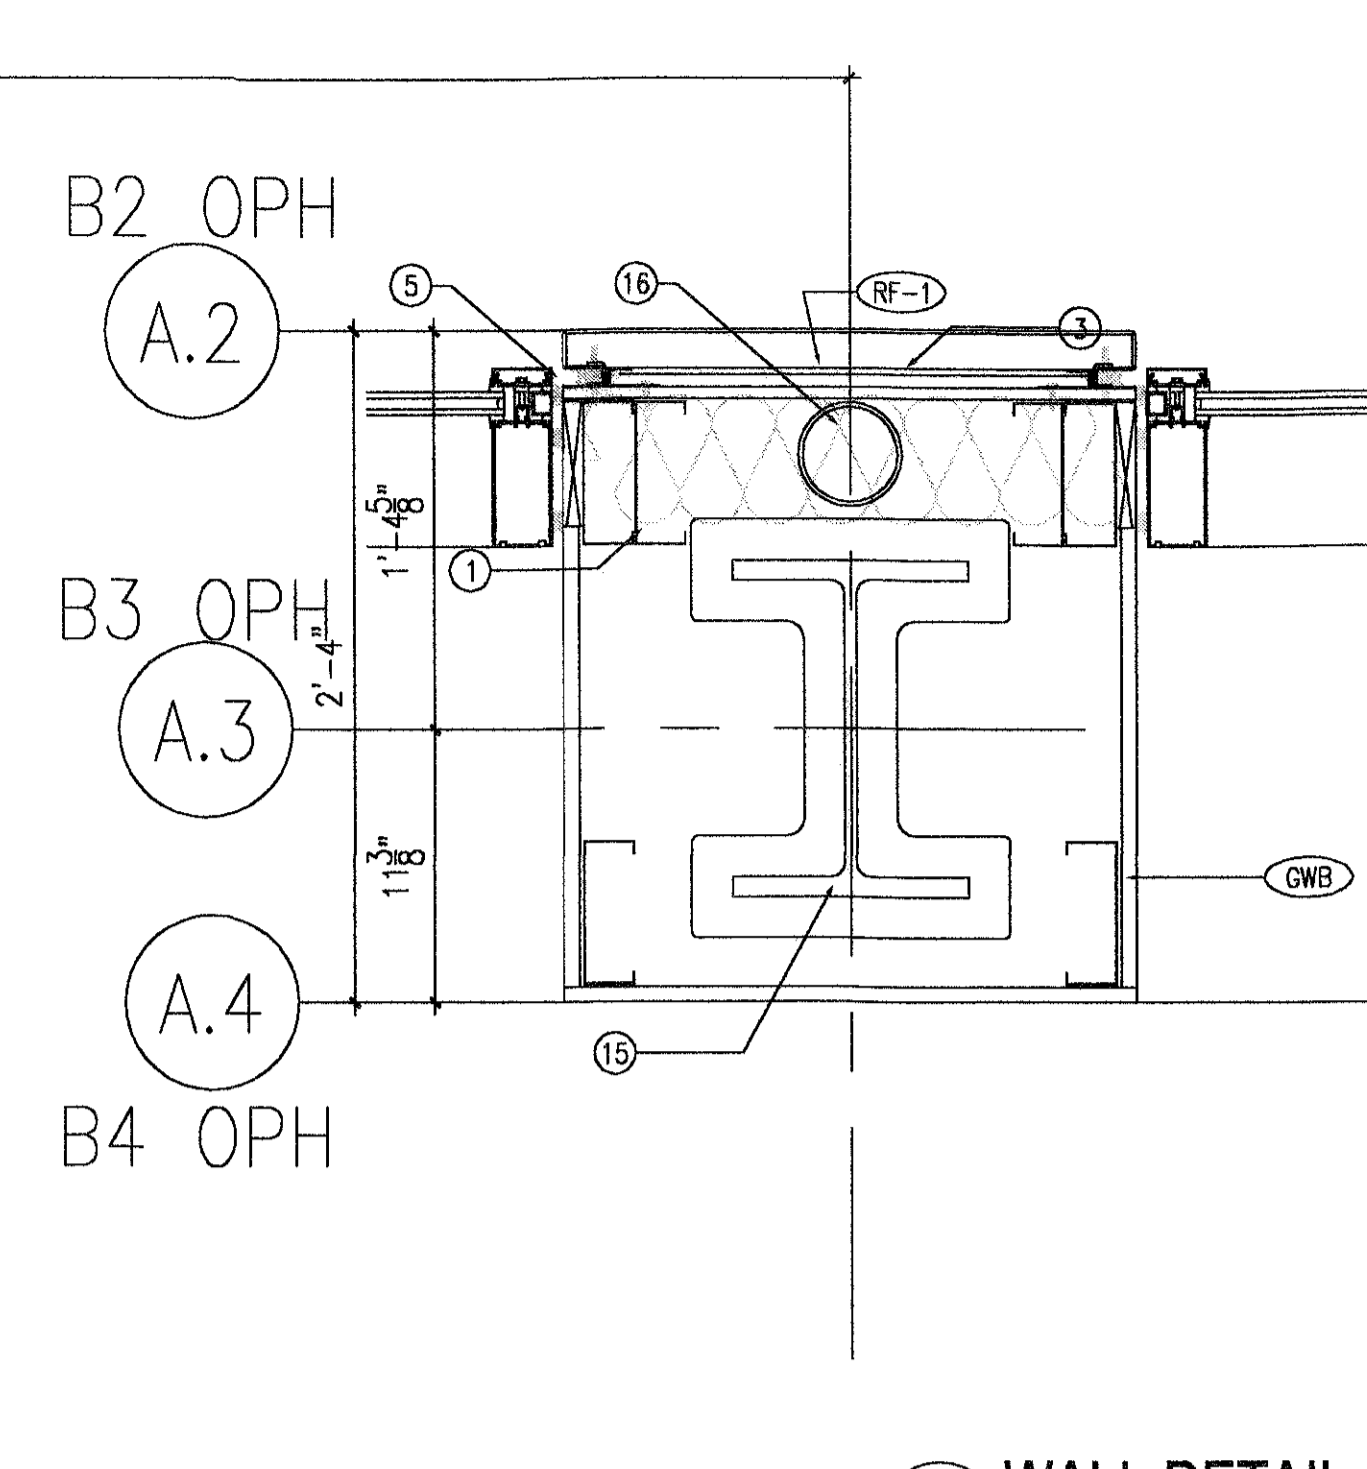


**01 WALL DETAIL**  
 A8.010 1 1/2"=1'-0"

**KEYED NOTES:**


- 1 METAL STUD CONSTRUCTION W/ BATT INSULATION
- 2 2 1/2" x 7 1/2" ALUMINUM VERTICAL MULLION - POWDERCOATED - STEEL REINFORCING AS REQUIRED FOR WIND LOADS
- 3 1/2" SHEATHING
- 4 A/C DUCT - RE MECHANICAL
- 5 SEALANT & BACKER ROD
- 6 SHIM
- 7 PRECOMPRESSED EXPANDING FOAM SEALANT TYPE COLORSEAL BY EMSEAL OR EQUAL. STANDARD COLOR TO MATCH COLOR OF METAL PANELS
- 8 NOT USED
- 9 SCHED. DOOR & FRAME
- 10 SSTL HANDRAIL
- 11 A/C DUCT CONNECTION @ PLATFORM
- 12 FAN FOR STAIRWAY VENTILATION - RE MECHANICAL
- 13 ALUMINUM LOUVERS - TYPE EMP-2 - POWDERCOATED
- 14 EDGE OF CONCRETE SLAB
- 15 STEEL COLUMN WITH 3 HR FIREPROOFING
- 16 DOWNSPOUT - RE PLUMBING DWG.
- 17 SHEET METAL - POWDERCOATED
- 18 STEEL Z @ ANGLE - CURVED @ ROOF - 1/8" THK.
- 19 HONEYCOMBED ALUMINUM PANEL - 1/2" THK - POWDERCOATED
- 20 CUSTOM EXTRUDED MULLION @ ANGLE WITH BUTT GLAZING
- 21 GLASS - TYPE GL-4
- 22 STRUCTURAL SILICONE WEATHER SEAL
- 23 SHIM & FLASHING
- 24 CONTINUOUS STEEL PLATE - 1/2"x10" - WELD TO POST BY ANGLE - PAINT
- 25 EDGE OF SOFFIT ABOVE
- 26 6" STEEL PIPE

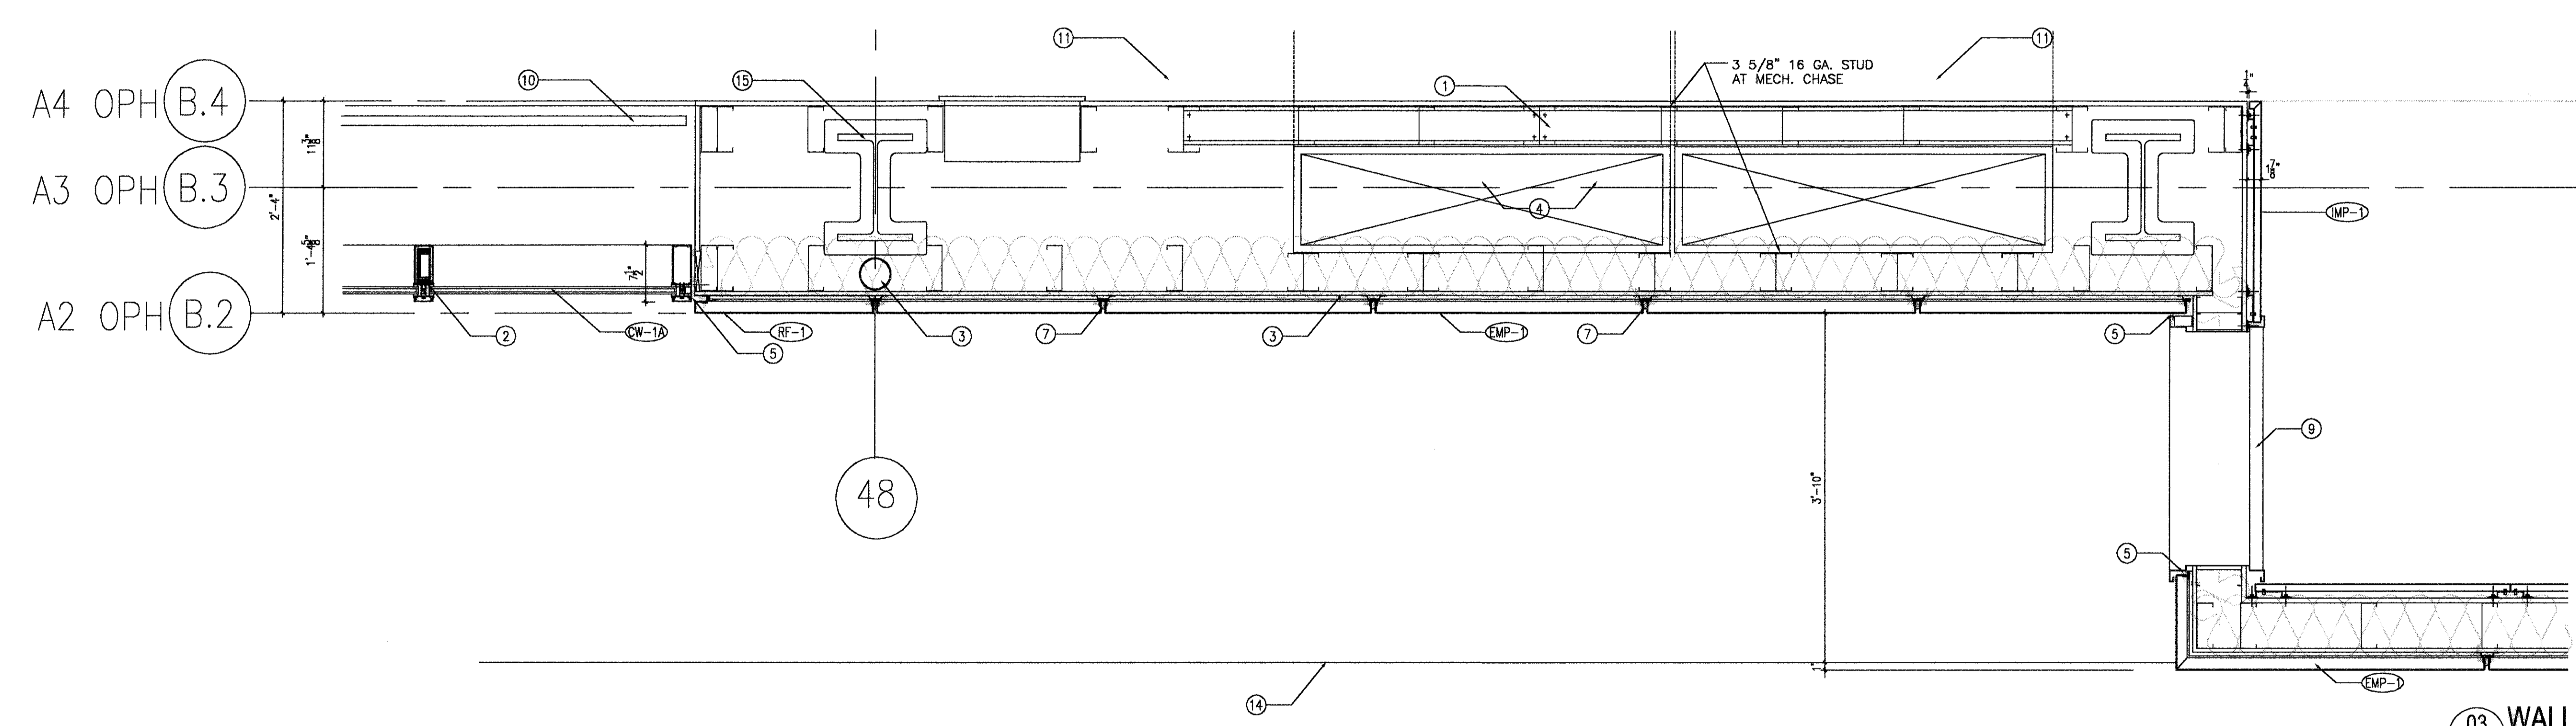


**03 WALL DETAIL**  
 A8.010 1"=1'-0"

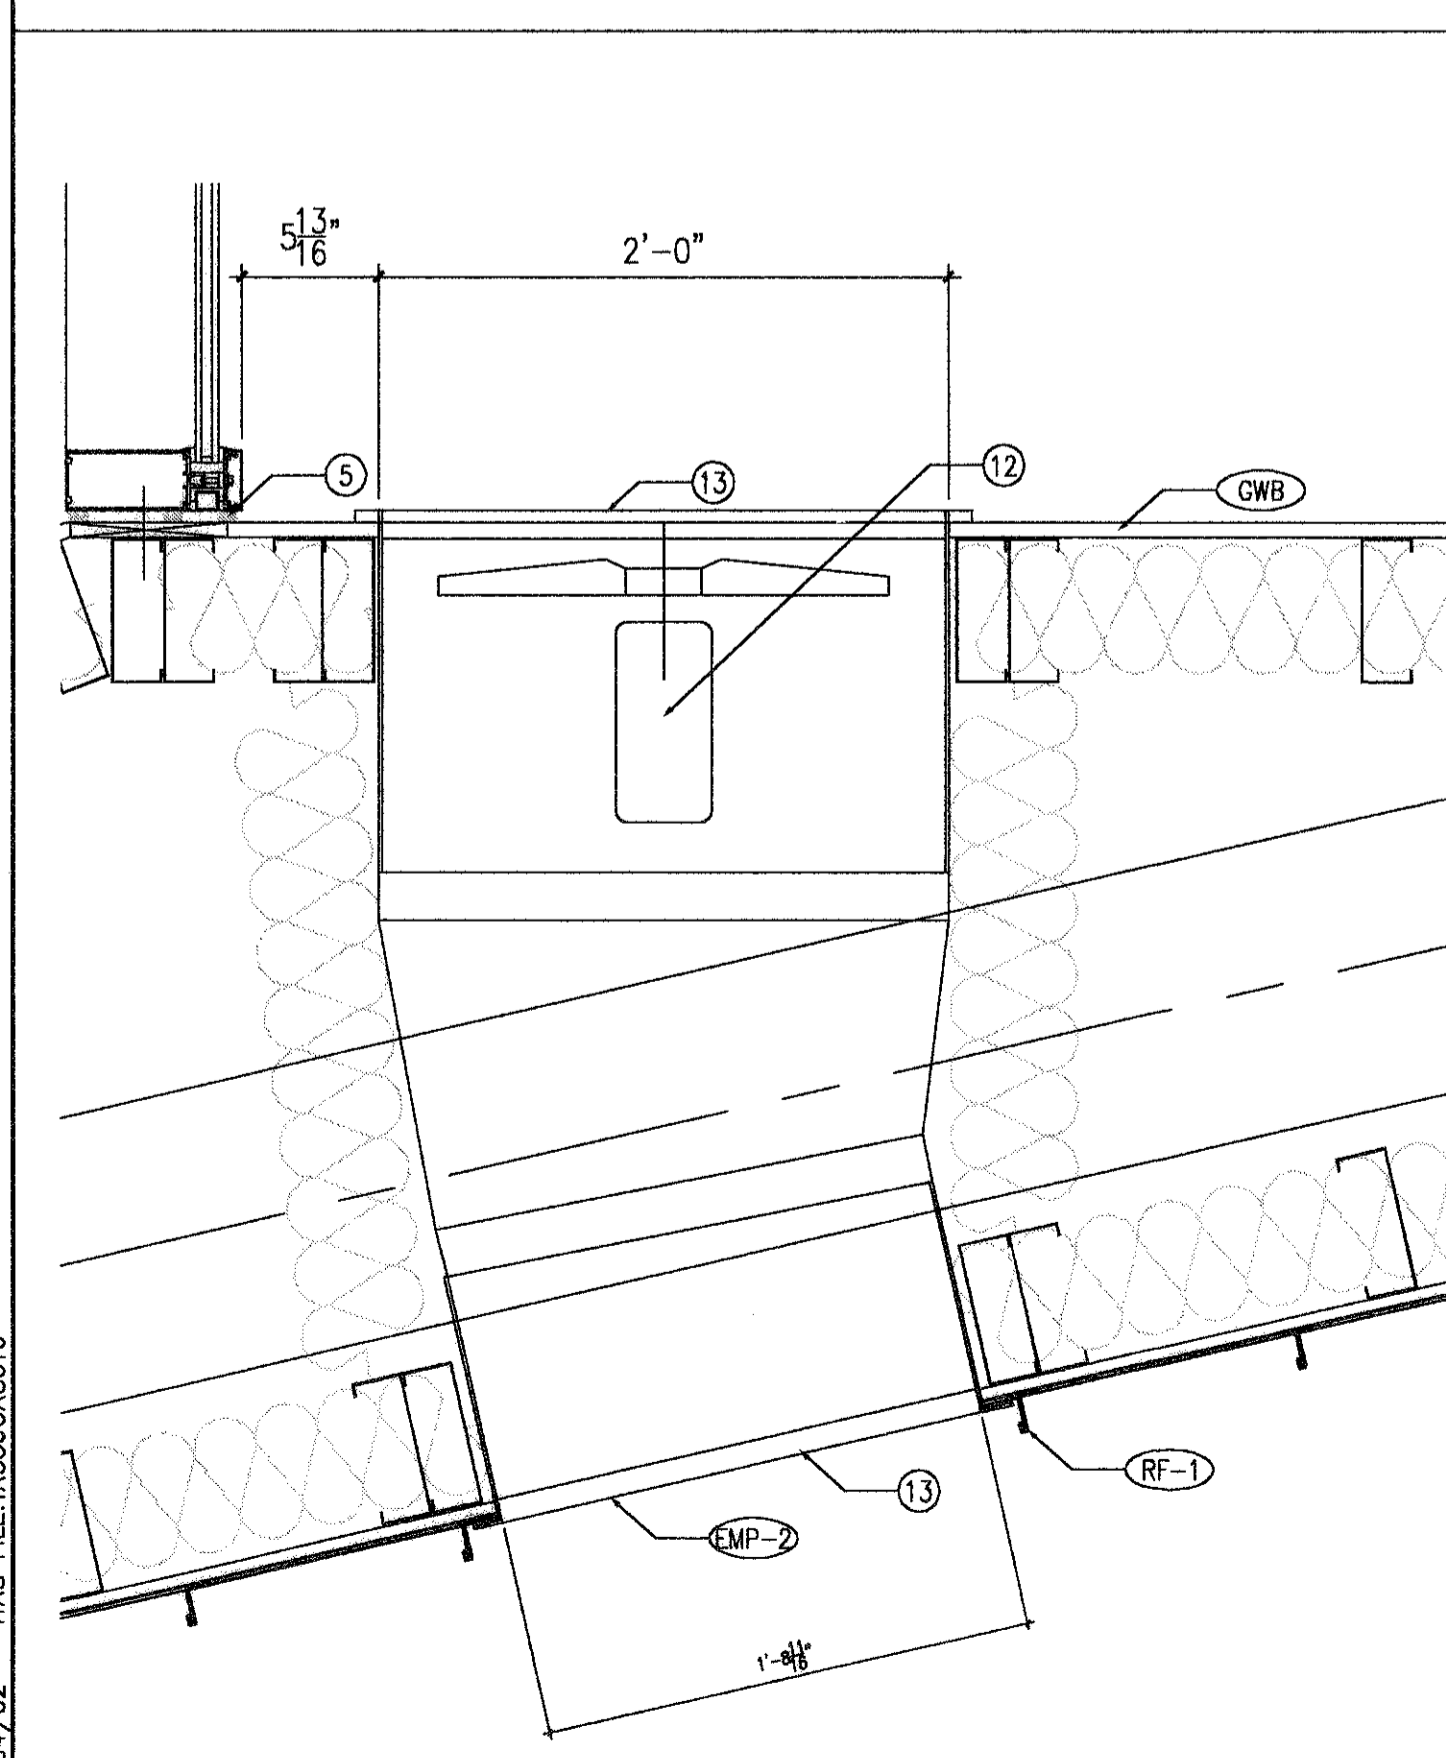


**07 WALL DETAIL**  
 A8.010 1 1/2"=1'-0"

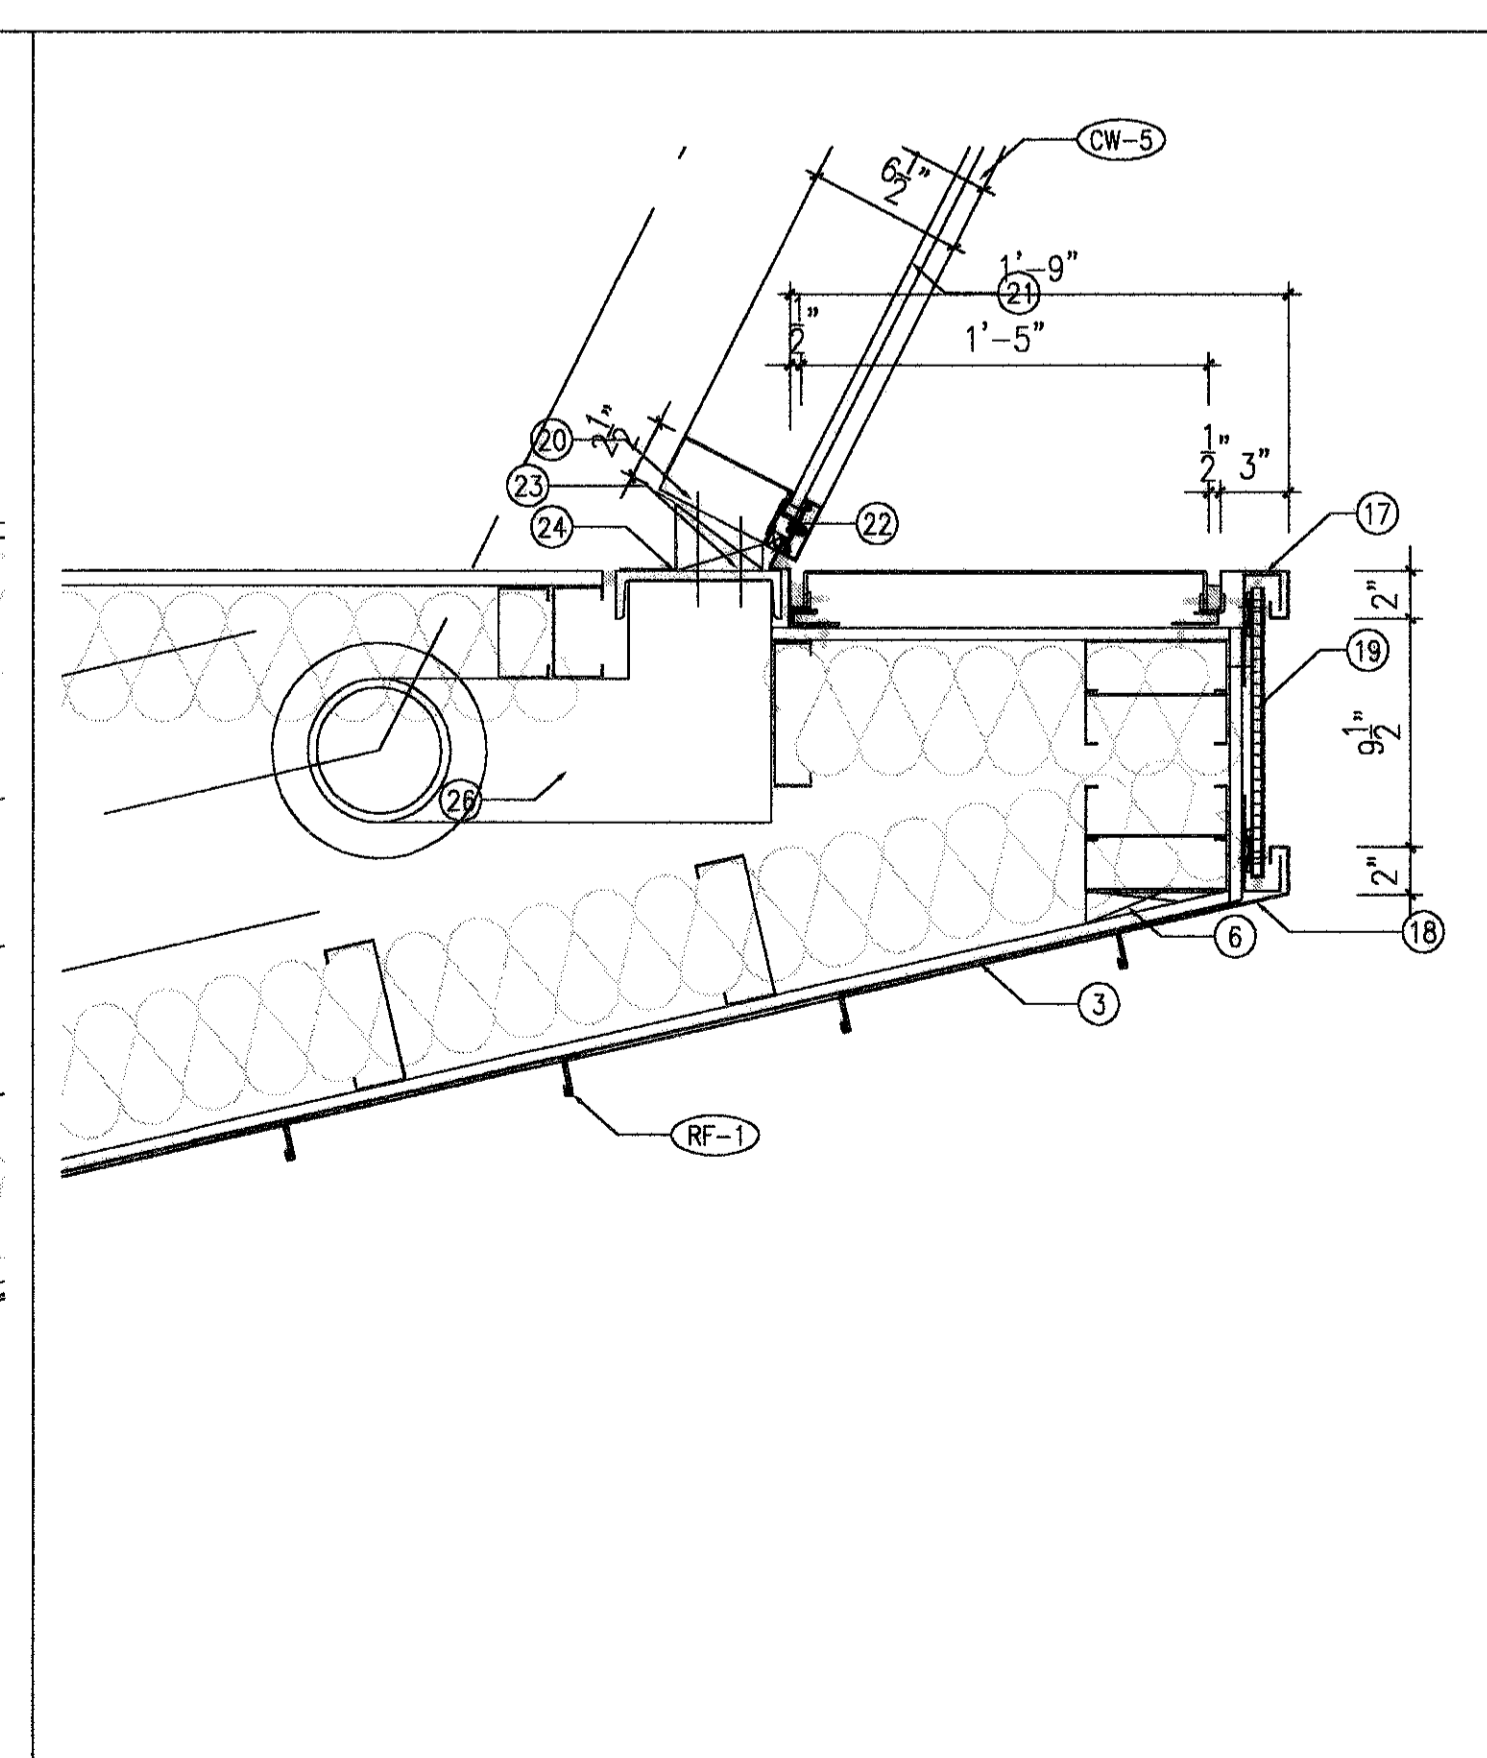

**06 WALL DETAIL**  
 A8.010 1 1/2"=1'-0"

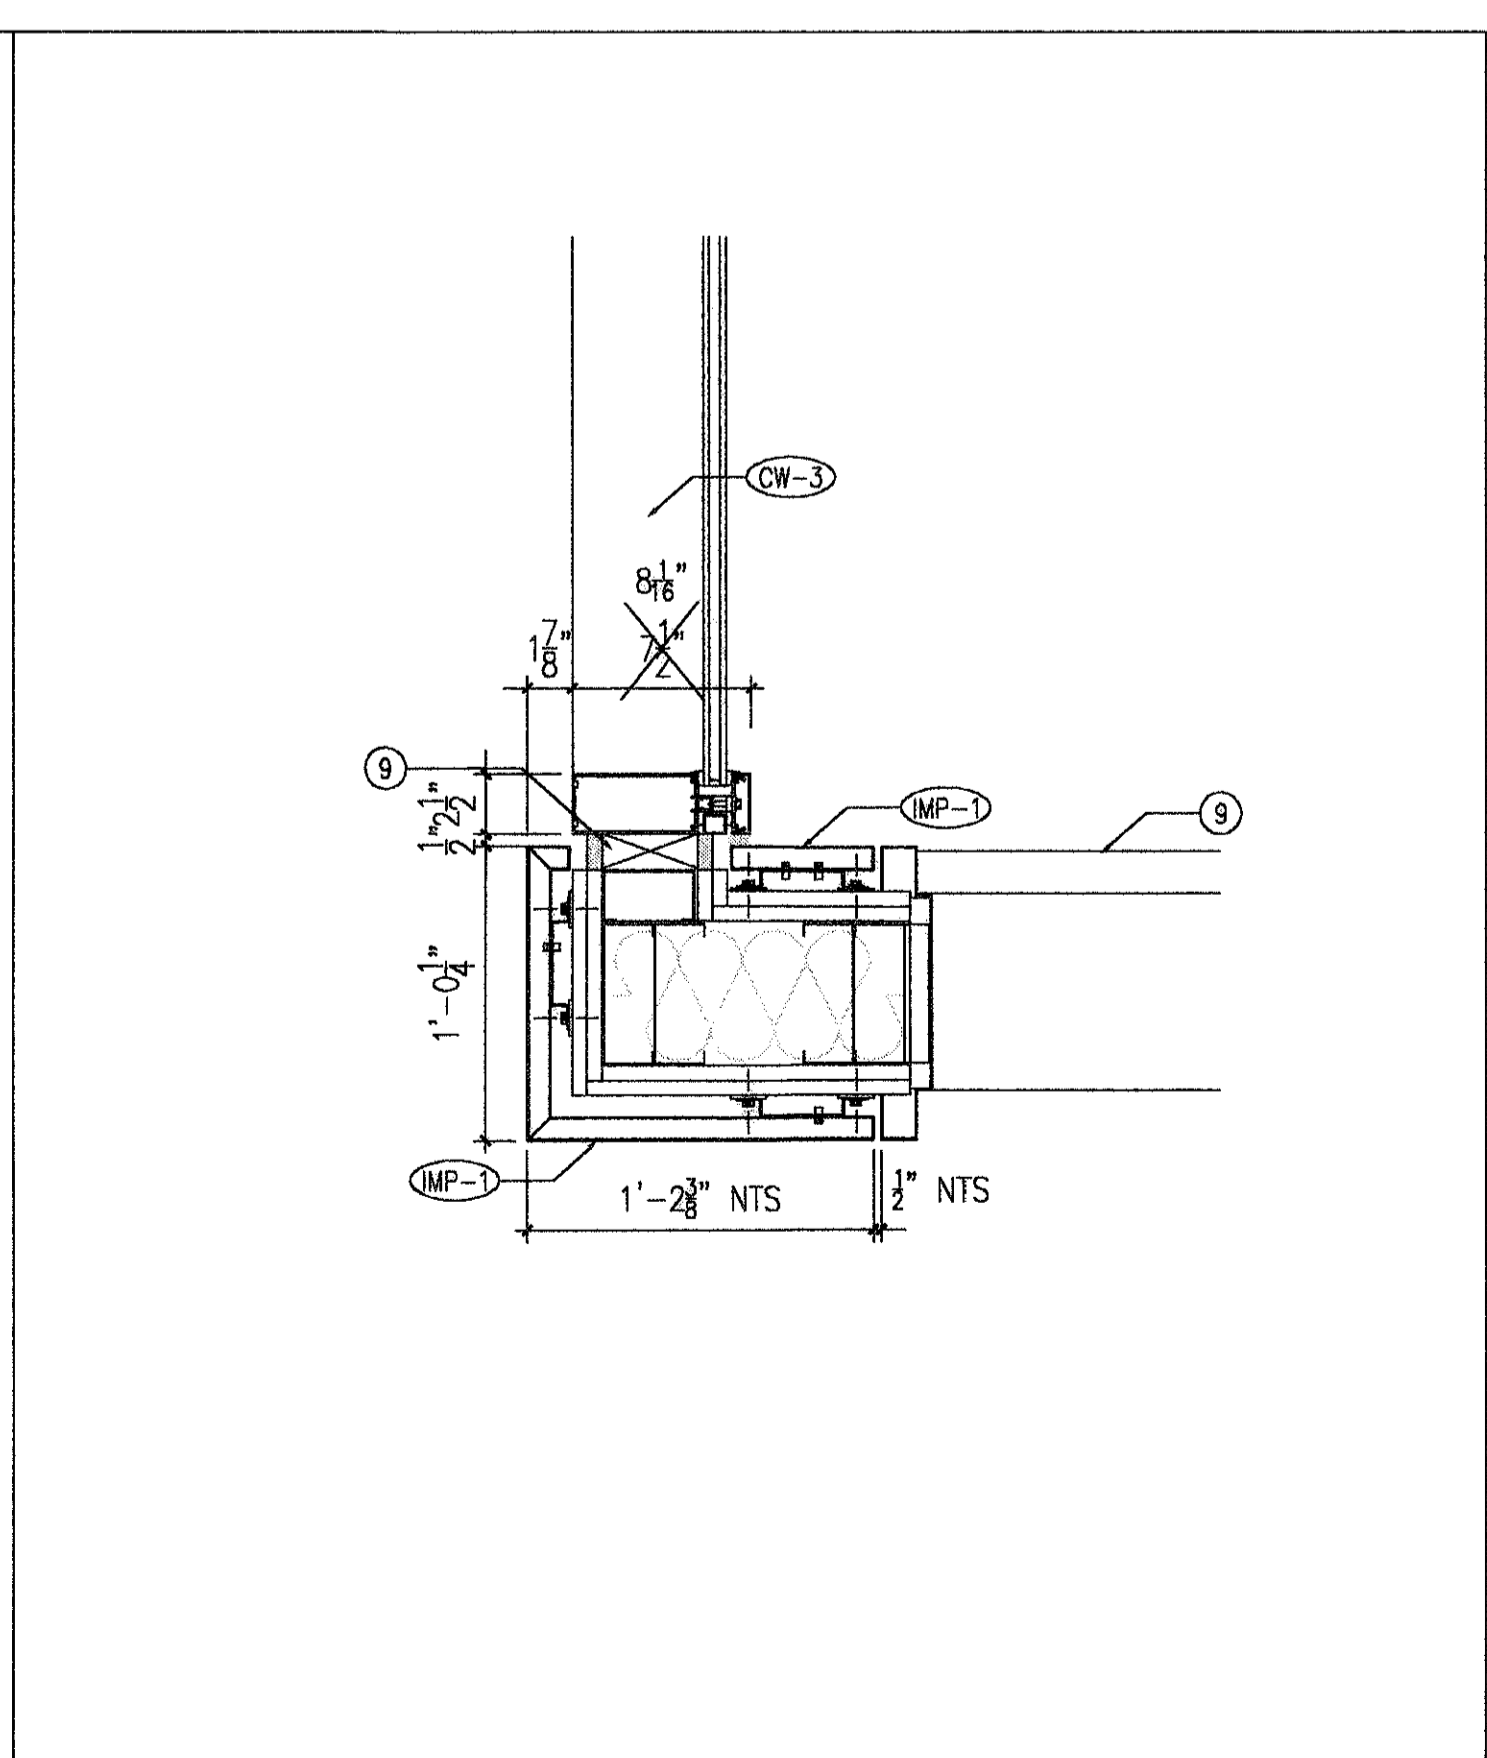


**05 WALL DETAIL**  
 A8.010 1 1/2"=1'-0"

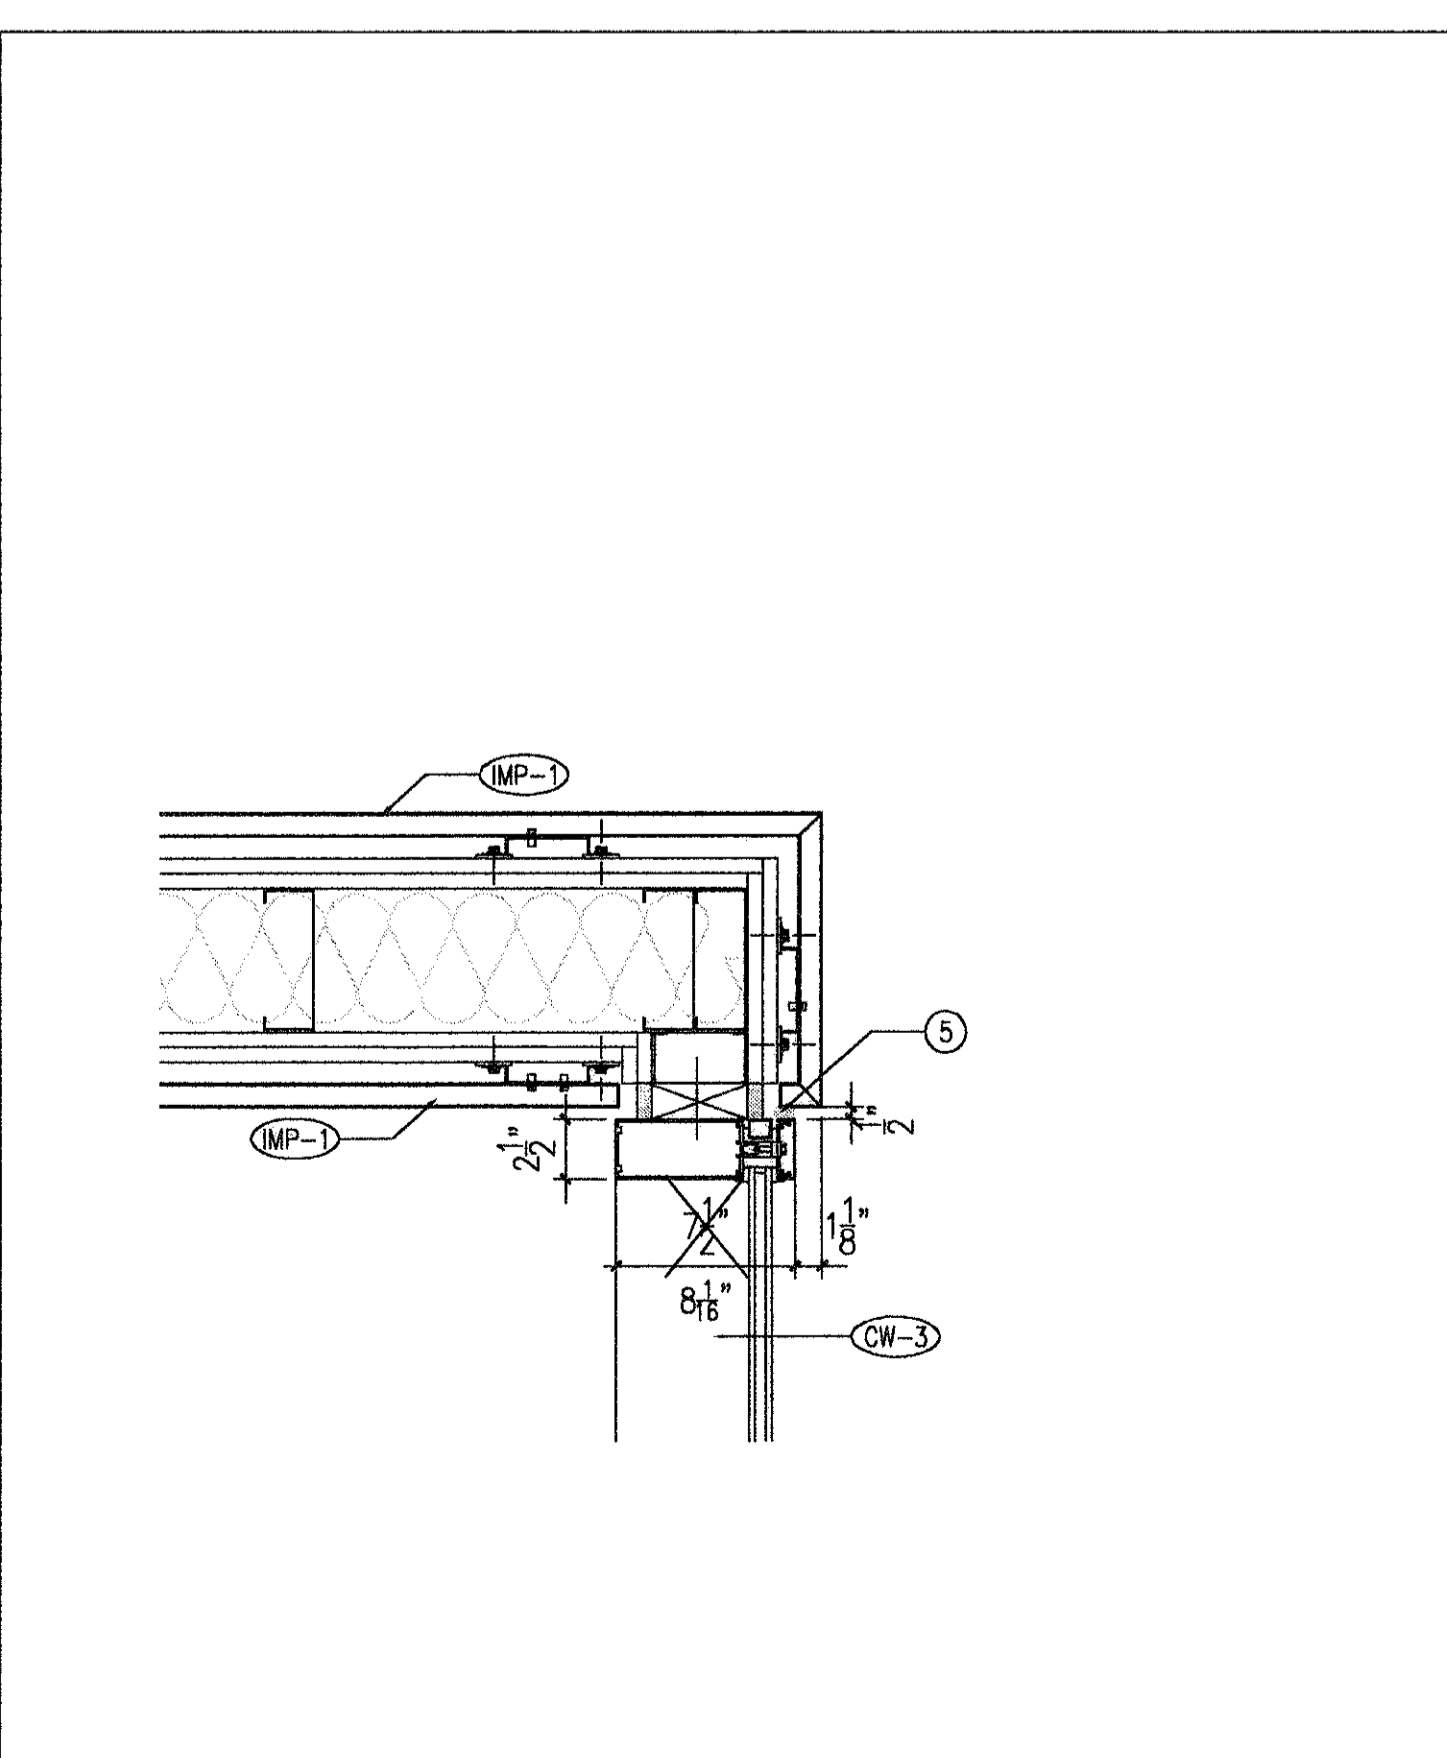

**04 WALL DETAIL**  
 A8.010 1 1/2"=1'-0"

PROJECT MGR:	HDM
DESIGNER:	SG
DRAWN BY:	SEM
CHECKED BY:	AB
DRAWING STANDARD:	ISEP 07.20.2000
SCALE:	AS NOTED
DATE:	09/14/01

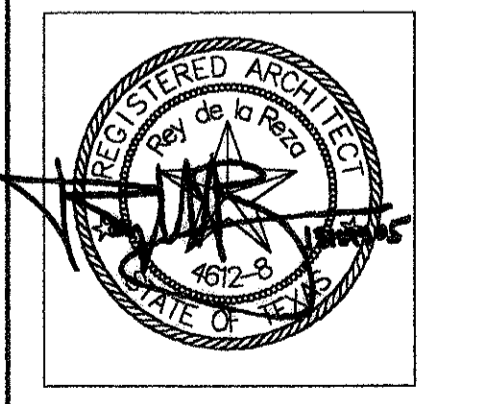


APPROVED BY:	DATE:
DIRECTOR	
HOUSTON AIRPORT SYSTEM	
PROJECT NO.	1140
C.I.P. NO.	A-0354
H.A.S. NO.	538C
SHEET NO.	


**RECORD DRAWINGS**  
 DO NOT MODIFY  
 Rey de la Reza Architects, Inc.  
 13 May 2005  
 Note: Information used to develop these documents was taken from Record of the Work Drawings prepared by the construction contractor, Clark Construction Group - Texas. The information provided by the contractor was not verified by the design firm named above.

PLOT DATE: 02/04/02 HAS FILE: A3536CAB010




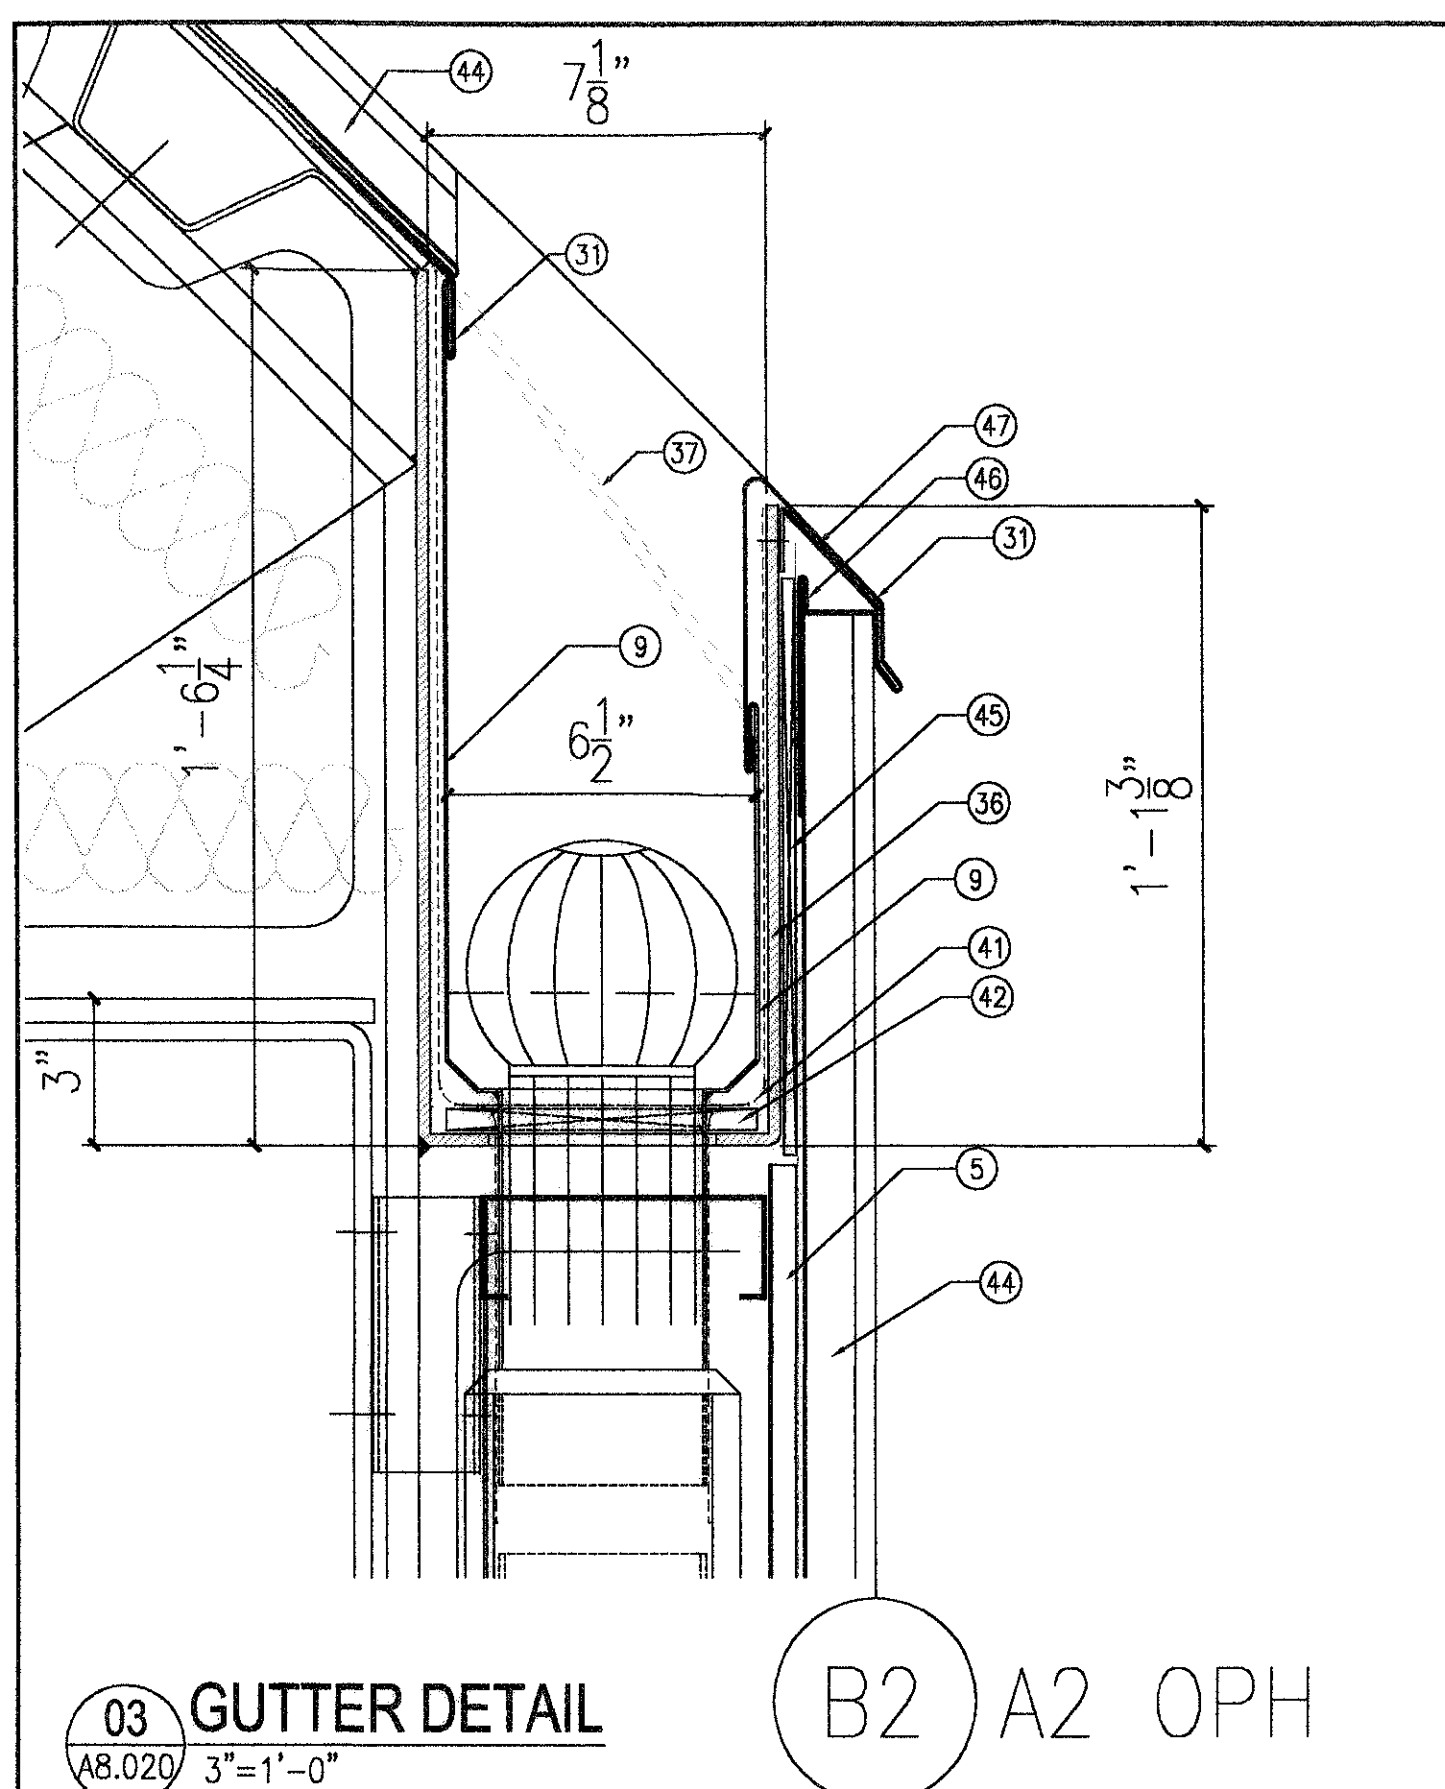


03 GUTTER DETAIL  
A8.020 3" = 1'-0"

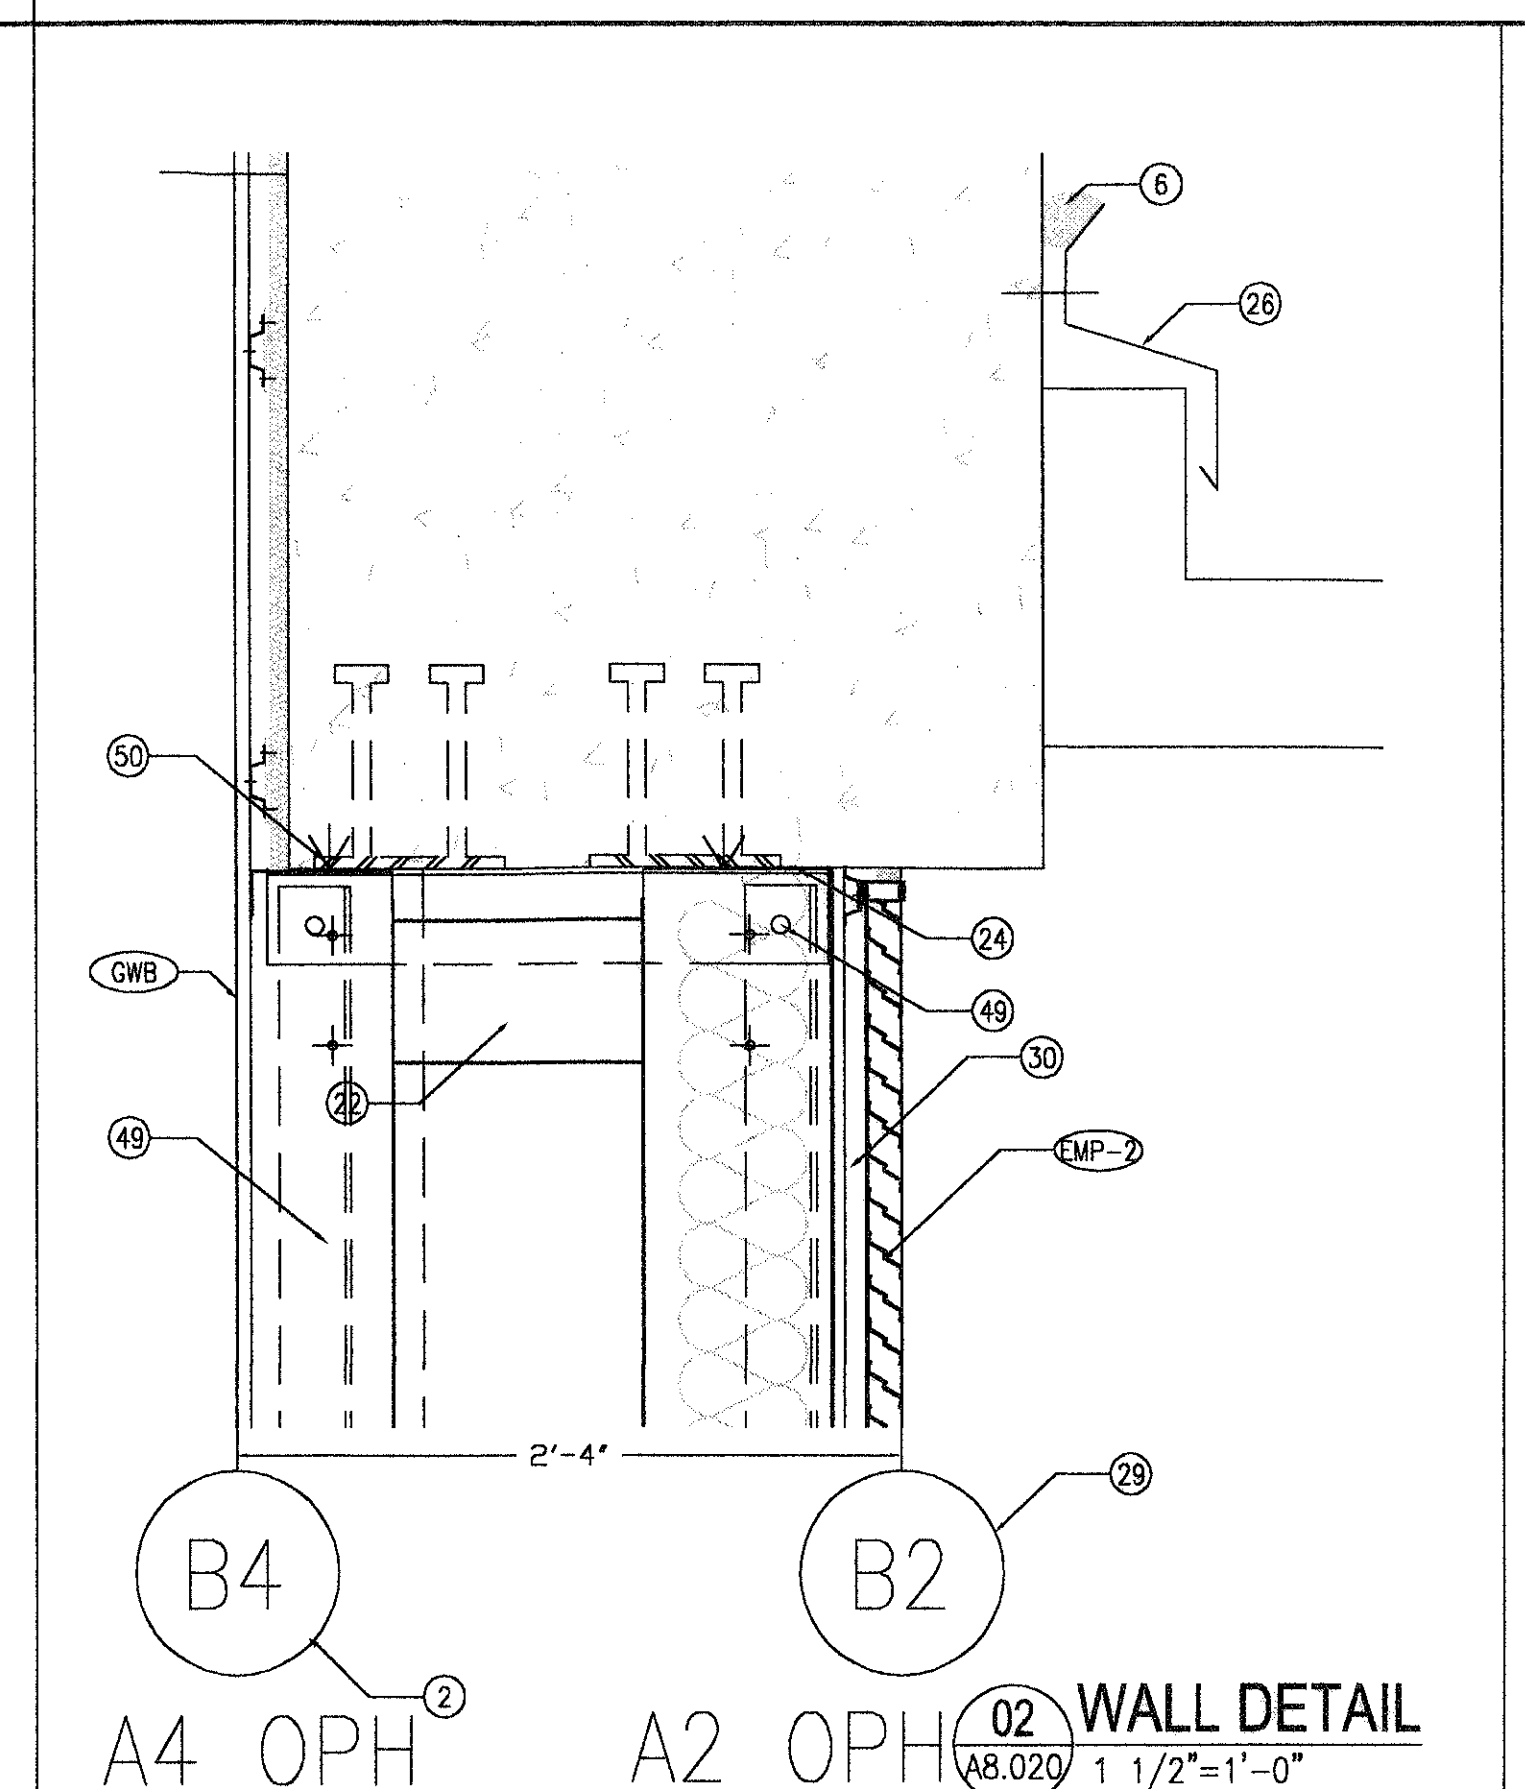


B4 A4 OPH  
A2 OPH B2  
02 WALL DETAIL  
A8.020 1 1/2" = 1'-0"

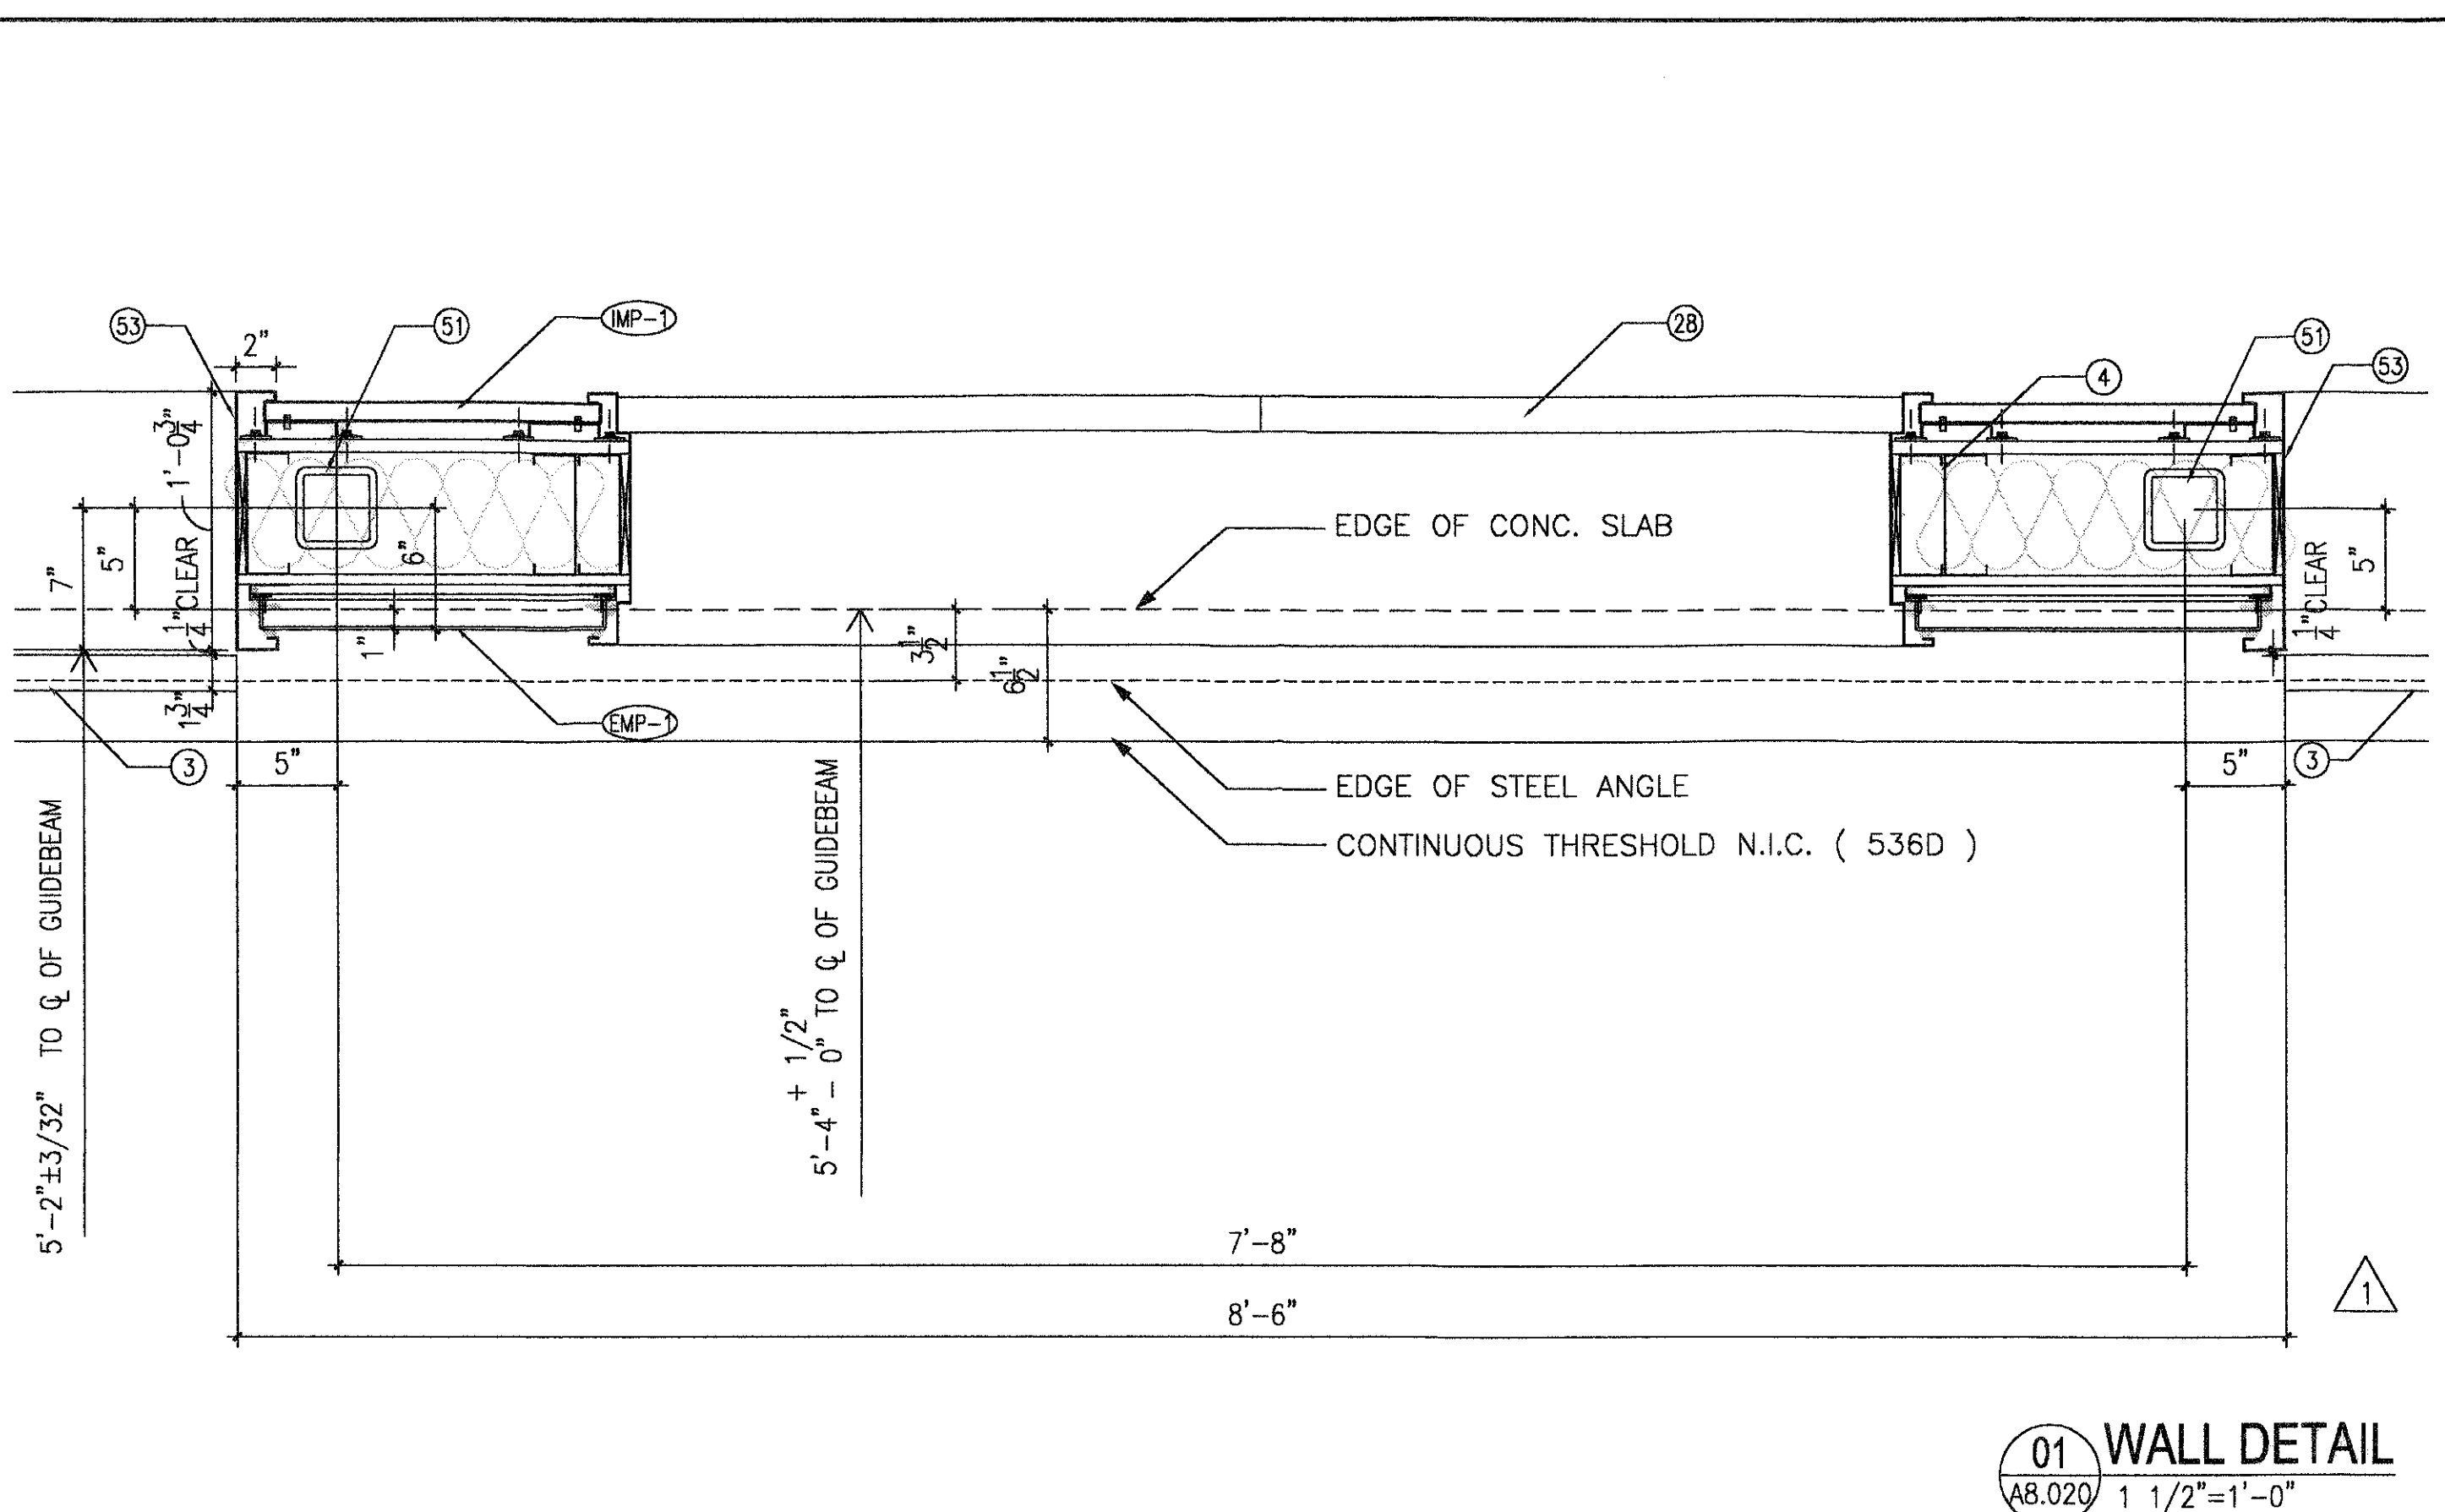


01 WALL DETAIL  
A8.020 1 1/2" = 1'-0"

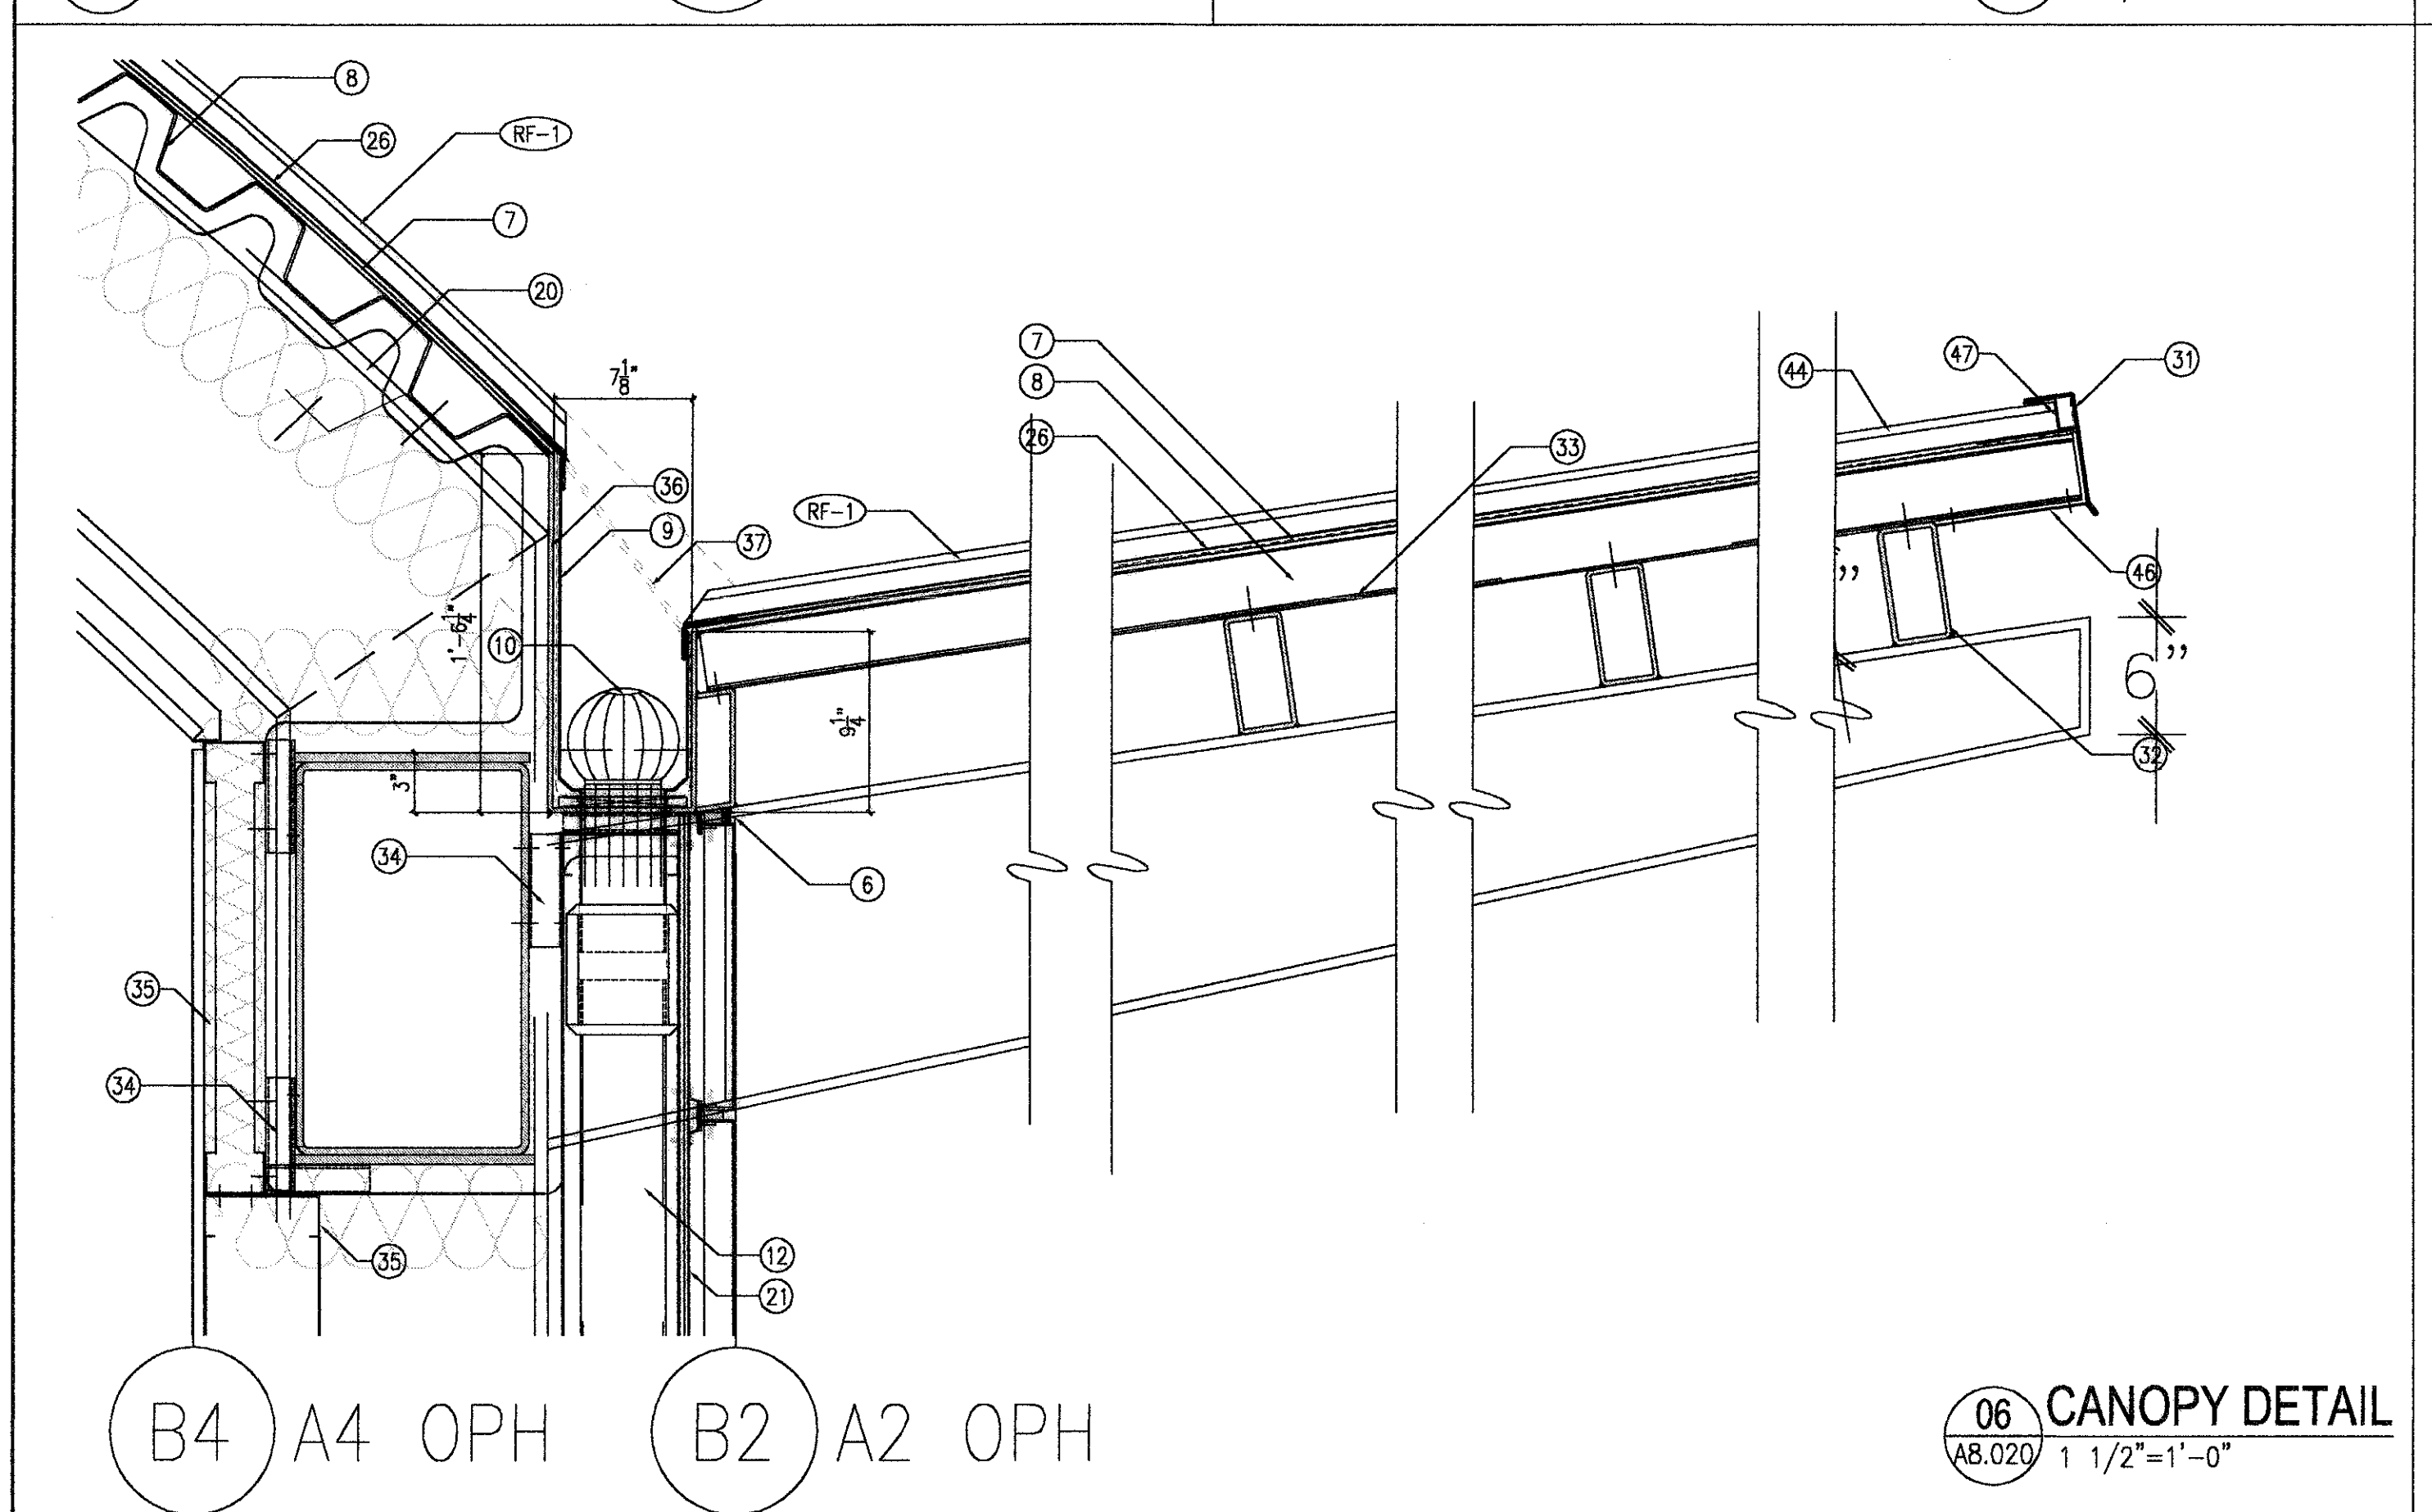


06 CANOPY DETAIL  
A8.020 1 1/2" = 1'-0"

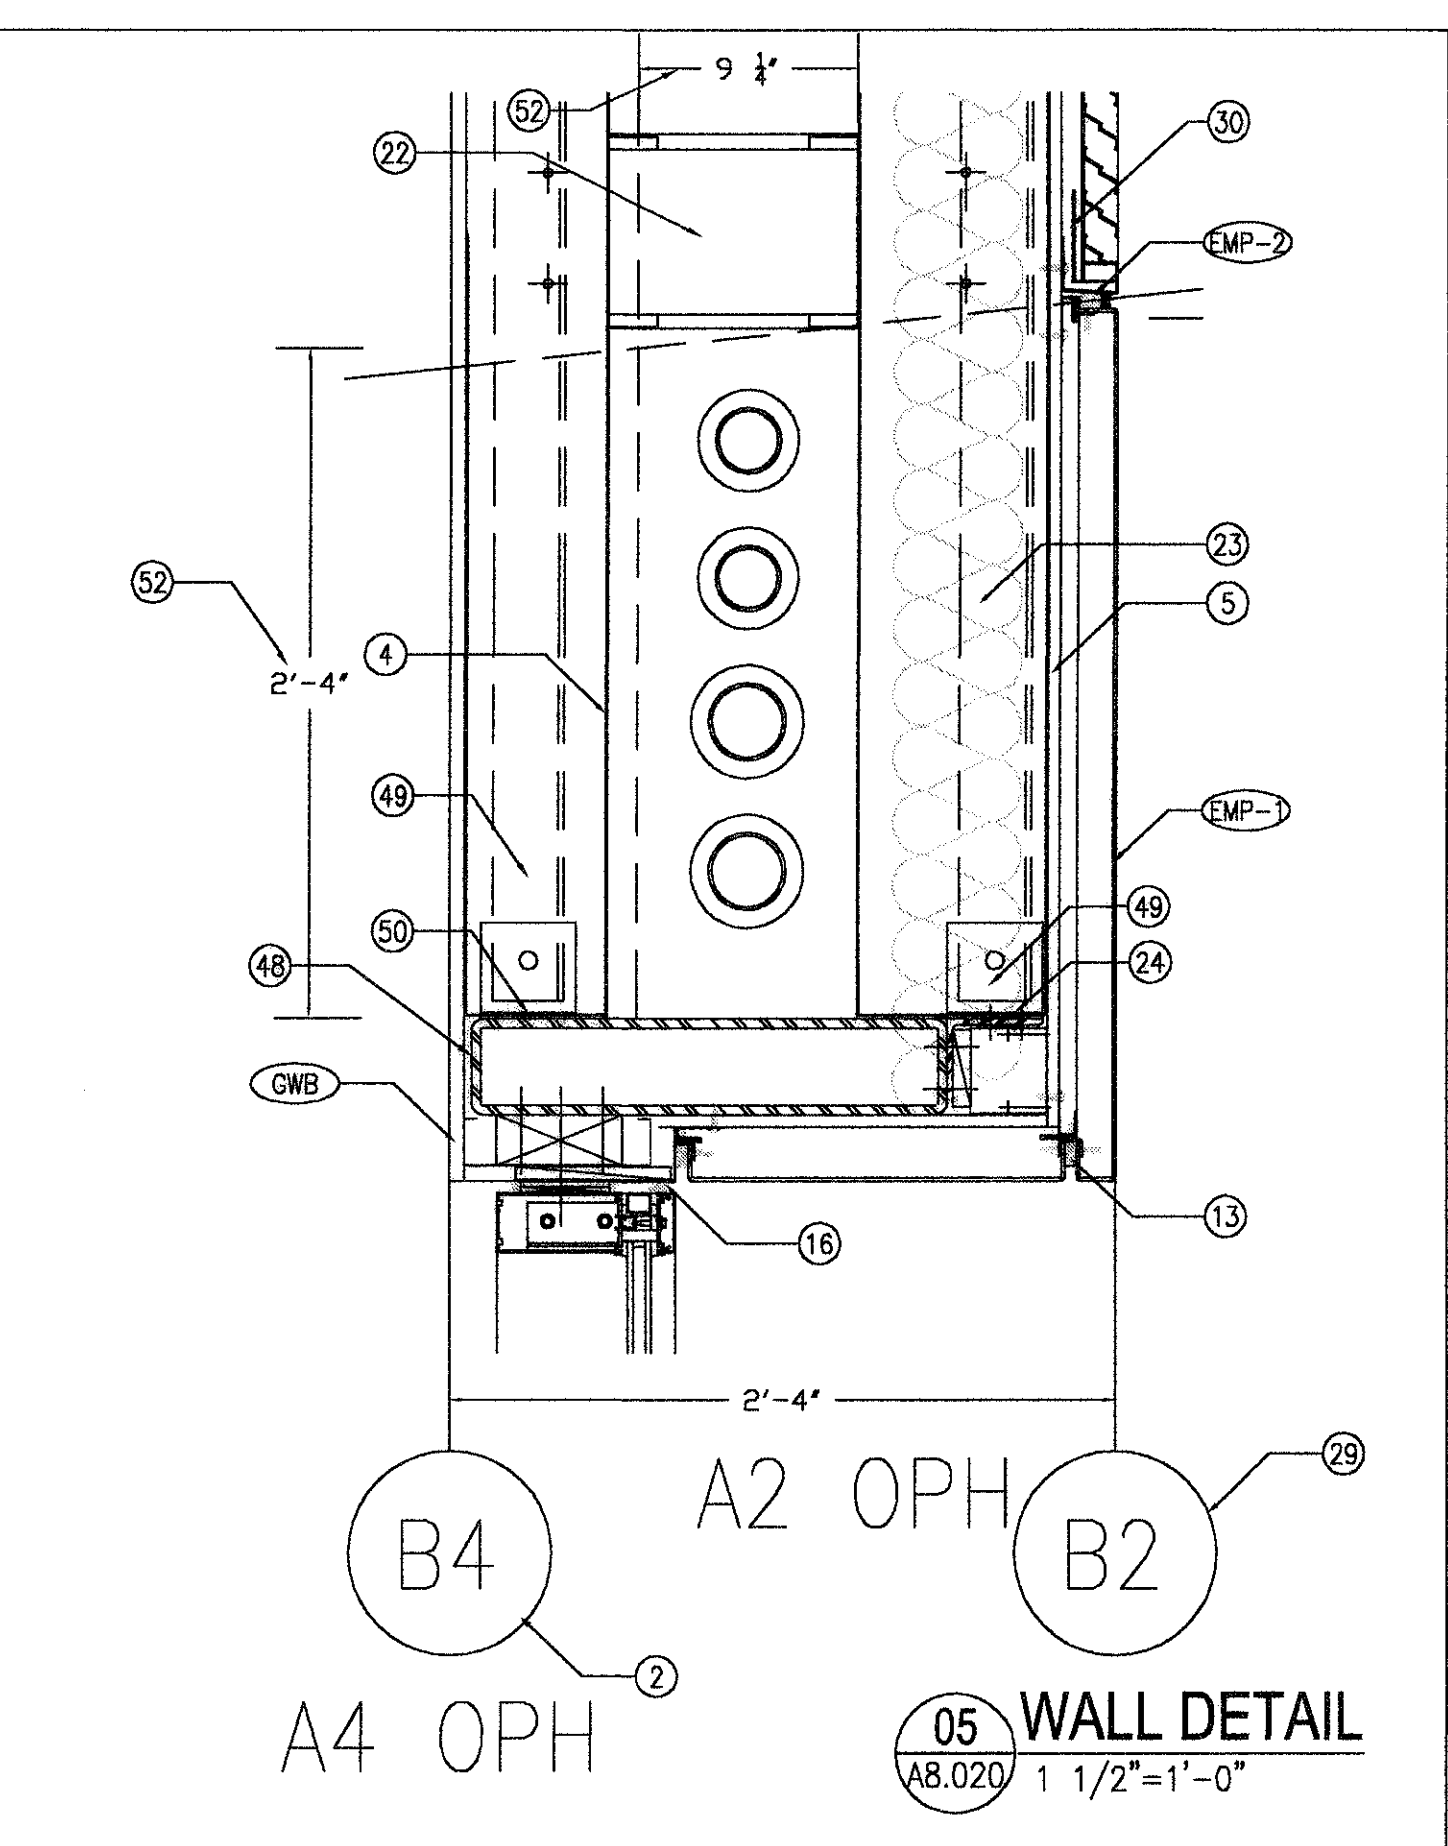


B4 A4 OPH  
A2 OPH B2  
05 WALL DETAIL  
A8.020 1 1/2" = 1'-0"

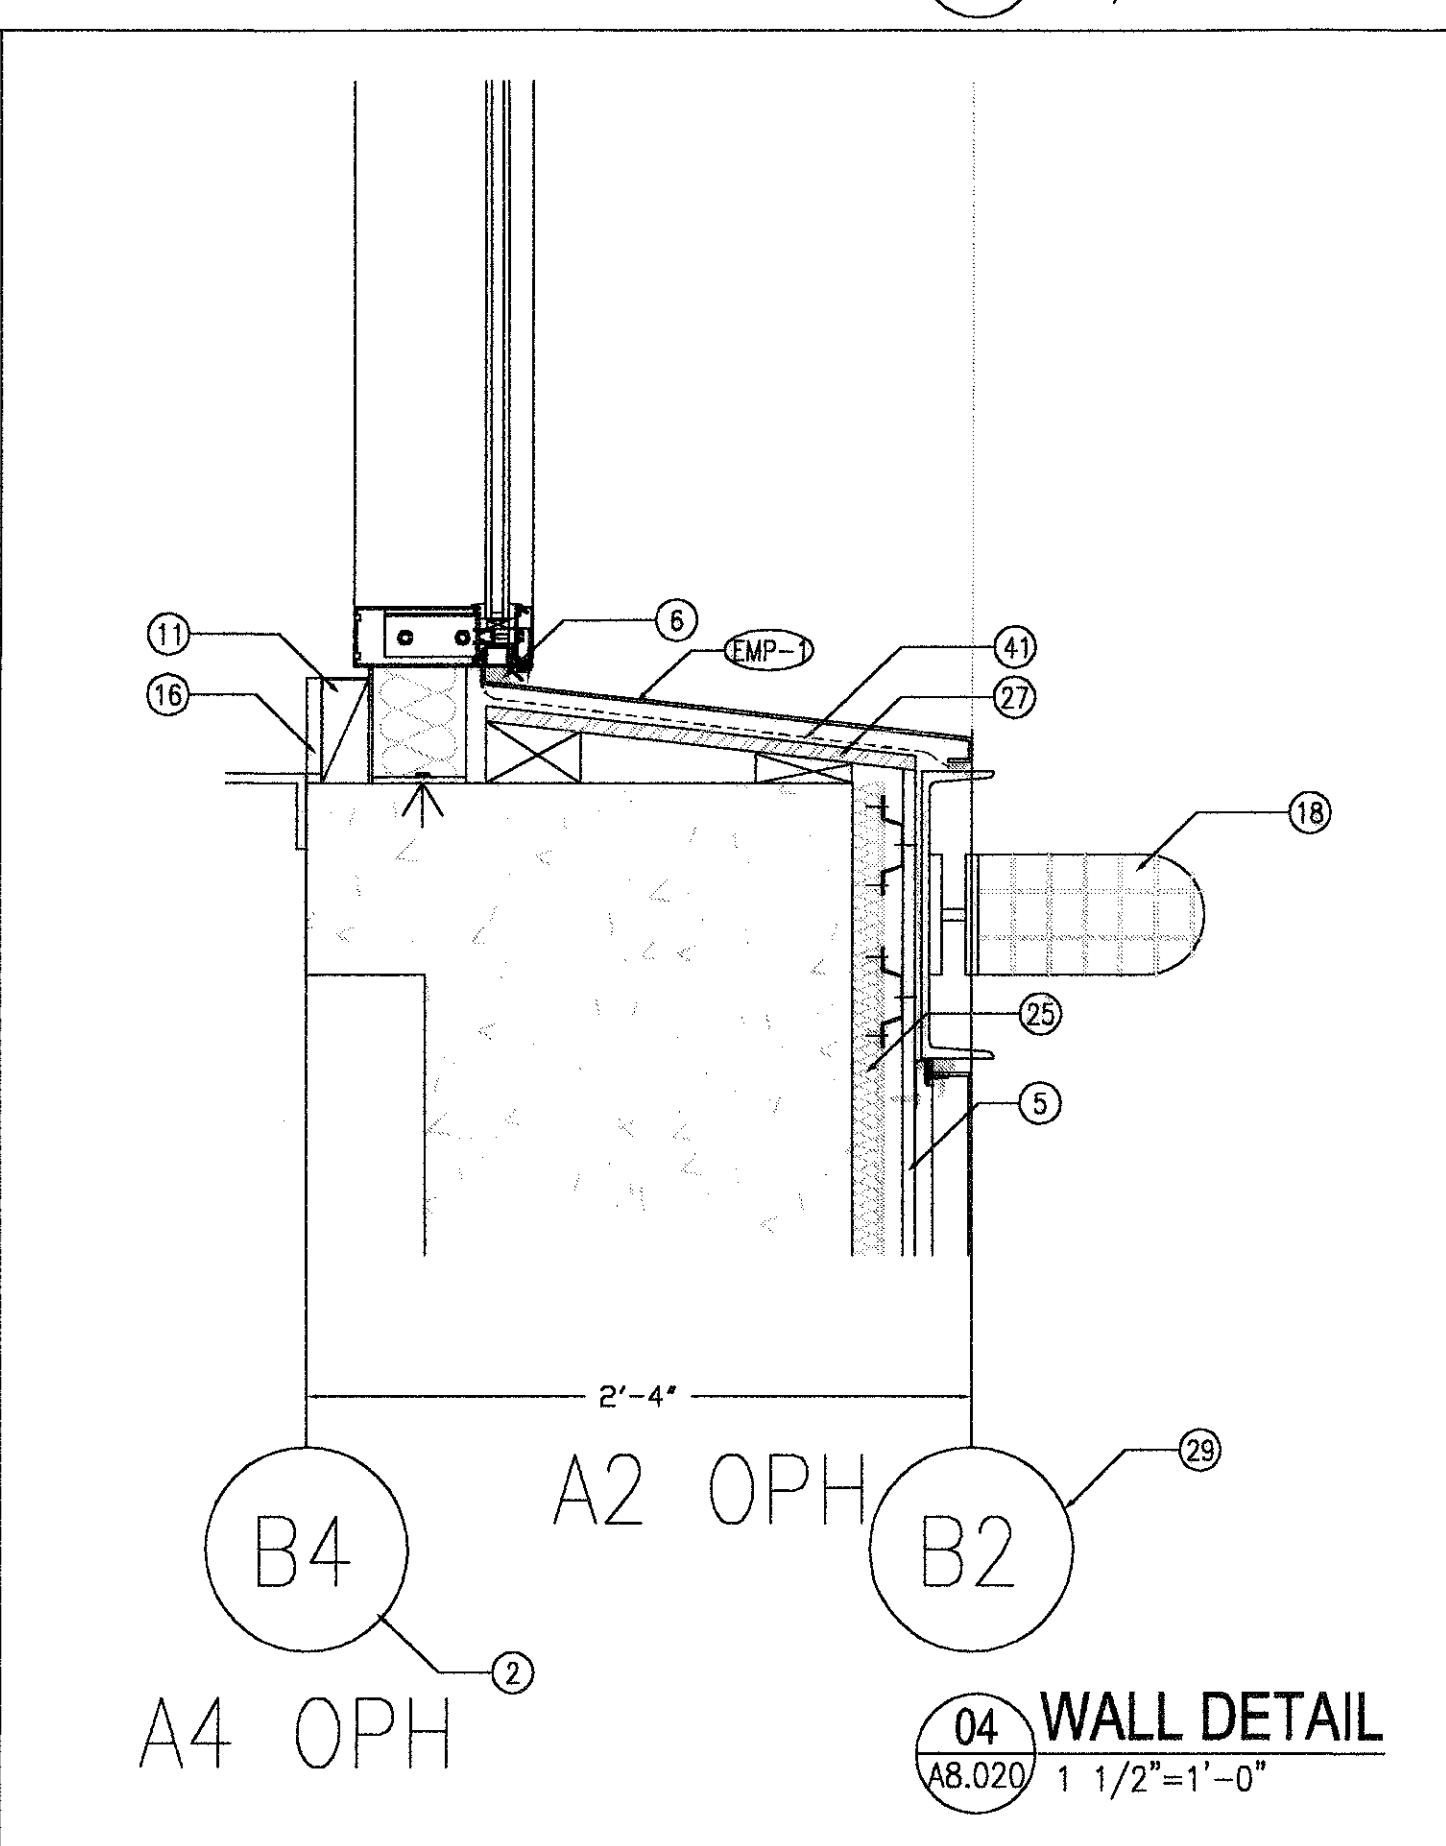

B4 A4 OPH  
A2 OPH B2  
04 WALL DETAIL  
A8.020 1 1/2" = 1'-0"

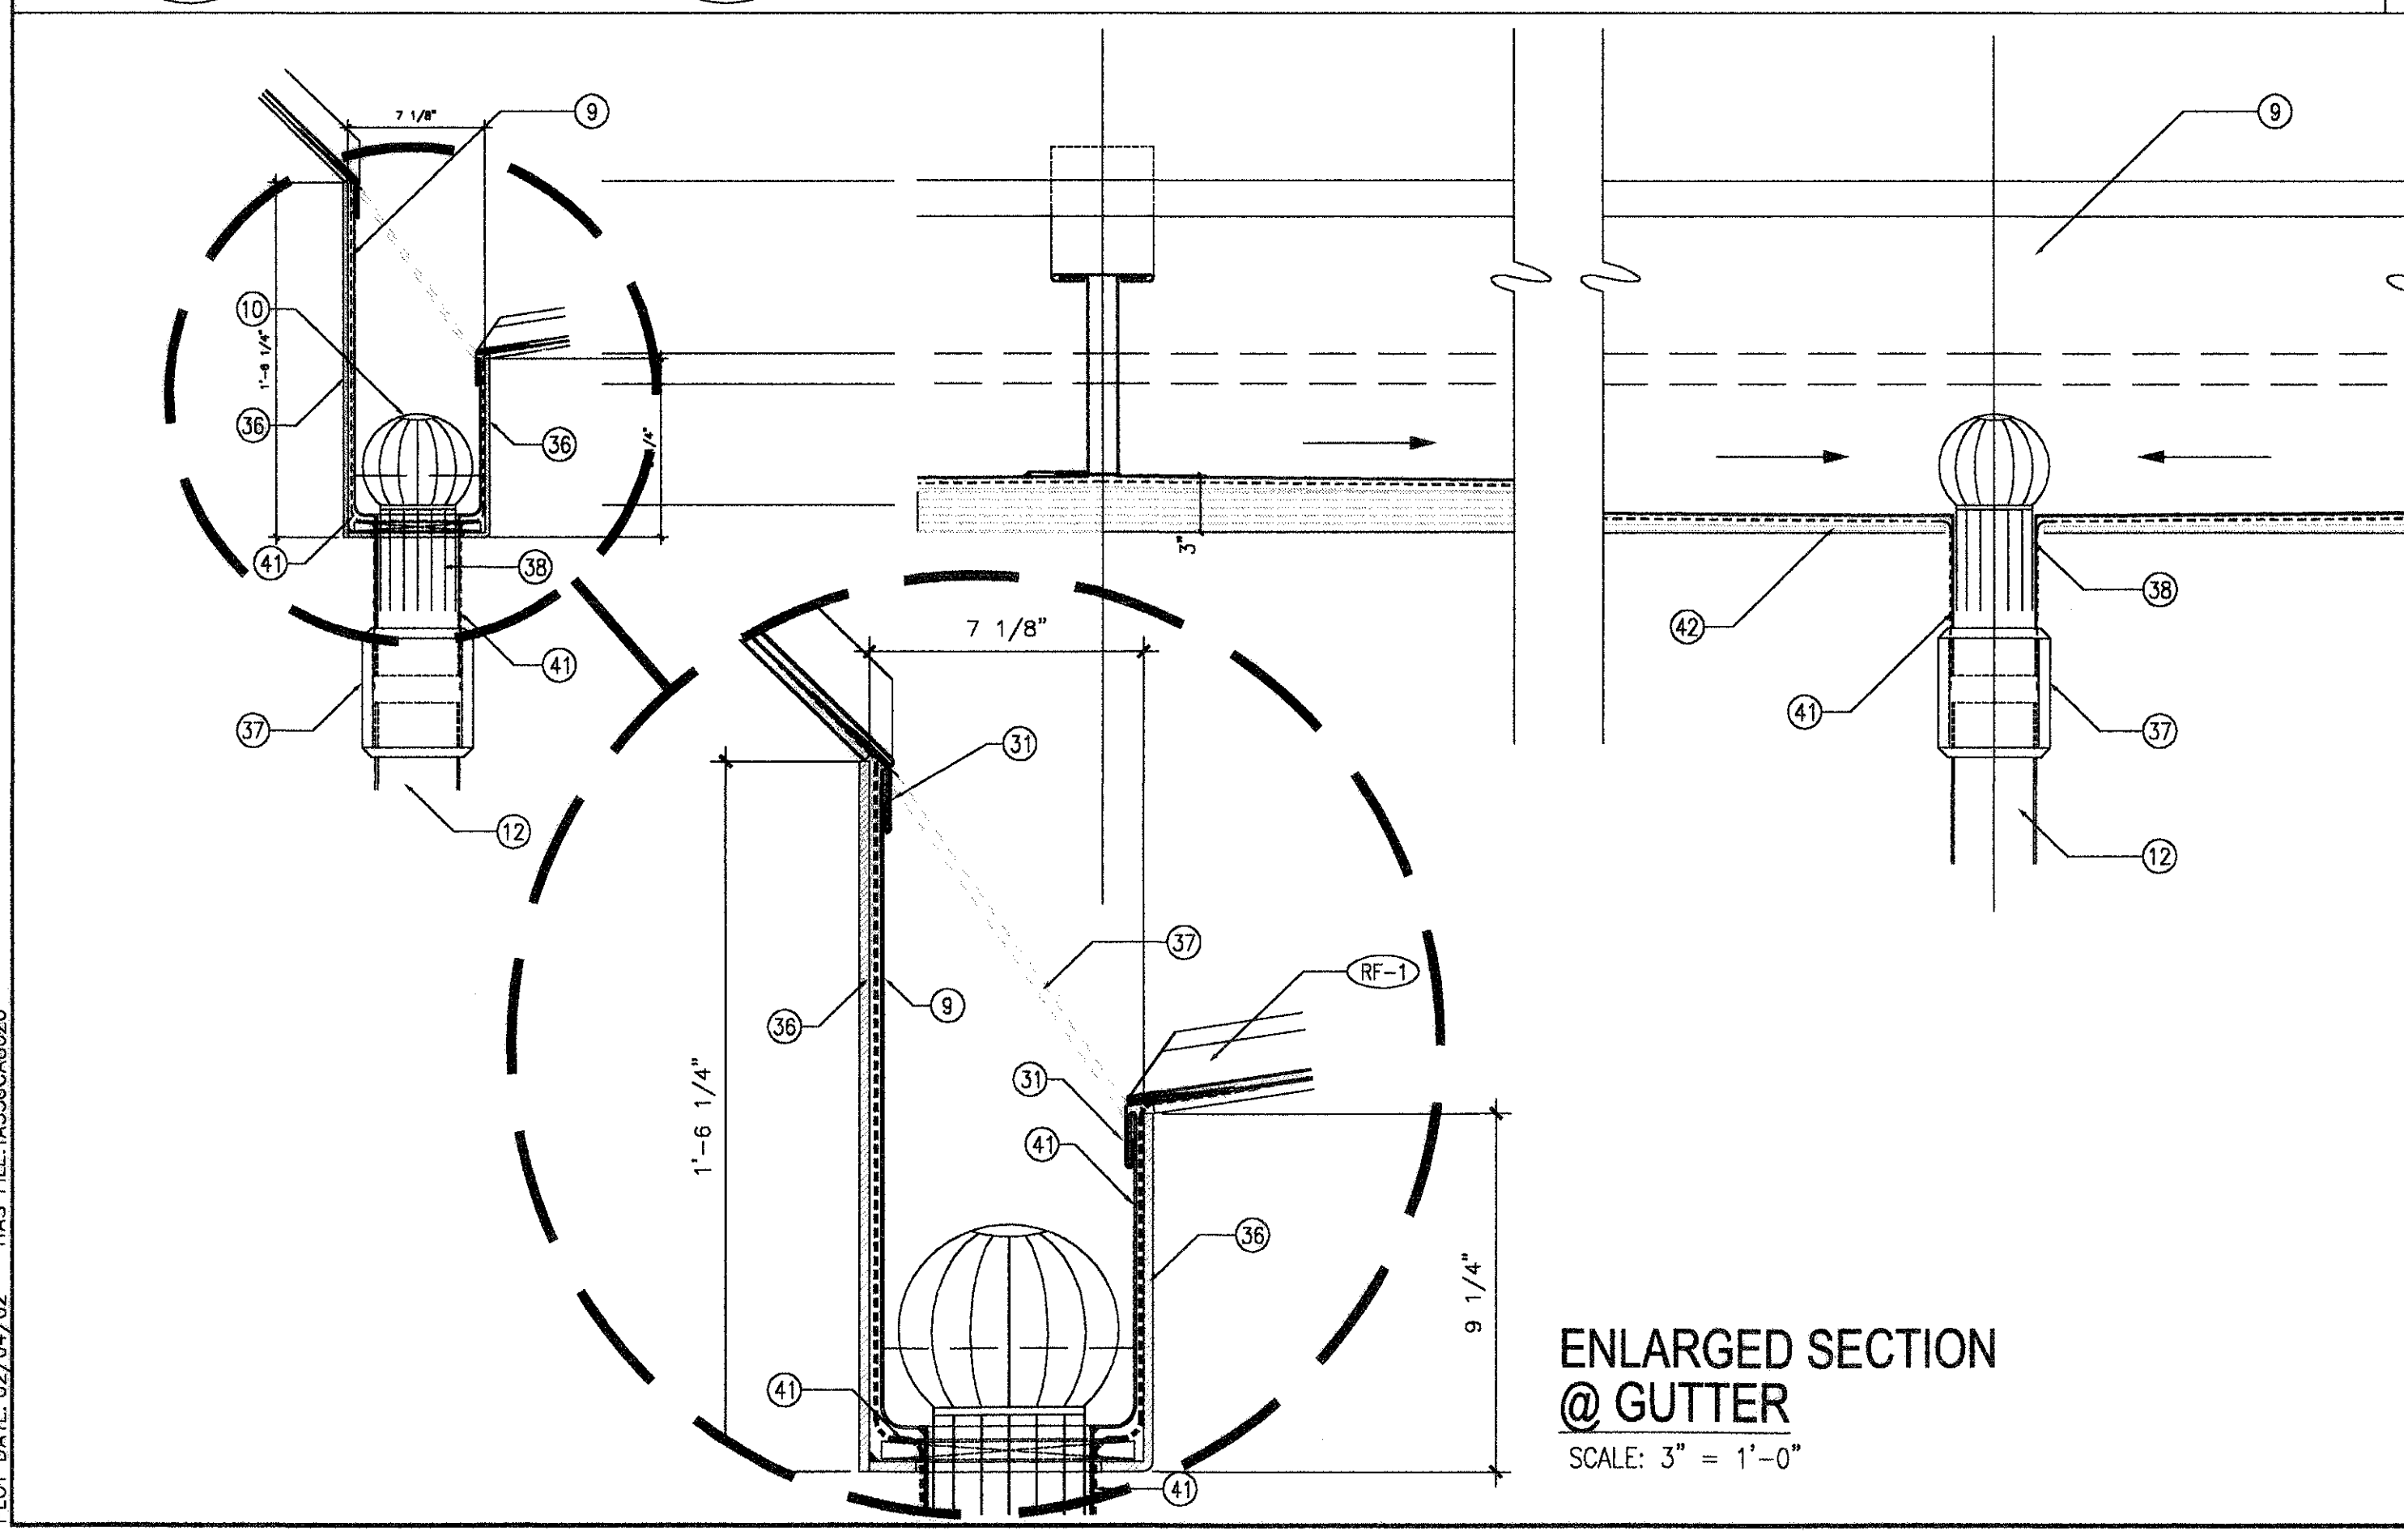

ENLARGED SECTION @ GUTTER  
SCALE: 3" = 1'-0"

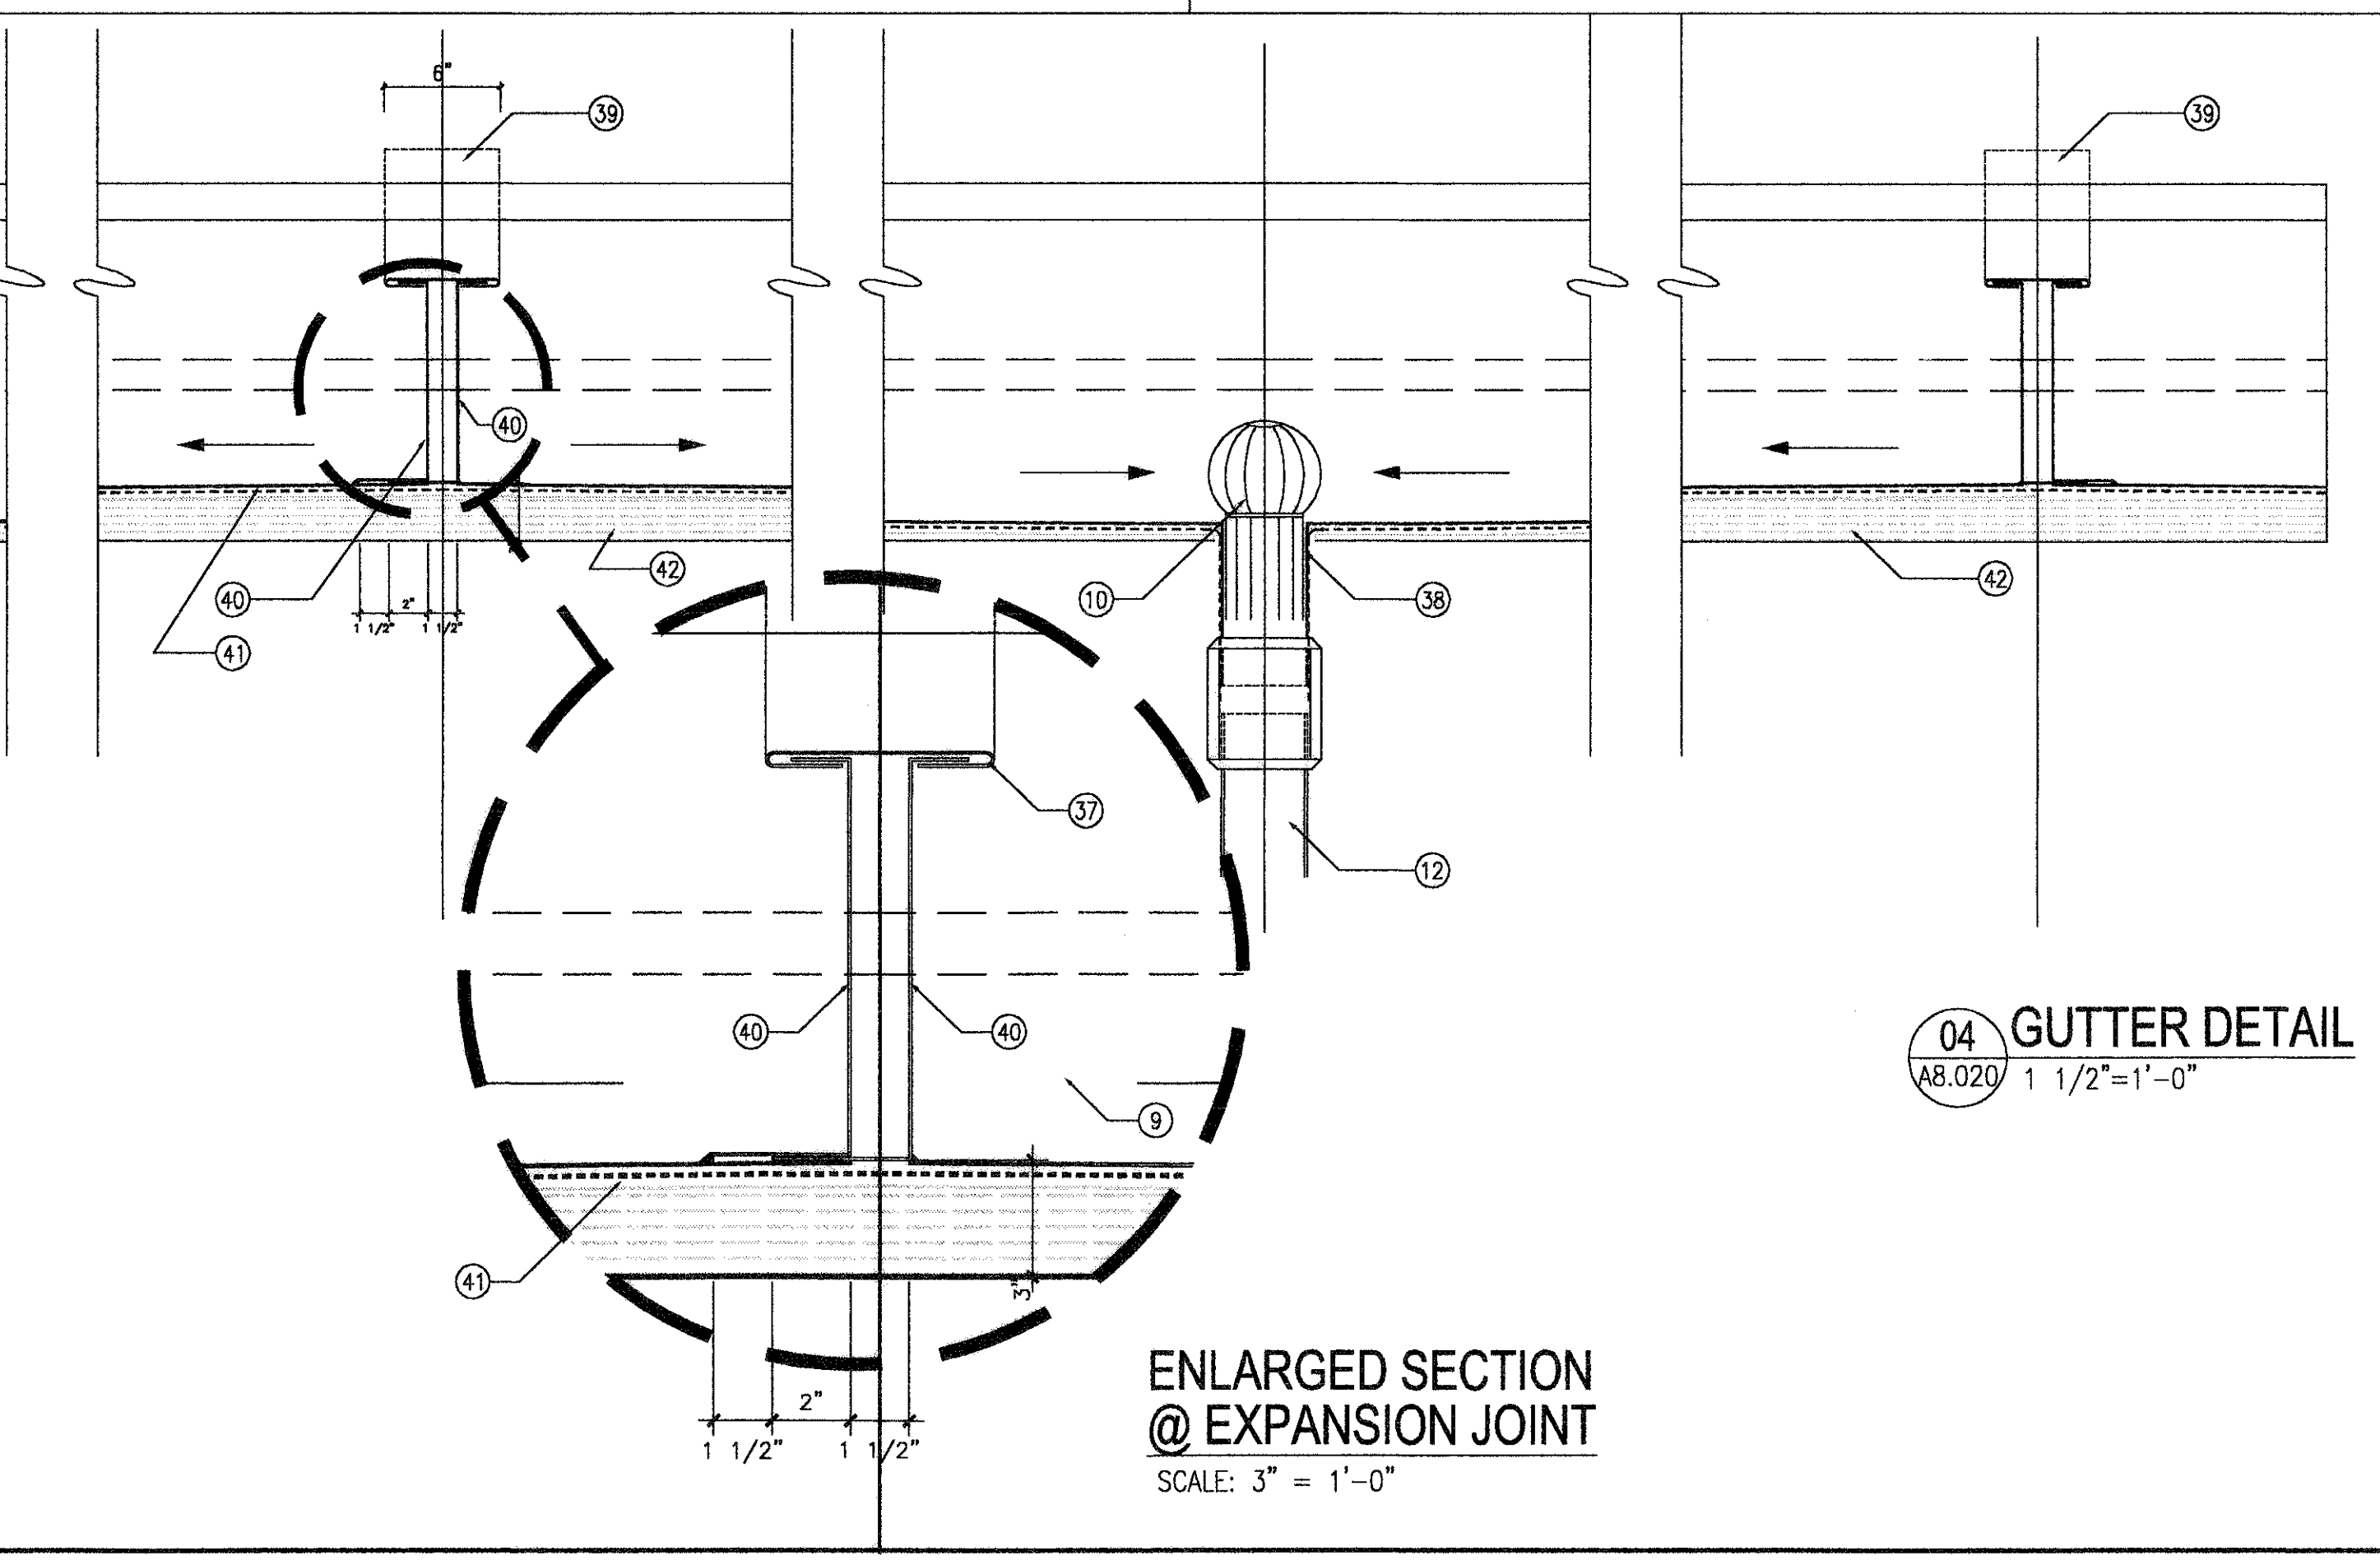

ENLARGED SECTION @ EXPANSION JOINT  
SCALE: 3" = 1'-0"

GENERAL NOTES:

- (EMP-1) EXTERIOR POWDERCOATED WALL METAL PANELS - ALUMINUM PANEL 1/8" THICK - TYPE SERIES 3000 MODIFIED FROM UNA-CLAD - COPPER SALES OR EQUAL - POWDERCOATED KYMAR 500
- (RF-1) STANDING SEAM METAL ROOF - TYPE UC3 FROM UNA-CLAD - COPPER SALES OR EQUAL - POWDERCOATED KYMAR 500; COLOR#2 SILVER METALLIC
- (SWB) PAINT 5/8" HI-IMPACT GYPSUM BOARD ON METAL STUDS
- (MP-2) POWDERCOATED ALUMINUM LOUVERS - WITH INSECT MESH WHEN USED BY MECHANICAL - CLOSED WITH ALUMINUM SHEET WELDED TO FRAME WHEN NOT USED BY MECHANICAL RE: MECHANICAL FOR OPENINGS
- (MP-1) INTERIOR STAINLESS STEEL WALL PANELS

**RECORD DRAWINGS**  
DO NOT MODIFY  
Rev de la Reza Architects, Inc.  
13 May 2005  
Note: Information used to develop these documents was taken from Record of the Work Drawings prepared by the construction contractor, Clark Construction Group - Texas. The information provided by the contractor was not verified by the design firm named above.

KEYED NOTES:

- 1 SLIDING DOOR POST - 4"x4" STEEL TUBE
- 2 COLUMN LINE B4: INTERIOR WALL FINISH FACE - A4 OPH
- 3 SLIDING DOOR BY OTHERS N.I.C. - HAS PROJECT 5360
- 4 6" METAL STUD @ 16" O.C. 16 GA.
- 5 1/2" SHEATHING
- 6 SEALANT & BACKER ROD
- 7 5/8" GYPSUM SHEATHING TYPE X
- 8 3" METAL DECK
- 9 SSSL GUTTER - 16 GA
- 10 BASKET STRAINER - SSSL WIRE MESH
- 11 SSSL CLAD - 16 GA
- 12 DOWNSPOUT - RE PLUMBING
- 13 PRECOMPRESSED EXPANDING FOAM SEALANT TYPE COLORSEAL BY EMSAL OR EQUAL. STANDARD COLOR TO MATCH COLOR OF METAL PANELS
- 14 BATT INSULATION
- 15 RIGID INSULATION
- 16 SSSL BASE
- 17 12" ALUMINUM CHANNEL - POWDERCOATED - FASTENERS NOT VISIBLE. ANCHOR TO STRUCTURE BY ALUM. PLATES WELDED @ CHANNEL BACK SIDE
- 18 BLUE SAFETY LIGHT
- 19 STEEL COLUMN + 3HR FIREPROOFING
- 20 STEEL BEAM + 1HR FIREPROOFING
- 21 UNDERLAYMENT
- 22 BRACING DEFINE
- 23 8" METAL STUD JOIST @ 16" O.C. 10 GA.
- 24 8" STEEL RUNNER
- 25 SHIM + SUBGIRT
- 26 EXTRUDED ALUM. FLASHING POWDERCOATED
- 27 MARINE GRADE PLYWOOD
- 28 SCHED. DOOR
- 29 COLUMN LINE B2: EXTERIOR METAL PANELS FINISH FACE - A2 OPH
- 30 ALUMINUM SHEET WELD TO FRAME @ BACK OF LOUVERS WHEN LOUVERS NOT USED BY MECHANICAL - RE MECHANICAL
- 31 FLASHING SHEET METAL - POWDERCOATED
- 32 3"x6" STEEL TUBES - WELD TO BEAM - PAINT
- 33 PERFORATED ALUM. SHEET - POWDERCOATED - SECURE TO DECK
- 34 STEEL Z CLIP @ FIREPROOFING - 20 GA.
- 35 STEEL STUD FIX TO Z CLIP
- 36 CONTINUOUS BENT STEEL PLATE - 1/4" THK - WELD TO STRUCTURE
- 37 SSSL COVER @ EXPANSION JOINT: EXTEND 1' UNDER STANDING SEAM ROOF BOTH SIDES
- 38 4" SSSL PIPE - 1/16 THK - WELD TO SSSL GUTTER - CONTINUOUS WELDING - WATER LIGHT
- 39 SSSL GUTTER EXPANSION JOINT @ HIGHEST POINT - RE ROOF PLAN A2.300 FOR LOCATION
- 40 SSSL SHEET - 1/16" THK. MIN - WELD TO GUTTER - WATERLIGHT
- 41 WATERPROOFING MEMBRANE TYPE VYCOR ULTRA FROM GRACE MANUFACTURER OR EQUAL UNDER SSSL GUTTER AND INSIDE 4" DOWNSPOUT - WATERLIGHT CONSTRUCTION
- 42 SLOPED SHIM - RIGID INSULATION BOARD
- 43 SLEEVE @ BASE OF SEPARATION JOINT SSSL SHEET WELDED
- 44 PREFINISHED UC3 STANDING SEAM PANEL
- 45 SHIM
- 46 PREFINISHED J-CHANNEL W/DRIP
- 47 BENT GALVANIZED STEEL PLATE 10 GA - FASTENED TO 1/4" STEEL PLATE
- 48 20" X 4" STEEL TUBE - SUPPORT OF CURTAIN WALL, RE: STRUCTURAL
- 49 STEEL ANGLE FRAME TO SUPPORT STEEL TUBE, RE: STRUCTURAL
- 50 6" STEEL RUNNER.
- 51 4" STEEL COLUMN SUPPORT OF CHANNEL @ SLIDING DOORS.
- 52 CLEARANCE FOR MEP SUPPLIES, RE: MEP
- 53 JAMB OF STAINLESS STEEL DOOR FRAME @ SLIDING DOOR - 16 GA

**HOUSTON AIRPORT SYSTEM**  
GEORGE BUSH  
INTERCONTINENTAL AIRPORT  
HOUSTON TEXAS

**REVISED ARCHITECT**  
REV DE LA REZA ARCHITECTS, INC.  
1452 WEST 18TH ST.  
HOUSTON, TX 77008  
Tel: 713.888.3121  
Tel: 713.882.0112

INTERNATIONAL SERVICES • EXPANSION • PROGRAM  
**APM STATION + PLATFORM**  
PLAN + SECTION DETAILS


PROJECT MGR: HEM  
DESIGNER: SD  
DRAWN BY: SEM  
CHECKED BY: AB  
DRAWING STANDARD: ISEP 07.20.2000  
SCALE: AS NOTED  
DATE: 09/14/01

APPROVED BY: DATE:


PROJECT NO. 1140  
CLIP. NO. A-0364  
H.A.S. NO. 536C  
SHEET NO.

**A8.020**




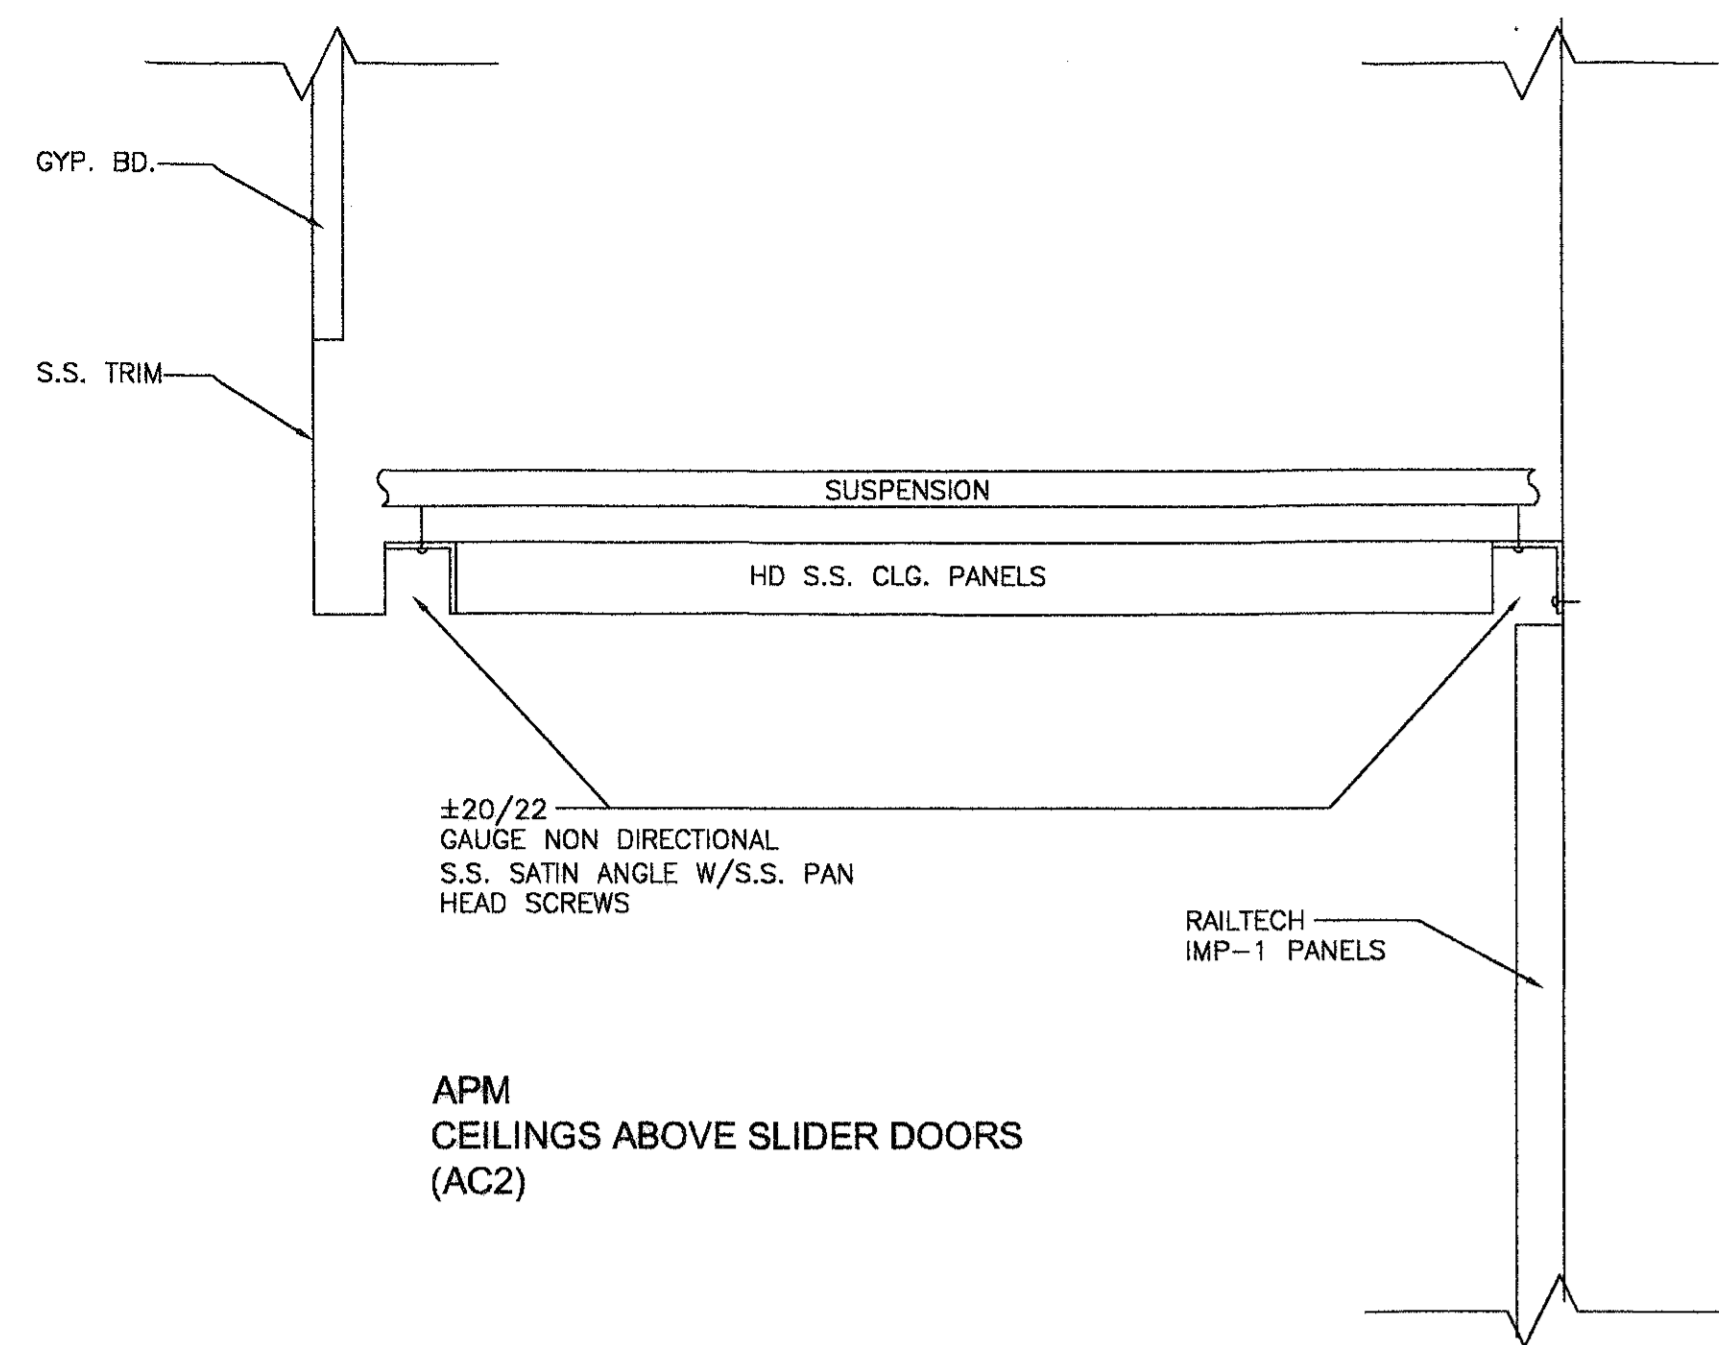

03 RFI 1839 DETAIL  
18.0204 NTS

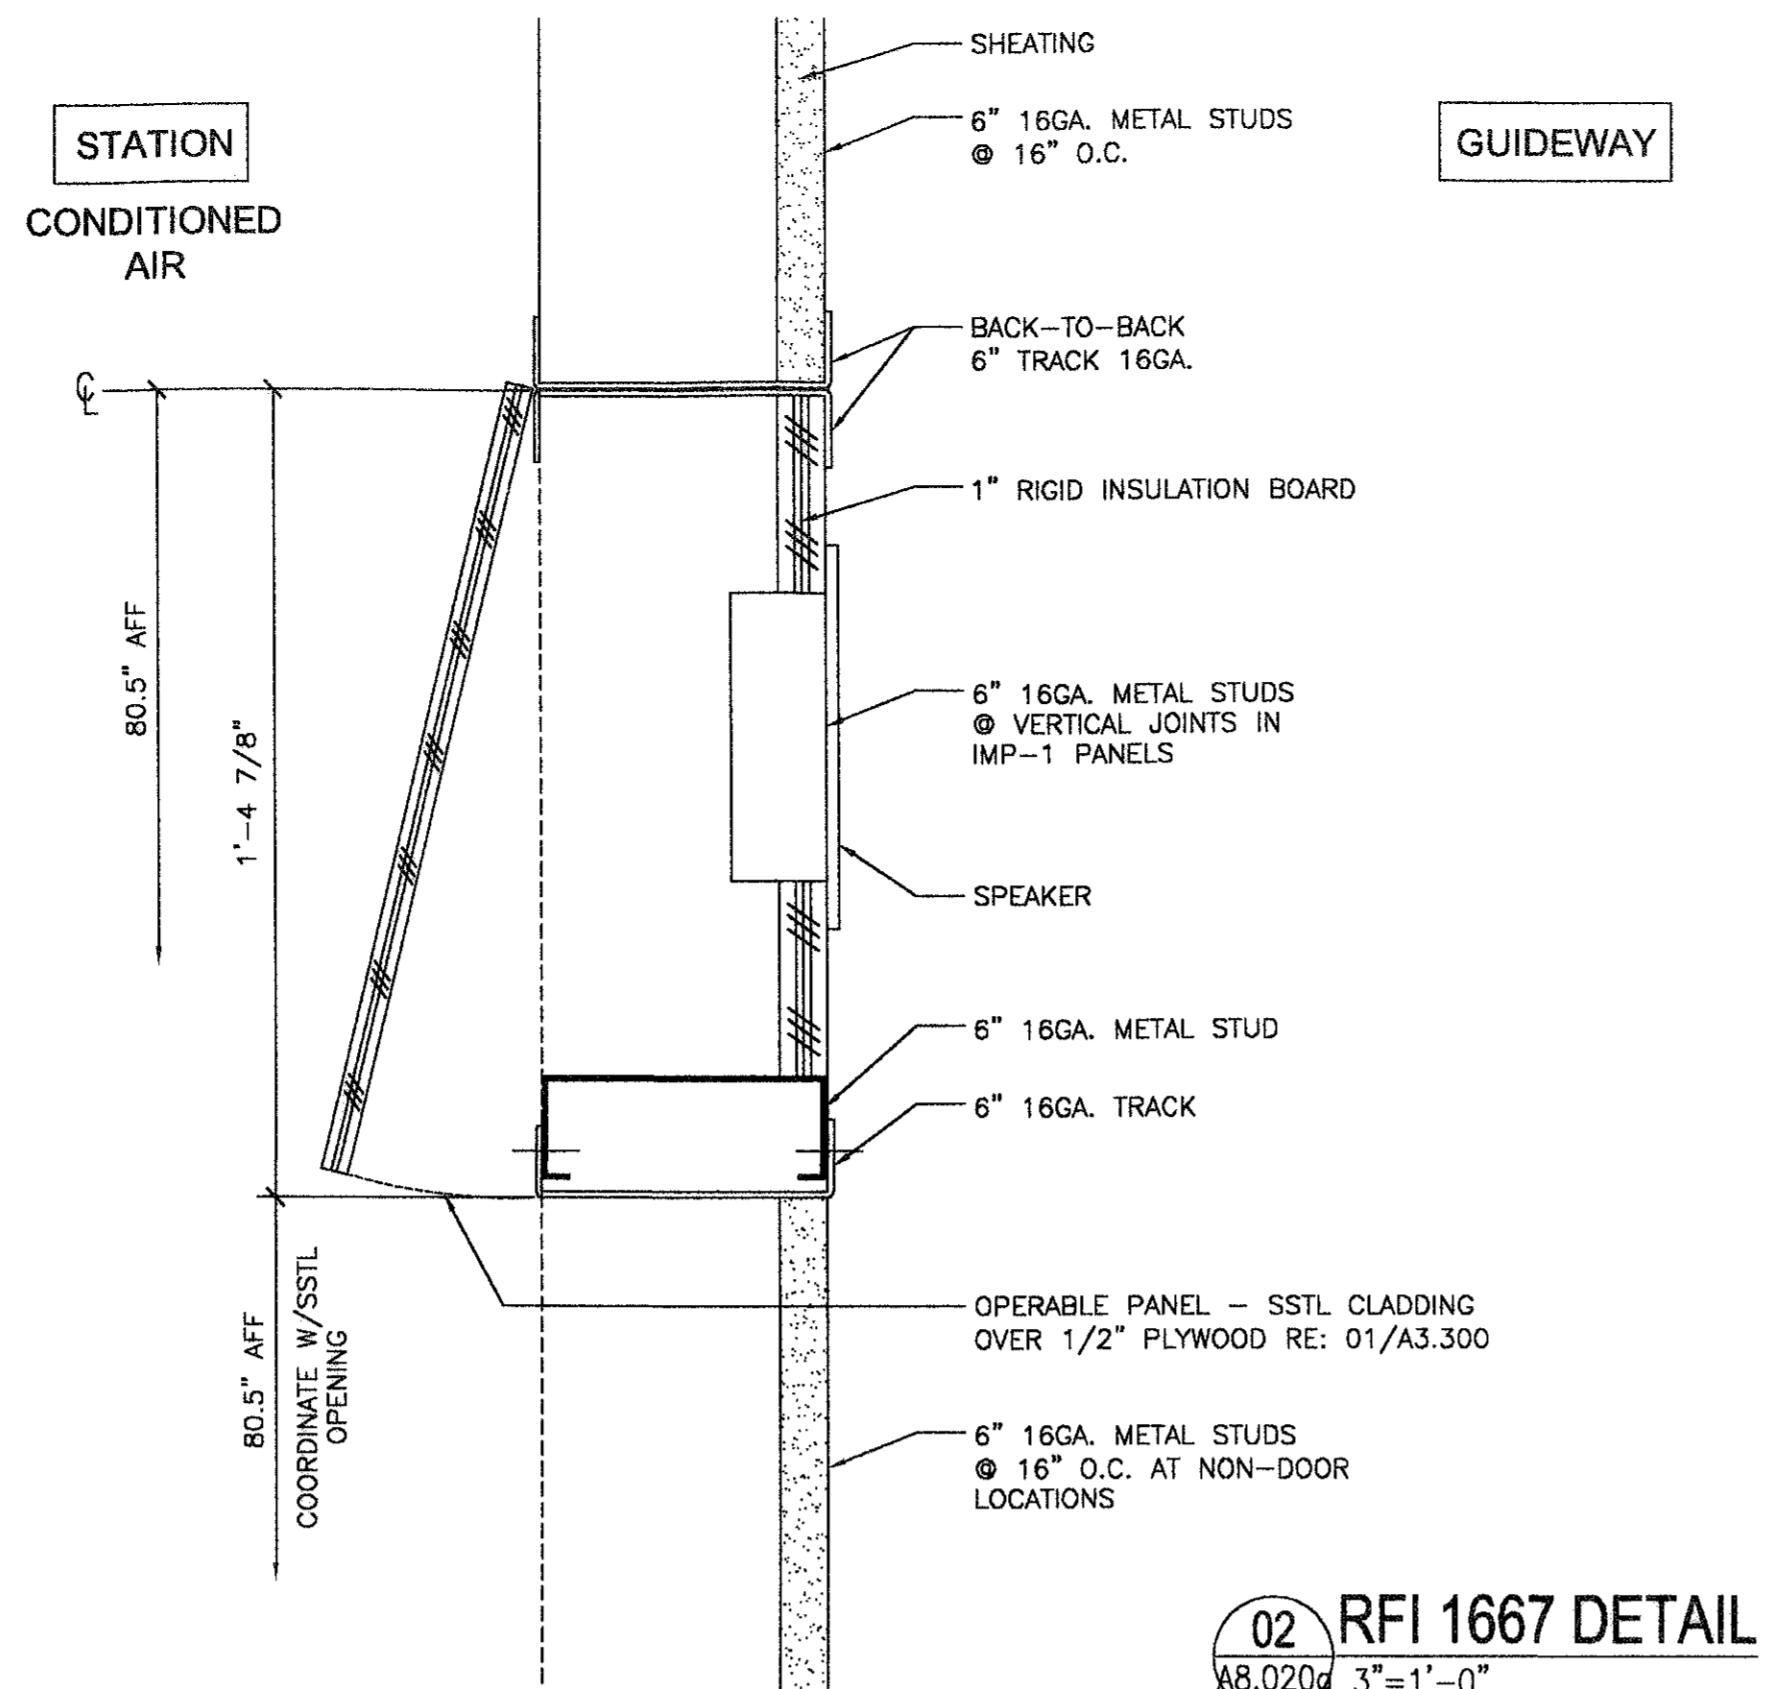

02 RFI 1667 DETAIL  
18.0204 3"=1'-0"

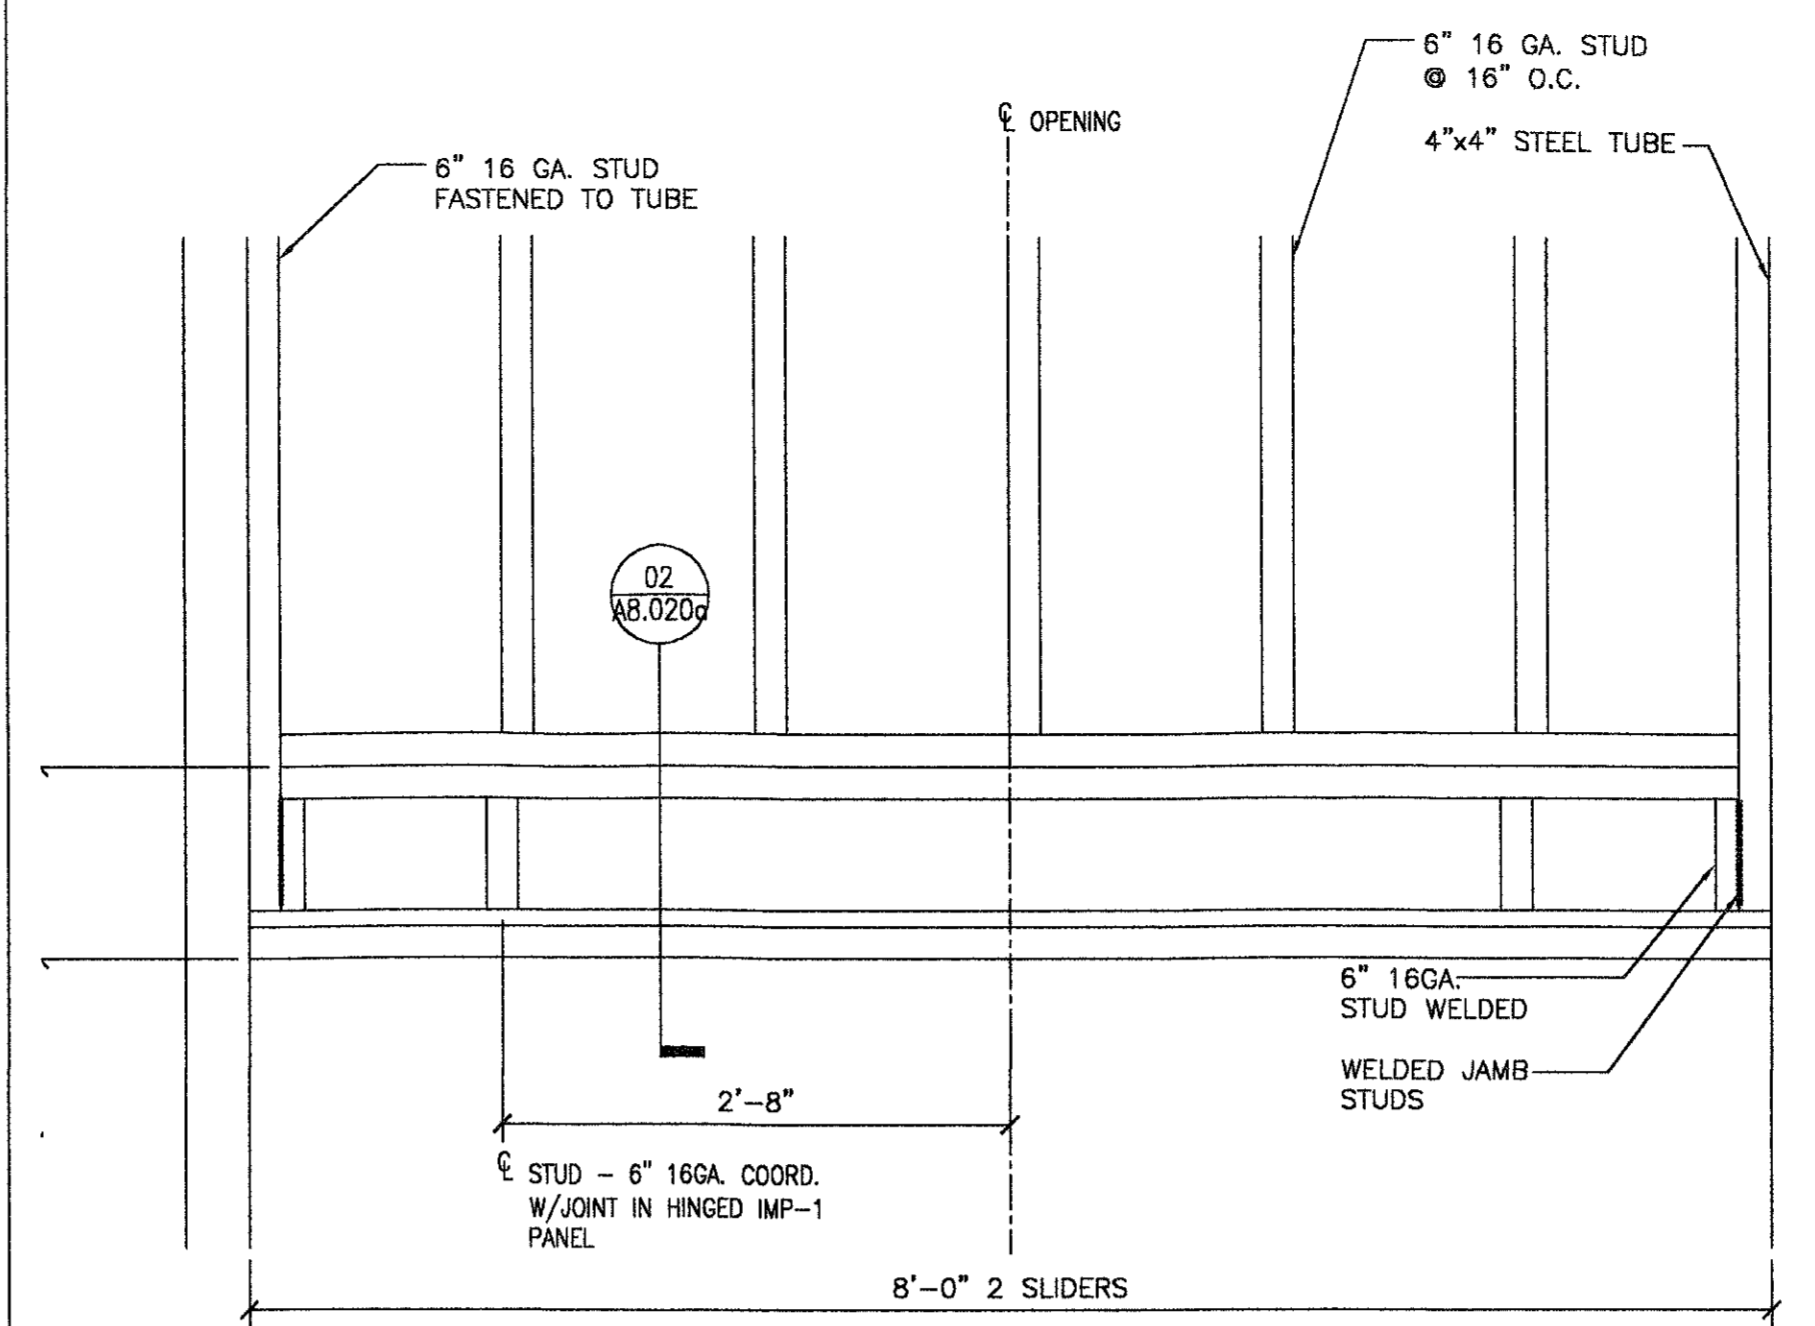

01 RFI 1667 SECTION  
18.0204 1"=1'-0"

GENERAL NOTES:

Houston Airport System  
George Bush  
Intercontinental Airport  
Houston Texas

Lee Elliott  
1000 W. RANDOLPH MILL RD.  
HOUSTON, TX 77062  
Tel: 817.281.1448  
Tel: 817.861.3299


Rey de la Plaza Architects, Inc.  
ARCHITECTS PLANNING INTERIOR DESIGN  
1245 WEST 15TH ST.  
HOUSTON, TX 77008  
Tel: 713.868.3121  
Tel: 713.862.9112

NO.	DESCRIPTION	DATE	BY
ISSUED FOR BID	10/19/01		
RECORD SET	05/13/05	EM	

KEYED NOTES:

INTERNATIONAL • SERVICES • EXPANSION • PROGRAM  
APM STATION + PLATFORM  
RFI RESPONSES

PROJECT MGR:	HEM
DESIGNER:	SG
DRAWN BY:	SEM
CHECKED BY:	AB
DRAWING STANDARD:	18SP 07.22.2000
SCALE:	AS NOTED
DATE:	09/14/01

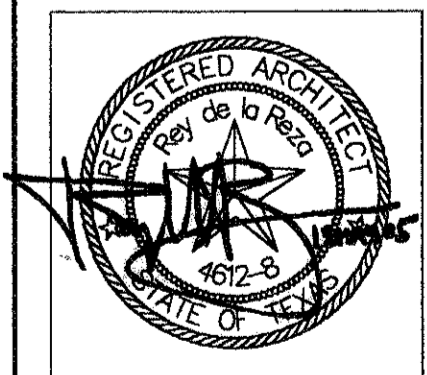


APPROVED BY: DATE:

DIRECTOR  
HOUSTON AIRPORT SYSTEM  
PROJECT NO. 1140  
C.L.P. NO. A-0354  
H.A.S. NO. 5360  
SHEET NO.


**RECORD DRAWINGS**  
DO NOT MODIFY  
Rey de la Plaza Architects, Inc.  
13 May 2005  
Note: Information used to develop these documents was taken from Record of the Work. Drawings prepared by the construction contractor, Clark Construction Group - Texas. The information provided by the contractor was not verified by the design firm named above.

119 A8.020a




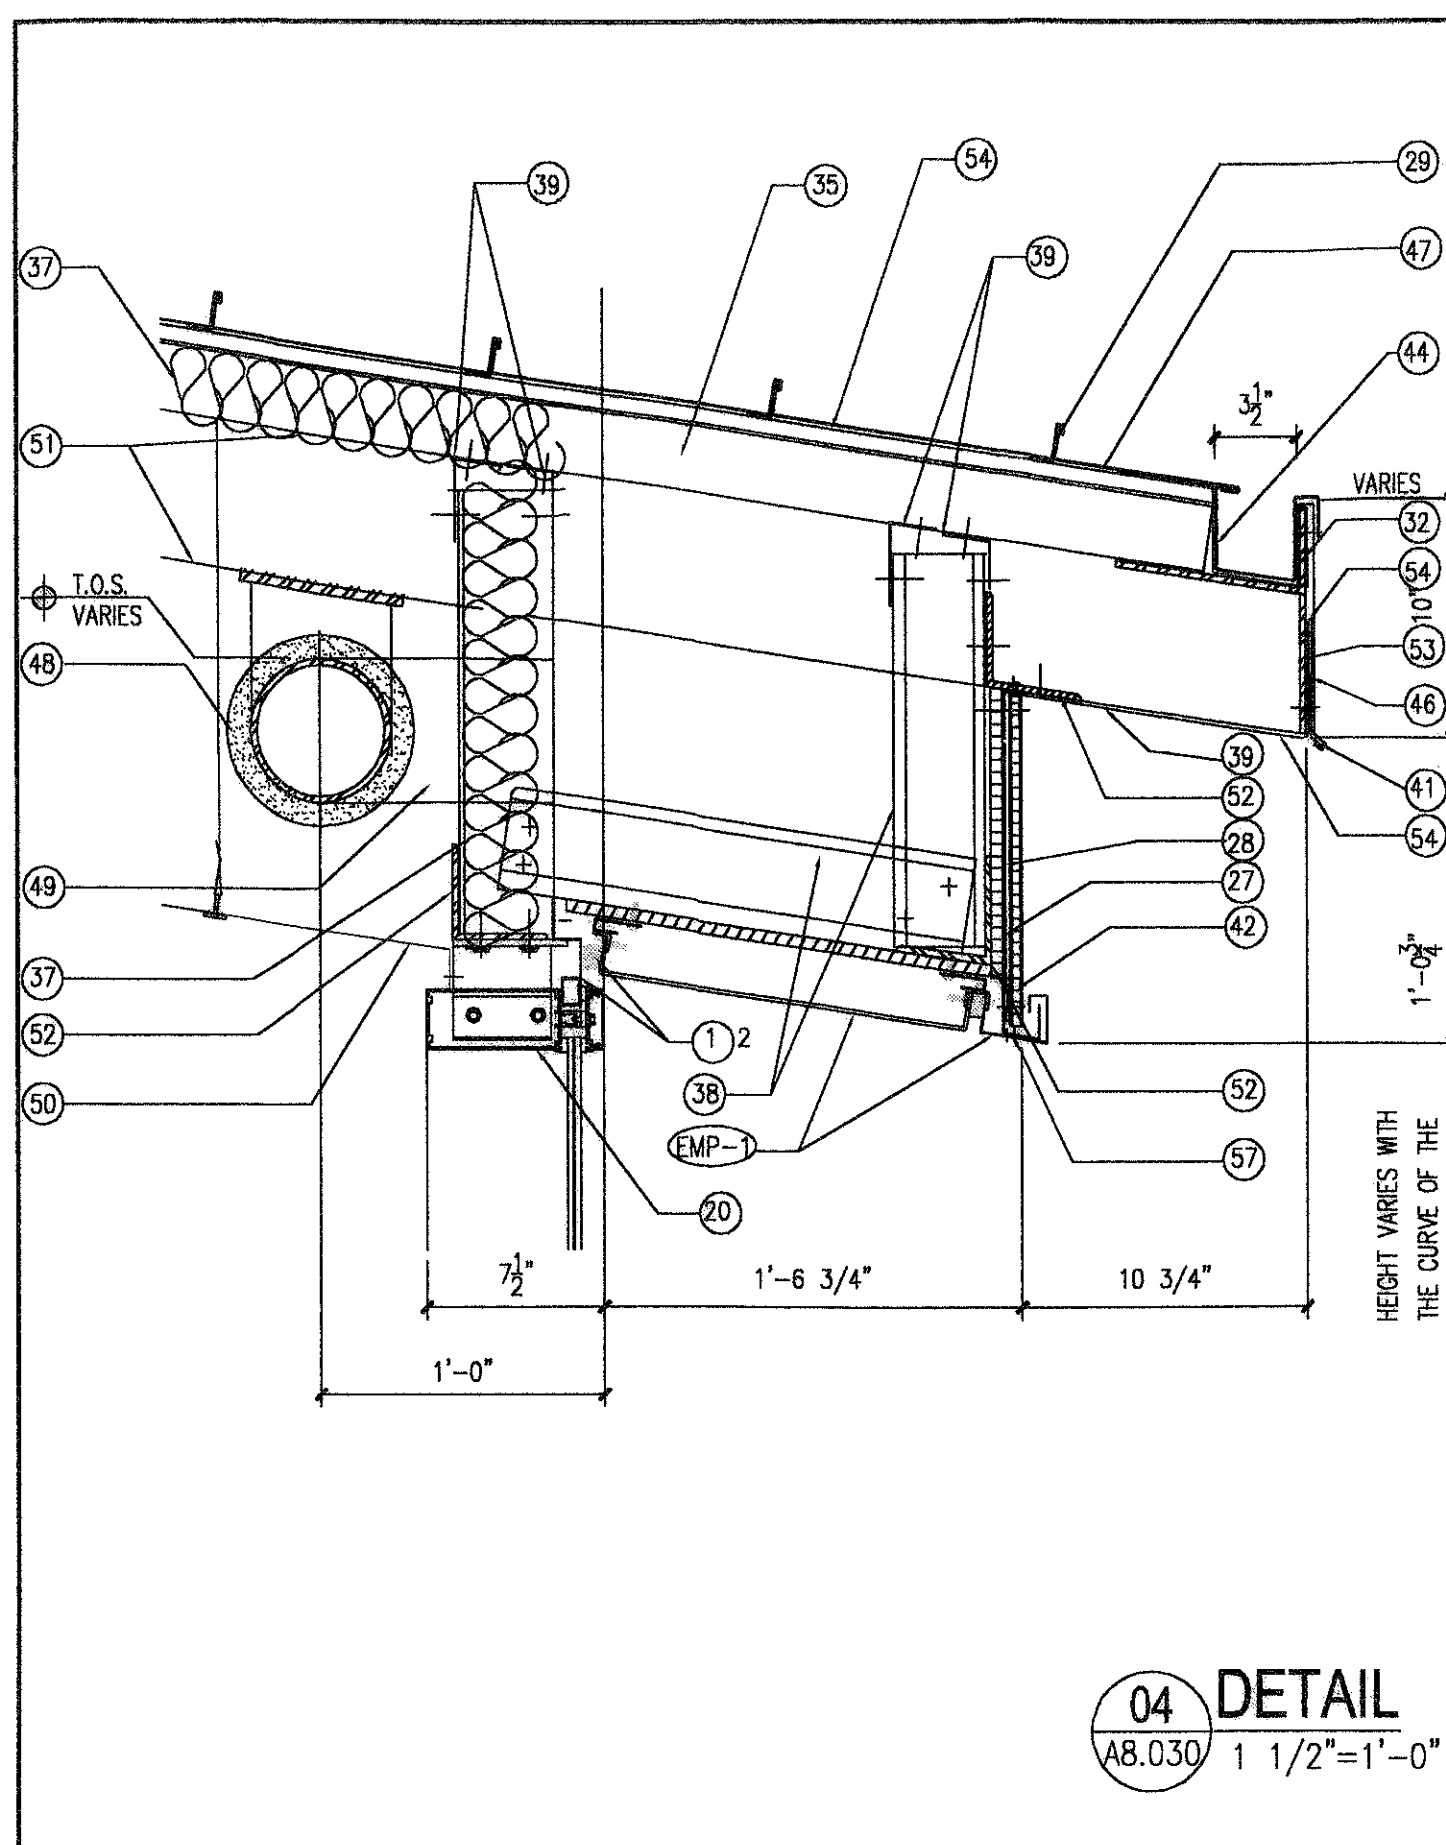


**04 DETAIL**  
A8.030 1 1/2"=1'-0"

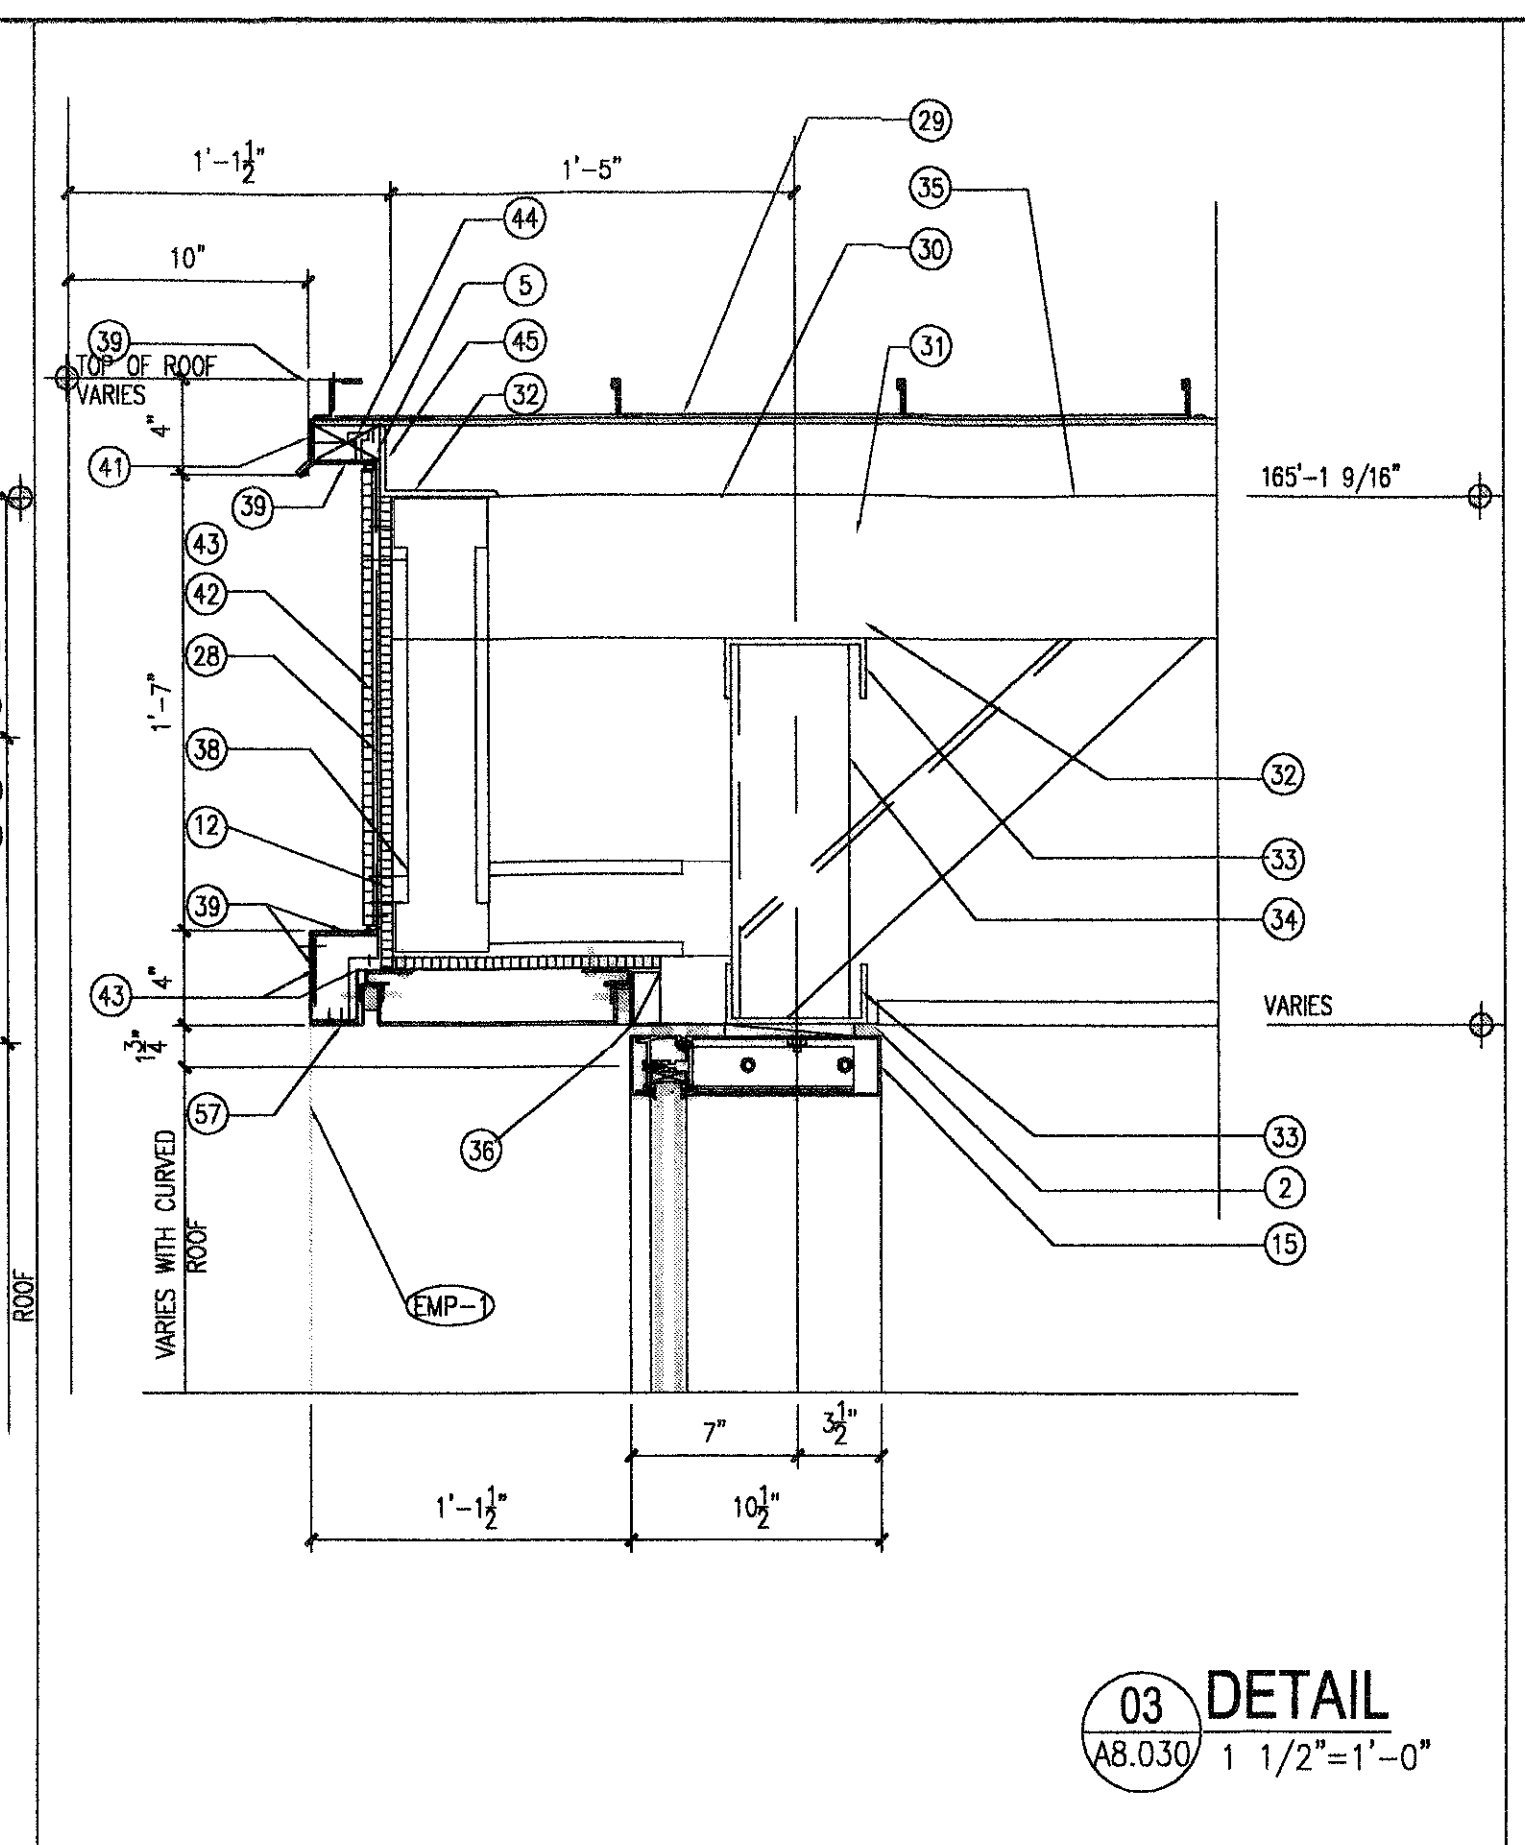


**03 DETAIL**  
A8.030 1 1/2"=1'-0"

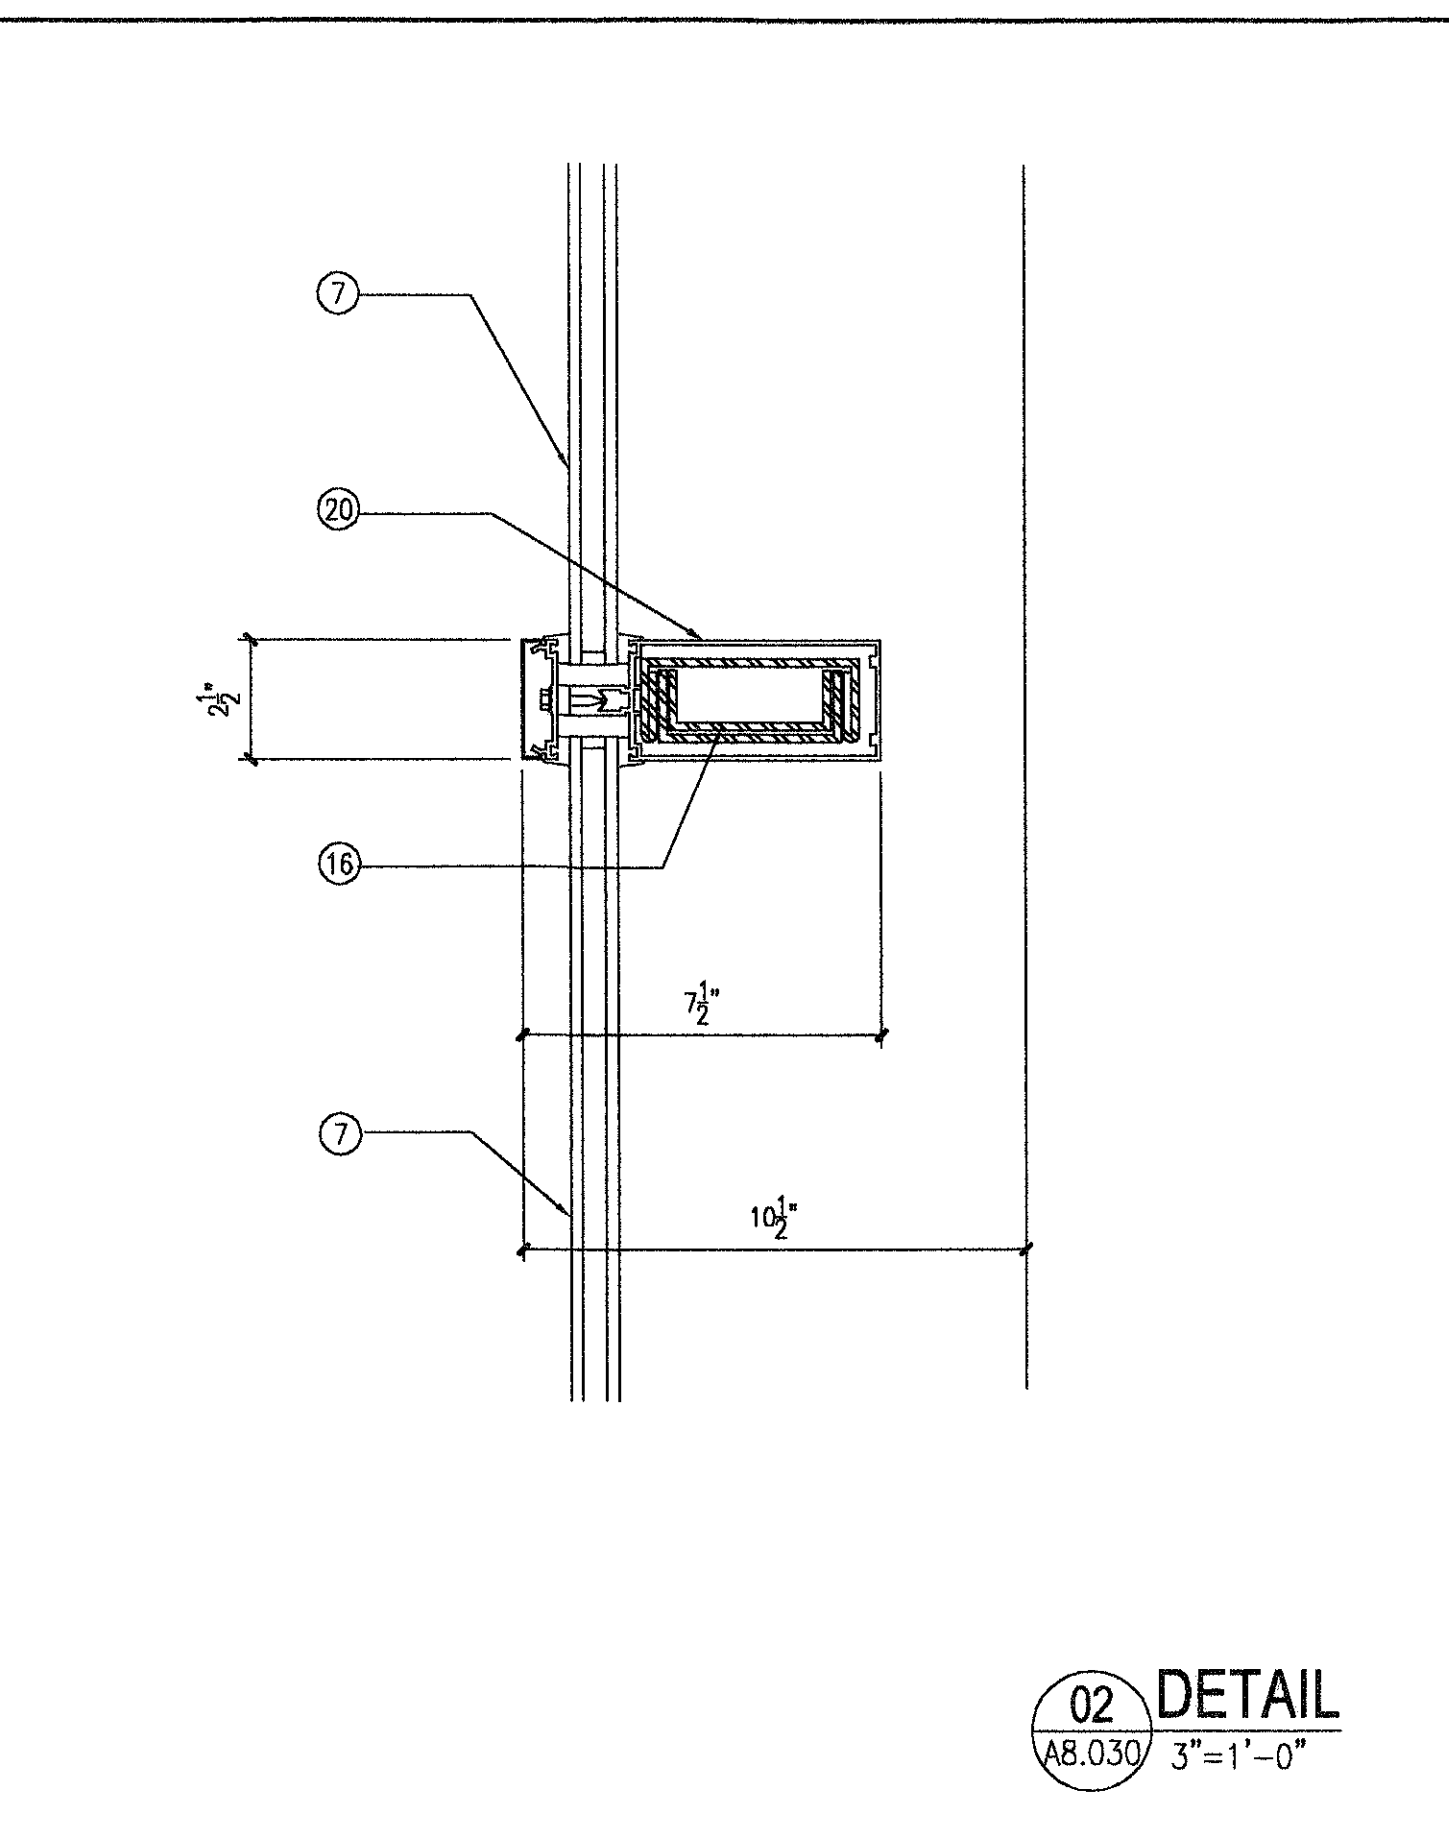


**02 DETAIL**  
A8.030 3"=1'-0"

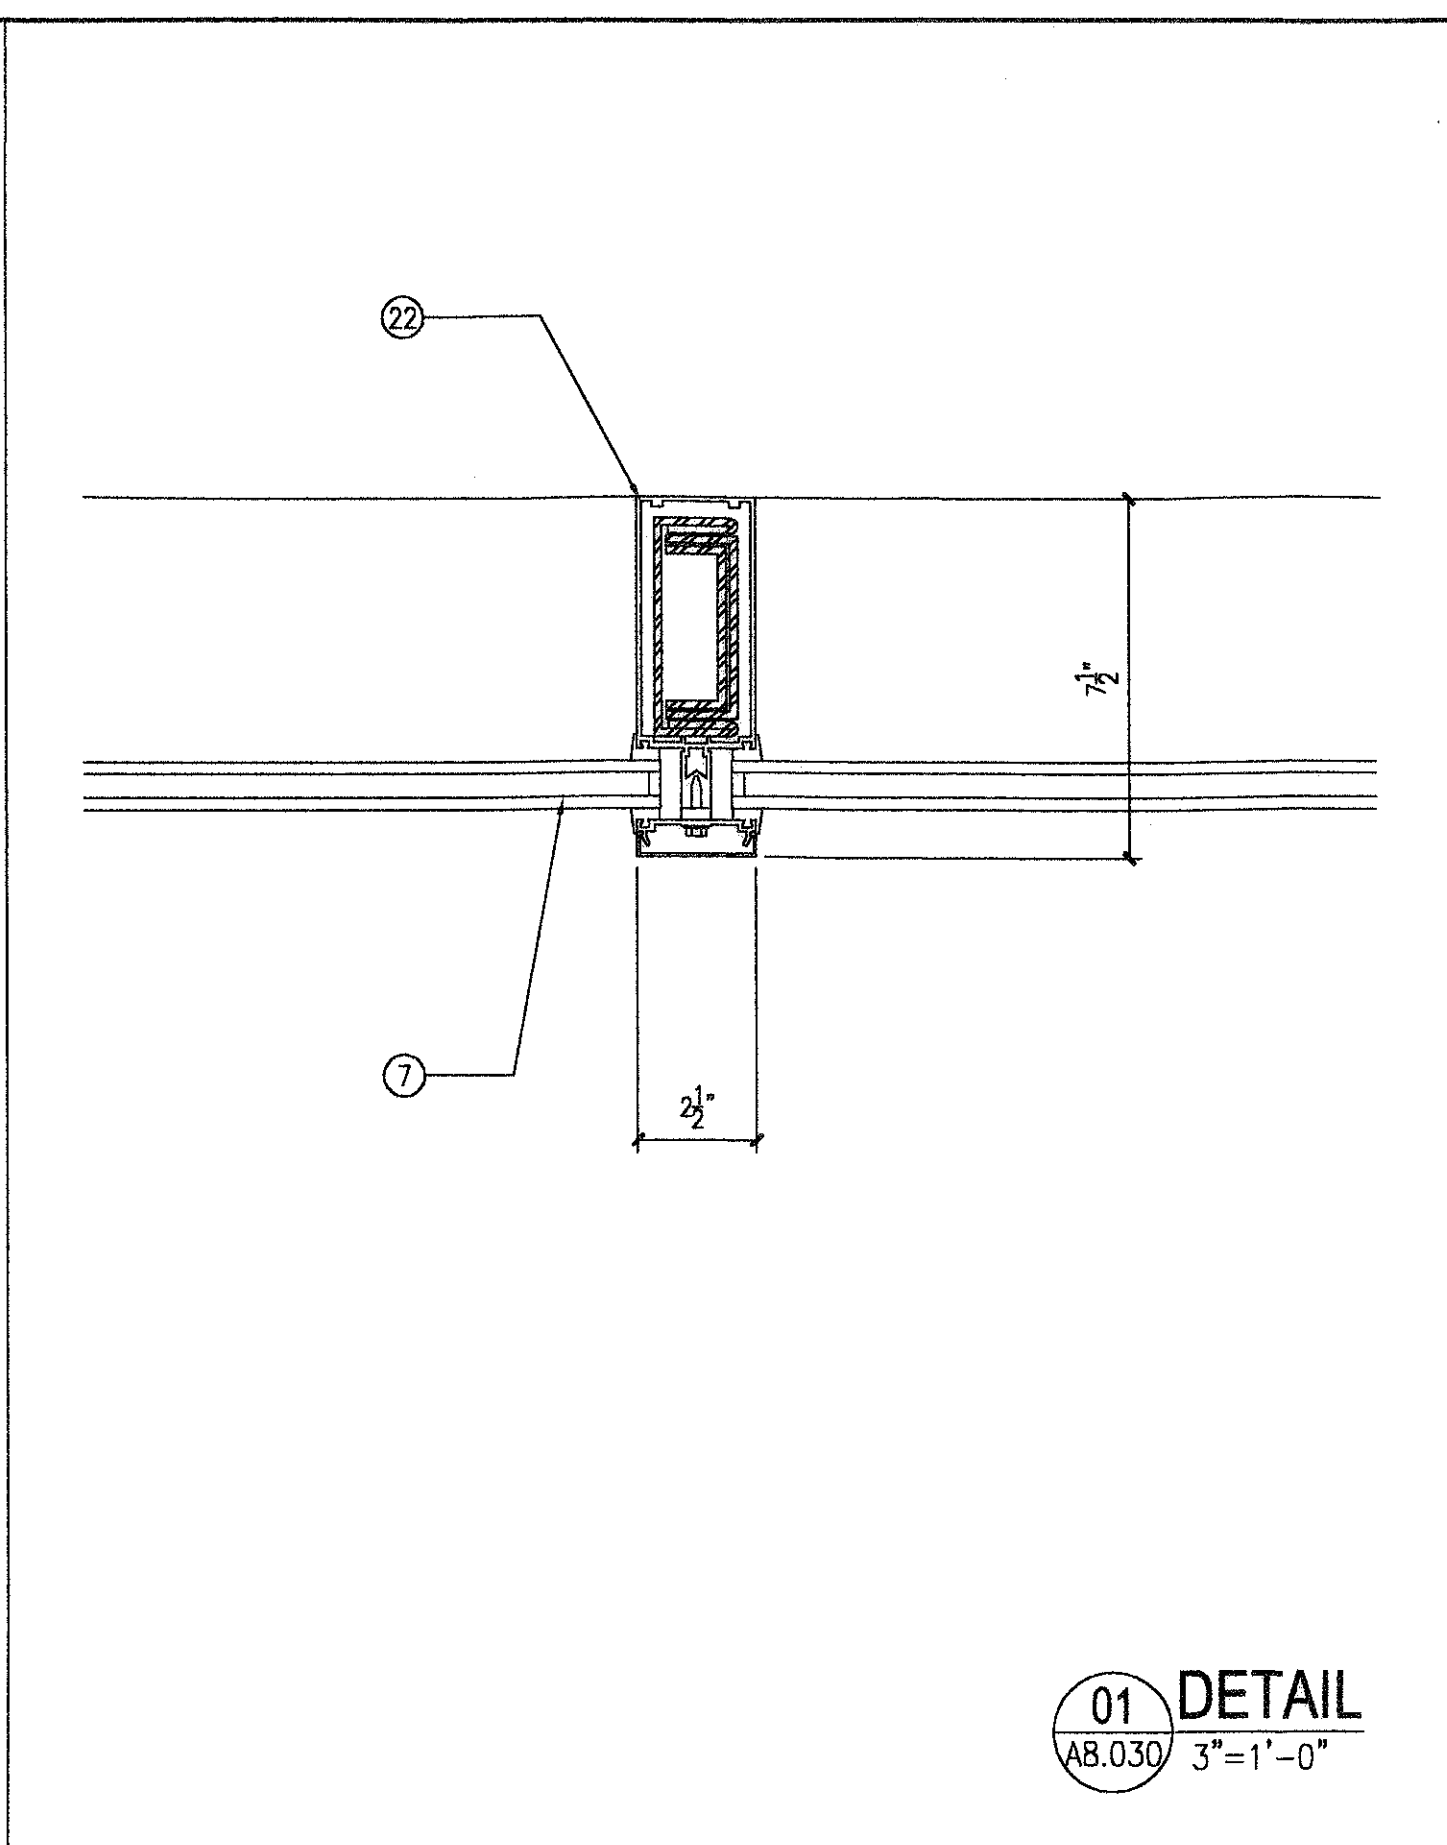


**01 DETAIL**  
A8.030 3"=1'-0"

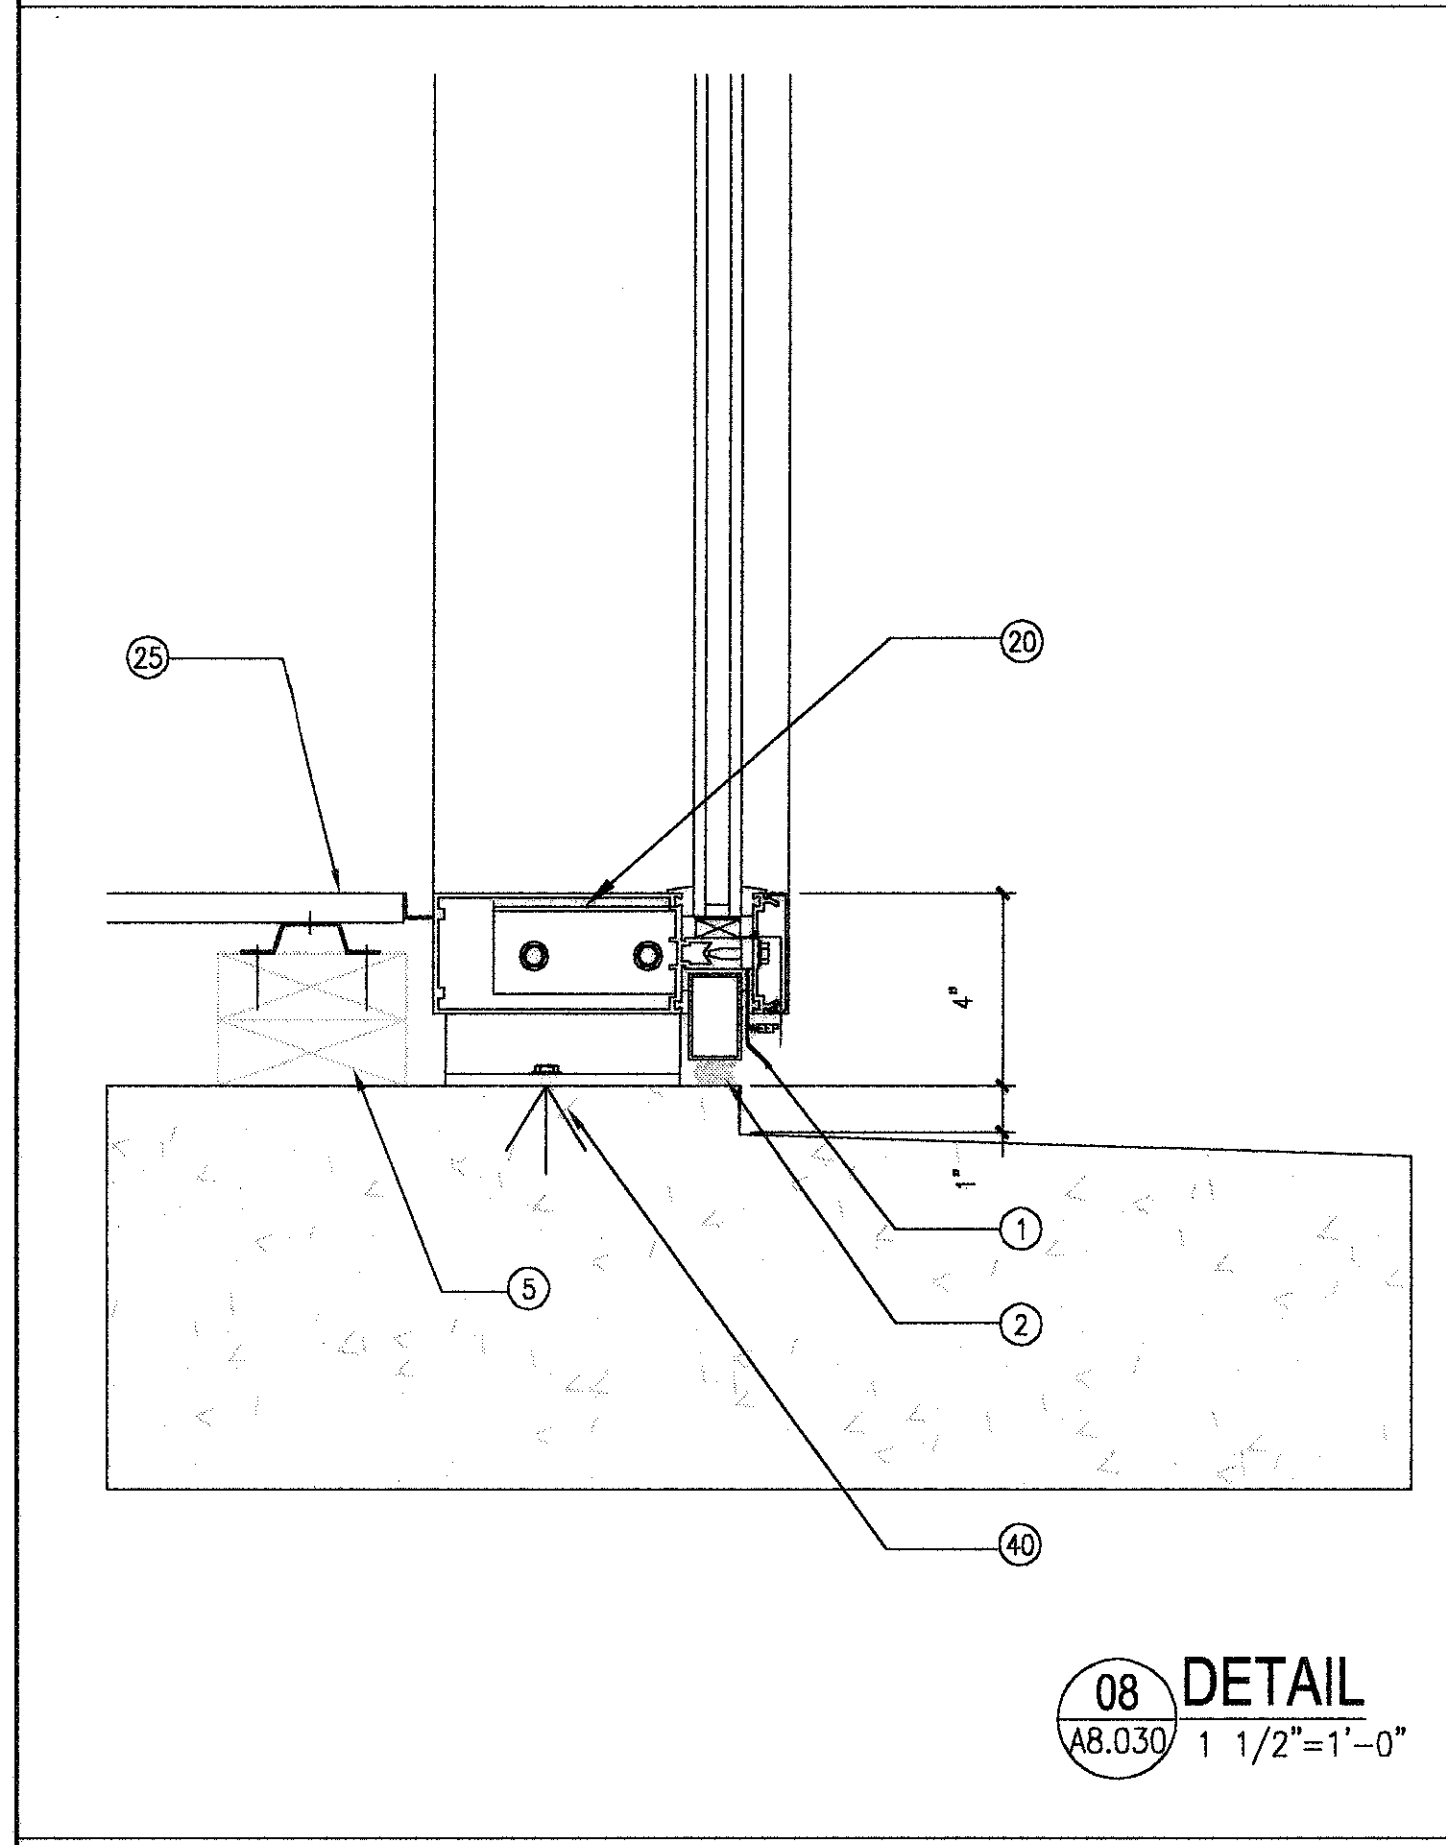


**08 DETAIL**  
A8.030 1 1/2"=1'-0"

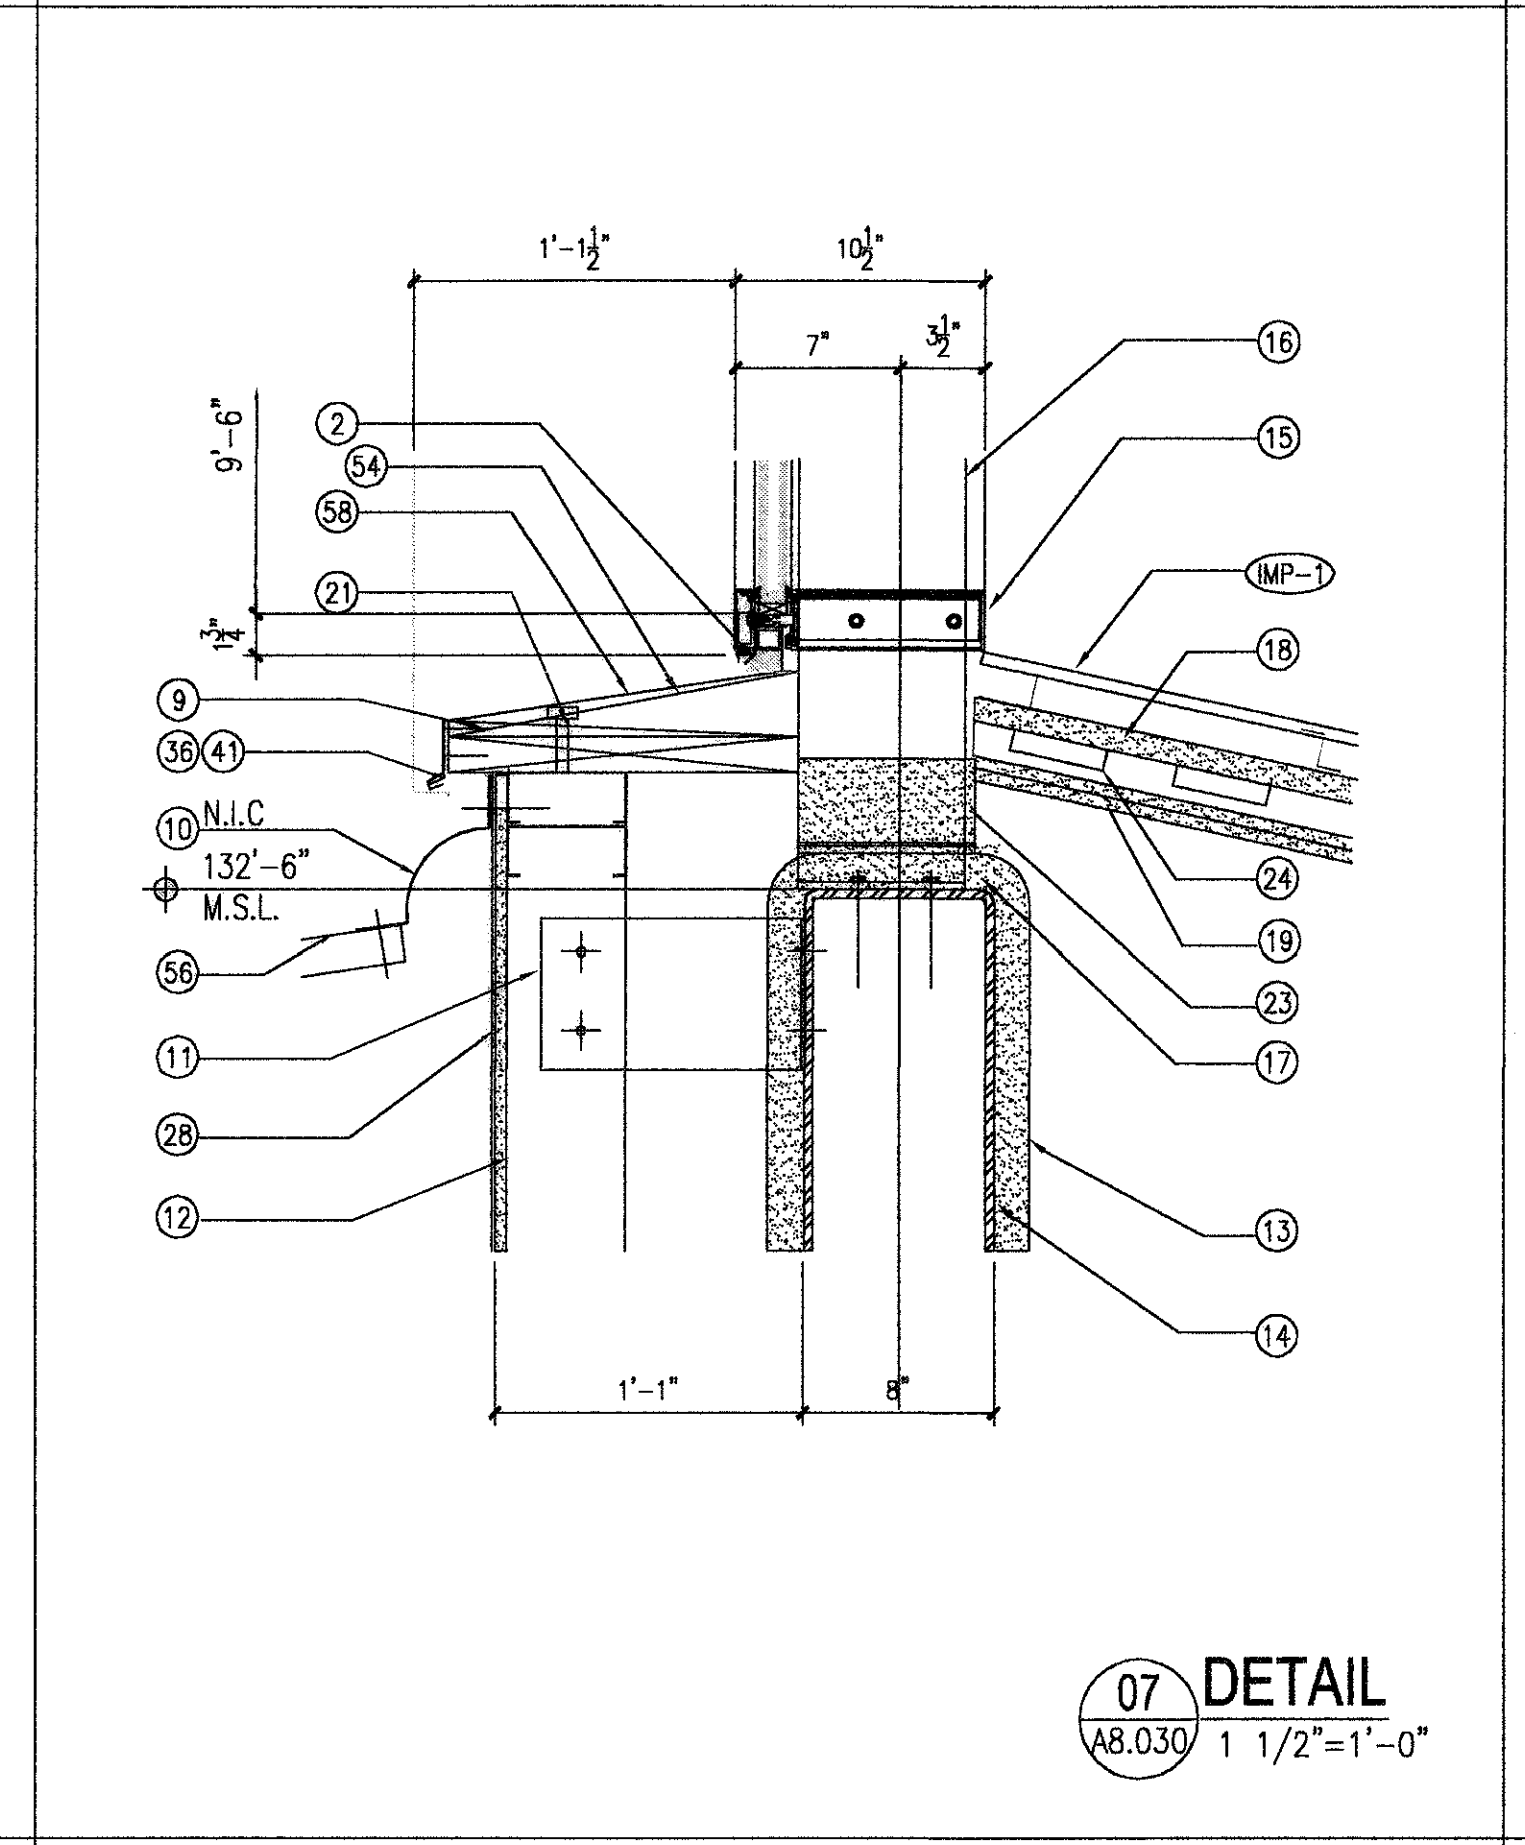

**07 DETAIL**  
A8.030 1 1/2"=1'-0"

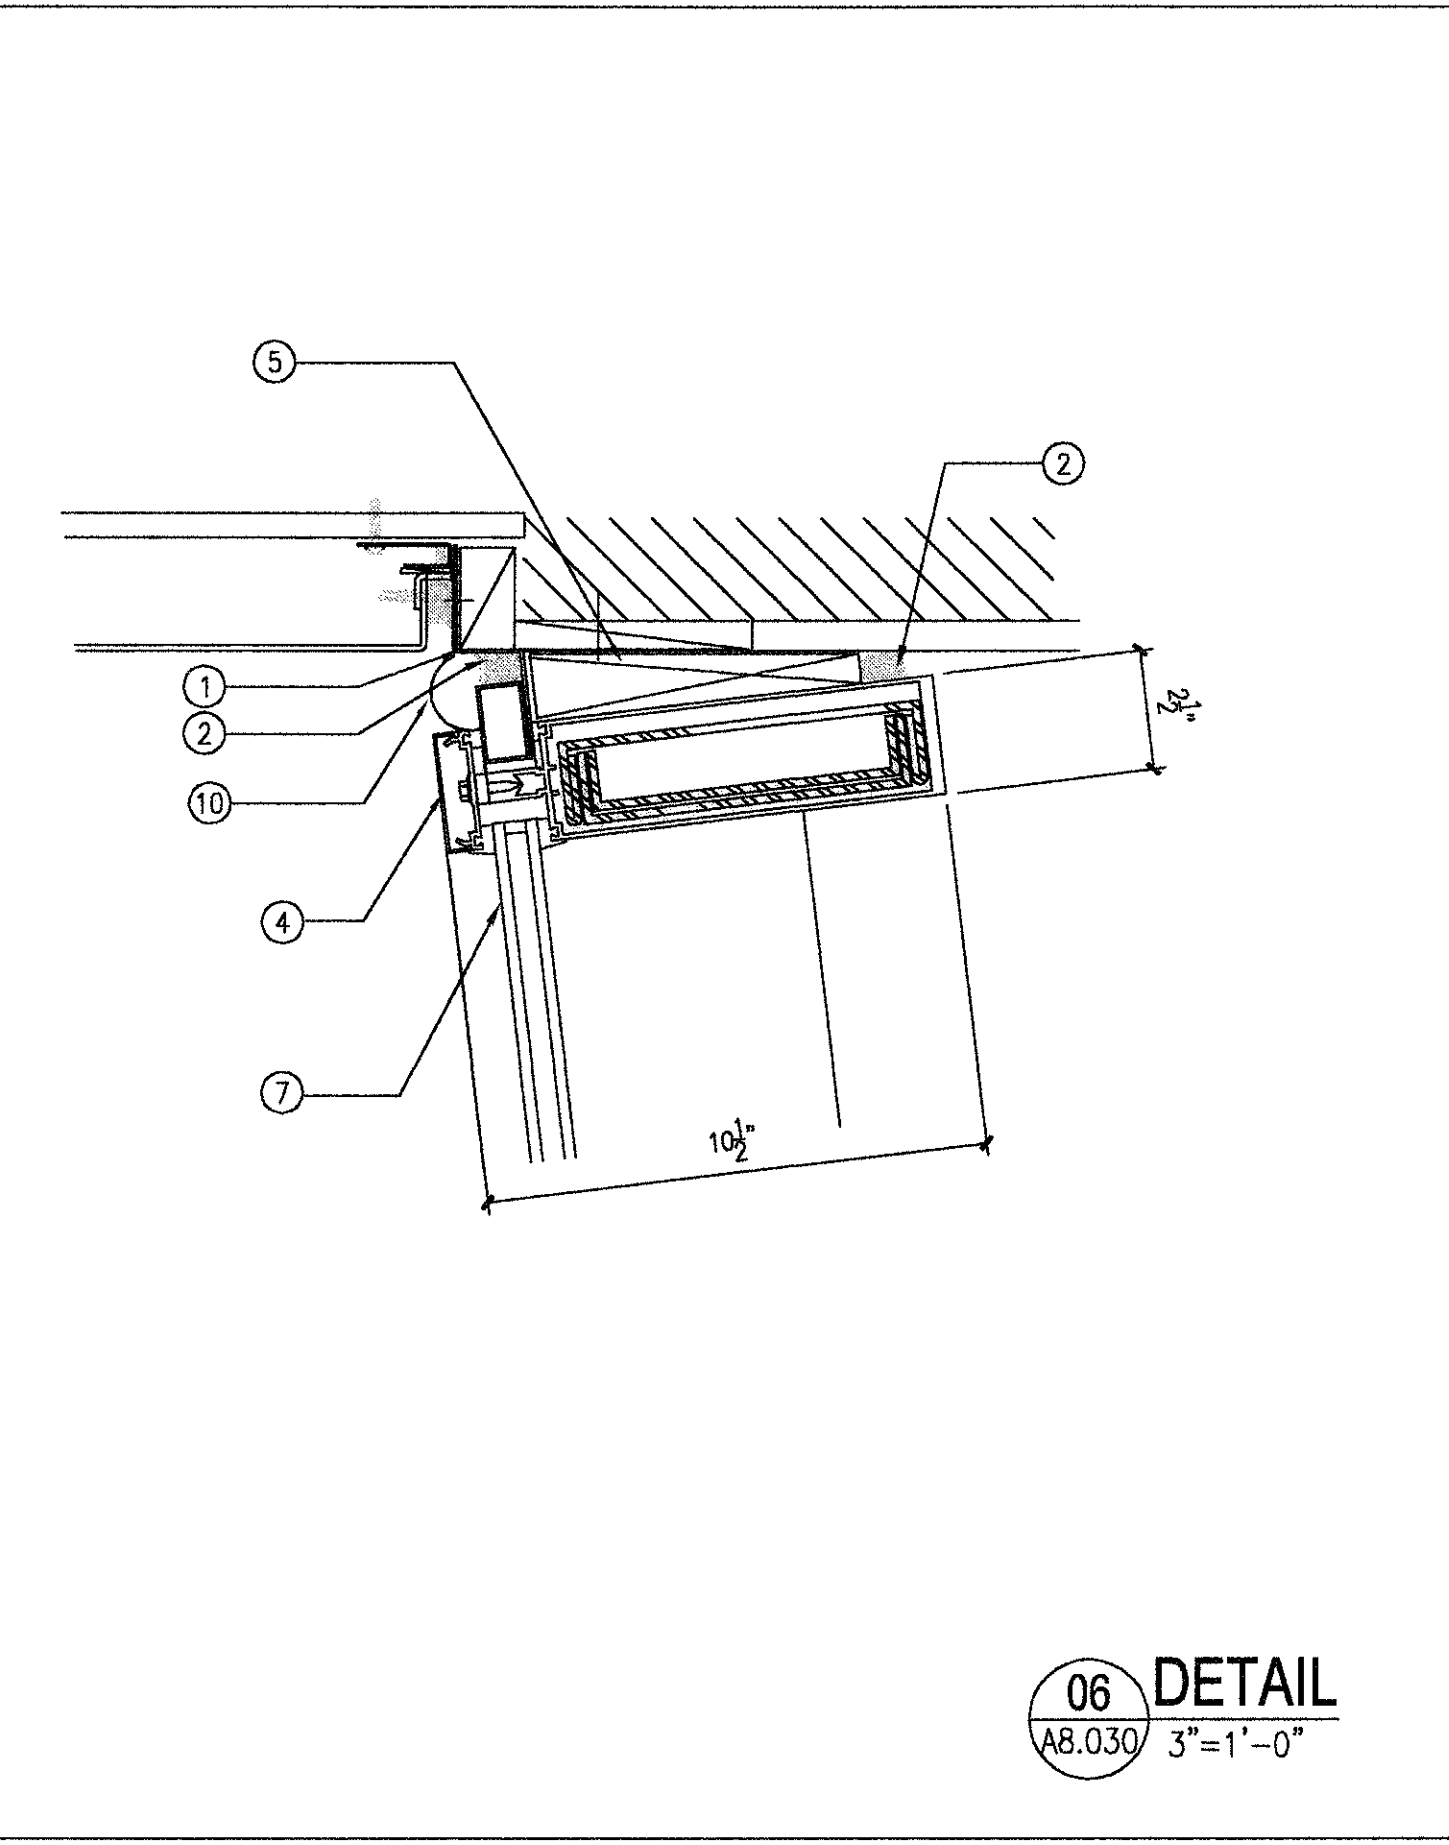


**06 DETAIL**  
A8.030 3"=1'-0"

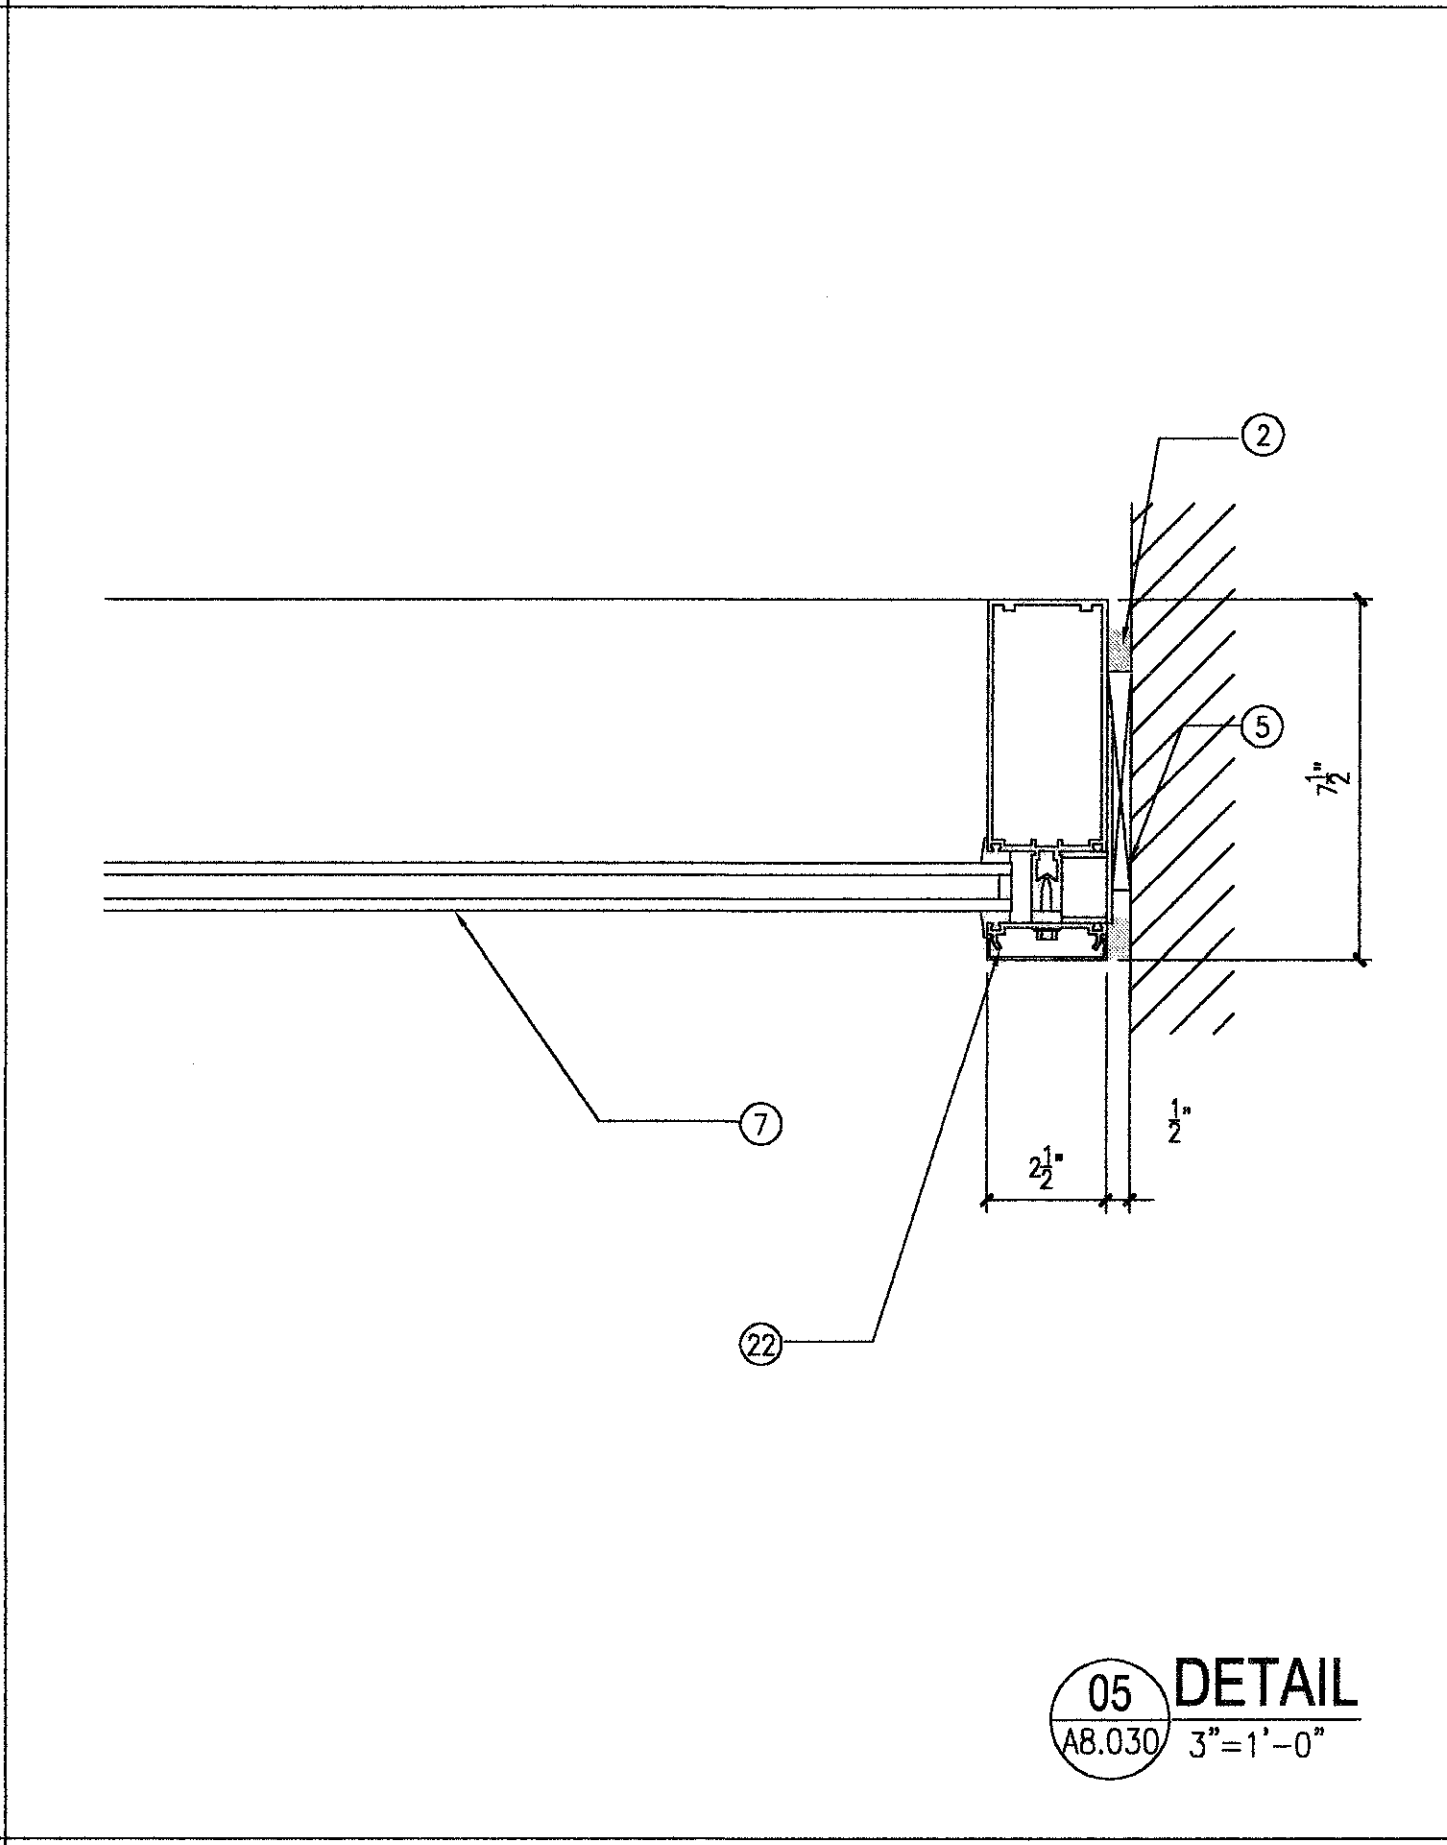

**05 DETAIL**  
A8.030 3"=1'-0"



**10 DETAIL**  
A8.030 3"=1'-0"

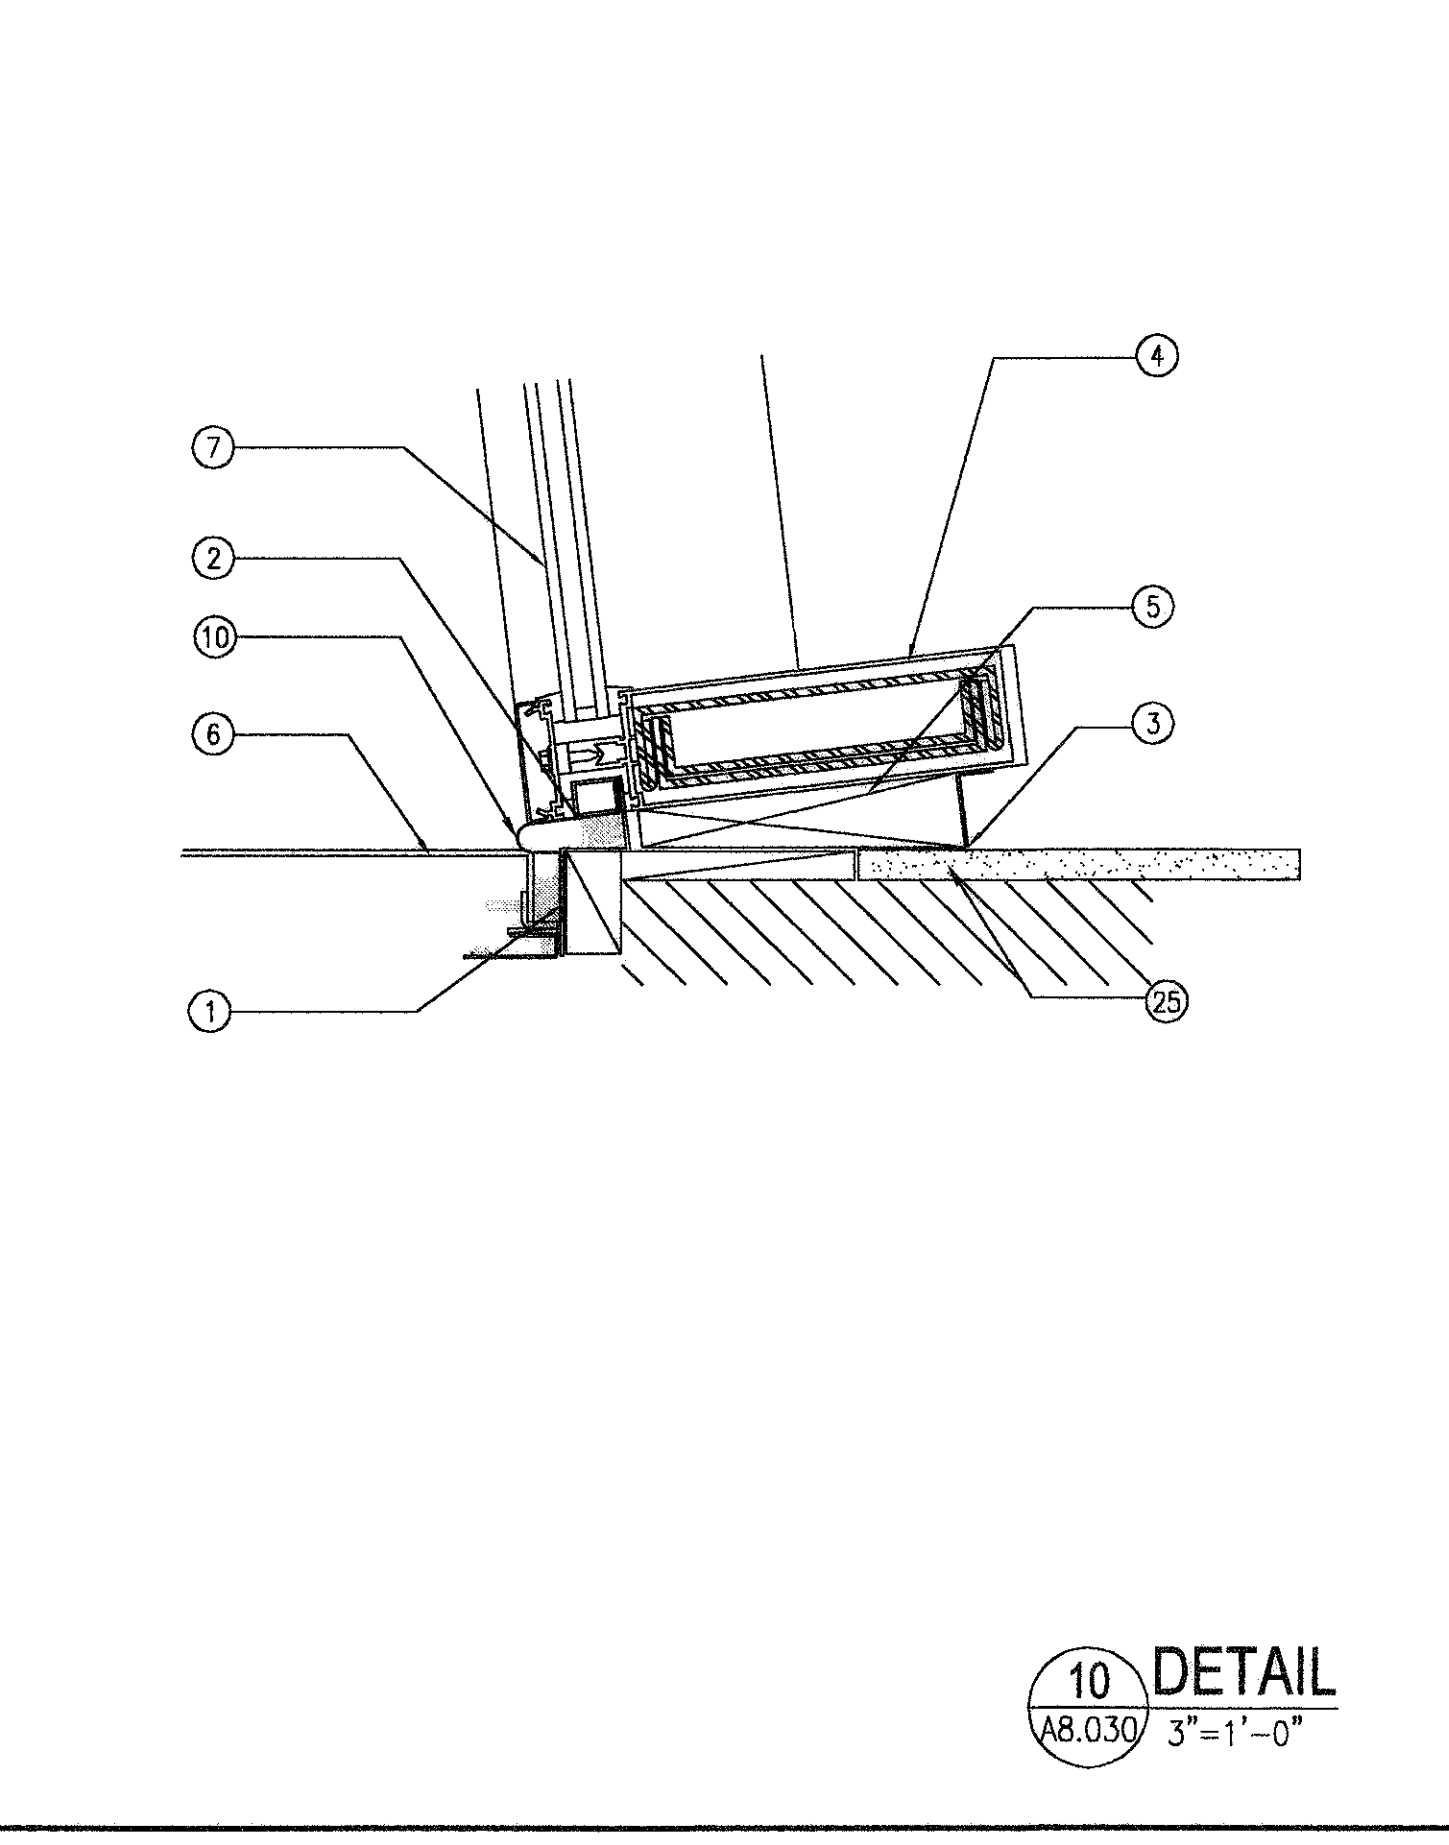

**09 DETAIL**  
A8.030 3"=1'-0"

**GENERAL NOTES:**

- (MP-1) INTERIOR STAINLESS STEEL WALL PANELS - MULTI DIRECTIONAL MACHINE POLISH
- (EMP-2) EXTERIOR POWDERCOATED WALL METAL PANELS - ALUMINUM PANEL 1/8" THICK - TYPE SERIES 3000 MODIFIED FROM UNA-CLAD - COPPER SALES OR EQUAL - POWDERCOATED KYNAR 500

**KEYED NOTES:**


- 1 GALVANIZED SHEETMETAL FLASHING
- 2 SEALANT AND BACKER ROD.
- 3 FIELD CUT ALUMINUM - ADHERED TO SHIM AND MULLION
- 4 VERTICAL MULLION - 2 1/2" X 10 1/2"
- 5 PROVIDE SHIM AS REQUIRED.
- 6 WALL METAL PANELS
- 7 GLASS - REFER SCHEDULE
- 8 6" METAL STUDS @ 24" O.C.
- 9 WOOD NAILED - ADHERE TO RUNNER
- 10 EXPANSION JOINT ASSEMBLY
- 11 6" X 6" X 9" BENT PLATE - FASTEN TO STUD & BEAM @ 24" O.C.
- 12 EXTERIOR SHEATHING
- 13 3 HOUR FIREPROOFING
- 14 STRUCTURAL TUBE SUPPORT
- 15 HORIZONTAL MULLION - 2 1/2" X 10 1/2"
- 16 STEEL REINFORCEMENT AS REQUIRED BY WIND LOADING
- 17 L ANGLE - WELD TO VERTICAL STRUCTURAL STEEL - FASTEN TO STRUCTURAL TUBE
- 18 1" SHAPTLINER
- 19 2 LAYERS OF 1/2" TYPE "X" GYPSUM WALLBOARD
- 20 HORIZONTAL MULLION - 2 1/2" X 7 1/2"
- 21 1/2" DIA. BOLT WELD TO STRUCTURE @ 24" O.C.
- 22 VERTICAL MULLION - 2 1/2" X 7 1/2"
- 23 FIRESTOPPING COMPOUND BETWEEN STRUCTURAL SUPPORT
- 24 1 STUDS @ 24" O.C.
- 25 5/8" GYPSUM BOARD
- 26 8" METAL STUDS @ 24" O.C.
- 27 1/2" EXTERIOR SHEATHING
- 28 VAPOR BARRIER
- 29 STANDING SEAM METAL ROOF
- 30 TUBE STEEL - 6 X 3 X 1/4
- 31 6" DIAMETER PIPE - CURVE BETWEEN TUBE STEEL
- 32 BENT STEEL PLATE 6" X 3" X 1/4"
- 33 CURVE C CHANNEL - 6X13 - WELD TO PLATE ABOVE
- 34 L ANGLE - 5 X 5 X 1/2 @ 24" O.C.
- 35 3" METAL DECK WITH 1 HOUR FIREPROOFING
- 36 DRIP EDGE
- 37 BATT INSULATION
- 38 4" METAL STUDS @ 24" O.C.
- 39 SHEET METAL CLADDING
- 40 ANCHOR STEEL REINFORCEMENT IN MULLION TO CONCRETE SLAB WITH ANCHOR BOLTS AND L ANGLE.
- 41 CONTINUOUS CLEAT TO PREVENT UPLIFT
- 42 HONEYCOMBED ALUMINUM PANEL
- 43 STEEL Z @ ANGLE - CURVE @ ROOF, 1/8" THICK
- 44 GUTTER - SHEET METAL - PREFINISHED - TO JOIN MAIN GUTTER @ EDGE OF ROOF
- 45 CURVE L ANGLE - 3 X 3 X 1/4 - WELD TO STRUCTURE
- 46 SHEETMETAL FASCIA - FASTEN TO BENT PLATE
- 47 5/8" GYP SHEATHING - TYPE X
- 48 6" PIPE WITH 1 HR. FIREPROOFING
- 49 STEEL PLATE - 1/4" THICK WELD TO PIPE BEAM AND STUD TO TRANSFER LATERAL LOAD
- 50 SCHEDULED CEILING
- 51 TS 6 X 3 X 1/4
- 52 CONTINUOUS L ANGLE - 4 X 4 X 1/4
- 53 1/4" THICK CAP PLATE CURVED - WELD TO 6" BEAM
- 54 WATERPROOFING MEMBRANE TYPE VYCOR ULTRA FROM GRACE MANUFACTURER OR EQUAL
- 55 MECHANICAL LOUVER SET INSIDE MULLION
- 56 ROOF ASSEMBLY AT BRIDGE - SEE F.I.S. BUILDING PACKAGE FOR MORE INFORMATION. 500 F-1
- 57 1/4" DIA. WEEP HOLES @ 36" O.C.
- 58 SHEET METAL FLASHING WATERTIGHT - POWDERCOATED

**RECORD DRAWINGS**

DO NOT MODIFY  
Ray de la Reza Architects, Inc.  
13 May 2005

Note: Information used to develop these documents was taken from Record of the Work Drawings prepared by the contribution contractor, Clark Construction Group - Texas. The information provided by the contractor was not verified by the design firm named above.

NOTE: REFER TO GRAPHIC SCALE IF ACTUAL SHEET SIZE IS OTHER THAN 30"x42".

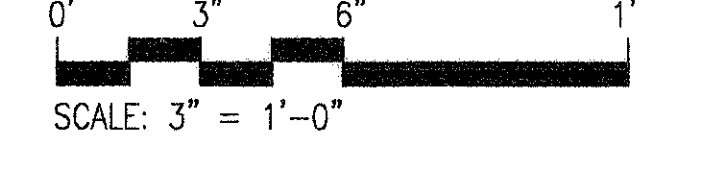

**Houston Airport System**  
GEORGE BUSH  
INTERCONTINENTAL AIRPORT  
HOUSTON TEXAS

**Lea + Elliott**  
1009 W RANDOLPH MILL RD  
HOUSTON, TEXAS  
Tel: 817.281.1462  
Tel: 817.881.3258

**REY DE LA REZA ARCHITECTS, INC.**  
1242 WEST 19TH ST.  
HOUSTON, TX 77008  
Tel: 713.888.3121  
Tel: 713.802.9112

**REVISIONS**

NO.	DESCRIPTION	DATE	BY
1	ISSUED FOR BID	10/19/01	
2	RECORD SET	05/13/05	EM

**INTERNATIONAL SERVICES • EXPANSION PROGRAM**

**APM STATION + PLATFORM**

**CURTAIN WALL DETAILS**

PROJECT MOR: MEM  
DESIGNER: SG  
DRAWN BY: SEM  
CHECKED BY: AB  
DRAWING STANDARD: ISEP 07.00.2000  
SCALE: 3"=1'-0"  
DATE: 09/14/01


**REGISTERED ARCHITECT**  
STATE OF TEXAS

APPROVED BY: \_\_\_\_\_ DATE: \_\_\_\_\_  
DIRECTOR  
HOUSTON AIRPORT SYSTEM


PROJECT NO. \_\_\_\_\_  
CLIP. NO. \_\_\_\_\_  
H.A.S. NO. \_\_\_\_\_  
SHEET NO. \_\_\_\_\_

**A8.030**




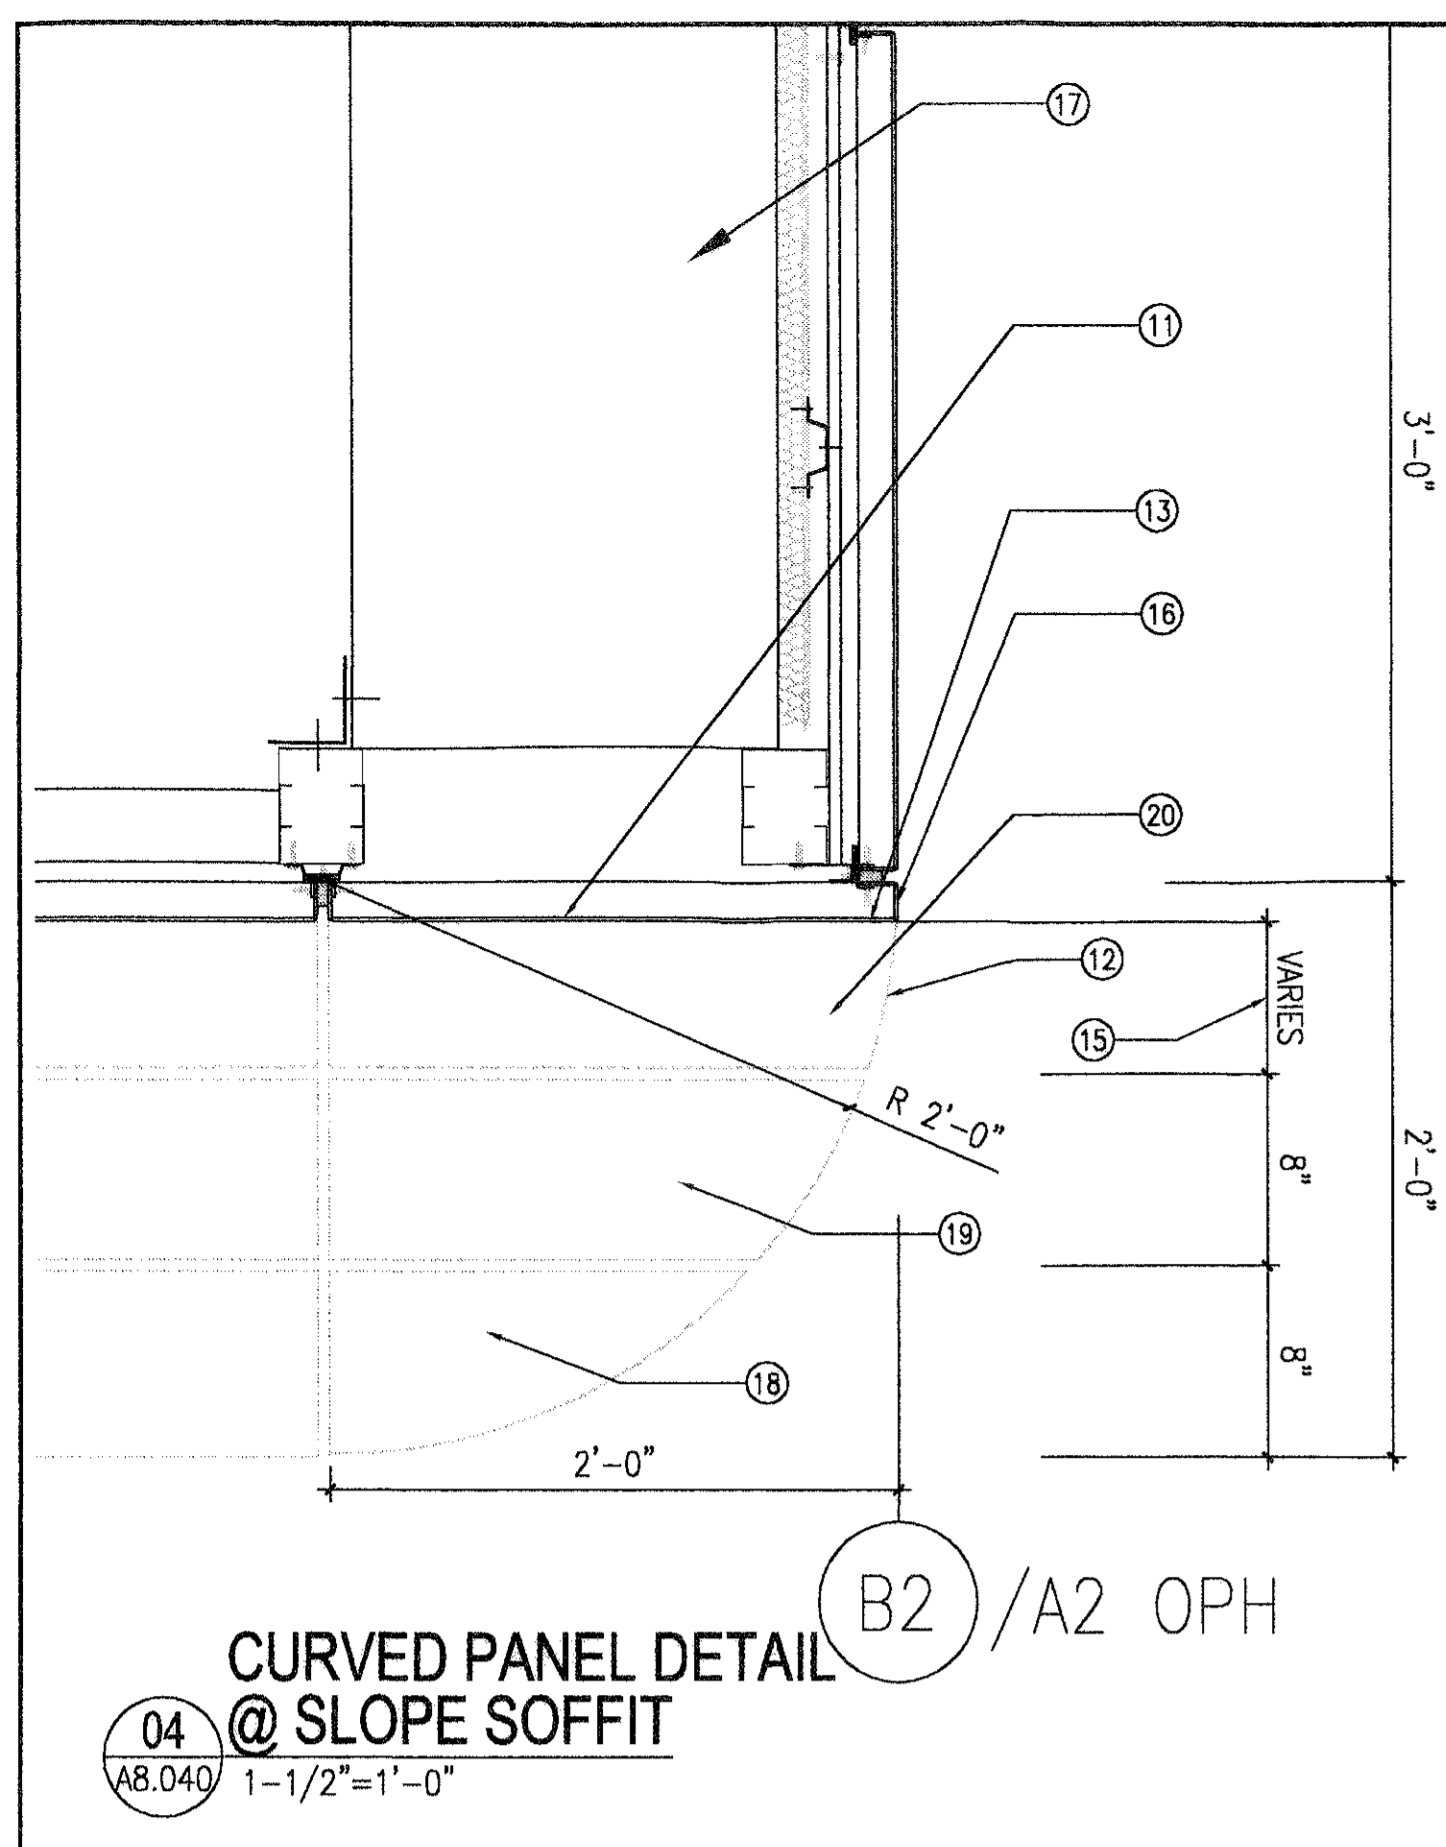


**04** CURVED PANEL DETAIL  
@ SLOPE SOFFIT  
AB.040 1-1/2"=1'-0"

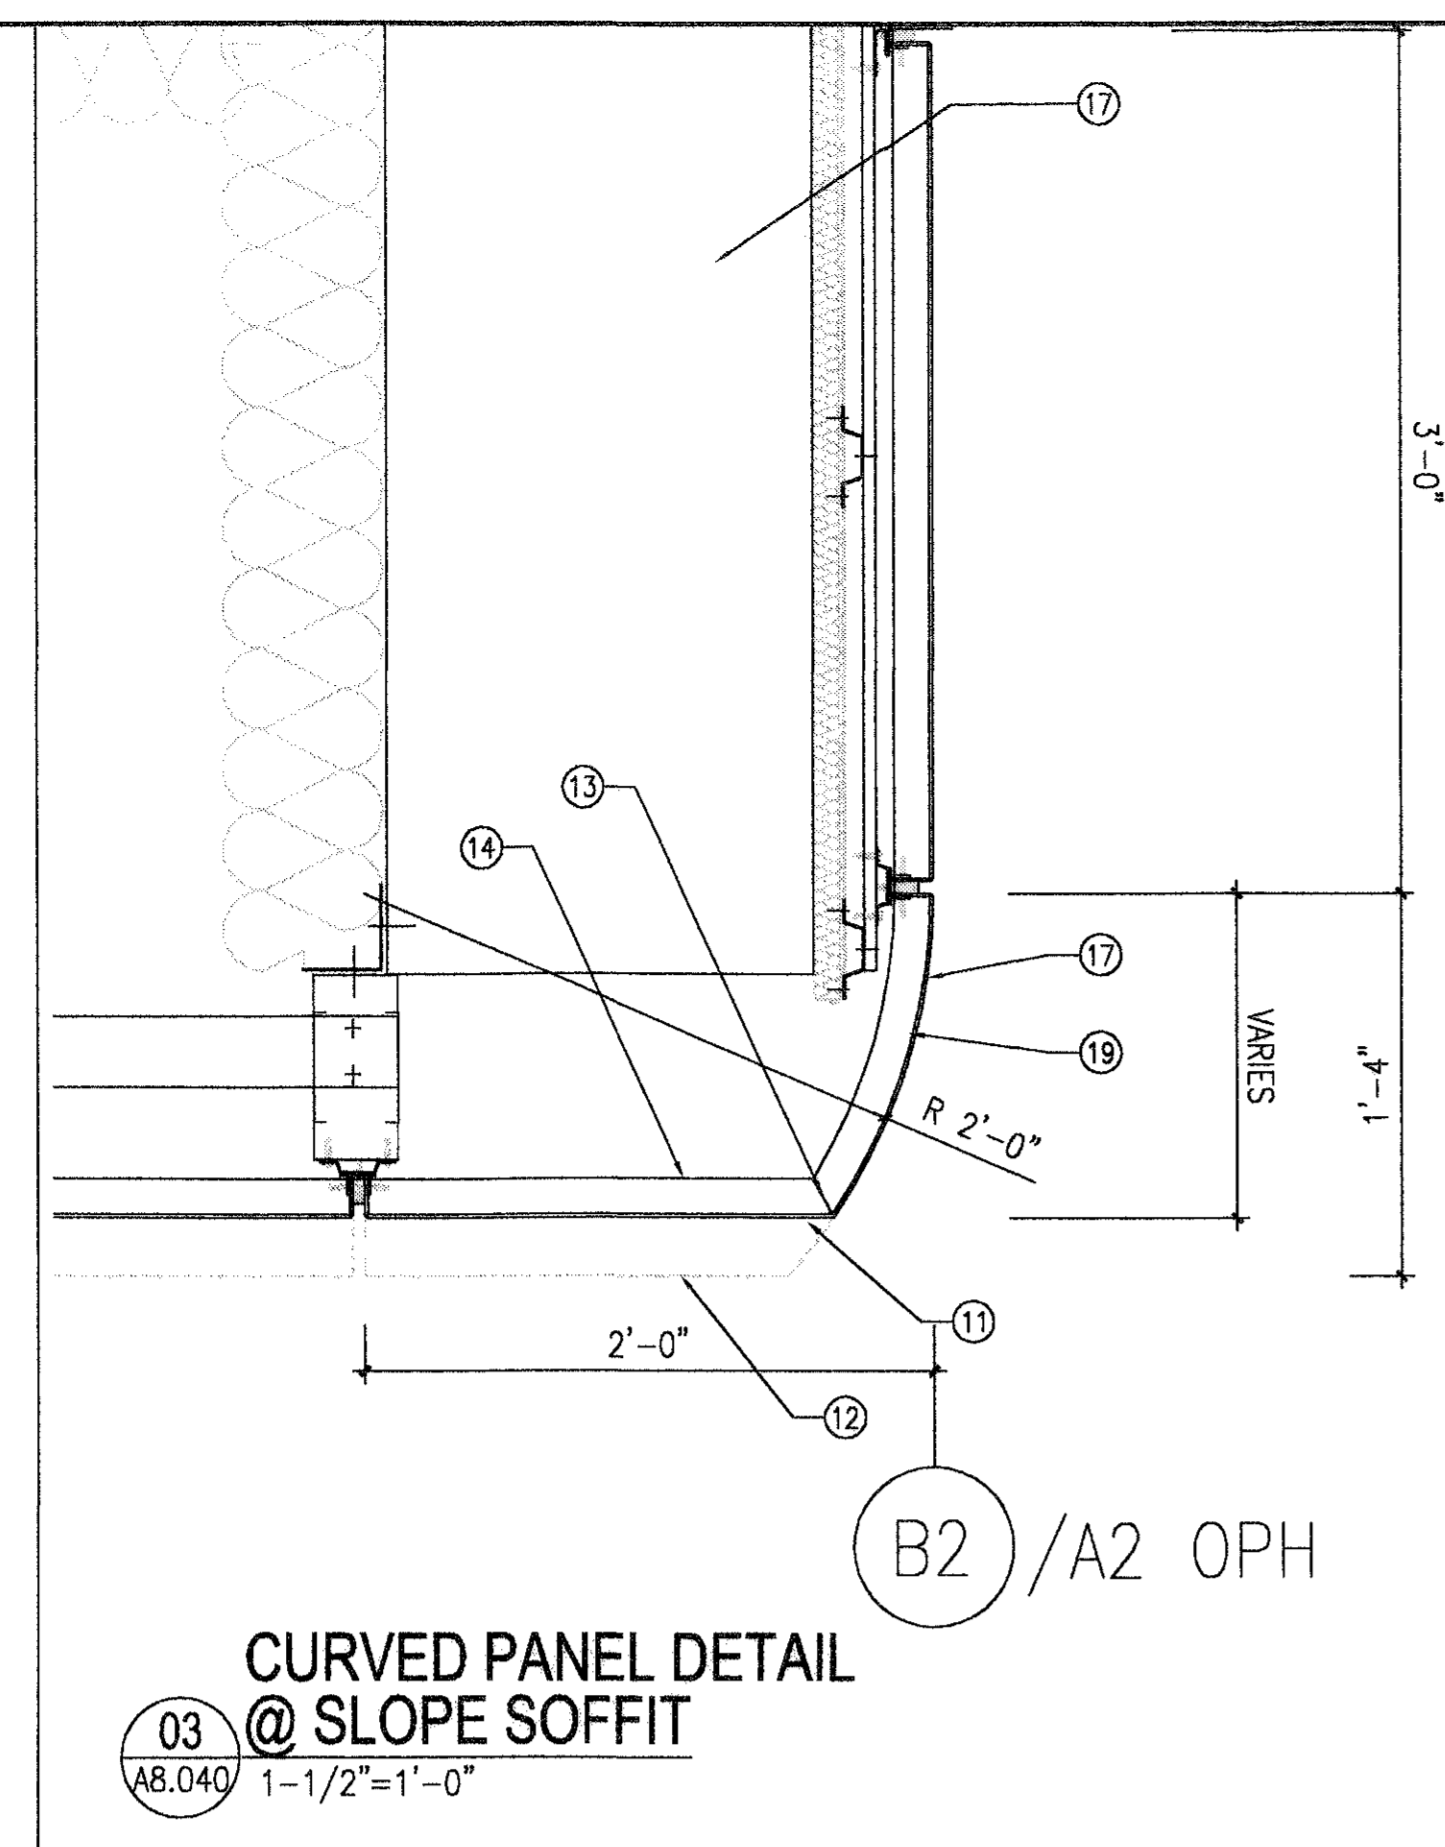


**03** CURVED PANEL DETAIL  
@ SLOPE SOFFIT  
AB.040 1-1/2"=1'-0"

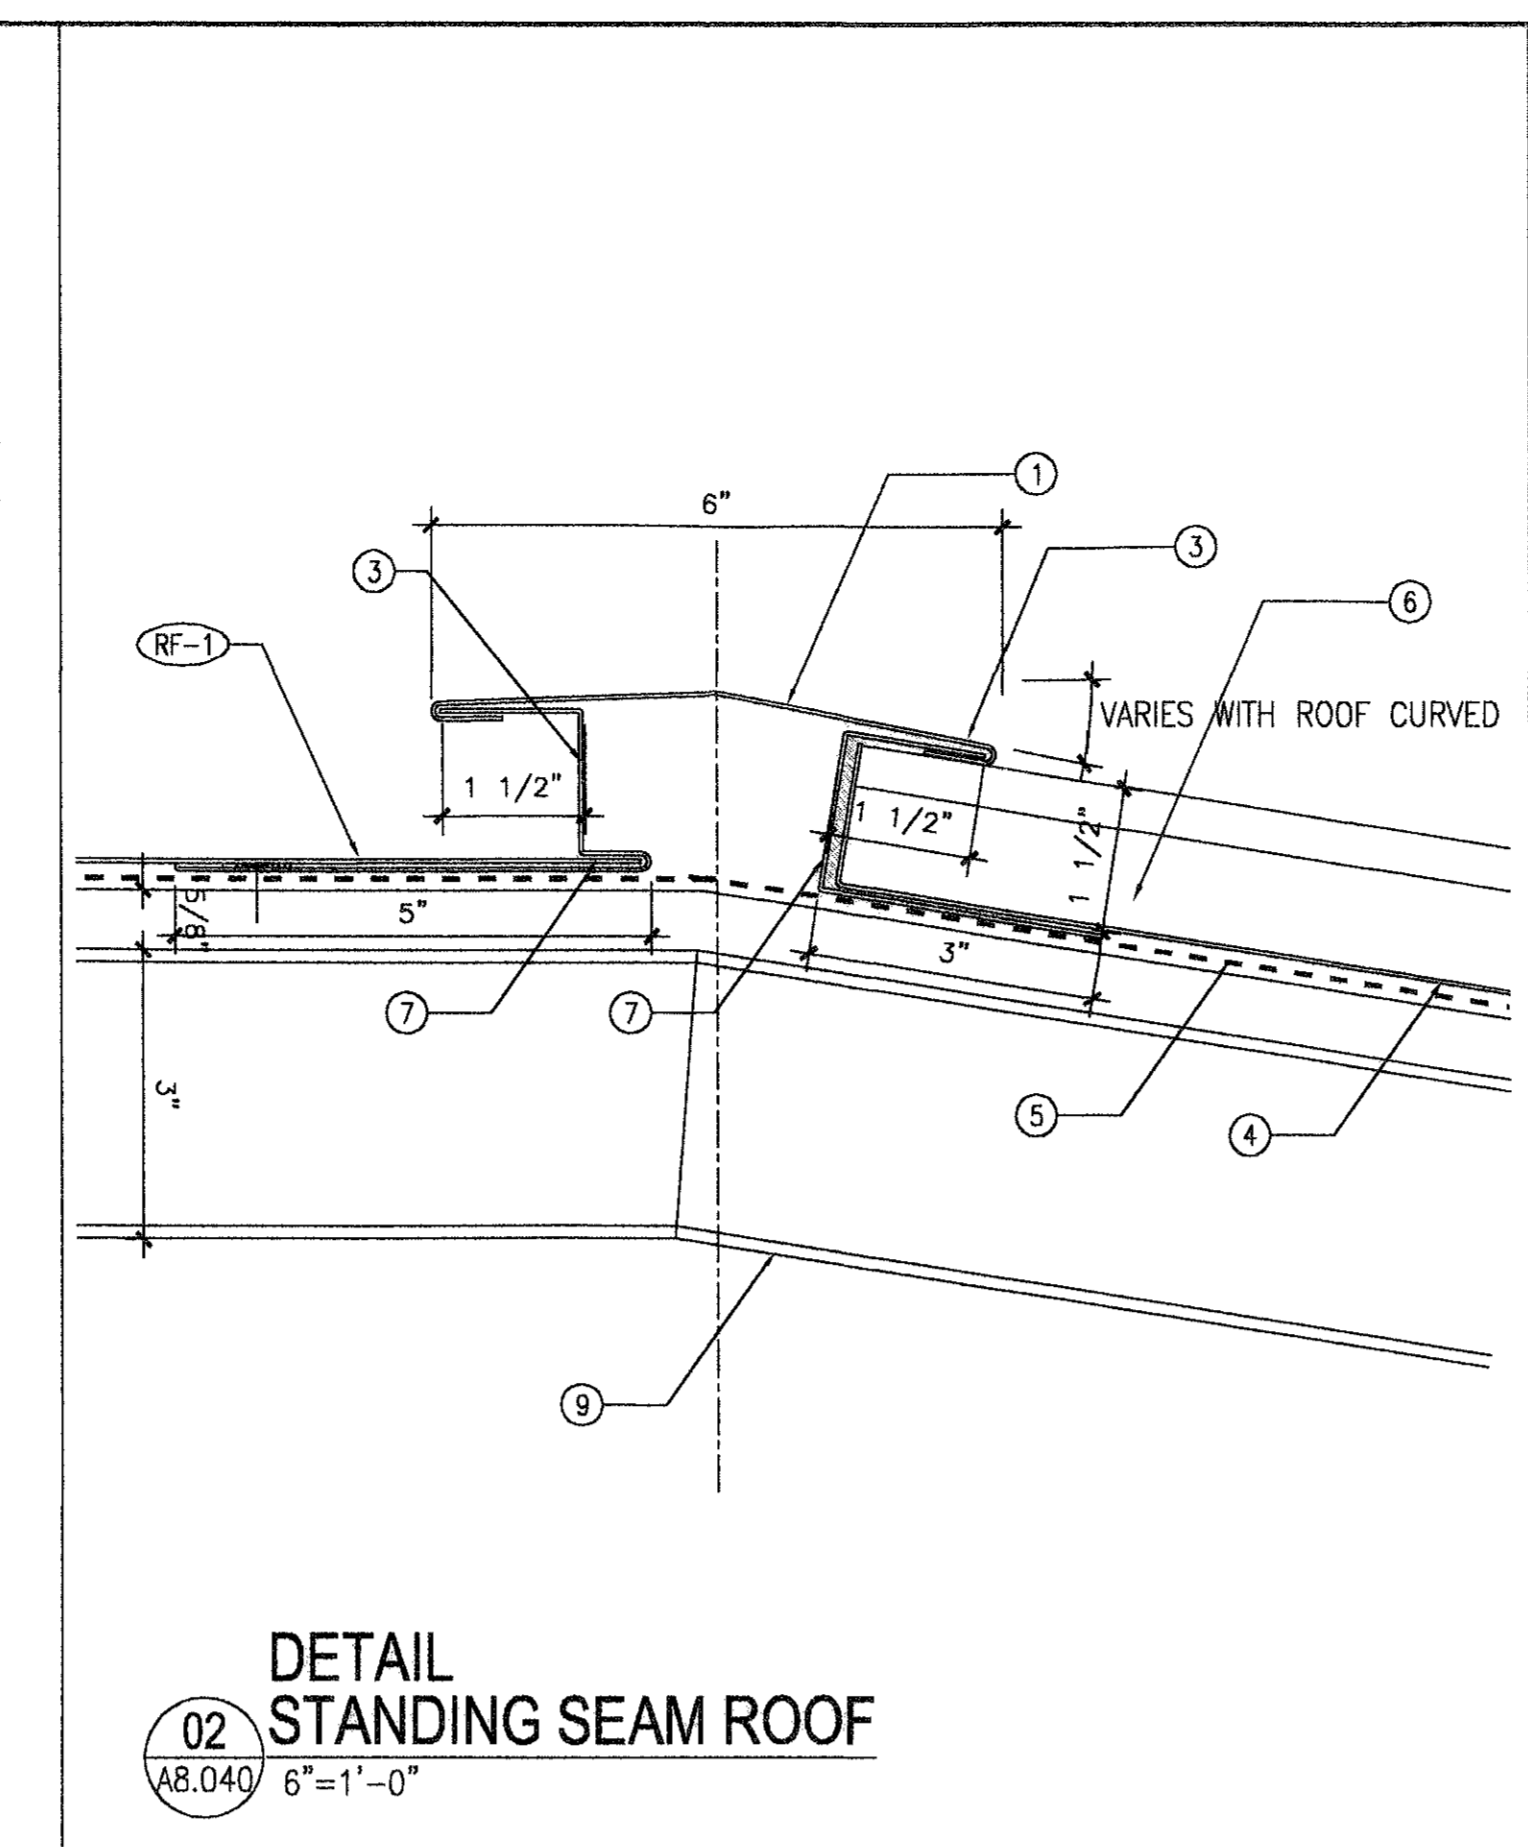


**02** DETAIL  
STANDING SEAM ROOF  
AB.040 6"=1'-0"

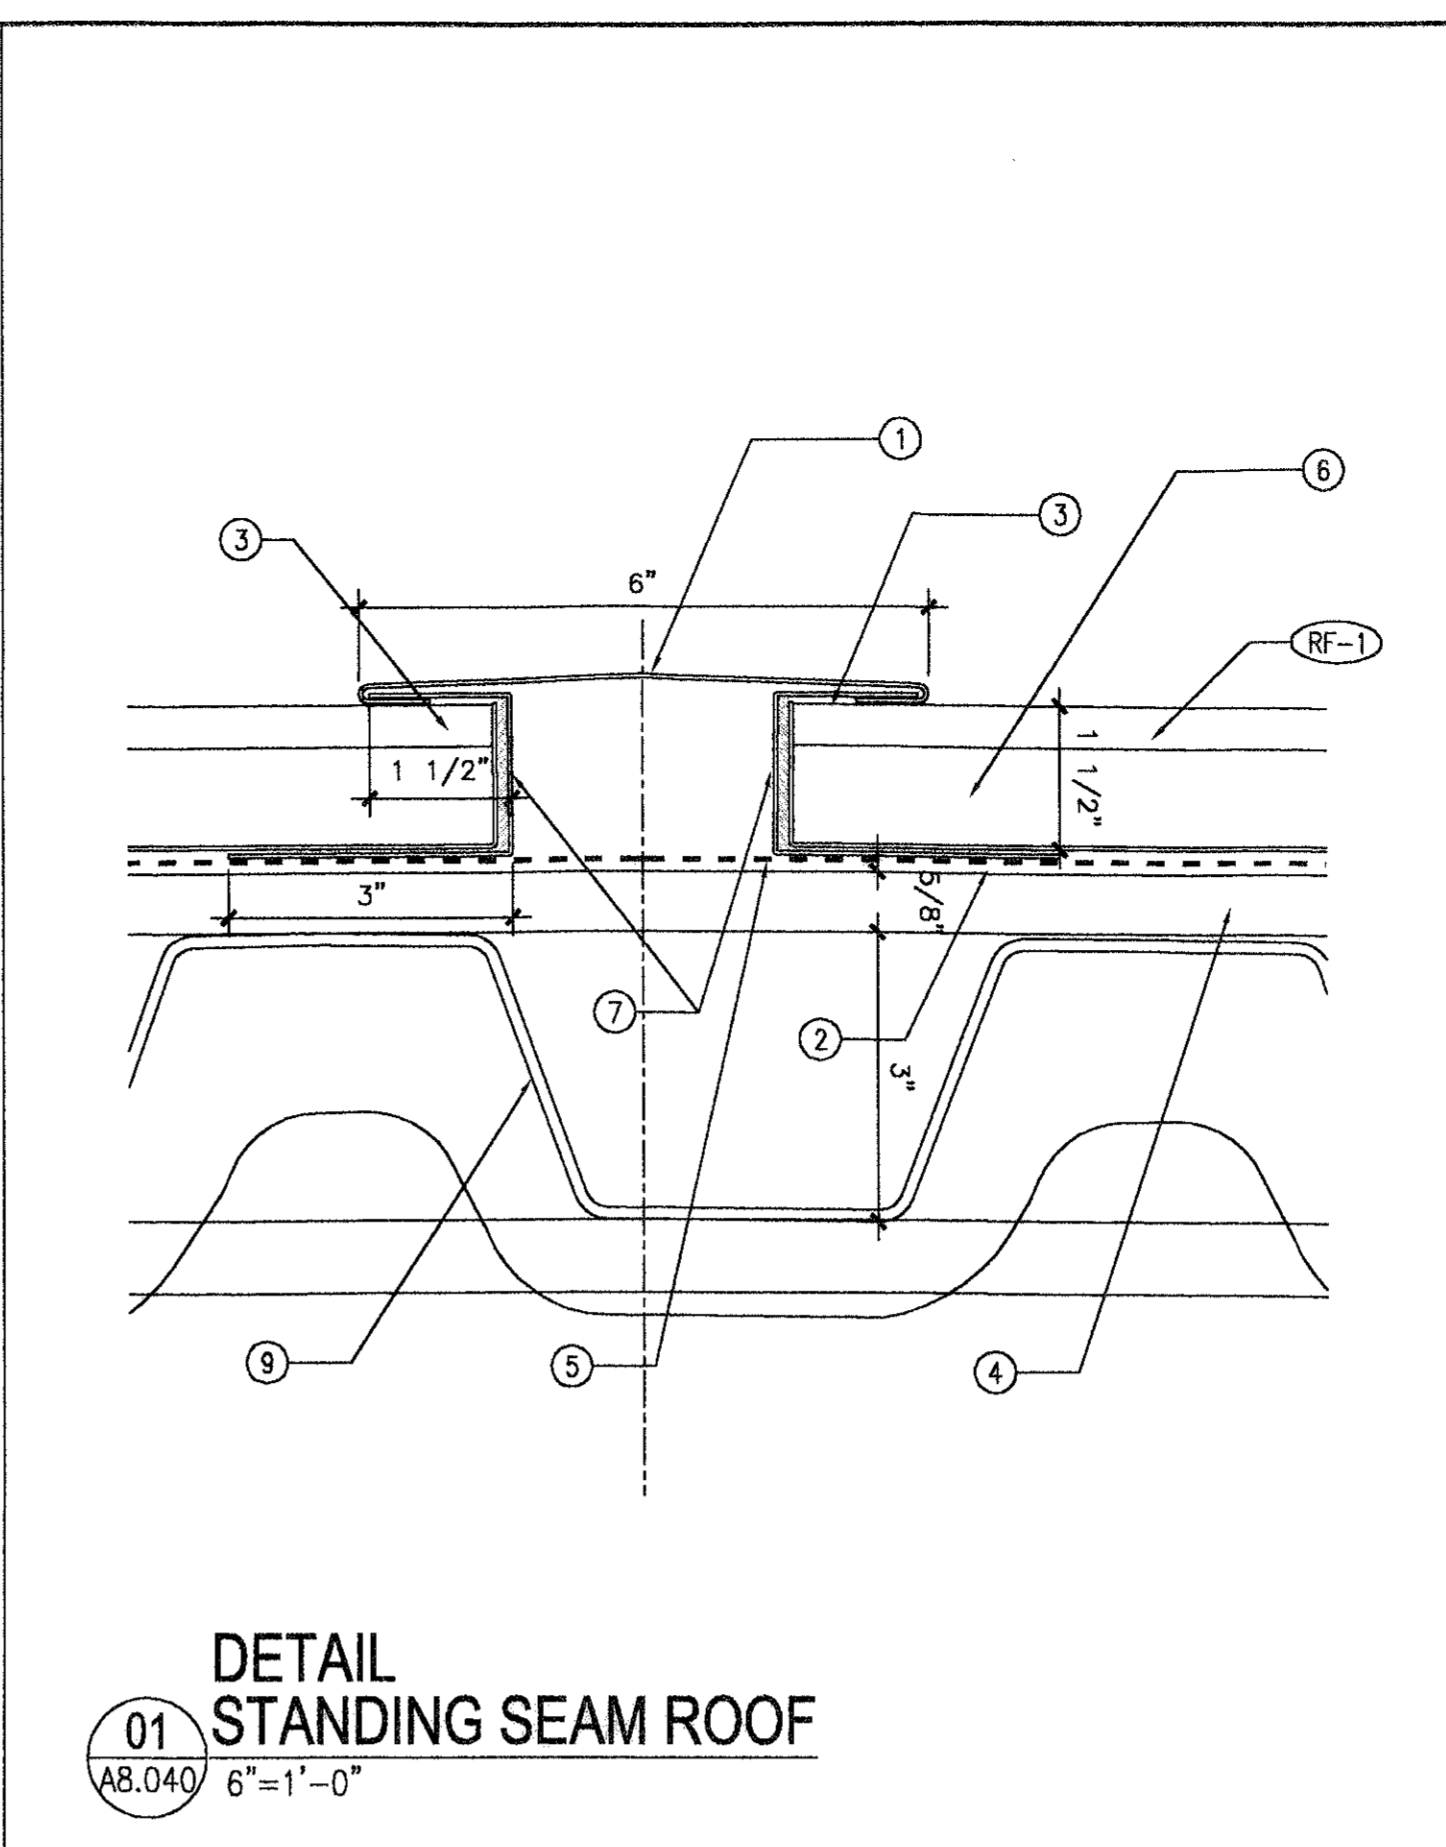

**01** DETAIL  
STANDING SEAM ROOF  
AB.040 6"=1'-0"

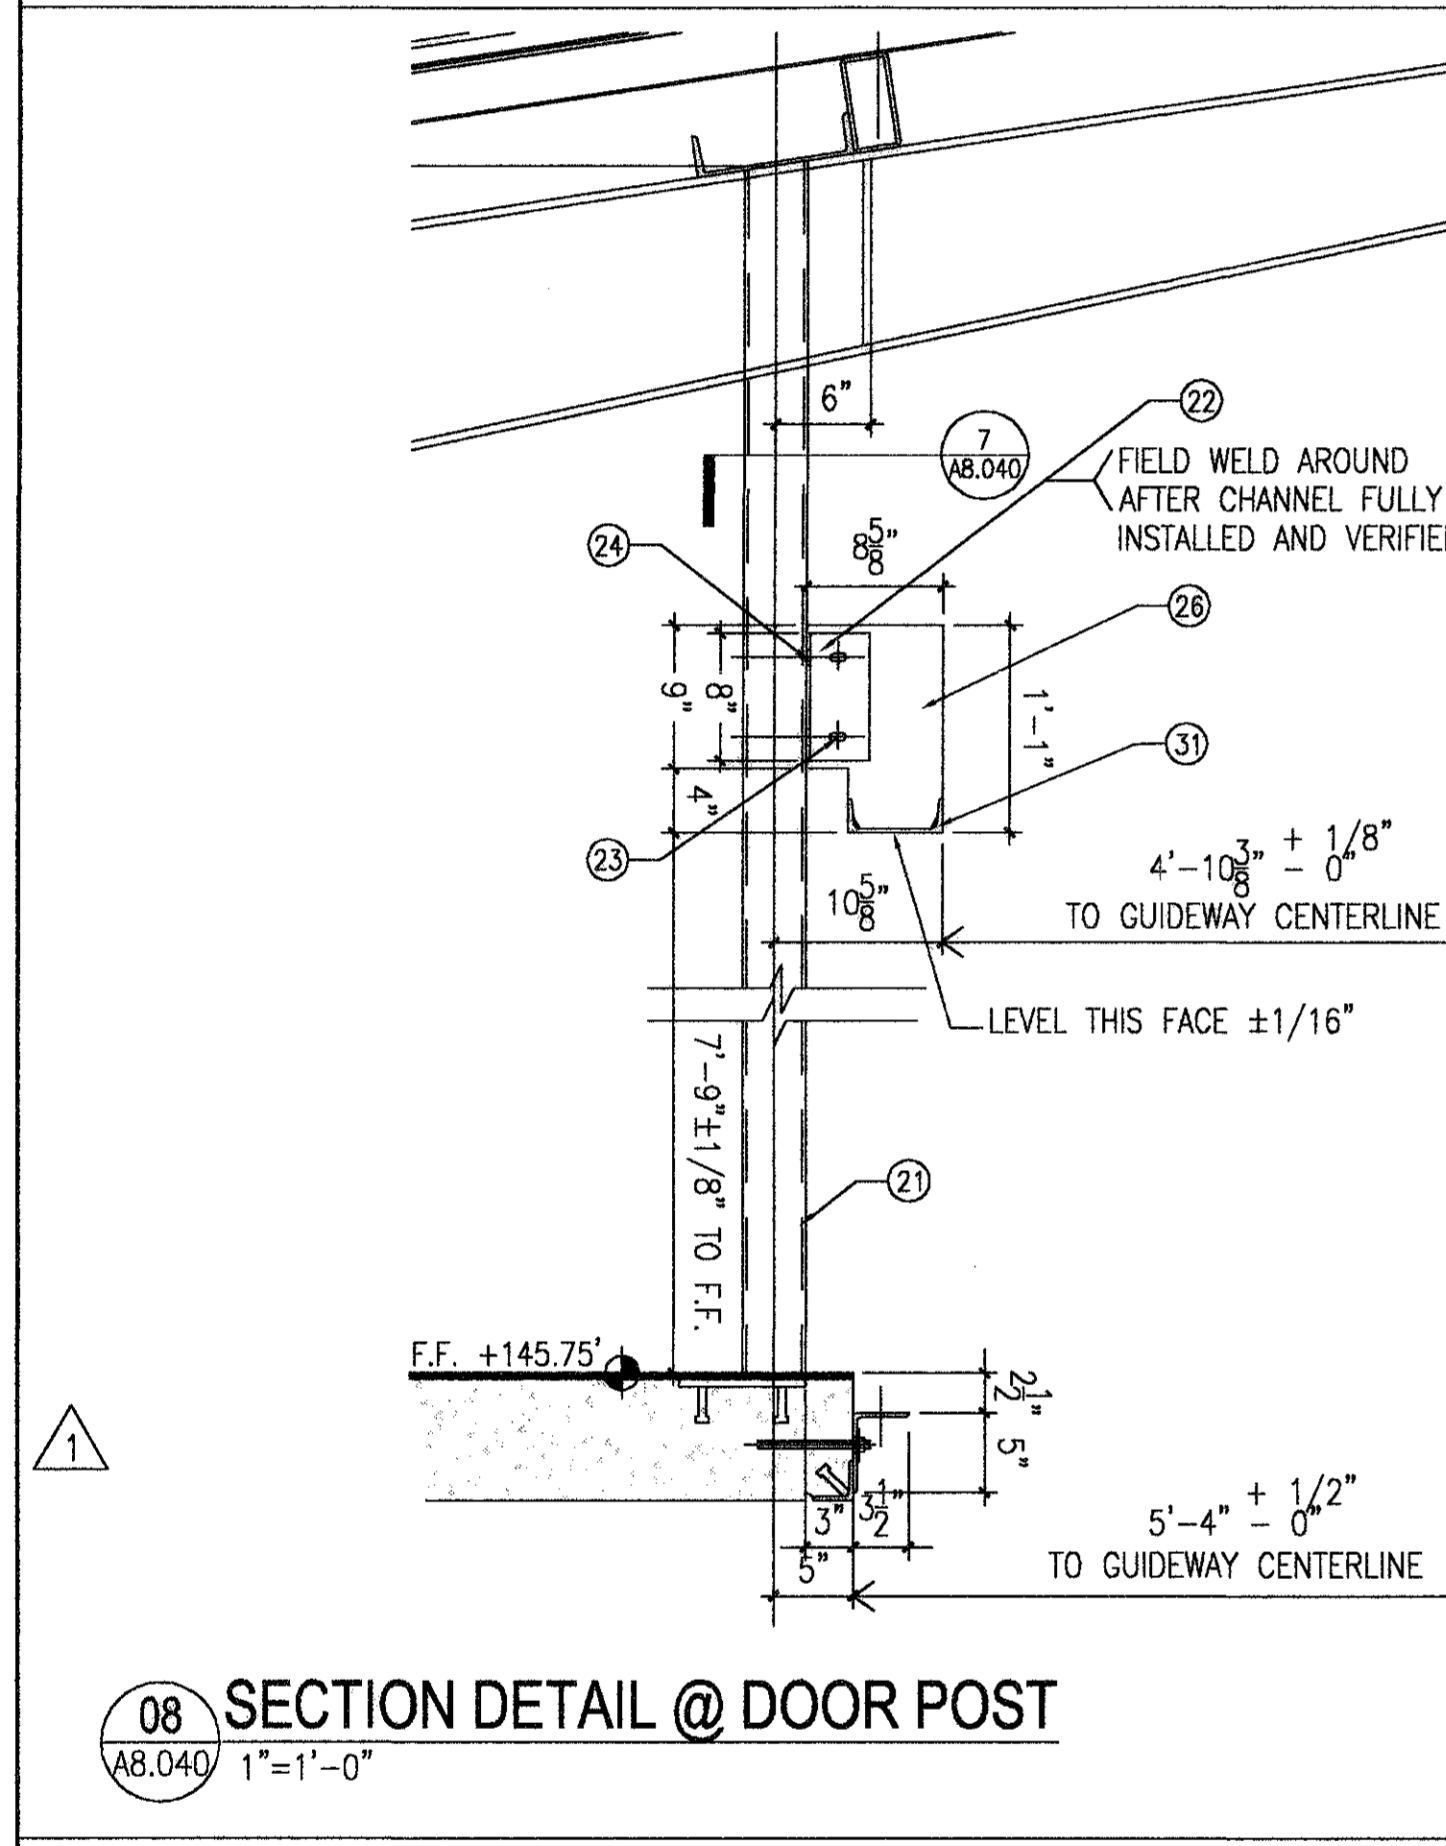


**08** SECTION DETAIL @ DOOR POST  
AB.040 1"=1'-0"

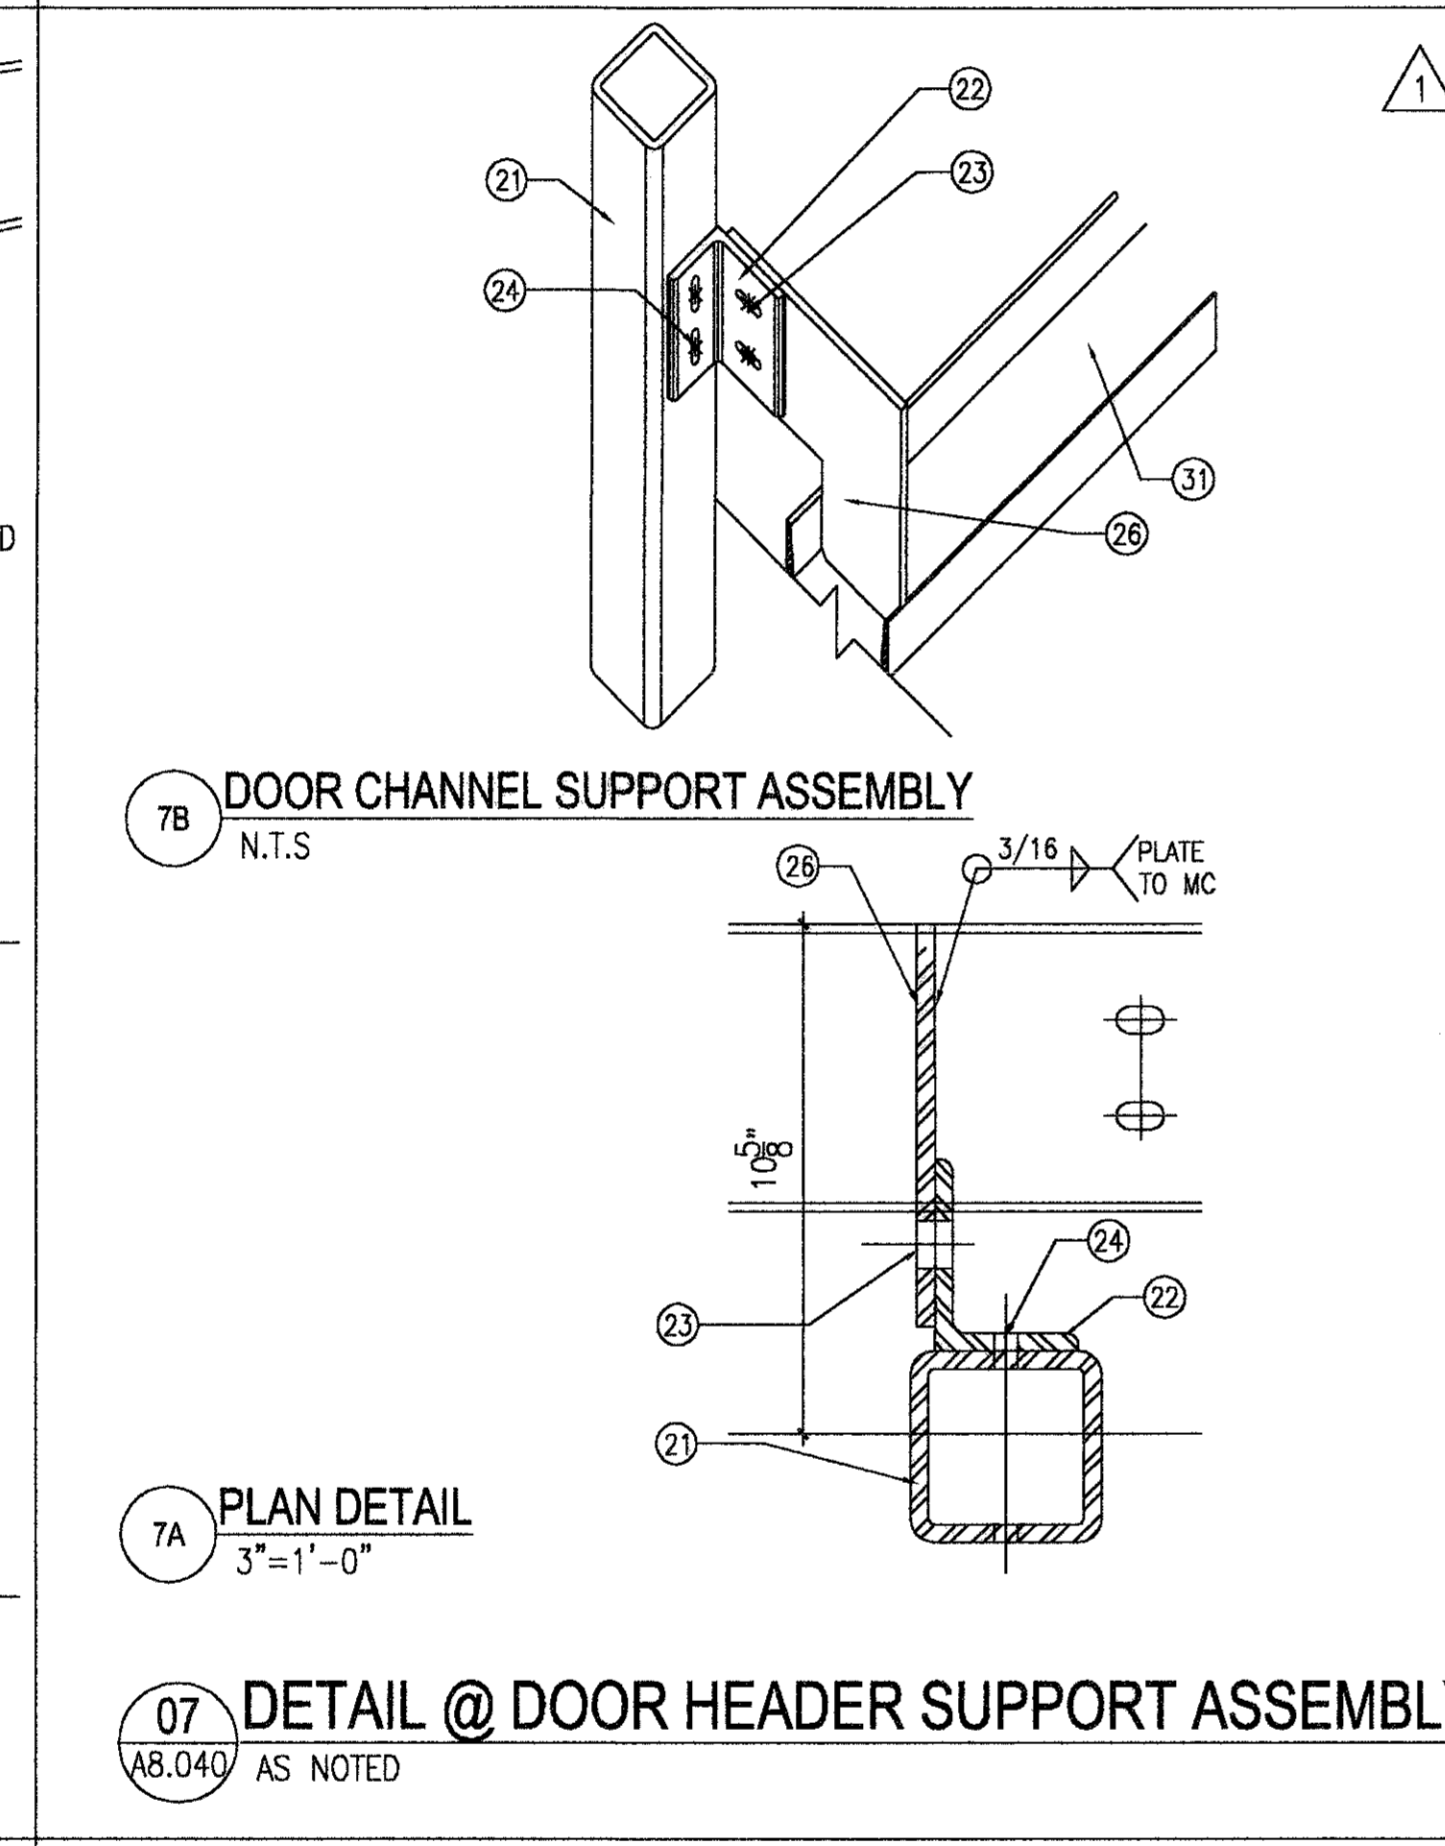


**7B** DOOR CHANNEL SUPPORT ASSEMBLY  
N.T.S.

**7A** PLAN DETAIL  
3"=1'-0"


**07** DETAIL @ DOOR HEADER SUPPORT ASSEMBLY  
AB.040 AS NOTED

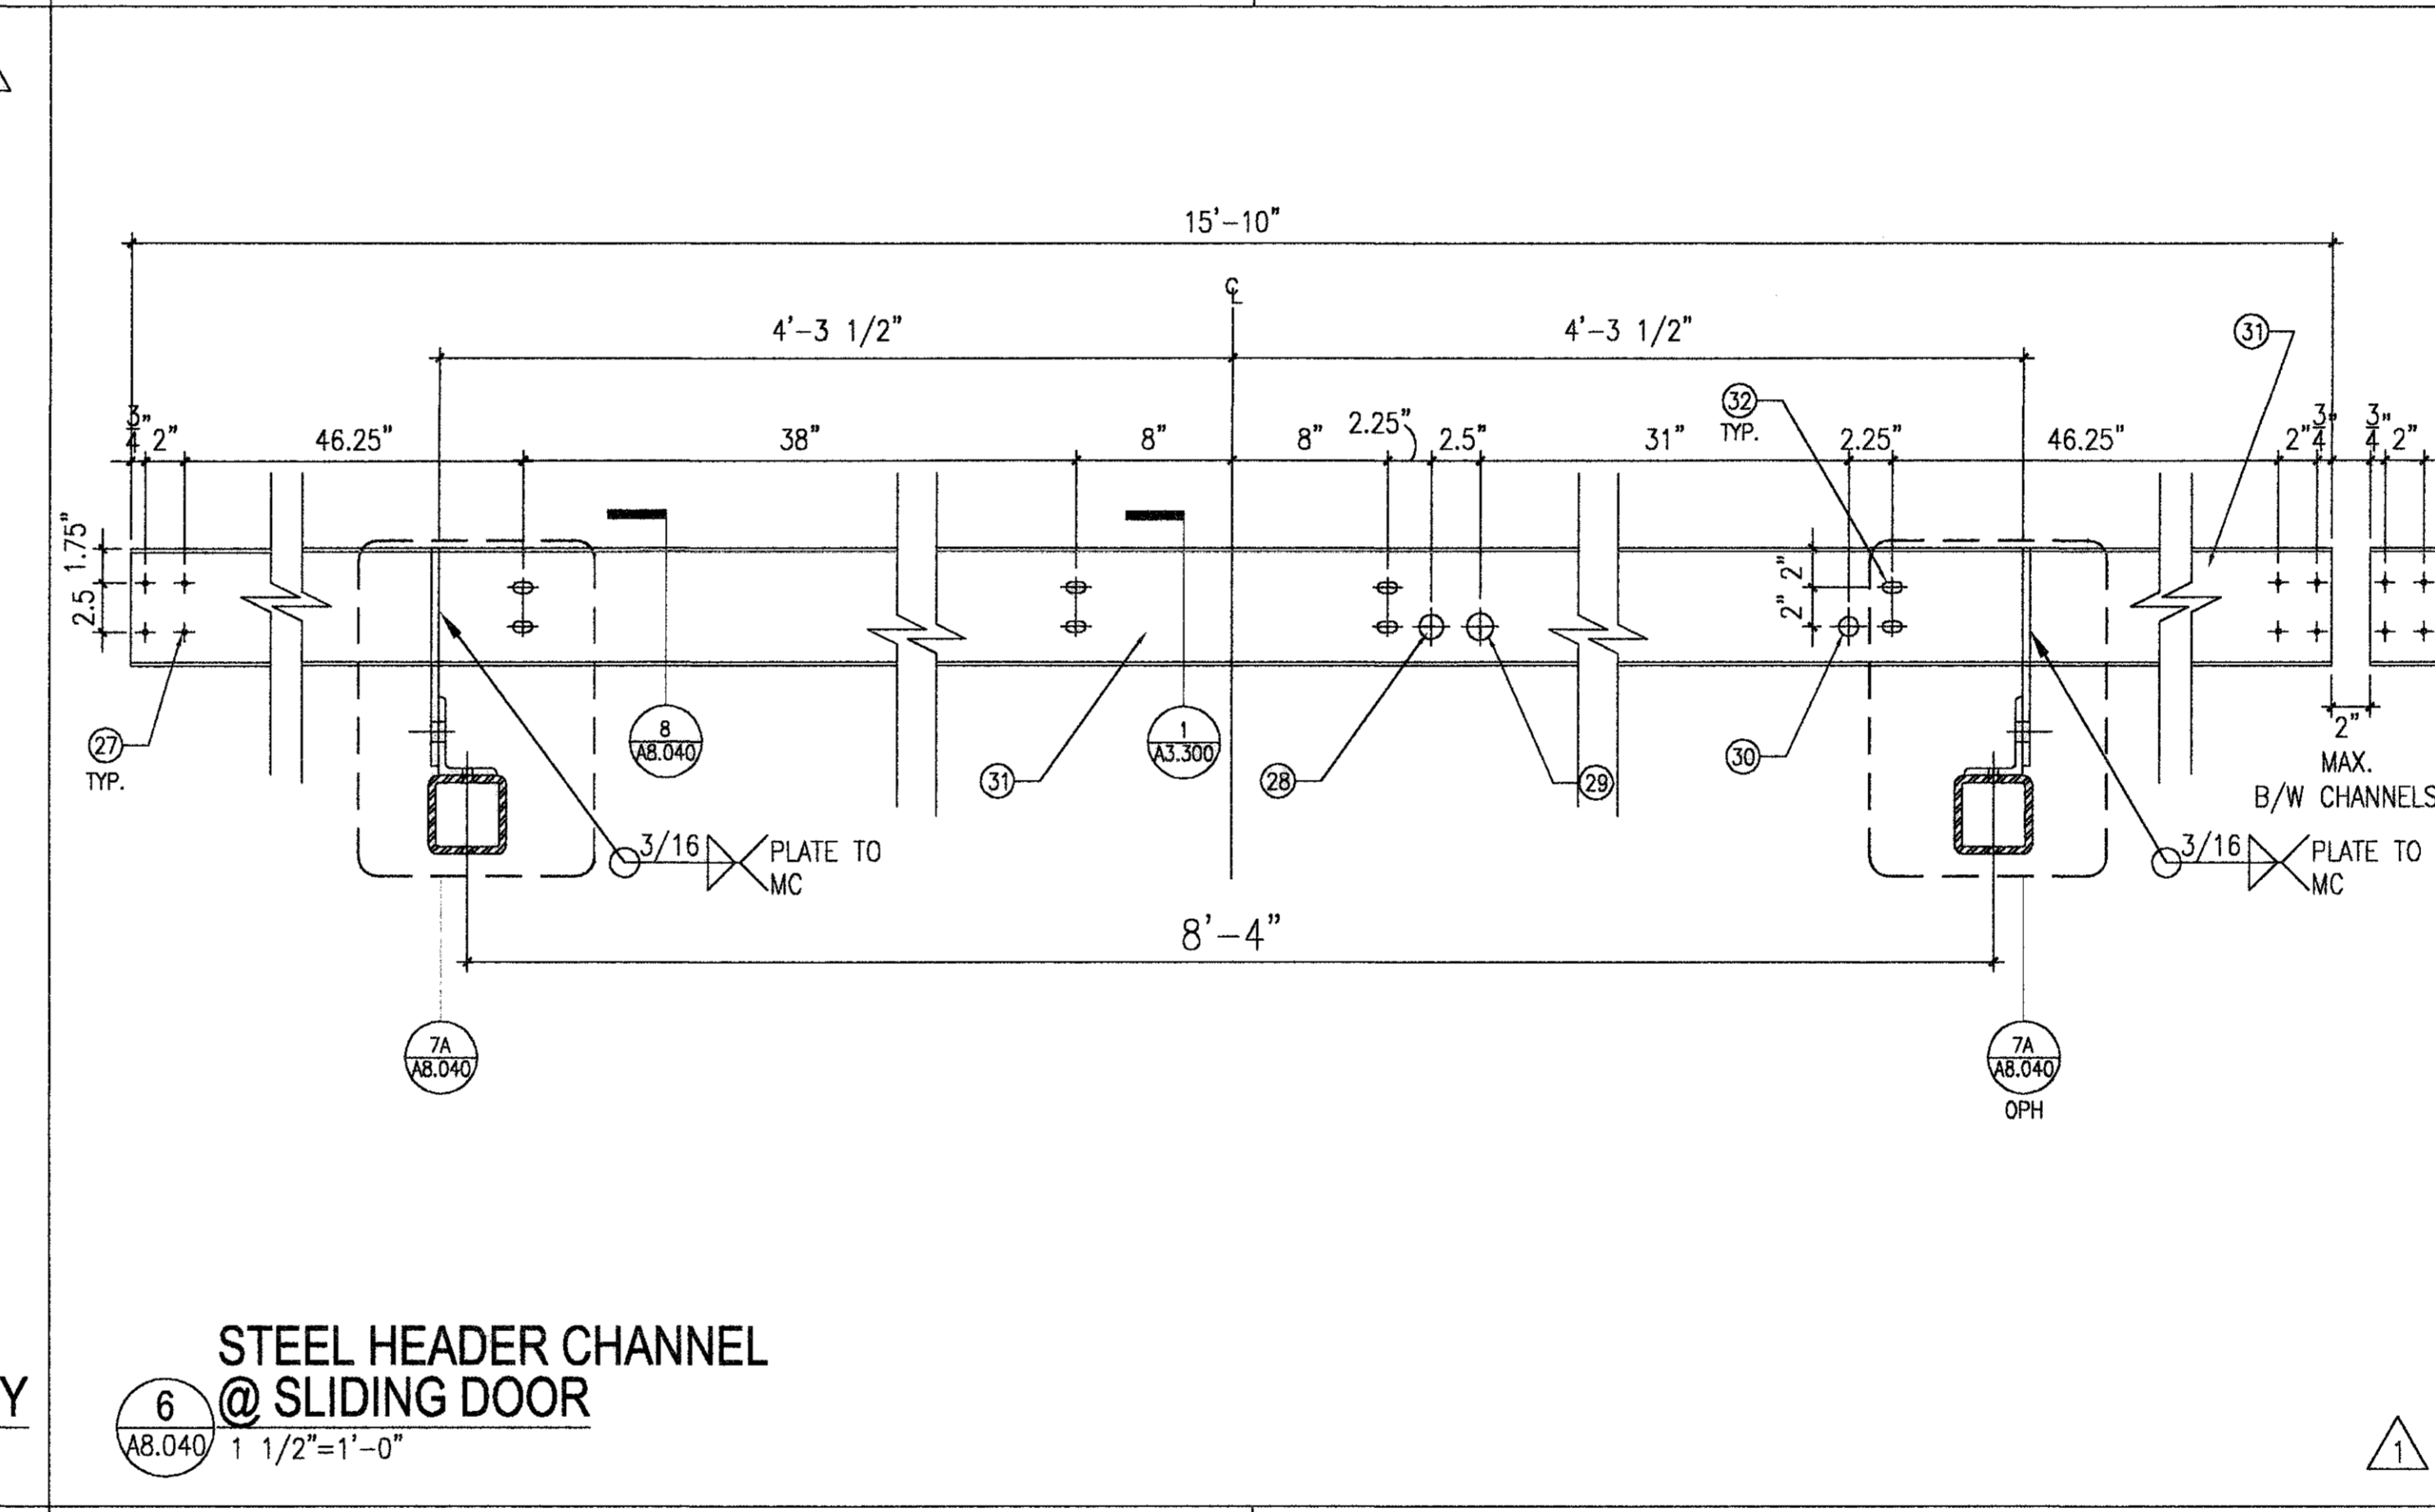


**6** STEEL HEADER CHANNEL  
@ SLIDING DOOR  
AB.040 1 1/2"=1'-0"

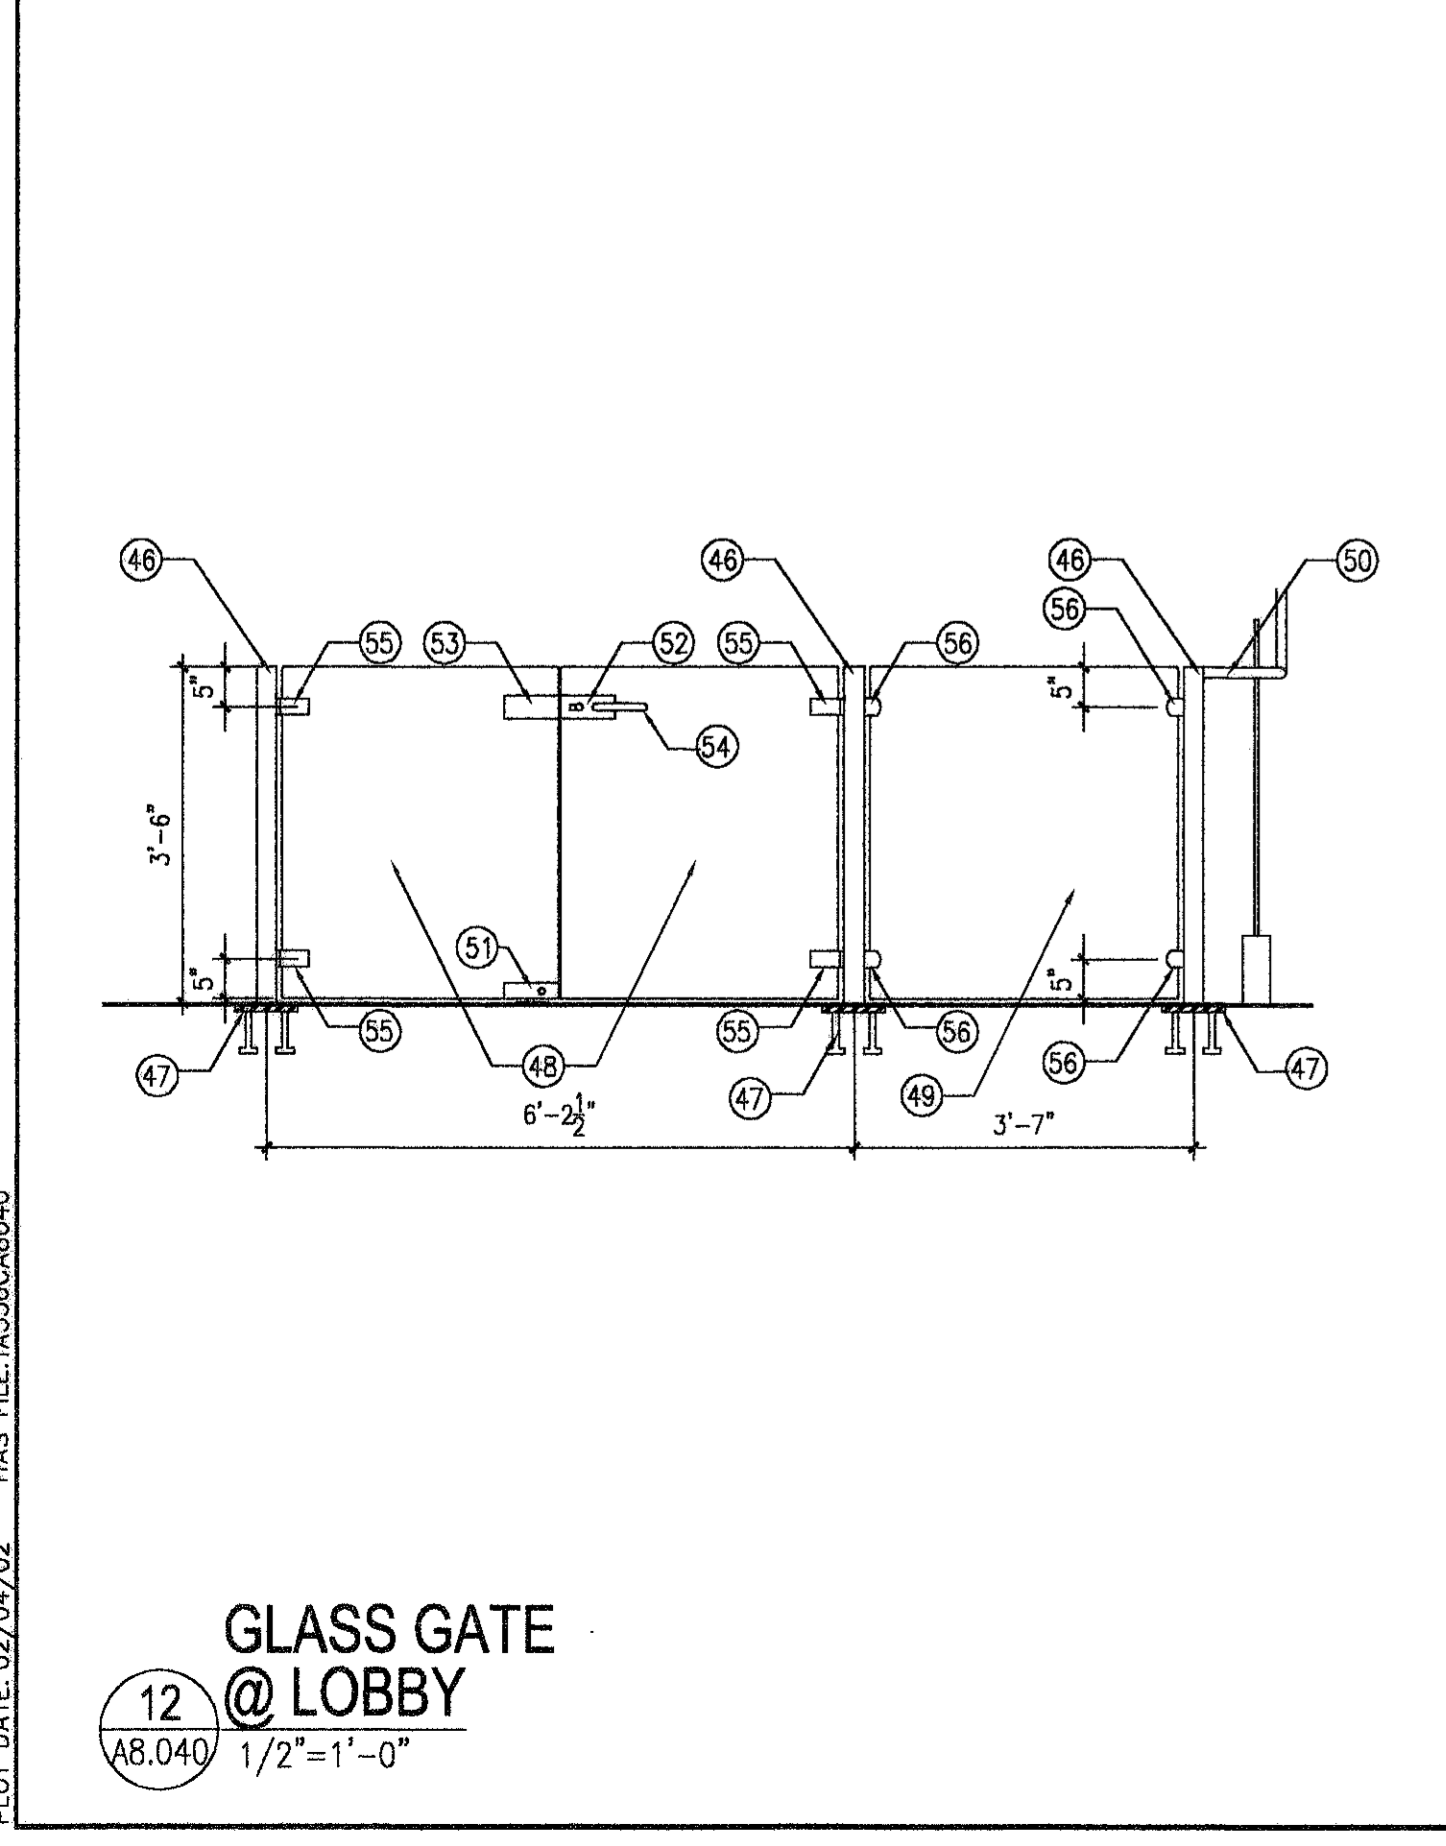


**12** GLASS GATE  
@ LOBBY  
AB.040 1/2"=1'-0"

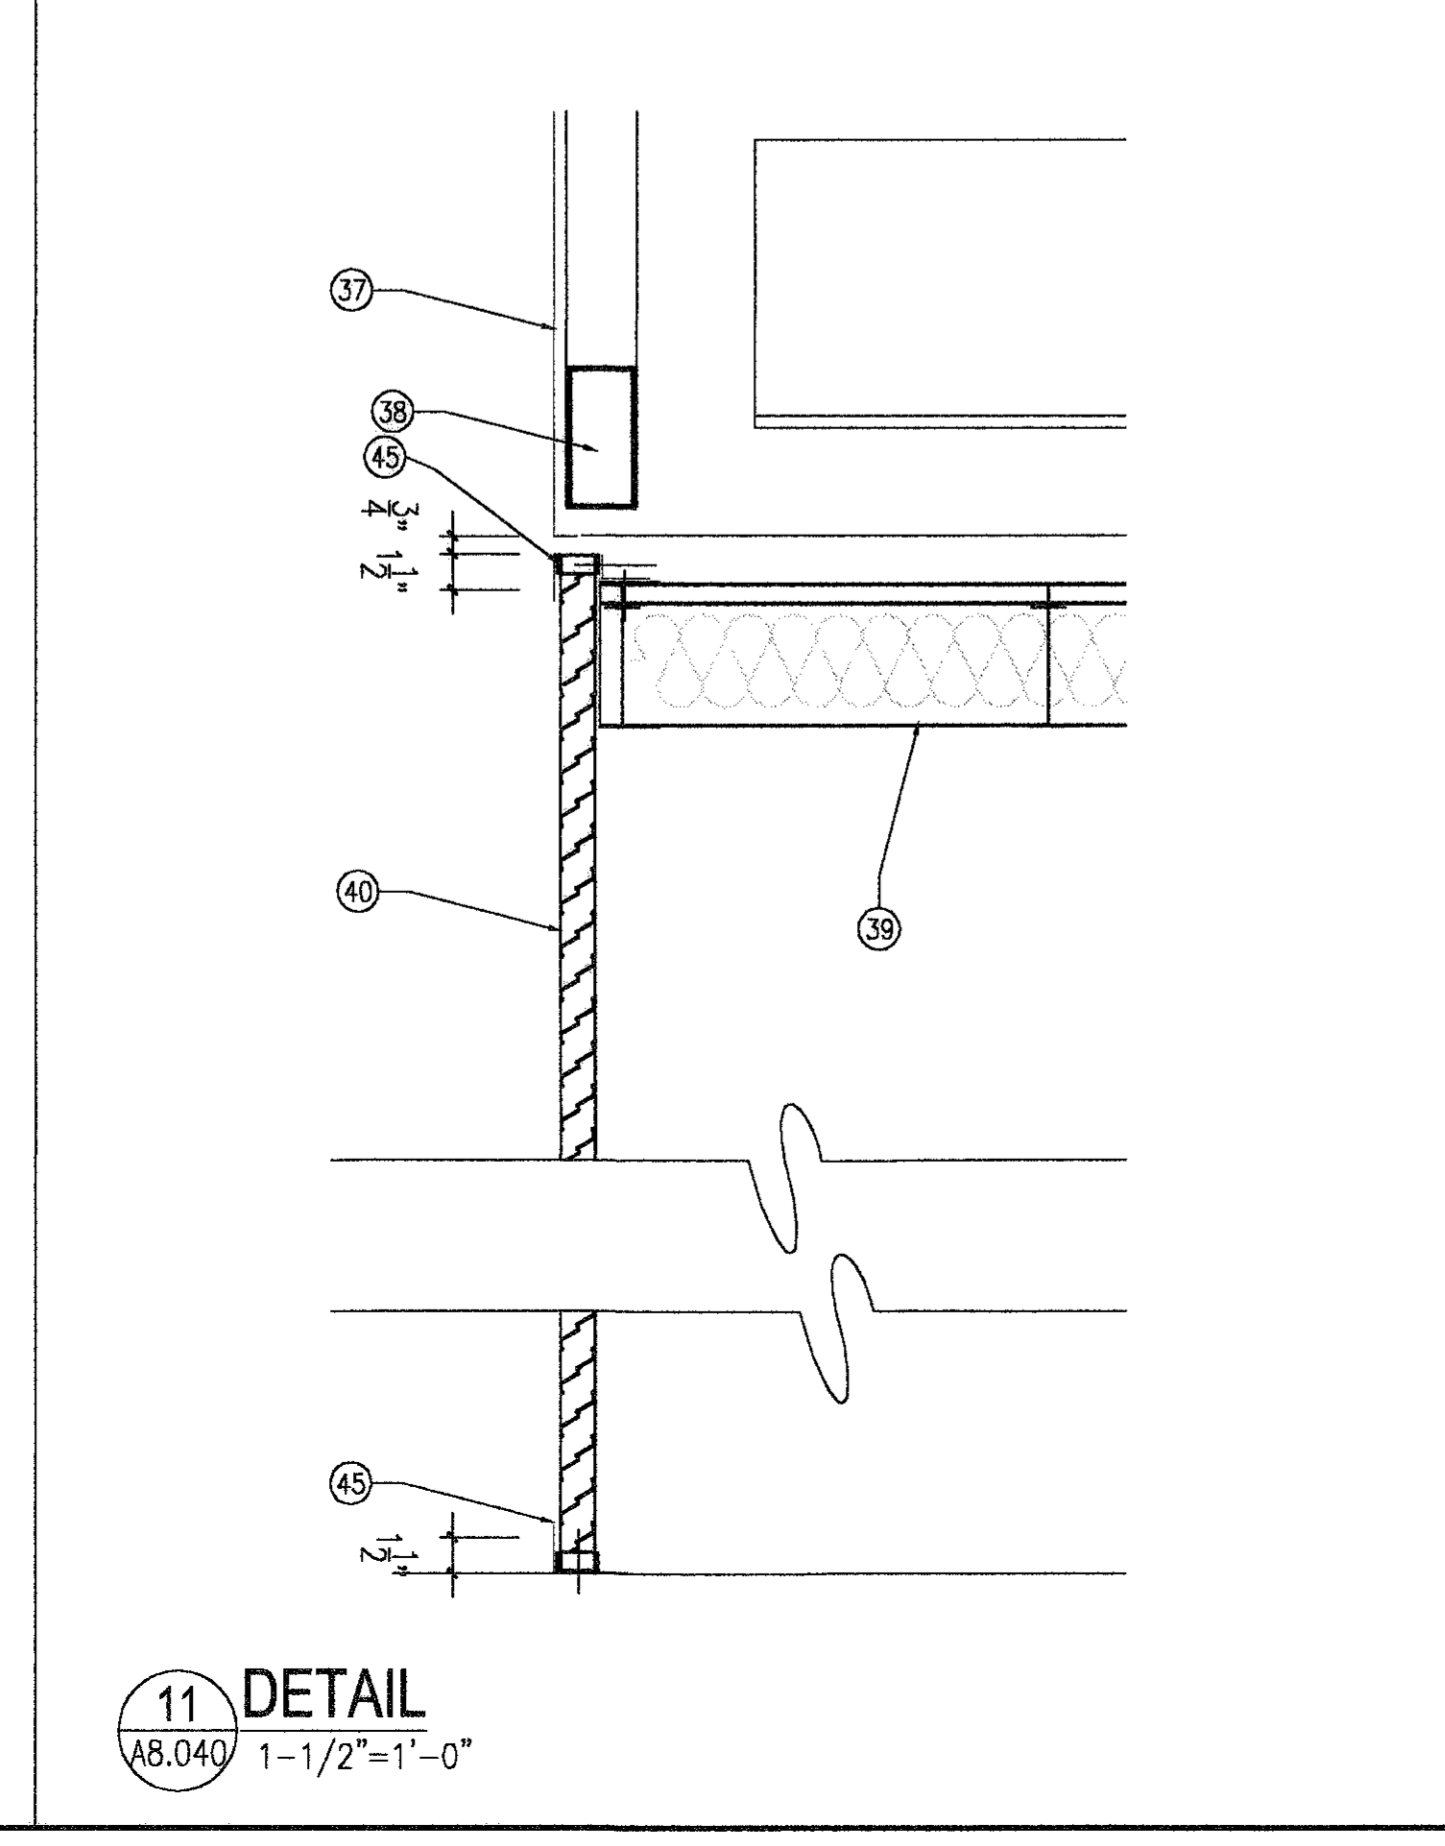

**11** DETAIL  
AB.040 1-1/2"=1'-0"

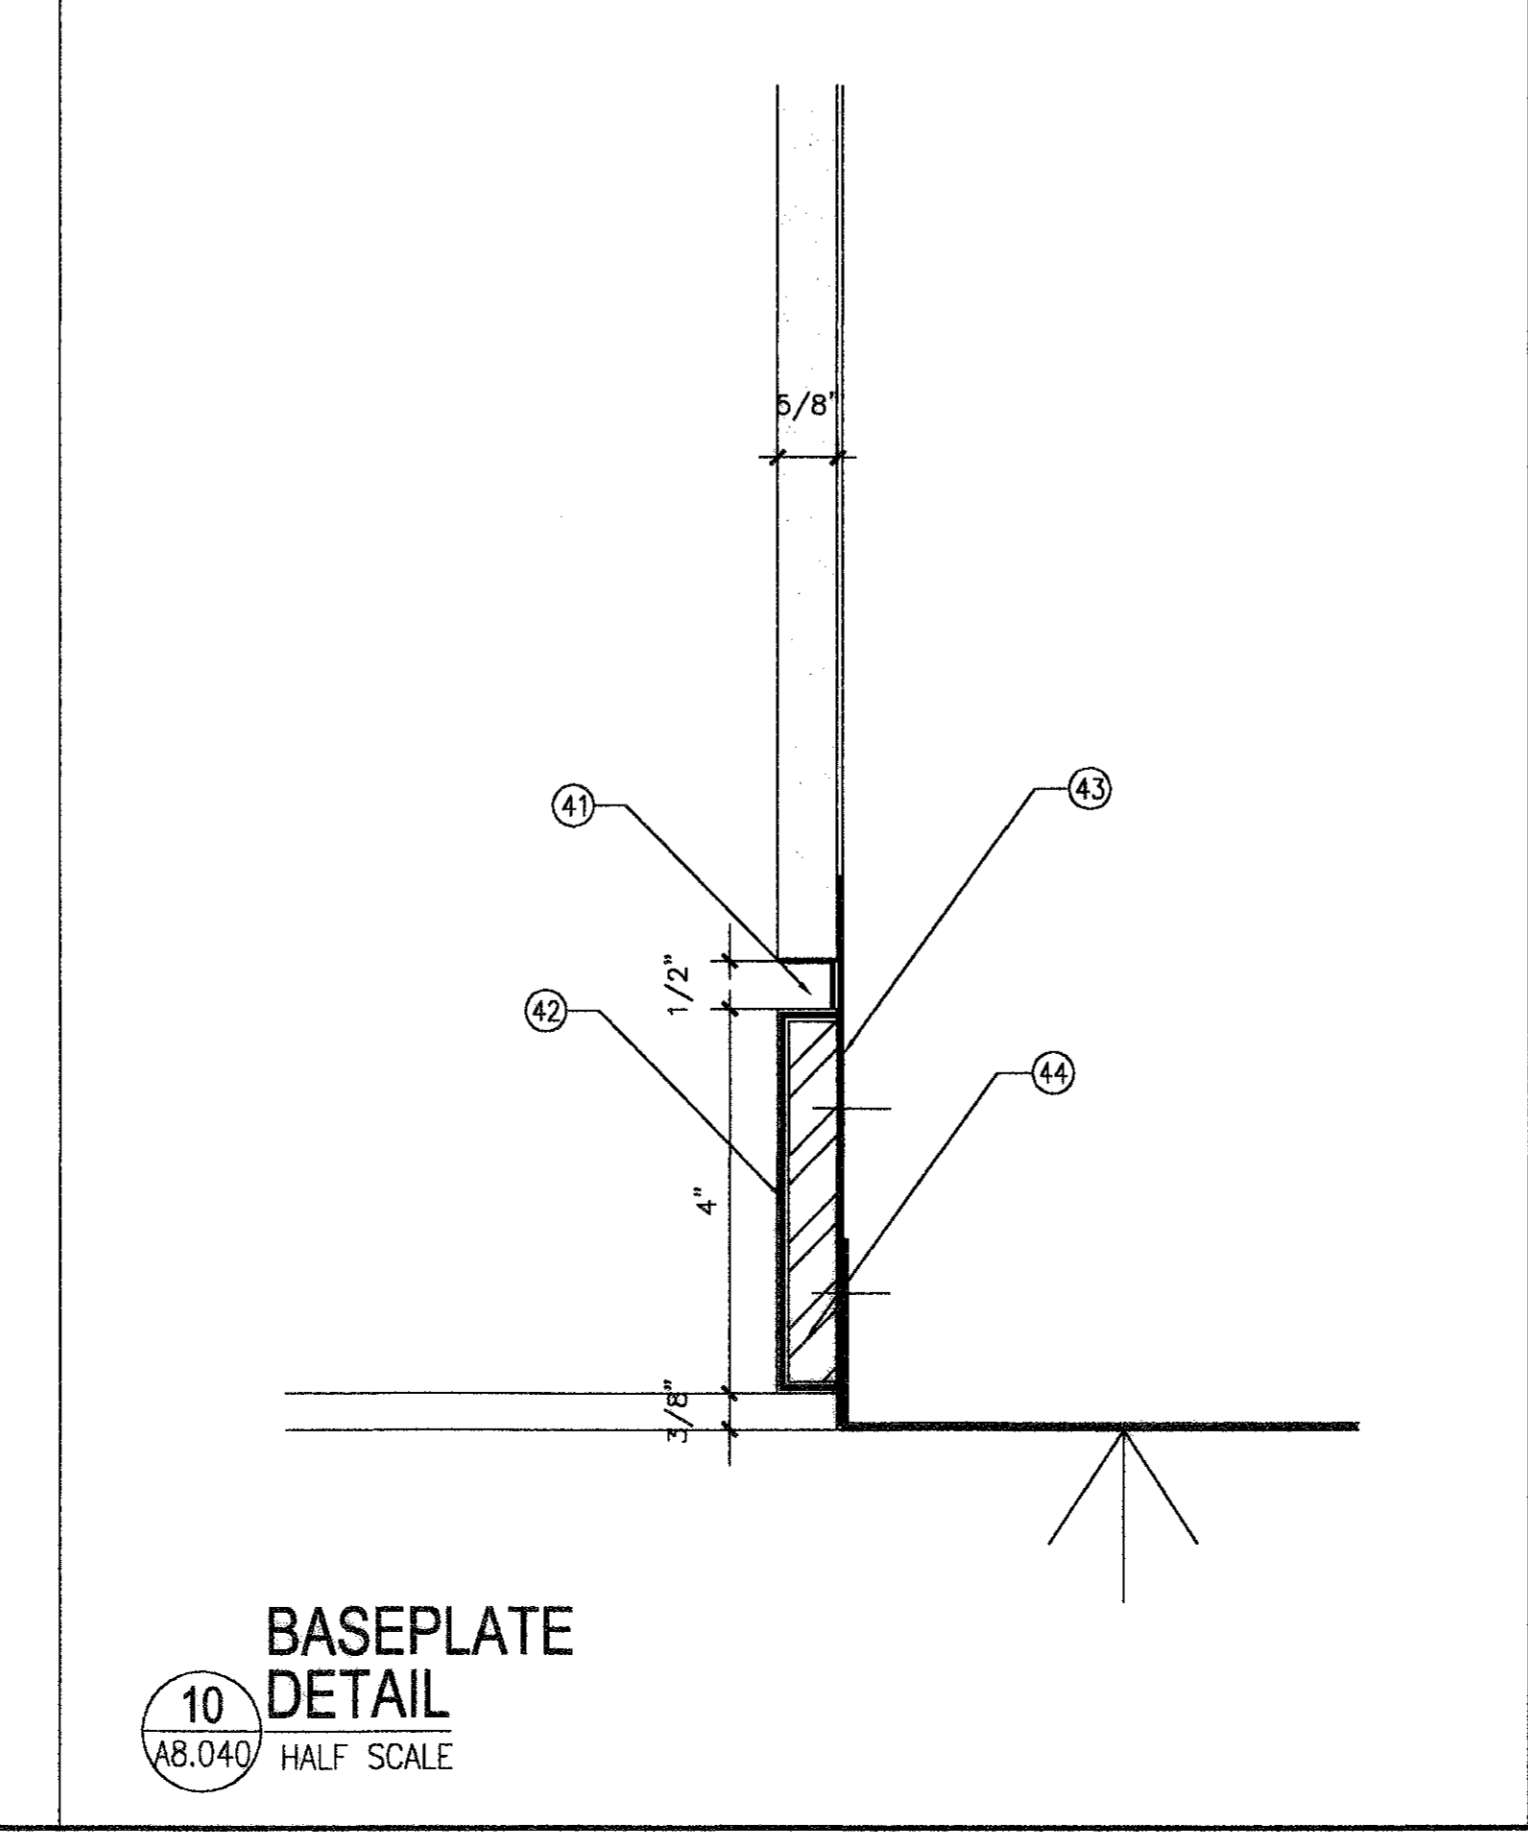

**10** BASEPLATE  
DETAIL  
AB.040 HALF SCALE

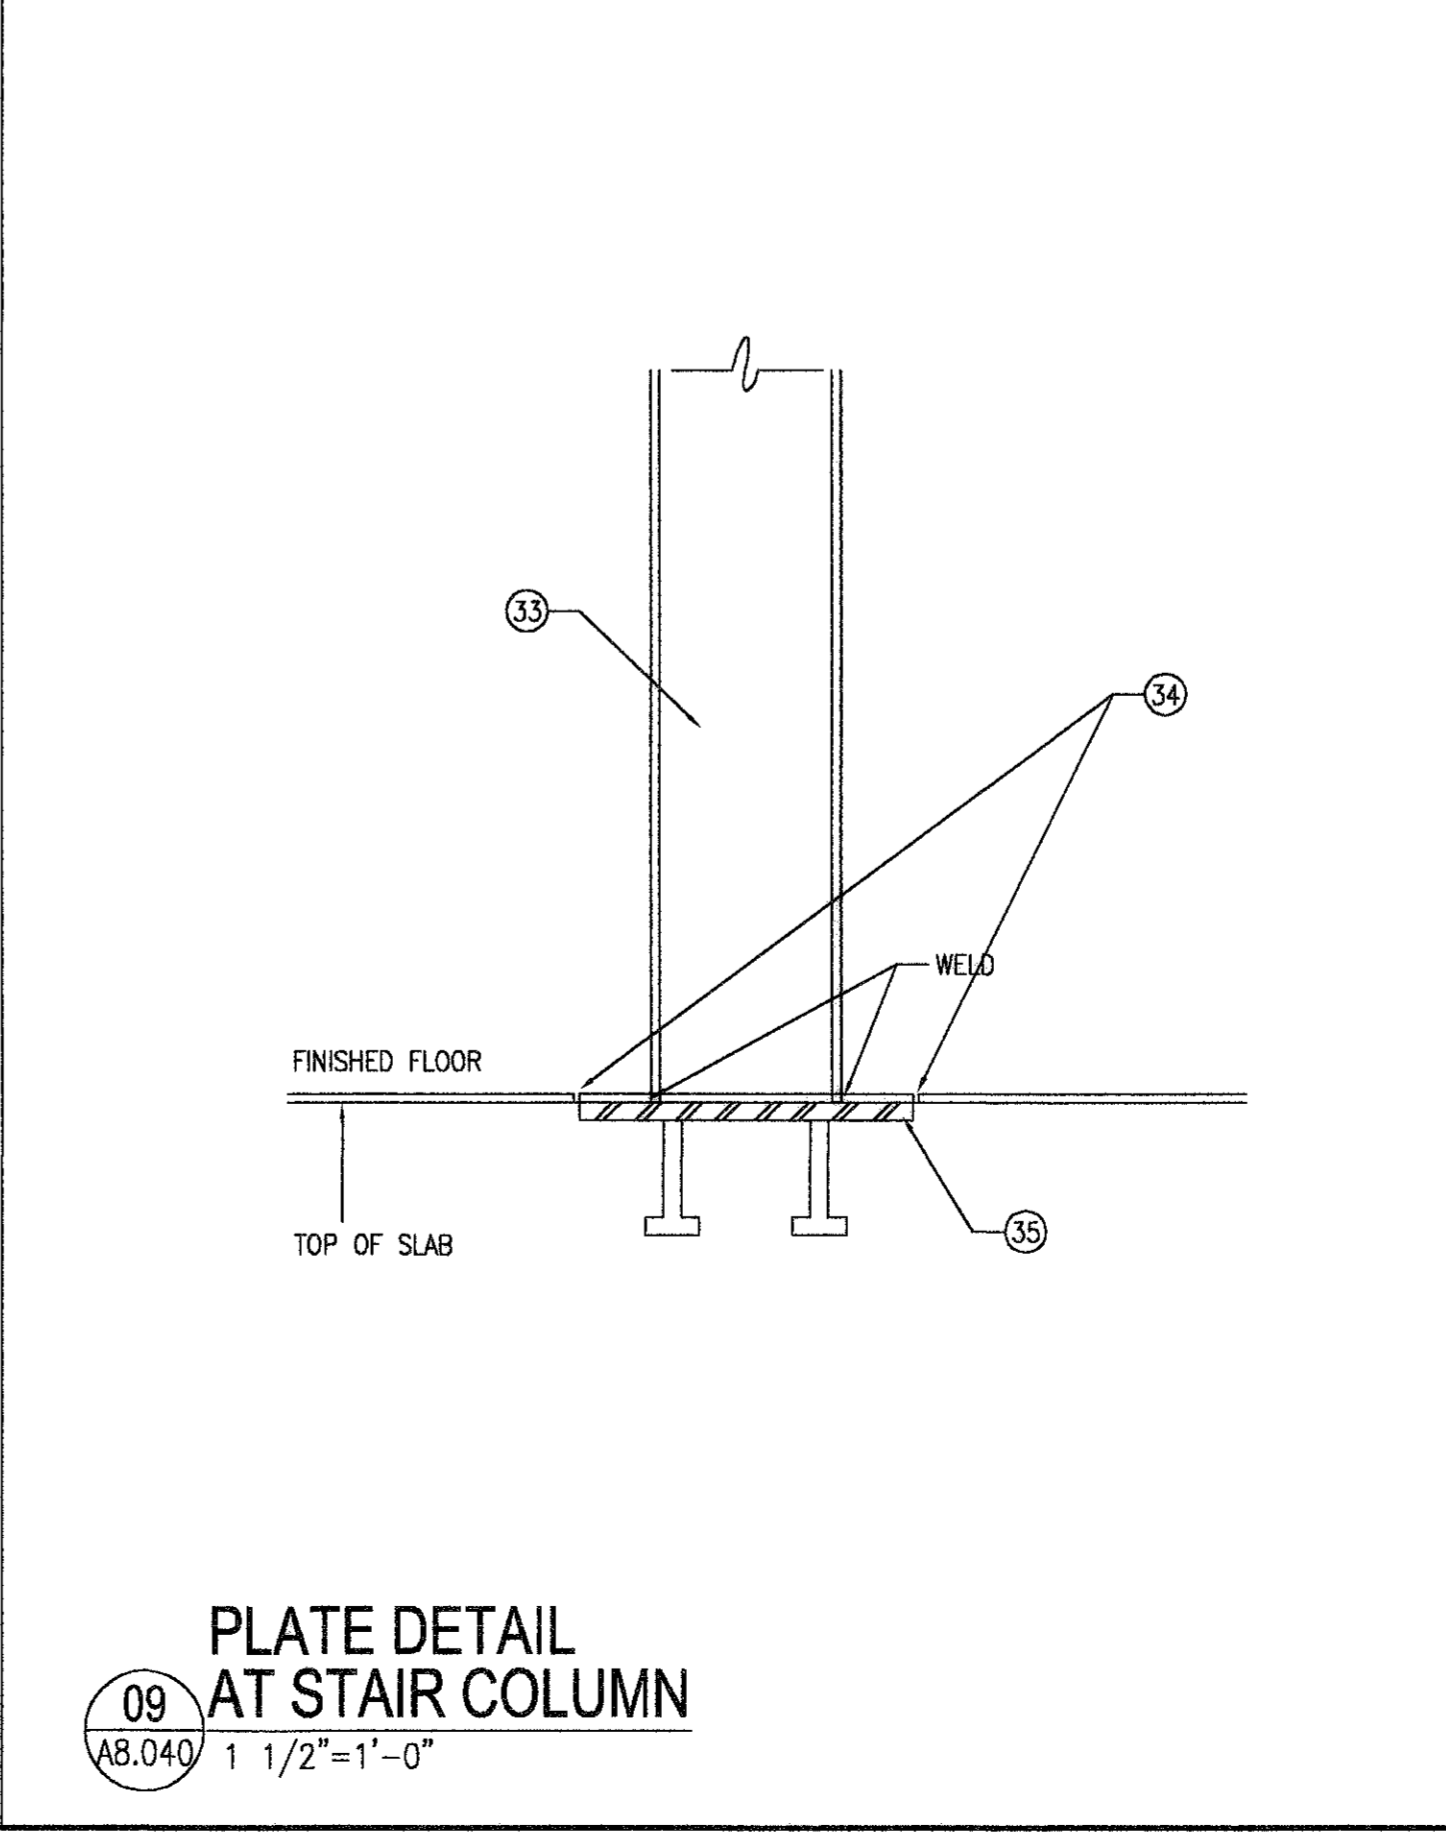

**09** PLATE DETAIL  
AT STAIR COLUMN  
AB.040 1 1/2"=1'-0"

**GENERAL NOTES:**

- EMP-2 EXTERIOR POWDERCOATED WALL METAL PANELS - ALUMINUM PANEL 1/8" THICK - TYPE SERIES 3000 MODIFIED FROM UNA-CLAD - COPPER SALES OR EQUAL - POWDERCOATED KYMAR 500
- RF-1 STANDING SEAM METAL ROOF - TYPE UCS FROM UNA-CLAD - COPPER SALES OR EQUAL - THERMOCLAD KYMAR 500; COLOR#2 SILVER METALLIC

**KEYED NOTES:**

- 1 PREFINISHED RIDGE / HIP COPING
- 2 FASTENERS
- 3 PREFINISHED J-CHANNEL
- 4 5/8" THK. GYPSUM BOARD TYPE X
- 5 UNDERLAYMENT
- 6 PREFINISHED UC-3 STANDING SEAM PANEL
- 7 SEALANT
- 8 PANEL TO BE CUT AND SET IN SEALANT WHERE REQUIRED
- 9 3" METAL DECK
- 10 PART OF CURVED PANEL TYPE EMP-1
- 11 PART OF PLANE PANEL
- 12 LINE OF WELD ALONG INTERSECTION OF SLOPED SOFFIT PLANE AND 2'-0" CYLINDER PANELS CUT WITH WATER SAW
- 13 CONTINUOUS WELDING PERFECTLY SANDED
- 14 STIFFENERS AS REQUIRED TO MAINTAIN SHAPE AND STIFFNESS OF PANEL
- 15 HEIGHT AND LENGTH OF LAST PANEL DIFFERENT ON NORTH AND SOUTH FACADES FINAL DIMENSIONS TO BE COORDINATED WITH 500F-1 @ SECURE BRIDGE AND TO BE FIELD VERIFIED
- 16 MAXIMUM HEIGHT OF METAL PANEL SHOWN ON DRAWING
- 17 CONCRETE BEAM - TAPER TO 42" @ SECURE BRIDGE WITH 9"x9" CHAMFER @ START OF SLOPE RE STRUCTURAL
- 18 WELDED PANEL 1
- 19 WELDED PANEL 2
- 20 LAST WELDED PANEL @ END HEIGHT AND LENGTH TO BE COORDINATED
- 21 TS 4"x4"x3/8" STEEL COLUMN
- 22 L 4"x3"x3/8" STEEL ANGLE W/ HORIZONTAL & VERTICAL SLOTTED HOLES AS SHOWN. FIELD WELD ALL AROUND ANGLE TO COLUMN AND PLATE AFTER CHANNEL FULLY INSTALLED AND POSITION VERIFIED
- 23 (2) 3/4" DIA. A 325 BOLTS IN HORIZONTAL SLOTTED HOLES OF ANGLE.
- 24 (2) 3/4" DIA. A 325 BOLTS, THROUGH STRUCTURAL TUBE, IN VERTICAL SLOTTED HOLES OF ANGLE.
- 25 NOT USED
- 26 1/2" THK. PLATE. CUT AROUND CHANNEL TO FIT. WELD TO CHANNEL.
- 27 DRILL #7, TAP 1/4"-20, (8 PLACES), TYP BOTH ENDS
- 28 DRILL 1.25", HOLE FOR VITAL CABLE
- 29 DRILL 1 3/8", HOLE FOR 1/0 CABLE
- 30 DRILL 1.00", HOLE FOR POWER CABLE
- 31 MC6 X 16.3" STEEL CHANNEL, 190" LONG (PLAN STEEL), PUNCH HOLES PRIOR INSTALLATION.
- 32 9/16" X 1.00" SLOT (8 PLACES)
- 33 8" X 8" TS @ STAIR LANDING
- 34 CONTROL JOINT @ PLATE
- 35 EMBEDDED E 3/4" x 14" x 14" W/ (4) 3/4" HEADED CONC ANCHORS, 6" EMBEDMENT
- 36 NOT USED
- 37 STAINLESS STEEL CLAD
- 38 ESCALATOR FRAME
- 39 PARTITION TYPE 3
- 40 LOUVERS, TYPE EMP-2, POWER COATED
- 41 1/2" EXTRUDED ALUMINUM ANGLE AT REVEAL, PREFINISHED
- 42 BENT STAINLESS STEEL BASEPLATE, 14 GA, NON-DIRECTIONAL POLISH, MINIMUM LENGTH 10'-0" JOINT ALIGNED WITH BUILDING GRID, ADHERED TO 1/2" BOARD SECURED TO METAL STUDS
- 43 6" GALVANIZED STEEL PLATE, 20 GA, ADHERED TO METAL STUDS
- 44 1/2" PLYWOOD BOARD SECURED TO METAL STUDS
- 45 LOUVERS FRAME ALUMINUM POWDERCOATED
- 46 STAINLESS STEEL POLE MIN SIZE 2 1/2" DIA., 3/8" THCK. WELD TO EMBEDDED PLATE. WELD TOP CAP. GRIND SMOOTH WELDS. SSTL #4 FINISH
- 47 EMBEDDED STEEL PLATE 6"x6"x3/4", WITH 4 HEADED CONC. ANCHORS 3/4" DIA. 6" LONG.
- 48 GLASS DOOR 3/8" TEMPERED. PUNCH ALL HOLES REQUIRED FOR HARDWARE PRIOR TEMPERING COORDINATE FINAL DIMENSIONS WITH HARDWARE REQUIREMENTS
- 49 FIXED GLASS PANEL 3/8" THCK TEMPERED. PUNCH HOLES REQUIRED FOR HARDWARE PRIOR TEMPERING
- 50 EXTEND STAIR HANDRAIL TO POLE AND WELD. GRIND SMOOTH
- 51 PATCH LOCK FROM C.R. LAURENCE COMPANY OR EQUAL. POLISHED STAINLESS FINISH. AMR SERIES AMR205PS. WITH CYLINDER AMR2050C
- 52 GLASS MOUNTED LATCH WITH LOCK AND THUMBTURN FROM C.R. LAURENCE COMPANY OR EQUAL. POLISHED STAINLESS FINISH. PTH311PS
- 53 GLASS MOUNTED LONG PATCH LOCK KEEPER FROM C.R. LAURENCE COMPANY OR EQUAL. POLISHED STAINLESS FINISH. PTH314PS
- 54 TUBULAR STYLE LEVER HANDLES FROM C.R. LAURENCE COMPANY OR EQUAL. POLISHED STAINLESS FINISH. PTH SERIES PTH302PS
- 55 SWINGING OFFSET PIVOT HINGE FROM C.R. LAURENCE COMPANY OR EQUAL. CRL CHROME FAD44CH.
- 56 LARGE ROUND GLASS CLAMPS FROM C.R. LAURENCE COMPANY INC. OR EQUAL. POLISHED STAINLESS FINISH. Z145PS

**RECORD DRAWINGS**  
DO NOT MODIFY  
Rey de la Raza Architects, Inc.  
13 May 2005

Note: Information used to develop these documents was taken from Record of the Work Drawings prepared by the construction contractor, Clark Construction Group - Texas. The information provided by the contractor was not verified by the design firm named above.

**HOUSTON AIRPORT SYSTEM**  
GEORGE BUSH  
INTERCONTINENTAL AIRPORT  
HOUSTON TEXAS

**Lea-Elcott**  
1009 W RANDOL MILL RD  
HOUSTON, TX 77062  
Tel: 817.261.1448  
Tel: 817.881.3296

**REY DE LA RAZA ARCHITECTS, INC.**  
ARCHITECTS PLANNING INTERIOR DESIGN  
1045 WEST 18TH ST.  
HOUSTON, TX 77008  
Tel: 713.868.3721  
Tel: 713.862.0122

**REVISIONS**

NO.	DESCRIPTION	DATE	BY
1	ISSUED FOR BID	10/19/01	
2	ADDENDUM 1	02/01/02	SG
3	ADDENDUM #3	02/15/02	SG
4	REVISION #1	01/27/03	SG
5	RECORD SET	05/13/05	EM

**INTERNATIONAL SERVICES • EXPANSION • PROGRAM**

**APM STATION + PLATFORM**

**DETAILS**

PROJECT MGR: HEM  
DESIGNER: SG  
DRAWN BY: SEM  
CHECKED BY: SEM  
DRAWING STANDARD: ISDP 07.20.2000  
SCALE: AS NOTED  
DATE: 09/14/01

APPROVED BY: DATE:

PROJECT NO. 1140  
C.I.P. NO. A-0354  
H.A.S. NO. 536C  
SHEET NO. 52

**A8.040**

PLOT DATE: 02/04/02 HAS FILE: A836CAB040



REVISIONS			
NO.	DESCRIPTION	DATE	BY
1	ISSUED FOR BO	10/18/01	
2	RECORD SET	05/13/05	EM

**GENERAL NOTES:**

- NO PERFORATION ALLOWED IN A/C DUCT GALVANIZED STEEL ENCLOSURE.
- STEEL BRACKETS WILL BE USED TO SECURE THE A/C DUCT. THE CLADDING WILL BE FIXED TO THE STEEL FRAME.
- AC-1 PRE-FINISHED CURVED, PERFORATED METAL CEILING PANEL WITH ACOUSTICAL INSULATION - ALUM. VAULT SYSTEM 1000 BY GORDON MANUFACTURER OR EQUAL - 0.032 GA

**KEYED NOTES:**


- ALUMINIUM CLADDING - 1/8" THK - PRE-FINISHED: POWDER COATED SAME COLOR THAN CEILING.
- STEEL BRACKETS AROUND A/C DUCT @ 10'-0" O.C. BOLT TO 5"x5" STEEL TUBES SECURED TO THE STRUCTURAL BEAMS. THE STEEL BRACKETS ARE BUILT IN TWO PARTS: EACH PART IS COMPOSED OF TWO 1/4" STEEL GUSSETS WELDED TO A 5-1/2"x1/8" THK. OVAL STEEL PLATE. THE TWO PARTS ARE BOLTED TOGETHER.
- W6 STEEL BEAM: RE STRUCTURAL
- ALUMINIUM CLADDING AROUND VERTICAL SUPPORT: 1/8" THK. POWDERCOATED
- SCHEDULE LIGHT FIXTURE - RE ELECTRICAL
- 1/4" STEEL GUSSET WELDED TO 1/8" THK. STEEL PLATE
- BENT STEEL PLATE - 1/8" THICK - GALVANIZED - SECURED TO STEEL BRACKET SHIM ON SPIRAL DUCT - PERFECTLY HORIZONTAL
- NOT USED
- SPLICE RING
- ANCHOR AND SHIM AS REQUIRED
- A/C DUCT: DOUBLE WALL OVAL SPIRAL DUCT - RE MECHANICAL
- STEEL STUD SECURE TO METAL DECK
- REVEAL: PRE-FINISHED EXTRUDED ALUM. CHANNEL
- SHIM AS REQUIRED
- STEEL ANGLE BOLTED TO W6 BEAM OR TO CURVED W16 BEAM WHEN ALIGNED
- 5"x5" STEEL TUBE BOLTED TO STEEL ANGLES @ W6 BEAM AND TO GUSSETS @ STEEL BRACKET
- 5"x5" STEEL TUBE BOLTED TO GUSSETS @ BEAM AND TO GUSSETS @ STEEL BRACKET
- 5-1/2" x 1/8" THK. STEEL PLATE
- ALUM. CLADDING FIXED TO STEEL BENT PLATE - SHIM AS REQUIRED
- 1/4" THK. GUSSETS EACH SIDE OF STEEL TUBE: WELDED TO BRACKET STIFFENERS
- TWO 6"x8"x1/4" GUSSETS WELDED TO THE BEAM
- BOLTED CONNECTION B/W EACH PART OF STEEL BRACKET
- 2"x4" STEEL TUBE - BOLTED TO GUSSETS @ STEEL BRACKETS - SPAN 10'
- SCHED SLOT RE MECHANICAL - DIFFUSER MATERIAL, CURVE AND FINISH TO MATCH DUCT CLADDING
- ALUM. CLADDING PANELS SECURED TO STEEL TUBE
- EXTRUDED ALUM. INSERT - JOINTS ALIGNED WITH JOINTS @ CLADDING - POWDERCOATED
- LOUVERS WITH ELLIPTICAL FRAME SECURED TO STEEL FRAME - PRE-FINISHED ALUM.
- STIFFENERS @ CLADDING AS REQUIRED TO MAINTAIN SHAPE AND STIFFNESS
- CONTINUOUS 1/4" THK. GUSSETS WELDED TO BRACKET WITH WELDED STEEL PLATE @ END
- CONTINUOUS 1/8" BENT STEEL PLATE WITH WELDED PLATE @ END
- PRE-FINISHED ELLIPTICAL ALUM. RING 1/4" THK WITH 1-1/2" x 1/8" ALUM. PLATE WELDED @ INTERIOR FACE
- GALVANIZED STEEL SHEET METAL WRAP AROUND DUCT @ END - SEALED
- STEEL ANGLE SECURED TO STEEL FRAME

INTERNATIONAL SERVICES • EXPANSION PROGRAM  
**APM STATION + PLATFORM**  
 INTERIOR DETAILS

PROJECT MGR:	HEM
DESIGNER:	SG
DRAWN BY:	SEM
CHECKED BY:	AB
DRAWING STANDARD:	ISRP 07.20.2000
SCALE:	AS NOTED
DATE:	09/14/01

**RECORD DRAWINGS**  
 DO NOT MODIFY  
 Rey de la Reza Architects, Inc.  
 13 May 2005

Note: Information used to develop these documents was taken from Record of the Work Drawings prepared by the construction contractor, Clark Construction Group - Texas. The information provided by the contractor was not verified by the design firm named above.

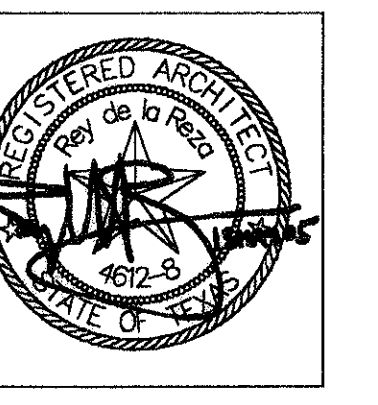

APPROVED BY:	DATE:
DIRECTOR	
HOUSTON AIRPORT SYSTEM	
PROJECT NO.	1140
C.I.P. NO.	A-0354
H.A.S. NO.	536C
SHEET NO.	

NOTE: REFER TO GRAPHIC SCALE IF ACTUAL SHEET SIZE IS OTHER THAN 30"x42".  
 SCALE: 1/4" = 1'-0"

**01 DUCT PLAN**  
 A9.000 1/2"=1'-0"

**02 DUCT DETAIL PLAN @ STRUCTURE**  
 A9.000 1/2"=1'-0"

**03 DUCT RCP**  
 A9.000 1/2"=1'-0"

**04 DUCT ELEVATION**  
 A9.000 1/2"=1'-0"

**05 DUCT DETAIL SECTION**  
 A9.000 1-1/2"=1'-0"

**06 DUCT DETAIL SECTION**  
 A9.000 1-1/2"=1'-0"

**07 DUCT DETAIL ELEVATION @ END**  
 A9.000 1/2"=1'-0"

**08 DUCT DETAIL SECTION @ BRACKET**  
 A9.000 1-1/2"=1'-0"

**09 DUCT DETAIL SECTION @ BRACKET**  
 A9.000 1-1/2"=1'-0"

**10 DUCT DETAIL SECTION @ END**  
 A9.000 1-1/2"=1'-0"

PLOT DATE: 02/04/02 HAS FILE: A3363CAB000



NO.	DESCRIPTION	DATE	BY
RECORD SET	05/13/05	EM	

GENERAL NOTES:

- (AC-1) PRE-FINISHED CURVED, PERFORATED METAL CEILING PANEL WITH ACOUSTICAL INSULATION - ALUMA VAULT SYSTEM 1000 BY GORDON MANUFACTURER OR EQUAL
  - (IMP-1) INTERIOR STAINLESS STEEL WALL PANELS - DEMOUNTABLE WALL SYSTEM BY NELSON INDUSTRIAL INC. OR EQUAL - 14 GA WITH STIFFENERS -
  - (AC-2) REMOVABLE SSSL CEILING PANELS - HOOK-ON CONCEALED PLANK FROM HUNTERDOUGLAS PRODUCT INC. OR EQUAL - 24 GA SSSL MULTI DIRECTIONAL MACHINE POLISH
- PROVIDE 3M SOUND DEADENING TAPE ON BACK OF SSSL WALL PANELS TYPE IMP-1 AT FIRST ROWS (LESS THAN 7' HIGH) - MIN. 50% AREA COVERAGE
  - PROVIDE STIFFENERS ON BACK OF SSSL PANELS TYPE IMP-1 AS REQUIRED

KEYED NOTES:


- 1 ALUMINIUM CLADDING - 1/8" THK - PRE-FINISHED: POWDERCOATED SAME COLOR THAN CEILING.
- 2 EXTRUDED ALUM. INSERT - JOINTS ALIGNED WITH JOINTS @ CLADDING - POWDERCOATED
- 3 SPLICE RING
- 4 SHIM AS REQUIRED
- 5 1/4" THK STEEL GUSSET WELDED TO STEEL BRACKET AROUND DUCT
- 6 REVEAL - SSSL
- 7 FASTENER
- 8 ALUMINIUM GRID WITH SLOTS
- 9 CLIP
- 10 SYSTEM 100 ALUMINAVALT TEE - POWDERCOATED
- 11 CEILING PANEL AC-1 CONFORM TO FACTORY CURVED TEE - POWDERCOATED
- 12 VINYL CLIP
- 13 HOLD DOWN CLIP
- 14 12 GA. HANGER WIRE SECURE TO STRUCTURE ABOVE
- 15 ALUMINIUM CLADDING @ SKYLIGHT - 1/8" THK - POWDERCOATED CUSTOM COLOR
- 16 BENT SSSL PLATE 16 GA
- 17 1-1/2" X 1-1/2" SSSL ANGLE 16 GA
- 18 "Z" HOOK-ON SUSPENSION PROFILE
- 19 SSSL HOOK-ON PLANK CEILING PANEL - 24 GA
- 20 1/8" THK BENT ALUMINIUM PLATE - POWDERCOATED
- 21 1/8" THK ALUM. ANGLE - SECURE TO STUD
- 22 GYPSUM BOARD
- 23 METAL STUD OR W16 BEAM @ SIM.
- 24 FASTENERS @ 12" O.C.
- 25 PRE-FINISHED ALUM ANGLE @ REVEAL
- 26 PRE-FINISHED ALUM. CHANNEL @ REVEAL
- 27 1 1/2" 16 GA GALVANIZED STEEL CHANNEL
- 28 "U" BOLT CROSS CONNECTOR CLAMP
- 29 2"x4" STEEL TUBE
- 30 STIFFENERS AS REQUIRED TO MAINTAIN SHAPE AND STIFFNESS OF DUCT CLADDING
- 31 WALL FINISH FACE
- 32 HOLD-DOWN CLIP
- 33 EXTRUDED ALUMINIUM CHANNEL. POWDERCOATED. JOINTS ALIGNED WITH CLADDING JOINTS

**RECORD DRAWINGS**  
 DO NOT MODIFY  
 Rey de la Reza Architects, Inc.  
 13 May 2005

Note: Information used to develop these documents was taken from Record of the Work Drawings prepared by the construction contractor, Clark Construction Group - Texas. The information provided by the contractor was not verified by the design firm named above.


INTERNATIONAL SERVICES • EXPANSION • PROGRAM  
**APM STATION + PLATFORM**  
 INTERIOR DETAILS

PROJECT MGR:	HEM
DESIGNER:	SG
DRAWN BY:	SM
CHECKED BY:	AB
DRAWING STANDARD:	SEP 07.20.2000
SCALE:	AS NOTED
DATE:	09/14/01

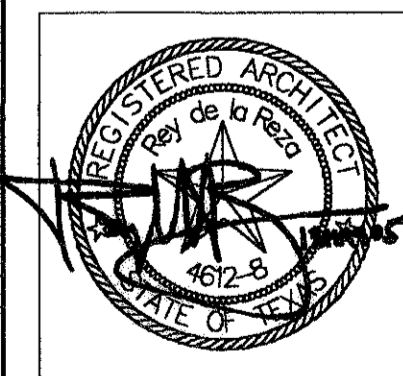


APPROVED BY:	DATE:
DIRECTOR	
HOUSTON AIRPORT SYSTEM	
PROJECT NO.	1140
C.I.P. NO.	A-0354
H.A.S. NO.	536C
SHEET NO.	


NOTE: REFER TO GRAPHIC SCALE IF ACTUAL SHEET SIZE IS OTHER THAN 30"x42".  
 SCALE: 1/4" = 1'-0"

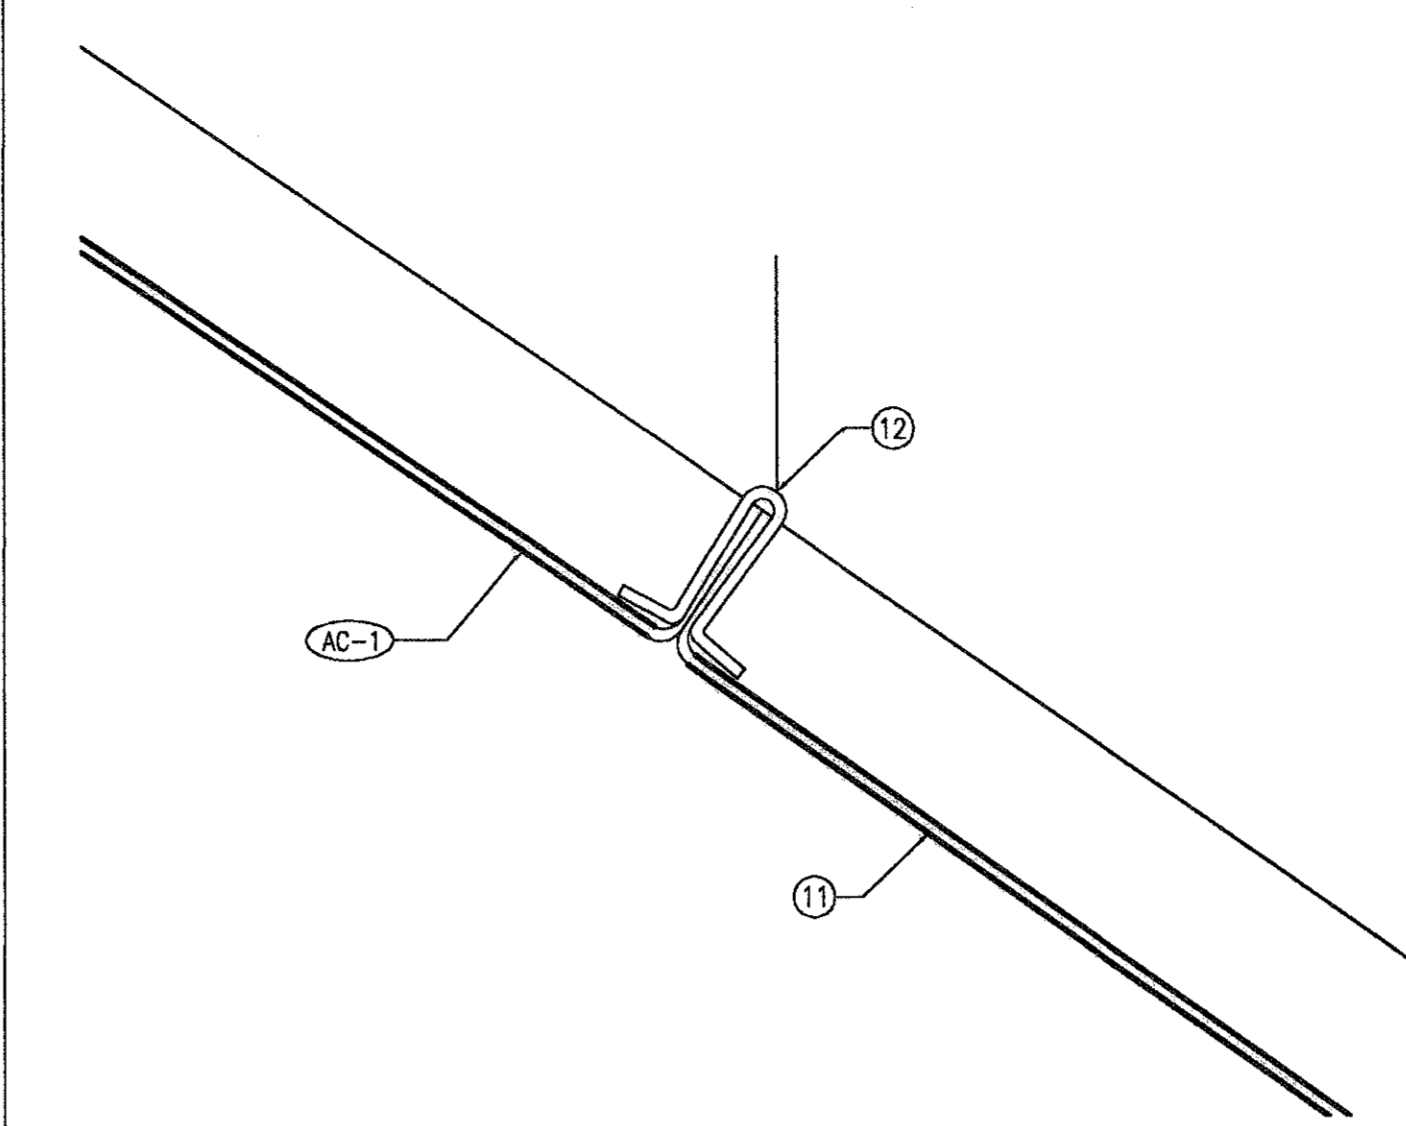


01  
 A9.001 1"=1"

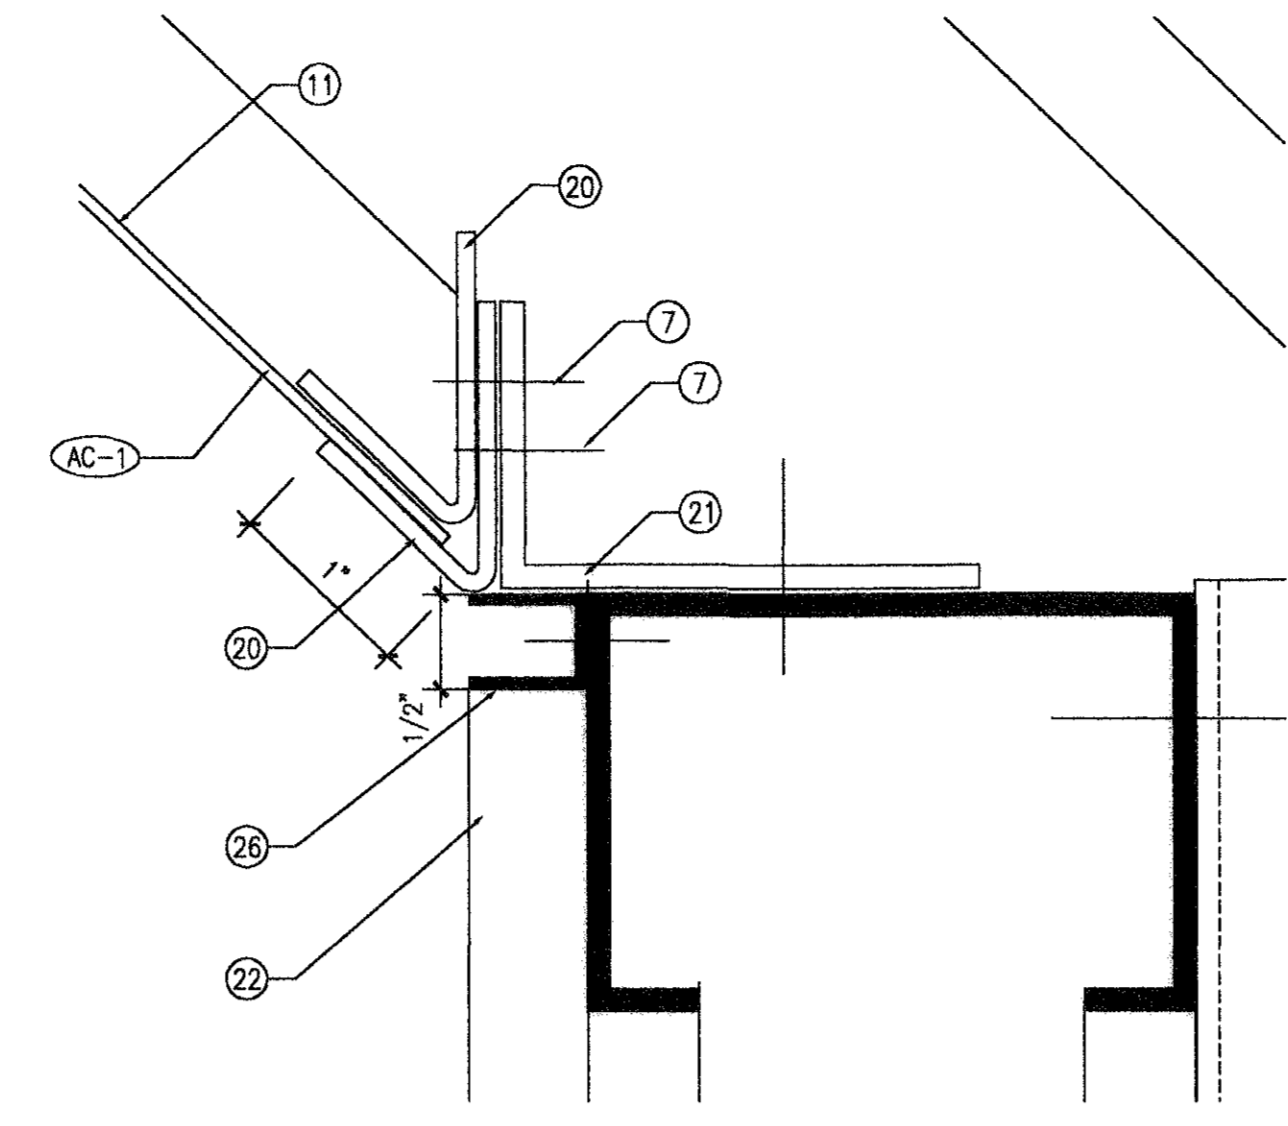


02  
 A9.001 1"=1"

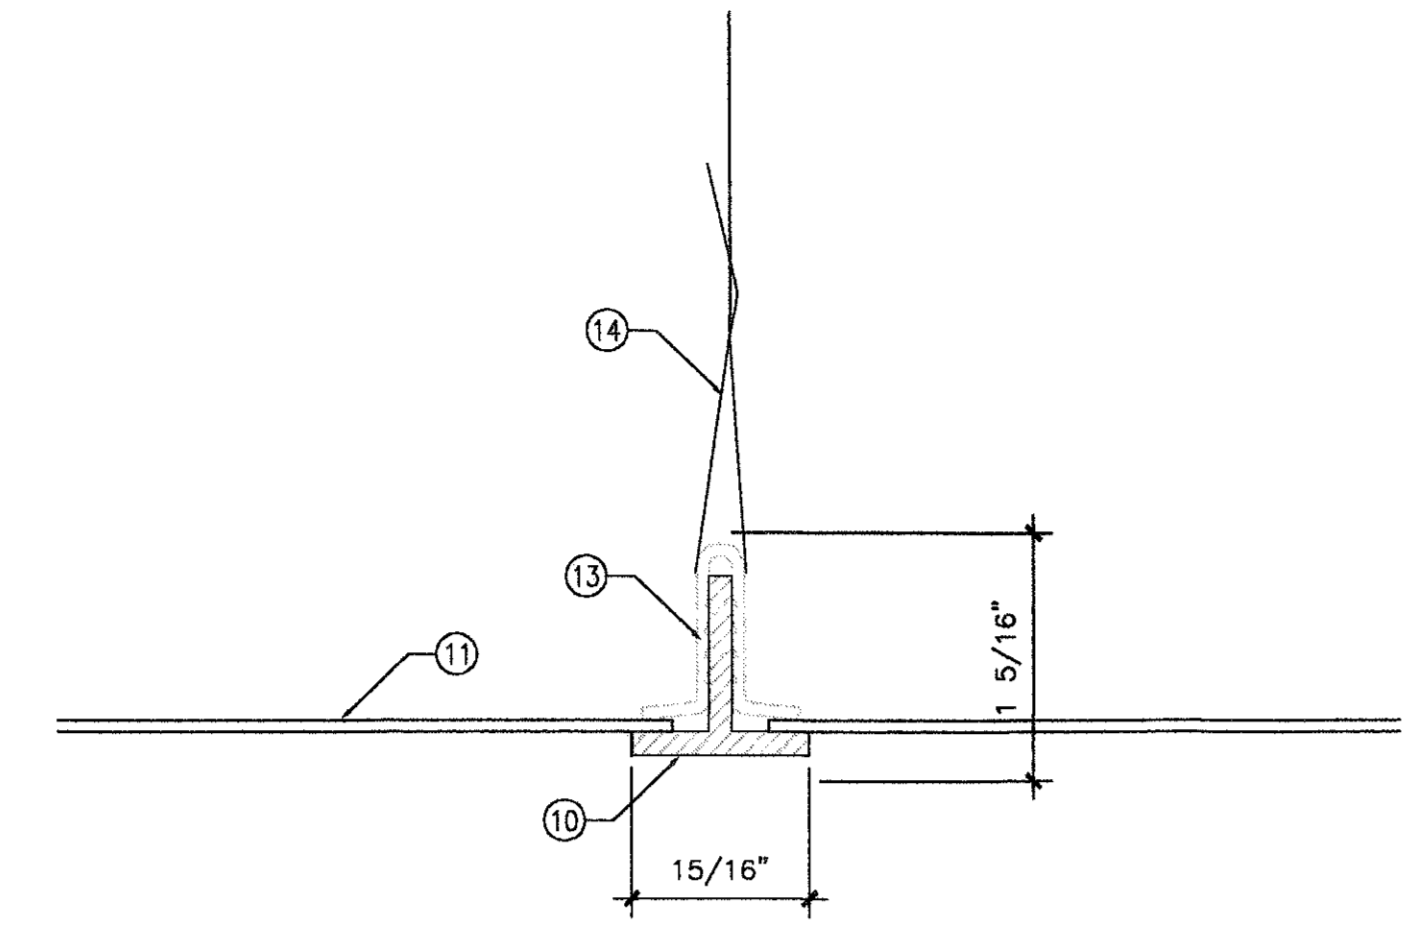


03  
 A9.001 1"=1"

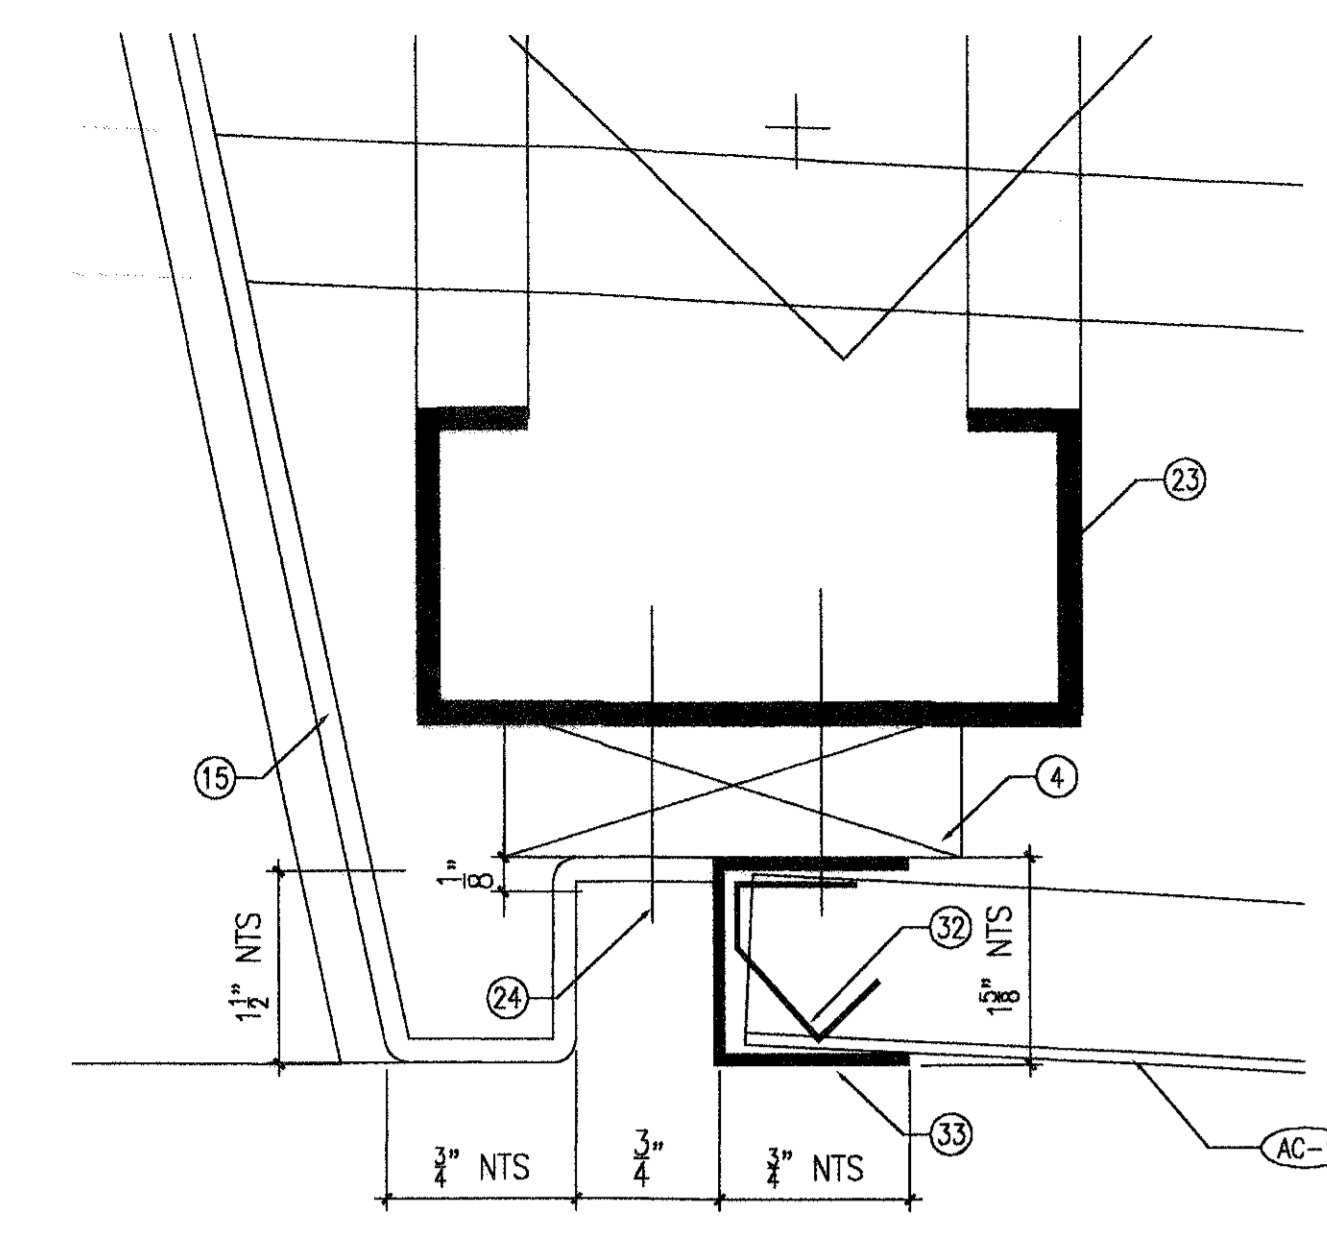

04  
 A9.001 1"=1"

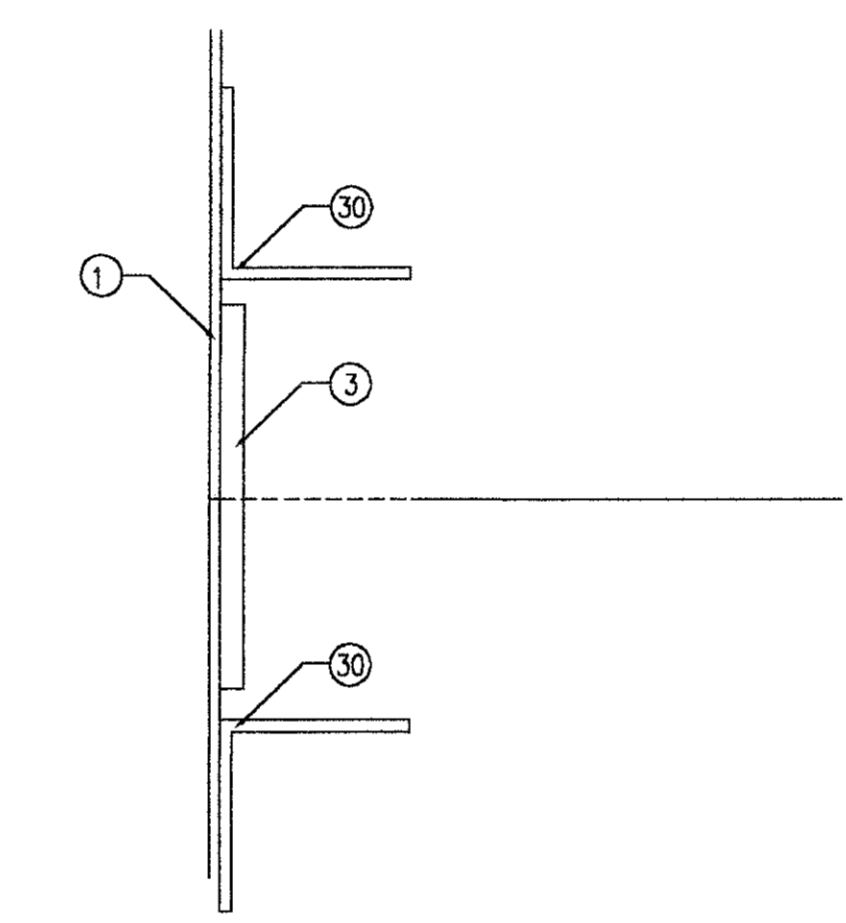


5B  
 1"=1"

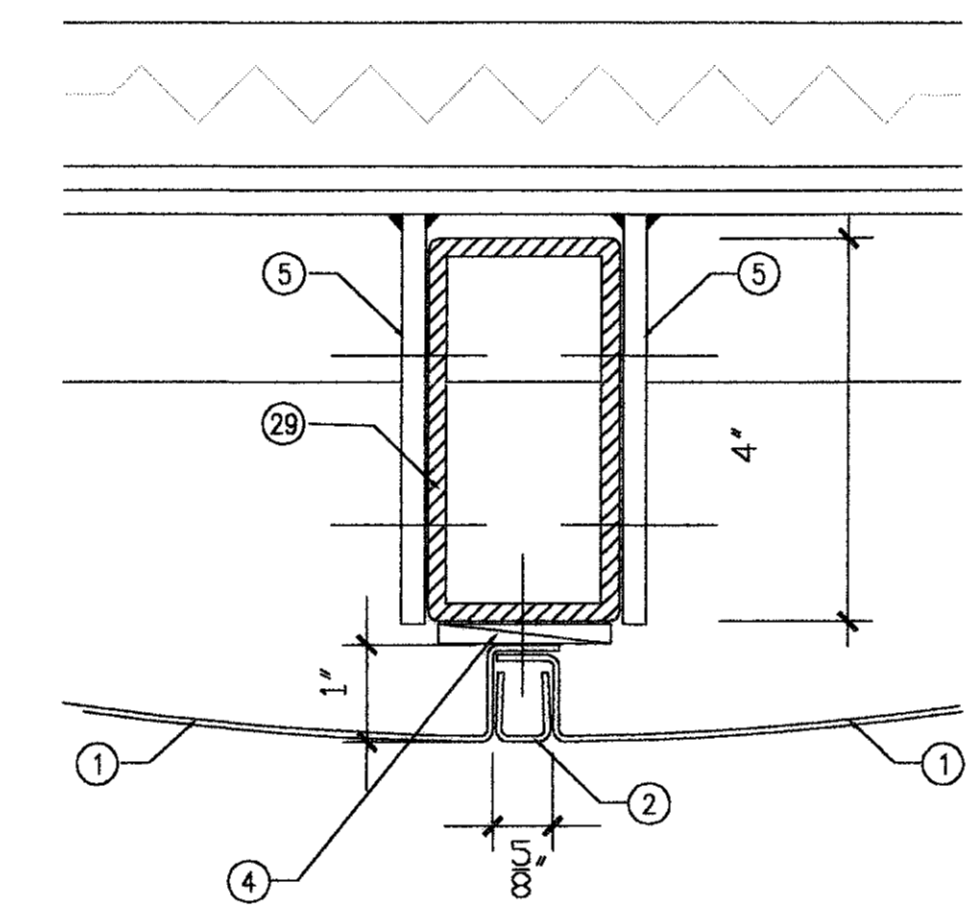


5A  
 6"=1'-0"


05  
 A9.001 AS NOTED

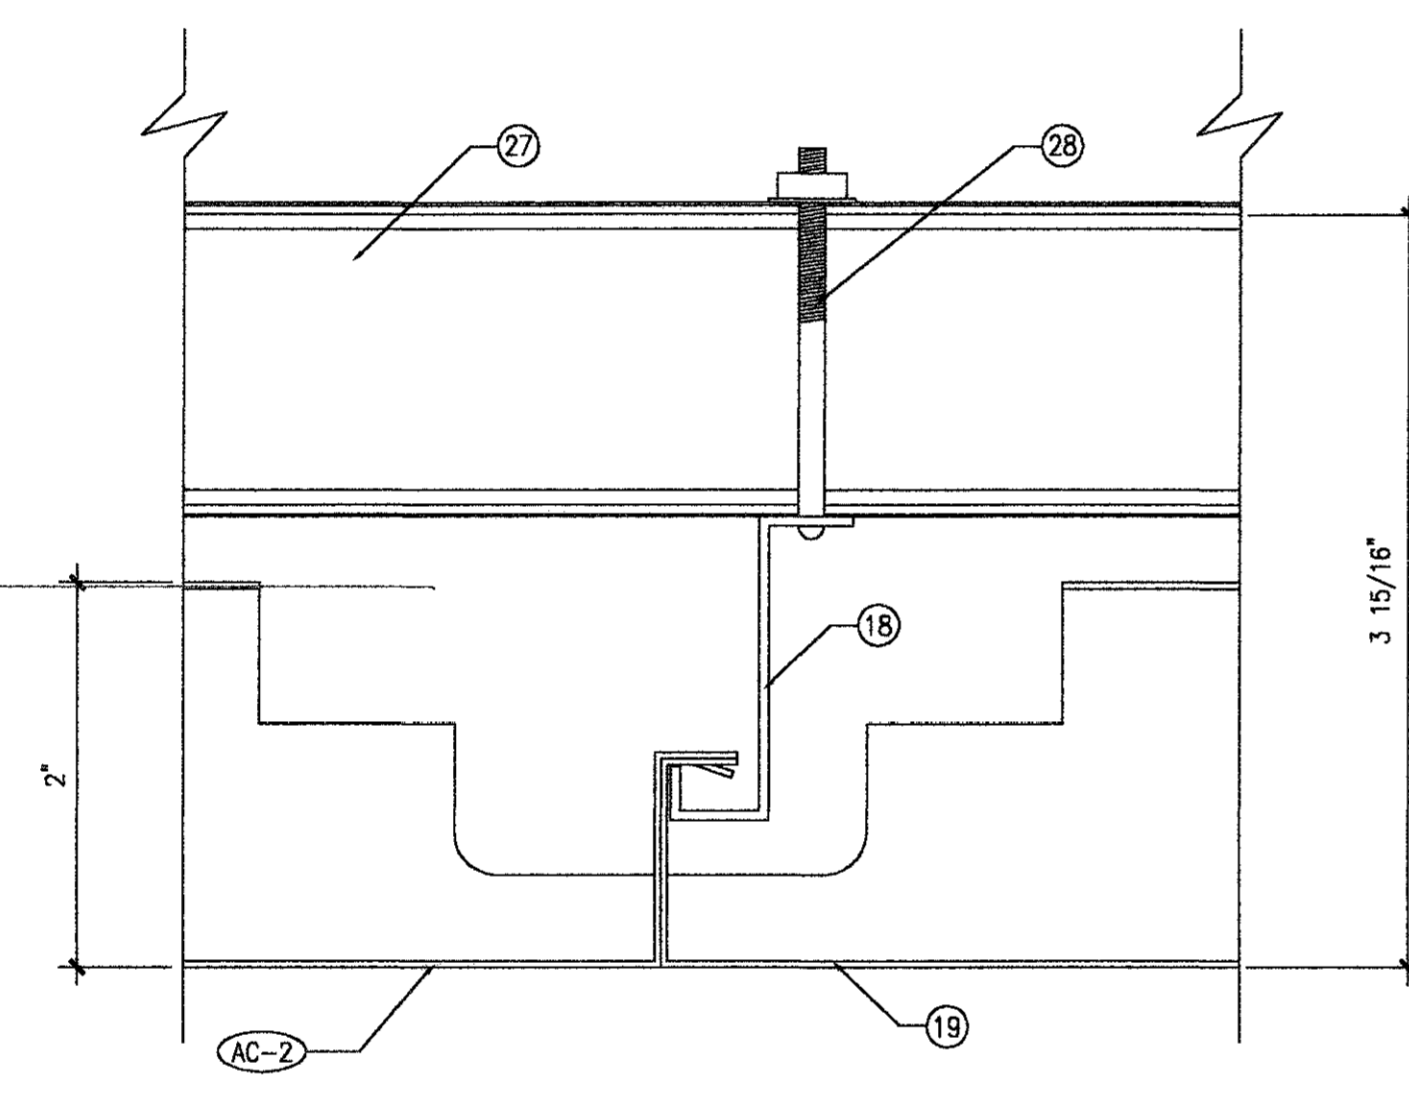


06  
 A9.001 1"=1"

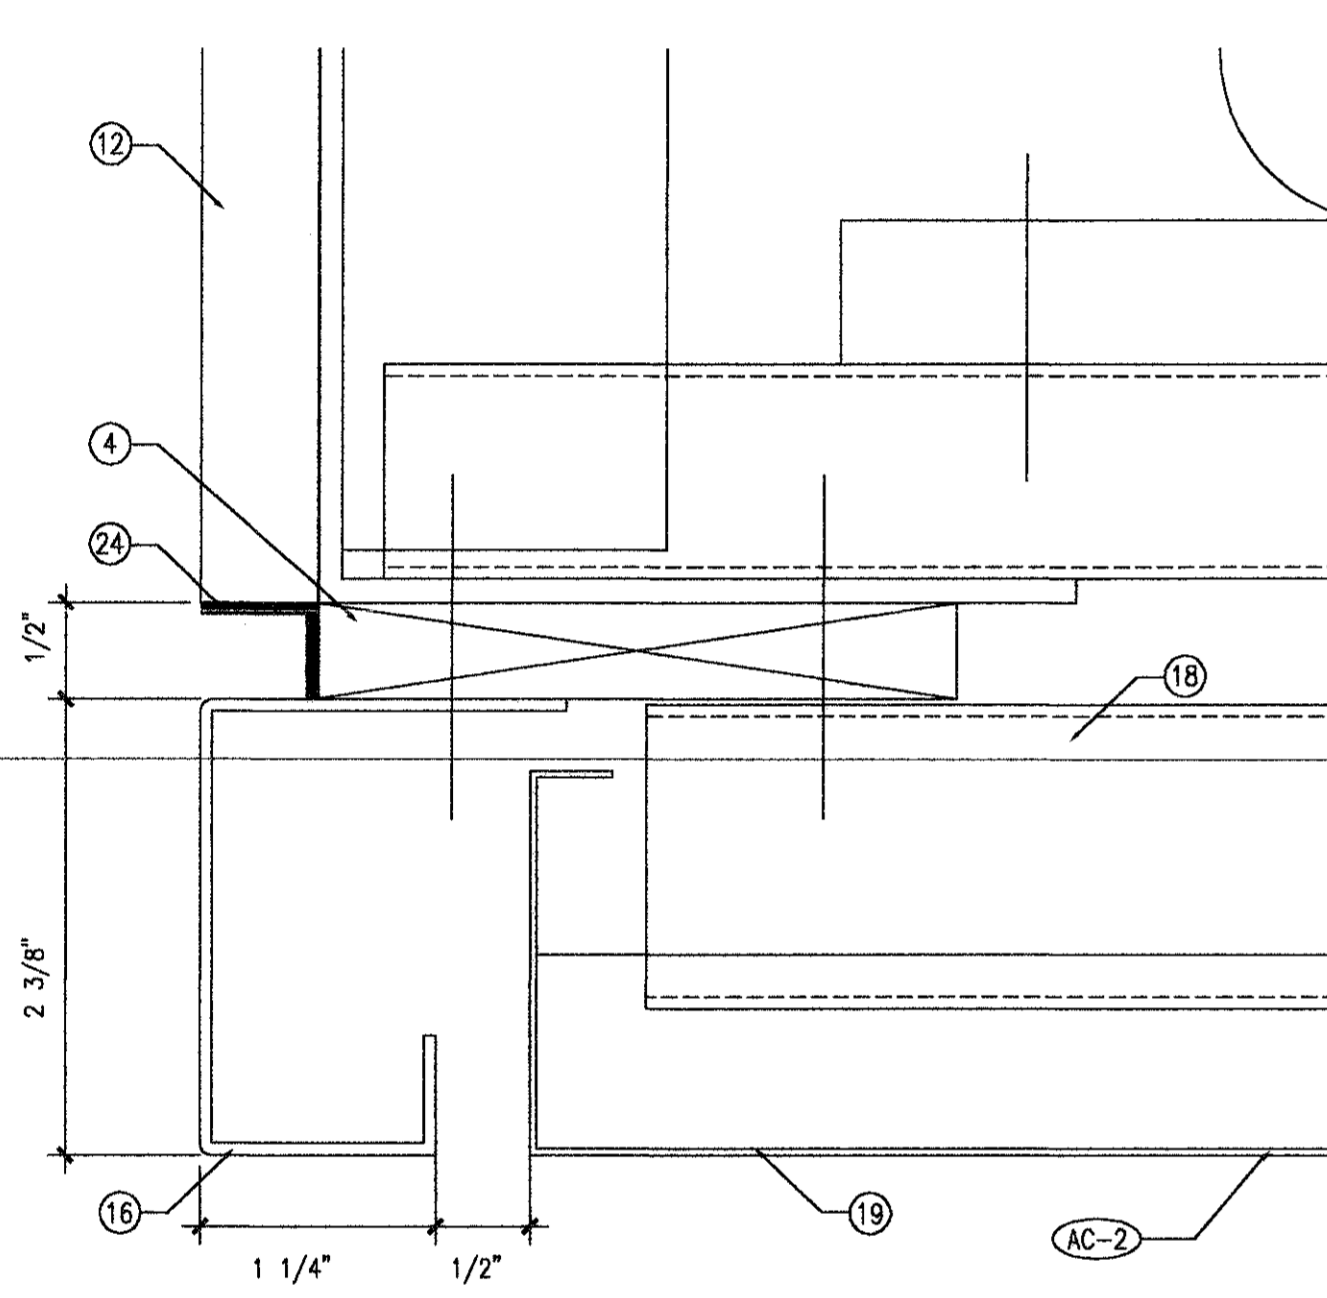


07  
 A9.001 1"=1"

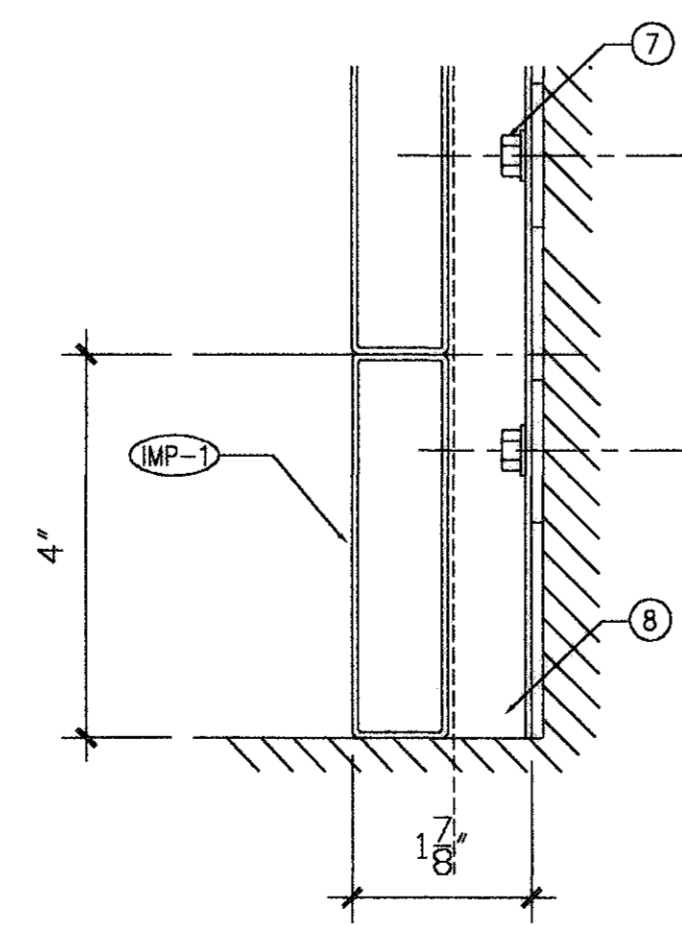


8B  
 6"=1'-0"

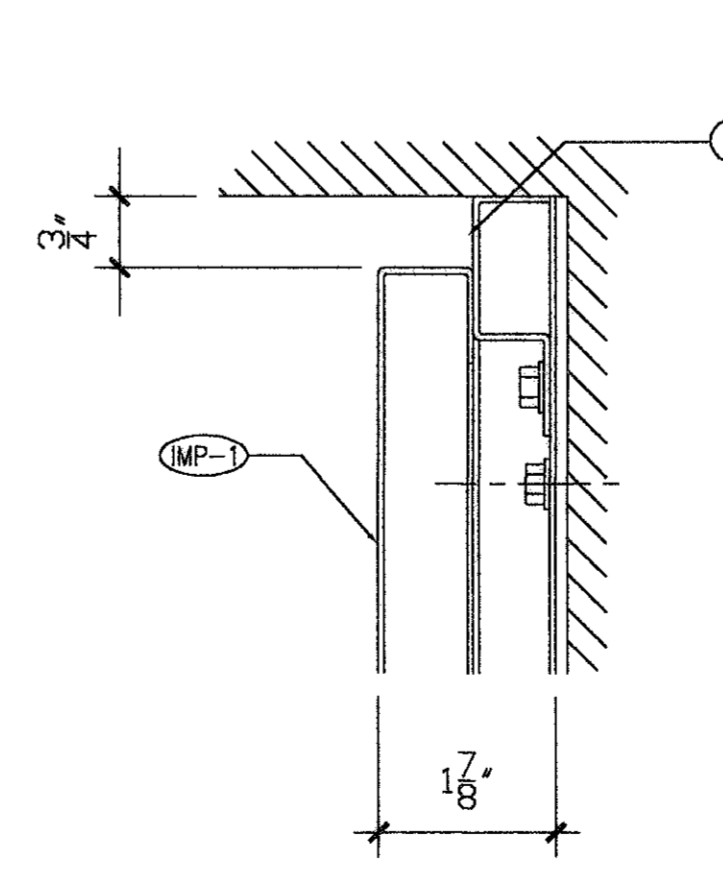

8C  
 6"=1'-0"

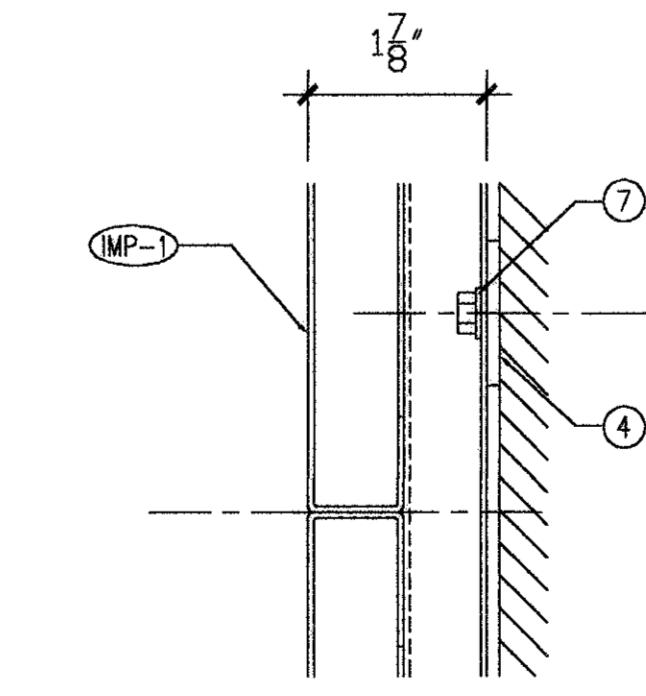


8D  
 6"=1'-0"

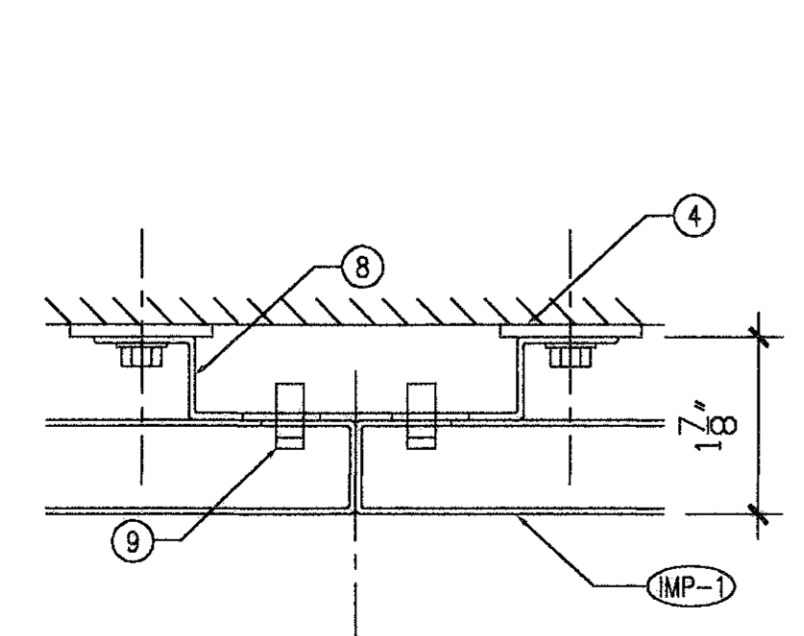

8A  
 6"=1'-0"

08  
 A9.001 6"=1'-0"

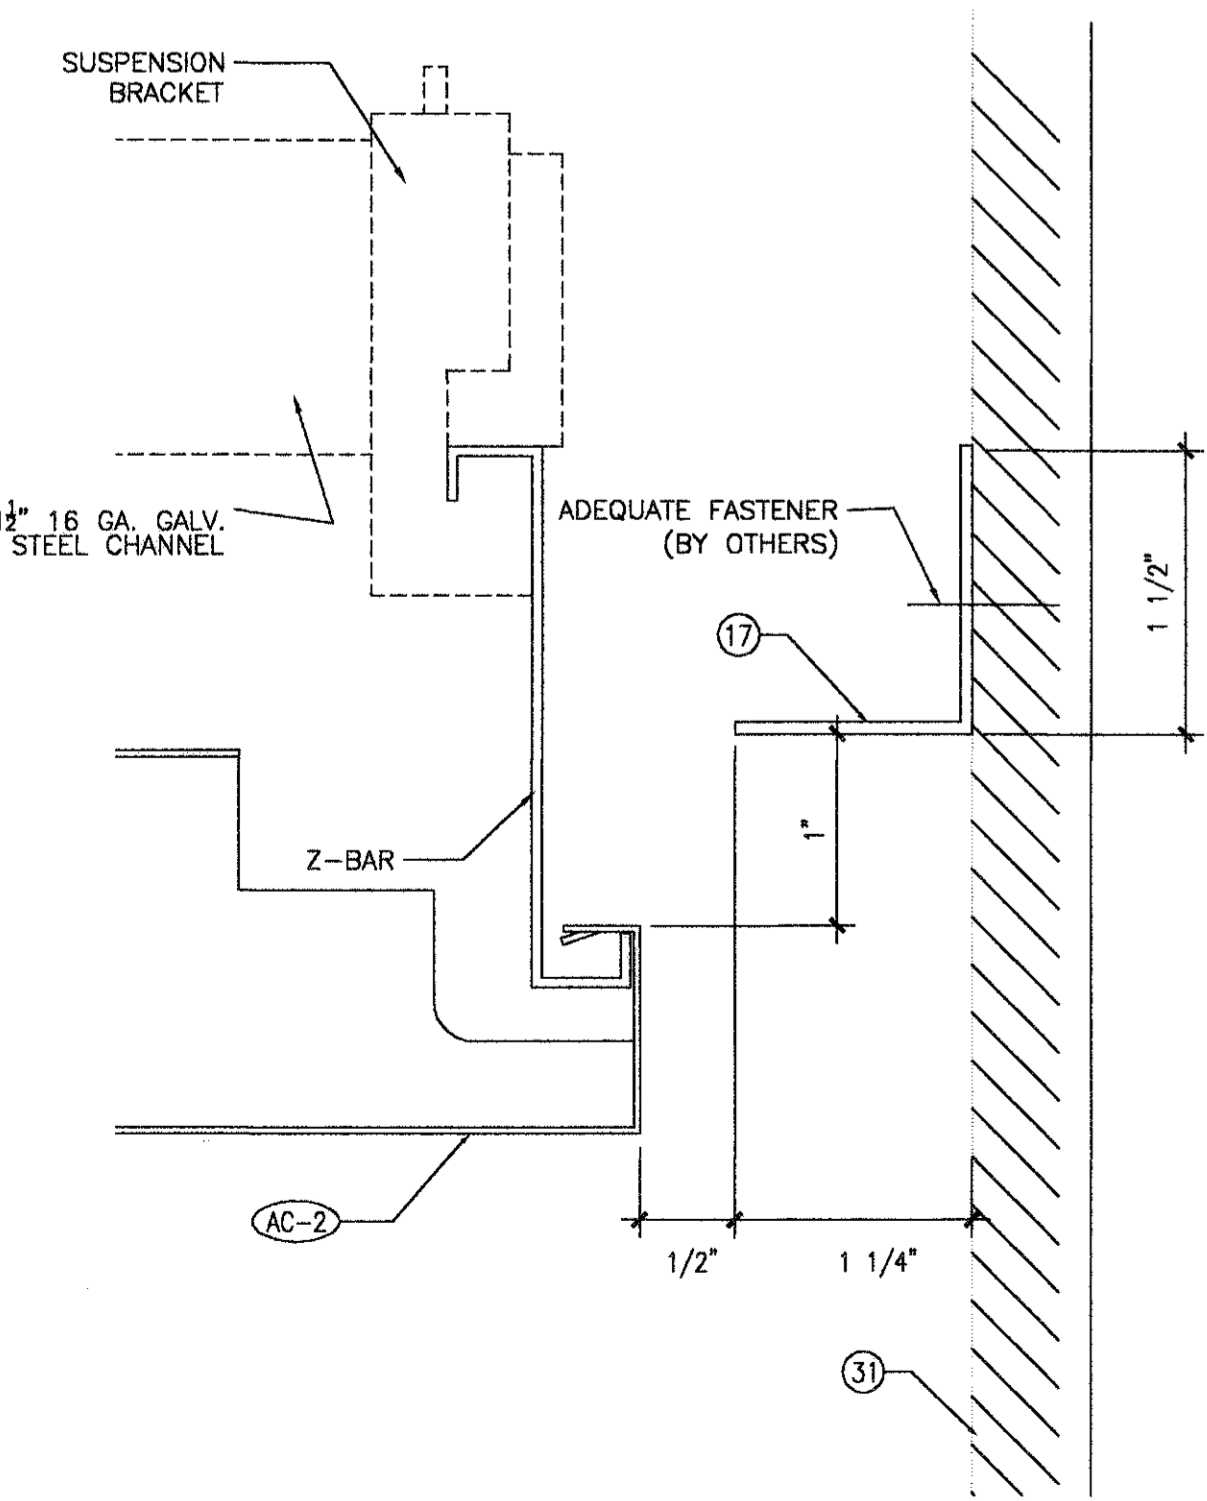

09  
 A9.001 1"=1"

PLOT DATE: 02/04/02 HAS FILE: HASVCARB01



NO.	DESCRIPTION	DATE	BY
RECORD SET		05/13/05	EM

GENERAL NOTES:


- GL-5 LAMINATED GLASS WITH PARTIAL WHITE INTERLAYER
- FL-2 TERRAZZO FLOOR TYPE 2
- AMP-1 INTERIOR STAINLESS STEEL WALL PANELS
- CAB AND DOORS DETAILS TO BE COORDINATED WITH ELEVATOR MANUFACTURER.

KEYED NOTES:

- 1 GLASS DOORS @ HOISTWAY AND CAB - CENTER OPENING
- 2 FRAME SSSL CLAD
- 3 GLASS BACK @ CAB
- 4 LADDER - GALVANIZED STEEL - SECURE TO CONCRETE STRUCTURE - RE A9.010
- 5 CONCRETE COLUMN - ARCHITECTURAL CONCRETE
- 6 CONCRETE WALL - ARCHITECTURAL CONCRETE
- 7 SSSL CLADDING - 1/16" THK MIN - NON-DIRECTIONAL MACHINE POLISH
- 8 SSSL HANDRAIL
- 9 HANDRAIL SUPPORT - SSSL
- 10 1/2" THK LAMINATED GLASS - CLEAR
- 11 INTERMEDIATE SSSL MULLION
- 12 SSSL GLASS BRACKET - 2" DIA. MAX - SECURE TO CONCRETE WALL
- 13 LAMINATED GLASS PANEL WITH WHITE INTERLAYER
- 14 LAMINATED GLASS PANEL CLEAR
- 15 SHEET METAL CLADDING - POWERCOATED
- 16 CAB FRAME BY CAB MANUFACTURER
- 17 STAINLESS STEEL HEAD
- 18 6" METAL STUD
- 19 SSSL PROFILE 2"x4"
- 20 DOOR FRAME - SSSL CLAD - 2 3/4" MAX.
- 21 EDGE OF CONCRETE WALL
- 22 STEEL ANGLE ANCHOR TO CONCRETE
- 23 DOOR SILL BY ELEVATOR MANUFACTURER
- 24 NYLON SPACER
- 25 HOLES DRILLED IN GLASS
- 26 1" SSSL TUBE WELD TO PLATE
- 27 3" SSSL PLATE 1/4" THK - ANCHOR TO CONCRETE

INTERNATIONAL SERVICES • EXPANSION • PROGRAM  
**APM STATION + PLATFORM**  
 ELEVATOR DETAILS


PROJECT MGR:	HEM
DESIGNER:	SEI
DRAWN BY:	SEM
CHECKED BY:	AB
DRAWING STANDARD:	ISEP 07.20.2000
SCALE:	AS NOTED
DATE:	09/14/01

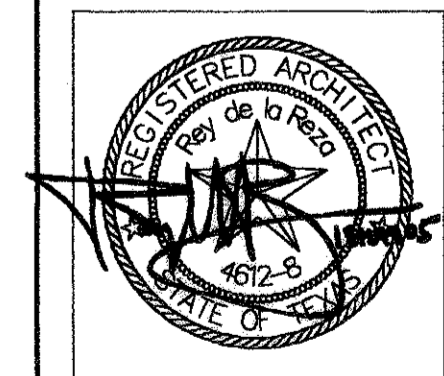


APPROVED BY: DATE:

PROJECT NO.	1140
C.I.P. NO.	A-0354
H.A.S. NO.	536C
SHEET NO.	


**RECORD DRAWINGS**  
 DO NOT MODIFY  
 Rey de la Reza Architects, Inc.  
 13 May 2005  
 Note: Information used to develop these documents was taken from Record of the Work Drawings prepared by the construction contractor, Clark Construction Group - Texas. The information provided by the contractor was not verified by the design firm named above.

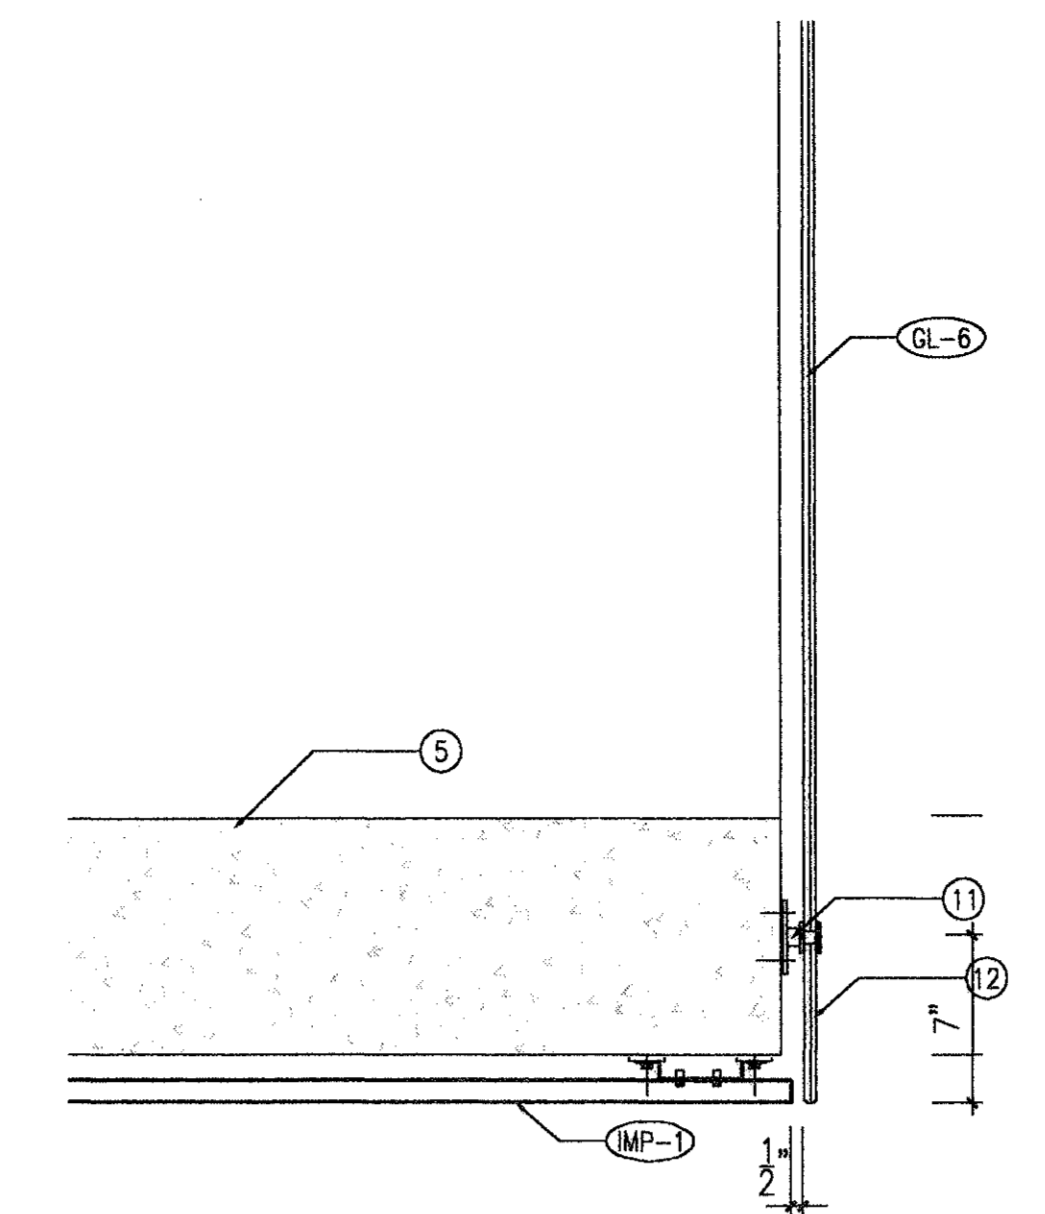


01 HOISTWAY PLAN DETAIL  
 ANGLE @ PLATFORM LEVEL  
 A9.010 1 1/2"=1'-0"

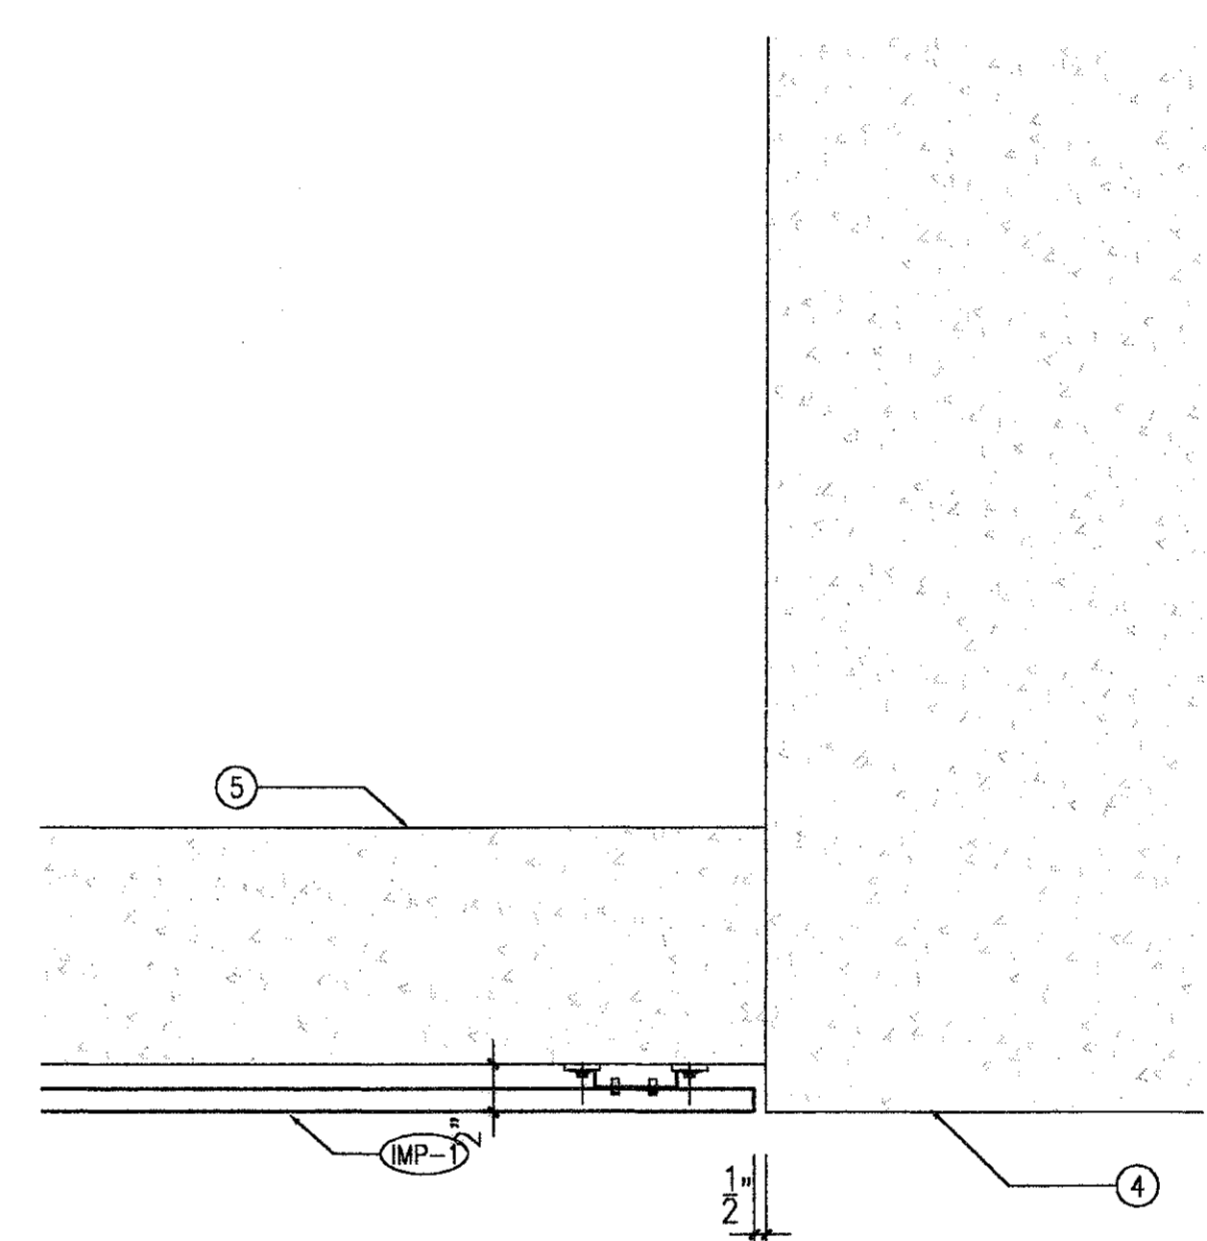


05 HOISTWAY PLAN DETAIL  
 ANGLE @ CONCRETE COLUMN  
 A9.010 1 1/2"=1'-0"

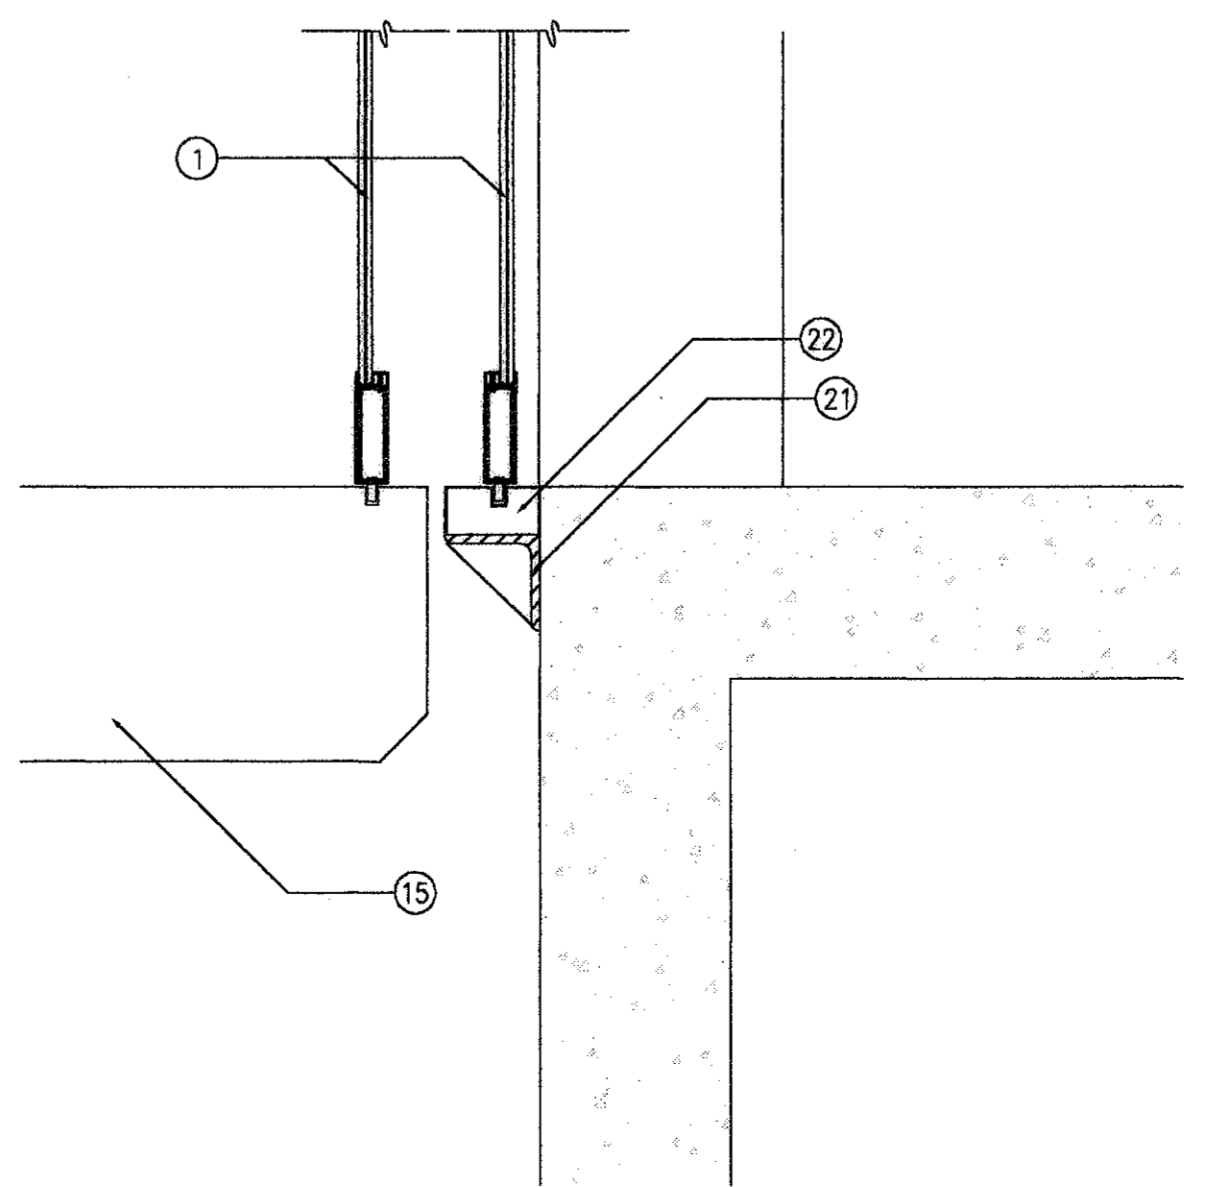


09 ELEVATOR SECTION DETAIL  
 SLIDING DOORS SILL  
 A9.010 1 1/2"=1'-0"

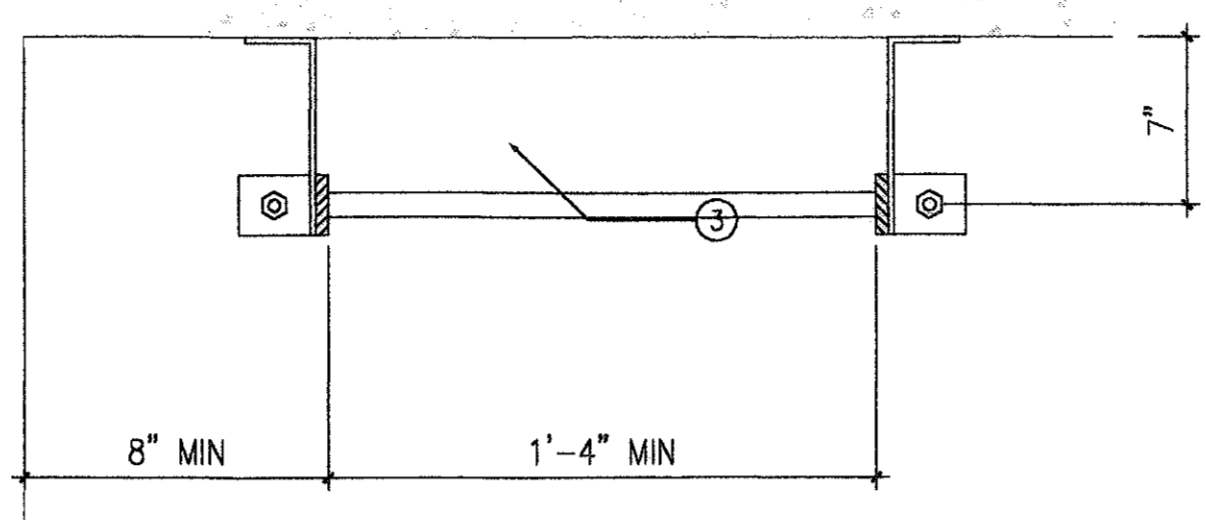


02 LADDER  
 A9.010 1 1/2"=1'-0"

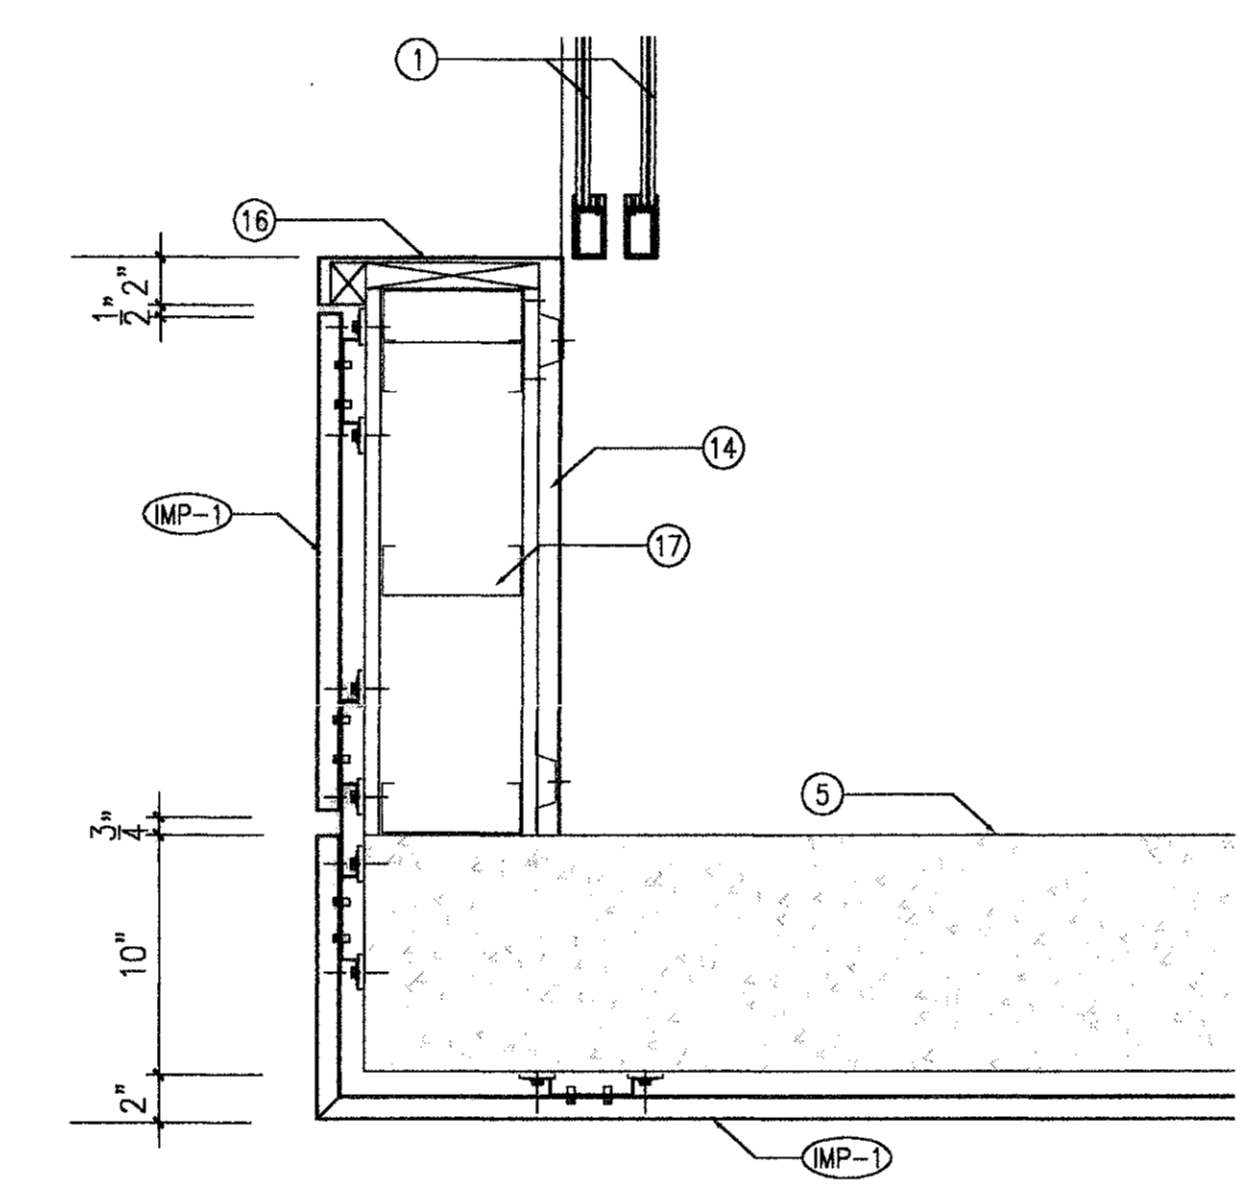


06 HOISTWAY PLAN DETAIL  
 ANGLE @ LOBBY  
 A9.010 1 1/2"=1'-0"

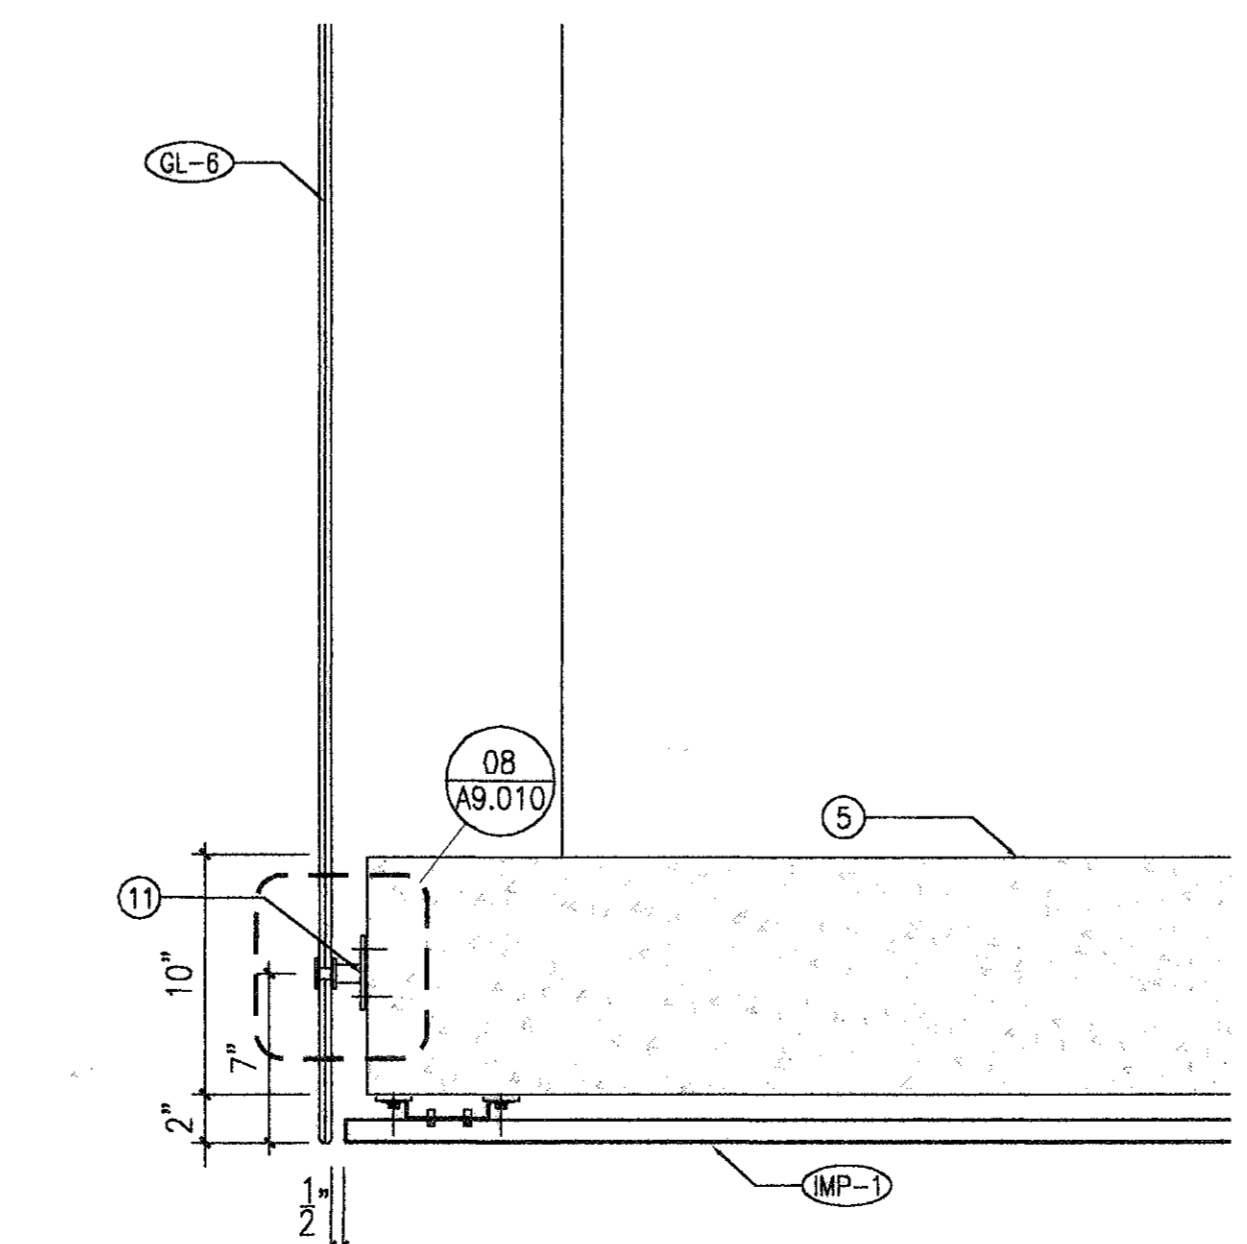


10 HOISTWAY PLAN DETAIL  
 ANGLE @ GLASS PANEL  
 A9.010 1 1/2"=1'-0"

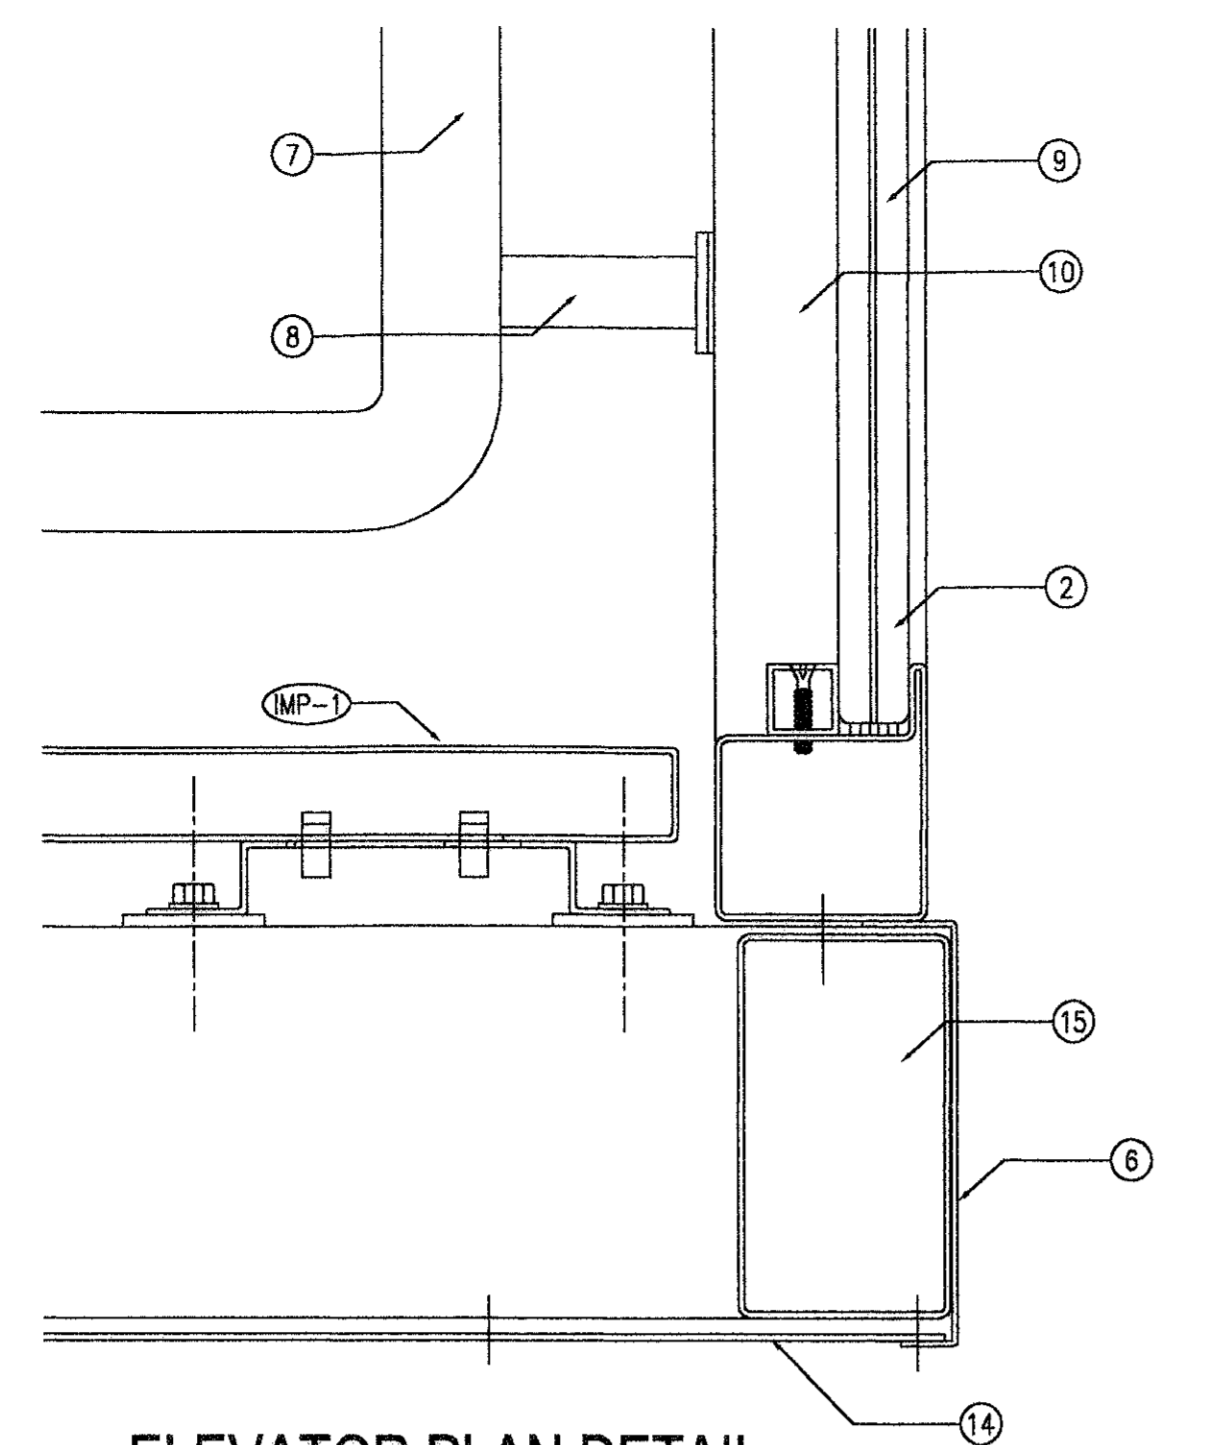


03 ELEVATOR PLAN DETAIL  
 ANGLE @ CAB  
 A9.010 6"=1'-0"

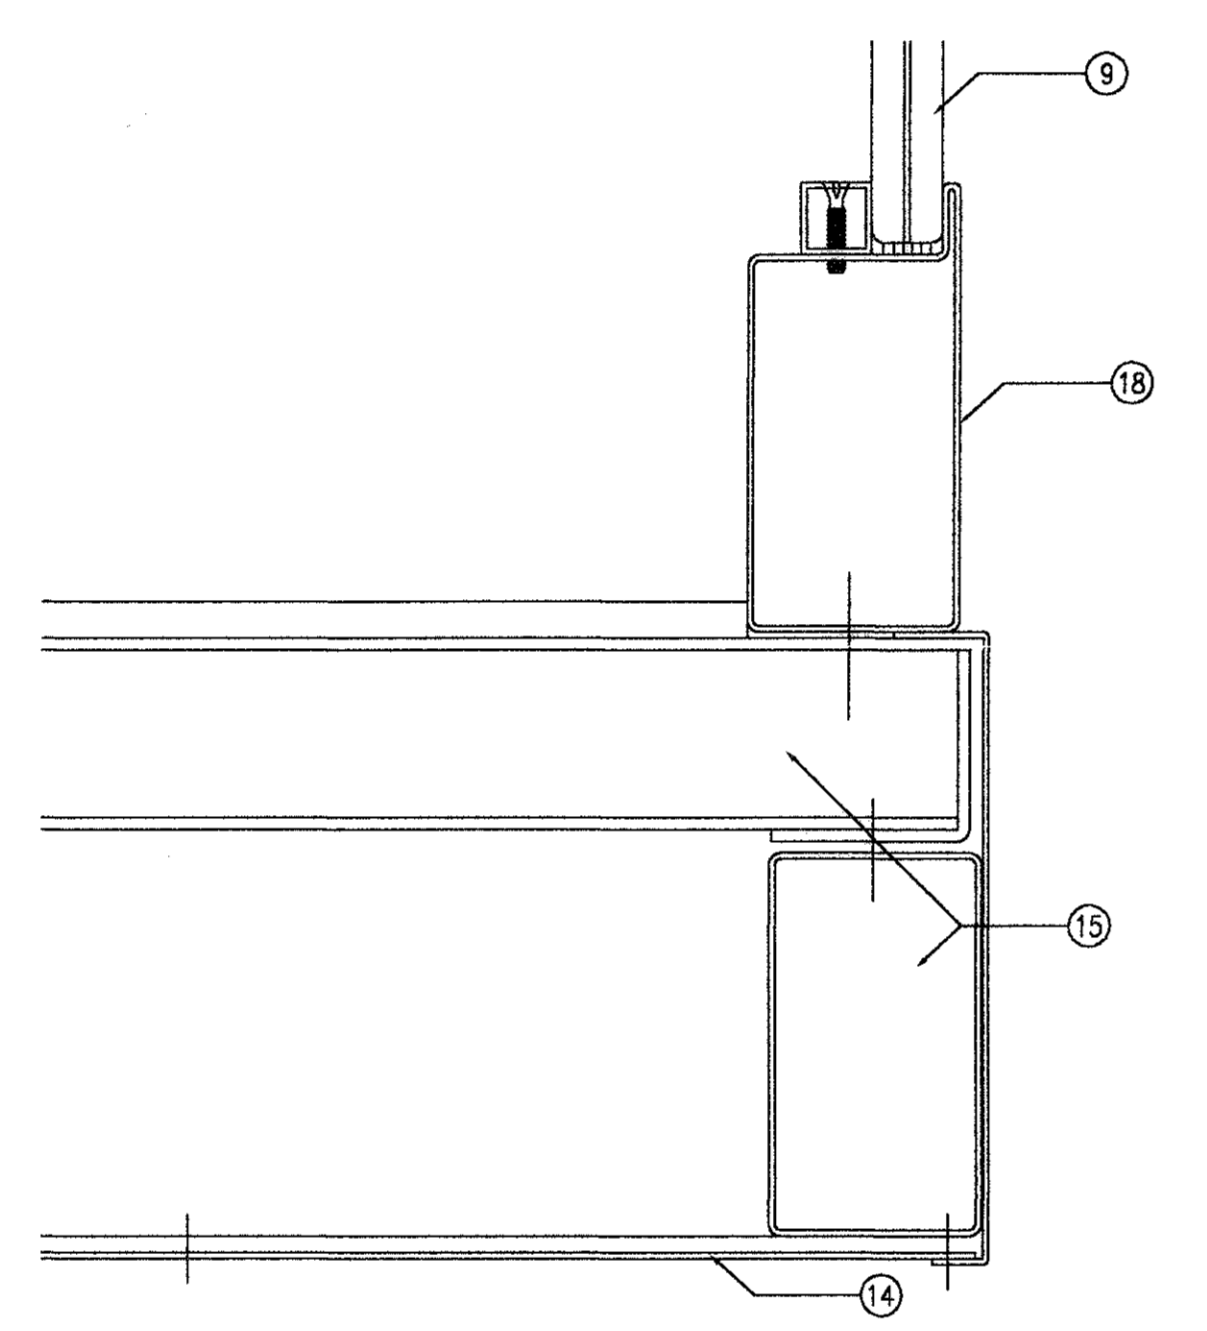


07 ELEVATOR SECTION DETAIL  
 CAB PLATFORM  
 A9.010 6"=1'-0"

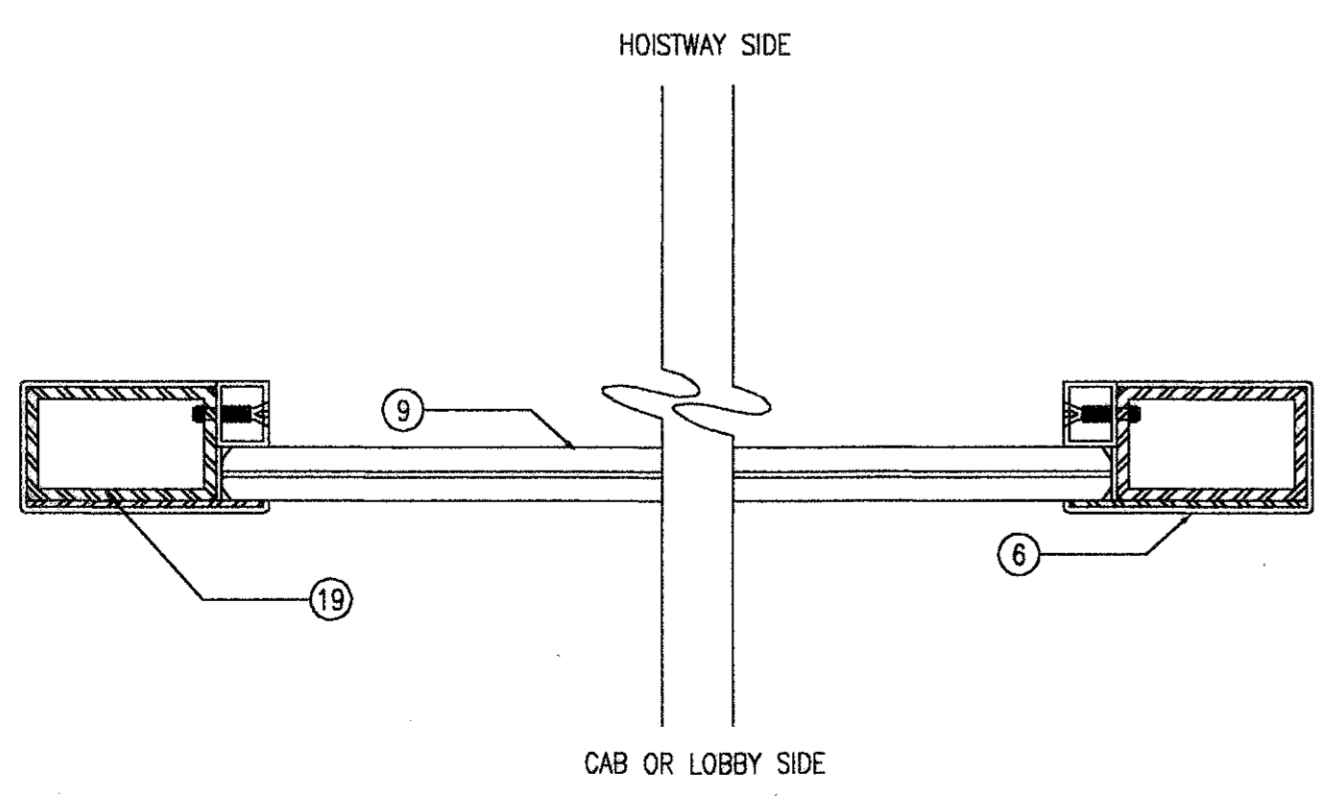

11 PLAN DETAIL  
 GLASS DOOR  
 A9.010 6"=1'-0"

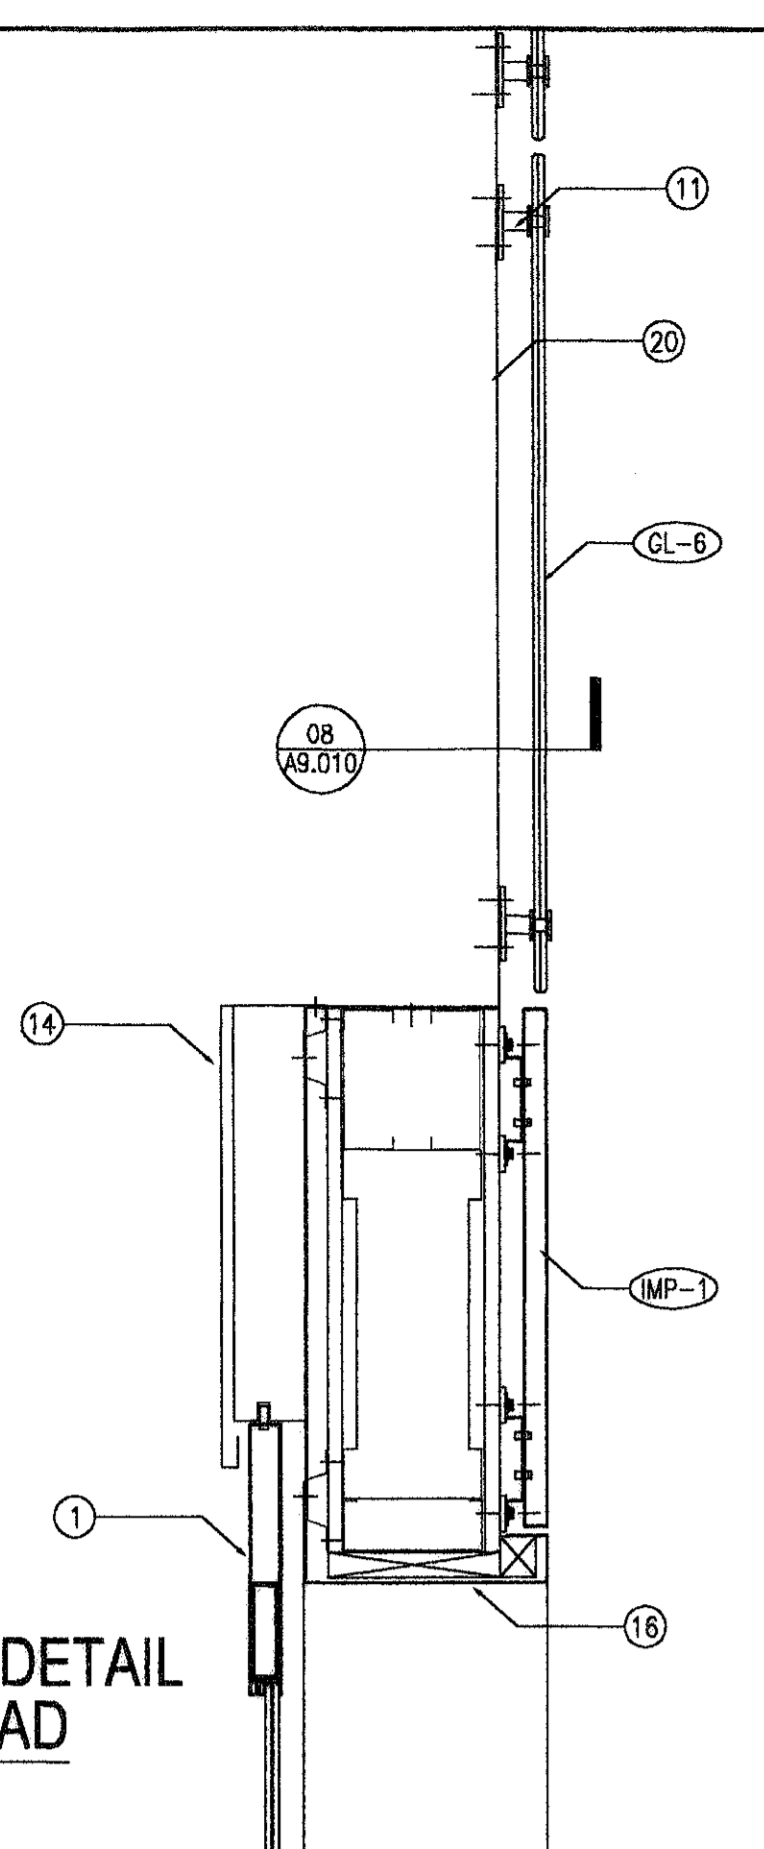

04 SECTION DETAIL  
 DOOR HEAD  
 A9.010 1 1/2"=1'-0"

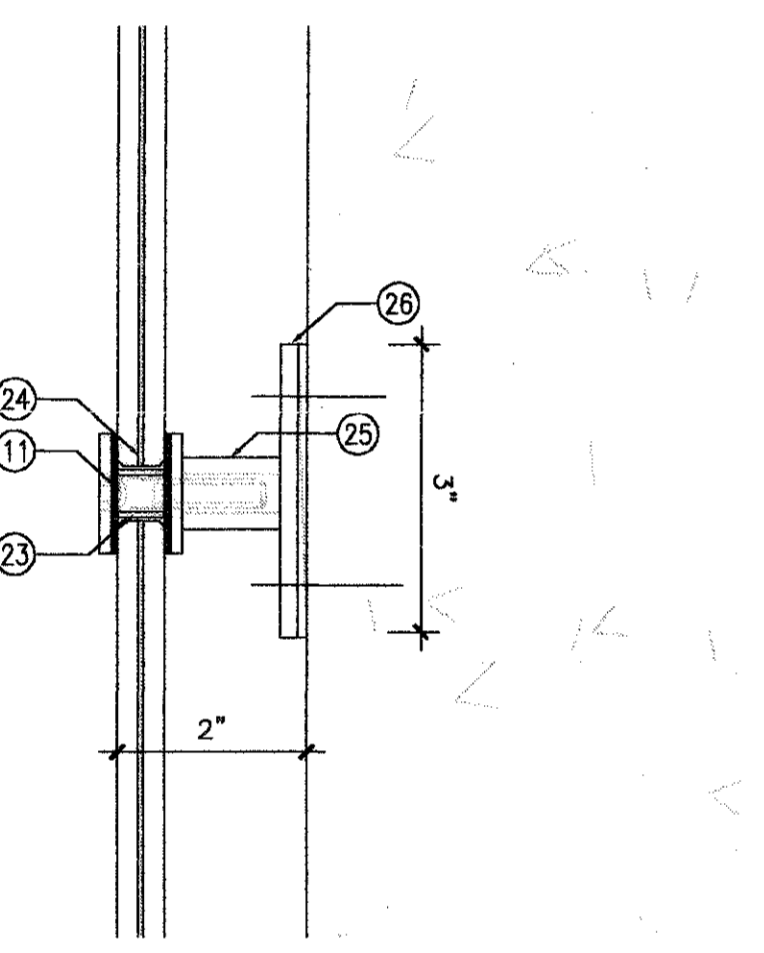

08 GLASS BRACKET  
 DETAIL  
 A9.010 6"=1'-0"

12 NOT USED  
 DETAIL  
 A9.010 1 1/2"=1'-0"

PLOT DATE: 02/04/02 HAS FILE: A9.010








**ANCHOR BOLT LOCATION SCHEDULE  
 GDWY "A" AT APM PLATFORM STATION "D"**

DESIGNATION	STATION END	NORTHING	EASTING	TYPE
AB-A1	15+90.14	13,925,787.28	3,129,238.41	A
AB-A2	16+02.81	13,925,787.69	3,129,251.07	A
AB-A3	16+15.47	13,925,788.10	3,129,263.73	A
AB-A4	16+28.14	13,925,788.50	3,129,276.39	A
AB-A5	16+30.14	13,925,788.57	3,129,278.39	A
AB-A6	16+41.14	13,925,788.92	3,129,289.38	A
AB-A7	16+52.14	13,925,789.28	3,129,300.38	A
AB-A8	16+63.14	13,925,789.63	3,129,311.37	A
AB-A9	16+65.14	13,925,789.70	3,129,313.37	A
AB-A10	16+77.81	13,925,790.10	3,129,326.03	A
AB-A11	16+90.47	13,925,790.51	3,129,338.69	A
AB-A12	17+03.14	13,925,790.92	3,129,351.35	A
AB-A13	17+05.14	13,925,790.98	3,129,353.35	A
AB-A14	17+17.81	13,925,791.39	3,129,366.01	A
AB-A15	17+30.47	13,925,791.80	3,129,378.67	A
AB-A16	17+43.14	13,925,792.20	3,129,391.33	A
AB-A17	17+45.14	13,925,792.27	3,129,393.33	A
AB-A18	17+56.97	13,925,792.65	3,129,405.16	A
AB-A19	17+68.81	13,925,793.03	3,129,416.98	A
AB-A20	17+80.64	13,925,793.41	3,129,428.81	A


**ANCHOR BOLT LOCATION SCHEDULE  
 GDWY "B" AT APM PLATFORM STATION "D"**

DESIGNATION	STATION END	NORTHING	EASTING	TYPE
AB-B1	115+96.88	13,925,730.98	3,129,240.23	A
AB-B2	116+09.55	13,925,731.39	3,129,252.89	A
AB-B3	116+22.21	13,925,731.79	3,129,265.55	A
AB-B4	116+34.88	13,925,732.20	3,129,278.21	A
AB-B5	116+36.88	13,925,732.27	3,129,280.21	A
AB-B6	116+47.88	13,925,732.62	3,129,291.20	A
AB-B7	116+58.88	13,925,732.97	3,129,302.20	A
AB-B8	116+69.88	13,925,733.33	3,129,313.19	A
AB-B9	116+71.88	13,925,733.39	3,129,315.19	A
AB-B10	116+84.55	13,925,733.80	3,129,327.85	A
AB-B11	116+97.21	13,925,734.21	3,129,340.51	A
AB-B12	117+09.88	13,925,734.62	3,129,353.17	A
AB-B13	117+11.88	13,925,734.68	3,129,355.17	A
AB-B14	117+24.55	13,925,735.09	3,129,367.83	A
AB-B15	117+37.21	13,925,735.49	3,129,380.49	A
AB-B16	117+49.88	13,925,735.90	3,129,393.15	A
AB-B17	117+51.88	13,925,735.97	3,129,395.15	A
AB-B18	117+63.71	13,925,736.35	3,129,406.98	A
AB-B19	117+75.55	13,925,736.73	3,129,418.80	A
AB-B20	117+87.38	13,925,737.11	3,129,430.63	A


NOTE: COORDINATES SHOWN ARE FOR INFORMATION AND COORDINATION INFORMATION ONLY.

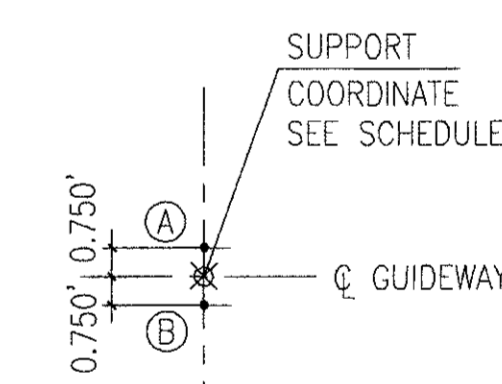

TYPE "A"

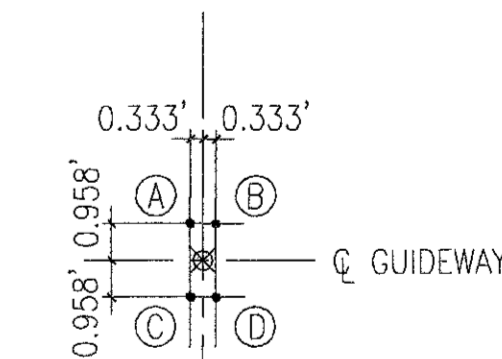

TYPE "B"

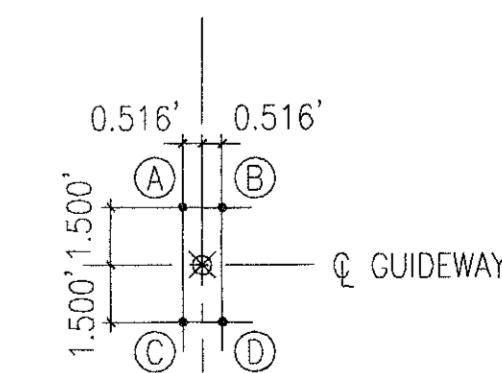

TYPE "C"



TYPICAL GUIDEBEAM SUPPORTS

**RECORD DRAWINGS**


DO NOT MODIFY  
 Terry + Moore Inc.  
 27 May 2005

Note: Information used to develop these documents was taken from Record of the Work Drawings prepared by the construction contractor, Clark Construction Group - Texas. The information provided by the contractor was not verified by the design firm named above.

INTERNATIONAL • SERVICES • EXPANSION • PROGRAM

**APM STATION AND PLATFORM  
 ANCHOR BOLT LOCATION SCHEDULES**

PROJECT MGR: P.J.M.  
 DESIGNER: J.P.  
 DRAWN BY: S.T.  
 CHECKED BY: P.J.M.  
 DRAWING STANDARD: ISEP 07.20.2000  
 SCALE: NONE  
 DATE: 06/06/03

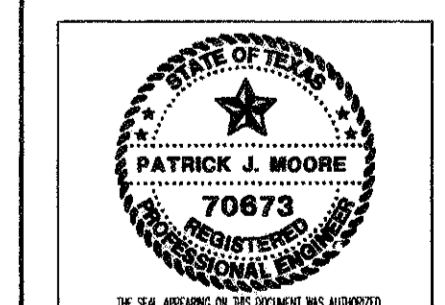

APPROVED BY: DATE:

DIRECTOR HOUSTON AIRPORT SYSTEM

PROJECT NO. 02-2214

C.I.P. NO. A-0354

H.A.S. NO. 536C

SHEET NO.

AB2.01



PLAN & ELEVATION SYMBOLS

- HID LIGHT FIXTURE, TYPE AS INDICATED
- HID LIGHT FIXTURE, TYPE AS INDICATED
- LIGHT FIXTURE, FLUORESCENT, LETTER INDICATES TYPE
- LIGHT FIXTURE, FLUORESCENT WITH EMERGENCY BATTERY PACK, LETTER INDICATES TYPE
- NEW PANELBOARD
- JUNCTION OR PULL BOX
- MOTOR, SPHASE HORSEPOWER AS NOTED
- MOTOR, SINGLE PHASE HORSEPOWER AS NOTED
- GROUND ROD
- GROUND ROD IN TEST WELL
- CONNECTION POINT
- GROUND WIRE, #4/0 BARE STRANDED COPPER
- HOMERUN TO PANELBOARD, CIRCUIT DESIGNATION AS NOTED
- FEEDER DESIGNATION - SEE ONE LINE DIAGRAM FOR CONDUIT AND WIRE SIZES
- KEYED NOTE
- CONDUIT TURNED UP
- CONDUIT TURNED DOWN
- CAPPED CONDUIT
- SINGLE POLE TOGGLE SWITCH
- 20A, 125V DUPLEX RECEPTACLE  
WP = WEATHERPROOF COVER
- 20A, 125V QUADPLEX RECEPTACLE
- NON-FUSED DISCONNECT SWITCH 30A, 3P UNLESS OTHERWISE INDICATED.
- FUSED DISCONNECT SWITCH 30A, 3P UNLESS OTHERWISE INDICATED.
- COMBINATION STARTER FVNR NEMA SIZE 1 UNLESS OTHERWISE INDICATED.
- FVNR STARTER NEMA SIZE 1 UNLESS OTHERWISE INDICATED.
- LIGHTING CONTACTOR
- TRUE RMS SOLID STATE DIGITAL MONITOR WITH SELECTABLE FUNCTIONS.
- INDICATING LIGHT - LETTER DENOTES COLOR  
G-GREEN R-RED C-CLEAR B-BLUE W-WHITE A-AMBER
- MAIN FIRE ALARM PANEL
- FIRE ALARM PULL STATION 48" AFF
- FIRE ALARM COMBINATION SPEAKER/STROBE 80" AFF
- FIRE ALARM VISUAL DEVICE, 15/75 CANDELA AS REQUIRED 80" AFF
- ADDRESSABLE FIRE ALARM DUCT DETECTOR  
"S" INDICATES LOCATED IN SUPPLY AIR DUCTWORK  
"R" INDICATES LOCATED IN RETURN AIR DUCTWORK
- FIRE ALARM PHOTOELECTRIC SMOKE DETECTOR
- FIRE ALARM RATE OF RISE HEAT DETECTOR
- FIRE ALARM FLOW SWITCH
- FIRE ALARM TAMPER SWITCH
- TELEPHONE OUTLET  
4" SQUARE X 2 1/8" DEEP BOX WITH 3/4" TO ABOVE CEILING
- DATA OUTLET  
4" SQUARE X 2 1/8" DEEP BOX WITH 3/4" TO ABOVE CEILING
- PUSHBUTTON
- LIGHTNING PROTECTION CONDUCTOR
- LIGHTNING PROTECTION AIR TERMINAL

ONE LINE AND CONTROL DIAGRAM SYMBOLS

- MOLDED CASE CIRCUIT BREAKER - SIZE AS NOTED. THREE POLES UNLESS OTHERWISE NOTED.
- DISCONNECT SWITCH - 30A, 3P UNLESS NOTED OTHERWISE
- FUSE - QUANTITY AND RATING AS NOTED
- TRANSFORMER - DESCRIPTION, CONNECTION AND RATING AS NOTED
- TRANSFORMER - DELTA CONNECTION
- TRANSFORMER - GROUNDED WYE CONNECTION
- CURRENT TRANSFORMER (CT) - QUANTITY AND RATIO AS NOTED
- MOTOR, THREE-PHASE, HORSEPOWER AS NOTED
- MOTOR STARTER - NEMA SIZE AS INDICATED
- SPACE HEATER
- GROUND CONNECTION SPACE HEATER
- TRUE RMS SOLID STATE DIGITAL MONITOR WITH SELECTABLE FUNCTIONS.
- INDICATING LIGHT - LETTER DENOTES COLOR  
G-GREEN R-RED C-CLEAR B-BLUE W-WHITE A-AMBER
- CONNECTION POINT
- KEYED NOTE
- FEEDER DESIGNATION - REFER TO PLAN DRAWINGS FOR LOCATION AND TO ONE LINE DIAGRAM FOR SIZE AND QUANTITY
- HOA SELECTOR SWITCH
- CONTACTOR OPERATING COIL
- NORMALLY OPEN (NO) CONTACT
- NORMALLY CLOSED (NC) CONTACT
- CONTROL RELAY
- PUSHBUTTON, NO MOMENTARY CONTACT
- PUSHBUTTON, NO MOMENTARY CONTACT
- ENCLOSURE

ABBREVIATIONS

- |                                       |   |
|---------------------------------------|---|
| A AMPERE (S)                          | KV KILOVOLT                                 |
| AIC AMPERE INTERRUPTING CAPACITY      | KVA KILOWATT AMPERES                        |
| AFF ABOVE FINISHED FLOOR              | KWHD KILOWATT-HOUR DEMAND                   |
| ATS AUTOMATIC TRANSFER SWITCH         | LR LOCAL-REMOTE                             |
| BAS BUILDING AUTOMATION SYSTEM        | LRA LOCKED ROTOR AMPERES                    |
| BRK BREAKER                           | LS LIMIT SWITCH                             |
| BLDG BUILDING                         | MAX MAXIMUM                                 |
| C CONDUIT                             | MCC MOTOR CONTROL CENTER                    |
| CAOP CHILLER AUXILIARY OIL PUMP       | MCP MOTOR CIRCUIT PROTECTOR                 |
| CB CIRCUIT BREAKER                    | MCOV MAX CONTINUOUS OPERATING VOLTAGE       |
| CCP CHILLER CONTROL PANEL             | MFAP MASTER FIRE ALARM PANEL                |
| CJ COPPER                             | MIN MINIMUM                                 |
| CKT CIRCUIT                           | MLO MAIN LUGS ONLY                          |
| CLF CURRENT LIMITING FUSE             | MOT MOTOR                                   |
| DEG DEGREE                            | MPR MOTOR PROTECTION RELAY                  |
| DW DIVISION                           | MR MULTI-RATIO                              |
| DCS DISTRIBUTED CONTROL SYSTEM        | MTD MOUNTED                                 |
| DWG DRAWING                           | NC NORMALLY CLOSED                          |
| EA EACH                               | NEC NATIONAL ELECTRICAL CODE                |
| F FREQUENCY                           | NIC NOT IN CONTRACT                         |
| FLA FULL LOAD AMPERES                 | NO NORMALLY OPEN                            |
| FVNR FULL VOLTAGE NON-REVERSING       | NTS NOT TO SCALE                            |
| GFCI GROUND FAULT CIRCUIT INTERRUPTER | No NUMBER                                   |
| GND GROUND                            | OFCI OWNER FURNISHED - CONTRACTOR INSTALLED |
| HAS HOUSTON AIRPORT SYSTEM            | PFCF POWER FACTOR CORRECTION CAPACITOR      |
| HOA HAND-OFF-AUTOMATIC                | O.C. OVERCURRENT                            |
| HP HORSEPOWER                         | PF POWER FACTOR                             |
| HPF HIGH POWER FACTOR                 | RCP REMOTE CONTROL PANEL                    |
| HPS HIGH PRESSURE SODIUM              | RGS RIGID GALVANIZED STEEL                  |
| HTG HEATING                           | RMS ROOT MEAN SQUARE                        |
| JB JUNCTION BOX                       | SSS SOLID STATE STARTER                     |
| KA KILOAMPERES                        | RVAT REDUCED VOLTAGE AUTO-TRANSFORMER       |
|                                       | SYM SYMMETRICAL                             |
|                                       | SYN SYNCHRONOUS                             |
|                                       | SWGR SWITCHGEAR                             |
|                                       | V VOLT(S)                                   |
|                                       | VIB VIBRATION                               |
|                                       | WP WEATHERPROOF                             |

LOAD ANALYSIS		
DESCRIPTION	KVA	AMPS @480V 3 PHASE
LARGEST MOTOR	43.20	51.96
25% LARGEST MOTOR	10.80	12.99
OTHER MOTOR LOADS	123.69	148.78
RECEPTACLE LOAD	9.22	11.08
LIGHTING LOAD @ 125% 25% OF LIGHTING LOAD	27.83 6.96	33.47 8.37
MISCELLANEOUS LOAD	30.00	36.08
TOTAL	251.70	302.75

THE NEW SERVICE CONSISTS OF A 600A, 480Y/277V PANELBOARD SERVED WITH 2 SETS OF 4-350 KCMIL CONDUCTORS. SEE ONE LINE DIAGRAM ON SHEET E6.000.

INTERNATIONAL SERVICES EXPANSION PROGRAM  
**APM STATION + PLATFORM**  
 LEGEND & LOAD ANALYSIS

PROJECT MGR: A.E.BELTRAN  
 DESIGNER: D.BEJSE  
 DRAWN BY: D.BEJSE  
 CHECKED BY: A.E.BELTRAN  
 DRAWING STANDARD: SEP 07.20.2000  
 SCALE: AS NOTED  
 DATE: 09/14/01

**RECORD DRAWING**  
 THIS DRAWING HAS BEEN REISED TO SHOW SIGNIFICANT CHANGES IN THE WORK MADE DURING CONSTRUCTION BASED ON MARKED-UP PRINTS, DRAWINGS AND OTHER DATA.

APPROVED BY: \_\_\_\_\_ DATE: \_\_\_\_\_  
 DIRECTOR  
 HOUSTON AIRPORT SYSTEM  
 PROJECT NO. 1061-001  
 C.I.P. NO. A-034  
 H.A.S. NO. 536  
 SHEET NO. 09 E0.000

S:\1061\001\EXE\01\A\0360\0000.dwg. Layout: 2/6/2005 11:49:59 AM.



REVISIONS			
NO.	DESCRIPTION	DATE	BY
ISSUED FOR BLDG.		10/19/01	
RECORD DRAWING		05/06/05	

LIGHTING FIXTURE SCHEDULE

TYPE	MANUFACTURER AND CATALOG NUMBER	DESCRIPTION	VOLTAGE	LAMPS	MOUNTING	REMARKS
FA	LITHONIA #AF10332277POGEB10WGAFFV	4' INDUSTRIAL FLUORESCENT, BAKED WHITE ENAMEL REFLECTOR, 100' UPLIGHT, ELECTRONIC BALLAST 10X THD, HFP, BF 0.99, WITH WIRE GUARD	277	3-F03278 3000K,85 CRI	CHAIN HUNG 8'-0" AFF	ELECTRONIC BALLAST <10XTHD PROVIDE IN-LINE FUSE
	COLUMBIA					
	DAY-BRITE					
FA1	LITHONIA #AF10332277POGEB10PS1400WGAFFV	4' INDUSTRIAL FLUORESCENT, BAKED WHITE ENAMEL REFLECTOR, 100' UPLIGHT, ELECTRONIC BALLAST 10X THD, HFP, BF 0.99, WITH WIRE GUARD EMERGENCY BATTERY PACK	277	3-F03278 3000K,85 CRI	CHAIN HUNG 8'-0" AFF	ELECTRONIC BALLAST <10XTHD PROVIDE IN-LINE FUSE EMERGENCY BATTERY PACK SEE NOTE 1 BELOW
	COLUMBIA					
	DAY-BRITE					
FB	NRL #ZM26-G-B2	FLUORESCENT VAPOR TIGHT	120	26W FLUOR TO SUIT FIXTURE	WALL ELEV FIT	
	GUTH					
	CHROUSE HINDS KURT VERSEN P926					
BC1	LITHONIA	COMPACT FLUORESCENT DOWNLIGHT 5 7/8" APERTURE, 10 1/4" DEEP	277	CF 3207E/830 3000K,82CRI	RECESSED	HFP ELECTRONIC BALLAST PROVIDE IN-LINE FUSE
	LIGHTOLIER					
	INDY					
BC2	INDY LIGHTING 610R-422-FL-BLACK PAINTED SPLAY	COMPACT FLUORESCENT DOWNLIGHT 7 3/8" APERTURE, 10 3/4" DEEP	277	CF 4907E/830 3000K,82CRI	RECESSED	HFP MAGNETIC ENCASED AND POTTED BALLAST PROVIDE IN-LINE FUSE
	HALO ARCHITECTURAL					
	PRESCOLITE					
BC3	KURT VERSEN P601	SURFACE MOUNTED COMPACT FLUORESCENT DOWNLIGHT 8 3/8" APERTURE, 8" DEEP WITH REMOTE EMERGENCY BATTERY PACK. SEE NOTE 1 BELOW.	277	CF 1807E/830 3000K,82CRI	SURFACE	HFP ELECTRONIC BALLAST PROVIDE IN-LINE FUSE EMERGENCY BATTERY PACK MOUNT ON CEILING ADJACENT TO FIXTURE
	LITHONIA					
	LIGHTOLIER					
BH1	KURT VERSEN R7302-SC	RECESSED METAL HALIDE DOWNLIGHT 5 7/8" APERTURE, 10 1/4" DEEP	277	MP 70PAR38/U/FL 3200K,75CRI	RECESSED	MAGNETIC BALLAST PROVIDE IN-LINE FUSE
	LITHONIA					
	LIGHTOLIER					
BH2	KURT VERSEN R7302-SC	RECESSED METAL HALIDE DOWNLIGHT 5 7/8" APERTURE, 10 1/4" DEEP	277	MP 150PAR38/U/FL 3200K,75CRI	RECESSED	MAGNETIC BALLAST PROVIDE IN-LINE FUSE
	LITHONIA					
	LIGHTOLIER					
BL1	ELLIPTIPAR F-305-1155-500-277-XX	2 LAMP ADJUSTABLE COVE LIGHT WITH EACH LAMP SEPARATELY ADJUSTABLE	277	T5 FP54/830/HO 3000K,82CRI	SURFACE	ELECTRONIC BALLAST 10X THD PROVIDE IN-LINE FUSE
	WINONA					
	LSI					
BL1E	ELLIPTIPAR F-305-1155-500-277-XX-E	2 LAMP ADJUSTABLE COVE LIGHT WITH EACH LAMP SEPARATELY ADJUSTABLE ONE LAMP ON INTEGRAL EMERGENCY BATTERY PACK SEE NOTE 1 BELOW	277	T5 FP54/830/HO 3000K,82CRI	SURFACE	ELECTRONIC BALLAST 10X THD PROVIDE IN-LINE FUSE EMERGENCY BATTERY PACK
	WINONA					
	LSI					
BL3	PRUDENTIAL CL5956	4' FLUORESCENT STRIP WITH T5 LAMP	277	T5 FP28/840/HO 4000K,82CRI BLUE COLOR SLEEVE FOR FIXTURES AT SKYLIGHT	COVE AND ELEVATOR SIDELIGHTING GLASS SEE ARCH PLANS	ELECTRONIC BALLAST 10X THD PROVIDE IN-LINE FUSE
	BELFER					
BS1	ERCO 33861 - DRIVER: ADVANCE TITANIUM #9137 005 18705	LED STEPLIGHT	120	INTEGRAL	SURFACE SEE ARCH PLANS	REMOTE BALLAST PROVIDE IN-LINE FUSE
BS2	PAULUHN FEPP30A-18-18X9005-BLUE STONCO	SURFACE MOUNTED BLUE GLASS ENCASED SAFETY LIGHT	120	18W CFL 4000K	SURFACE	INTEGRAL ELECTRONIC PROVIDE IN-LINE FUSE
BU1	ELLIPTIPAR T-151-035G-V-07-B-V0-0 WINONA INSIGHT	SURFACE MOUNTED ASYMMETRIC DISTRIBUTION UPLIGHT SILVER METALLIC	277	CMH35/76612	SURFACE	INTEGRAL MAGNETIC PROVIDE IN-LINE FUSE
BU2	ELLIPTIPAR F121-P126-E-01-277-VE0 WINONA INSIGHT	INDIRECT SURFACE MOUNTED FIXTURE WITH EXTERNAL EMERGENCY BATTERY PACK SEE NOTE 1 BELOW SILVER METALLIC	277	26W/B74/D/G24q-3	SURFACE WALL 4" BELOW CEILING	INTEGRAL ELECTRONIC PROVIDE IN-LINE FUSE EMERGENCY BATTERY PACK MOUNTED ADJACENT TO FIXTURE ON WALL
XA	LITHONIA #LESW1R12/277ELNSD	SINGLE FACE DIE CAST ALUMINUM EXIT SIGN WITH EMERGENCY BATTERY PACK	277	LED	UNIVERSAL SEE PLANS	UNSWITCHED
XB	LITHONIA #LESW2R12/277ELNSD	DOUBLE FACE DIE CAST ALUMINUM EXIT SIGN WITH EMERGENCY BATTERY PACK	277	LED	UNIVERSAL SEE PLANS	UNSWITCHED

(1) EMERGENCY BATTERY PACK TO OPERATE ONE LAMP AT 1400 LUMENS FOR 90 MINUTES. PROVIDE A TEST SWITCH AND MOUNT SO SWITCH EXTENDS THROUGH BALLAST COVER ADJACENT TO LAMPS. ROUTE ONE UNSWITCHED LEG TO FIXTURE. ON LOSS OF NORMAL POWER BATTERY PACK WILL OPERATE ONE LAMP FOR A MINIMUM OF 90 MINUTES. REFER TO MANUFACTURER WIRING DIAGRAM.

INTERNATIONAL SERVICES EXPANSION PROGRAM  
 APM STATION + PLATFORM  
 LIGHTING FIXTURE SCHEDULE

PROJECT MGR: A.E.BELTRAM  
 DESIGNER: D.BEISLE  
 DRAWN BY: D.BEISLE  
 CHECKED BY: A.E.BELTRAM  
 DRAWING STANDARD: ISEP 07.20.2000  
 SCALE: AS NOTED  
 DATE: 09/14/01

**RECORD DRAWING**  
 THIS DRAWING HAS BEEN  
 REVIEWED TO SHOW  
 SIGNIFICANT CHANGES IN  
 THE WORK MADE DURING  
 CONSTRUCTION BASED ON  
 MARKED-UP PRINTS,  
 DRAWINGS AND OTHER  
 DATA.



APPROVED BY: \_\_\_\_\_ DATE: \_\_\_\_\_  
 DIRECTOR  
 HOUSTON AIRPORT SYSTEM  
 PROJECT NO. 1061-001  
 C.I.P. NO. A-0354  
 H.A.S. NO. 5390  
 SHEET NO. \_\_\_\_\_



**GENERAL NOTES FOR ALL WORK:**

- REMOVE, REPLACE, AND REPAIR EXISTING WALL, FLOORING, AND CEILINGS AS REQUIRED TO PERFORM THE WORK.
- PROVIDE THE OWNER WITH A COPY OF RECORD DRAWINGS AFTER COMPLETION OF THE PROJECT.
- ALL WORK AND EQUIPMENT SHALL COMPLY WITH ALL APPLICABLE LAWS, CODES, ETC. OF ALL AUTHORITIES HAVING JURISDICTION, INCLUDING FEDERAL, STATE, DISTRICT, AND LOCAL AUTHORITIES. MODIFICATIONS REQUIRED BY THE ABOVE SAID AUTHORITIES SHALL BE MADE WITHOUT ADDITIONAL CHARGE TO THE TENANT. WHERE CONTRACT DOCUMENT REQUIREMENTS ARE IN EXCESS OF CODE REQUIREMENTS, THE CONTRACT DOCUMENTS SHALL GOVERN. DEVIATIONS FROM THE CONTRACT DOCUMENTS REQUIRED BY THE ABOVE AUTHORITIES SHALL BE SUBMITTED TO THE OWNER FOR REVIEW.
- NEW DUCTWORK, CONDUIT, AND PIPING SHOWN ON DRAWINGS SHALL BE INSTALLED AS HIGH AS POSSIBLE. CONTRACTORS SHALL COORDINATE DUCTWORK, CONDUIT, AND PIPING INSTALLATION WITH LIGHTING FIXTURES, SPECIAL CEILING CONSTRUCTION, AIR DISTRIBUTION EQUIPMENT, ETC., AND PROVIDE ADDITIONAL RISES, DROPS, AND OFFSETS AS REQUIRED.
- EXISTING CONDITIONS: THE MEP DESIGN SHOWN ON THESE DRAWINGS IS SUPPORTED BY EXISTING BASE BUILDING MEP SYSTEMS WHICH HAVE BEEN ASSUMED TO BE IN GOOD WORKING ORDER. ANY DEFICIENCY IN THE BASE BUILDING MEP SYSTEMS WHICH PREVENTS A COMPLETE INTERFACE WITH THE TENANT SYSTEMS OR PREVENTS THE TENANT SYSTEMS FROM BEING FULLY FUNCTIONAL AT THE COMPLETION OF CONSTRUCTION SHALL BE IDENTIFIED IN WRITING BY THE CONTRACTOR TO THE OWNER AS SOON AS PRACTICAL AFTER DISCOVERY.
- PERMITS, FEES AND LICENSES: FEES, PERMITS AND LICENSES REQUIRED BY THE LEGALLY CONSTITUTED AUTHORITIES FOR INSTALLATION OF THE WORK ACCORDING TO THE PLANS AND SPECIFICATIONS SHALL BE OBTAINED AND PAID FOR BY THE CONTRACTOR WHO SHALL DELIVER THE ABOVE MENTIONED CERTIFICATES TO THE OWNER'S REPRESENTATIVE.
- THE CONTRACTOR SHALL REVIEW THE SITE PRIOR TO BID SUBMISSION AND SHALL INCLUDE IN HIS BID THE COST OF REPLACEMENT, REPAIR, RELOCATION OR REMOVAL OF EXISTING MEP OR FIRE PROTECTION ELEMENTS AS REQUIRED TO COMPLETE INSTALLATION OF ALL SYSTEMS SHOWN ON THESE DRAWINGS. WORK SHOWN REQUIRES PREMIUM TIME TO AVOID DISRUPTION OF THE OTHER TENANT'S ACTIVITIES AND MEP SERVICES. CONTRACTOR SHALL CONFIRM THE REQUIREMENTS FOR PREMIUM TIME OR SPECIAL PROCEDURES WITH THE OWNER AND INCLUDE THE COST IN HIS BID PROPOSAL. THE CONTRACTOR, BY SUBMITTING HIS BID PROPOSAL AGREES TO ACCEPT ALL EXISTING SITE CONDITIONS NOT SPECIFICALLY EXCEPTED. ALL EXCEPTIONS SHALL BE PROVIDED IN WRITING TO THE OWNER.
- DRAWINGS:
  - BECAUSE OF THE SMALL SCALE OF THE DRAWINGS, IT IS NOT POSSIBLE TO INDICATE ALL OFFSETS, FITTINGS, AND ACCESSORIES WHICH MAY BE REQUIRED. CONTRACTOR SHALL CAREFULLY INVESTIGATE THE CONDITIONS SURROUNDING INSTALLATION OF HIS WORK AND SHALL FURNISH THE NECESSARY FITTINGS WHICH MAY BE REQUIRED TO COMPLETE THE INSTALLATION.
  - THE DRAWINGS WERE PREPARED FROM THE BEST INFORMATION AVAILABLE AND ATTEMPT TO GIVE REASONABLE INDICATION OF EXISTING EQUIPMENT. HOWEVER, BEFORE BEGINNING WORK, THE CONTRACTOR SHALL VERIFY, IN THE FIELD, THE LOCATION AND ROUTING OF EXISTING DUCTWORK, PIPING, AIR DISTRIBUTION EQUIPMENT, ELECTRICAL FEEDERS, STRUCTURE, ETC. AND IS RESPONSIBLE FOR REROUTING EXISTING DUCTWORK, PIPING, ELECTRICAL FEEDERS, SPRINKLER BRANCH LINES, CEILING SUPPORT WIRE, ETC. AS IS REQUIRED FOR NEW INSTALLATIONS AT NO ADDITIONAL COST TO THE OWNER.
- FIBER OPTIC CONDUITS ARE NOT TO BE MOVED FOR THE PURPOSE OF ACCOMMODATING OTHER DISCIPLINES WITHOUT HAS / IT APPROVAL. APPROVAL SHOULD ROUTE THROUGH CONSTRUCTION MANAGEMENT TO HAS / IT. TAKE ALL NECESSARY PRECAUTIONS NOT TO DAMAGE EXISTING FIBER OPTIC CONDUITS. WHEN WELDING IN CLOSE PROXIMITY TO FIBER OPTIC CONDUITS, PROTECT CONDUITS WITH HEAT / FIRE BARRIER. CONTRACTOR IS RESPONSIBLE FOR ANY FIBER OPTIC CONDUIT THAT IS DAMAGED DURING CONSTRUCTION. RESPONSIBILITY INCLUDES THE OPERATIONAL COST OF THE SYSTEMS AFFECTED BY THE DAMAGED FIBER UNTIL THOSE SYSTEMS ARE RESTORED TO 100% FUNCTIONALITY.
- CORE DRILLING THROUGH THE ITT LEVEL WALLS TO BE SUPPLIED BY HOLES INC. (281)469-7070 OR APPROVED EQUAL.


**ELECTRICAL DETAILS:**

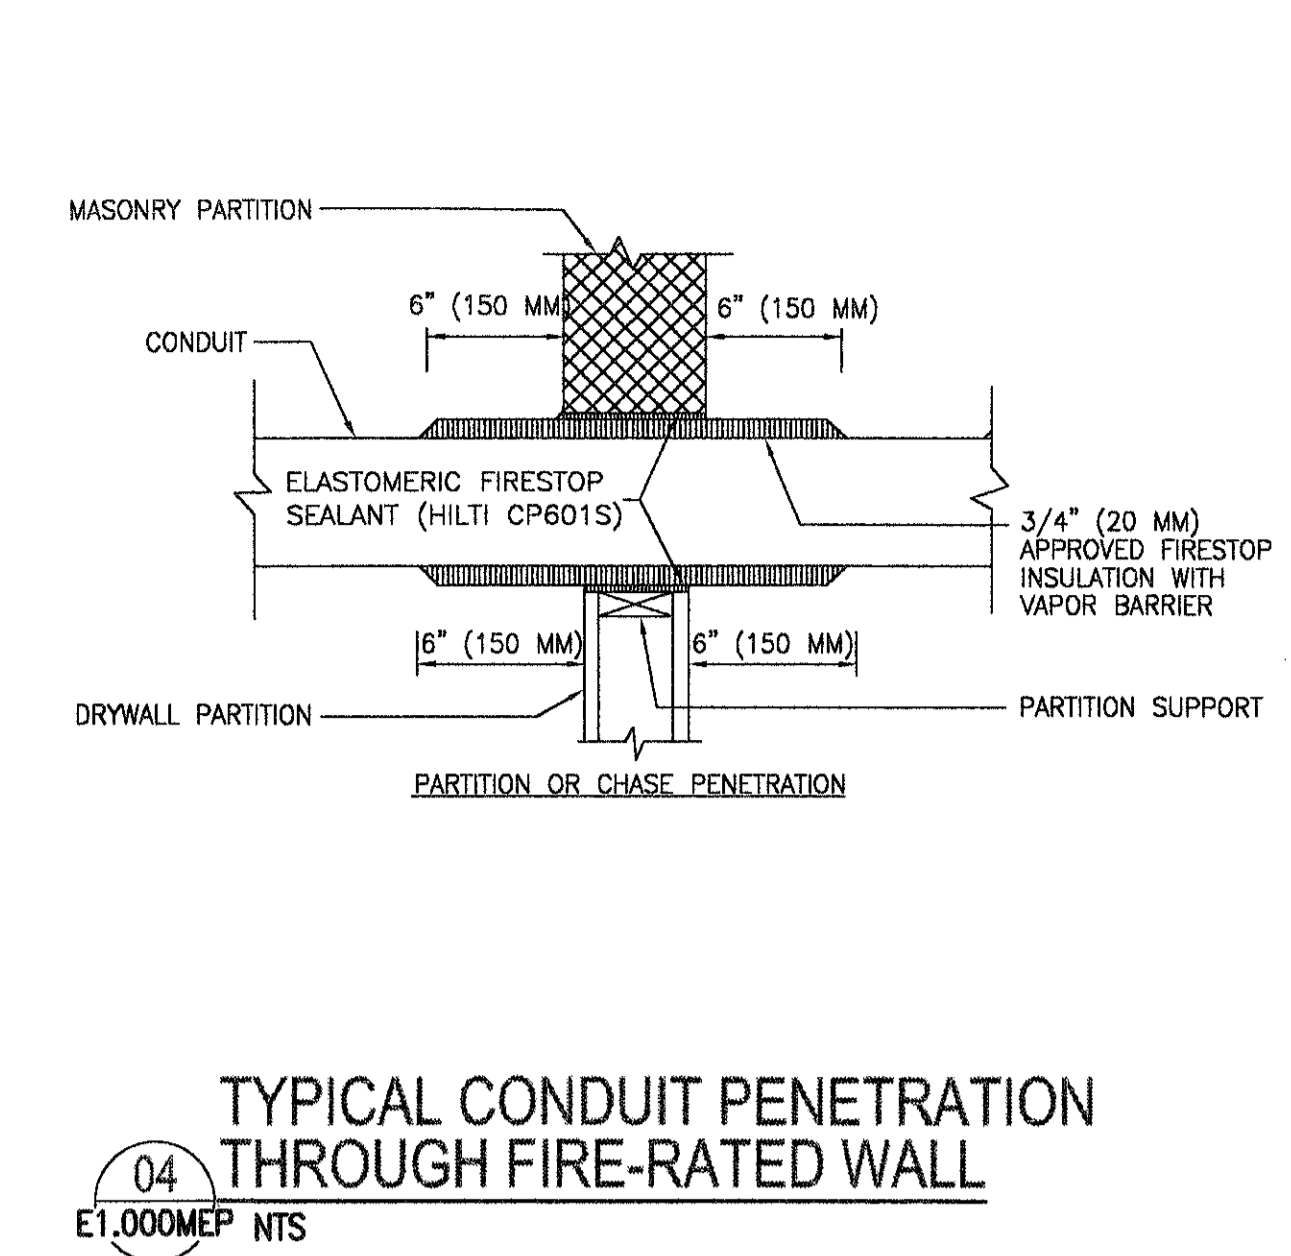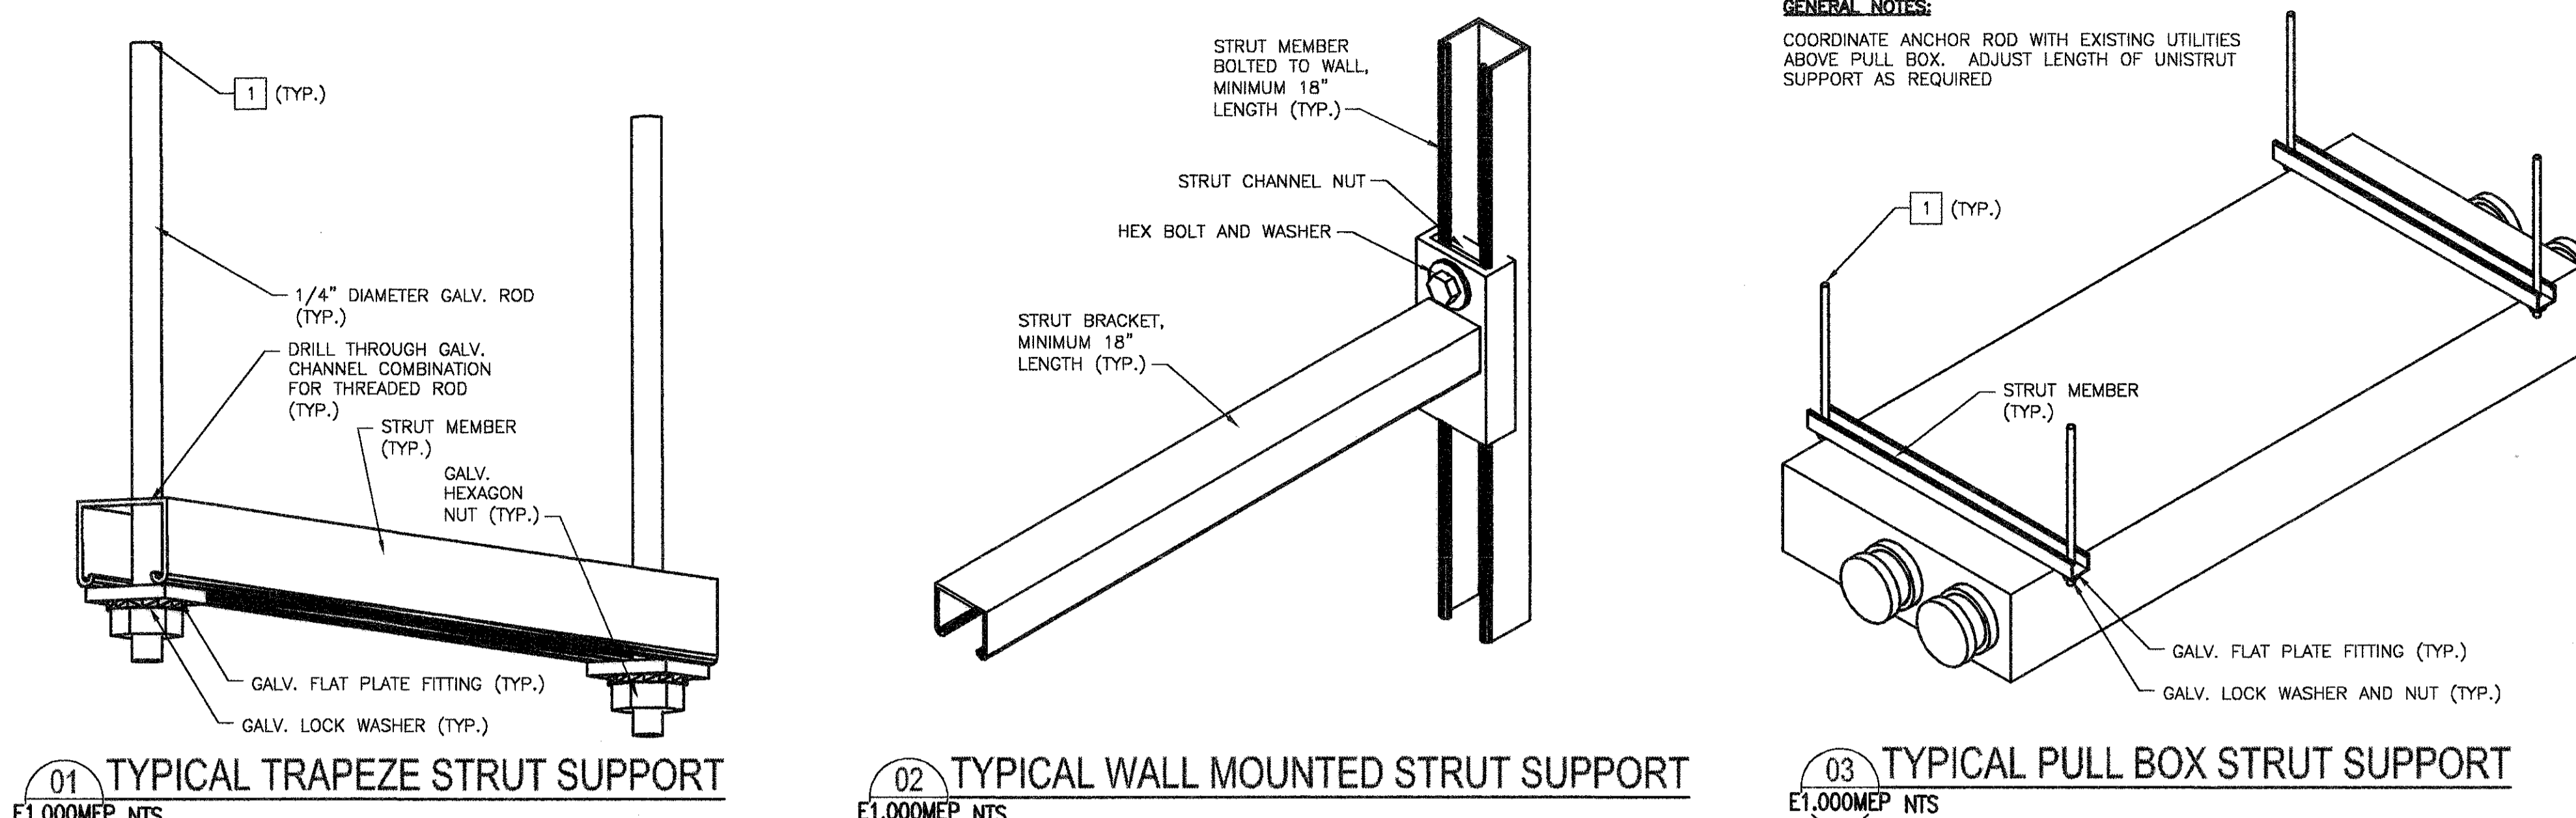


01 TYPICAL TRAPEZE STRUT SUPPORT  
02 TYPICAL WALL MOUNTED STRUT SUPPORT  
03 TYPICAL PULL BOX STRUT SUPPORT  
04 TYPICAL CONDUIT PENETRATION THROUGH FIRE-RATED WALL

**KEYED NOTES:**

1 ADHESIVE ANCHORS SHALL CONSIST OF AN ALL-THREAD ANCHOR ROD, NUT, WASHER AND ADHESIVE CAPSULE. ALTERNATIVELY, ADHESIVE ANCHORS SHALL CONSIST OF A STEEL INSERT AND AN ADHESIVE CAPSULE. THE RESIN MATERIAL SHALL BE VINYL URETHANE METHACRYLATE AS PROVIDED IN HILTI HVU CAPSULES OR APPROVED EQUAL. STEEL INSERT SHALL BE HILTI HIS INSERTS OR APPROVED EQUAL. ALL-THREAD ROD SHALL BE HILTI HAS OR HAS-E RODS OR APPROVED EQUAL. IMBED ANCHOR IN CONCRETE STRUCTURE 7" MIN.

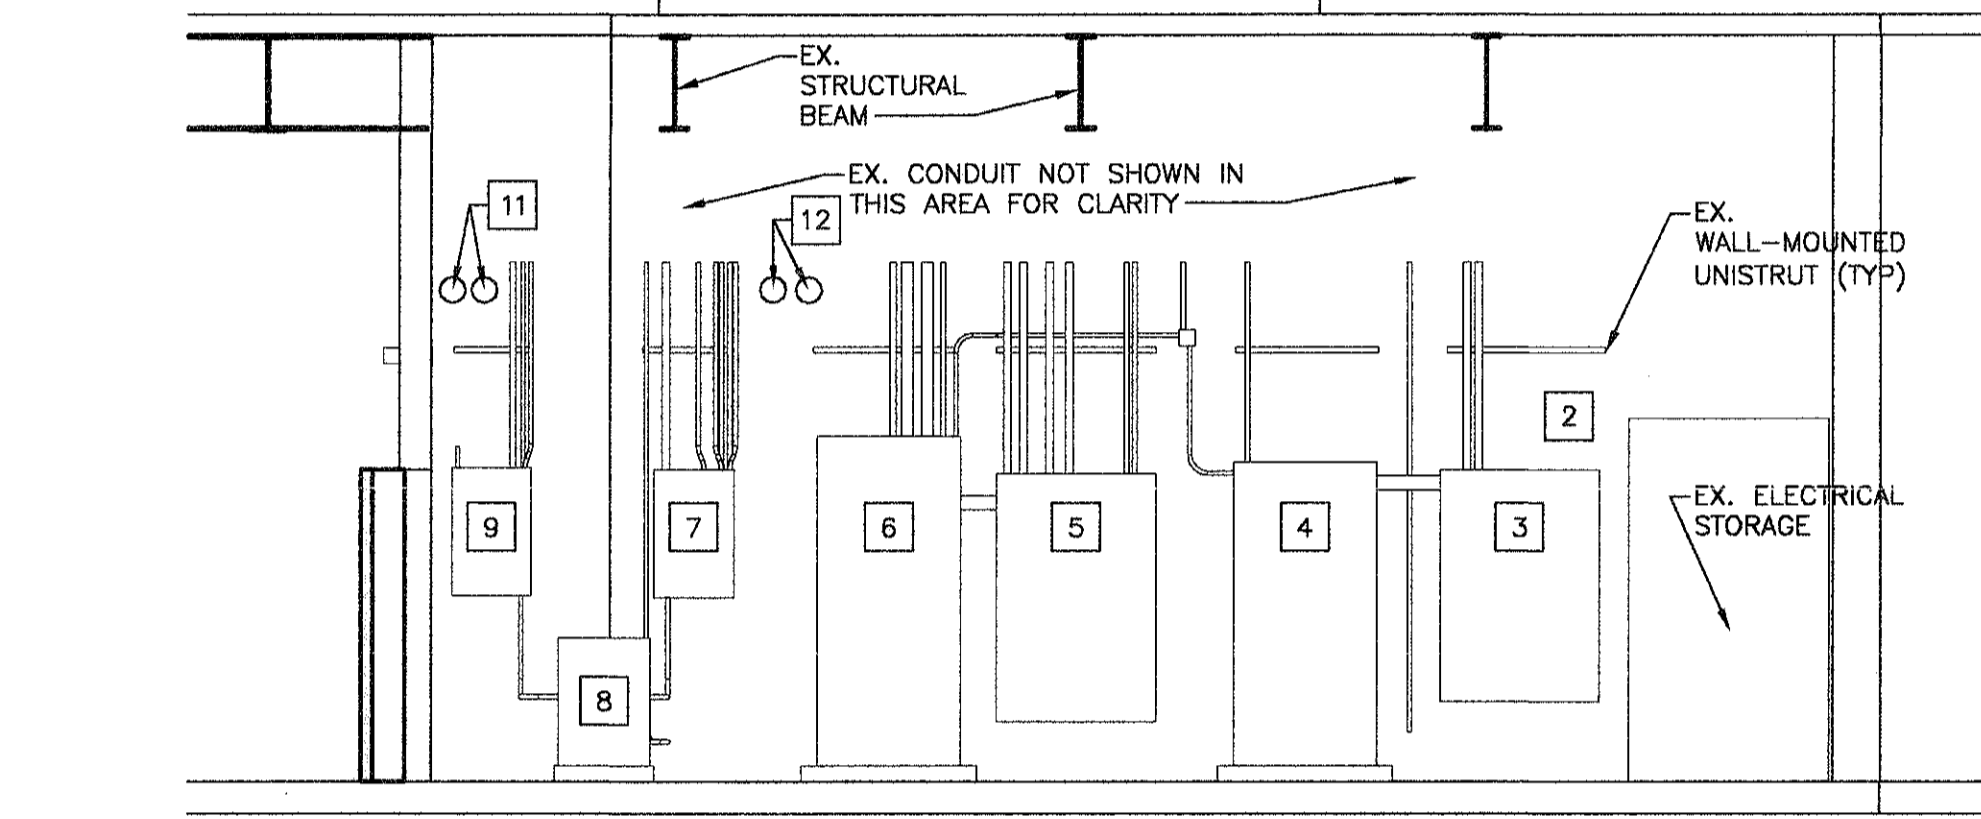


**CORE DRILLING SECTION LOOKING EAST**  
E1.000MEP1" = 4' - 0"  
NOTE: REFER TO GRAPHIC SCALE IF ACTUAL SHEET SIZE IS OTHER THAN 30"x42".  
SCALE: 1/4" = 1'-0"

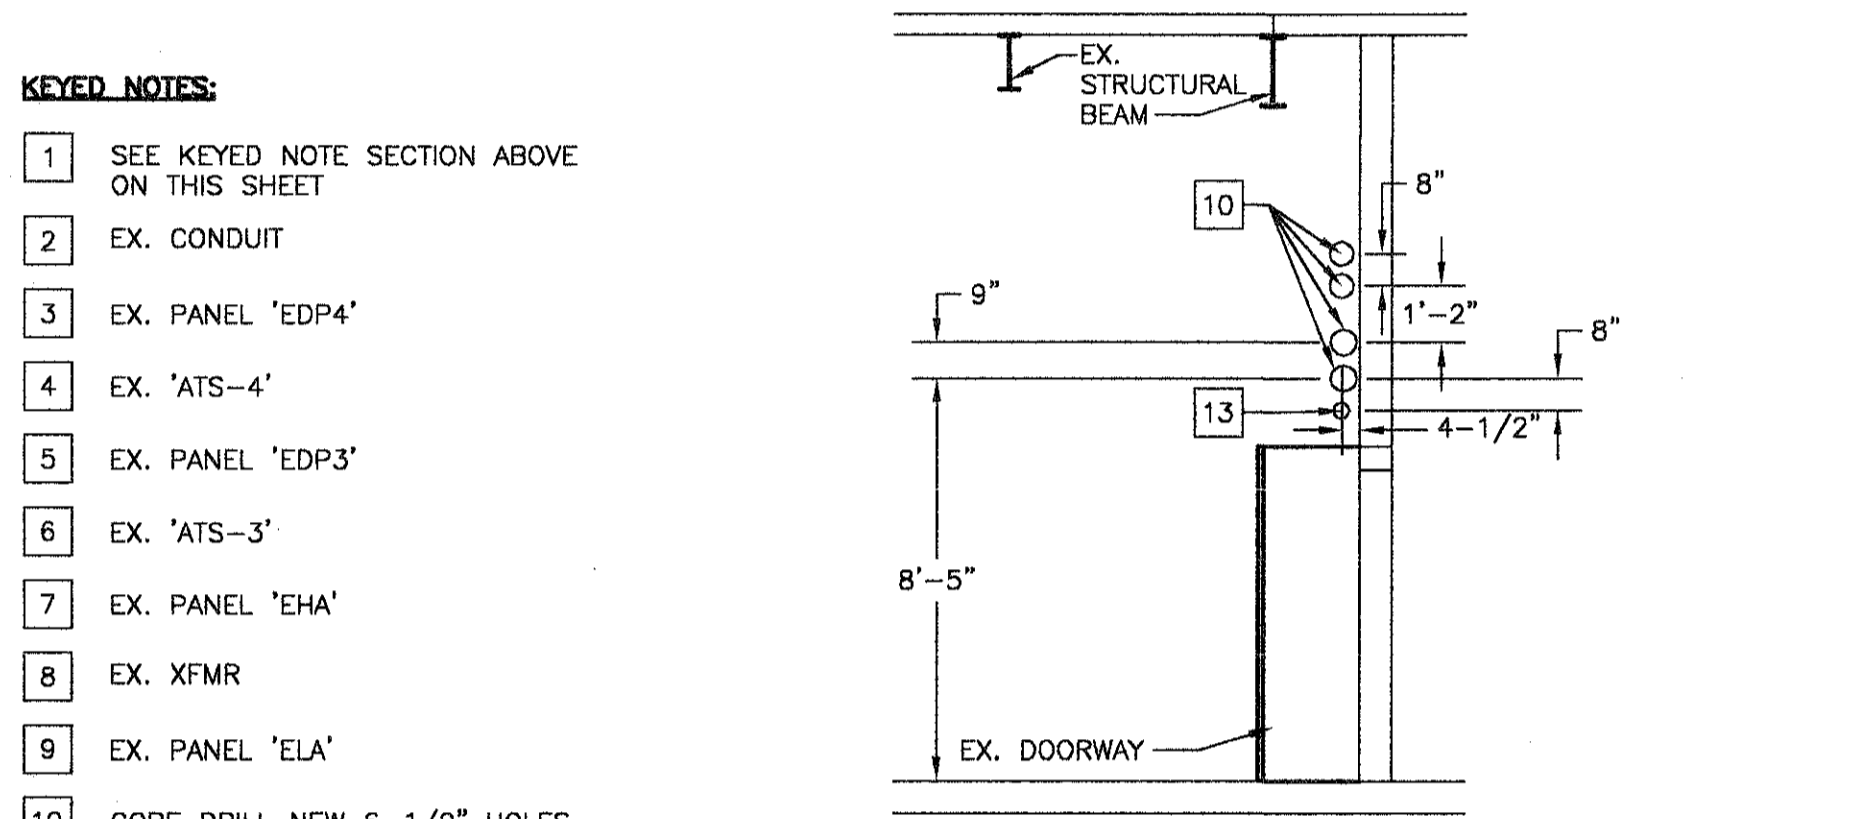

**CORE DRILLING SECTION LOOKING EAST**  
E1.000MEP1" = 4' - 0"  
NOTE: REFER TO GRAPHIC SCALE IF ACTUAL SHEET SIZE IS OTHER THAN 30"x42".  
SCALE: 1/4" = 1'-0"

**DETAIL/DRAWING REFERENCE KEY**

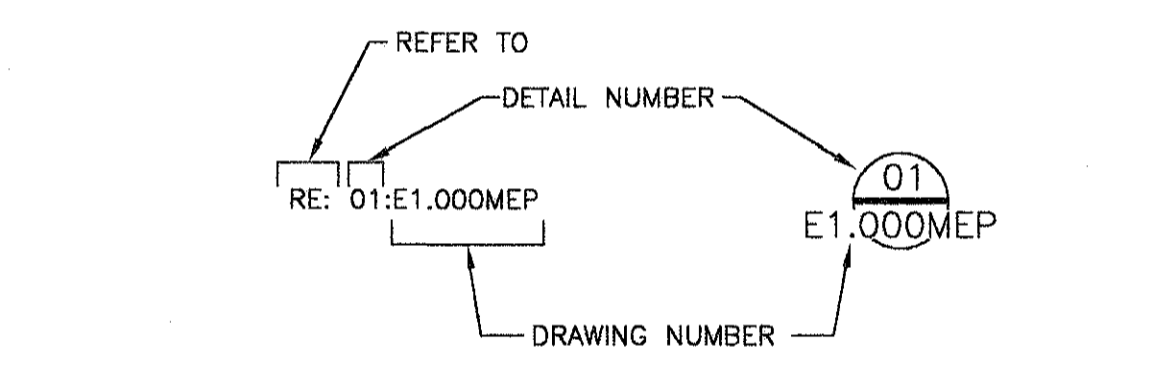

**ELECTRICAL GENERAL NOTES:**

- INSTALL COMPONENTS IN ACCORDANCE WITH CONTRACT DRAWINGS, MANUFACTURER'S INSTRUCTIONS AND APPROVED SUBMITTAL DATA.
- TAKE ALL NECESSARY PRECAUTIONS NOT TO DAMAGE CONTENTS OF EXISTING CONDUITS. WHEN WELDING IN CLOSE PROXIMITY TO COMMUNICATIONS CONDUIT, PROTECT CONDUIT WITH HEAT/FIRE BARRIER.
- CONTRACTOR IS RESPONSIBLE FOR ANY CONDUIT / FIBER THAT IS DAMAGED DURING CONSTRUCTION. RESPONSIBILITY INCLUDES THE OPERATIONAL COST OF THE SYSTEMS AFFECTED BY THE DAMAGED FIBER UNTIL THOSE SYSTEMS ARE RESTORED TO 100% FUNCTIONALITY.
- THERE SHALL BE NO MORE THAN 400 FEET OF CONDUIT BETWEEN PULL BOXES.
- THERE SHALL BE NO MORE THAN 270' OF CONDUIT BEND BETWEEN PULL BOXES.


**DRAWINGS:**

E1.000MEP NOTES AND DETAILS  
E2.200MEP PROPOSED APM POWER CONDUIT ROUTING

**ABBREVIATIONS**

GENERAL TERMS	
AFB	ABOVE FINISHED FLOOR
APPROX	APPROXIMATE
ASTM	AMERICAN SOCIETY OF TESTING AND MATERIALS
COMM	COMMUNICATION
DEMO	DEMOLISH
DET	DETAIL
DIA	DIAMETER
DUCT	DUCTWORK
EMT	ELECTRICAL METALLIC TUBING
EX	EXISTING
FFM	FEET PER MINUTE
GALV	GALVANIZED
HAS	HOUSTON AIRPORT SYSTEM
NEC	NATIONAL ELECTRICAL CODE
NFPA	NATIONAL FIRE PROTECTION ASSOCIATION
RA	RETURN AIR
REF	REFERENCE
S.A.	SUPPLY AIR
TEMP	TEMPORARY
TYP	TYPICAL
U.L.	UNDERWRITER'S LABORATORIES, INC.
XFMR	TRANSFORMER


**LINE TYPE LEGEND**

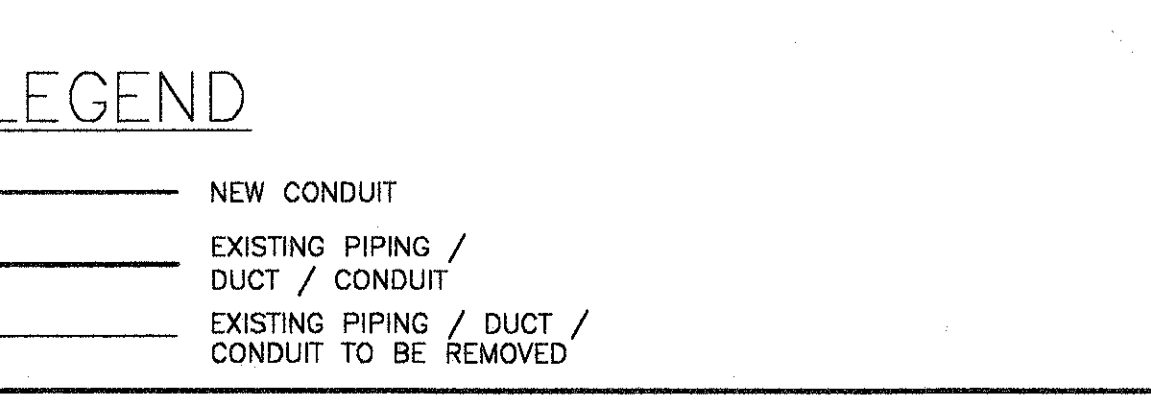

**FIRE SUPPRESSION GENERAL NOTES:**

- THIS SPACE IS PRESENTLY FULLY SPRINKLED WITH A WET PIPE SYSTEM INSTALLED IN ACCORDANCE WITH THE RULES AND REGULATIONS OF NFPA PAMPHLET NO. 13 AND CITY OF HOUSTON FIRE DEPARTMENT POLICIES AND INTERPRETATIONS USING U.L. TESTED AND APPROVED MATERIALS AND EQUIPMENT. THE SYSTEM MODIFICATION SHALL CONFORM TO THESE REQUIREMENTS UTILIZING MATERIALS MATCHING EXISTING. SPRINKLER PIPE INSTALLATION OR MODIFICATION SHALL BE THOROUGHLY COORDINATED WITH ALL OTHER TRADES PRIOR TO COMMENCEMENT OF WORK.
- ALL MODIFICATIONS TO EXISTING SPRINKLER PIPE SHALL BE DEMOLISHED TO NEAREST FITTING. NO RETHRADING OF EXISTING PIPE ALLOWED.
- NEW SPRINKLER HEADS SHALL MATCH EXISTING SPRINKLER HEADS WITHIN SIMILAR NEARBY AREAS AND SHALL BE EQUAL TO RELIABLE MODEL "G1". PROVIDE SAME AS EXISTING CONCEALED COVERS AND MATCH EXISTING CEILING FINISH DETAILS WITH A FACTORY APPLIED FINISH. SPRINKLER HEADS SHALL BE INSTALLED IN THE CENTER OF ACOUSTICAL TILES.
- SPRINKLER HEADS CAN NOT BE REUSED UNDER ANY CIRCUMSTANCE.
- TEMPERATURE RATING FOR ALL SPRINKLER HEADS SHALL BE 155°F.

**SECTION INDICATORS:**

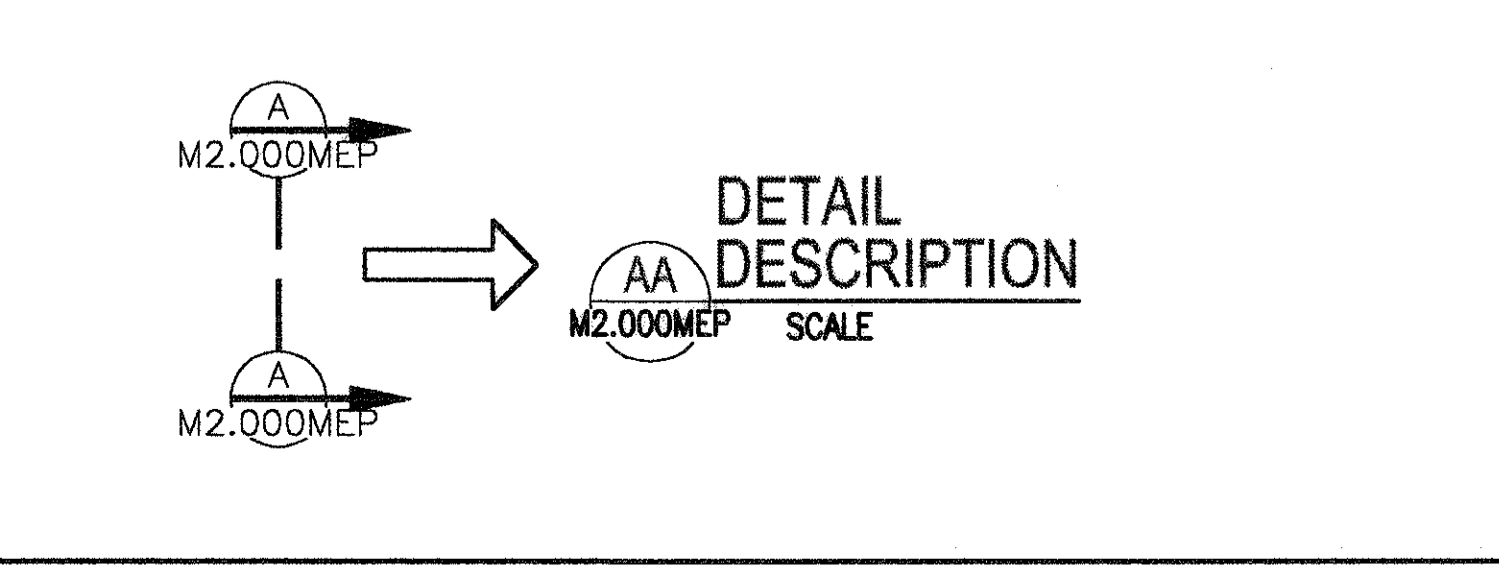


**RECORD DRAWING DO NOT MODIFY**

THE UNDERSIGNED CERTIFIES THE INFORMATION SHOWN ON CLARK CONSTRUCTION GROUP - TEXAS'S "RECORD OF THE WORK", SIGNED BY DAVID BURNS, DATED 03-1-2005, FURNISHED BY CLARK CONSTRUCTION GROUP - TEXAS TO THE CITY OF HOUSTON DEPARTMENT OF AVIATION PDC/ CONSTRUCTION DIVISION, IS CORRECTLY INCORPORATED INTO THIS RECORD DRAWING. THE UNDERSIGNED IS NOT RESPONSIBLE FOR CONTENT, ACCURACY OR COMPLETENESS OF CLARK CONSTRUCTION GROUP - TEXAS'S "RECORD OF THE WORK".

I. A. NAMAN + ASSOC., INC. 03.29.05  
(Name of Design Firm) (Date)  
WILLIAM HOWE MARSHALL  
(Printed name and signature of person whose seal appears on drawings)

**KEY MAP**

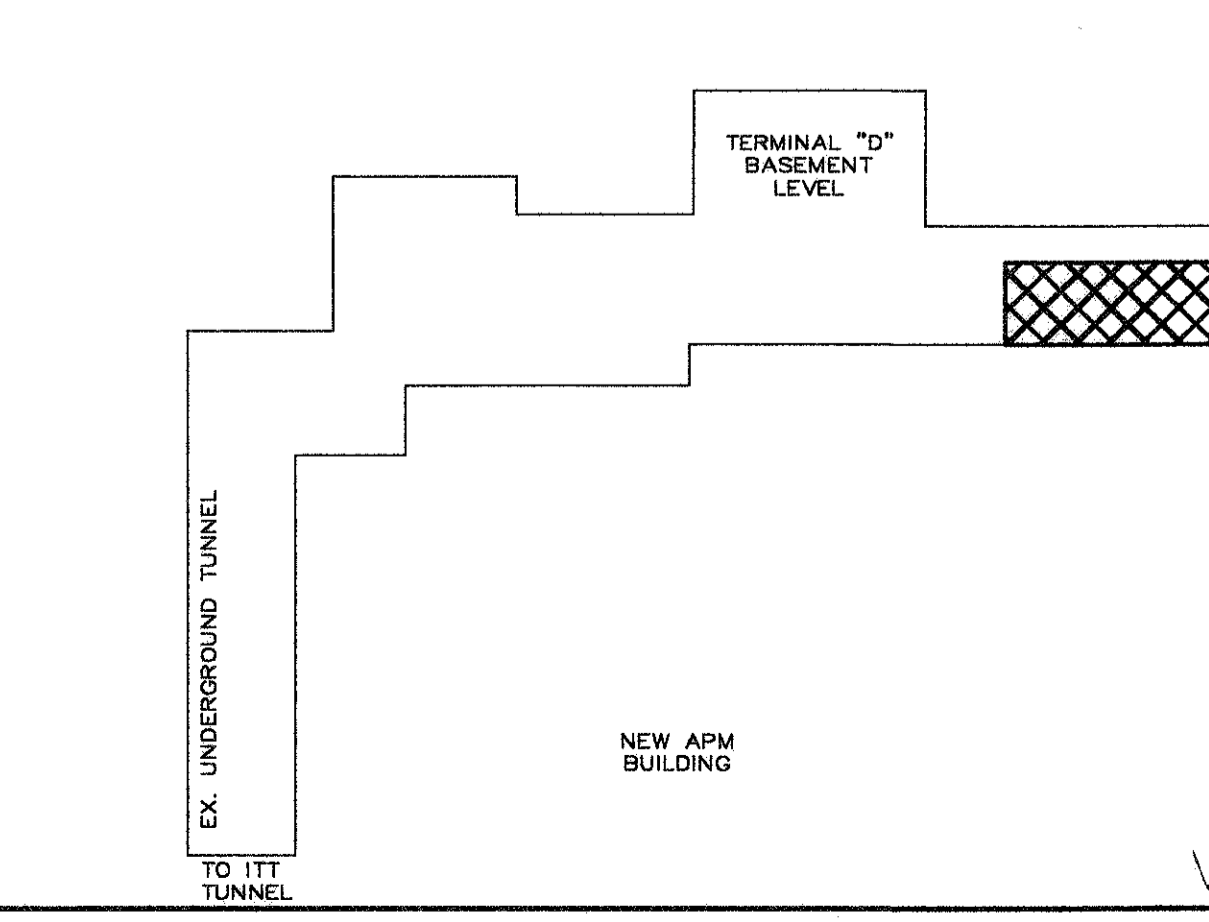

**HOUSTON AIRPORT SYSTEM**  
GEORGE BUSH  
INTERCONTINENTAL AIRPORT  
HOUSTON TEXAS

**ina**  
I. A. NAMAN + ASSOCIATES, INC.  
MEP ENGINEERING  
TWO GREENWAY PLAZA, SUITE 700  
HOUSTON, TX 77046  
(713) 860-3600 (PHONE)  
(713) 860-3789 (FAX)

REVISIONS

NO.	DESCRIPTION	DATE	BY
1.	BULLETIN 22C	02.03.04	CMB
2.	R.D.'S	03.29.05	CMB


INTERNATIONAL • SERVICES • EXPANSION • PROGRAM

**APM STATION + PLATFORM**

NOTES AND DETAILS

PROJECT MGR: WHM  
DESIGNER: VFS/CDE  
DRAWN BY: VFS/CDE  
CHECKED BY: VFS/CDE  
DRAWING STANDARD:

SCALE: AS NOTED  
DATE: 02.03.04

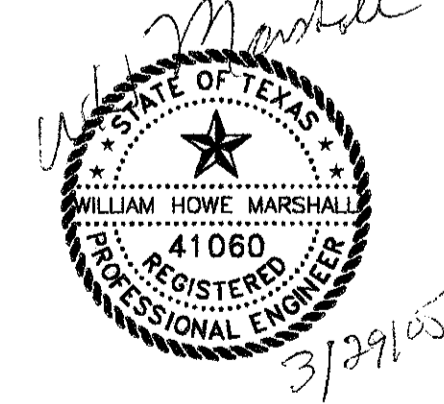

APPROVED BY: \_\_\_\_\_ DATE: \_\_\_\_\_

DIRECTOR  
HOUSTON AIRPORT SYSTEM

PROJECT NO. 1312  
C.I.P. NO. A-0354  
H.A.S. NO. 536C  
SHEET NO. E1.000MEP




NO.	DESCRIPTION	DATE	BY
1	REVISION ME 2	4-17-2003	BBB
	RECORD DRAWING	05/06/05	

INTERNATIONAL PROGRAM  
 SERVICES EXPANSION  
**APM STATION + PLATFORM**  
 ELECTRICAL SITE PLAN

PROJECT MGR:	A. BELTRAN
DESIGNER:	D. BELFLE
DRAWN BY:	D. BELFLE
CHECKED BY:	A. BELTRAN
DRAWING STANDARD:	
SCALE:	AS NOTED
DATE:	09/14/01

**RECORD DRAWING**  
 THIS DRAWING HAS BEEN REVISIONED TO SHOW SIGNIFICANT CHANGES IN THE WORK MADE DURING CONSTRUCTION BASED ON MARKED-UP PRINTS, DRAWINGS AND OTHER DATA.

APPROVED BY:	DATE:
DESIGNER:	DATE:
PROJECT NO.:	1061-001
C.I.P. NO.:	A-0354
H.A.S. NO.:	5382
SHEET NO.:	

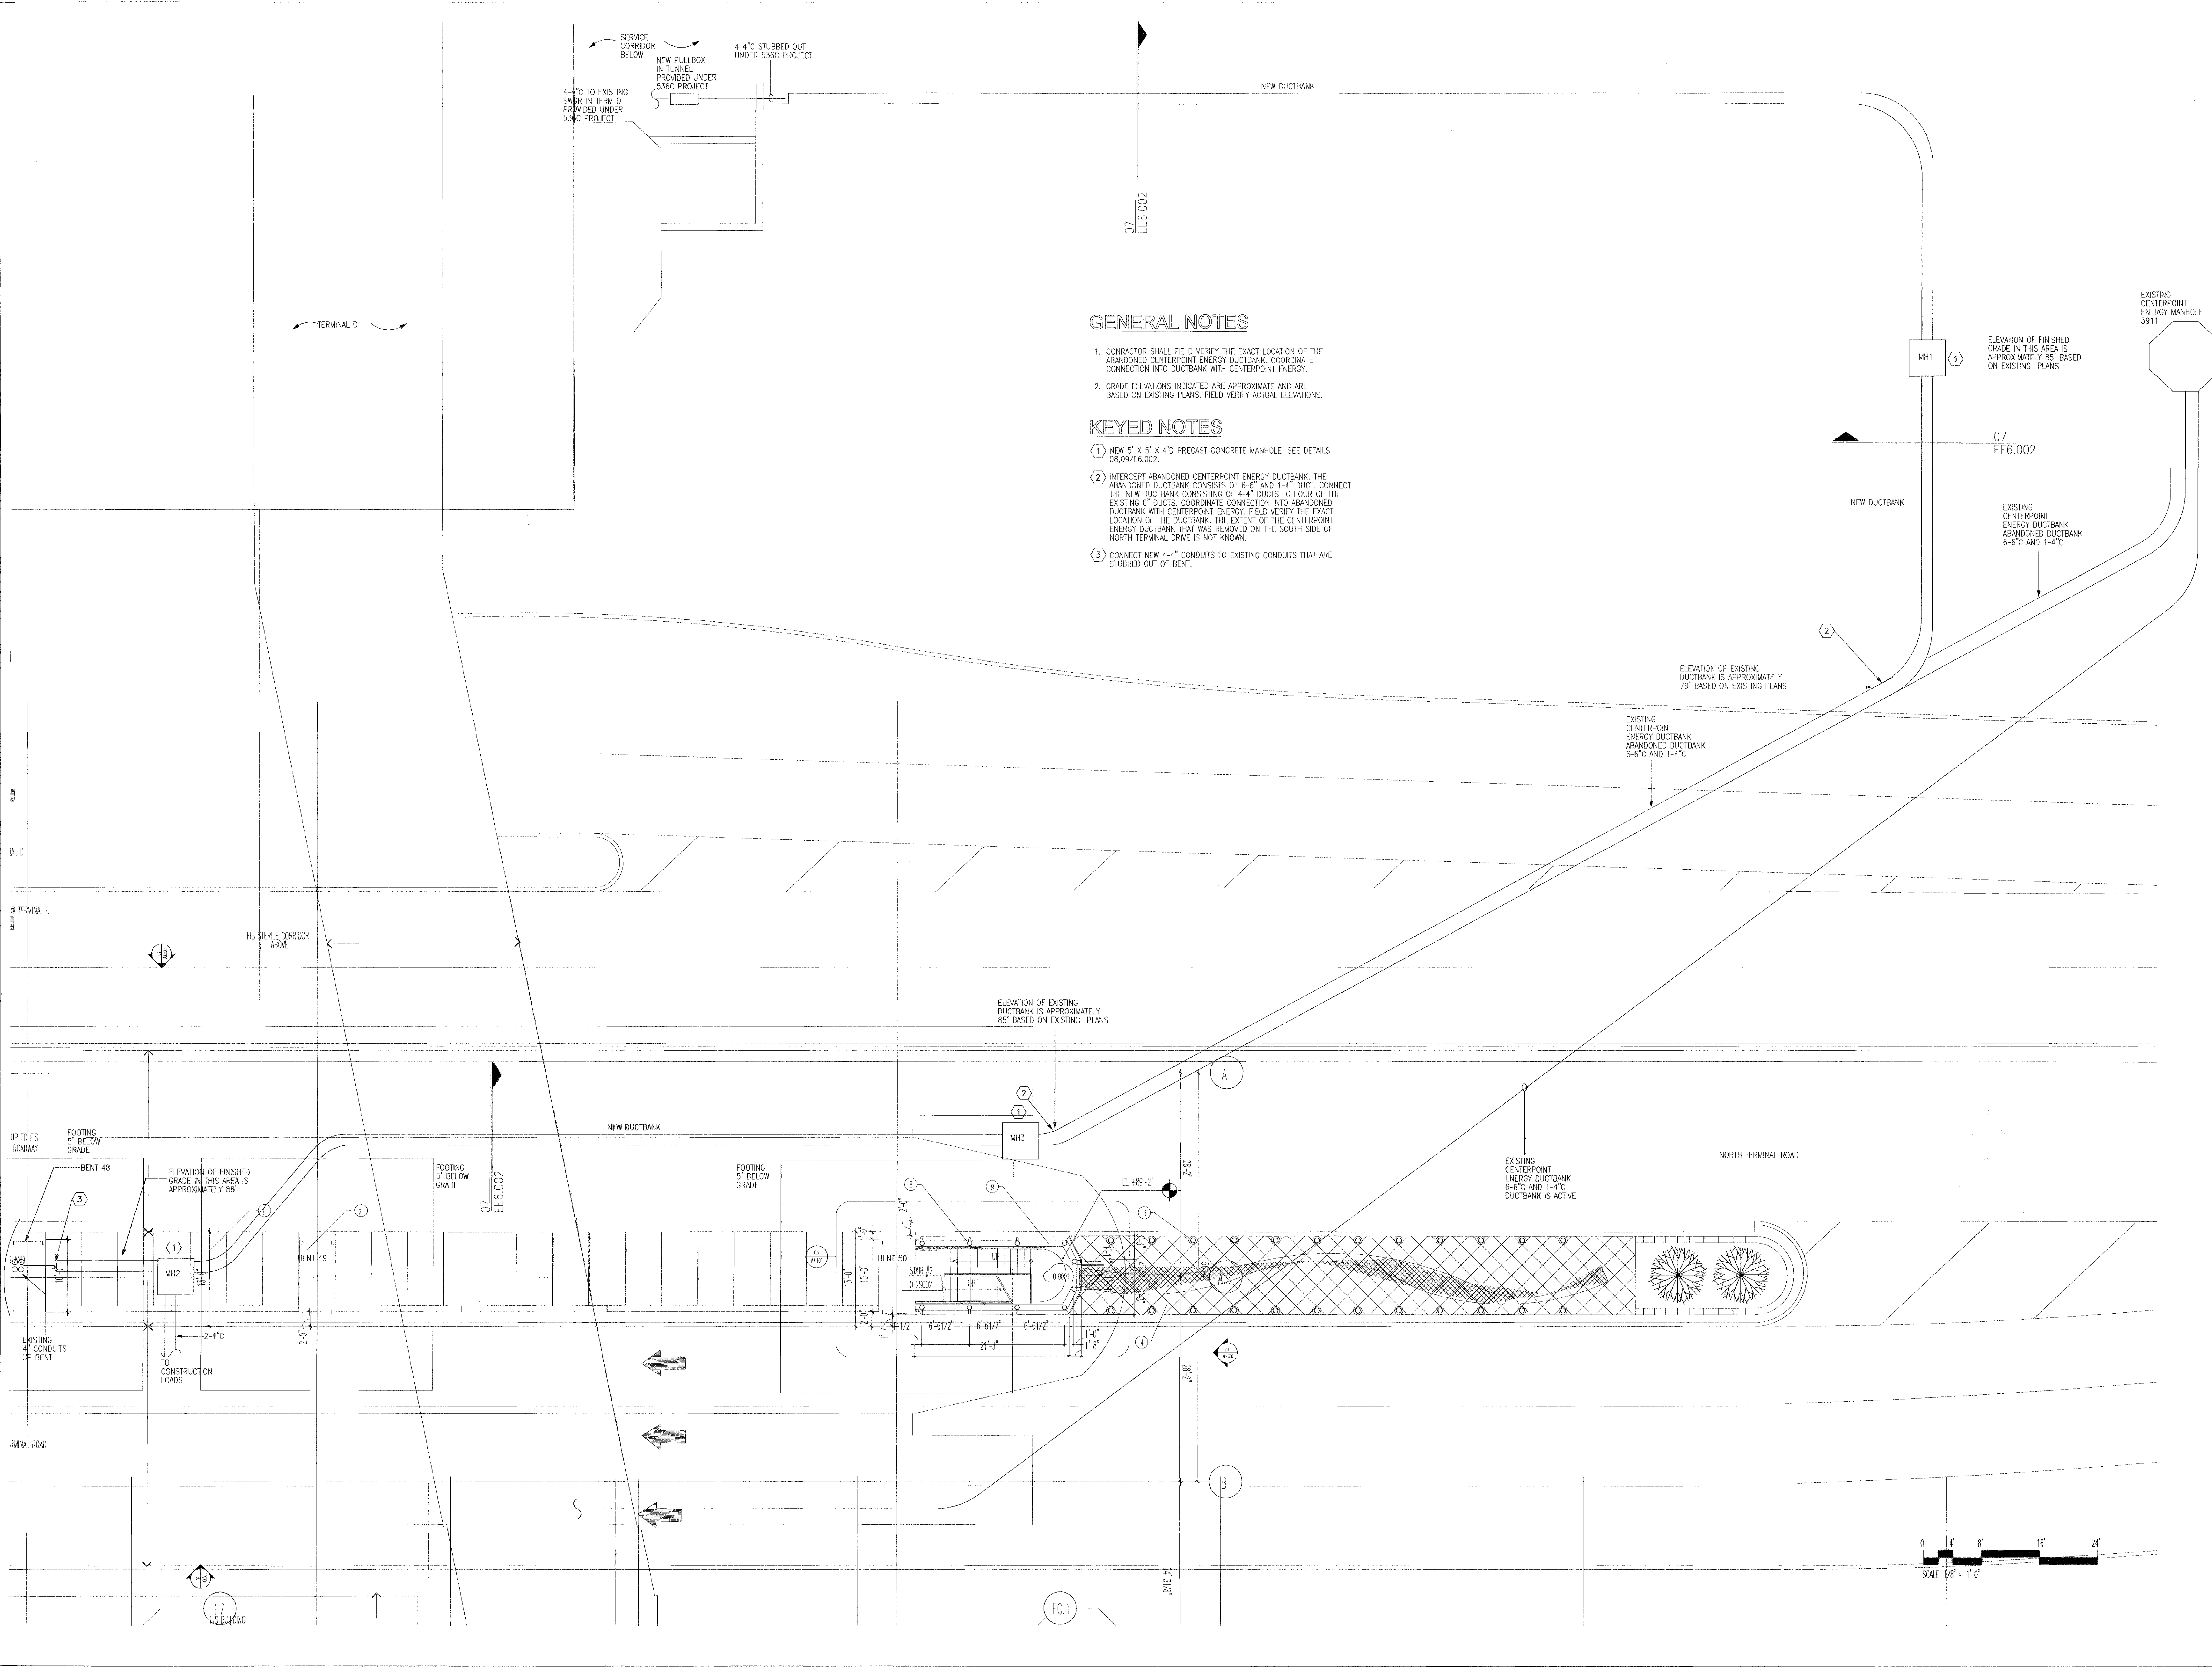


**GENERAL NOTES**

- CONTRACTOR SHALL FIELD VERIFY THE EXACT LOCATION OF THE ABANDONED CENTERPOINT ENERGY DUCTBANK. COORDINATE CONNECTION INTO DUCTBANK WITH CENTERPOINT ENERGY.
- GRADE ELEVATIONS INDICATED ARE APPROXIMATE AND ARE BASED ON EXISTING PLANS. FIELD VERIFY ACTUAL ELEVATIONS.


**KEYED NOTES**

- NEW 5' X 5' X 4'D PRECAST CONCRETE MANHOLE. SEE DETAILS 08.09/EE6.002.
- INTERCEPT ABANDONED CENTERPOINT ENERGY DUCTBANK. THE ABANDONED DUCTBANK CONSISTS OF 6-6" AND 1-4" DUCT. CONNECT THE NEW DUCTBANK CONSISTING OF 4-4" DUCTS TO FOUR OF THE EXISTING 6" DUCTS. COORDINATE CONNECTION INTO ABANDONED DUCTBANK WITH CENTERPOINT ENERGY. FIELD VERIFY THE EXACT LOCATION OF THE DUCTBANK. THE EXTENT OF THE CENTERPOINT ENERGY DUCTBANK THAT WAS REMOVED ON THE SOUTH SIDE OF NORTH TERMINAL DRIVE IS NOT KNOWN.
- CONNECT NEW 4-4" CONDUITS TO EXISTING CONDUITS THAT ARE STUBBED OUT OF BENT.

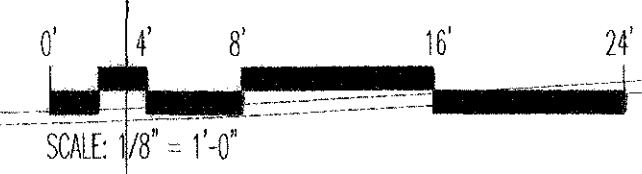



NO.	DESCRIPTION	DATE	BY
ISSUED FOR BID		10/19/01	
REVISION NO. 1	11-27-2003	BBB	
REVISION NO. 2	4-17-2003	BBB	
BULLETIN NO. 43	10-03-2003	BBB	
RECORDED DRAWING		05/06/05	


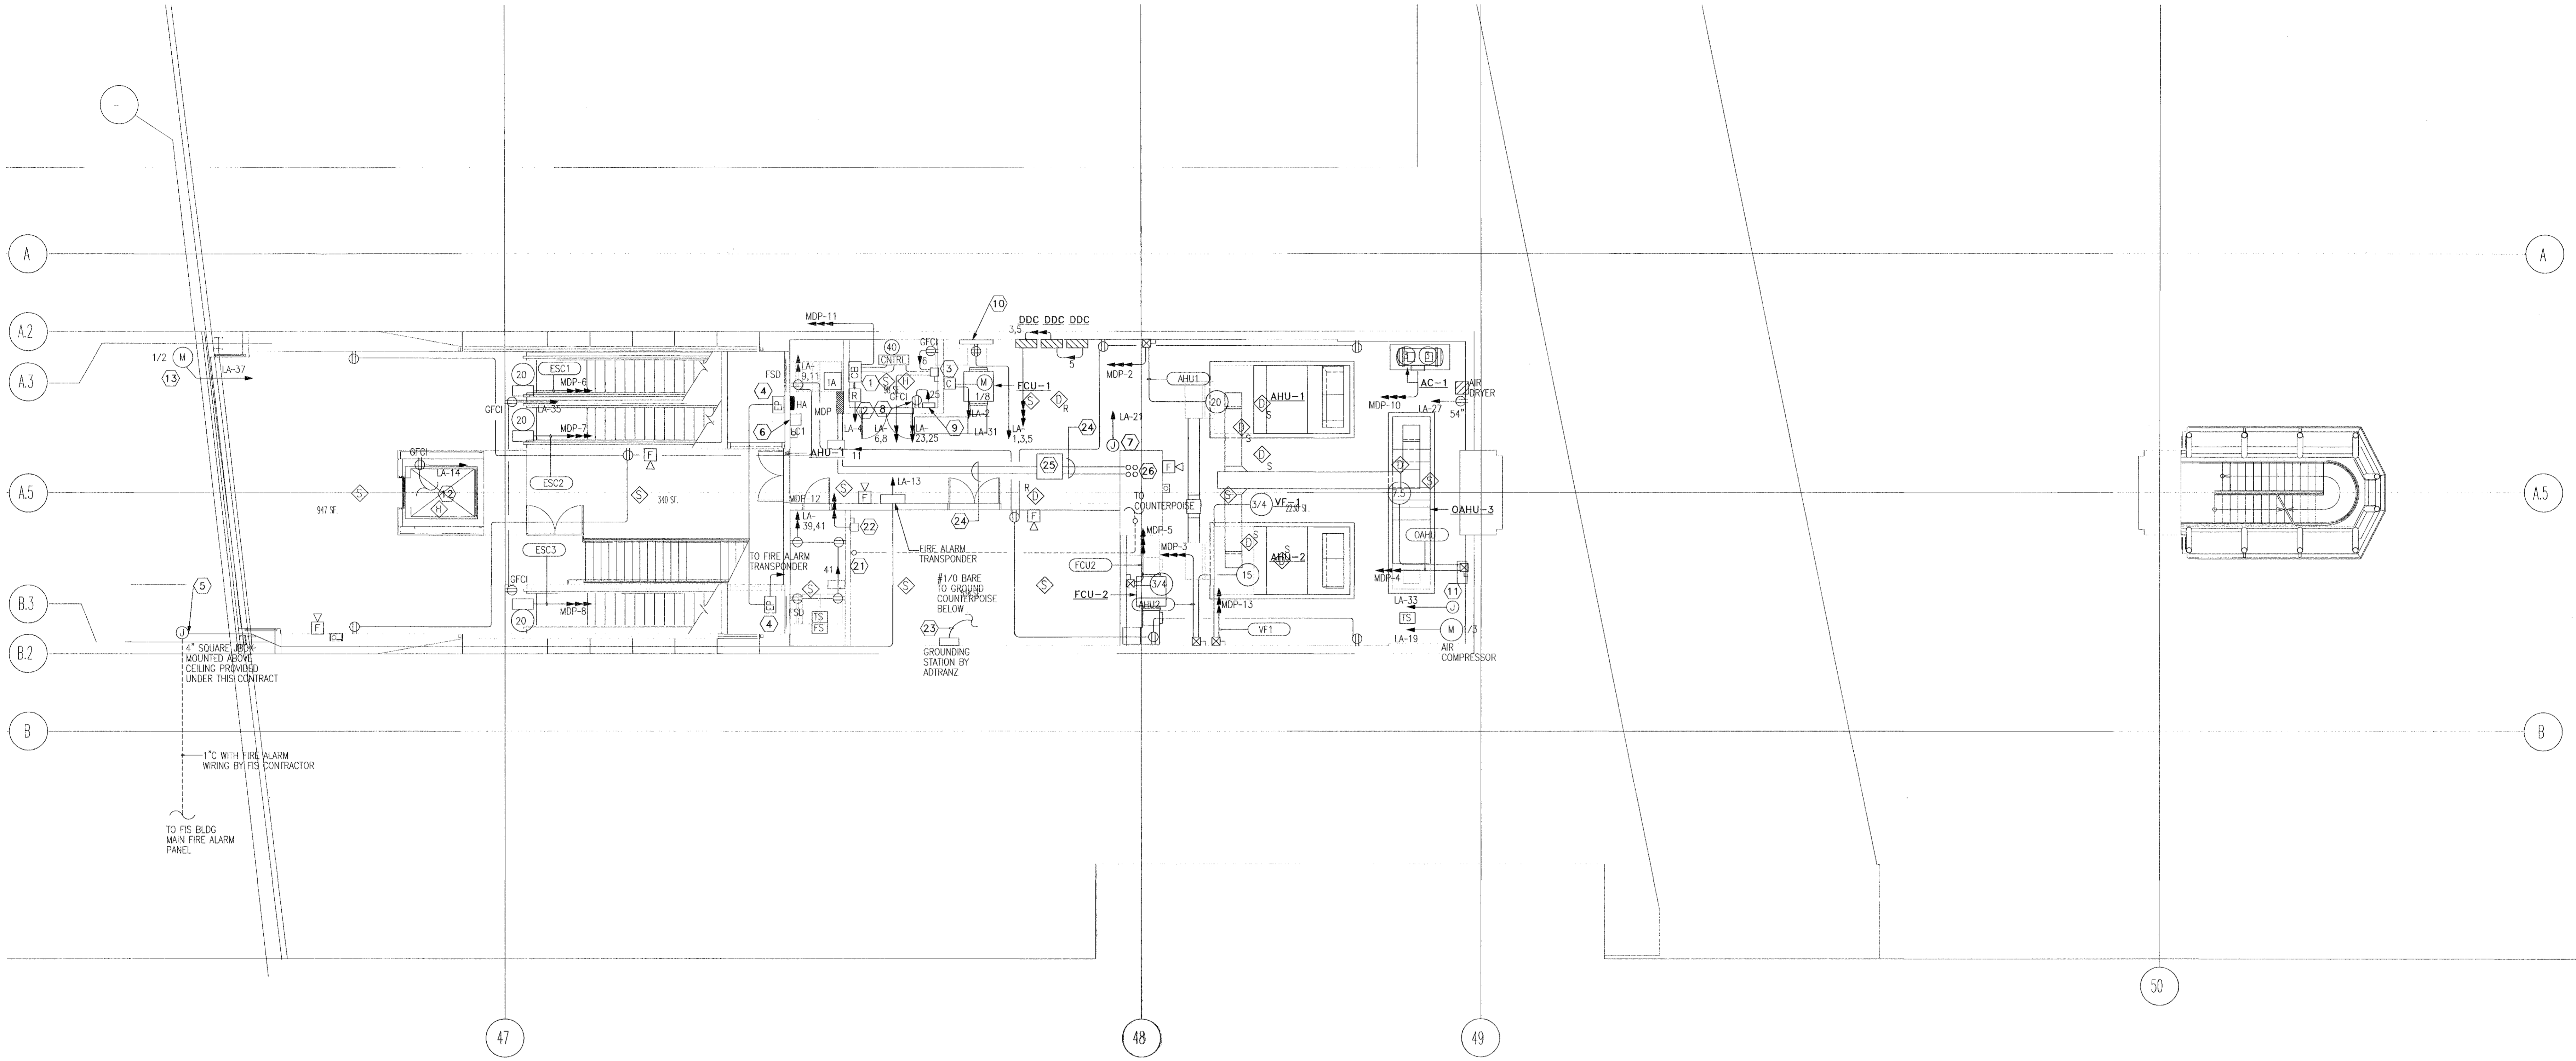


**KEYED NOTES:**

- 1 SHUNT TRIP CIRCUIT BREAKER WITH NORMALLY OPEN AUXILIARY CONTACT FOR BATTERY LOWERING REQUIREMENTS. CONNECT 2#14, #14 GND, 3#16 FROM AUXILIARY CONTACT TO ELEVATOR CONTROLLER.
- 2 FIRE ALARM SHUTDOWN RELAY.
- 3 240V, 30A/2P DISCONNECT SWITCH FOR ELEVATOR CAB LIGHTING AND RECEPTACLE CIRCUIT.
- 4 CONNECT "EP" SWITCH FOR FIRE SMOKE DAMPER TO FIRE ALARM TRANSPONDER.
- 5 TERMINATE CONDUITS IN JUNCTION BOXES AS INDICATED.
- 6 SEE 03/E6.001 FOR LIGHTING CONTACTOR CONTROL DIAGRAM.
- 7 JUNCTION BOX FOR CONNECTION TO HEAT TRACING.
- 8 RECEPTACLE FOR ELEVATOR SUMP PUMP SP-1.
- 9 ELEVATOR SUMP ALARM PANEL PROVIDED UNDER DIV 15.
- 10 4" W X 8" H X 3/4" D PLYWOOD BACKBOARD FOR COMMUNICATION EQUIPMENT.
- 11 CONNECT 120V CIRCUIT TO VALVE PROVIDED UNDER DIVISION 15. SEE PLUMBING PLANS.
- 12 CONNECT RECEPTACLE IN ELEVATOR PIT TO LIGHT FIXTURE IN PIT. SEE SHEET E3.001.
- 13 FIRE DOOR MOTOR OPERATOR. FIRE DOOR SHALL CLOSE ON ACTIVATION OF FIRE ALARM SYSTEM.
- 14 NOT USED.
- 15 NOT USED.
- 16 NOT USED.
- 17 NOT USED.
- 18 NOT USED.
- 19 NOT USED.
- 20 NOT USED.
- 21 #1/0 GROUND IN 3/4" C. ROUTE IN SLAB, DOWN COLUMN AND CONNECT TO GROUND COUNTERPOISE. SEE E4.000. LEAVE 10' OF CONDUCTOR SLACK IN ROOM FOR CONNECTION TO UPS BY ADTRANZ.
- 22 DISCONNECT SWITCH FOR UPS. UPS PROVIDED BY ADTRANZ.

**GENERAL NOTES:**

1. SMOKE DAMPERS AND AHU'S SHALL SHUTDOWN ON ANY GENERAL FIRE ALARM.

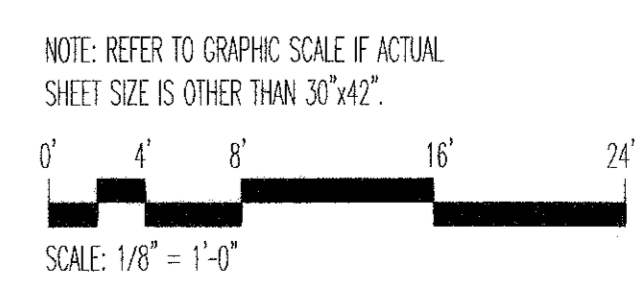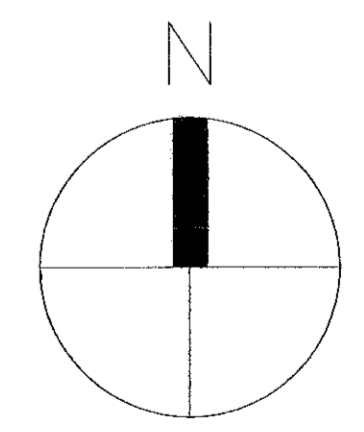

INTERNATIONAL SERVICES EXPANSION PROGRAM  
**APM STATION + PLATFORM**  
 LOBBY - POWER AND FIRE ALARM PLAN

PROJECT MGR:	A.E.BELTRAM
DESIGNER:	D.BELISLE
DRAWN BY:	D.BELISLE
CHECKED BY:	A.E.BELTRAM
DRAWING STANDARD:	ISEP 07.20.2000
SCALE:	AS NOTED
DATE:	09/14/01

**RECORD DRAWING**  
 THIS DRAWING HAS BEEN REVIEWED TO SHOW SIGNIFICANT CHANGES IN THE WORK MADE DURING CONSTRUCTION BASED ON MARKED-UP PRINTS, DRAWINGS AND OTHER DATA.

APPROVED BY:	DATE:
DIRECTOR HOUSTON AIRPORT SYSTEM	
PROJECT NO.:	1581-001
C.I.P. NO.:	A-0304
H.A.S. NO.:	5395
SHEET NO.:	













**GENERAL NOTES:**  
 1. NOT USED

**REVISIONS**

NO.	DESCRIPTION	DATE	BY
1.	BULLETIN 22C 02.03.04 CDB		
2.	R.D.'S	03.28.05	CDB

**KEYED NOTES:**

- 1 WALL MOUNTED CANTILEVER HANGER SUPPORT. SEE DETAIL 02 SHEET E1.000MEP (TYP).
- 2 EX. CONDUIT
- 3 EX. PANEL 'EDP4'
- 4 EX. 'ATS-4'
- 5 EX. PANEL 'EDP3'
- 6 EX. 'ATS-3'
- 7 EX. PANEL 'EHA'
- 8 EX. XFMR
- 9 EX. PANEL 'ELA'
- 10 UNISTRUT TRAPEZE STYLE HANGER SUPPORT. SEE DETAIL 01 SHEET E1.000MEP (TYP).
- 11 PROPOSED NEW PULLBOX (24"x60"x8" DEEP) SEE DETAIL 03 SHEET E1.000MEP (TYP)

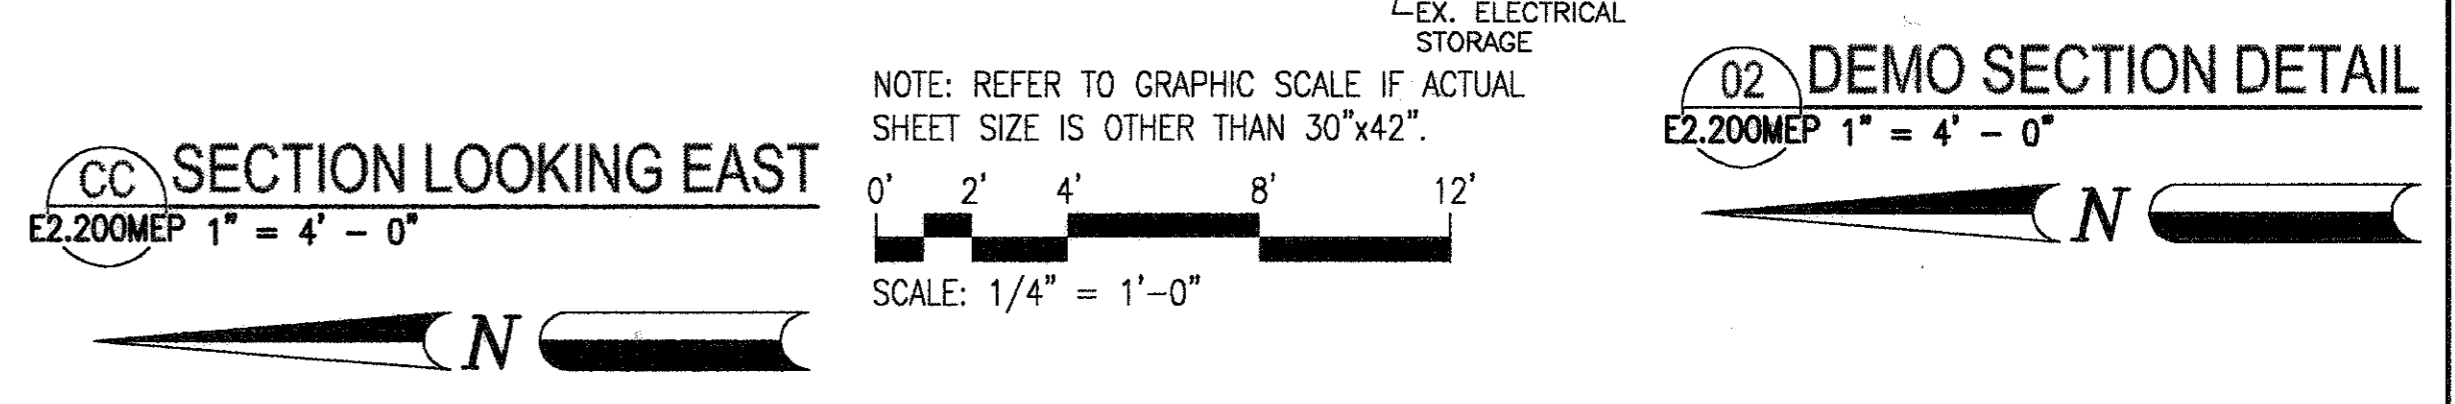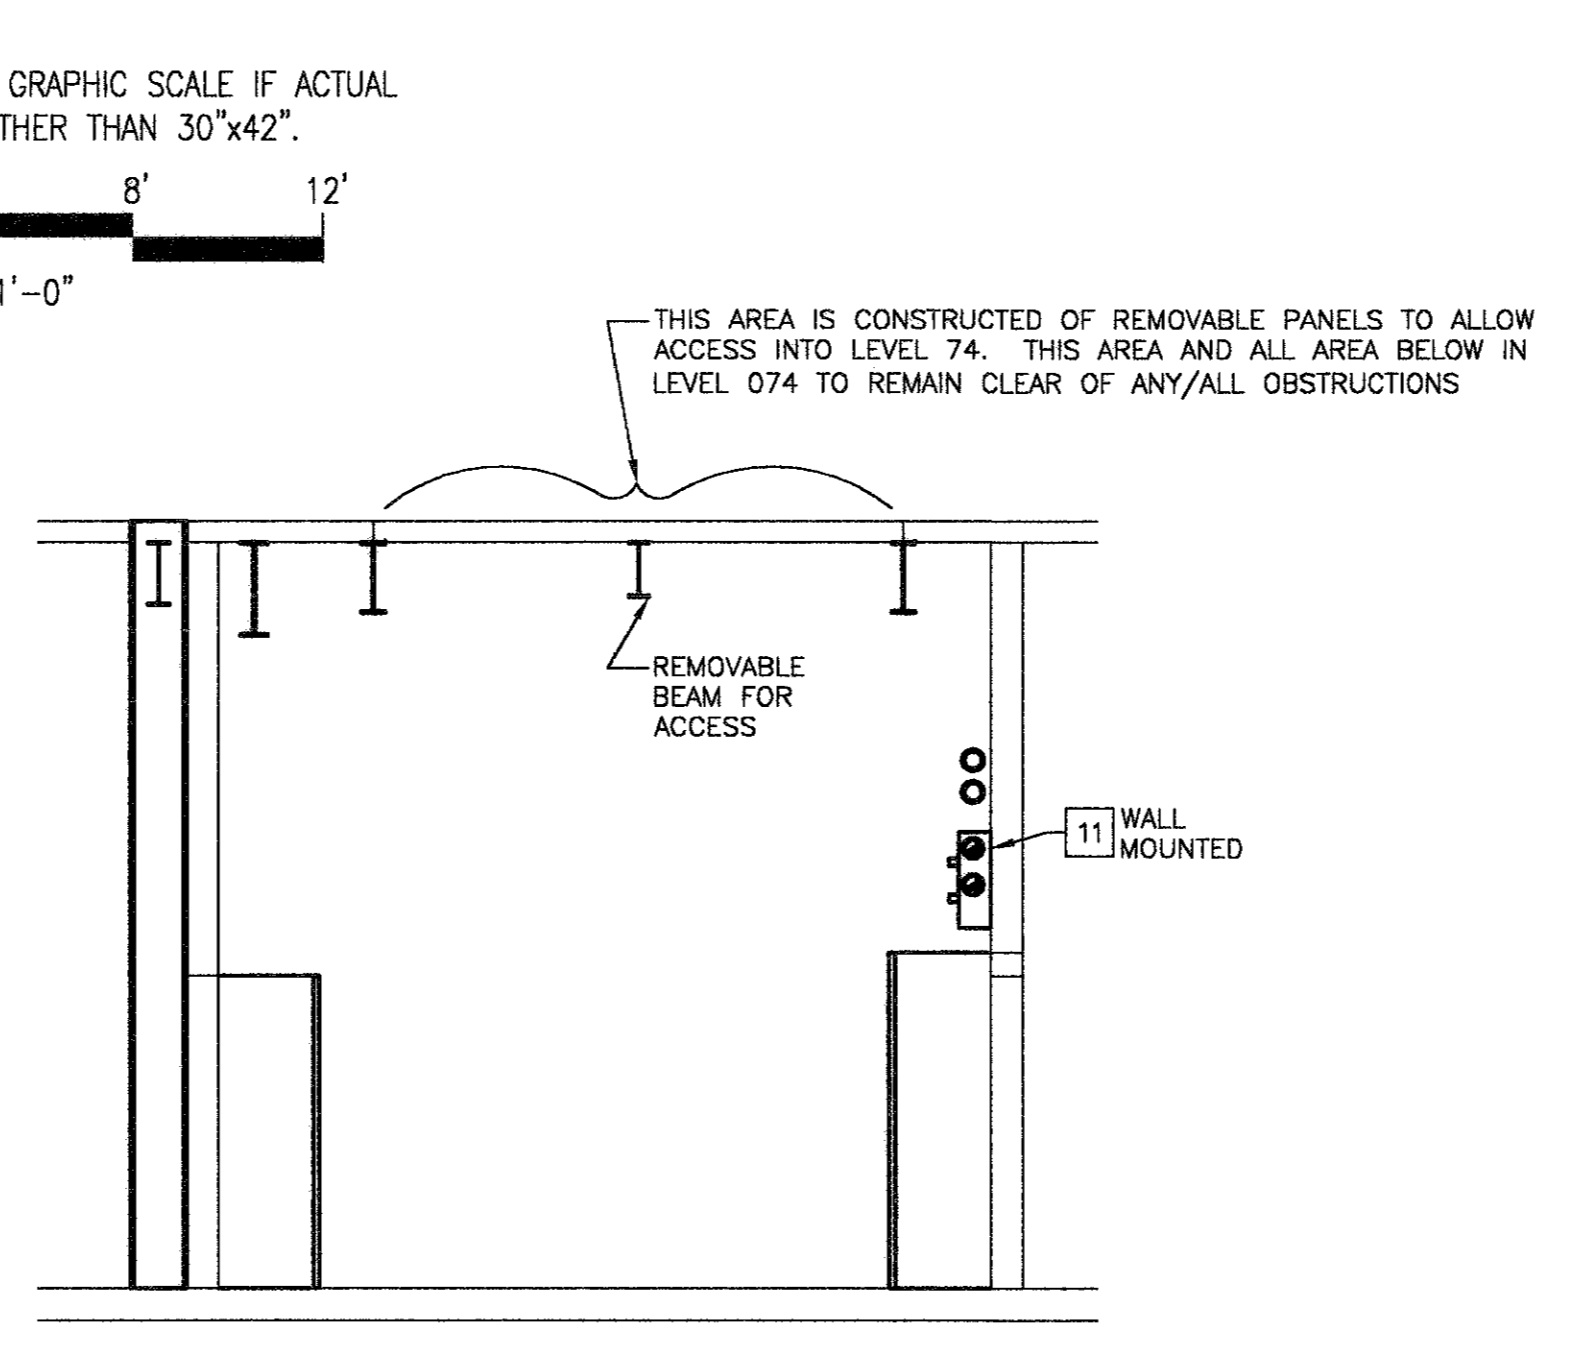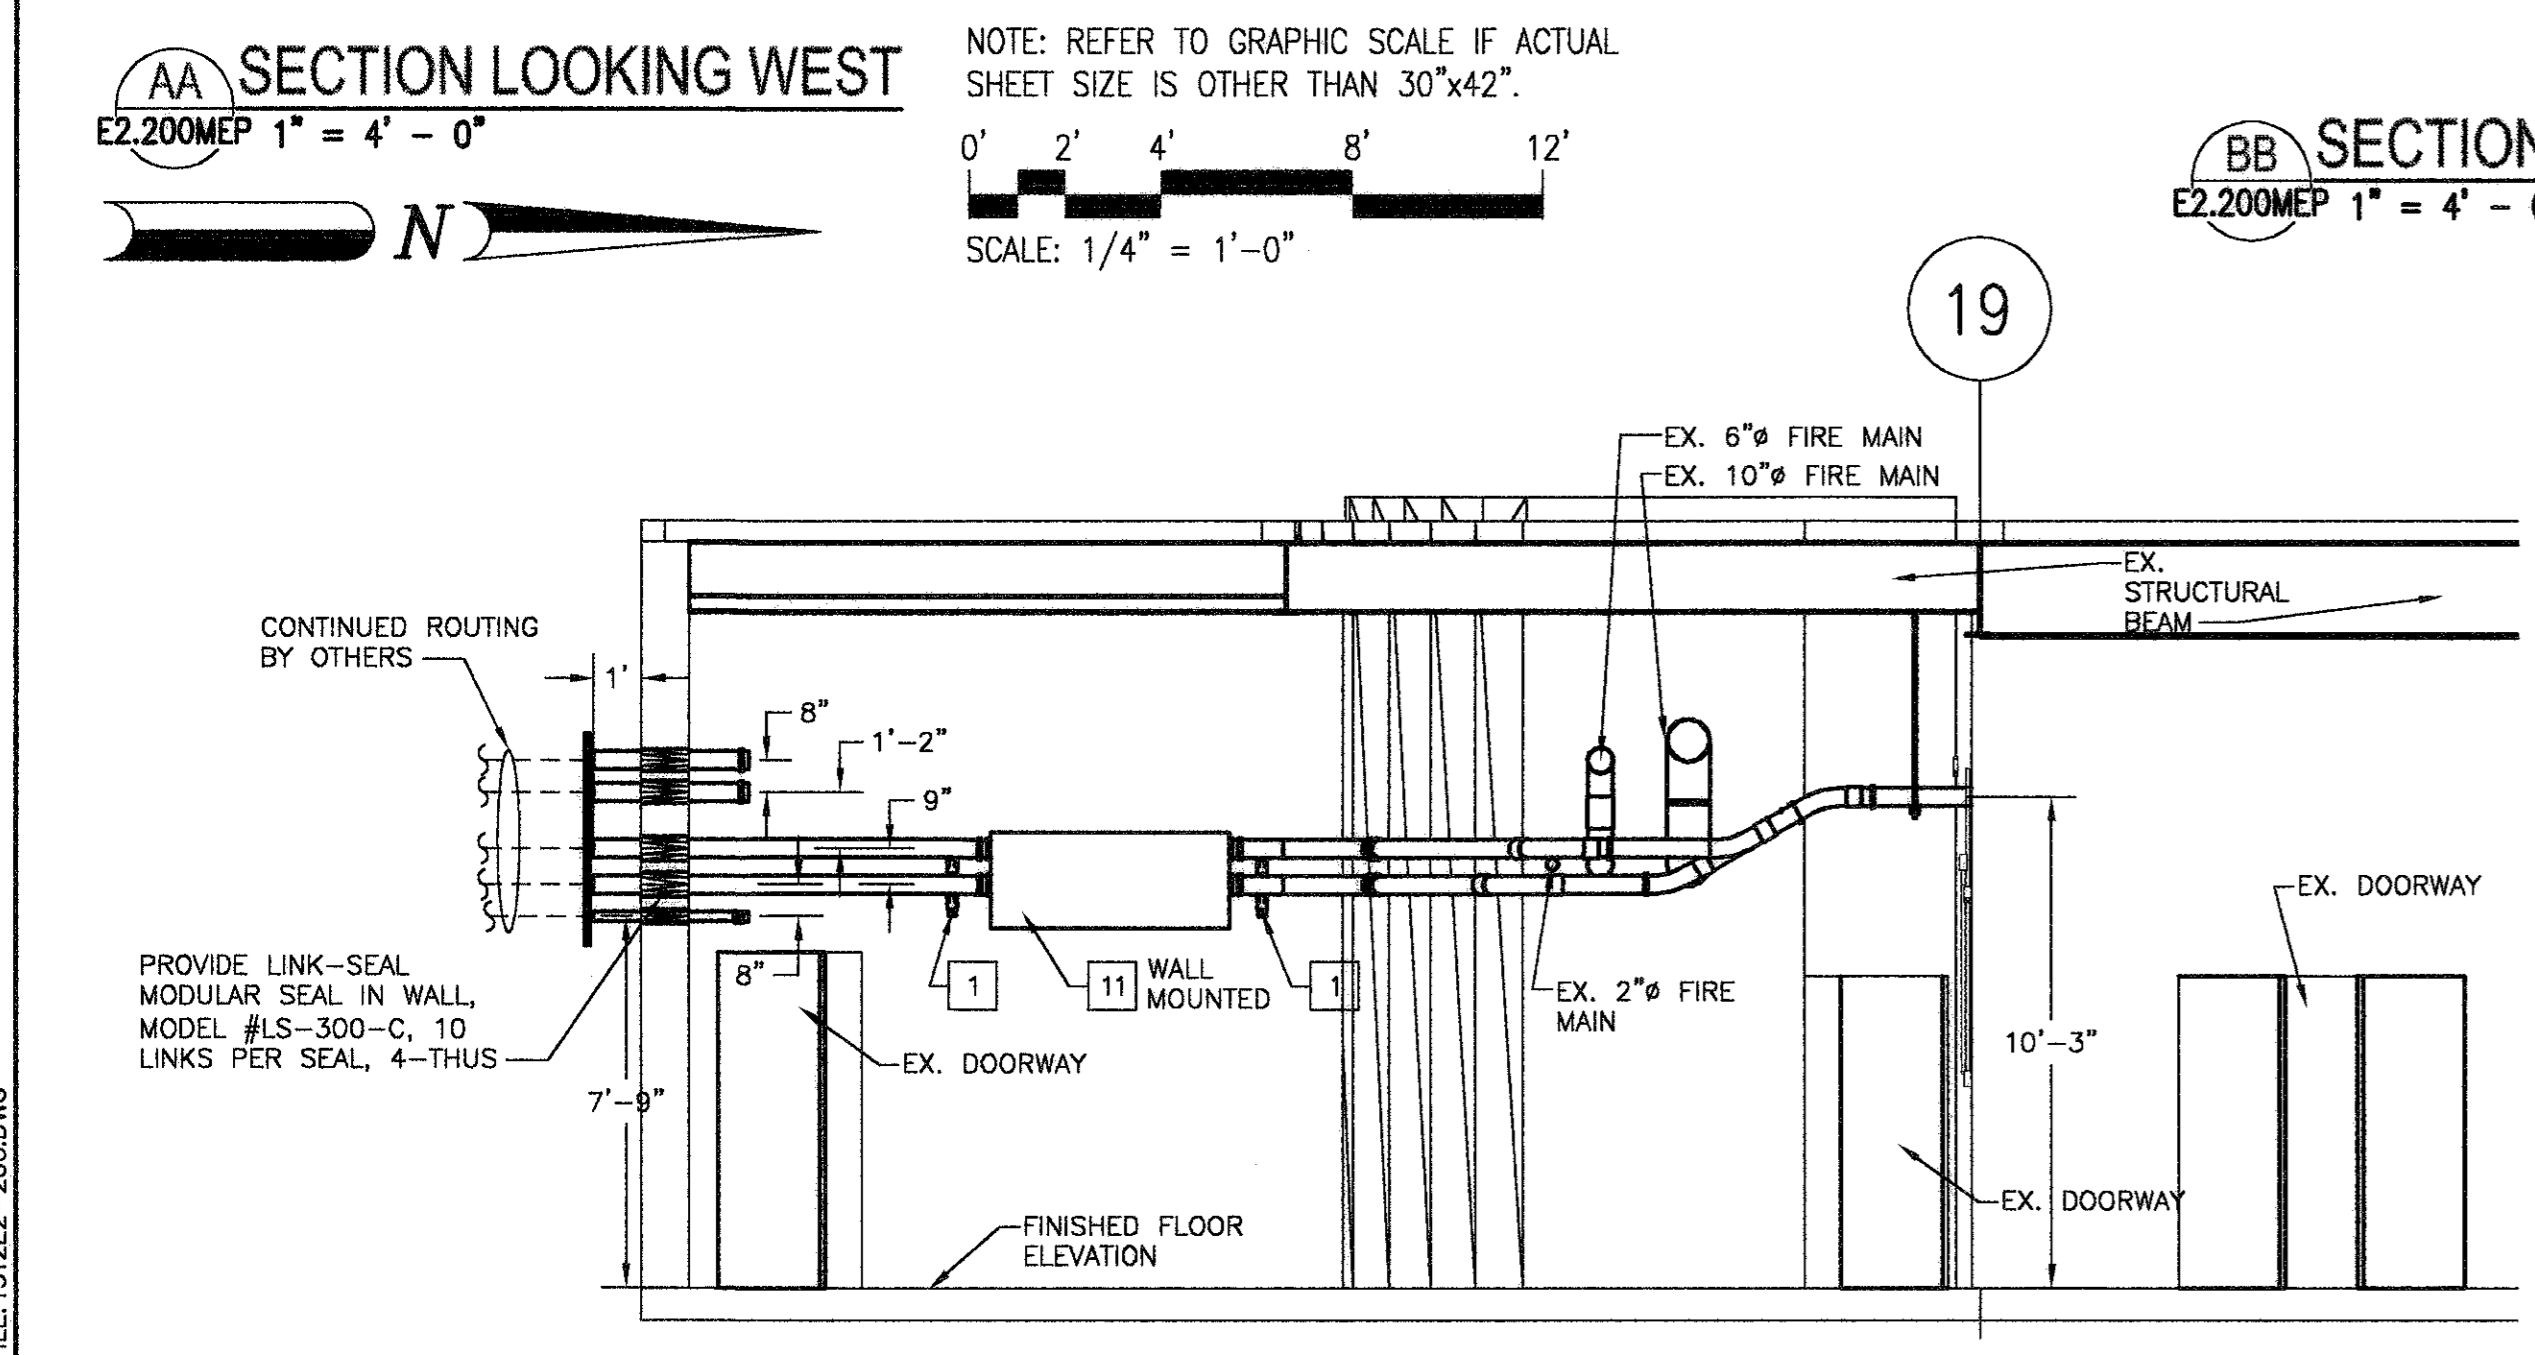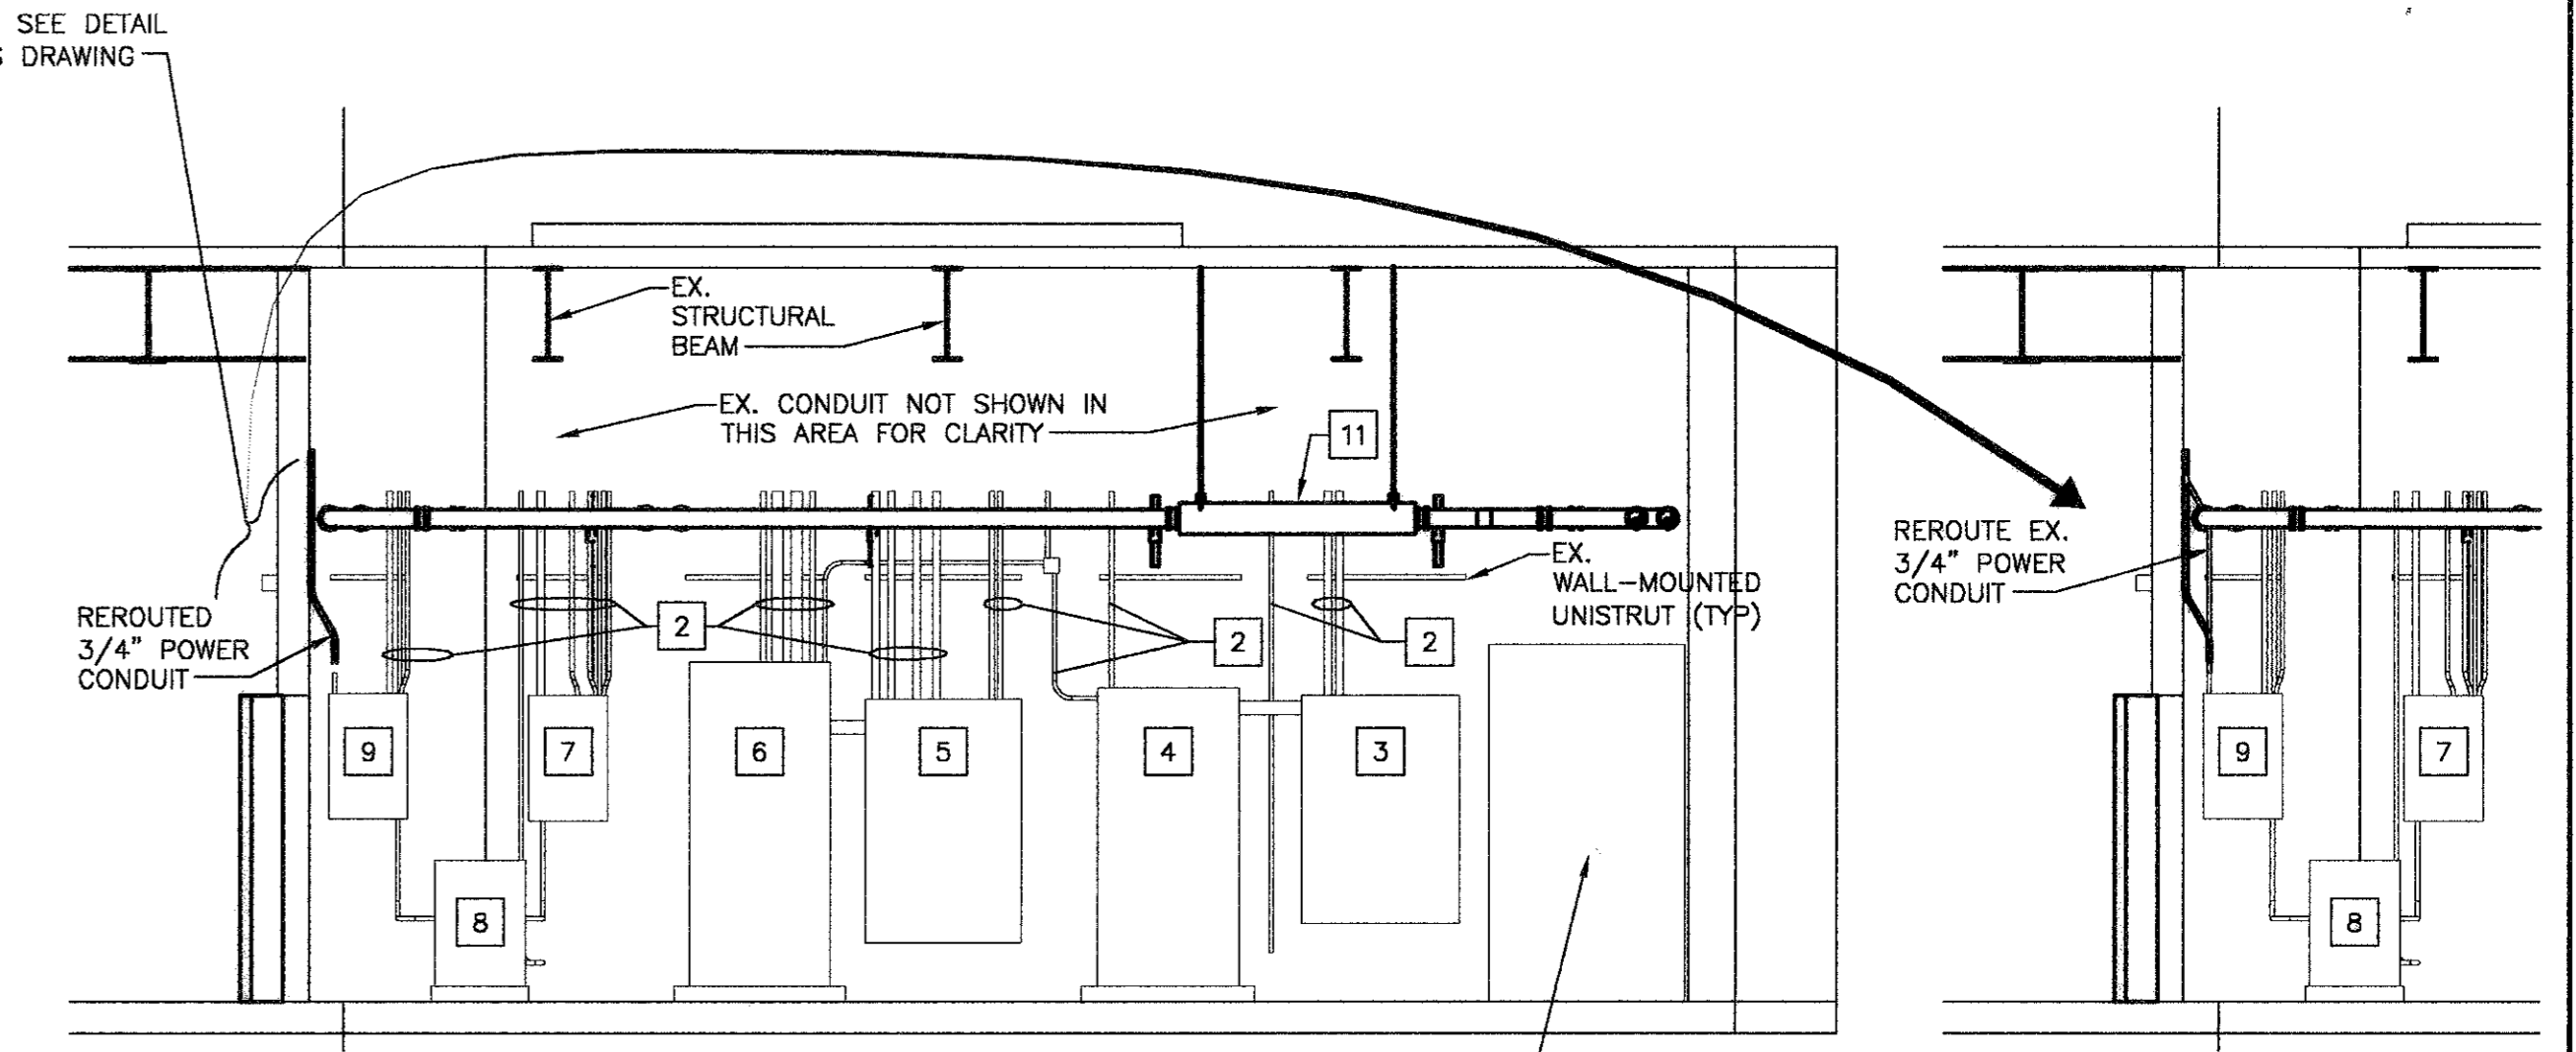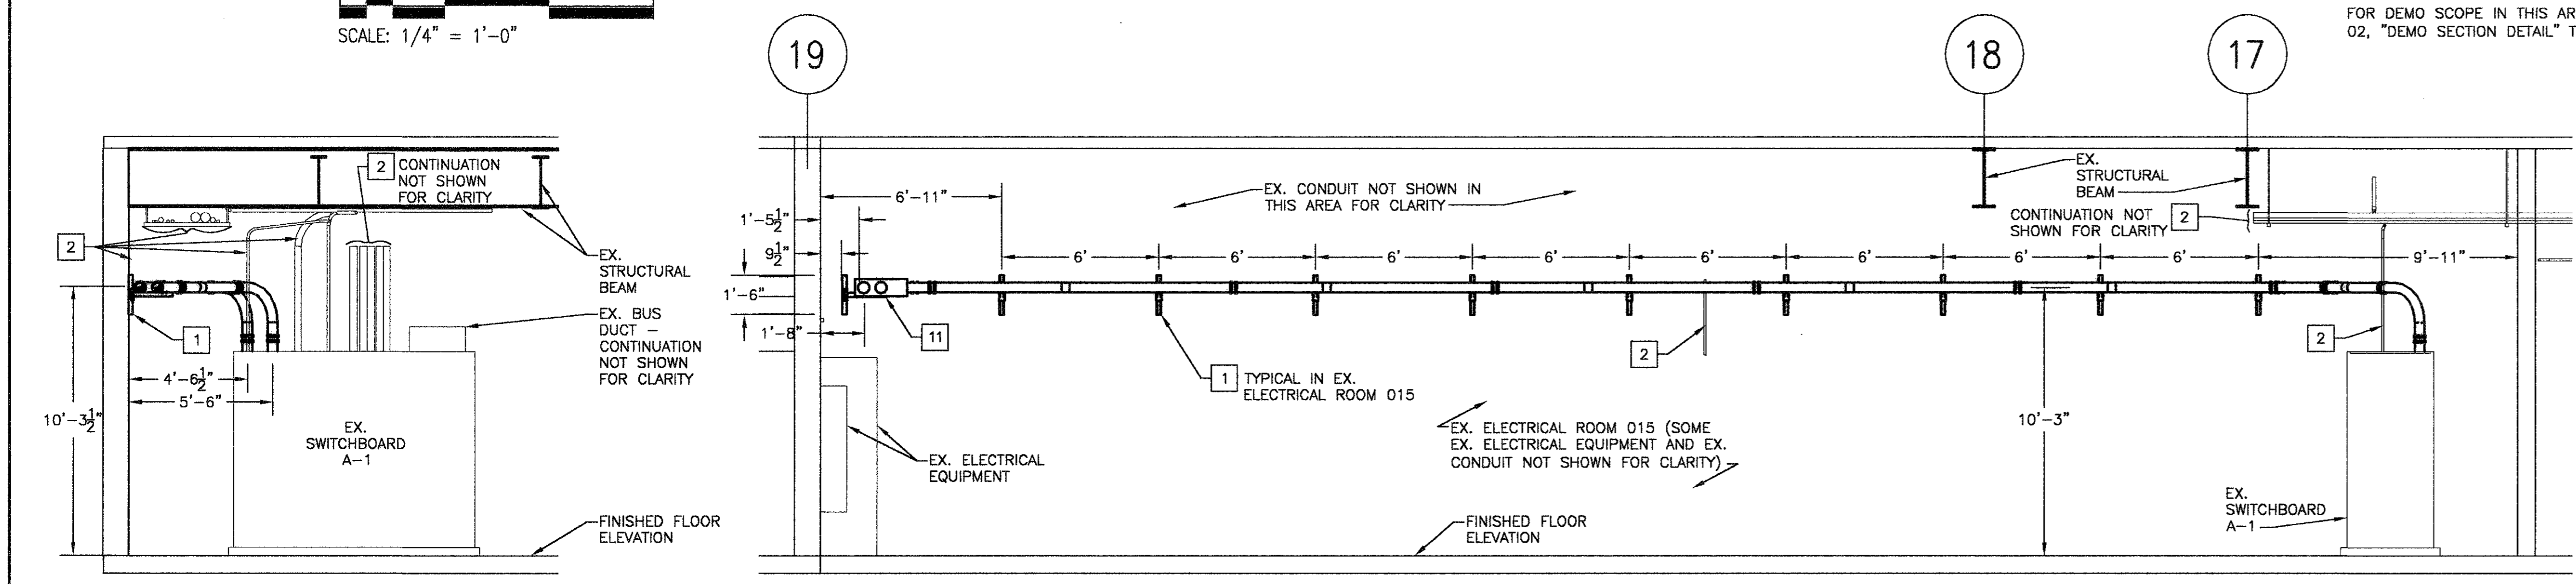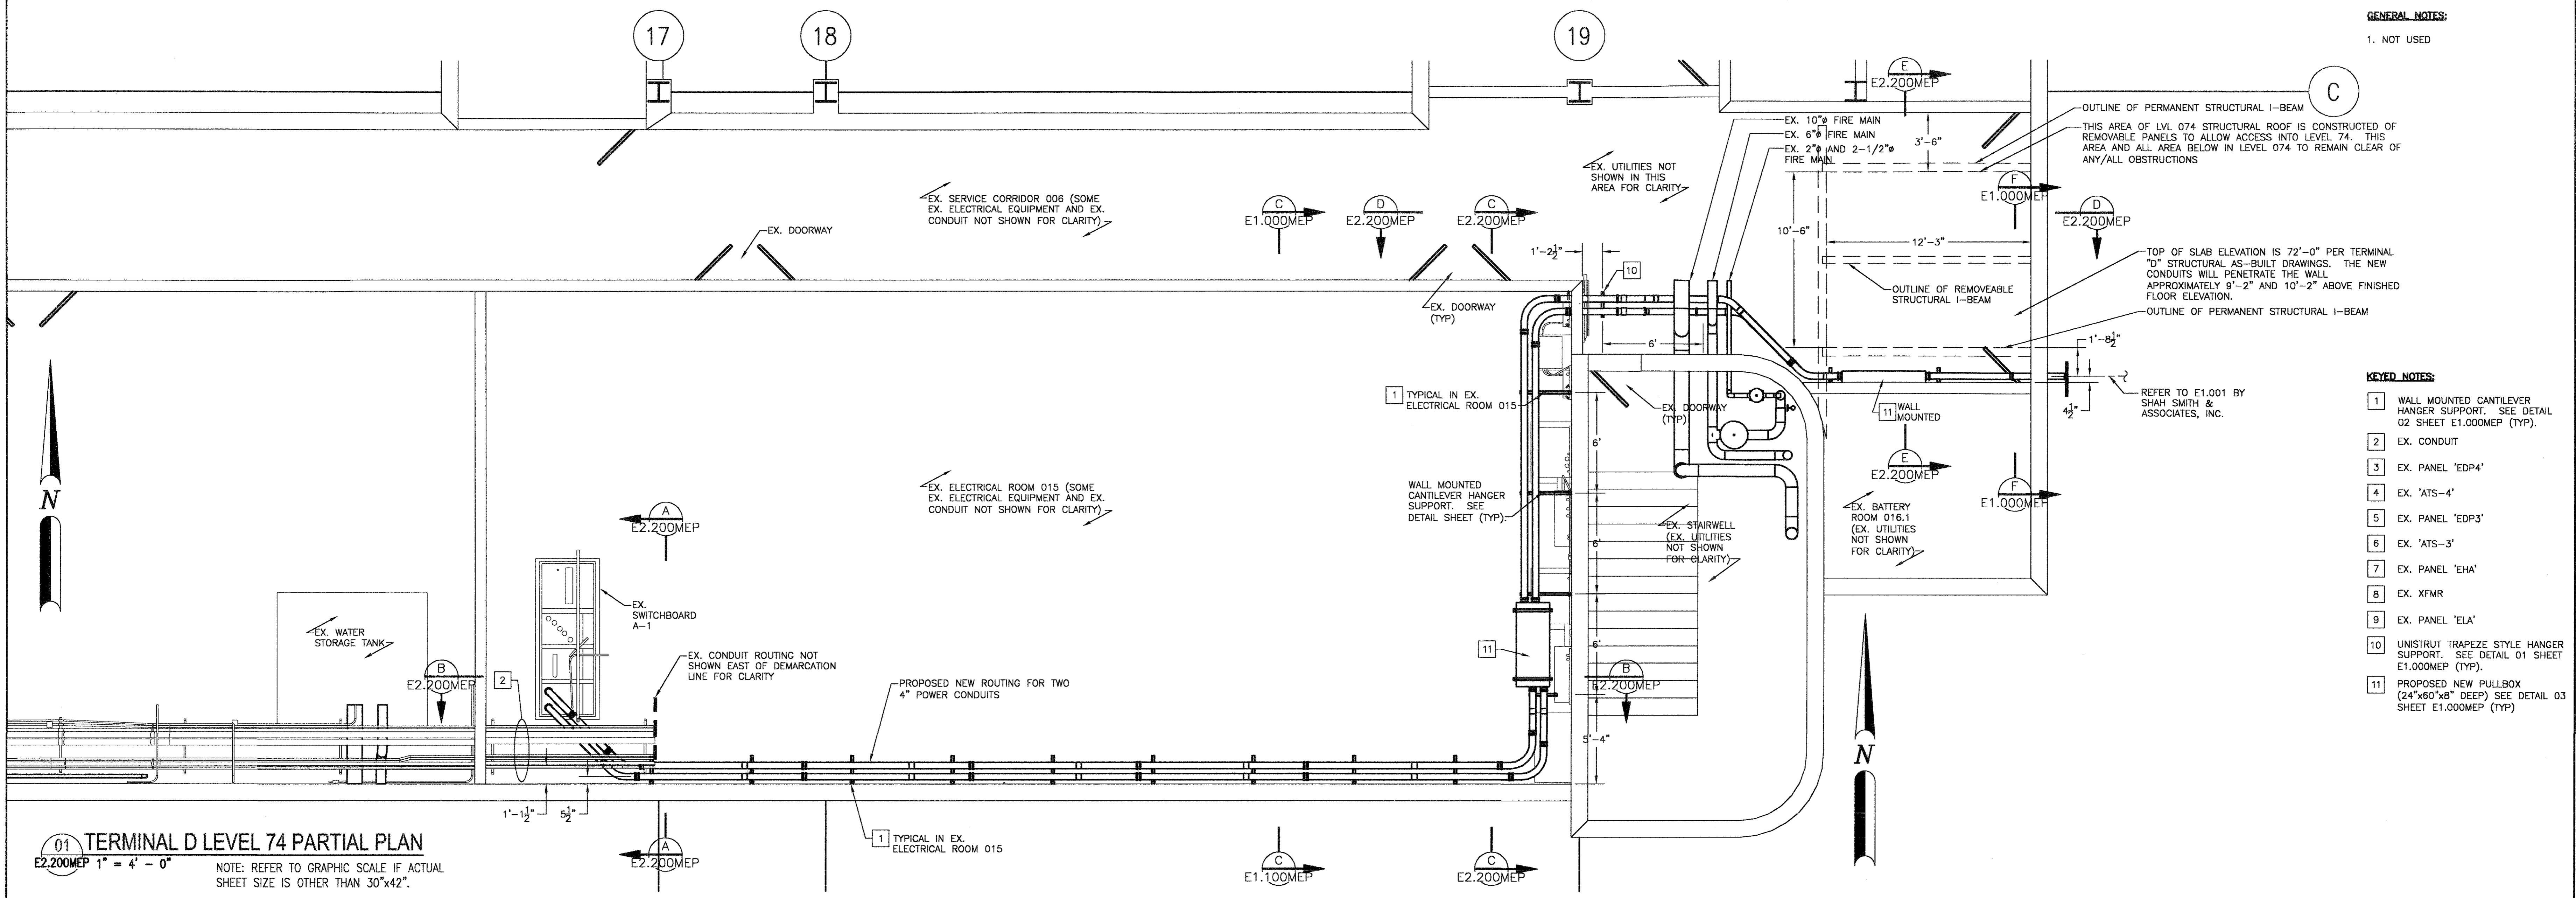


**RECORD DRAWING DO NOT MODIFY**

THE UNDERSIGNED CERTIFIES THE INFORMATION SHOWN ON CLARK CONSTRUCTION GROUP - TEXAS'S "RECORD OF THE WORK", SIGNED BY DAVID BURNS, DATED 03-1-2005, FURNISHED BY CLARK CONSTRUCTION GROUP - TEXAS TO THE CITY OF HOUSTON DEPARTMENT OF AVIATION PDC/CONSTRUCTION DIVISION, IS CORRECTLY INCORPORATED INTO THIS RECORD DRAWING. THE UNDERSIGNED IS NOT RESPONSIBLE FOR CONTENT, ACCURACY OR COMPLETENESS OF CLARK CONSTRUCTION GROUP - TEXAS'S "RECORD OF THE WORK".

L. A. NAMAN + ASSOC., INC. 03.29.05  
 (Name of Design Firm) (Date)  
 WILLIAM HOWE MARSHALL  
 (Printed name and signature of person whose seal appears on Drawings)

**PROJECT MGR:** WHM  
**DESIGNER:** VFS/CDE  
**DRAWN BY:** VFS/CDE  
**CHECKED BY:** VFS/CDE  
**DRAWING STANDARD:**

**SCALE:** AS NOTED  
**DATE:** 02.03.04

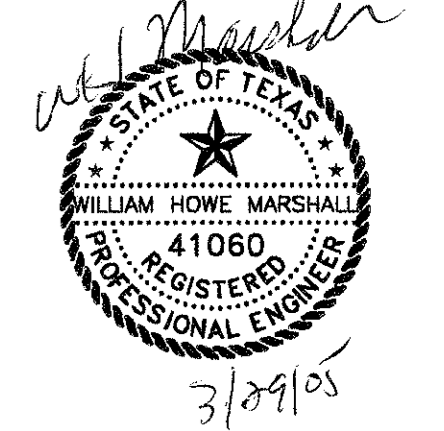

**APPROVED BY:** DATE

**DIRECTOR**  
 HOUSTON AIRPORT SYSTEM

**PROJECT NO.:** 1312

**C.I.P. NO.:** A-0354


**H.A.S. NO.:** 536C

**SHEET NO.:** E2.200MEP

- LEGEND**
- NEW CONDUIT
  - EXISTING PIPING / DUCT / CONDUIT
  - EXISTING PIPING / DUCT / CONDUIT TO BE REMOVED



NO.	DESCRIPTION	DATE	BY
ISSUED FOR BIDDING		10/15/01	
RECEIVED DRAWING		05/06/05	

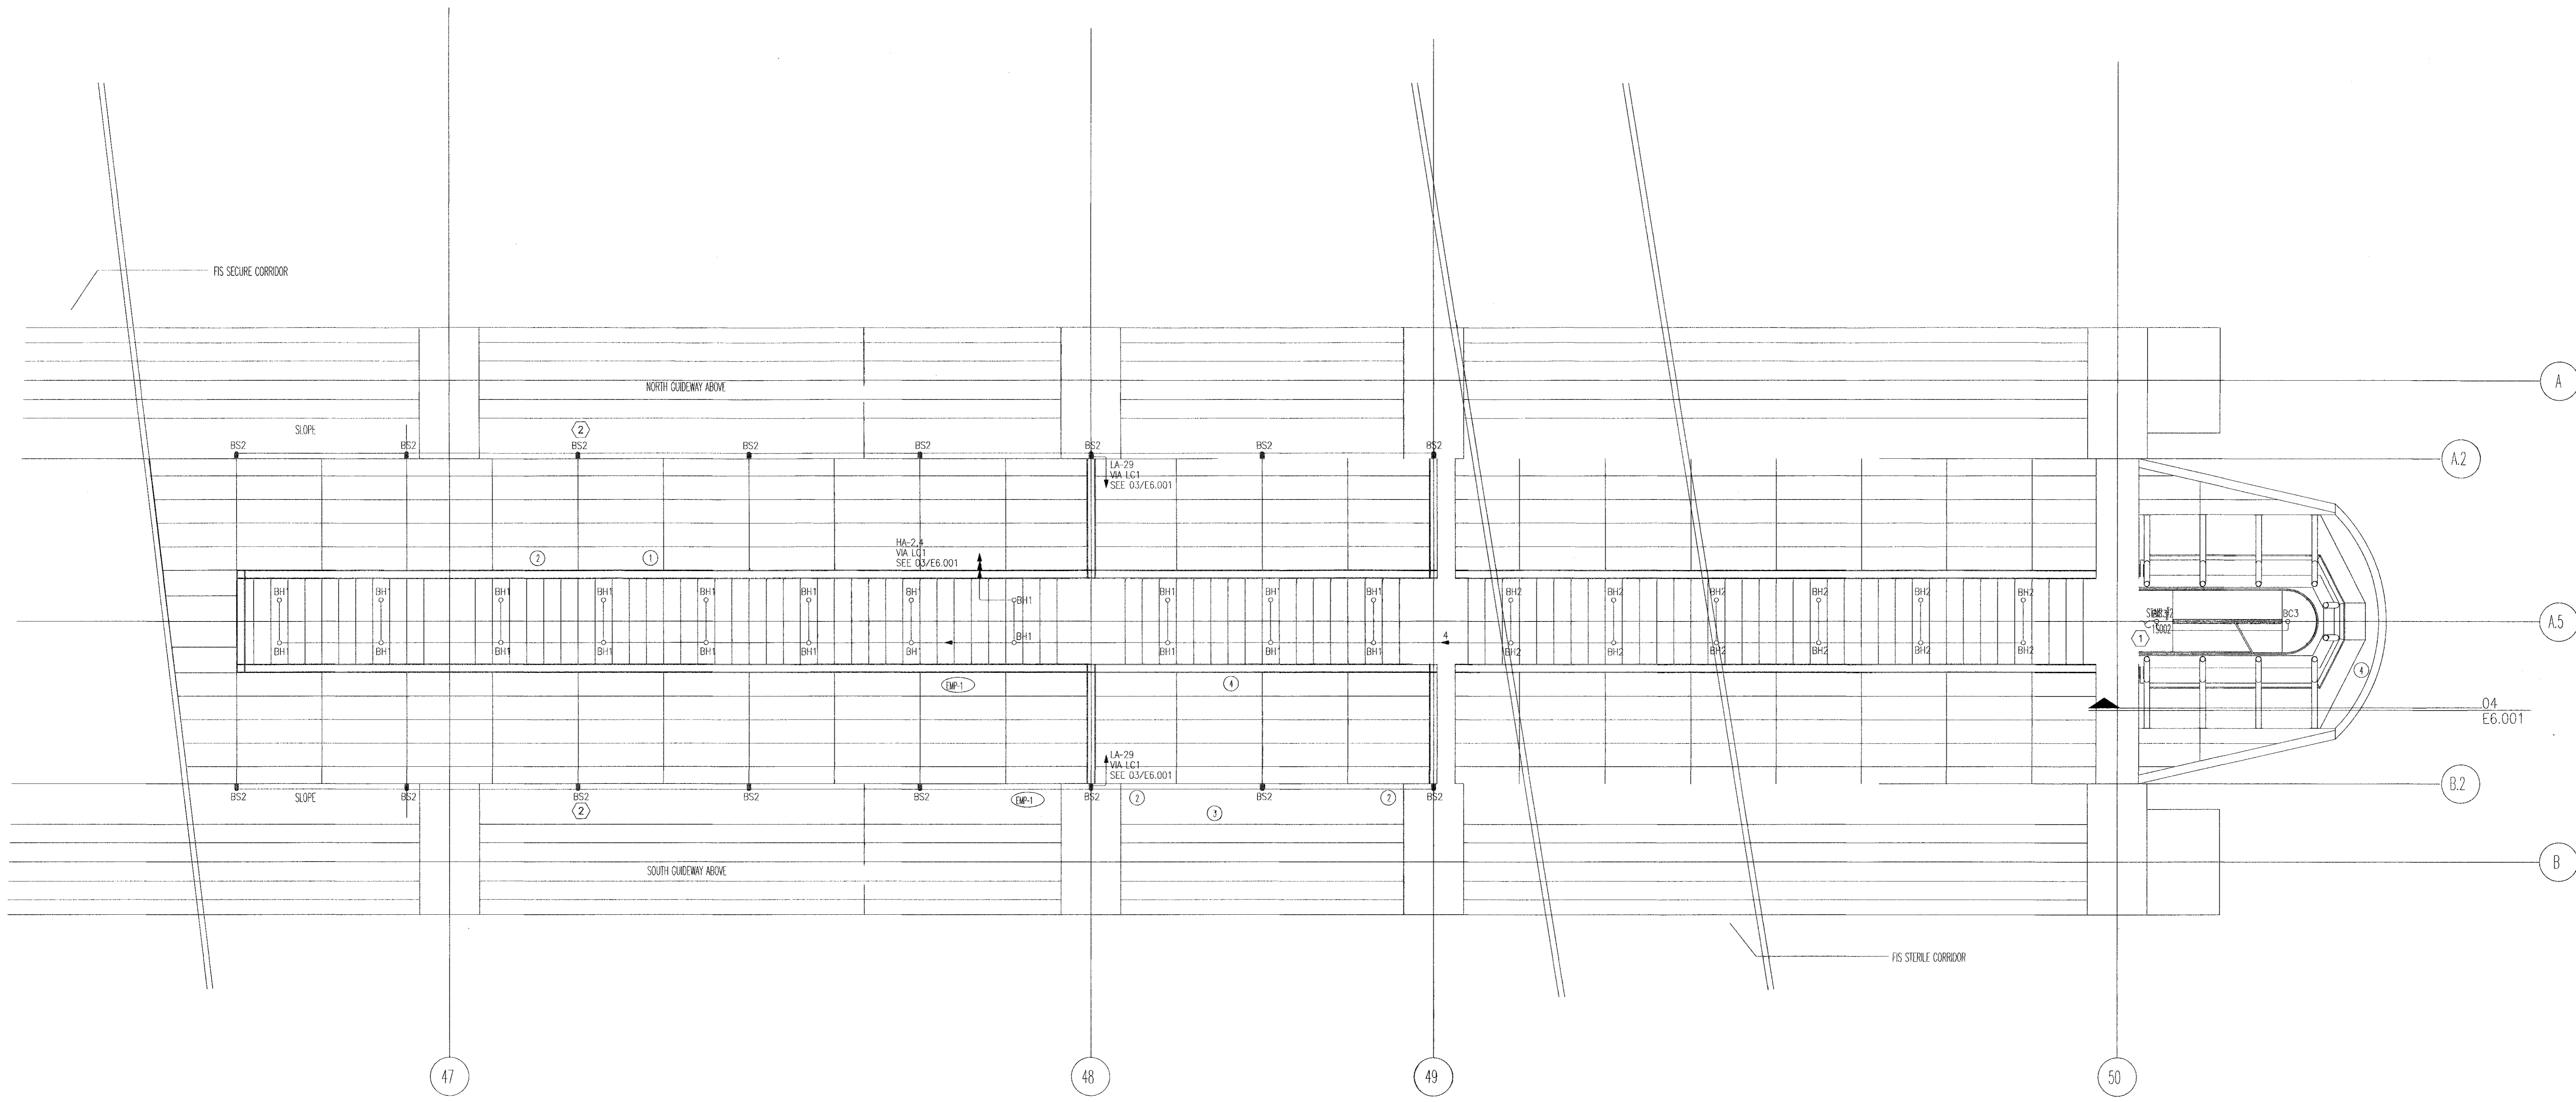



**01** GROUND LEVEL LIGHTING PLAN  
 E3.000 1/8"=1'-0"

INTERNATIONAL SERVICES EXPANSION PROGRAM  
**APM STATION + PLATFORM**  
 GROUND LEVEL - LIGHTING PLAN

**KEYED NOTES:**

- ① CONNECT TO LIGHT FIXTURES ON LANDING ABOVE. SEE DETAIL 04/E6.001.
- ② REFER TO ARCHITECTURAL PLANS FOR LIGHT FIXTURE MOUNTING DETAILS.

**GENERAL NOTES:**

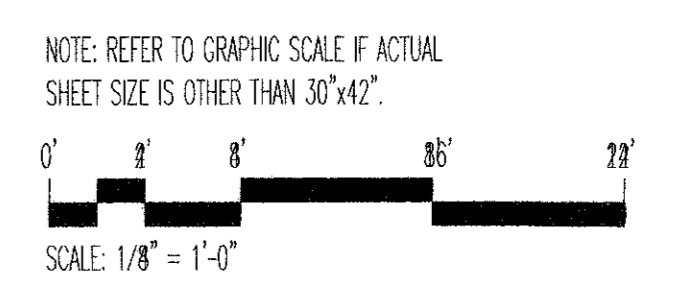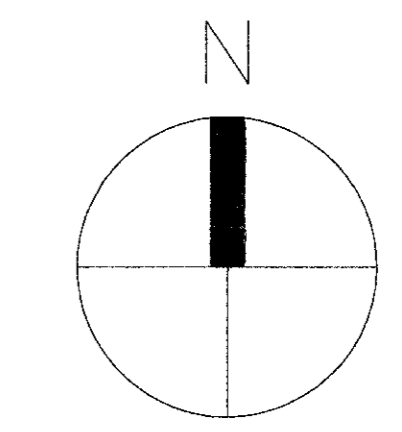

PROJECT MGR:	A.E. BELTRAM
DESIGNER:	D. BELTRAM
DRAWN BY:	D. BELTRAM
CHECKED BY:	A.E. BELTRAM
DRAWING STANDARD:	OSP 07.20.2000
SCALE:	AS NOTED
DATE:	09/14/01


**RECORD DRAWING**  
 THIS DRAWING HAS BEEN RECORDED TO SHOW SIGNIFICANT CHANGES IN THE WORK MADE DURING CONSTRUCTION BASED ON MARKED-UP PRINTS, DRAWINGS AND OTHER DATA.

APPROVED BY:	DATE:
DIRECTOR HOUSTON AIRPORT SYSTEM	
PROJECT NO.:	1061-001
C.I.P. NO.:	A-034
H.A.S. NO.:	S38C
SHEET NO.:	

99 E3.000



NO.	DESCRIPTION	DATE	BY
1	ISSUED FOR BID	08/19/01	
2	RECEIVED DRAWING	05/06/05	


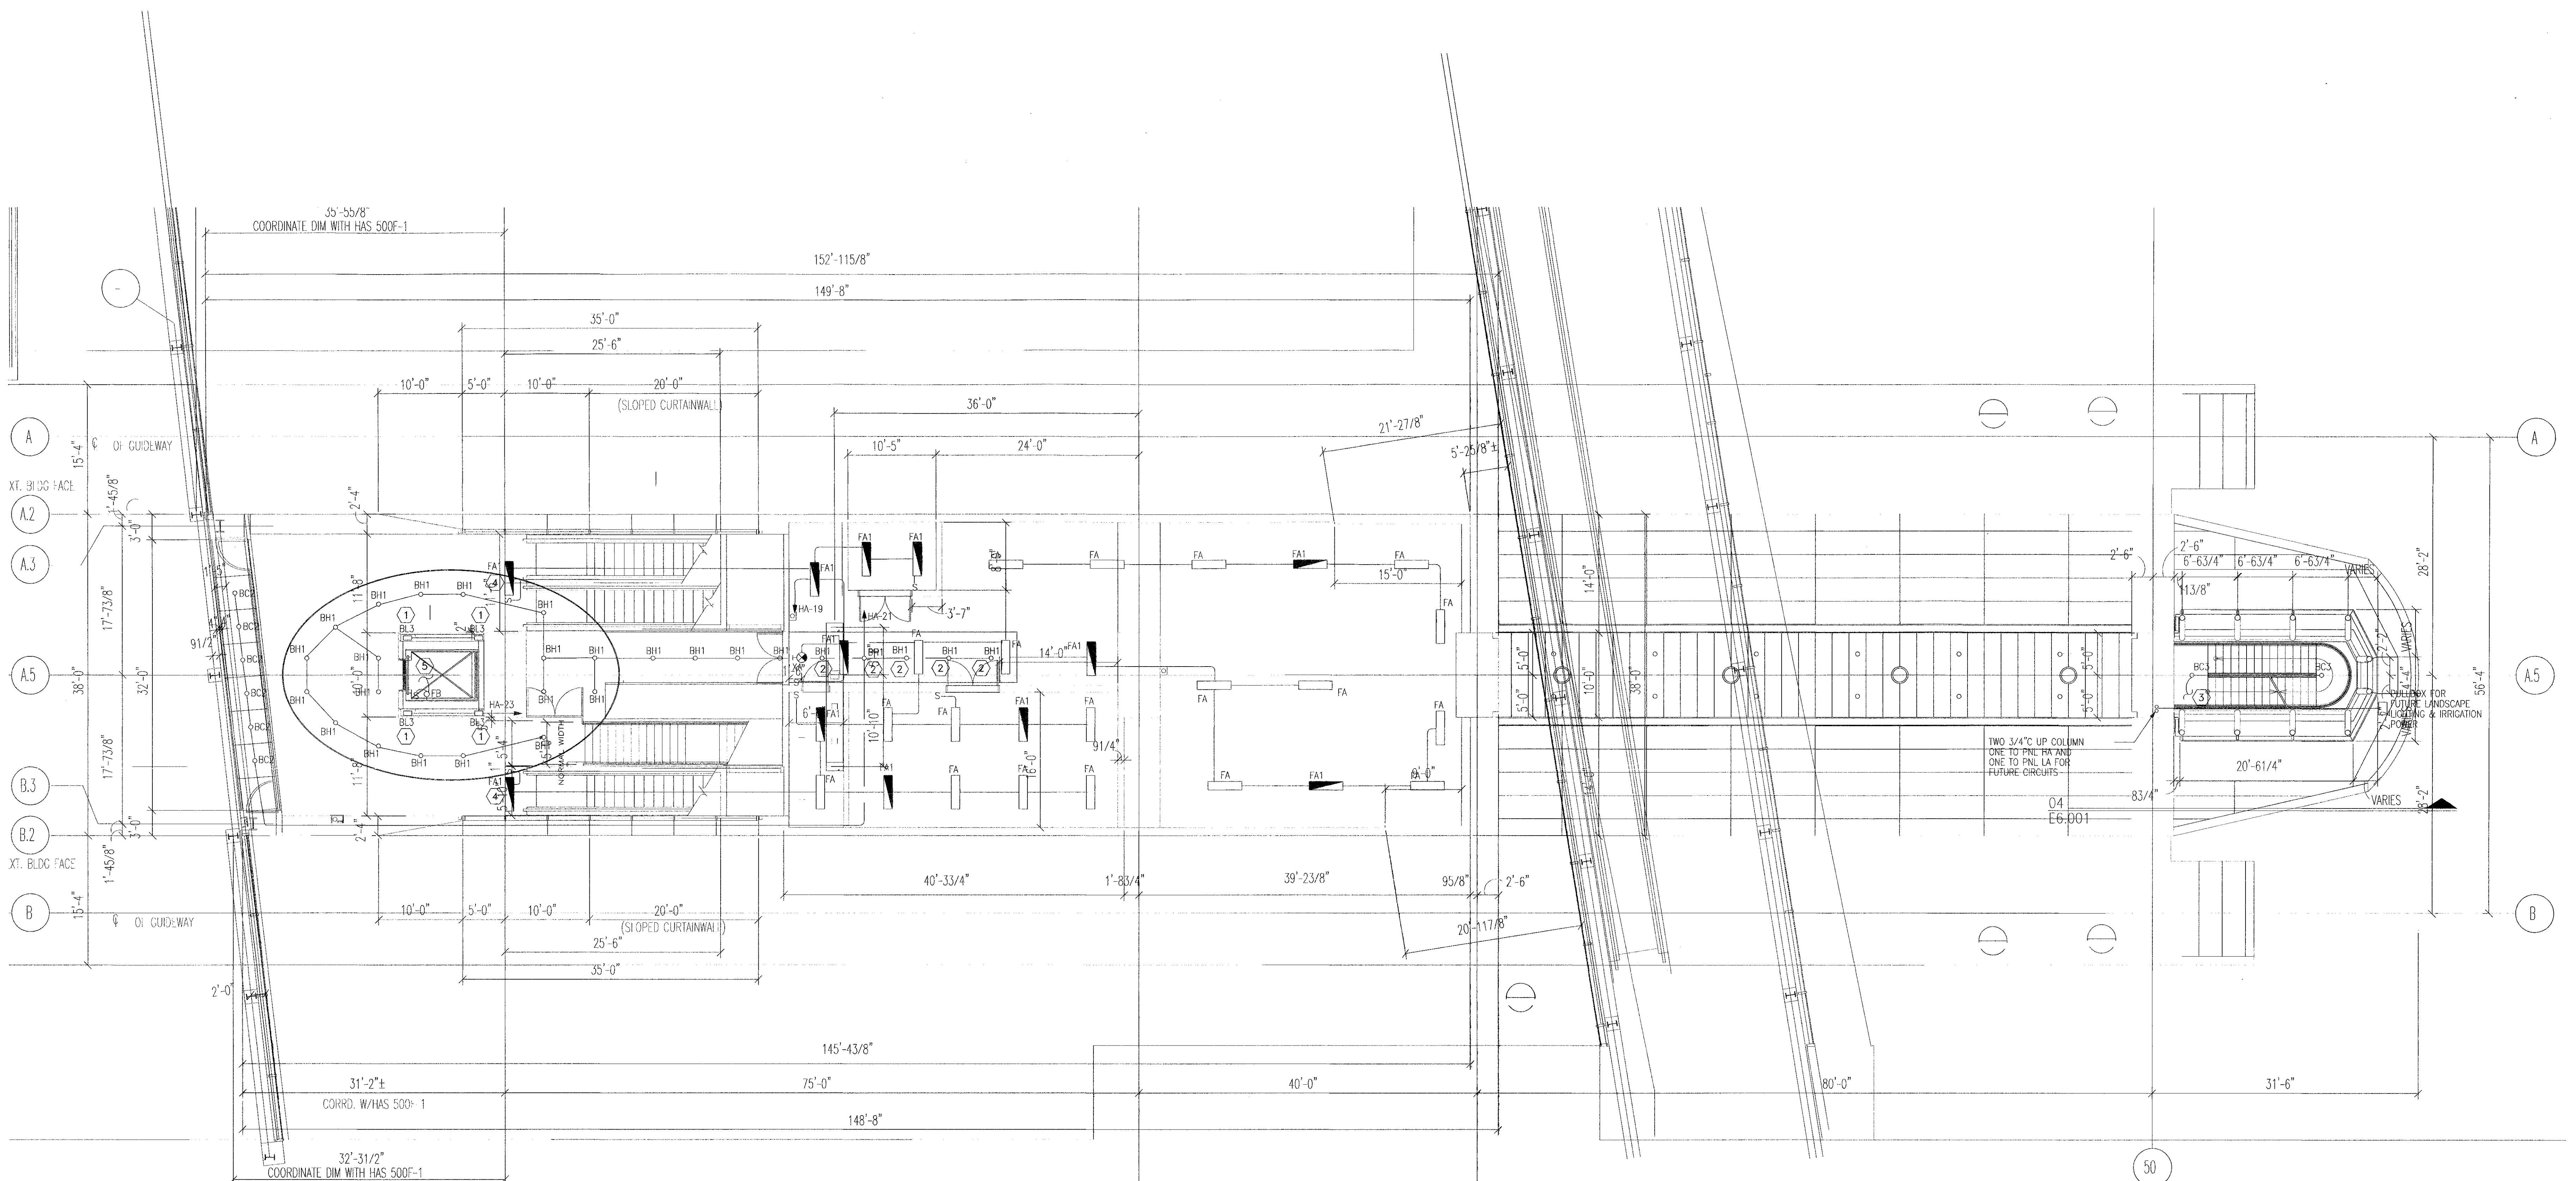


**01 LOBBY LIGHTING PLAN**  
 E3.001 1/2"=1'-0"

**KEYED NOTES:**

- 1 LIGHTS ARE MOUNTED IN ELEVATOR SIDELIGHTING GLASS FOR ENTIRE LENGTH. SEE ARCHITECTURAL PLANS.
- 2 THIS FIXTURE IS LOCATED IN CEILING ABOVE. SEE ARCHITECTURAL PLANS.
- 3 CONNECT TO LIGHT FIXTURES ON LANDING ABOVE AND BELOW. SEE DETAIL 04/E6.001.
- 4 LIGHT FIXTURE AND SWITCH LOCATED BELOW IN ESCALATOR EQUIPMENT ROOM. COORDINATE EXACT LOCATION OF FIXTURE AND SWITCH WITH ESCALATOR INSTALLER.
- 5 CONNECT TO LINE SIDE OF RECEPTACLE CIRCUIT IN ELEVATOR PIT. SEE SHEET E2.000.

**GENERAL NOTES:**

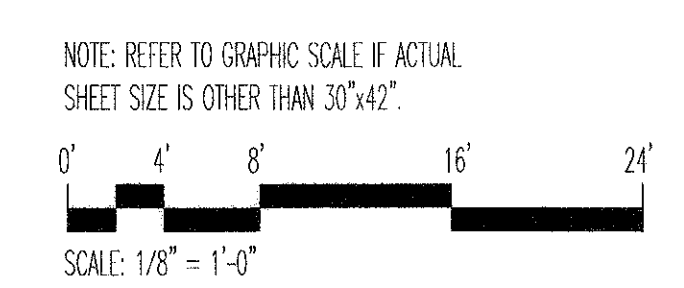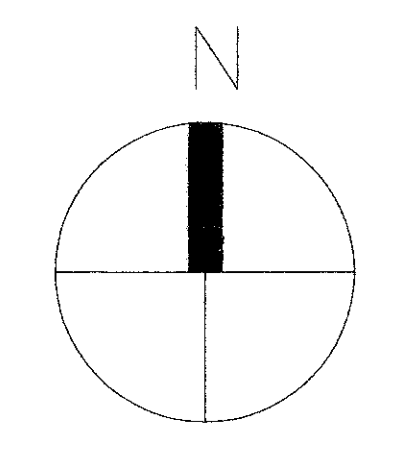

INTERNATIONAL SERVICES EXPANSION PROGRAM  
**APM STATION + PLATFORM**  
 LOBBY - LIGHTING PLAN

PROJECT MGR: A.E.BELTRAN  
 DESIGNER: D.BUSJIS  
 DRAWN BY: D.BUSJIS  
 CHECKED BY: A.E.BELTRAN  
 DRAWING STANDARD: SEP 07.20.2000  
 SCALE: AS NOTED  
 DATE: 09/14/01


**RECORD DRAWING**  
 THIS DRAWING HAS BEEN REVISED TO SHOW SIGNIFICANT CHANGES IN THE WORK MADE DURING CONSTRUCTION BASED ON MARKED-UP PRINTS, DRAWINGS AND OTHER DATA.

APPROVED BY: \_\_\_\_\_ DATE: \_\_\_\_\_  
 DIRECTOR  
 HOUSTON AIRPORT SYSTEM

PROJECT NO. 1061-001  
 C.I.P. NO. 4-0354  
 H.A.S. NO. 5382  
 SHEET NO. 100 E3.001



REVISIONS		
NO.	DESCRIPTION	DATE
1	ISSUED FOR BID	10/19/01
2	RECEIVED DRAWING	05/06/02


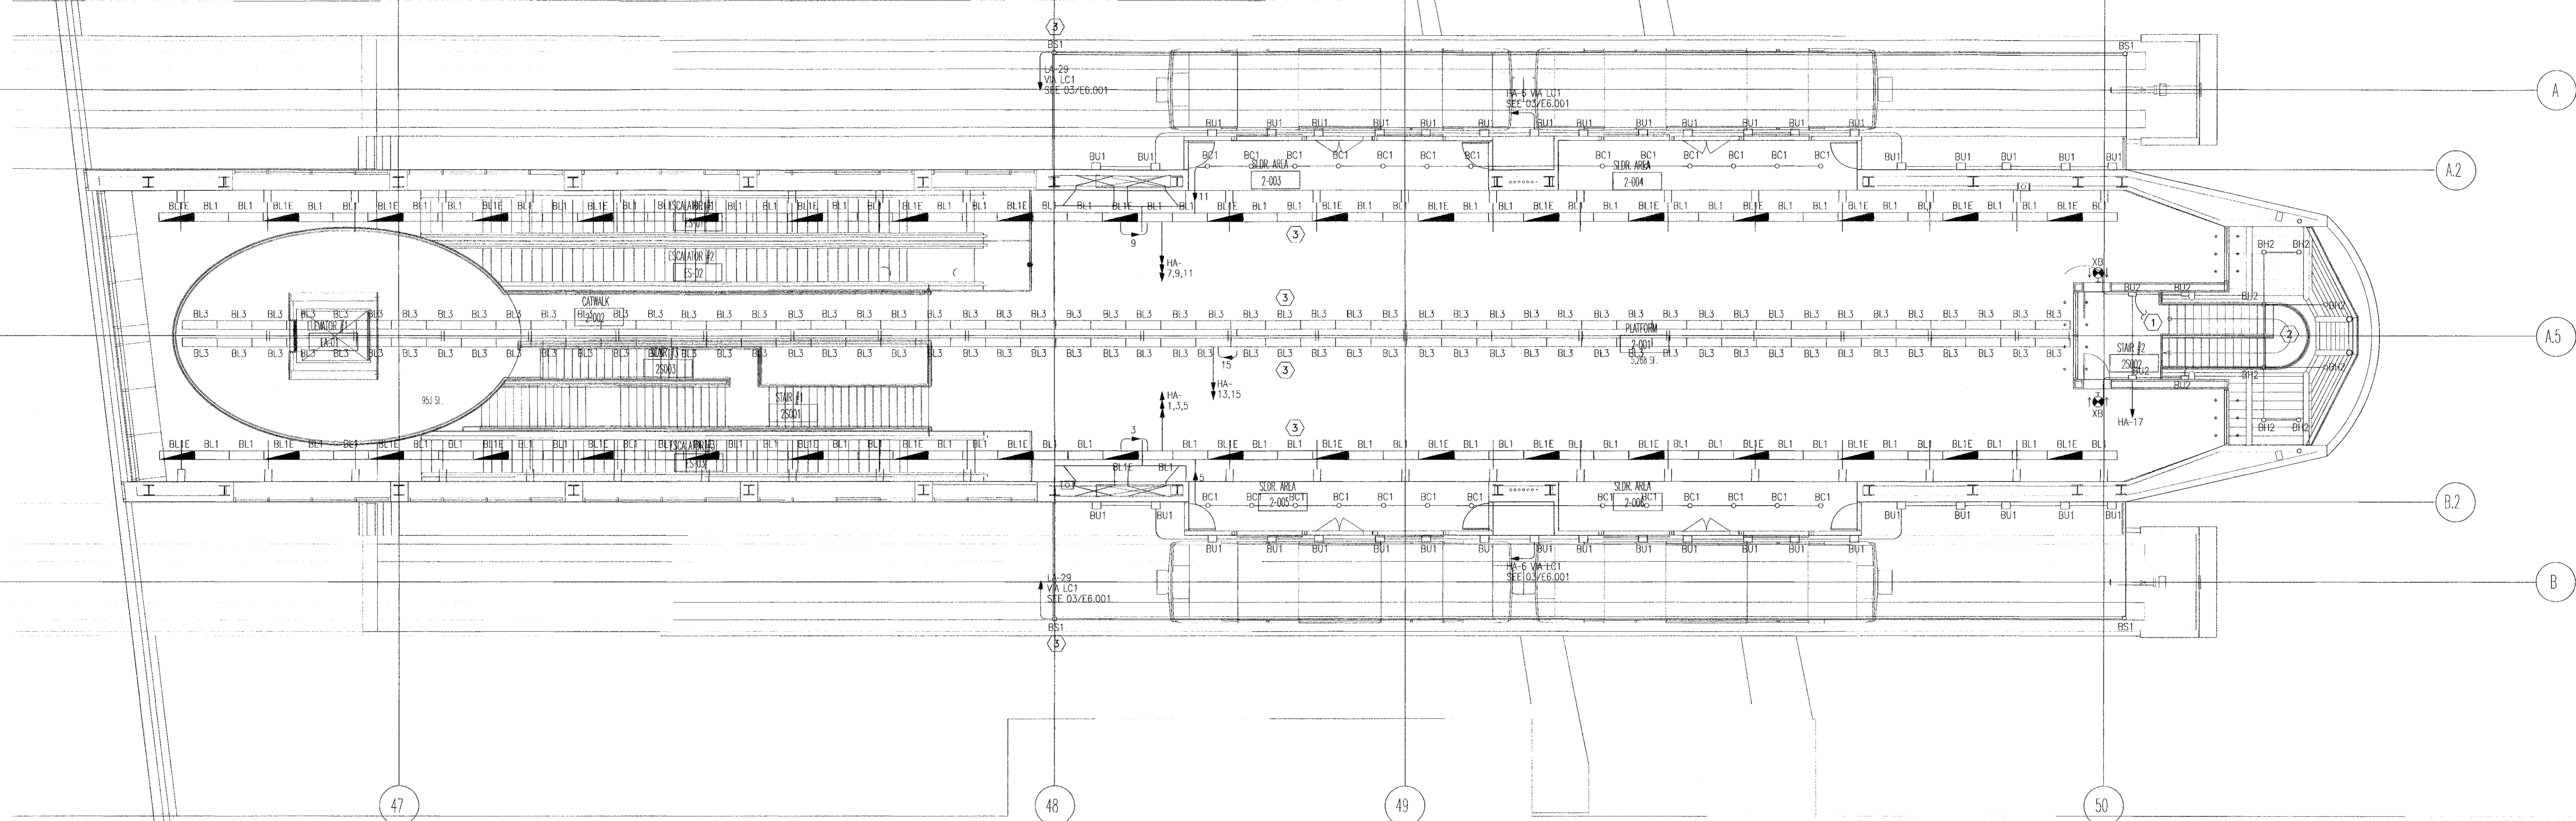


01 PLATFORM LIGHTING PLAN  
 E3.002 1/8"=1'-0"

KEYED NOTES:

- 1 CONNECT TO FIXTURES IN STAIRWELL BELOW.
- 2 CONDUIT SHALL BE INSTALLED IN CONCRETE STRUCTURE. NO EXPOSED CONDUIT IN STAIRWELL.
- 3 SEE ARCHITECTURAL PLANS FOR LIGHT FIXTURE MOUNTING DETAILS, TYPICAL.

GENERAL NOTES:

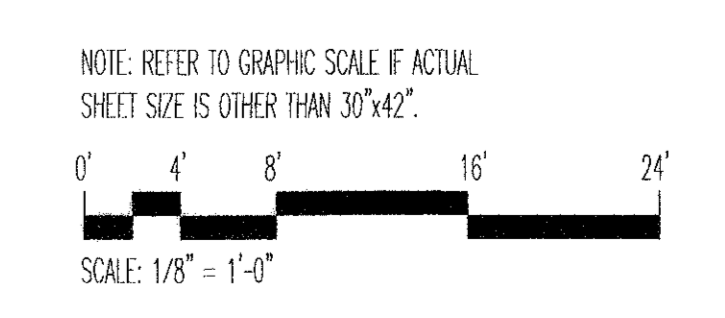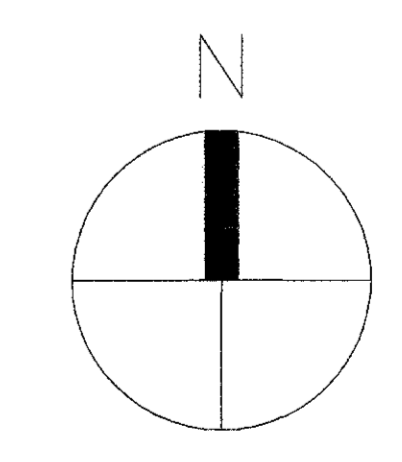

INTERNATIONAL SERVICES EXPANSION PROGRAM  
**APM STATION + PLATFORM**  
 PLATFORM - LIGHTING PLAN

PROJECT MGR:	A.E. BELTRAN
DESIGNER:	D. BILISLE
DRAWN BY:	D. BILISLE
CHECKED BY:	A.E. BELTRAN
DRAWING STANDARD:	SEP 07.20.2000
SCALE:	AS NOTED
DATE:	09/14/01

**RECORD DRAWING**  
 THIS DRAWING HAS BEEN REVISIONED TO SHOW SIGNIFICANT CHANGES IN THE WORK MADE DURING CONSTRUCTION BASED ON MARKED-UP PRINTS, DRAWINGS AND OTHER DATA.

APPROVED BY:	DATE:
DIRECTOR	HOUSTON AIRPORT SYSTEM
PROJECT NO.	1081-001
C.I.P. NO.	A-0354
H.A.S. NO.	5396
SHEET NO.	

E3.002












NO.	DESCRIPTION	DATE	BY
1	ISSUED FOR BID	10/19/01	
2	BULLETIN FOR 4-17-2003 DBB		
3	BULLETIN FOR 07-01-2003 DBB		
4	BULLETIN FOR 01-20-2005 DBB		
	RECORD DRAWING	09/26/05	

INTERNATIONAL SERVICES EXPANSION PROGRAM  
 APM STATION + PLATFORM  
 ONE LINE DIAGRAM

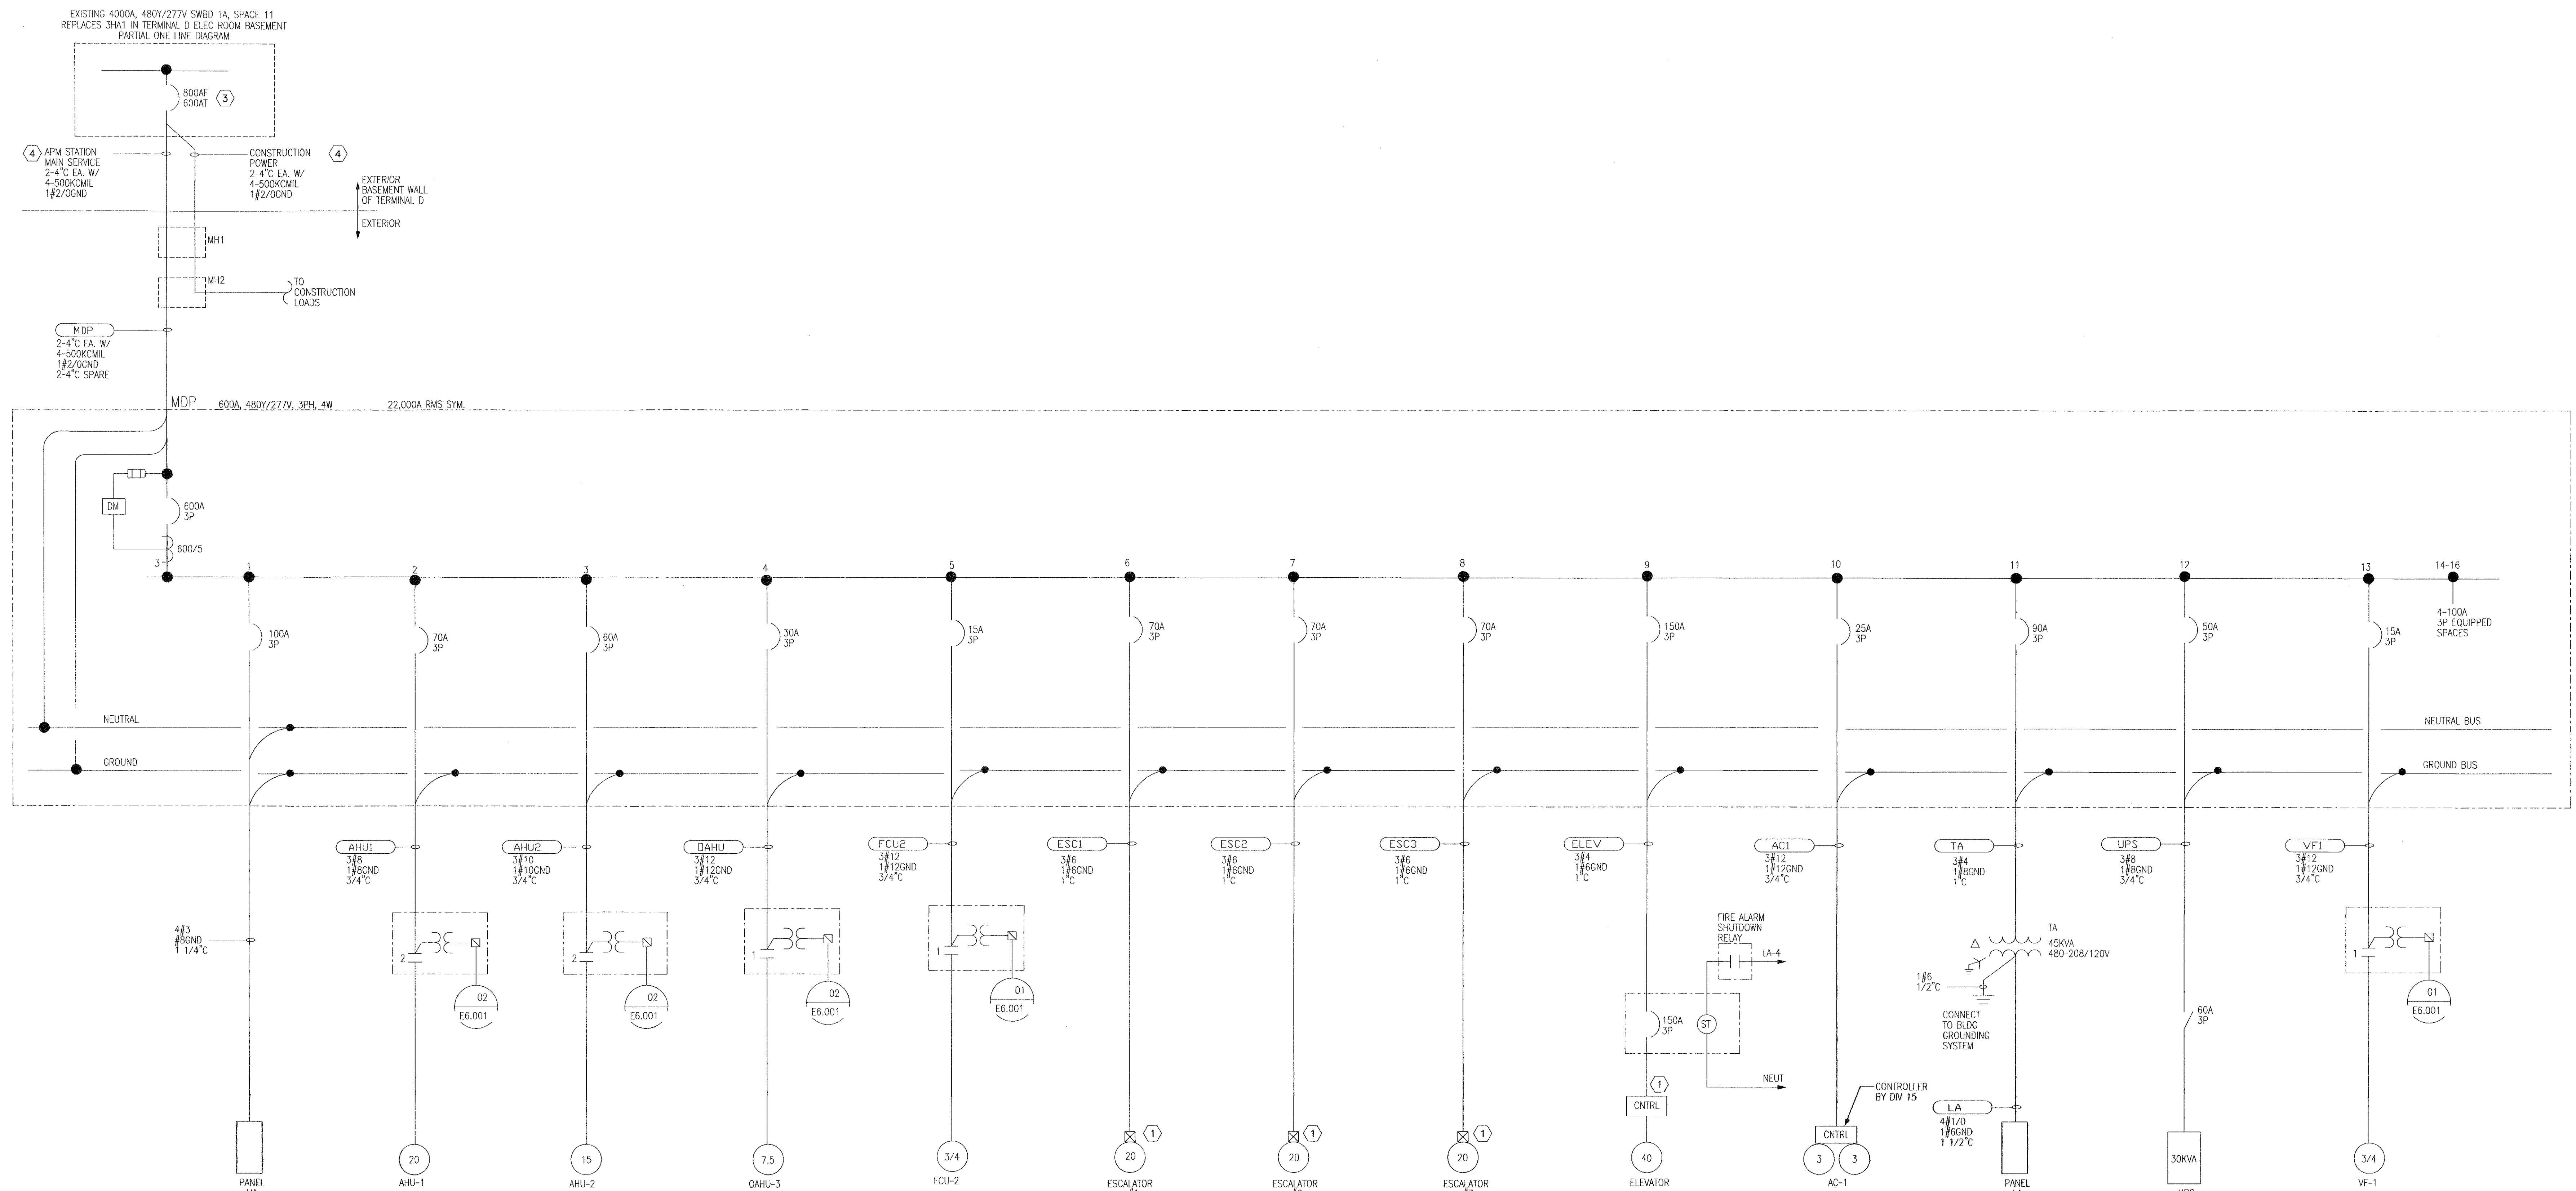

PANEL:	LA	VOLTAGE:	208/120V	3PH	4W	AIC:	10,000KA	RMS SYM	REMARKS:
ROOM NO:	ELECTRICAL / MECHANICAL	BUS:	225A	<input type="checkbox"/> MLO	<input type="checkbox"/> MCB	<input type="checkbox"/> SURFACE	<input type="checkbox"/> FLUSH		
		LUGS:	<input type="checkbox"/> SUB-FEED	<input type="checkbox"/> FEED-THRU	<input type="checkbox"/> NEMA 1	<input type="checkbox"/> NEMA 3R			
ALL BREAKERS 20A UNLESS OTHERWISE NOTED									
WIRE&CONDUIT	VA	LOAD DESCRIPTION	150 A	LOAD DESCRIPTION	VA	WIRE&CONDUIT			
2#12, #12G, 3/4"C	600	DDC PNL RM 1-004	1	FCU-1	350	2#12, #12G, 3/4"C			
2#12, #12G, 3/4"C	600	DDC PNL RM 1-004	3	ELEV SHUNT TRIP CONTROL POWER	100	2#12, #12G, 3/4"C			
2#12, #12G, 3/4"C	600	DDC PNL RM 1-004	5	R-ELEVATOR MACHINE RM	400	2#12, #12G, 3/4"C			
2#12, #12G, 3/4"C	100	CONTROL POWER LCT RM 1-0003	7	ELEVATOR LTS AND RCPTS	600	2#12, #12G, 3/4"C			
2#12, #12G, 3/4"C	720	R-RM 001.2	9	SF-1-STAIRWELL	696	2#12, #12G, 3/4"C			
2#12, #12G, 3/4"C	900	R-RM 0001.2.3	11	SF-2-STAIRWELL	696	2#12, #12G, 3/4"C			
2#12, #12G, 3/4"C	720	FIRE ALARM PANEL RM 1-0003	13	R & LIGHT-ELEVATOR PIT	200	2#12, #12G, 3/4"C			
2#12, #12G, 3/4"C	540	R-RM 2-001	15	SPARE					
2#12, #12G, 3/4"C	540	R-RM 2-001	17	SPARE					
2#10, #10G, 3/4"C	864	AIR COMPRESSOR-MECH RM	19	SPARE					
2#12, #12G, 3/4"C	600	HEAT TRACE	21	SPARE					
2#12, #12G, 3/4"C	696	RCPT FOR SP-1 ELEV MACH RM	23	SPARE					
2#12, #12G, 3/4"C	200	RCPT FOR ELEV HIGH LIQUID ALARM-ELEV MACH RM	25	SPARE					
2#12, #12G, 3/4"C	600	R-AIR DRYER-MECH RM	27	SPARE					
2#12, #12G, 3/4"C	400	L- SAFETY LIGHT & LED LIGHT	29	SPARE					
2#12, #12G, 3/4"C	600	R-COMM-MECH RM	31	SPARE					
2#12, #12G, 3/4"C	100	VALVE-MECH RM	33	SPARE					
2#12, #12G, 3/4"C	800	R-ESCALATOR MACH RM	35	SPARE					
2#10, #10G, 3/4"C	1200	FIRE DOOR	37	SPARE					
2#12, #12G, 3/4"C	360	R-SECURITY RM	39	SPARE					
2#12, #12G, 3/4"C	360	R-SECURITY RM	41	SPARE					

13,022 KVA CONNECTED 13,022 KVA DEMAND

PANEL:	HA	VOLTAGE:	480Y/277V	3PH	4W	AIC:	22,000A	RMS SYM	REMARKS:
ROOM NO:	ELECTRICAL / MECHANICAL	BUS:	225A	<input type="checkbox"/> MLO	<input type="checkbox"/> MCB	<input type="checkbox"/> SURFACE	<input type="checkbox"/> FLUSH		
		LUGS:	<input type="checkbox"/> SUB-FEED	<input type="checkbox"/> FEED-THRU	<input type="checkbox"/> NEMA 1	<input type="checkbox"/> NEMA 3R			
ALL BREAKERS 20A UNLESS OTHERWISE NOTED									
WIRE&CONDUIT	KVA	LOAD DESCRIPTION	225A M/G	LOAD DESCRIPTION	KVA	WIRE&CONDUIT			
2#12, #12G, 3/4"C	1960	L-RM 2-001	1	L-EXTERIOR	1870	2#12, #12G, 3/4"C			
2#12, #12G, 3/4"C	1960	L-RM 2-001	3	L-EXTERIOR	2160	2#12, #12G, 3/4"C			
2#12, #12G, 3/4"C	520	L-RM 2-001	5	L-EXTERIOR	1800	2#12, #12G, 3/4"C			
2#12, #12G, 3/4"C	1960	L-RM 2-001	7	SPARE					
2#12, #12G, 3/4"C	1960	L-RM 2-001	9	SPARE					
2#12, #12G, 3/4"C	520	L-RM 2-001	11	SPARE					
2#12, #12G, 3/4"C	1728	L-RM 2-001	13	SPARE					
2#12, #12G, 3/4"C	1728	L-RM 2-001	15	SPARE					
2#12, #12G, 3/4"C	1600	L-STAR #2	17	SPARE					
2#12, #12G, 3/4"C	2070	L-MECH-ELEV-EQUIP RM	19	SPARE					
2#12, #12G, 3/4"C	2600	L-CATWALK/LOBBY	21	SPARE					
2#12, #12G, 3/4"C	200	L-ELEV GLASS	23	SPARE					
4#8, #8G, 1"C	3000	L-GUIDEWAY	25	SPARE					
			27	SPARE					
			29	SPARE					
			31	SPACE					
			33	SPACE					
			35	SPACE					
			37	SPACE					
			39	SPACE					
			41	SPACE					

27,436 KVA CONNECTED 34,295 KVA DEMAND

GENERAL NOTES

A REFERENCE SHEETS E1.000 MEP AND E2.200 MEP UNDER PROJECT 536A-1 FOR SITE PLAN AND EXISTING LOCATION FOR SWITCHGEAR IN TERMINAL D.

KEYED NOTES

- (1) MOTOR CONTROLLER BY EQUIPMENT VENDOR.
- (2) THIS CIRCUIT WILL BE CONNECTED UNDER PROJECT 536A-1, APM GALLERY EXTENSION. CIRCUIT BREAKER IS PROVIDED UNDER THIS CONTRACT.
- (3) PROVIDE NEW G.E. POWER BREAK 1 800A FRAME BREAKER WITH 600A TRIP RATING, MVT TRIP UNIT, LSIG2Z TRIP FUNCTIONS STATIONARY MOUNTED WITH ALL REQUIRED ACCESSORIES TO MOUNT IN EXISTING SWITCHBOARD SPACE. BREAKER SHALL BE STANDARD BREAK DESIGN SUITABLE FOR 65KA AT 480V. FURNISH LUGS AS INDICATED ON THE DRAWINGS AND A NEUTRAL GROUND SENSOR. CONNECT THE CONTROL WIRING AS REQUIRED FOR THE ZONE INTERLOCK MODULE.
- (4) CONDUIT FROM EXTERIOR WALL OF TERMINAL D TO SWITCHBOARD IS PROVIDED UNDER CONTRACT 536C. BETWEEN NEW MANHOLES MH1 AND MH2 A SECTION OF THE DUCTBANK IS EXISTING. ALL OTHER CONDUIT IS PROVIDED UNDER THIS PROJECT. ALL CONDUITS ARE PROVIDED UNDER THIS PROJECT. SEE ESITE FOR ROUTING.

PROJECT MGR:	AJ.BELTRAN
DESIGNER:	D.BEJLE
DRAWN BY:	D.BEJLE
CHECKED BY:	AJ.BELTRAN
DRAWING STANDARD:	
DATE:	SEP 07 20 2000
SCALE:	AS NOTED
DATE:	09/14/01


**RECORD DRAWING**  
 THIS DRAWING HAS BEEN REVISED TO SHOW SIGNIFICANT CHANGES IN THE WORK MADE DURING CONSTRUCTION BASED ON MARKED-UP PRINTS, DRAWINGS AND OTHER DATA.

APPROVED BY:	DATE:
PROJECT NO:	1061-001
C.I.P. NO:	A-034
H.A.S. NO:	536C
SHEET NO:	E6.000









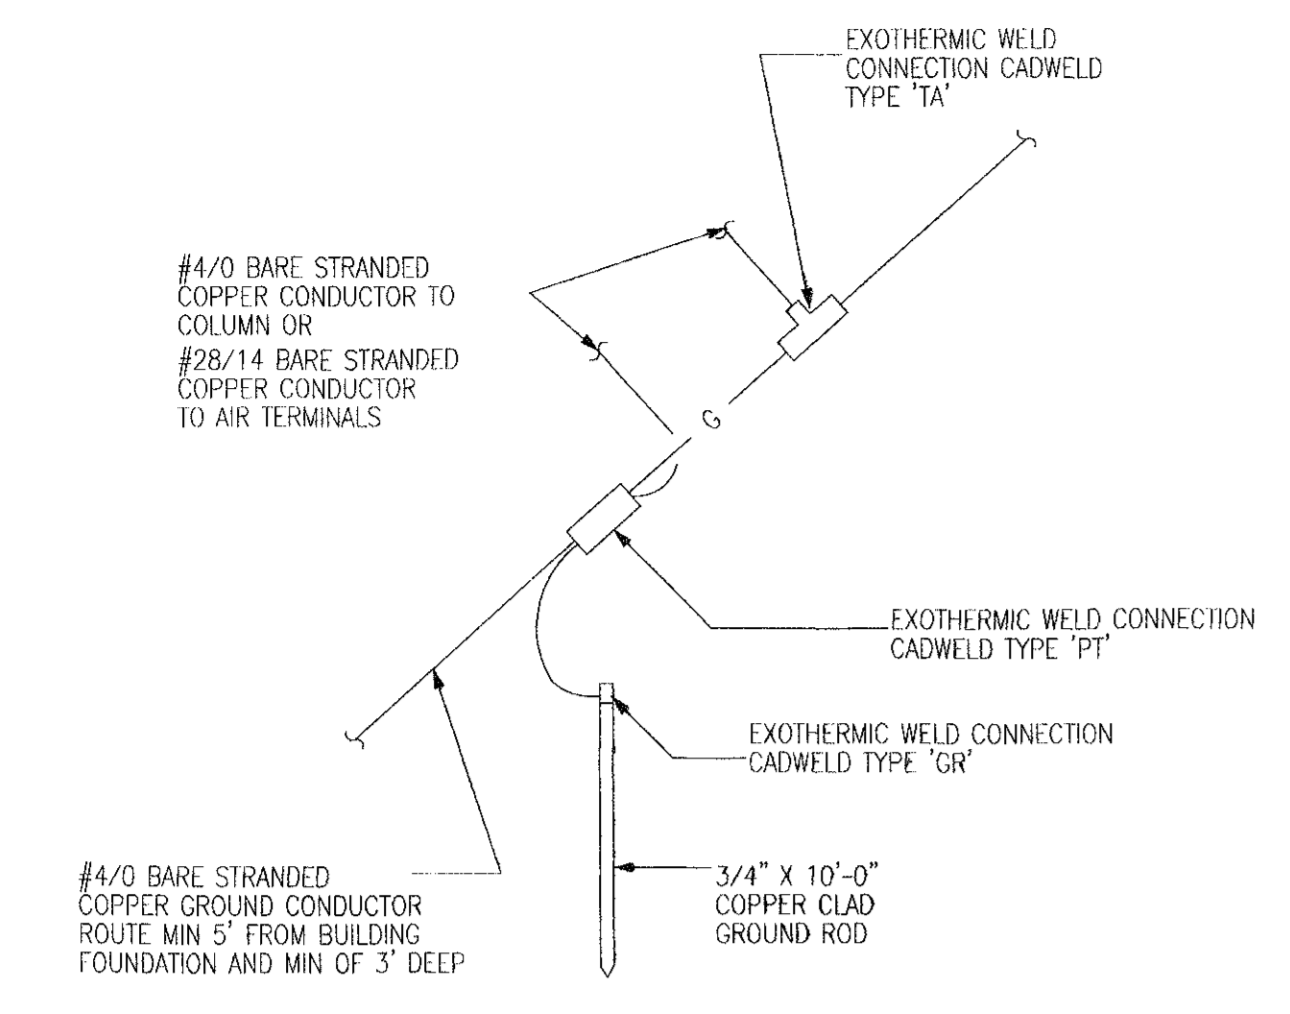


01 GROUND COUNTERPOISE DETAIL  
 E7.000 NTS

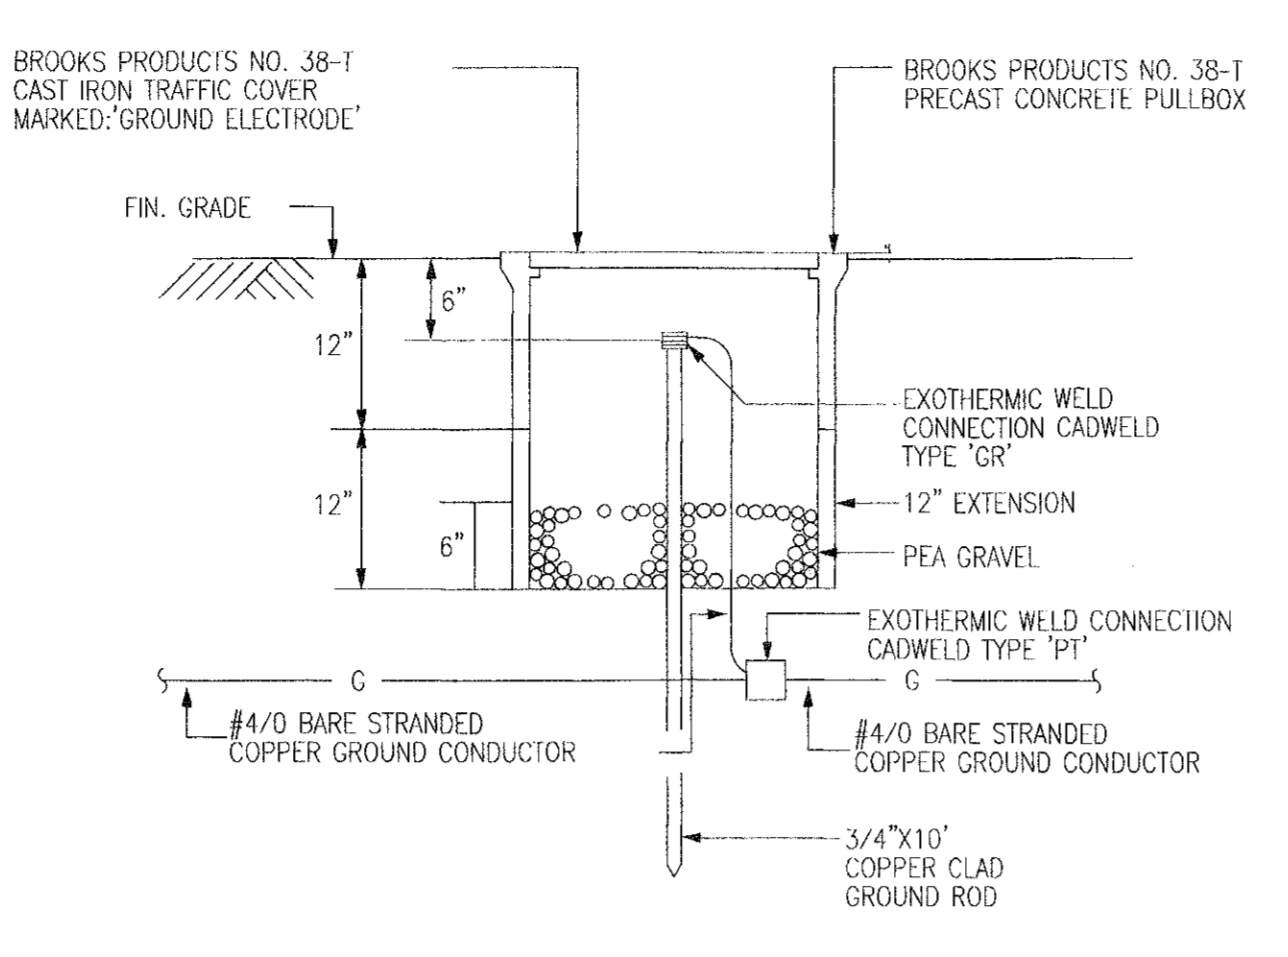


02 GROUND SYSTEM TEST WELL  
 E7.000 NTS

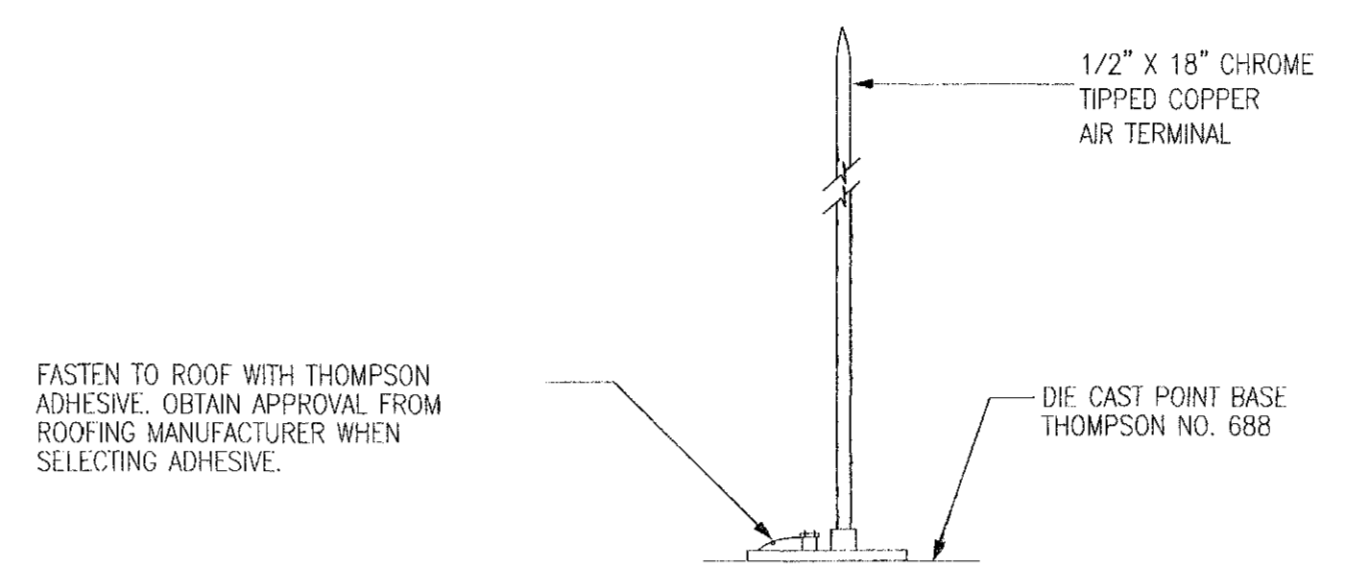


03 FLAT ROOF MOUNTED AIR TERMINAL DETAIL  
 E7.000 NTS

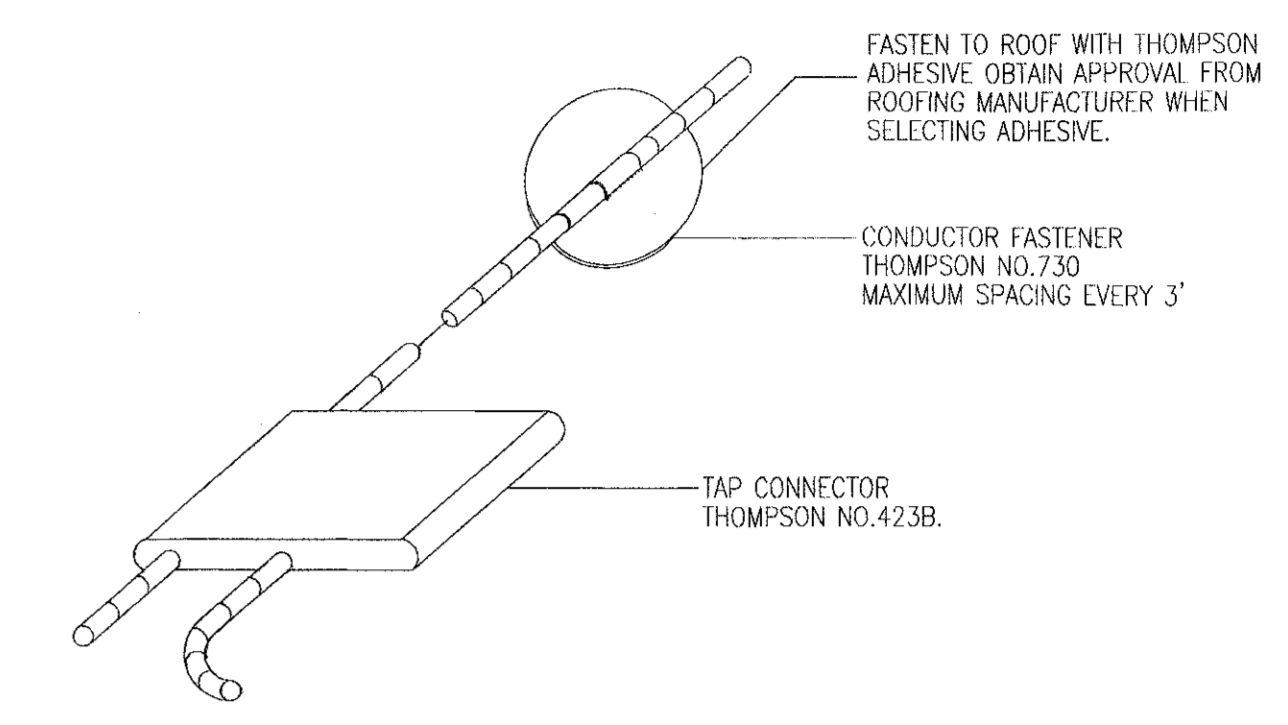


04 ROOF CABLE INSTALLATION DETAIL  
 E7.000 NTS

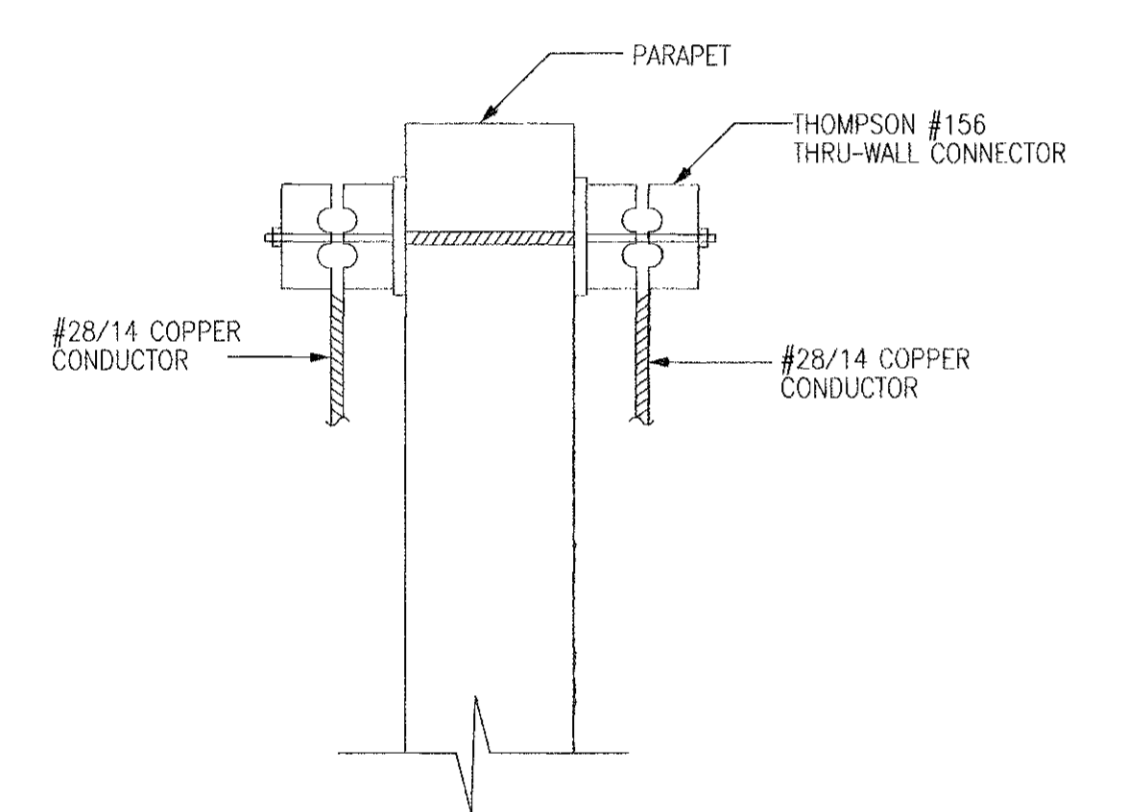

05 THROUGH WALL CONNECTOR DETAIL  
 E7.000 NTS

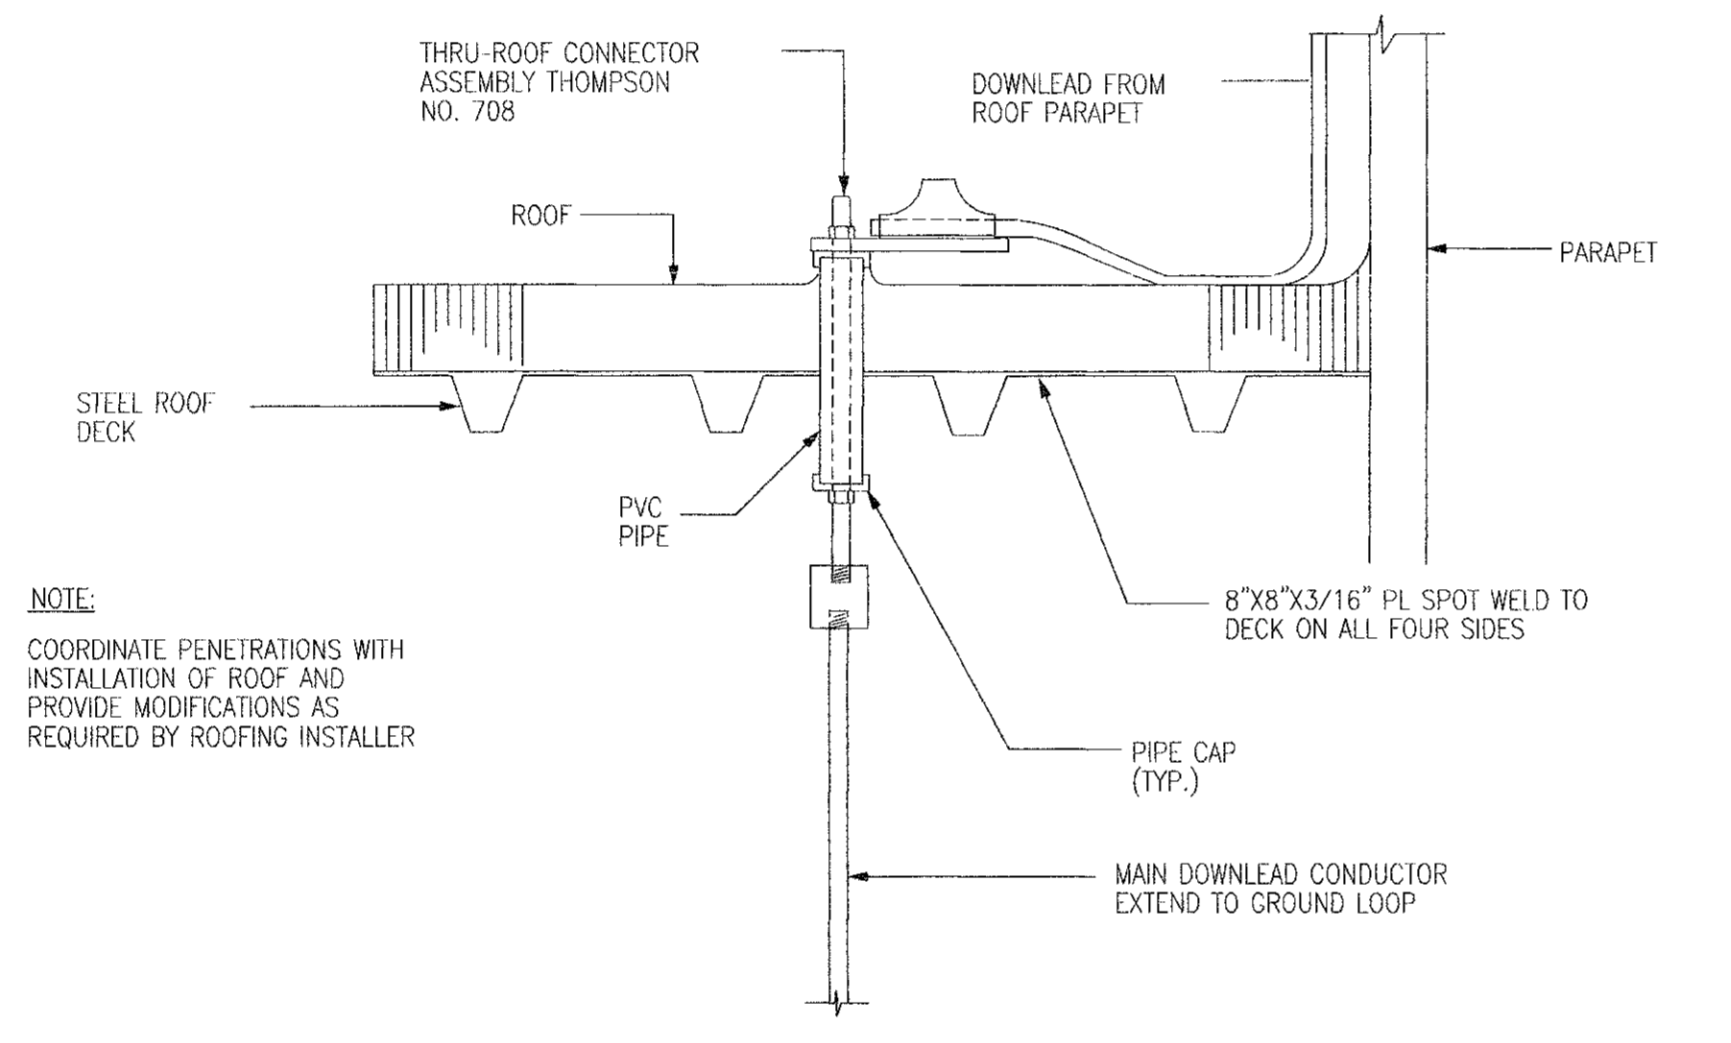


06 THROUGH ROOF CONNECTOR DETAIL  
 E7.000 NTS

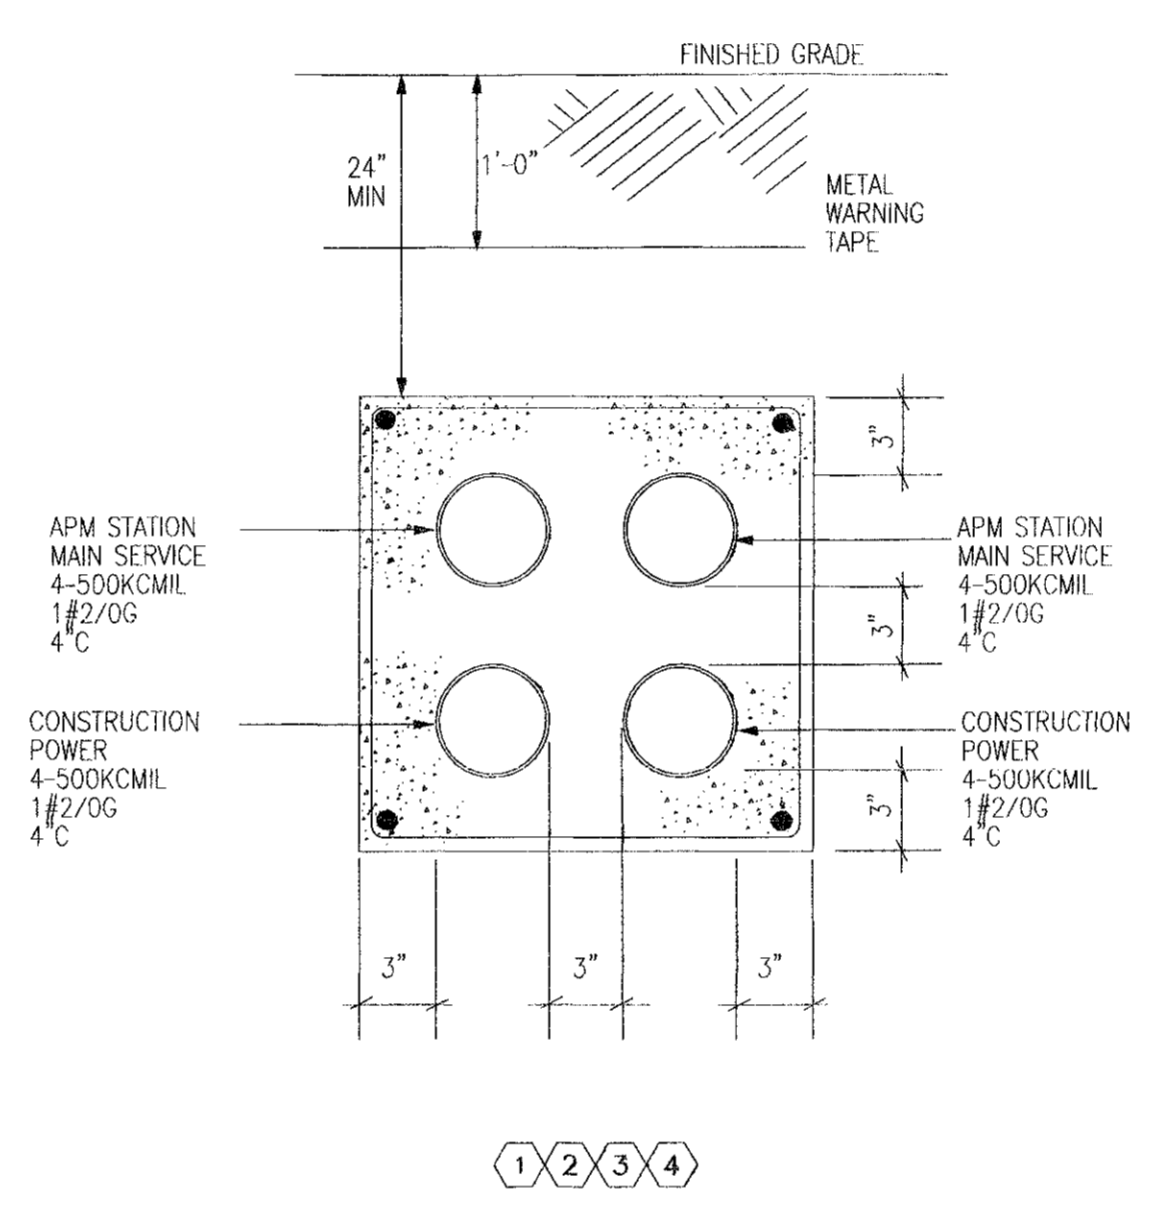

07 NEW 480V DUCTBANK  
 E6.002 NTS


GENERAL NOTES  
 1. ALL CONDUITS SHALL BE SEALED WATER TIGHT.

KEYED NOTES  
 1. ALL CONDUIT SHALL BE TYPE DB, UNLESS NOTED OTHERWISE.  
 2. PROVIDE #4 REBAR LONGITUDINALLY IN EACH CORNER OF DUCT BANK FOR ENTIRE LENGTH.  
 3. PROVIDE #3 REBAR STIRRUPS ON 3'-0\"/>

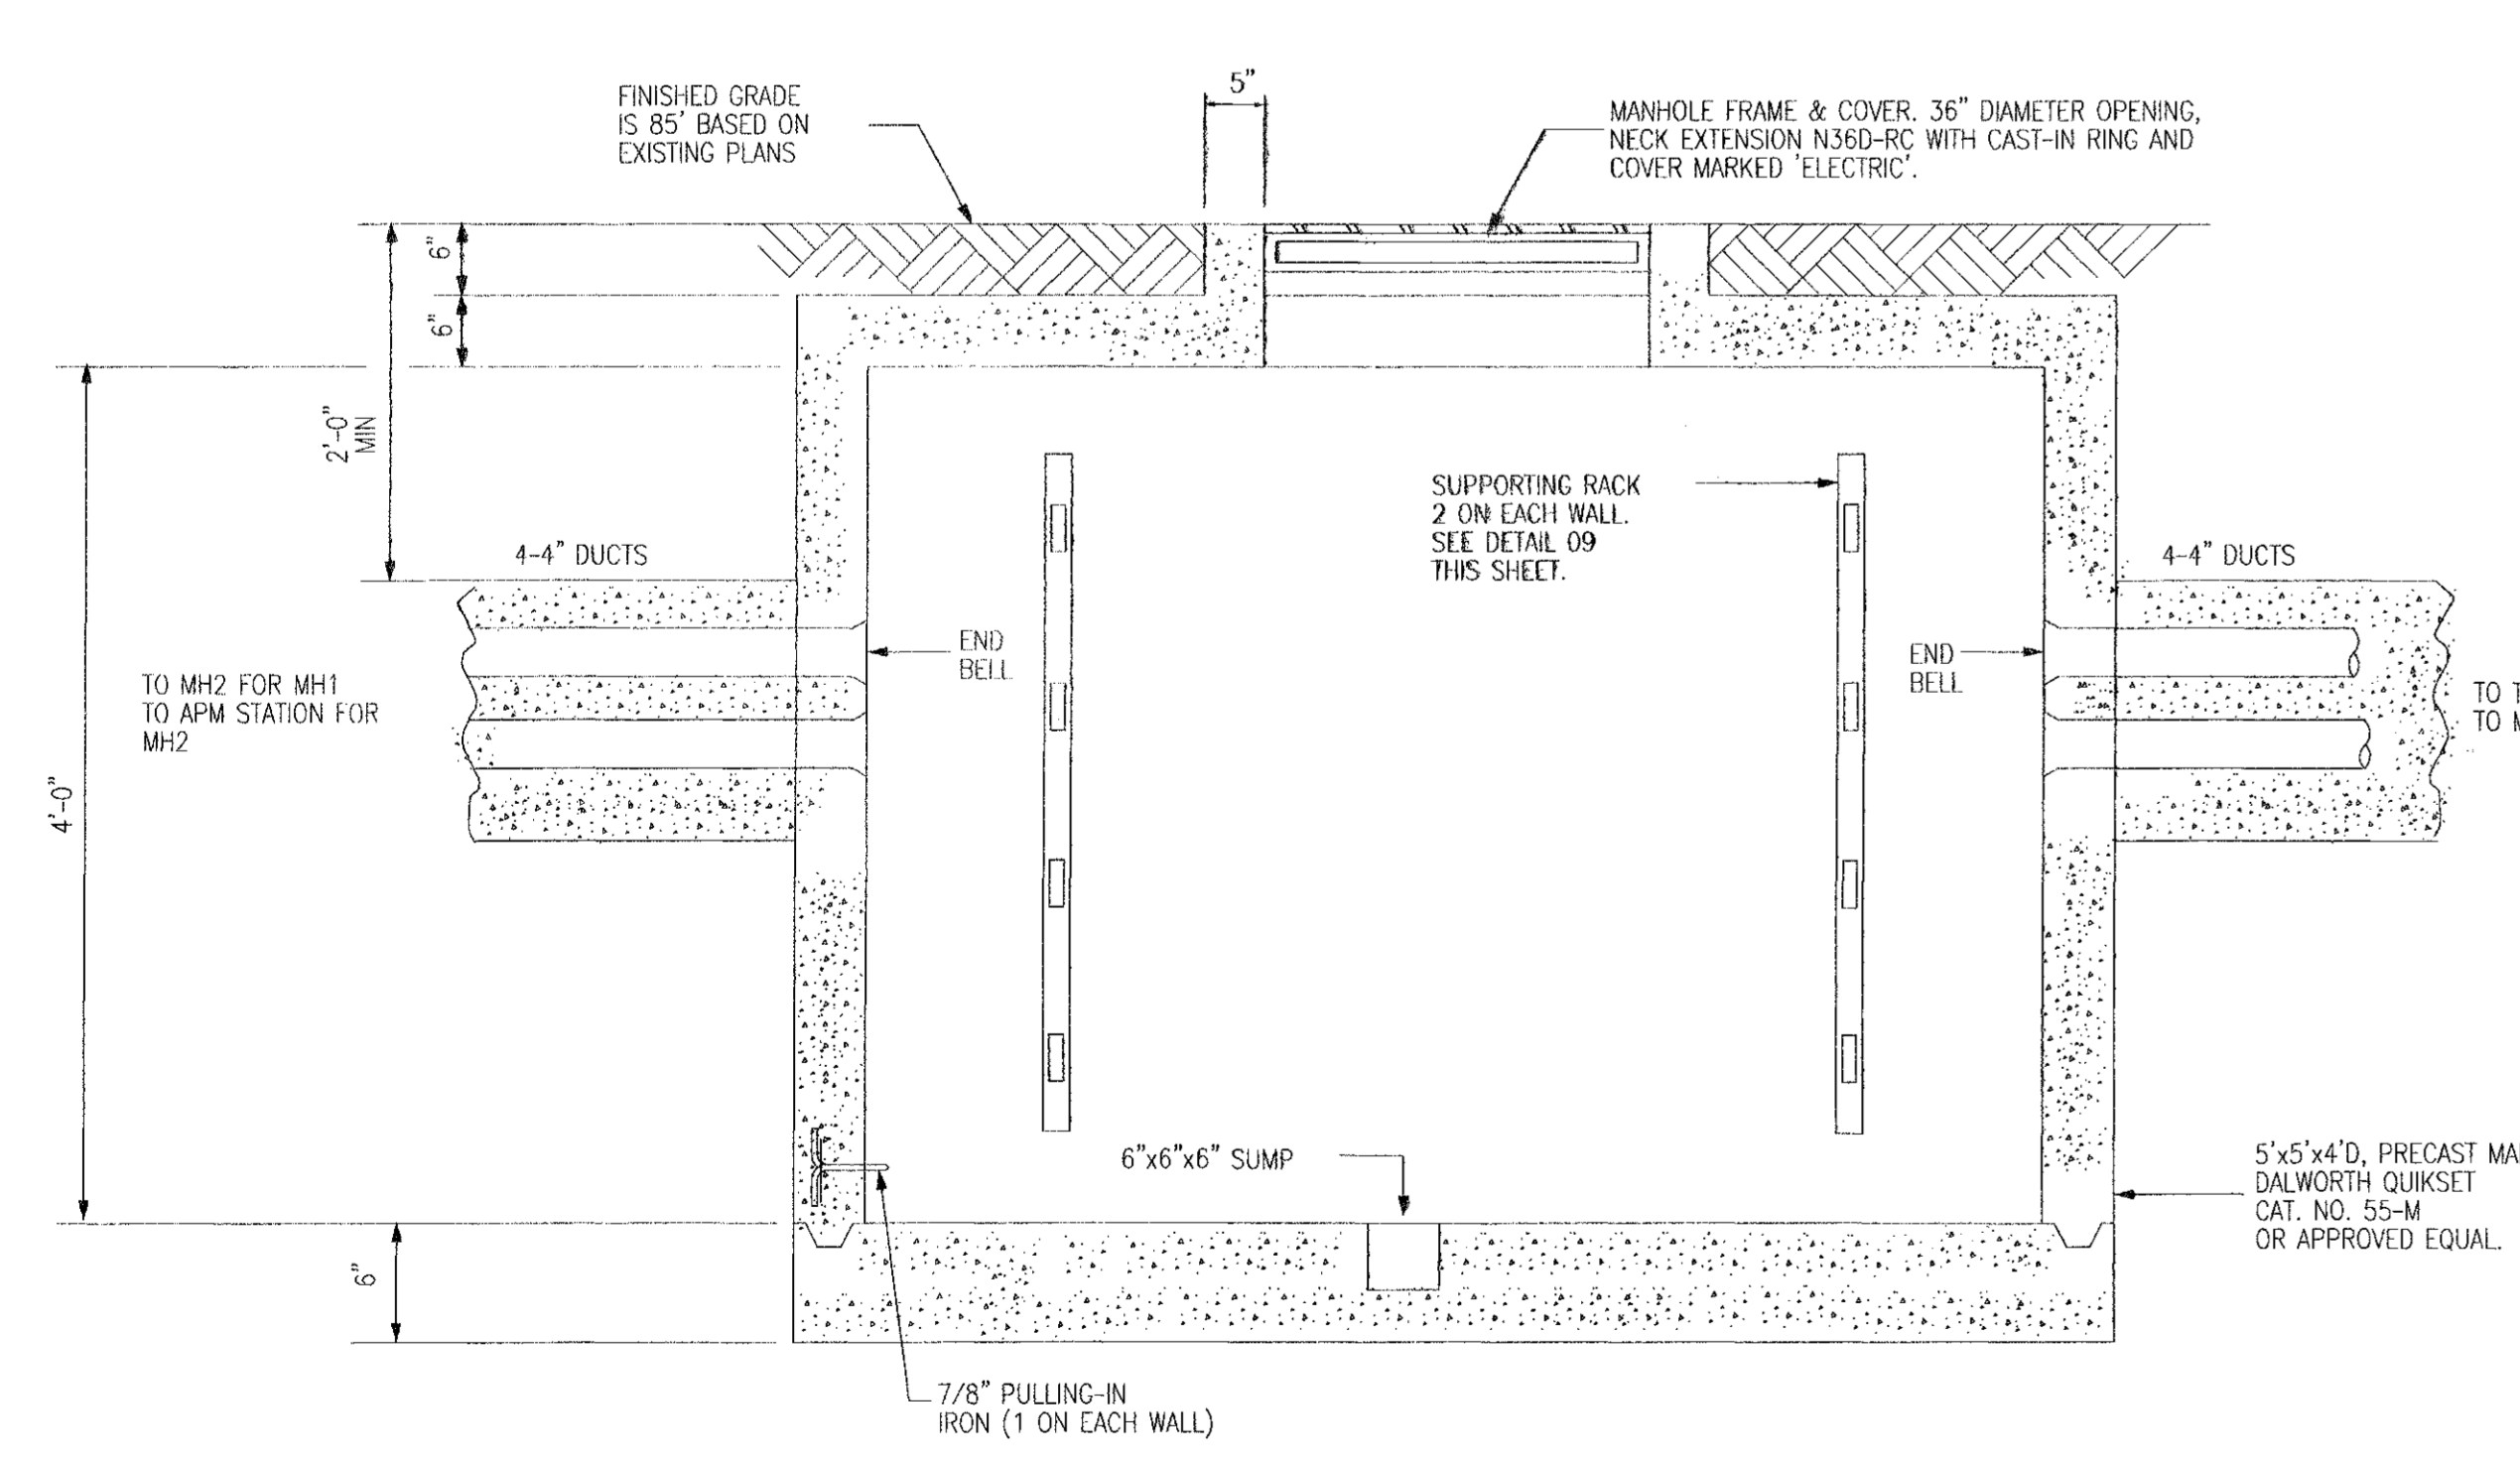

08 PRECAST CONCRETE MANHOLE DETAIL  
 LOOKING WEST FOR MH1  
 LOOKING NORTH FOR MH2  
 E6.002 NTS

- MANHOLE NOTES:
1. WRAP CONDUCTORS FOR APM STATION MAIN SERVICE ONE COMPLETE REVOLUTION AROUND MANHOLE BEFORE EXITING.
  2. AT MH2 THERE WILL BE 2-4\"/>

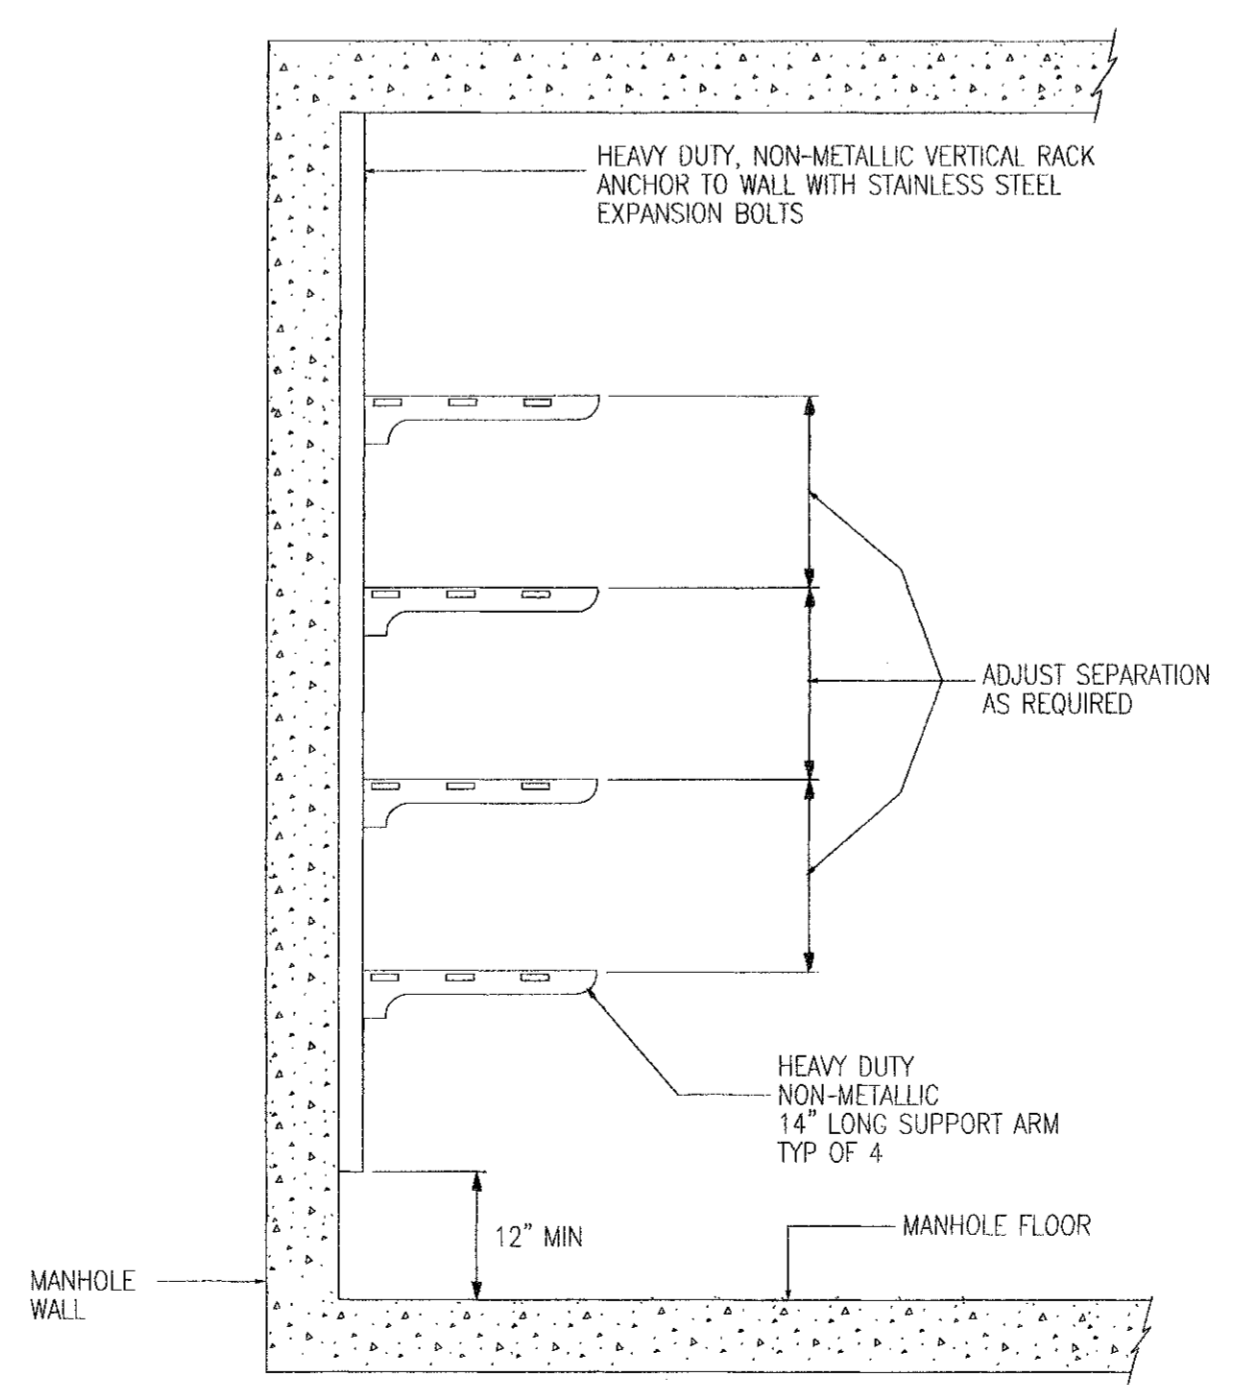


09 PRECAST CONCRETE MANHOLE DETAIL SECTION  
 E6.002 NTS



NO.	DESCRIPTION	DATE	BY
	Bulletin 54F	8/27/04	
	Bulletin 54F.R1	12/09/04	
	Record Drawings	4/29/05	

**RECORD DRAWINGS**  
 DO NOT MODIFY  
 Date: 4/29/05  
 Morris Architects

Note: Information used to develop these documents was taken from record of the work drawings prepared by the construction contractor. Intex United, the information provided was not verified by the design firm named above.

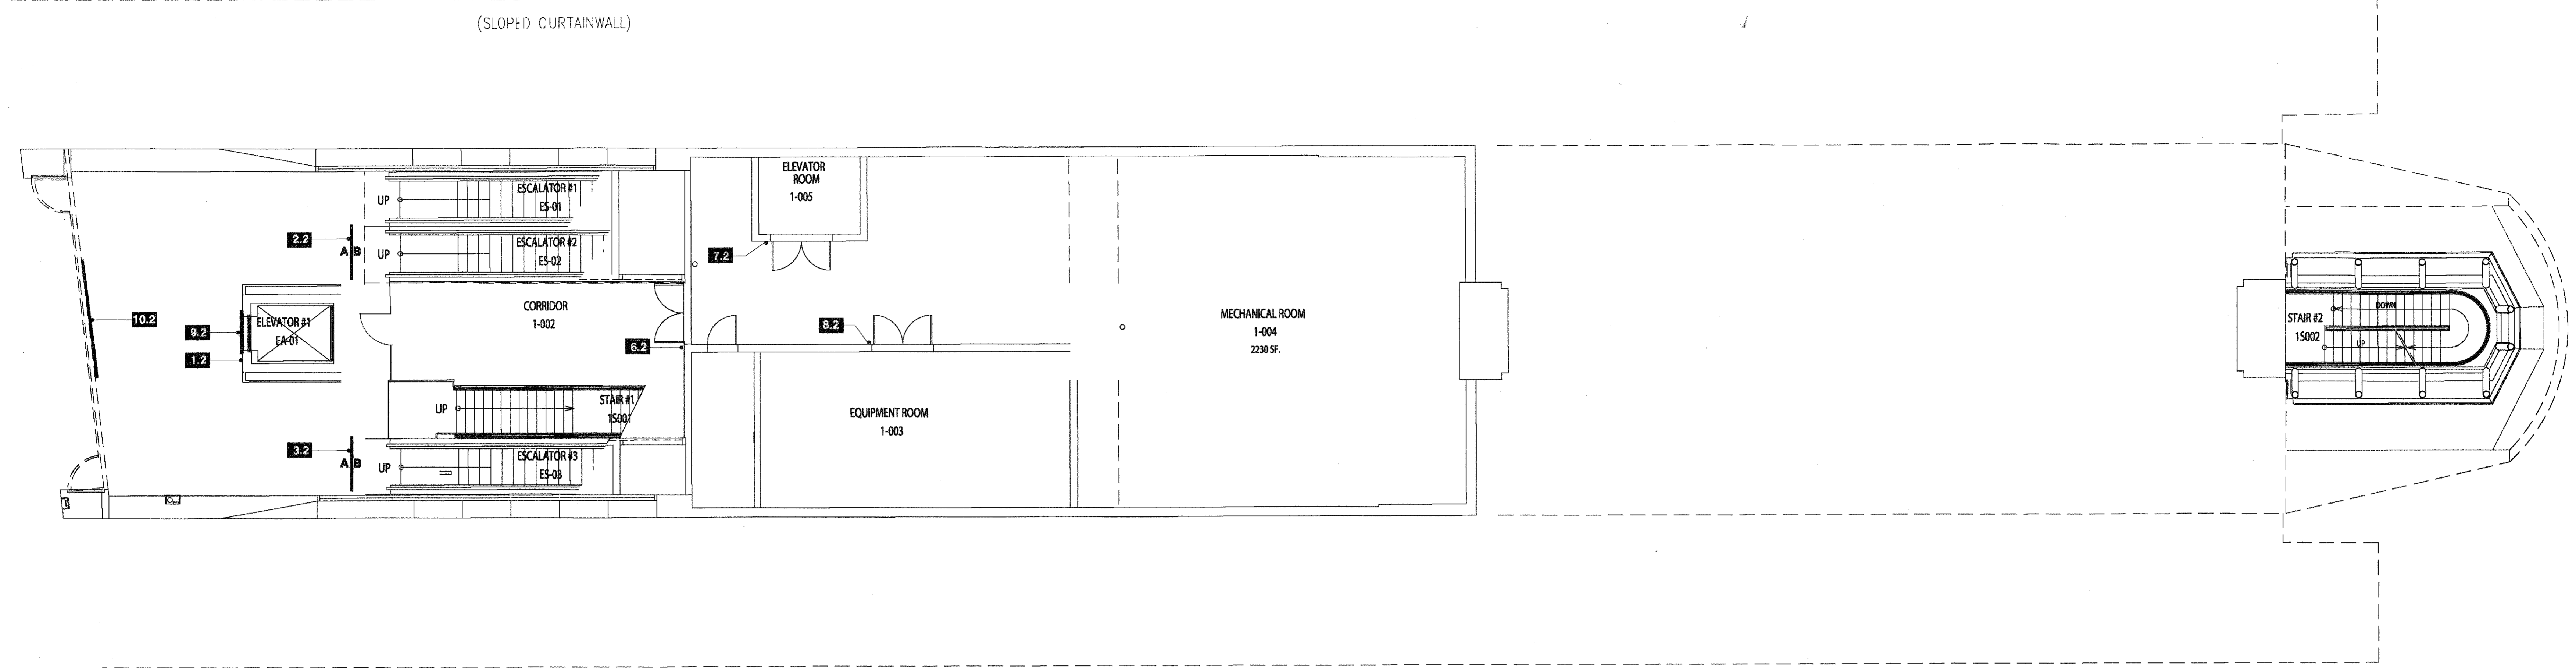

**SIGN MESSAGES:**

**SIGN 1.2:** (Elevator Call Button Sign)  
 LEVEL 2  
 Up to:  
 Train to  
 Terminals B, C

IN CASE OF FIRE EMERGENCY,  
 DO NOT USE ELEVATORS.  
 USE EXIT STAIRS.

**SIGN 2.2:** (New Overhead Sign)  
 A. (Arrow Right)  
 Escalator/Esalera (Symbol)  
 Train to Gates/ Tren a las Salas B 60 to B91, C14 to C27 (Symbol)

B. (Arrow Left) (Symbol) Gates/Salas E1 to E24  
 Gates/Salas D1 to D12 (Symbol) (Arrow Right)

**SIGN 3.2:** (New Overhead Sign)  
 A. (Arrow Up)  
 (Symbol) Escalator/Esalera  
 (Symbol) Train to Gates/ Tren a las Salas B 60 to B91, C14 to C27

B. (Arrow Left) (Symbol) Gates/Salas E1 to E24  
 Gates/Salas D1 to D12 (Symbol) (Arrow Right)

**SIGN MESSAGES:**

**SIGN 4.2:** (Not Used)

**SIGN 5.2:** (Not Used)

**SIGN 6.2:** (Permanent Room ID)  
 IAAPM.2.004.M  
 MECHANICAL ROOM  
 Authorized Personnel Only  
 (Grade Two Braille)

**SIGN 7.2:** (Permanent Room ID)  
 IAAPM.2.005.M  
 ELEVATOR ROOM  
 (Grade Two Braille)

**SIGN 8.2:** (Permanent Room ID)  
 IAAPM.2.003  
 EQUIPMENT ROOM  
 Authorized Personnel Only  
 (Grade Two Braille)

**SIGN MESSAGES:**


**SIGN 9.2:** (New Overhead Sign mounted to elevator fascia)  
 (Arrow Up) Elevator to  
 Terminals B, C

**SIGN 10.2:** (New Fascia mounted Sign)  
 (Arrow Left) (Symbol) Gates/Salas E1 to E24  
 Gates/Salas D1 to D12 (Symbol) (Arrow Right)

INTERNATIONAL PROGRAM  
 EXPANSION  
 SERVICES  
**APM STATION & PLATFORM**  
 SIGNAGE LOCATION PLAN  
 LOBBY LEVEL

PROJECT MGR:	BC
DESIGNER:	BC
DRAWN BY:	BC
CHECKED BY:	SC
DRAWING STANDARD:	

SCALE: NTS  
 DATE: 08/27/04

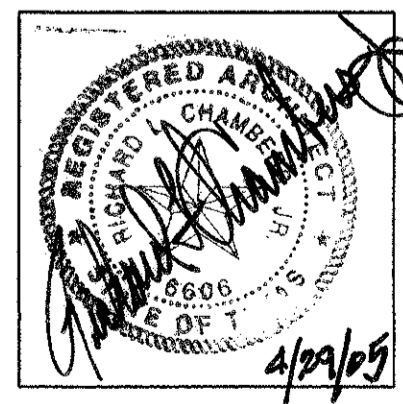

APPROVED BY:	DATE:
PROJECT NO.:	080402.000
C.I.P. NO.:	A-034
H.A.S. NO.:	036
SHEET NO.:	


PLOT DATE: HAS FILE:



NO.	DESCRIPTION	DATE	BY
Bulletin 54F	8/27/04		
Bulletin 54F.R1	12/09/04		
▲	Record Drawings	4/29/05	

**RECORD DRAWINGS**  
 DO NOT MODIFY  
 Date: 4/29/05  
 Morris Architects

Note: Information used to develop these documents was taken from record of the work drawings prepared by the construction contractor, Intex United. This information provided was not verified by the design firm named above.

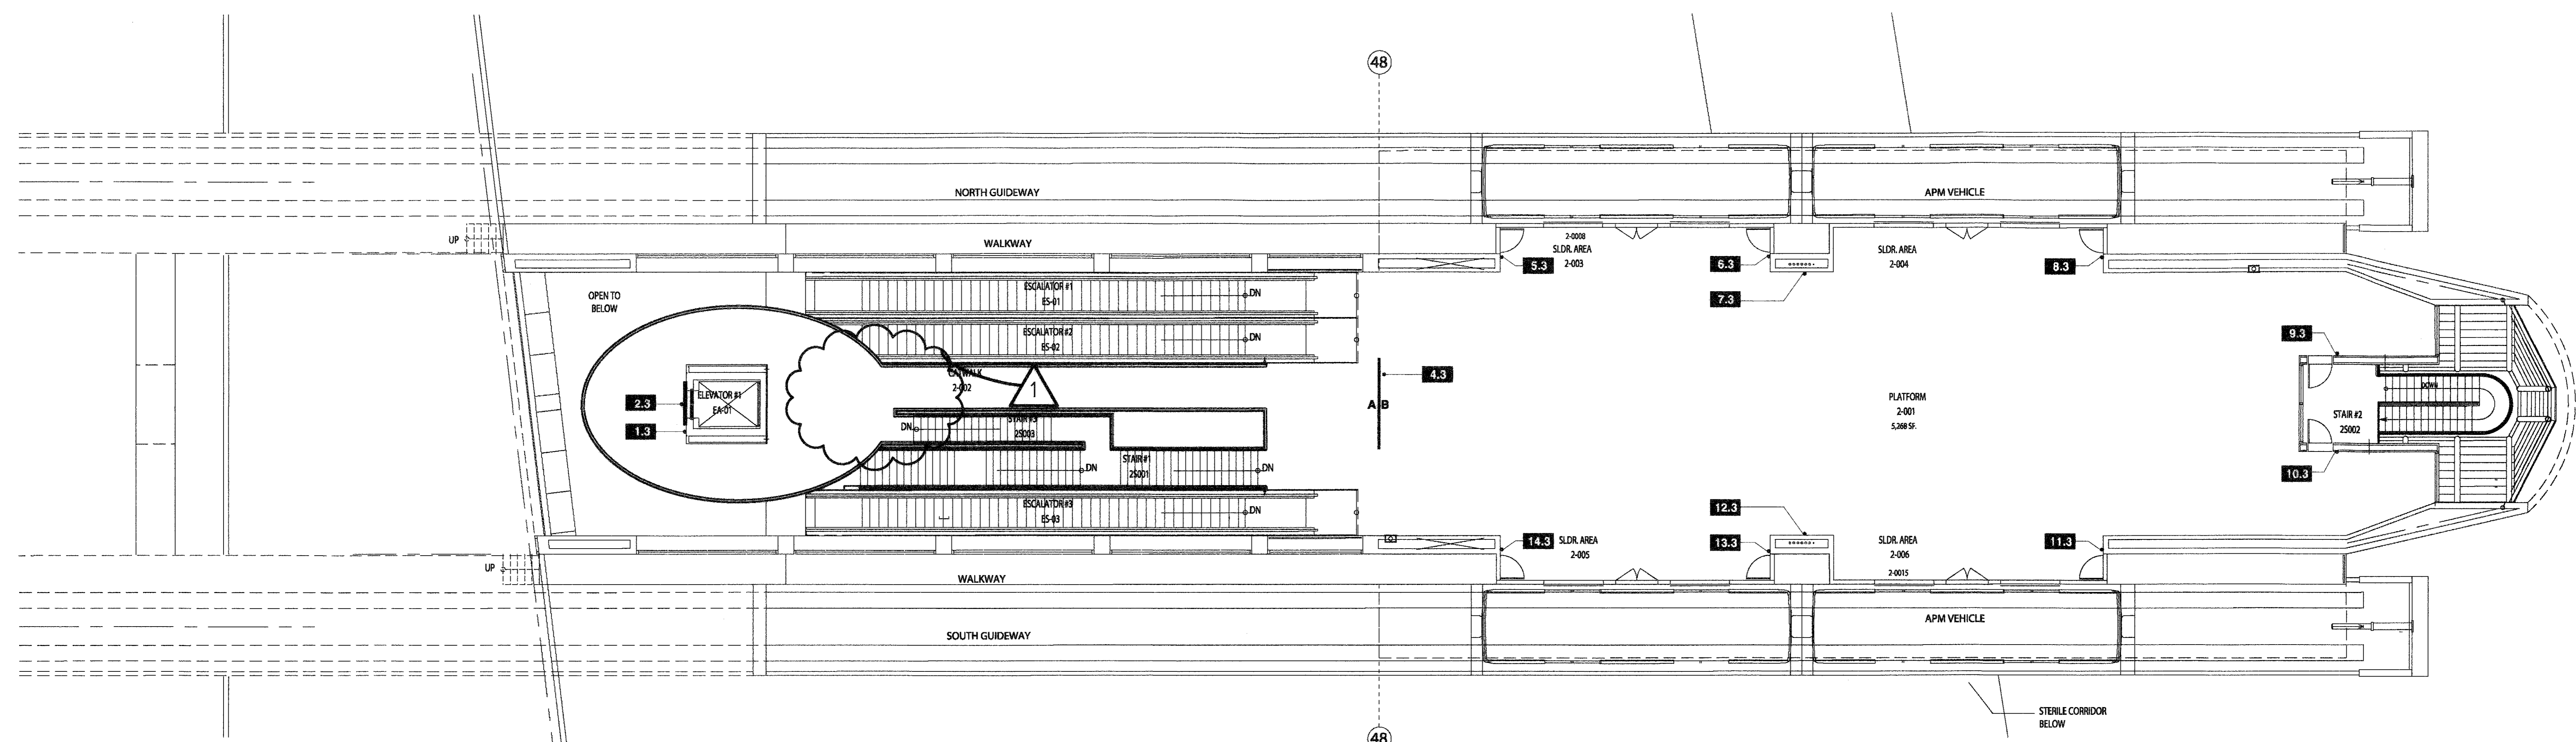

**SIGN MESSAGES:**

**SIGN 1.3:** (Elevator Call Button Sign)  
 LEVEL 3  
 DOWN TO:  
 Terminals D, E

IN CASE OF FIRE EMERGENCY,  
 DO NOT USE ELEVATORS.  
 USE EXIT STAIRS.

**SIGN 2.3:** (New Overhead Sign mounted to elevator fascia)  
 (Arrow Down) Elevator to Terminals D, E

**SIGN 3.3:** (deleted)

**SIGN MESSAGES:**

**SIGN 4.3:** (New Overhead Sign)

Side A: (Arrow Up)  
 (Symbol) Train to Gates/Tren a las Salas  
 B60 to B91, C14 to C27

Side B:  
 (Arrow Down Right)  
 (Symbol) Escalator/Escalera

(Arrow Up)  
 (Symbol) Elevator/Elevador  
 (Symbol) Gates/Salas D1 to D12, E1 to E24

**SIGN 5.3:** (EEO Sign)  
 Emergency Exit Only  
 Alarm Will Sound if Door is Opened  
 (Grade Two Braille)

**SIGN 6.3:** (EEO Sign)  
 Emergency Exit Only  
 Alarm Will Sound if Door is Opened  
 (Grade Two Braille)

**SIGN MESSAGES:**

**SIGN 7.3:** (New Wall Directional)  
 (Arrow Left)  
 (Symbol) Elevator/Elevador  
 (Symbol) Escalator/Escalera  
 (Symbol) Gates/Salas  
 D1 to D12, E1 to E24

**SIGN 8.3:** (EEO Sign)  
 Emergency Exit Only  
 Alarm Will Sound if Door is Opened  
 (Grade Two Braille)

**SIGN 9.3:** (Stair ID Sign)  
 IAAPM.3.001  
 STAIR 2  
 Emergency Exit Only  
 Alarm Will Sound if Door is Opened  
 (Grade Two Braille)

**SIGN 10.3:** (Stair ID Sign)  
 IAAPM.3.001  
 STAIR 2  
 Emergency Exit Only  
 Alarm Will Sound if Door is Opened  
 (Grade Two Braille)

**SIGN 11.3:** (EEO Sign)  
 Emergency Exit Only  
 Alarm Will Sound if Door is Opened  
 (Grade Two Braille)

**SIGN 12.3:** (New Wall Directional)  
 (Arrow Right)  
 (Symbol) Elevator/Elevador  
 (Symbol) Escalator/Escalera  
 (Symbol) Gates/Salas  
 D1 to D12, E1 to E24

**SIGN MESSAGES:**


**SIGN 13.3:** (EEO Sign)  
 Emergency Exit Only  
 Alarm Will Sound if Door is Opened  
 (Grade Two Braille)

**SIGN 14.3:** (EEO Sign)  
 Emergency Exit Only  
 Alarm Will Sound if Door is Opened  
 (Grade Two Braille)

INTERNATIONAL PROGRAM EXPANSION SERVICES  
**APM STATION & PLATFORM**  
 SIGNAGE LOCATION PLAN  
 PLATFORM LEVEL

PROJECT MGR:	SC
DESIGNER:	SC
DRAWN BY:	SC
CHECKED BY:	SC
DRAWING STANDARD:	

SCALE: NTS  
 DATE: 07/06/04

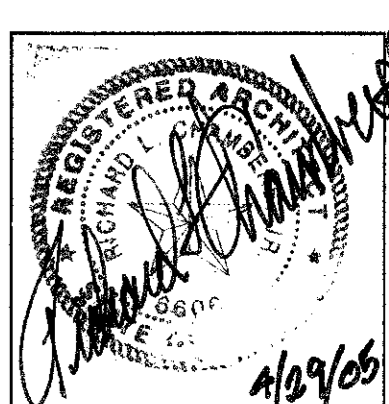

APPROVED BY: DATE:

DIRECTOR  
 HOUSTON AIRPORT SYSTEM

PROJECT NO.	G0402.000
CLIP NO.	A-0264
H.A.S. NO.	8962
SHEET NO.	137

G1.002



REVISIONS

NO.	DESCRIPTION	DATE	BY
Bulletin 54F	0/27/04		
Bulletin 54F.R1	12/09/04		
Record Drawings	4/29/05		

RECORD DRAWINGS  
 DO NOT MODIFY  
 Date: 4/29/05  
 Morris Architects


Note: Information used to develop these documents was taken from record of the work drawings prepared by the construction contractor, Intex United. The information provided was not verified by the design firm named above.

INTERNATIONAL SERVICES EXPANSION PROGRAM

**APM STATION & PLATFORM**  
 SIGN FACE LAYOUTS

PROJECT MGR:	SC
DESIGNER:	SC
DRAWN BY:	SC
CHECKED BY:	SC
DRAWING STANDARD:	

SCALE: NTS  
 DATE: 07/04/04

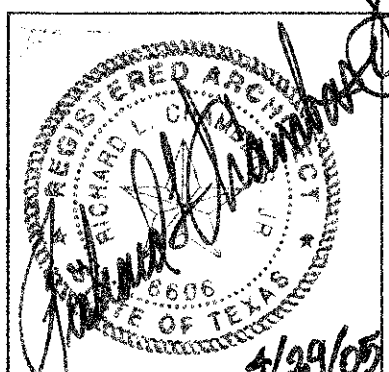

APPROVED BY: DATE:


DIRECTOR  
 HOUSTON AIRPORT SYSTEM

PROJECT NO.: 020488.000


CLP. NO.: A-1094

SHEET NO.: 586


**G1.003**

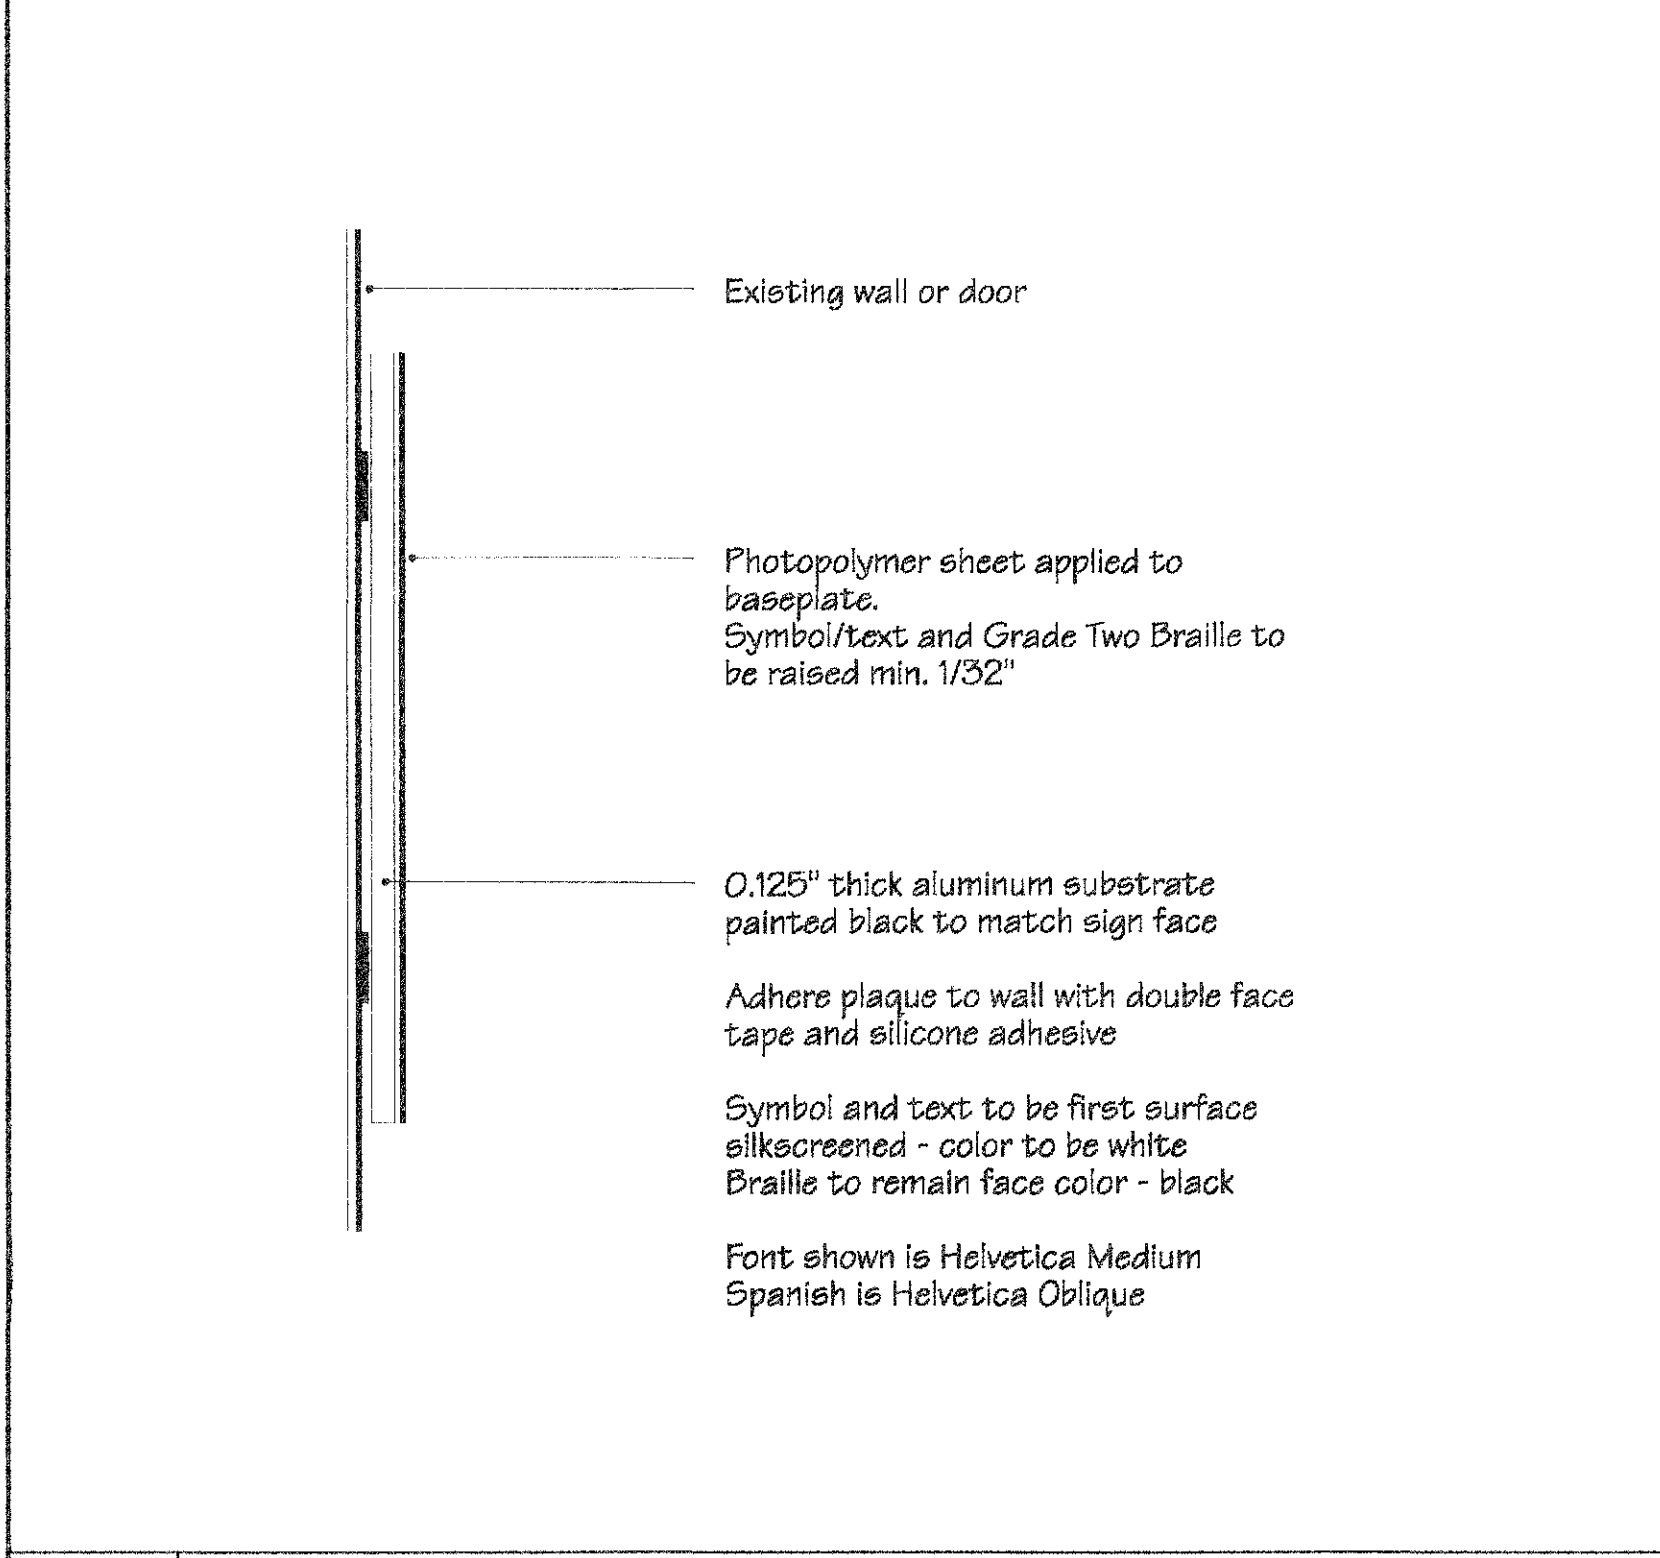


**1** DETAIL SECTION - Typ. Wall Plaques  
 SCALE: 3" = 1'-0"

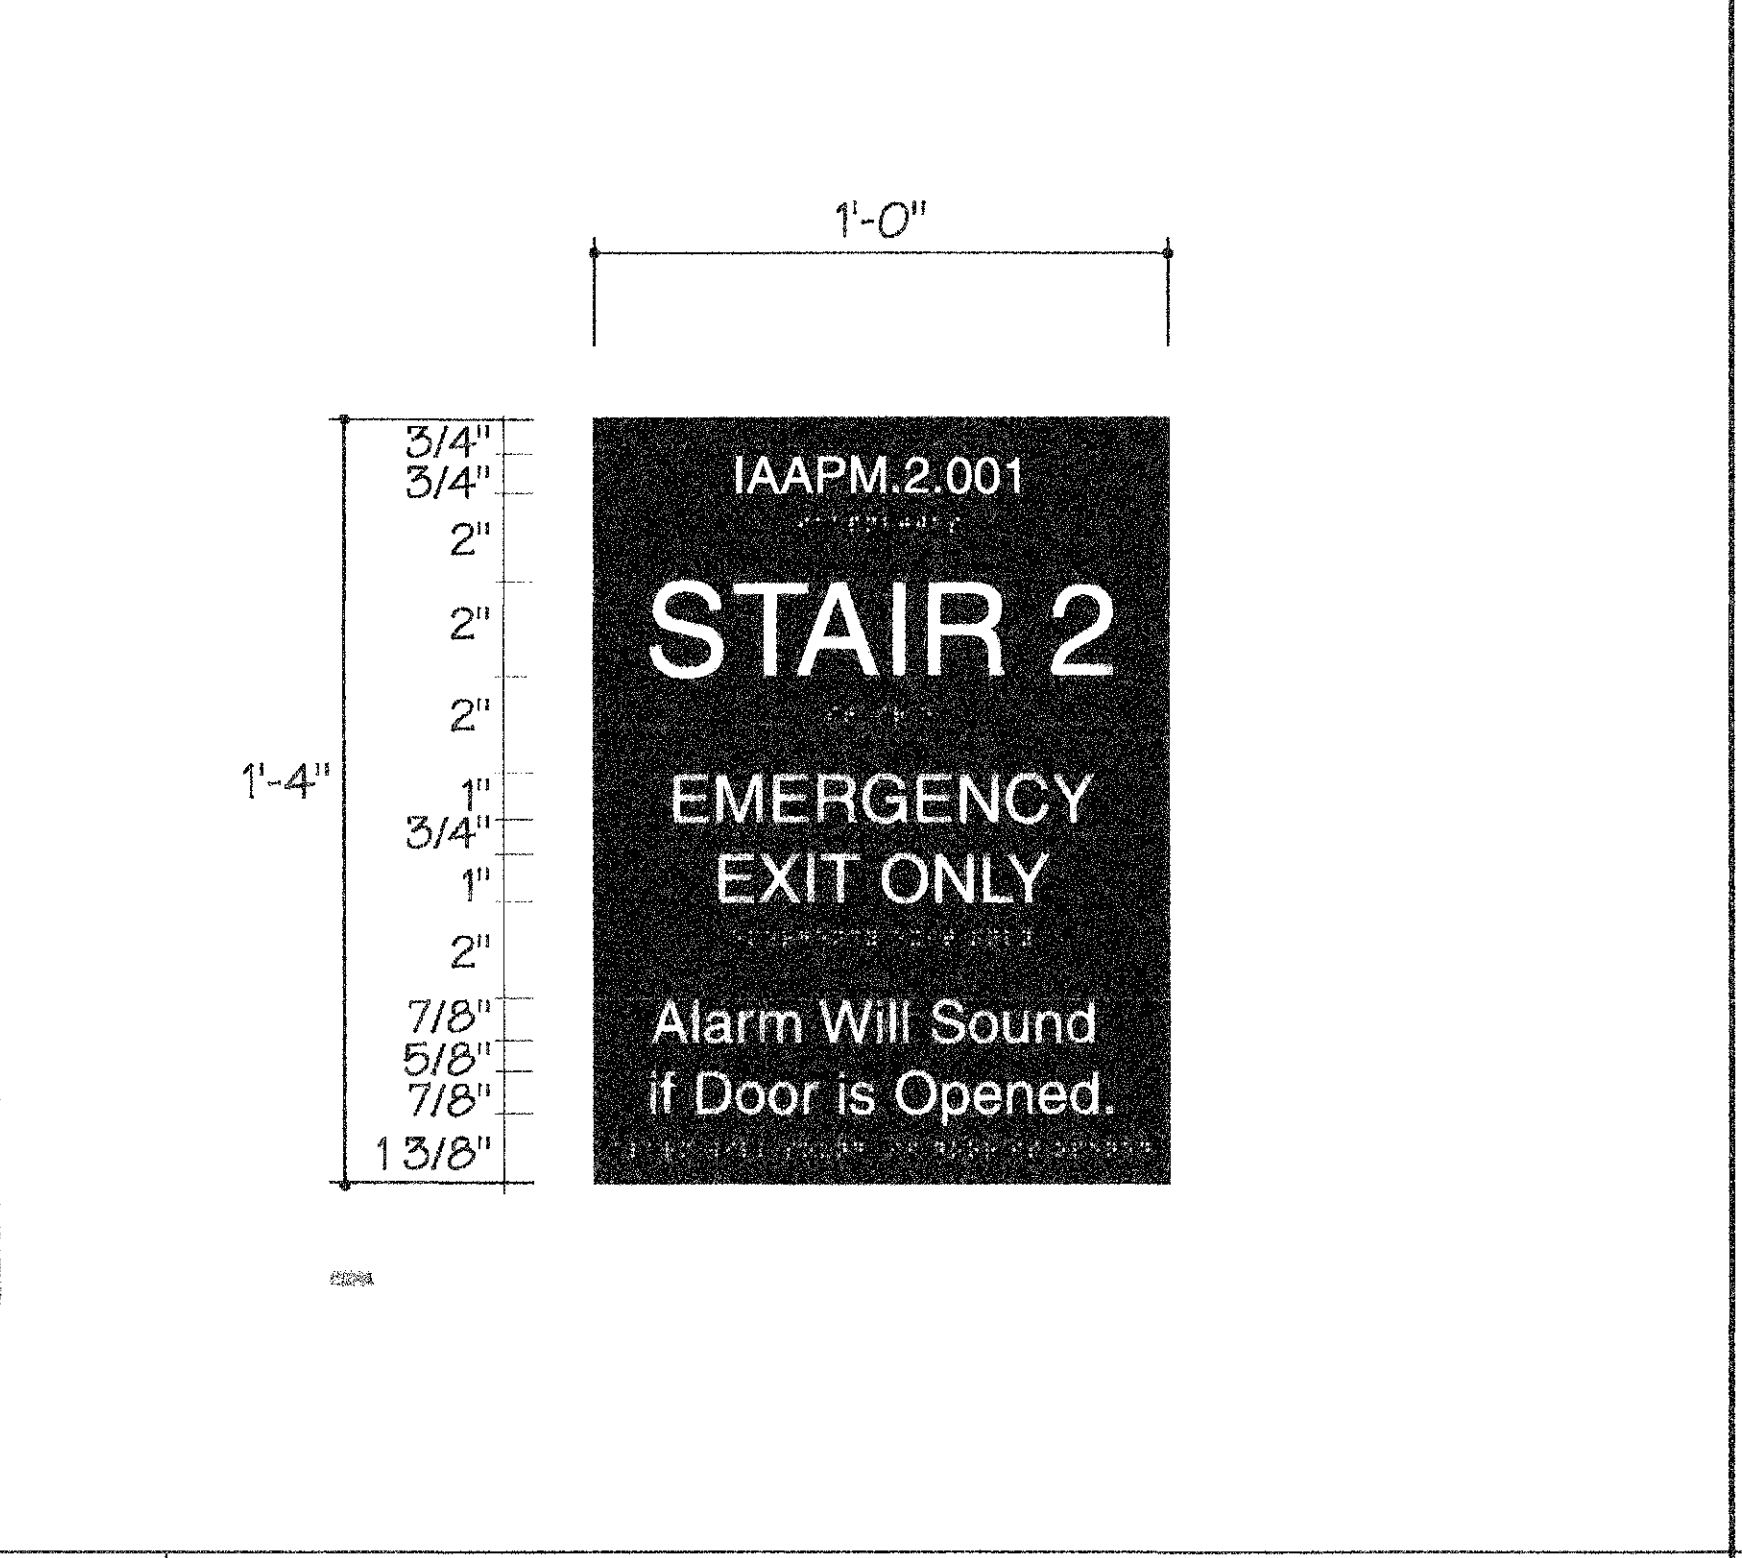


**2** ELEVATION - Typ. Stair Sign  
 SCALE: 3" = 1'-0"

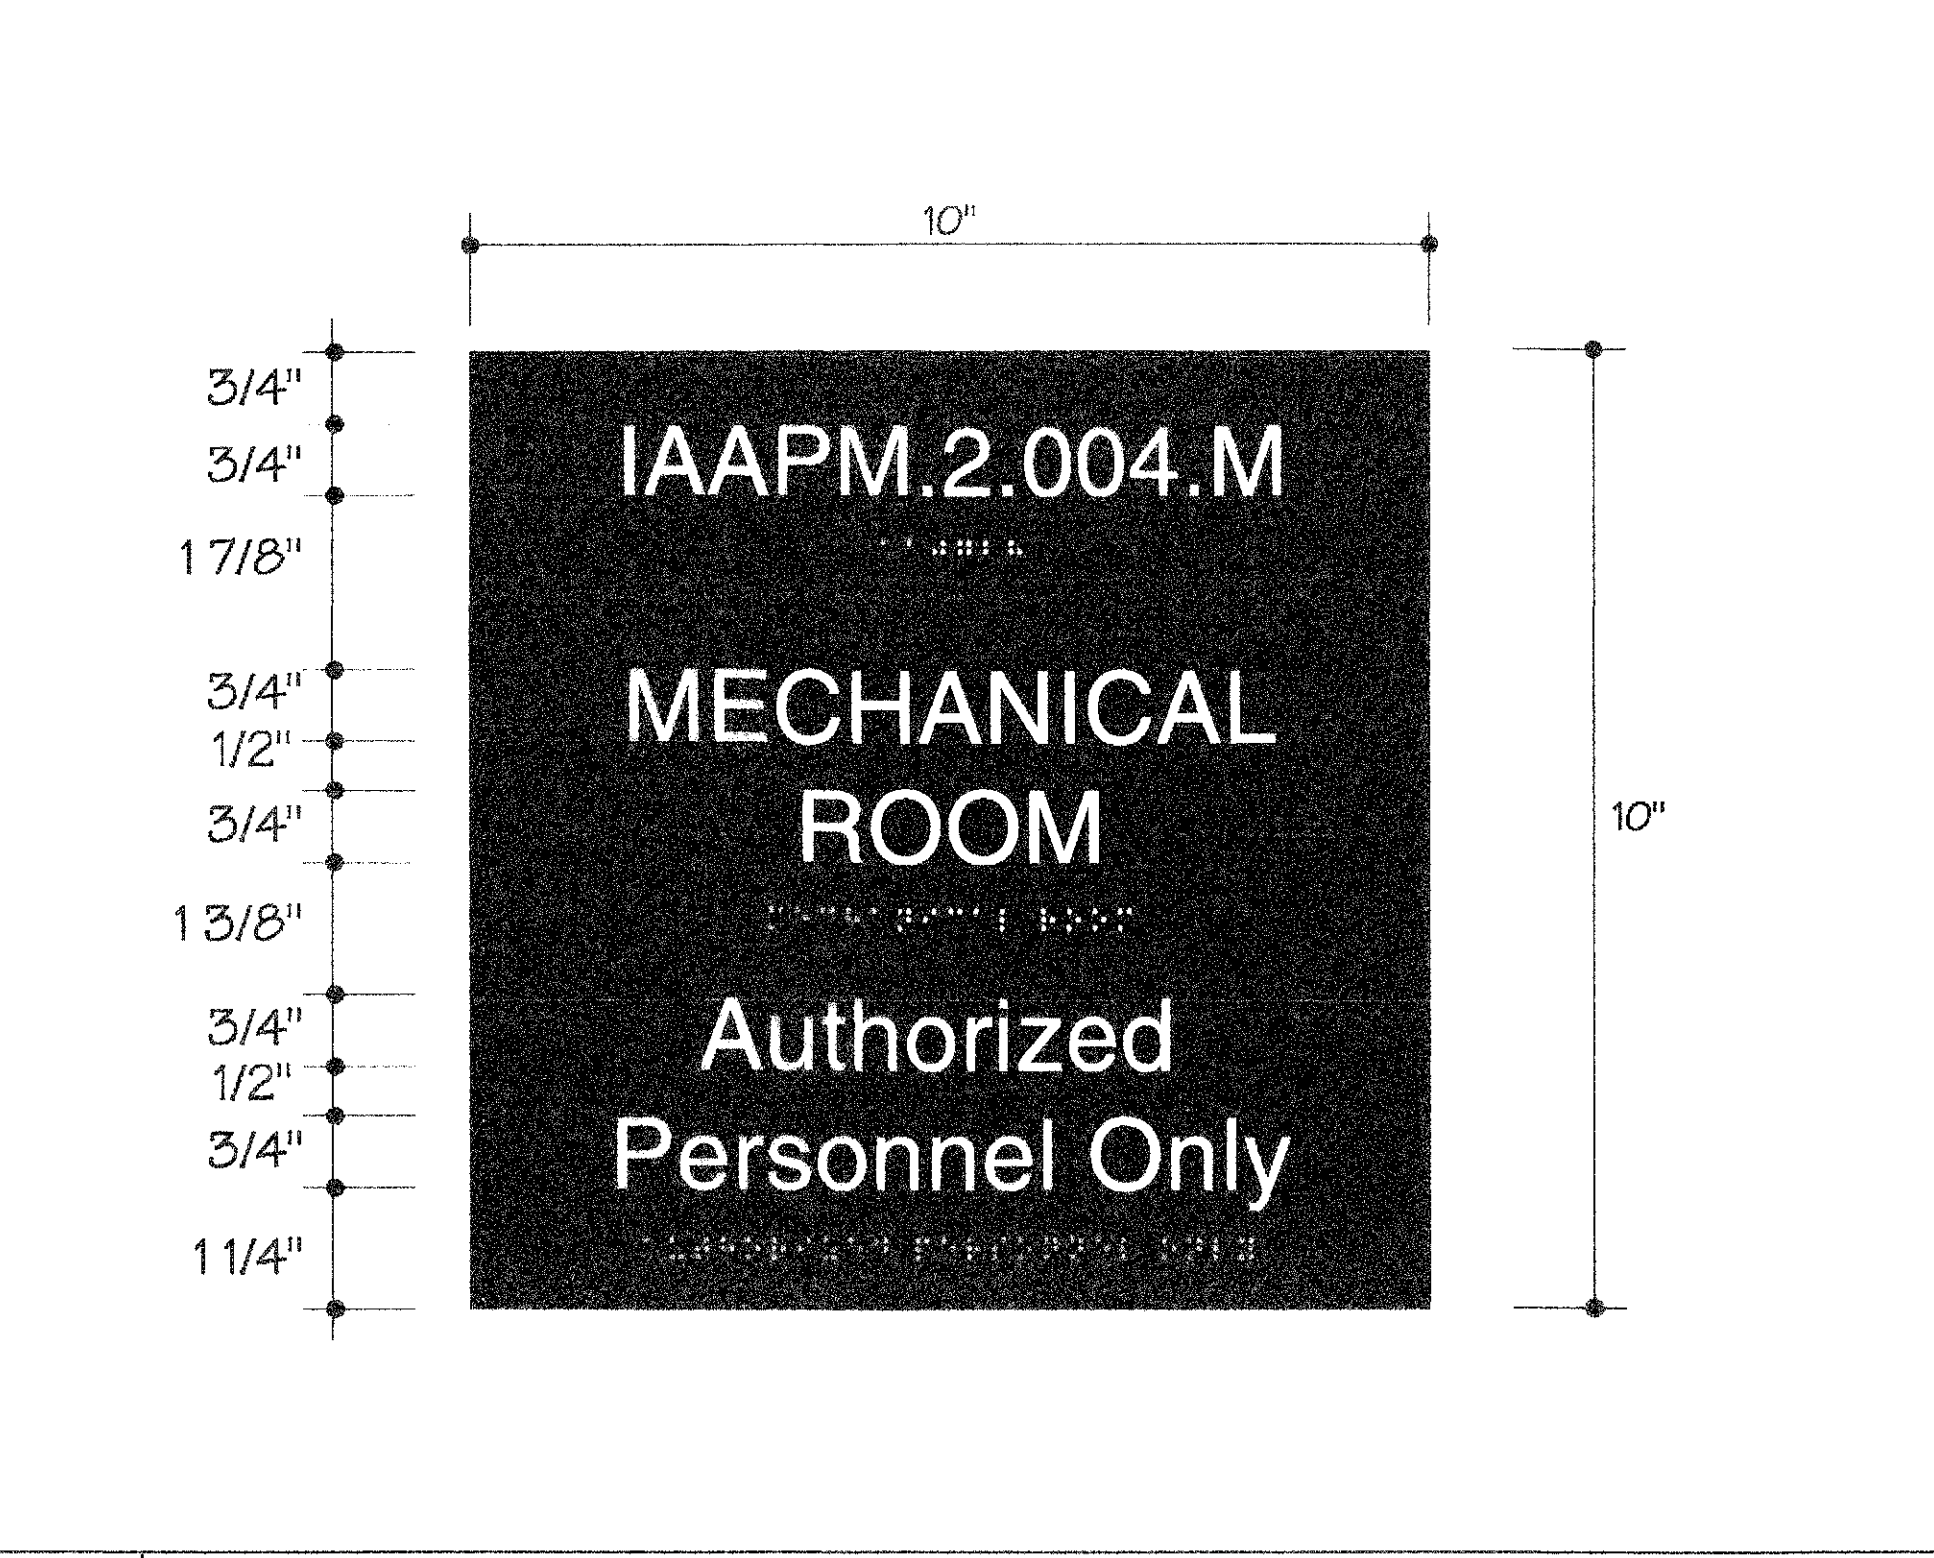


**3** ELEVATION - Typ. Permanent Room ID  
 SCALE: Half Size

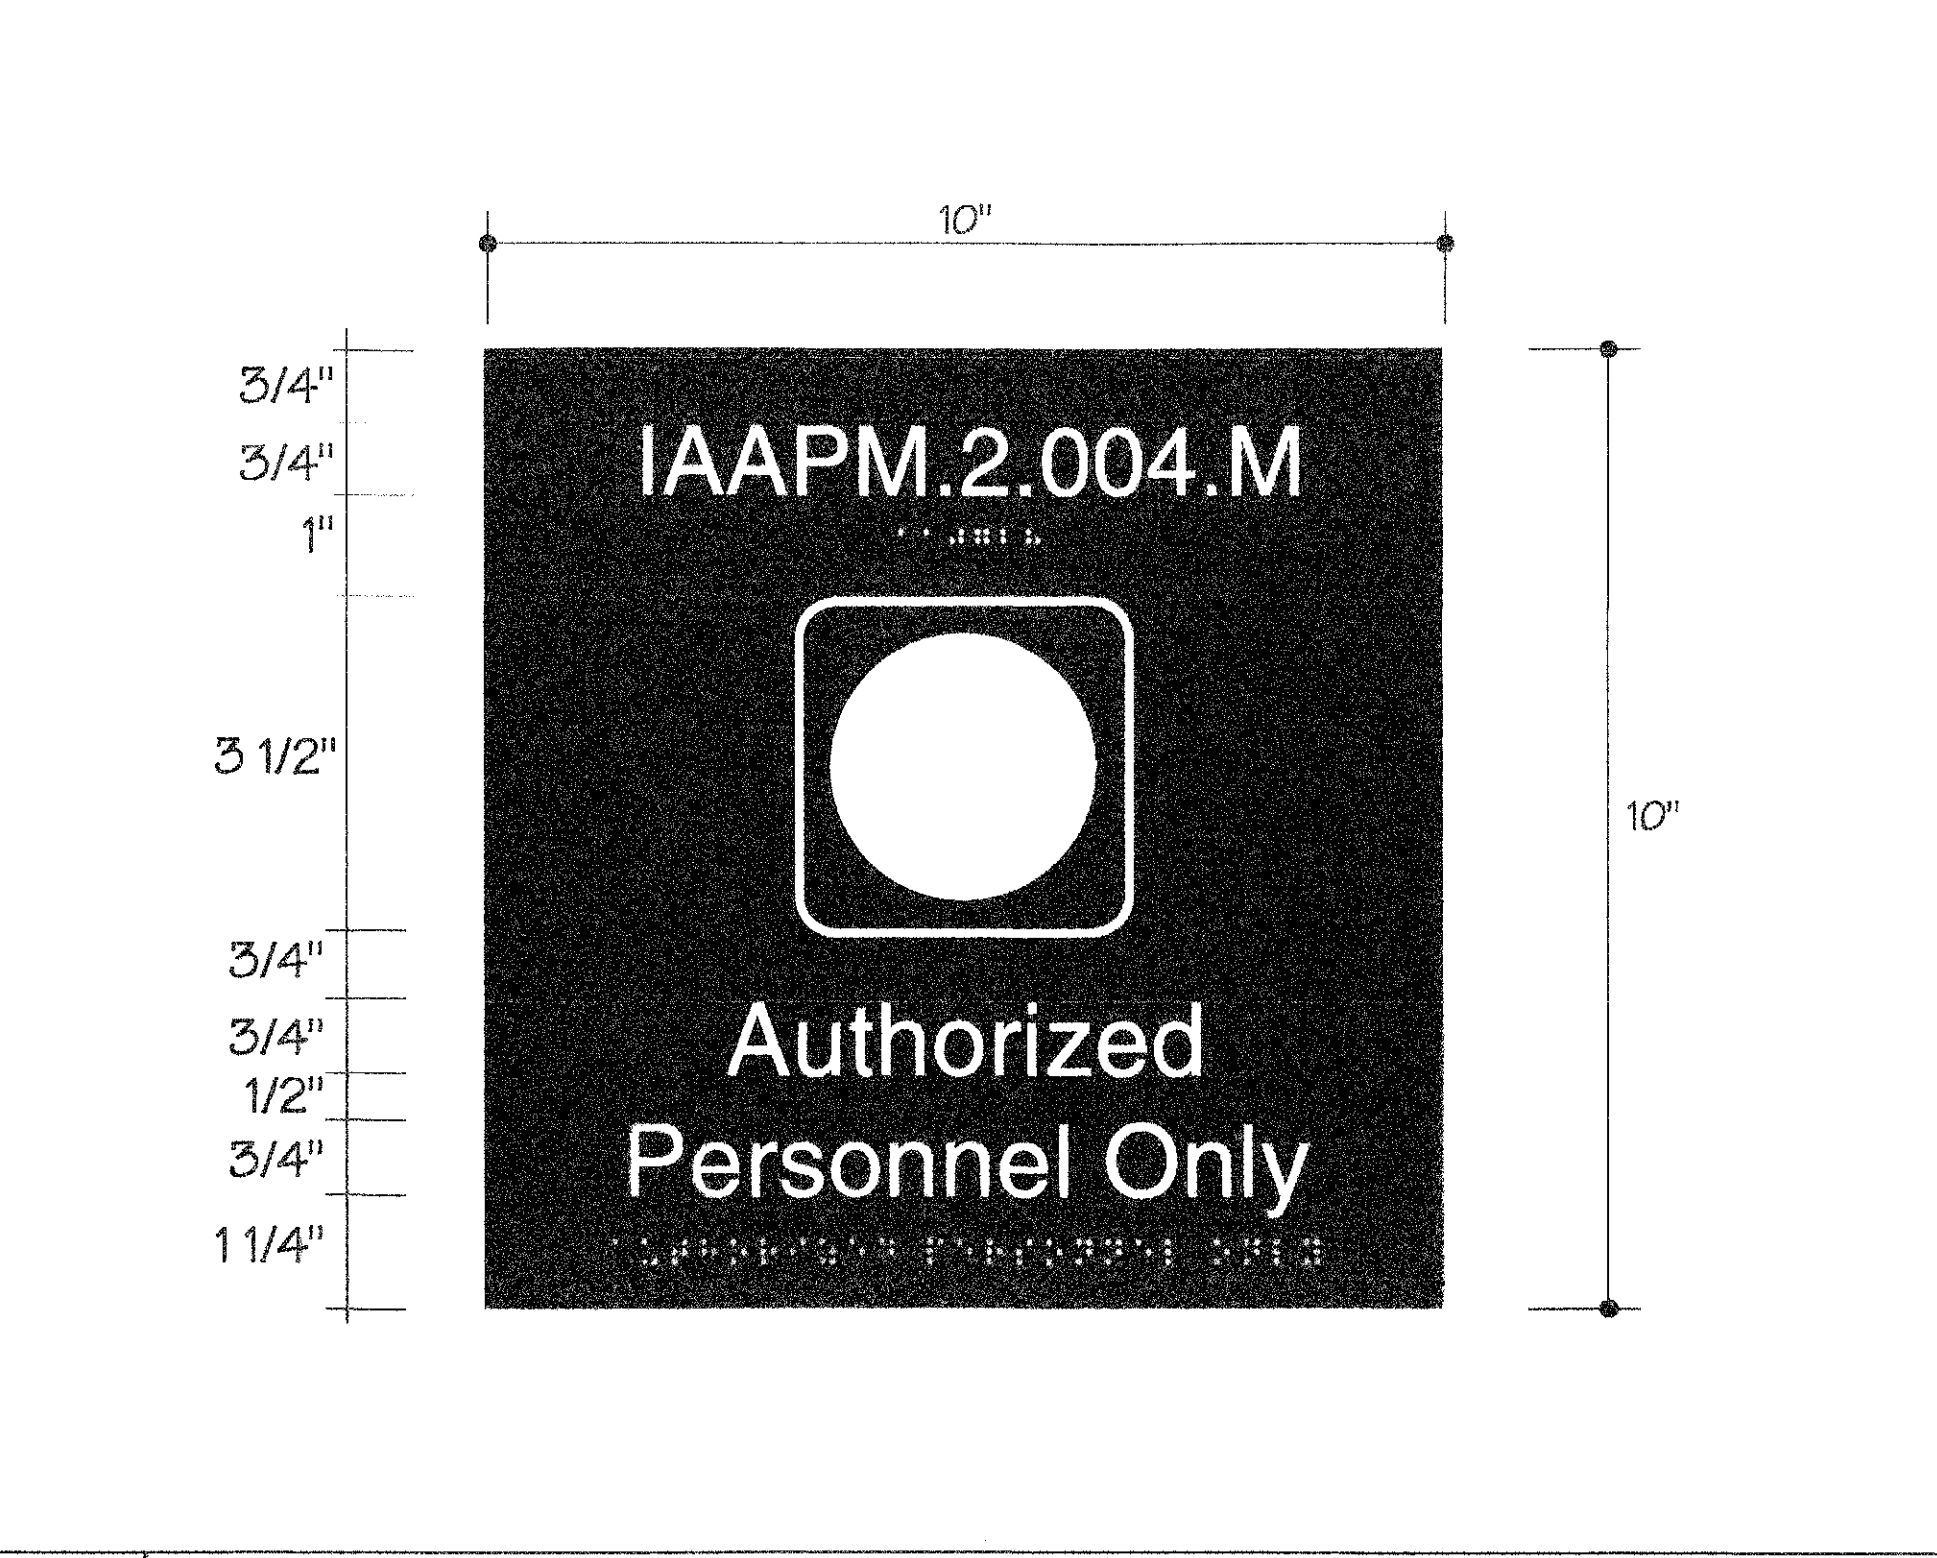


**4** ELEVATION - Typ. Permanent Room ID  
 SCALE: Half Size

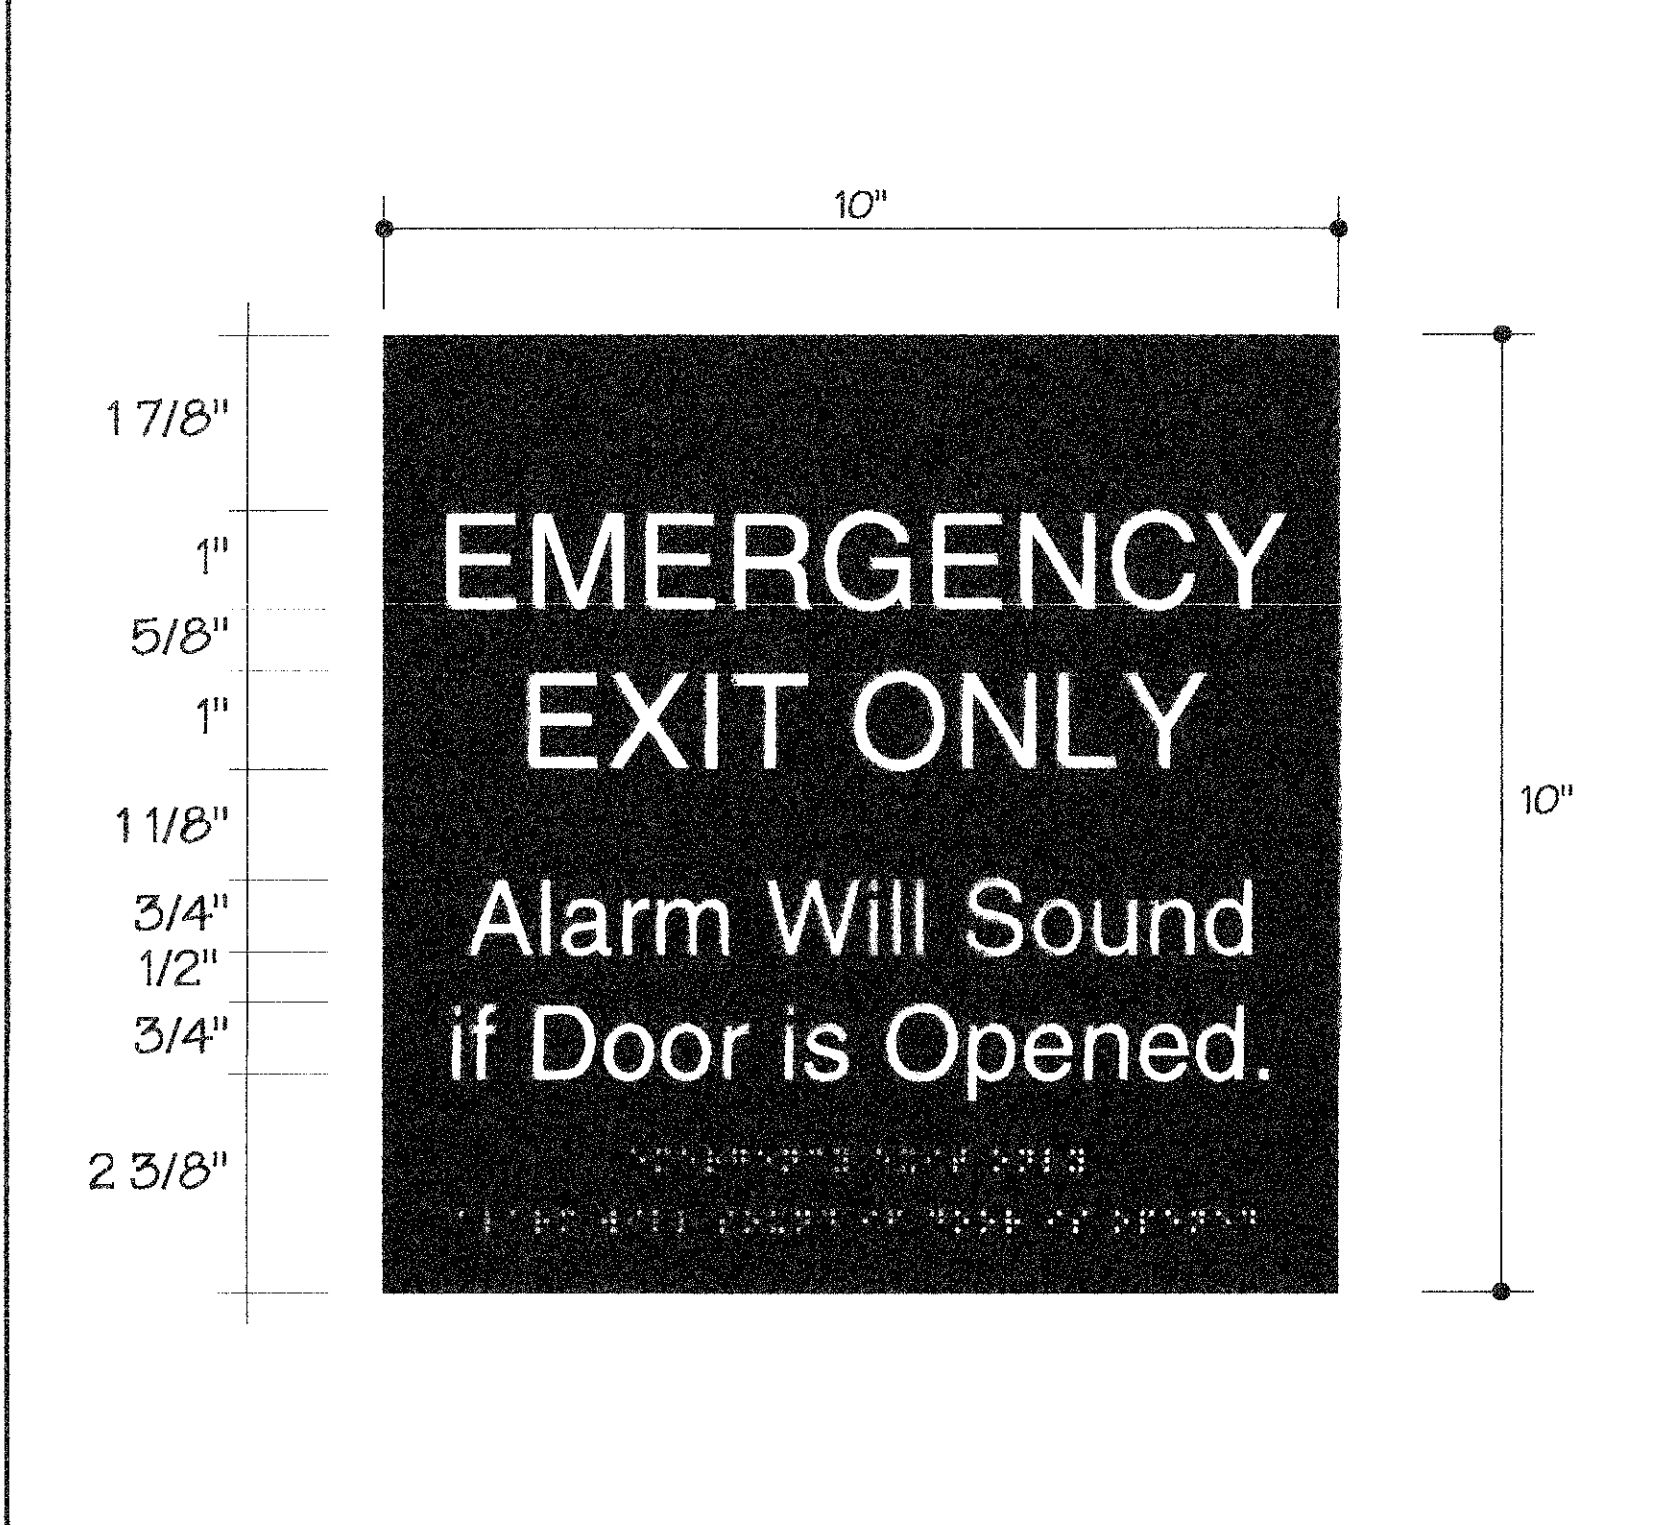


**5** ELEVATION - Emergency Exit Sign  
 SCALE: 3" = 1'-0"

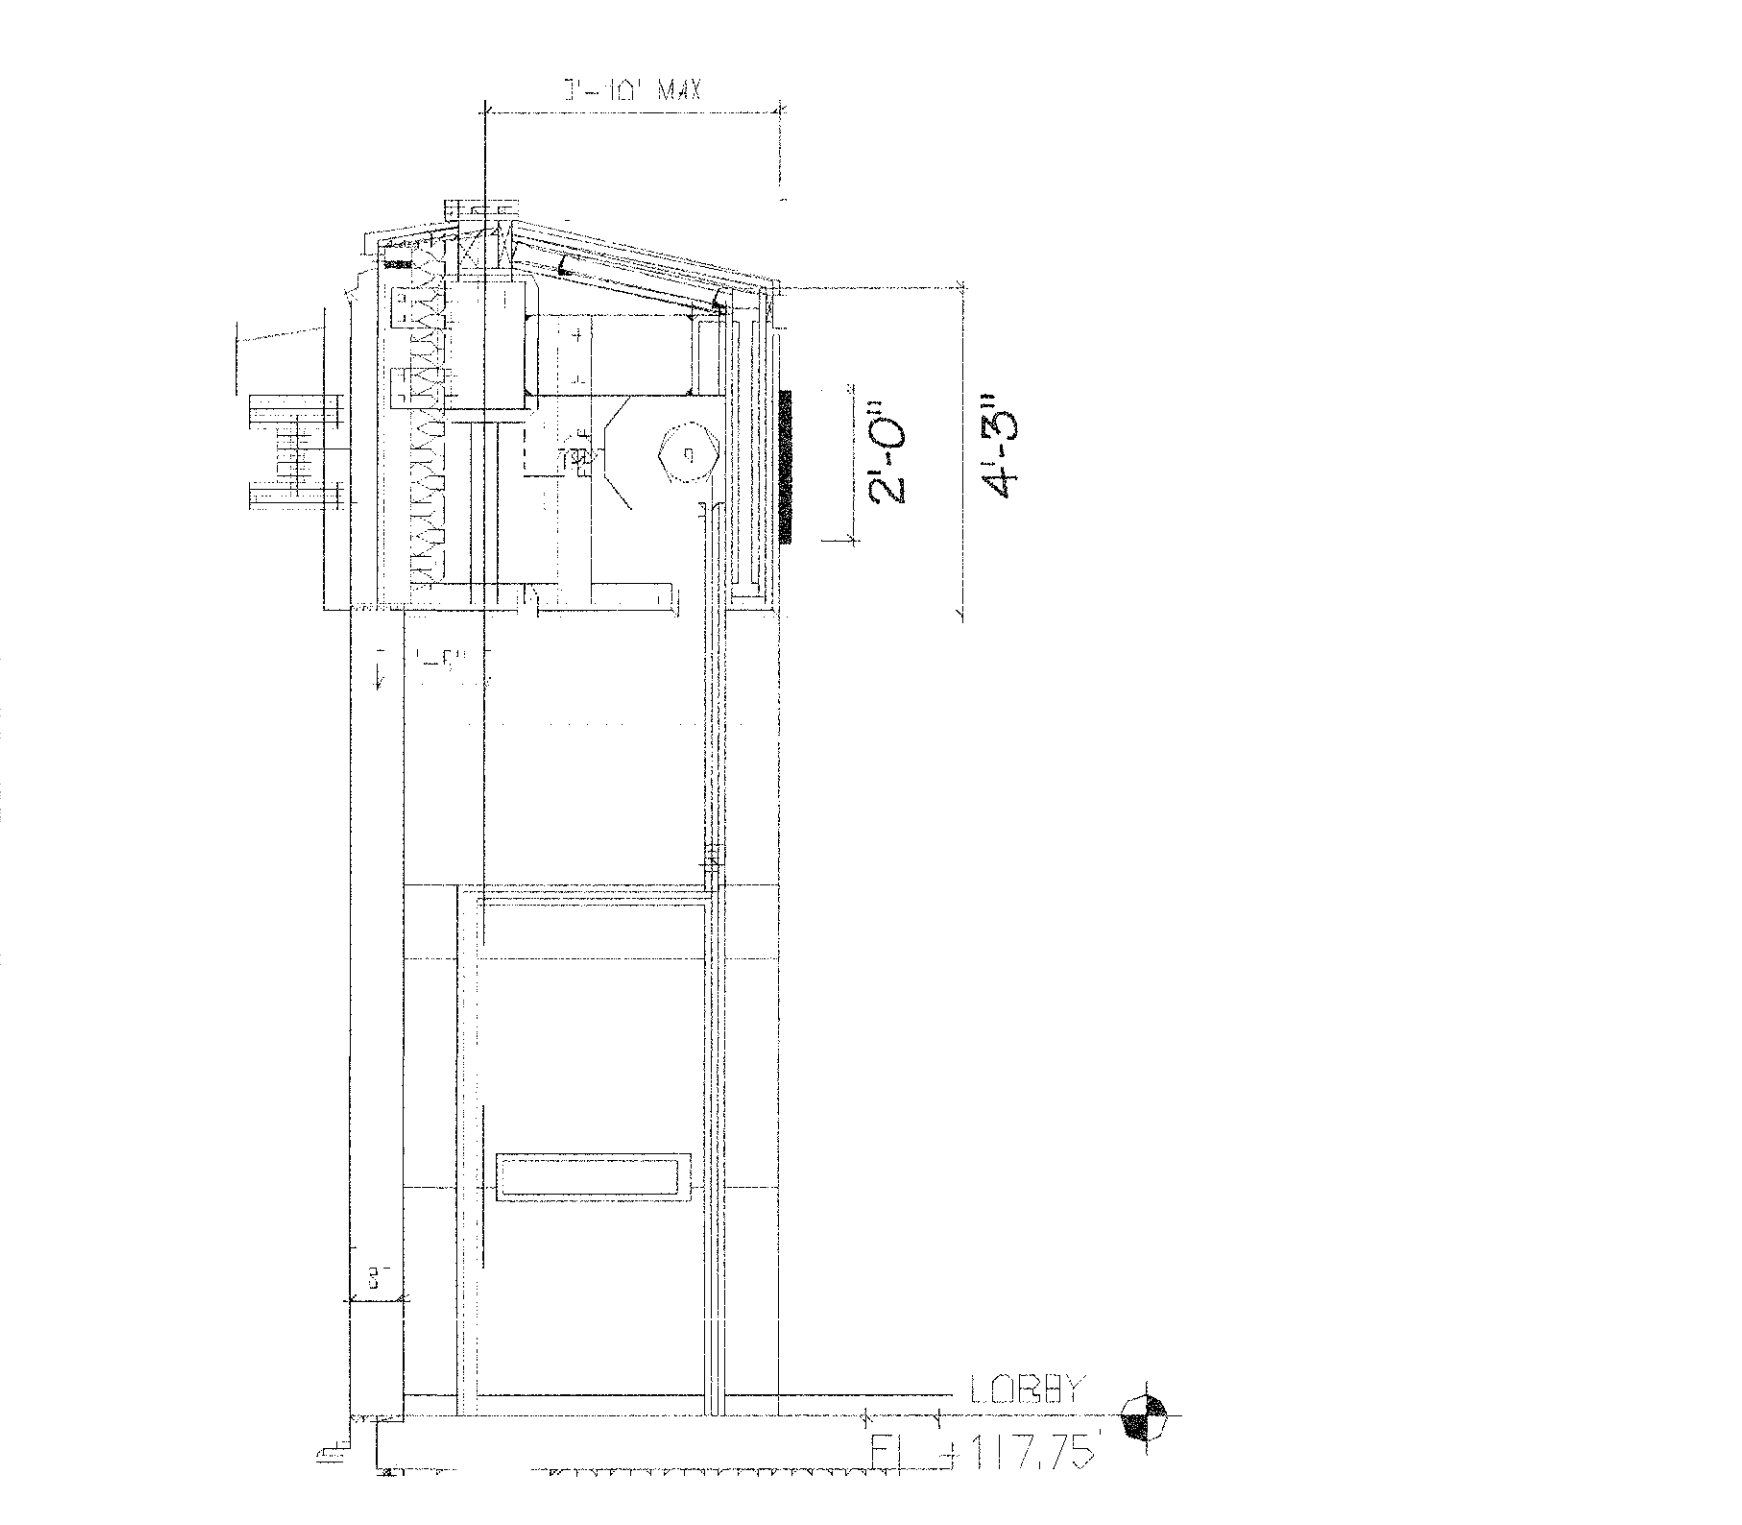


**6** SECTION/LAYOUT/Fascia Mounted Sign 10.2  
 SCALE: 1 1/2" = 1'-0"

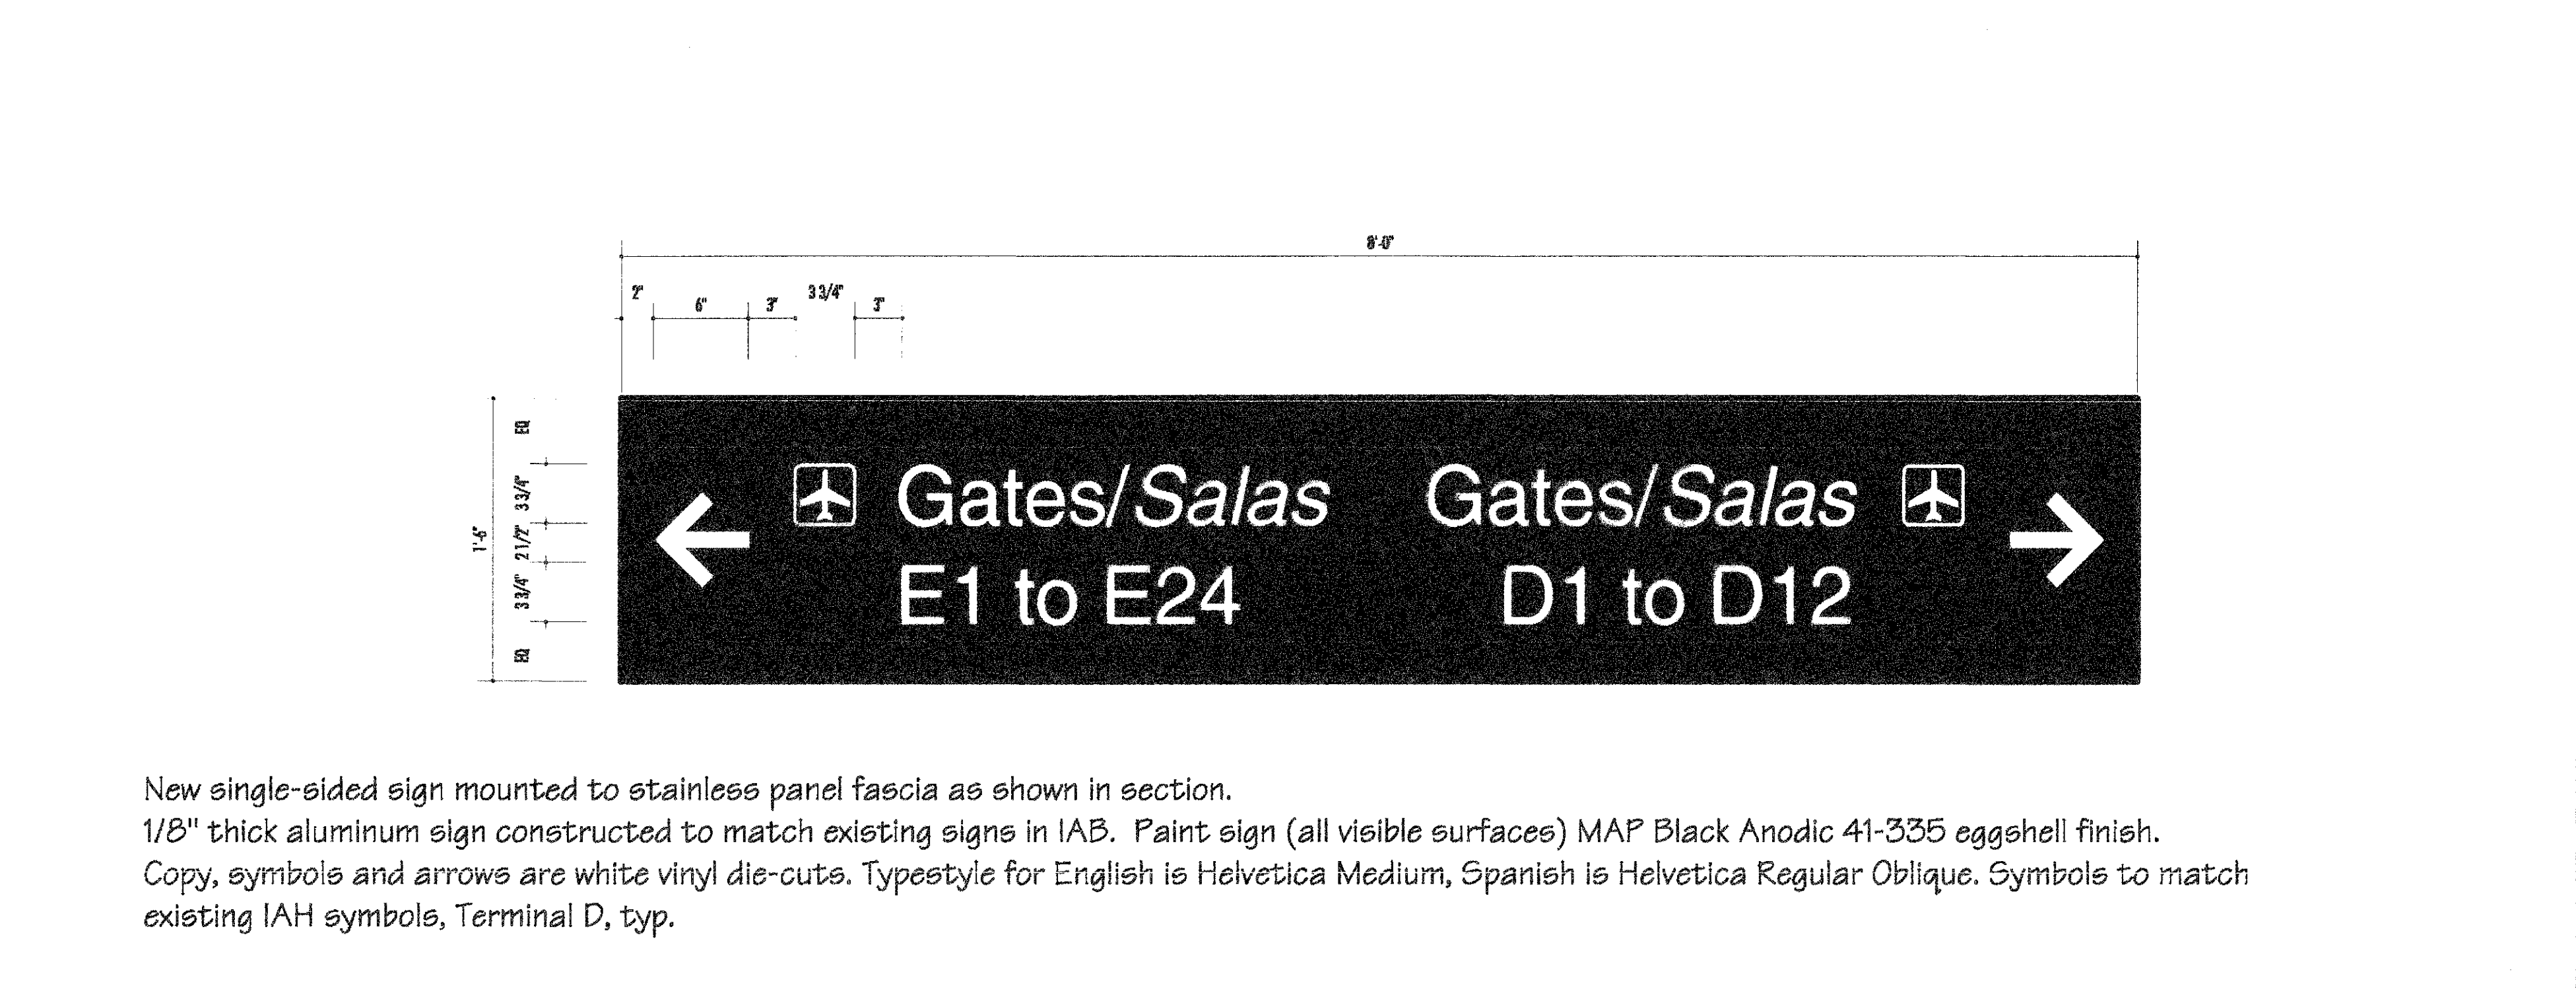

**6** SECTION/LAYOUT/Fascia Mounted Sign 10.2  
 SCALE: 1 1/2" = 1'-0"

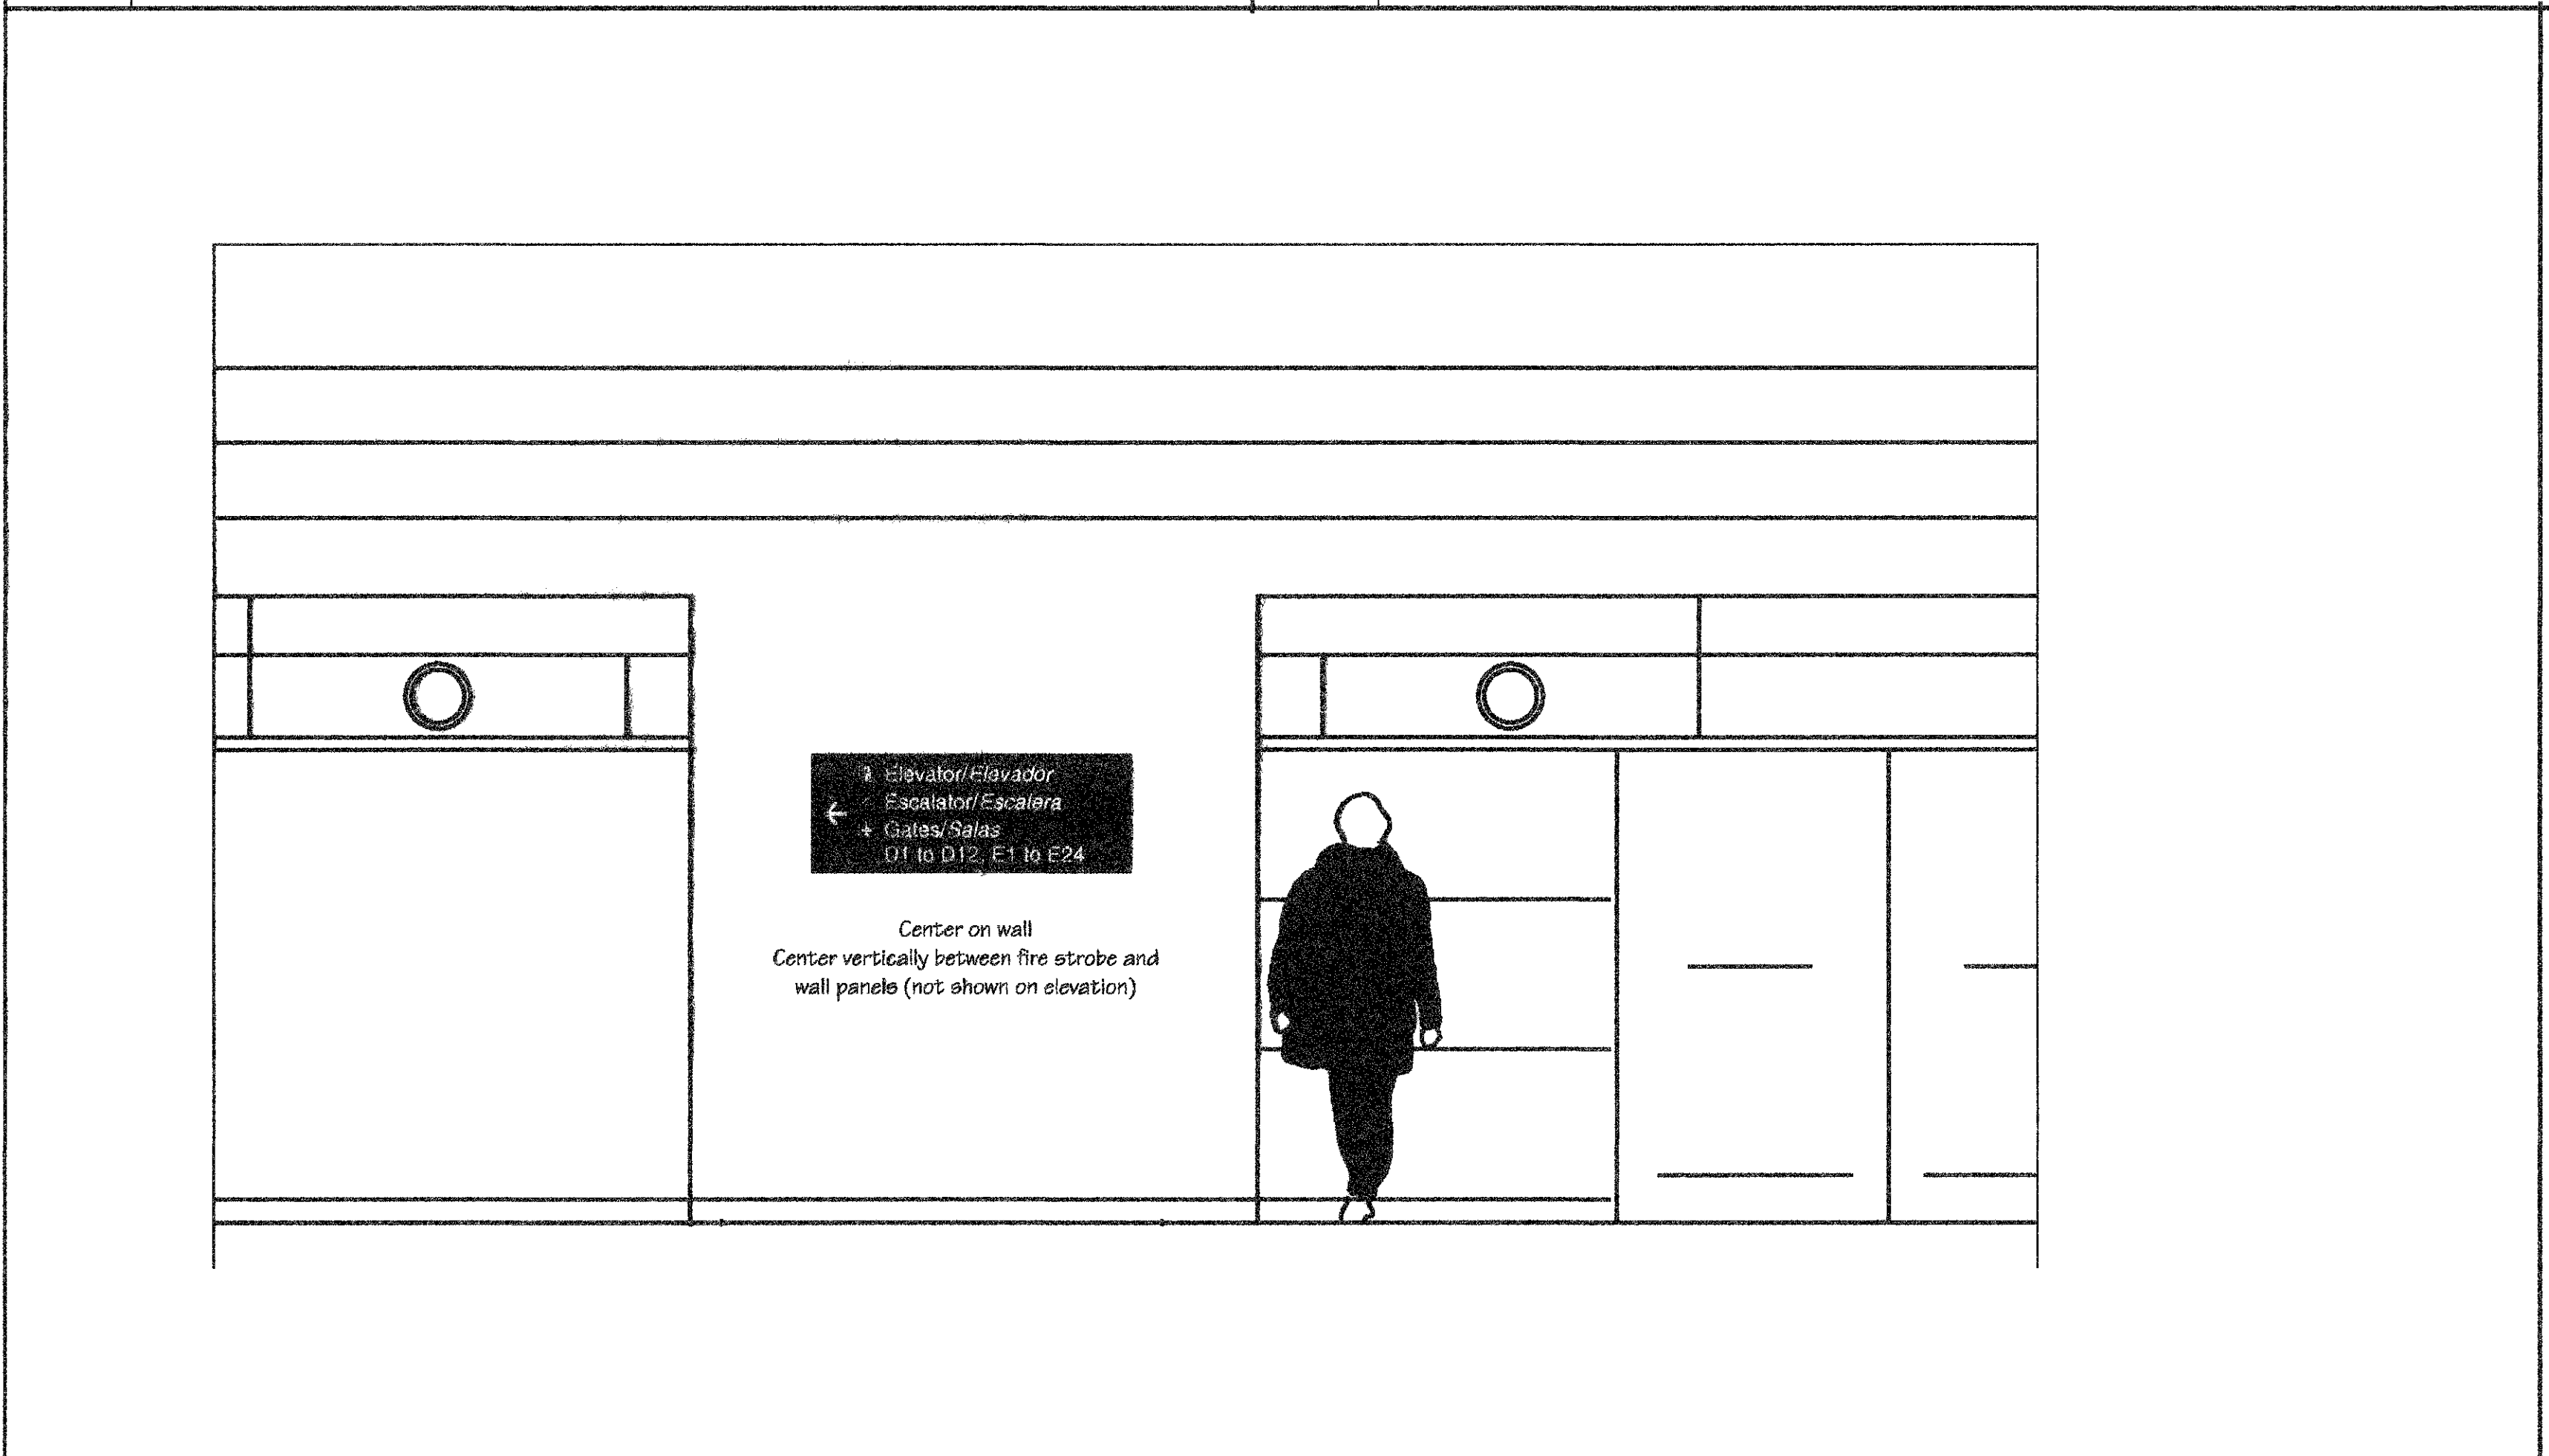

**7** ELEVATION - Sign 7.3, Wall mounted Directional  
 SCALE: NTS

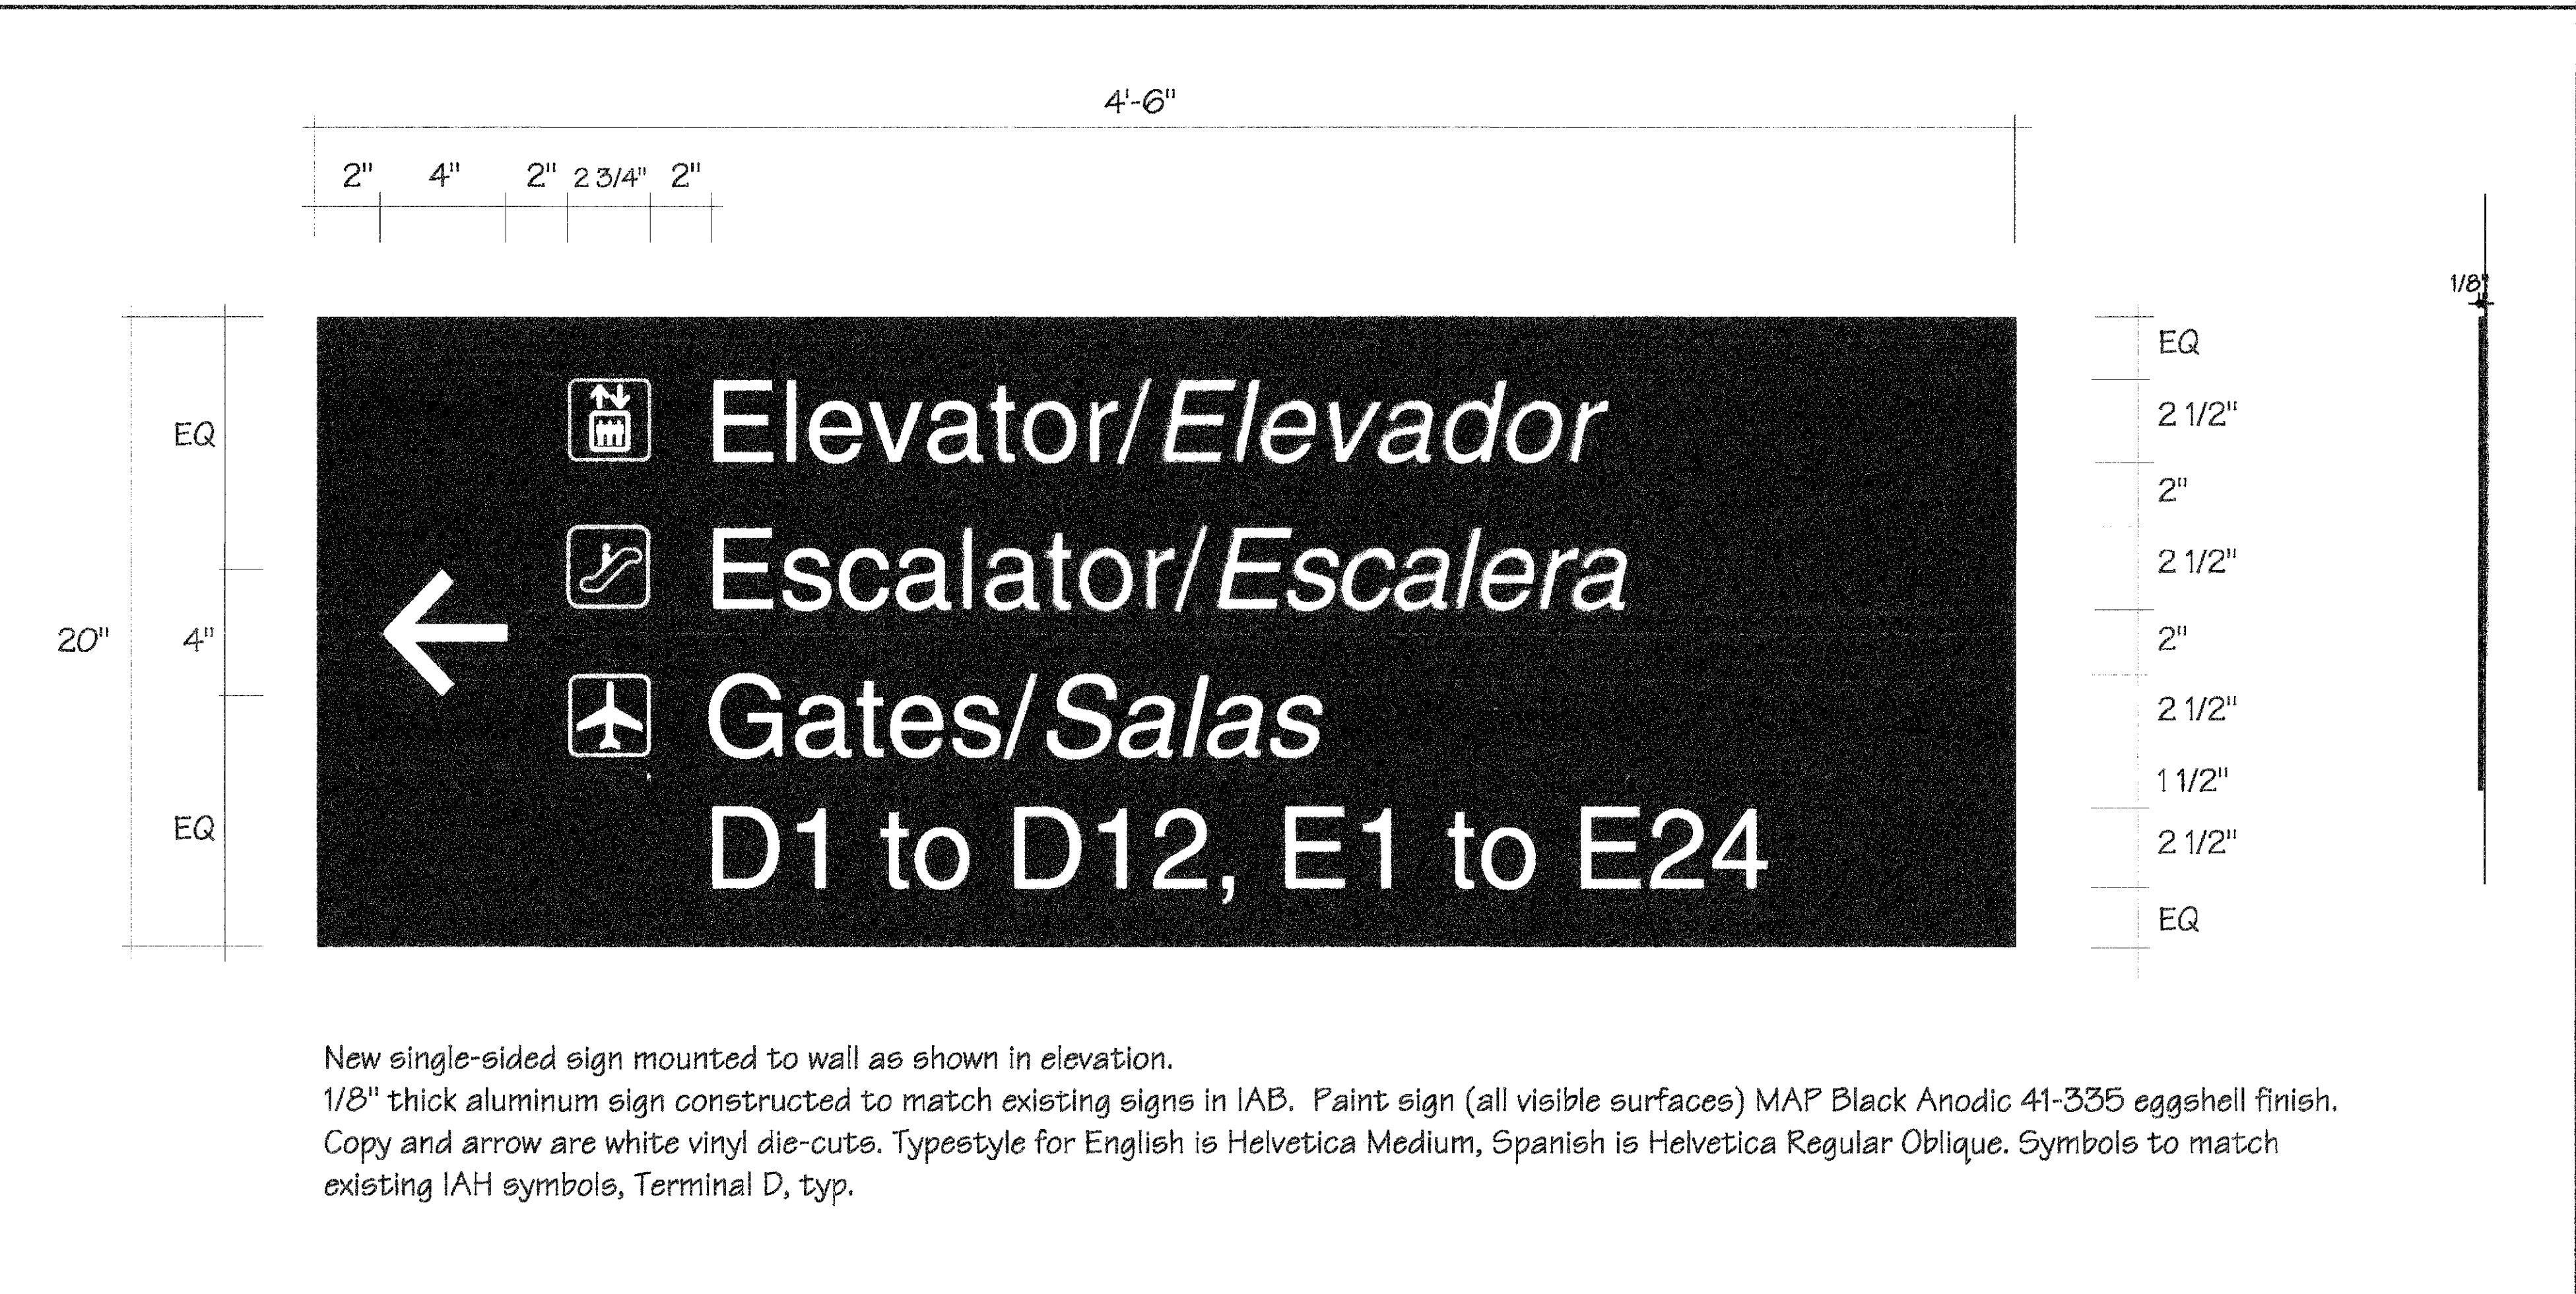

**8** LAYOUT - Sign 7.3, Wall mounted Directional \*(12.3 layout similar, opposite direction)  
 SCALE: 3" = 1'-0"



REVISIONS

NO.	DESCRIPTION	DATE	BY
Bulletin 54F		8/27/04	
Bulletin 54F.R1		12/09/04	
Record Drawings		4/29/05	


RECORD DRAWINGS  
 DO NOT MODIFY  
 Date: 4/29/05  
 Morris Architects

Note: Information used to develop these documents was taken from records of the work drawings prepared by the construction contractor. Inter-United, the information provided was not verified by the design firm named above.

INTERNATIONAL SERVICES EXPANSION PROGRAM  
**APM STATION & PLATFORM**  
 SIGNFACE LAYOUTS 2



PROJECT MGR:	SC
DESIGNER:	SC
DRAWN BY:	SC
CHECKED BY:	SC
DRAWING REVIEWER:	

SCALE: NTS  
 DATE: 9/29/04

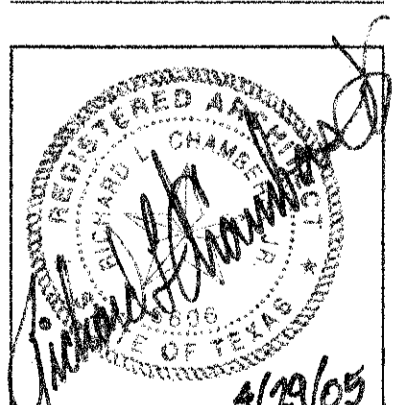

APPROVED BY:	DATE:
DIRECTOR:	PROJECT NO.:
PROJECT NO.:	DATE:
CIP NO.:	DATE:
I.A.S. NO.:	DATE:
SHEET NO.:	DATE:


**G1.004**

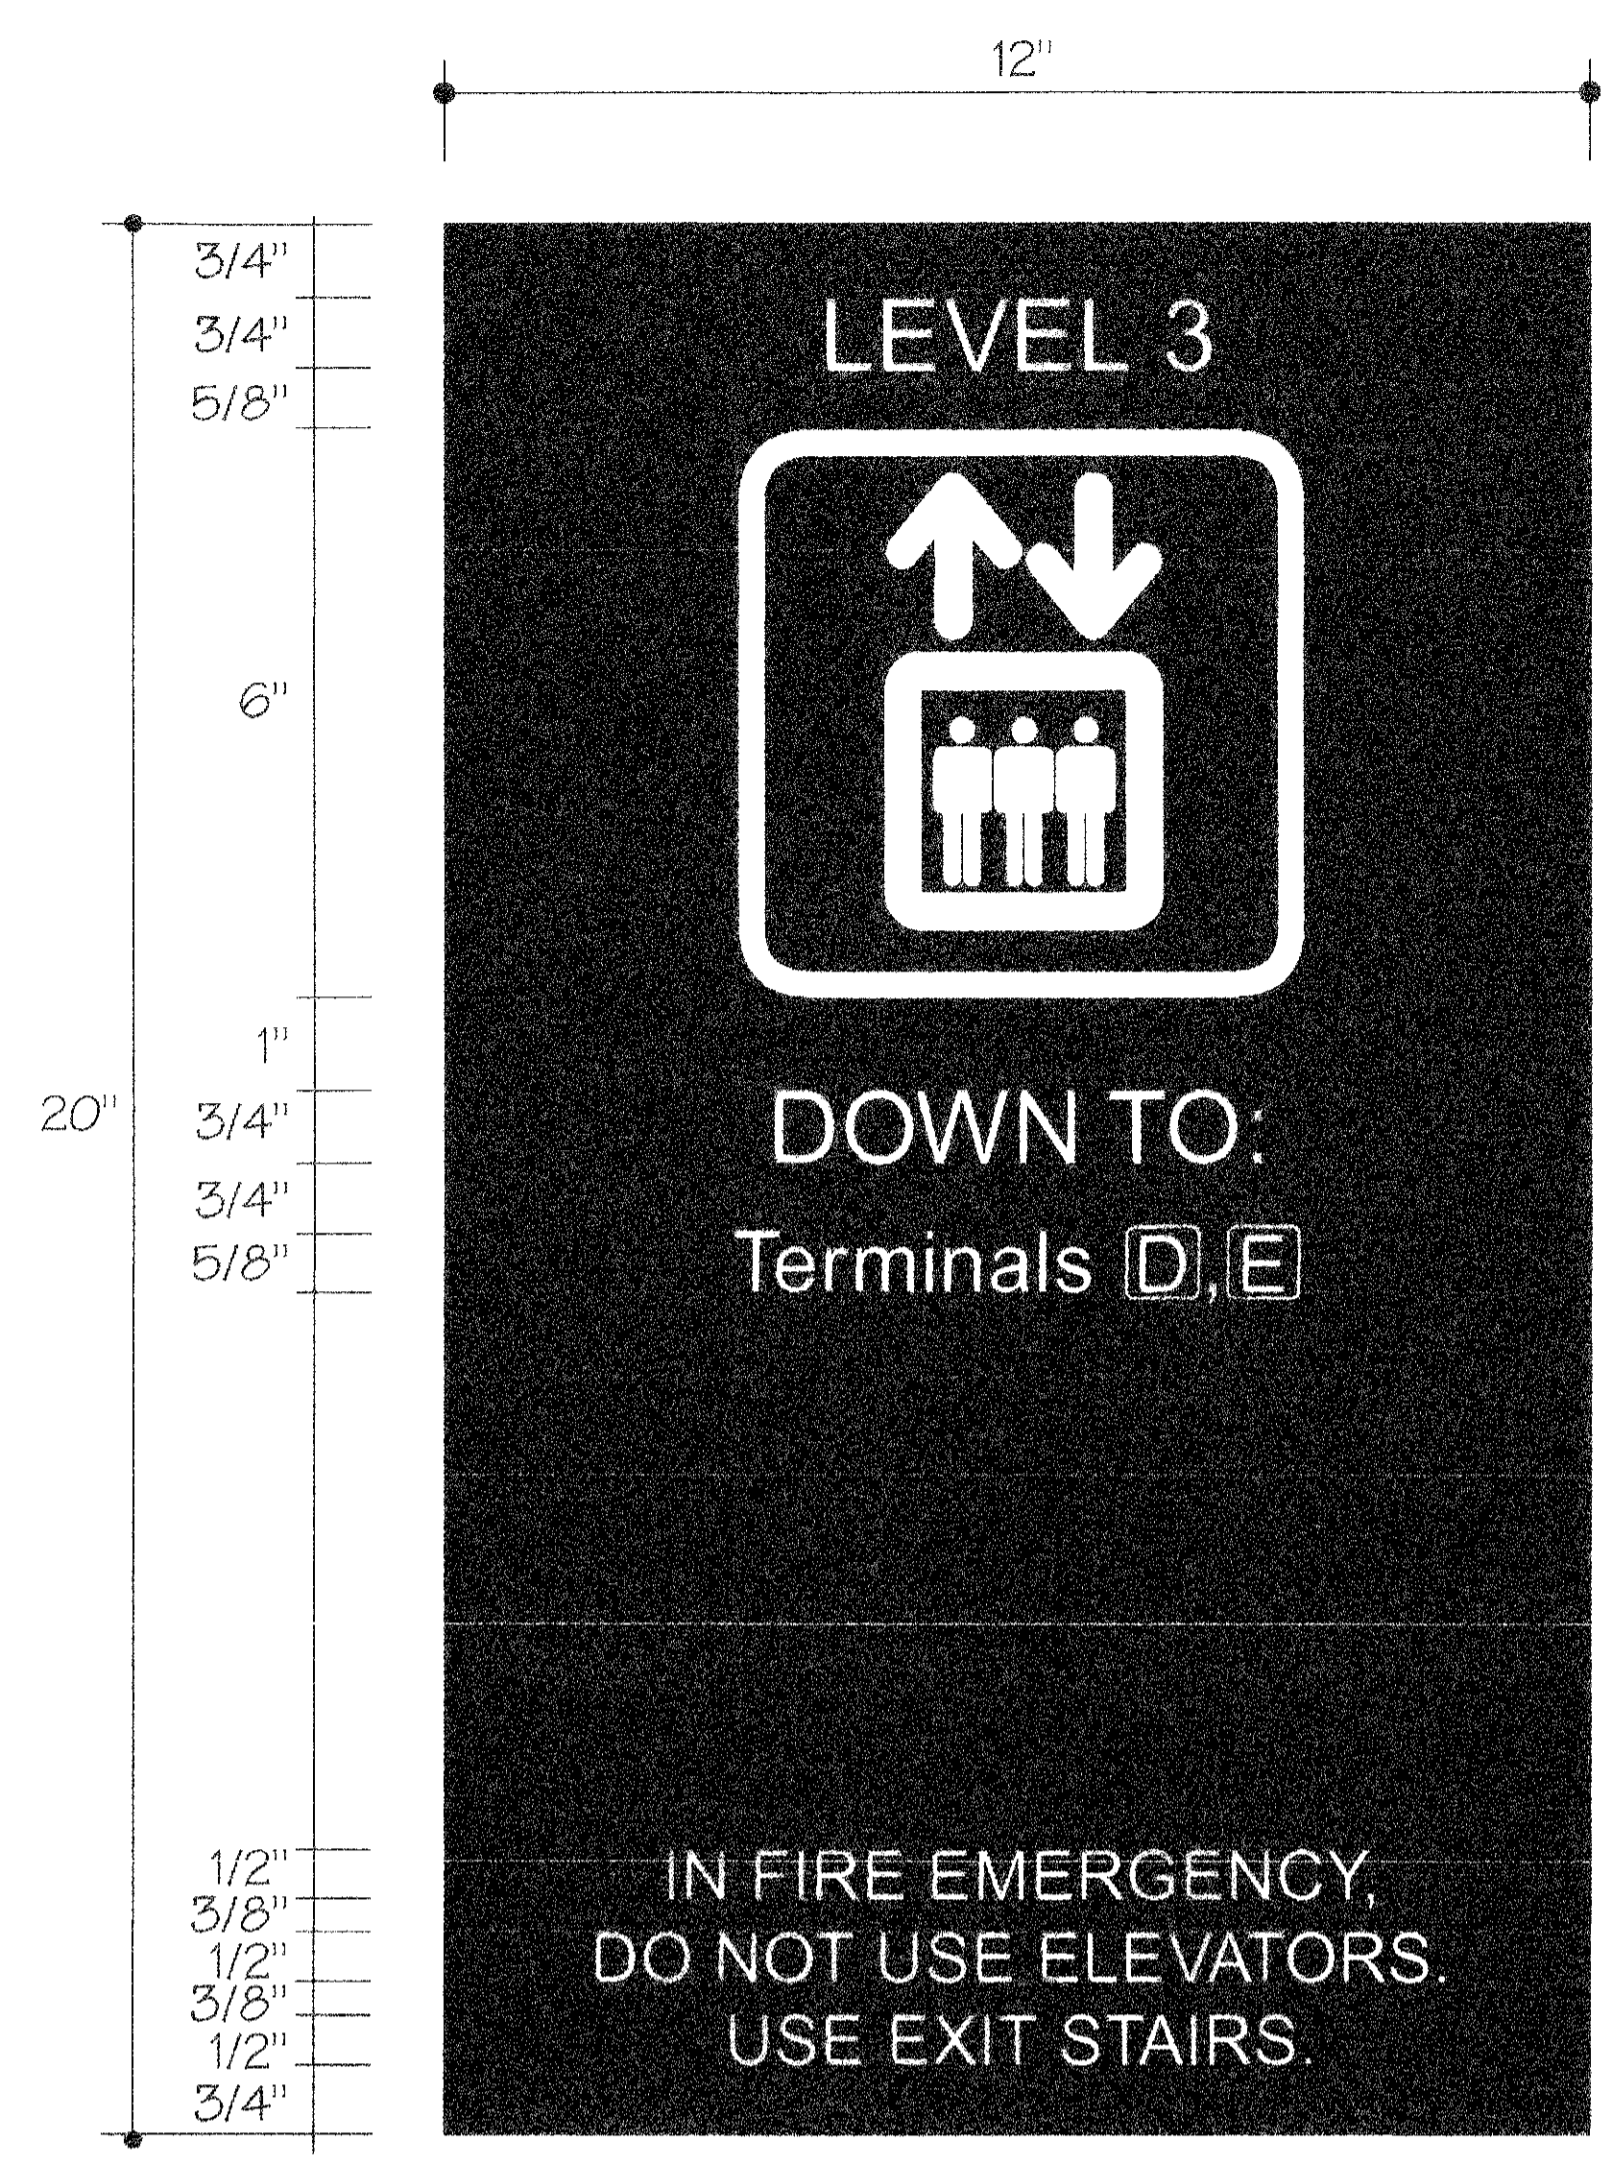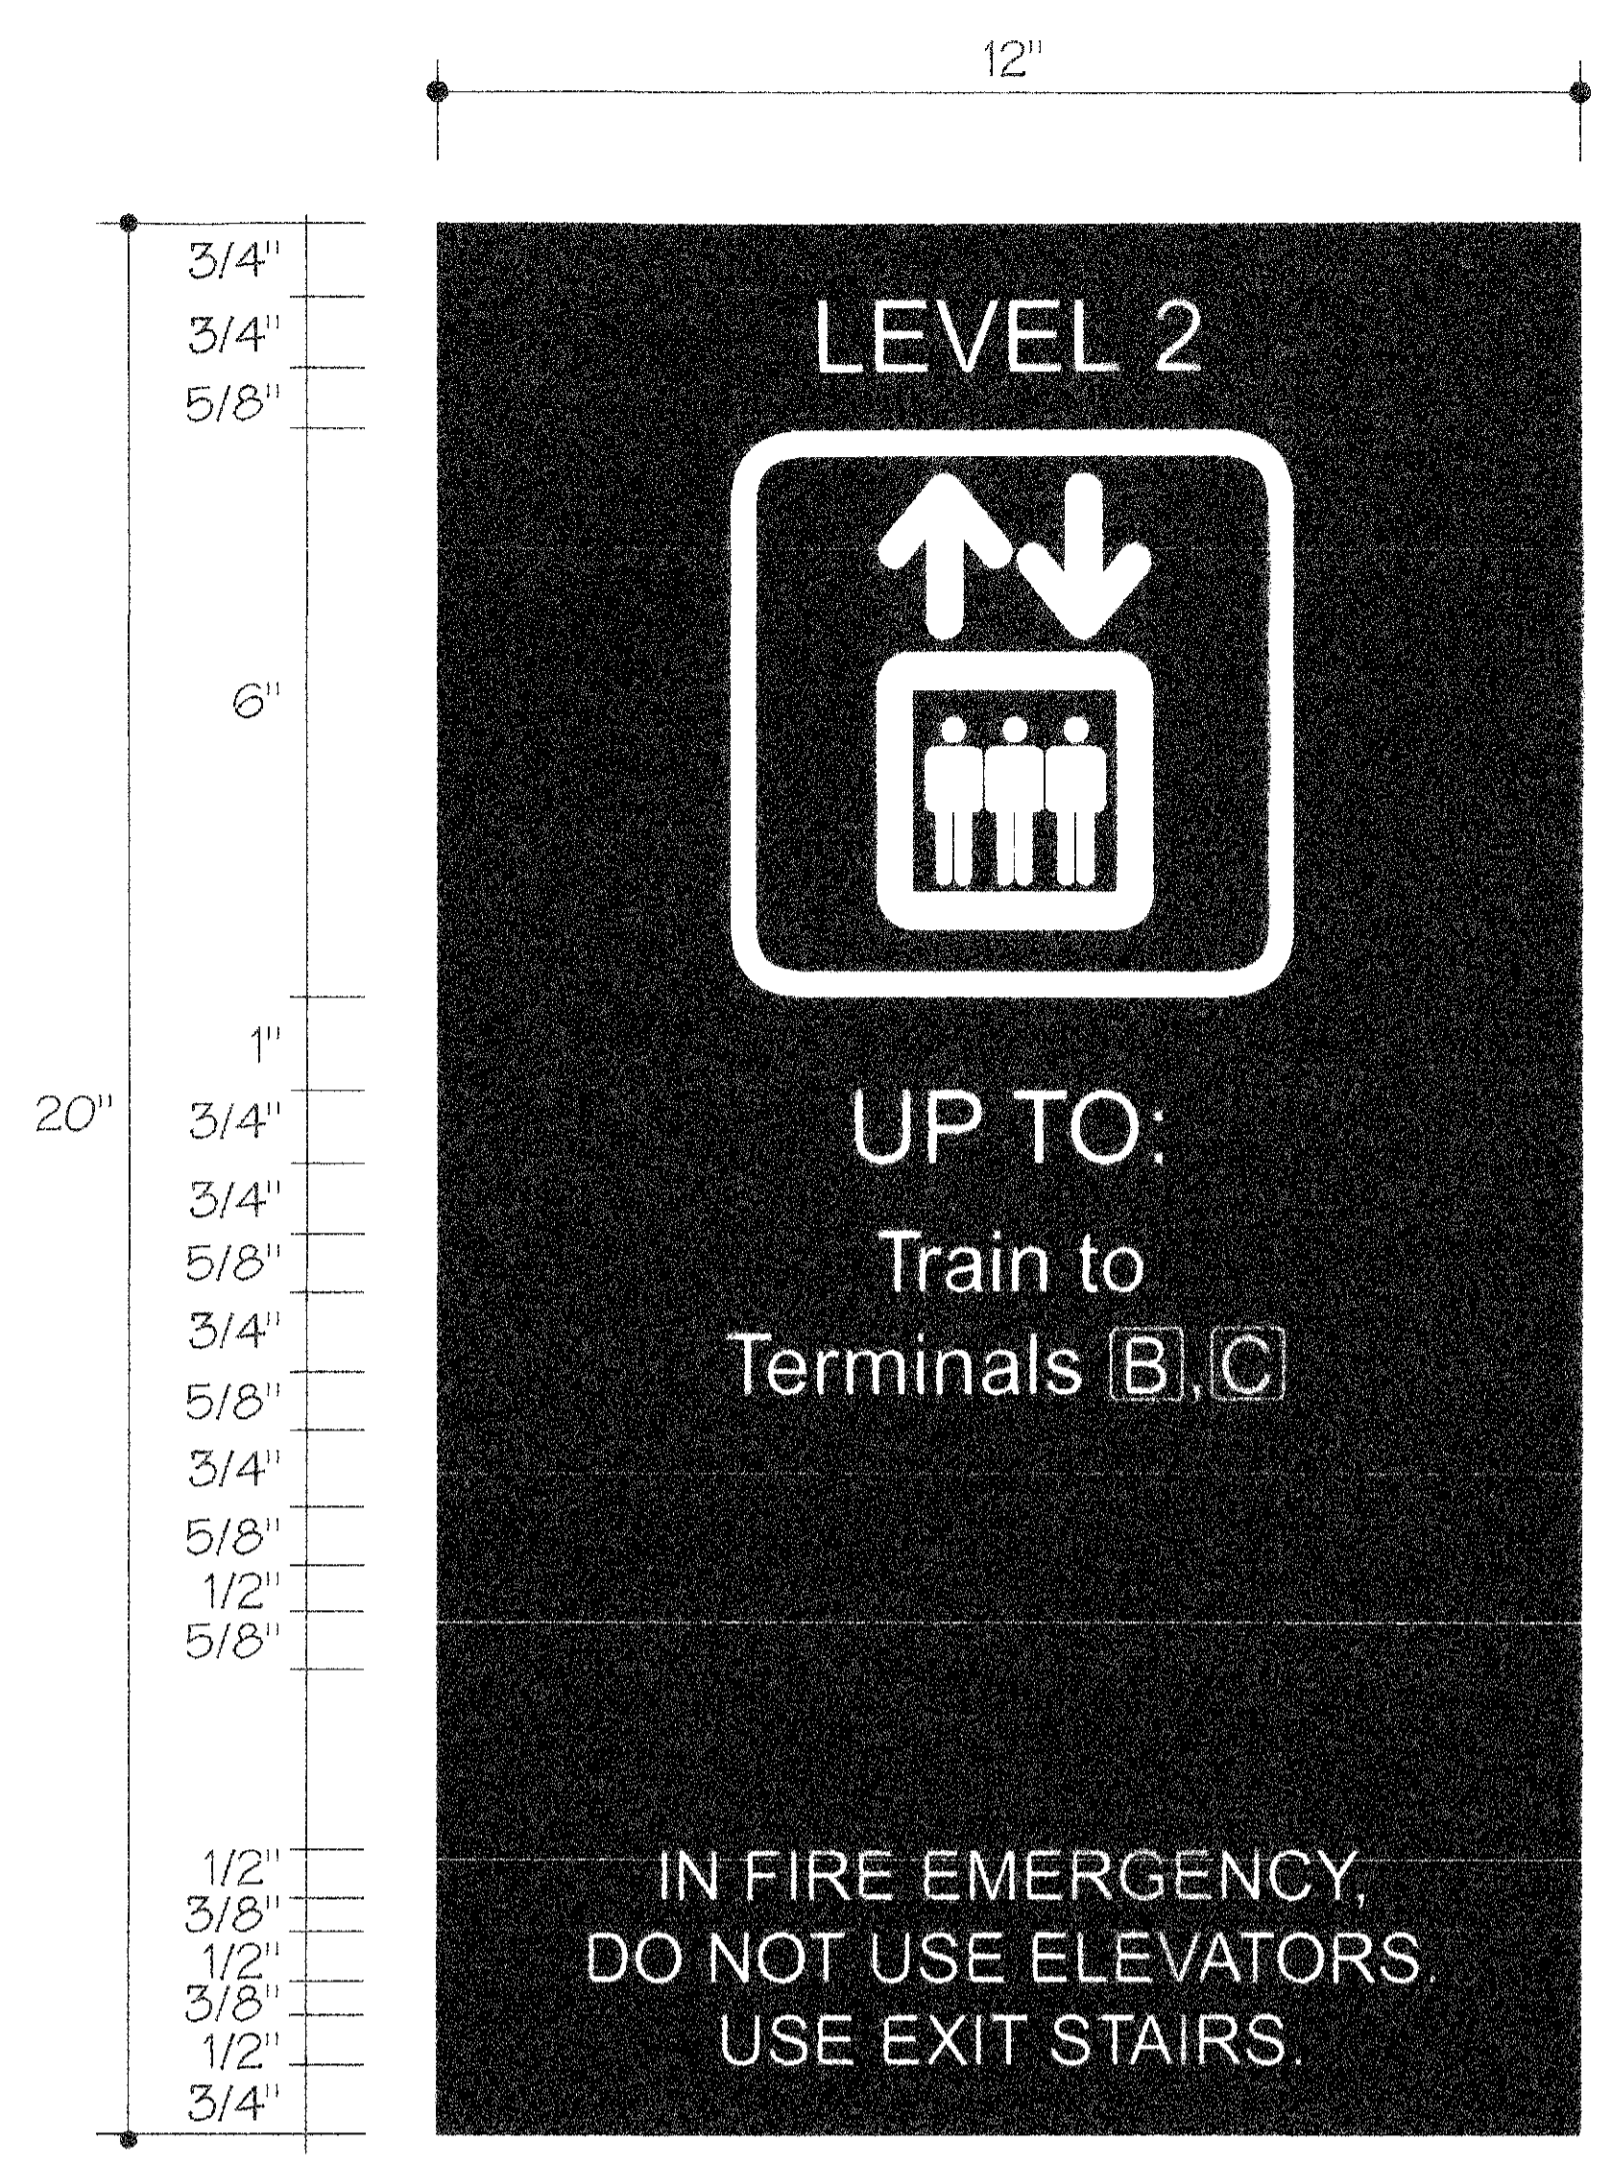

Existing wall



0.125" thick aluminum substrate painted black to match sign face - MAP Black Anodic 41-335 eggshell finish.

Symbol and text to be silkscreened  
 Copy Color to be white

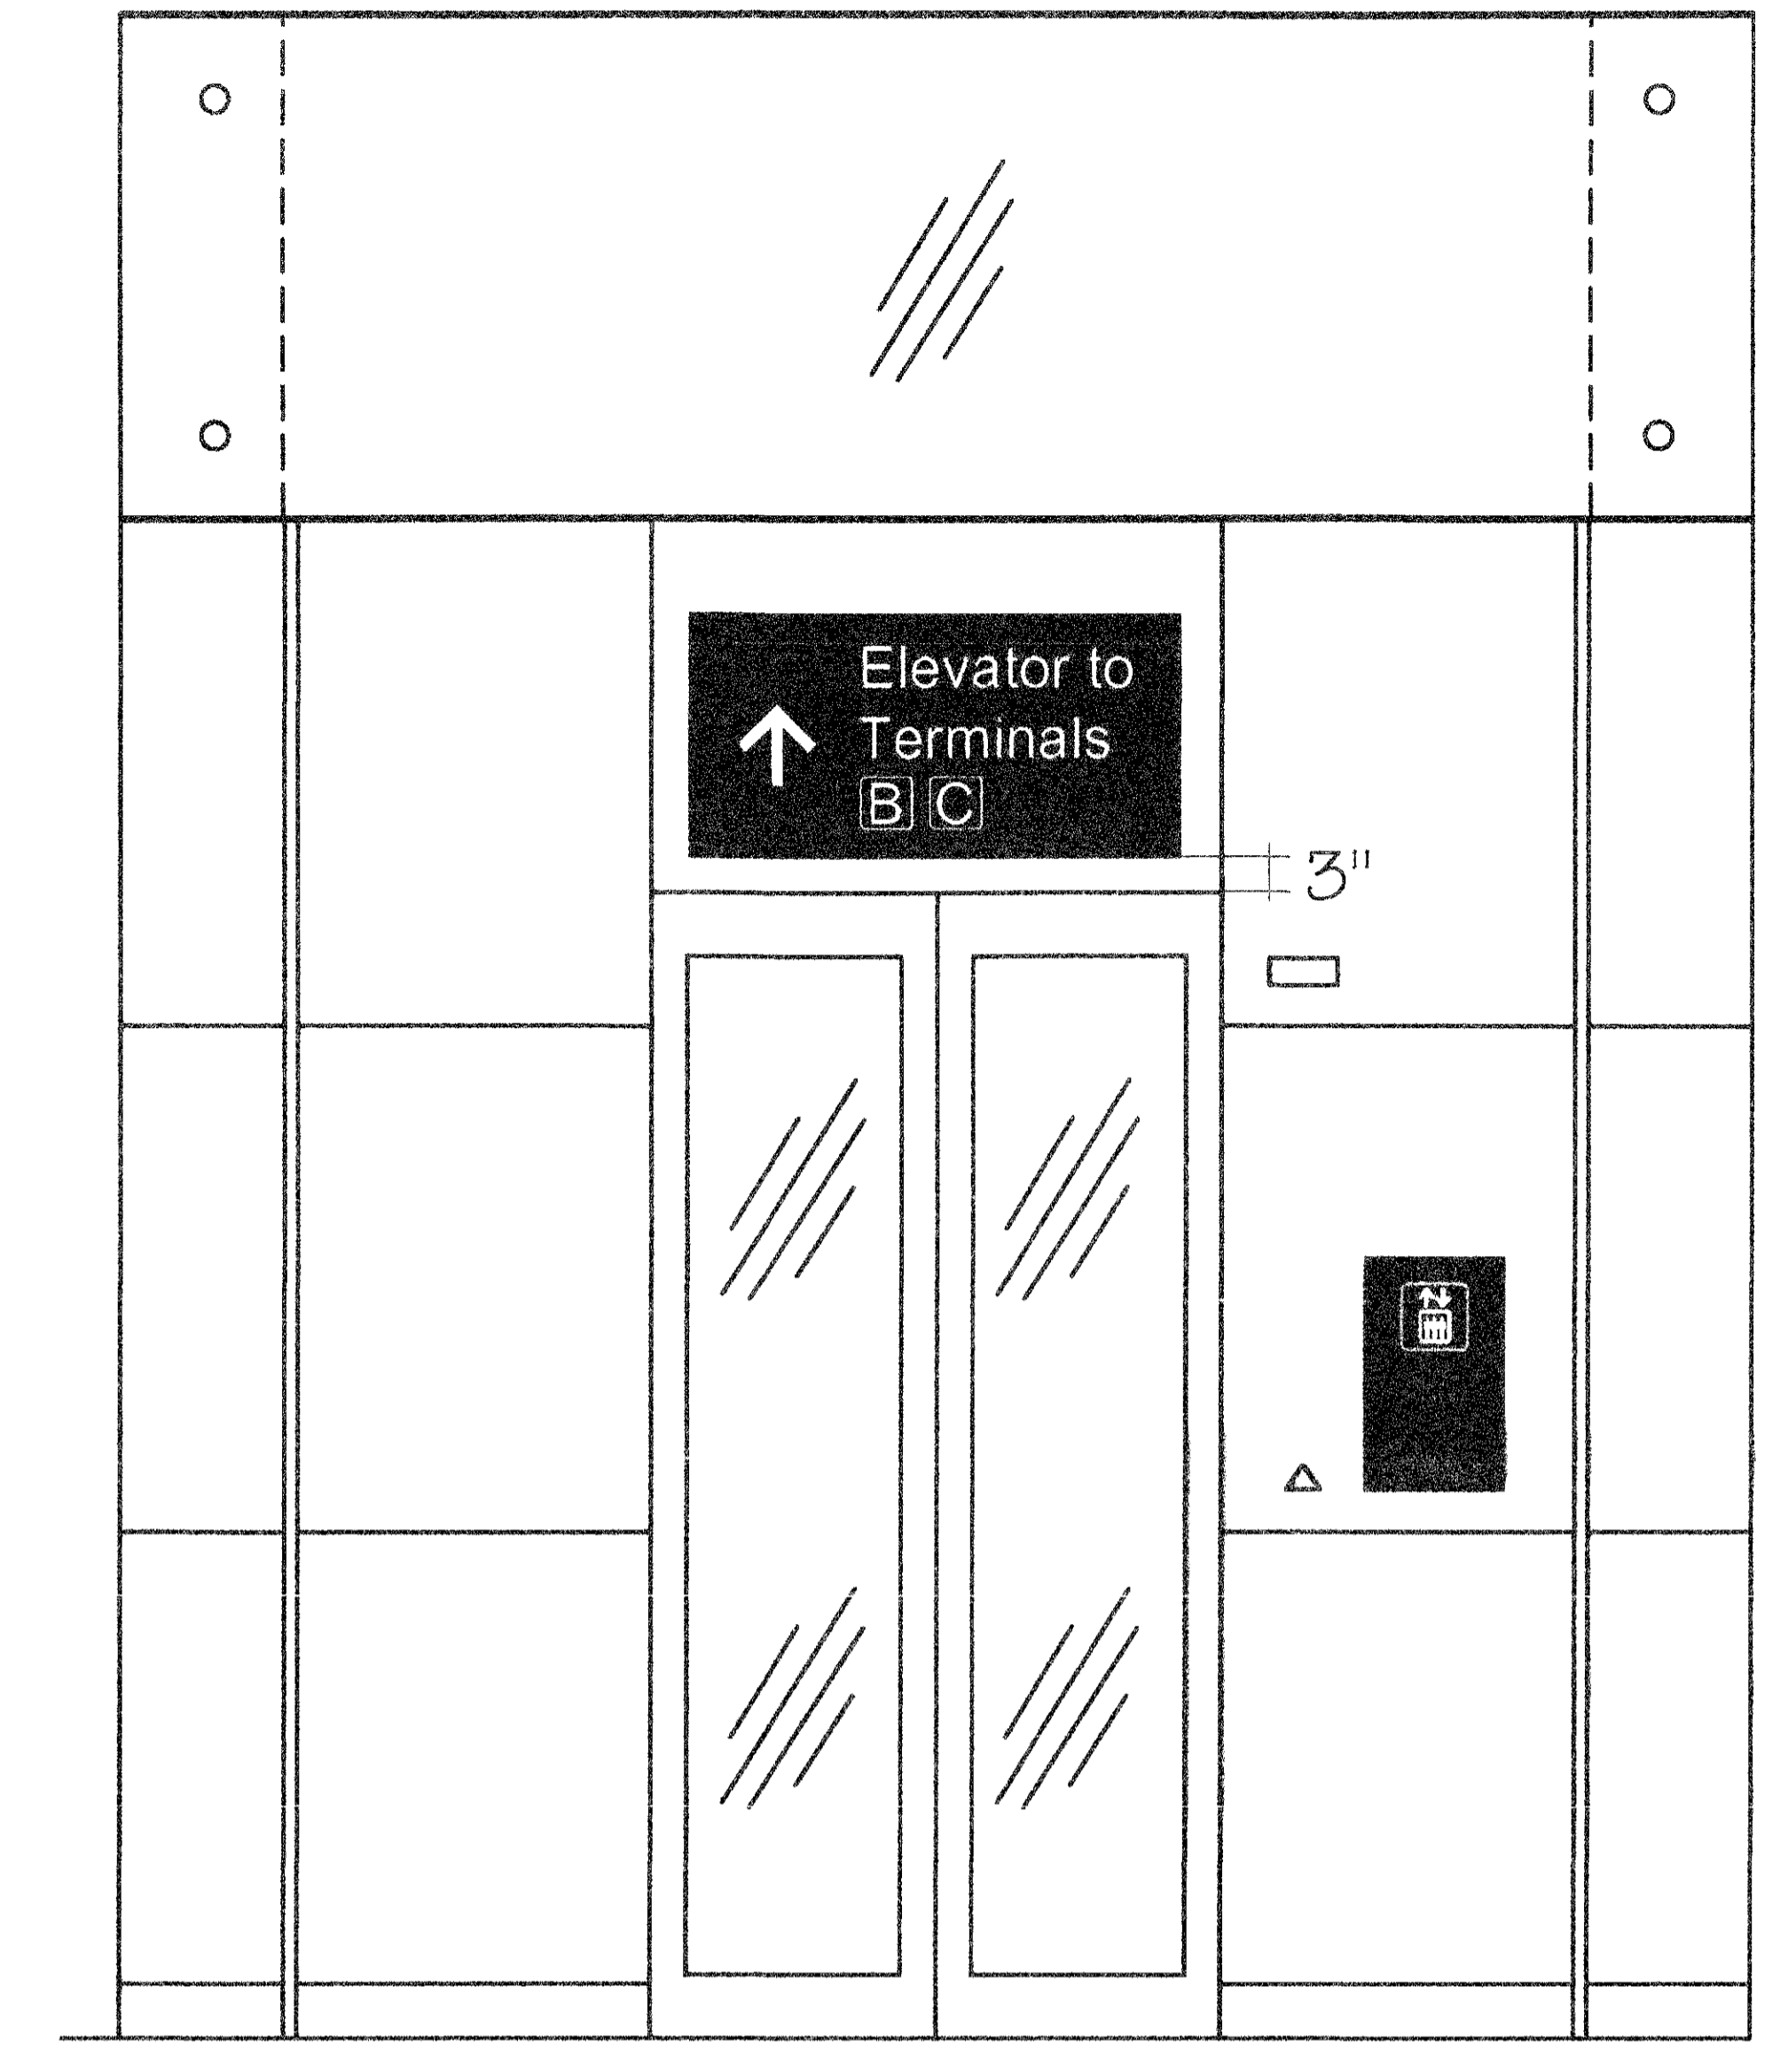


**1** LAYOUT - Elevator Egress Signs 1.2, 2.3  
 SCALE: 3" = 1'-0"

**2** ELEVATION - Elevators  
 SCALE: NTS

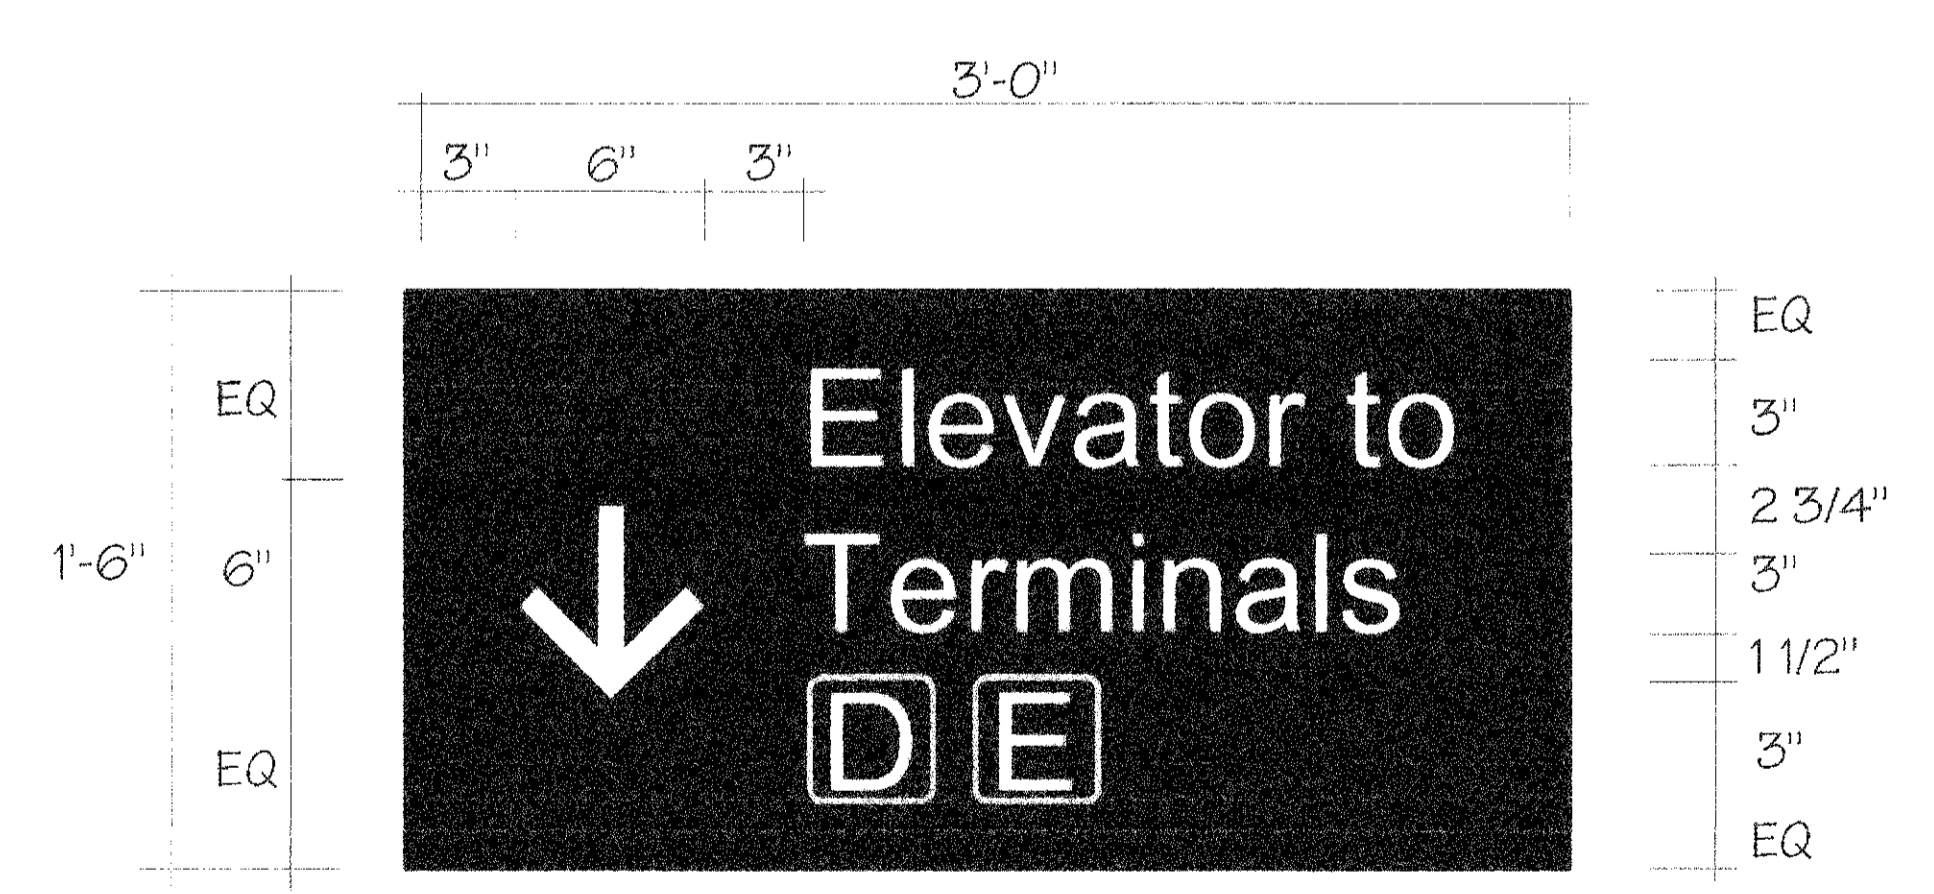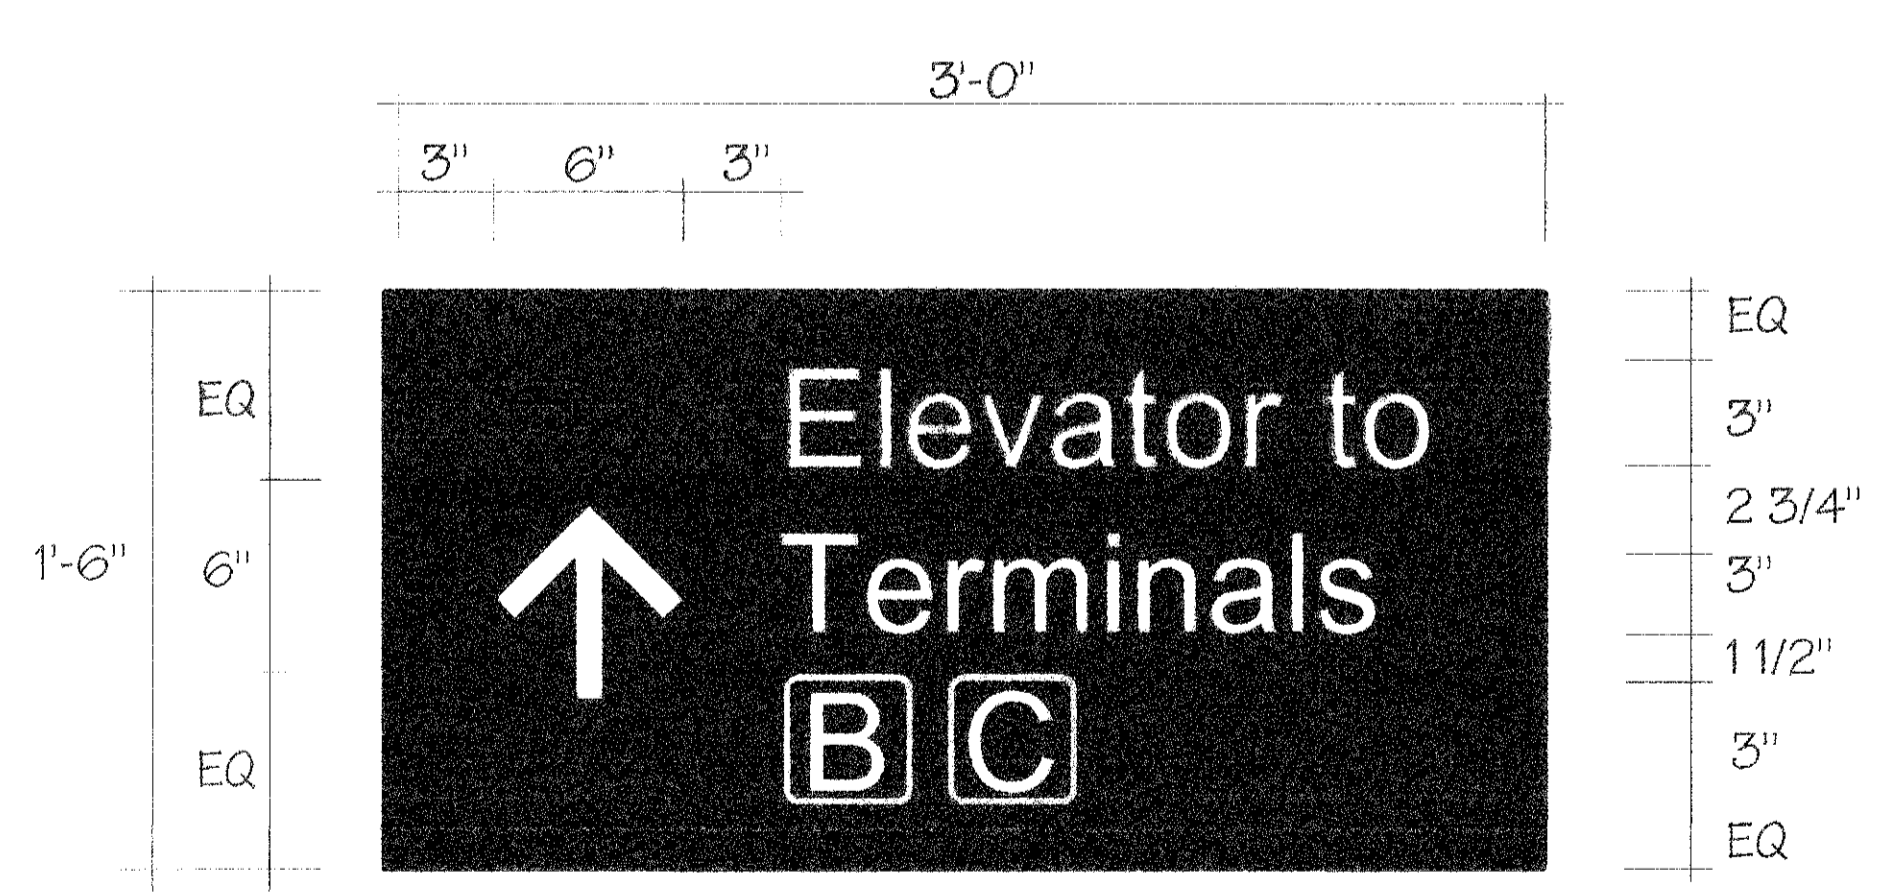

9.2 New single-sided sign mounted to glass above elevator doors. 1/8" thick aluminum sign constructed to match existing signs in IAB. Paint sign MAP Black Anodic 41-335 eggshell finish. Copy, arrow and symbols are white vinyl die-cuts. Typestyle for English is Helvetica Medium. Symbols to match existing IAH symbols, Terminal D, typ.

2.3 New single-sided sign mounted to glass above elevator doors. 1/8" thick aluminum sign constructed to match existing signs in IAB. Paint sign MAP Black Anodic 41-335 eggshell finish. Copy, arrow and symbols are white vinyl die-cuts. Typestyle for English is Helvetica Medium. Symbols to match existing IAH symbols, Terminal D, typ.

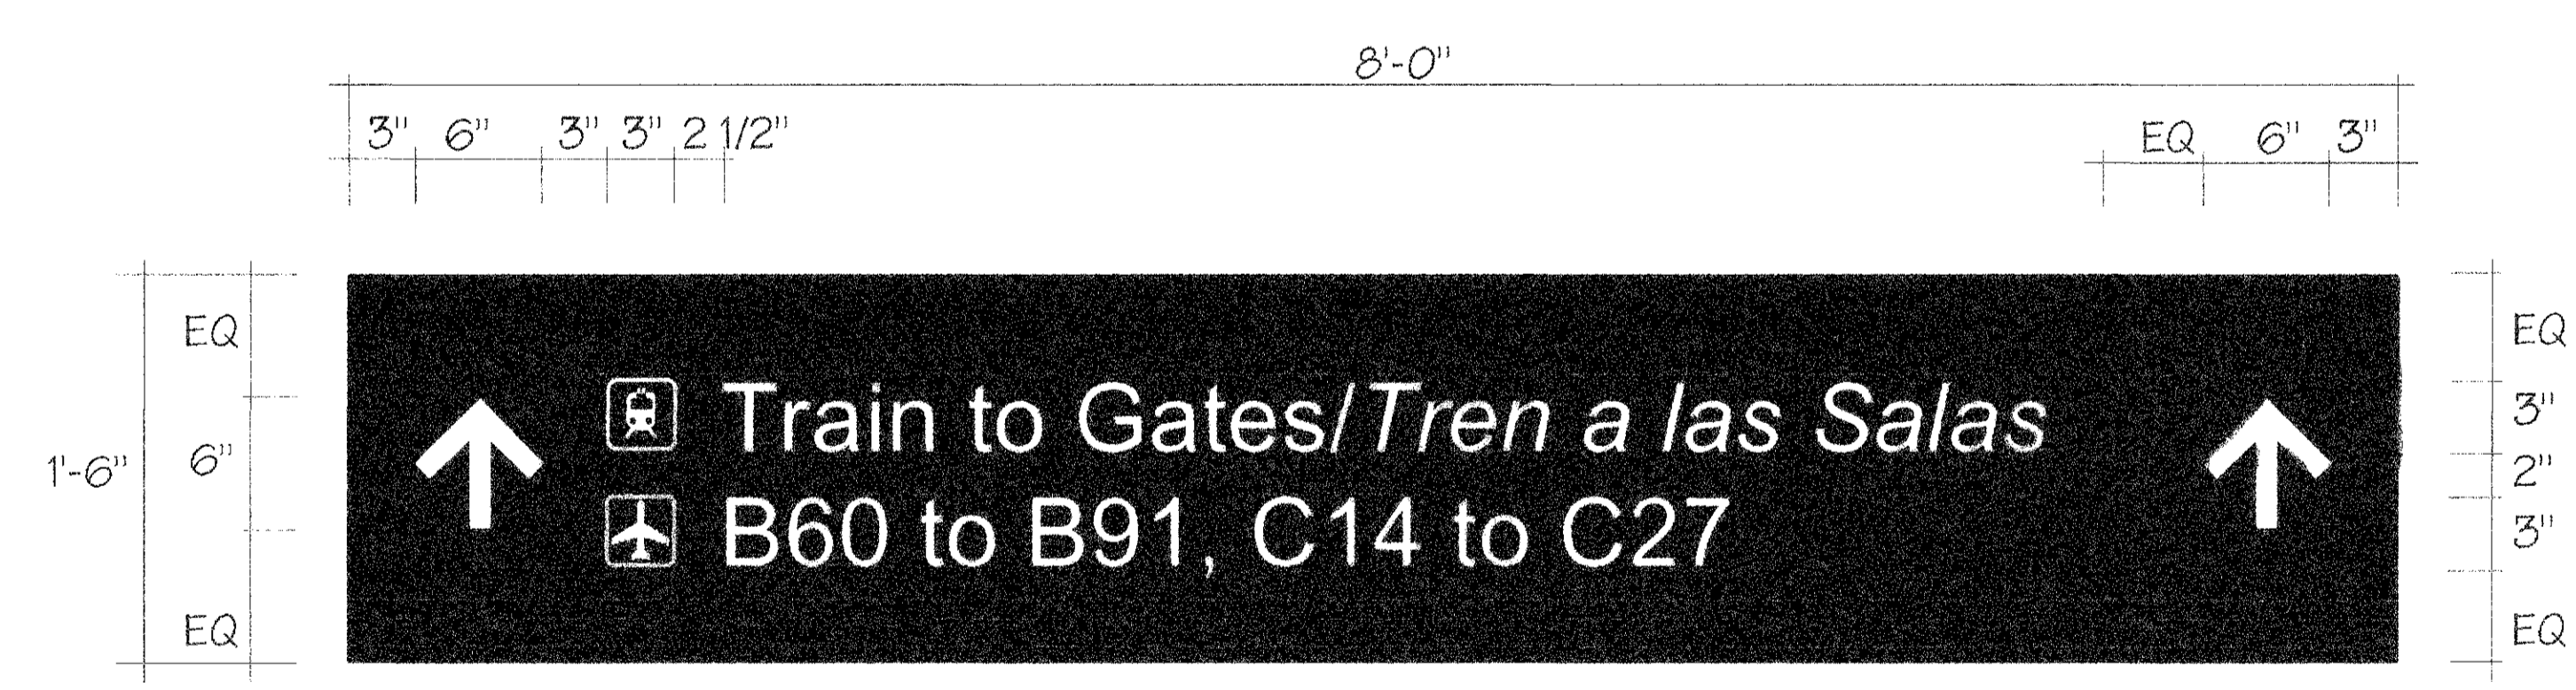

Sign 3.3, Side A




Sign 3.3, Side B

Fabrication details match 2.2, 3.2; mounting detail matches 4.3.


**3** LAYOUT/ELEVATION- Elevator Overhead Signs 9.2, 2.3  
 SCALE: NTS

**4** ELEVATION - Overhead Sign 3.3  
 1 1/2" = 1'-0"




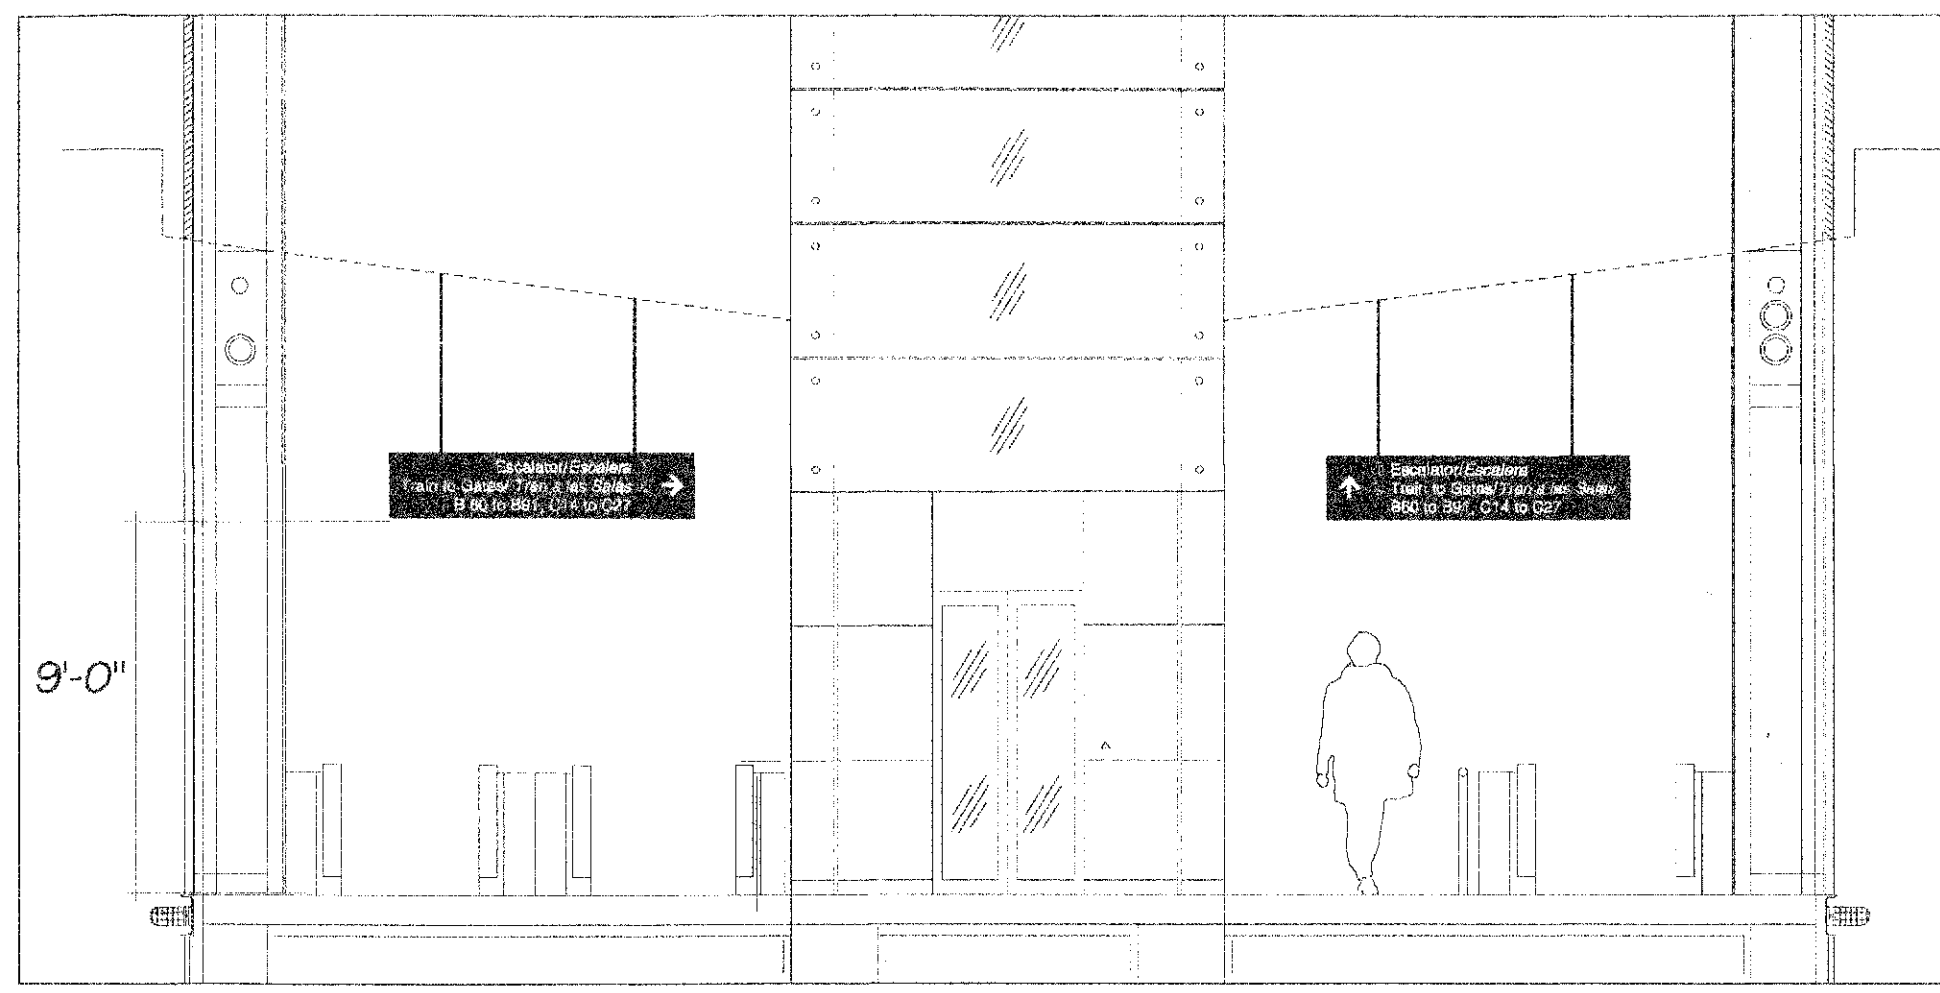


**1** ELEVATION - Overhead Signs 2.2 and 3.2  
SCALE: NTS

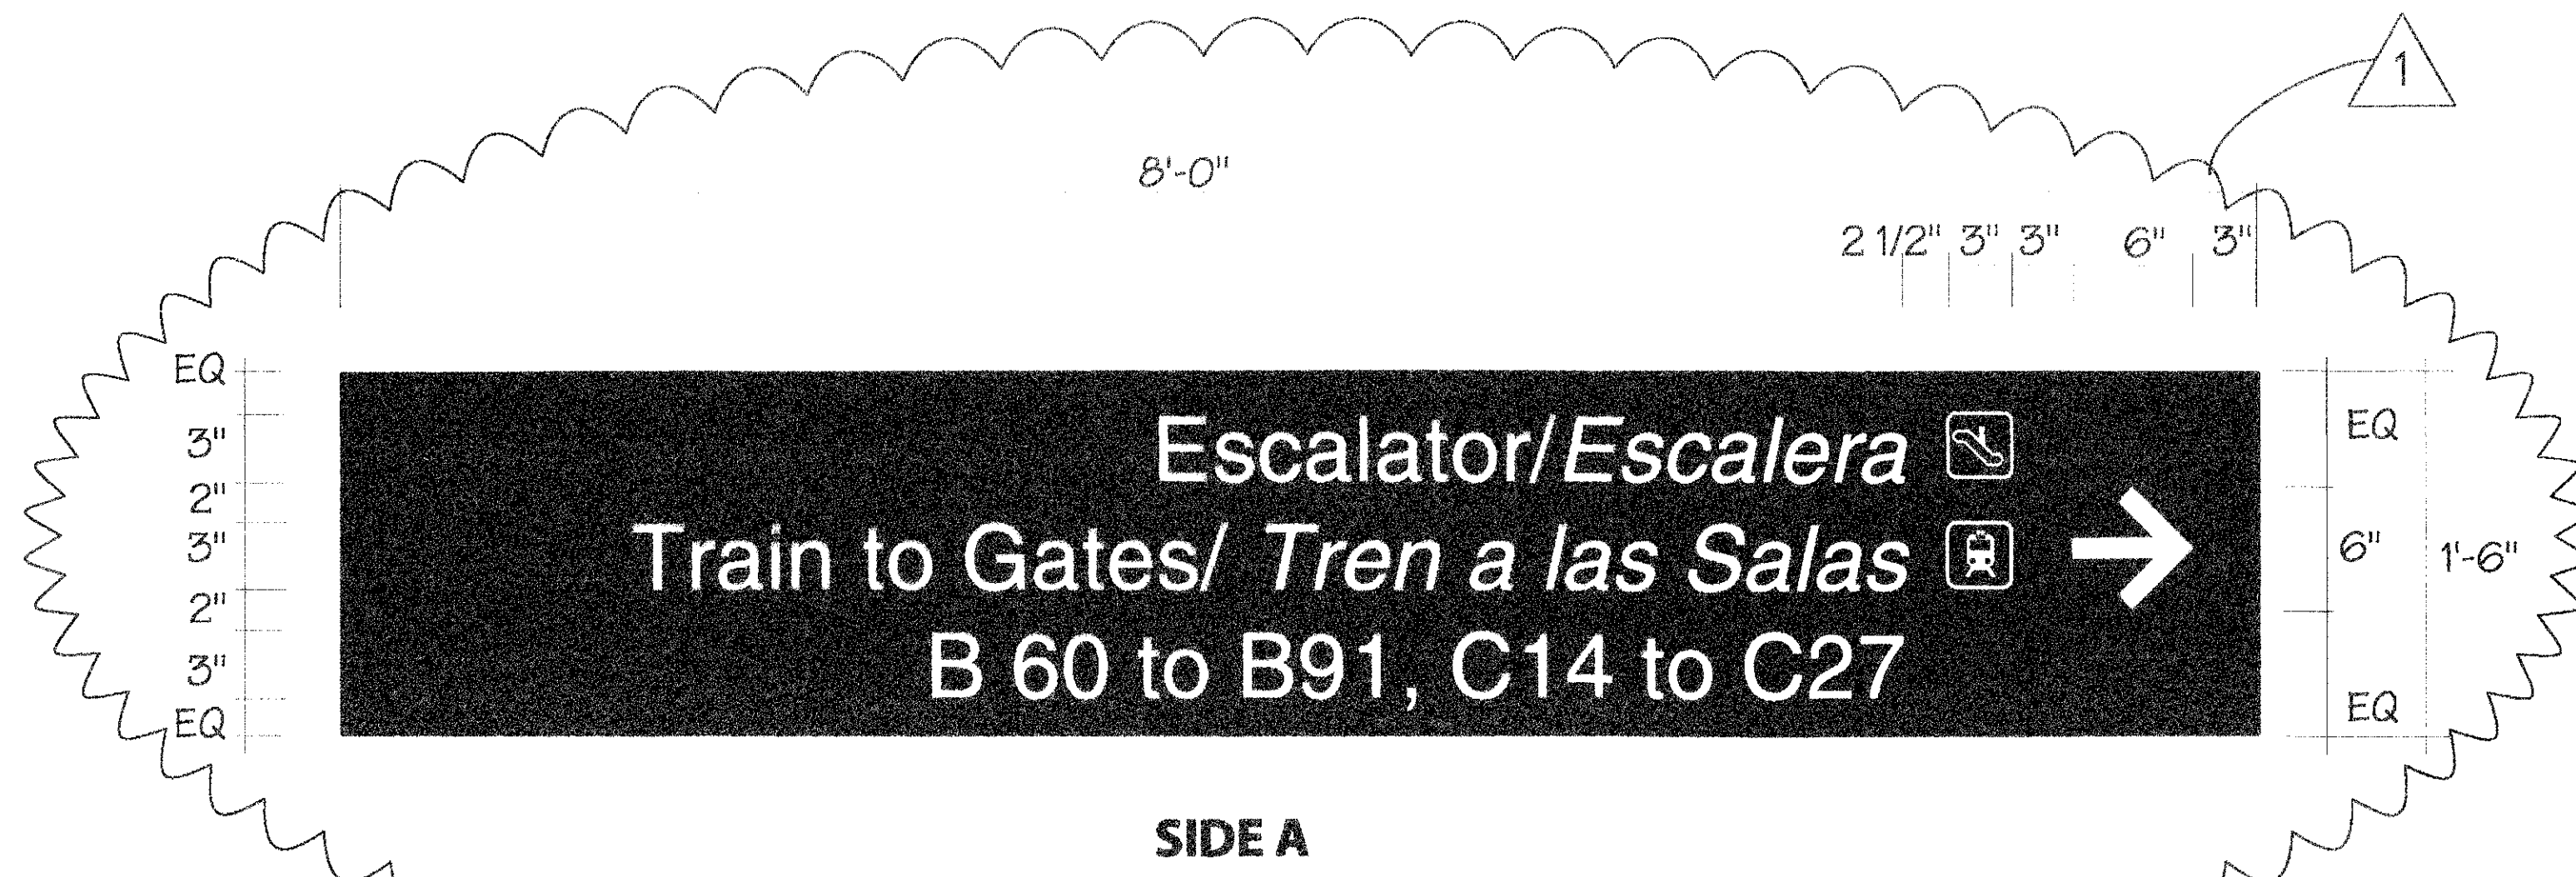


**2** LAYOUT - Overhead Sign 2.2  
SCALE: 1

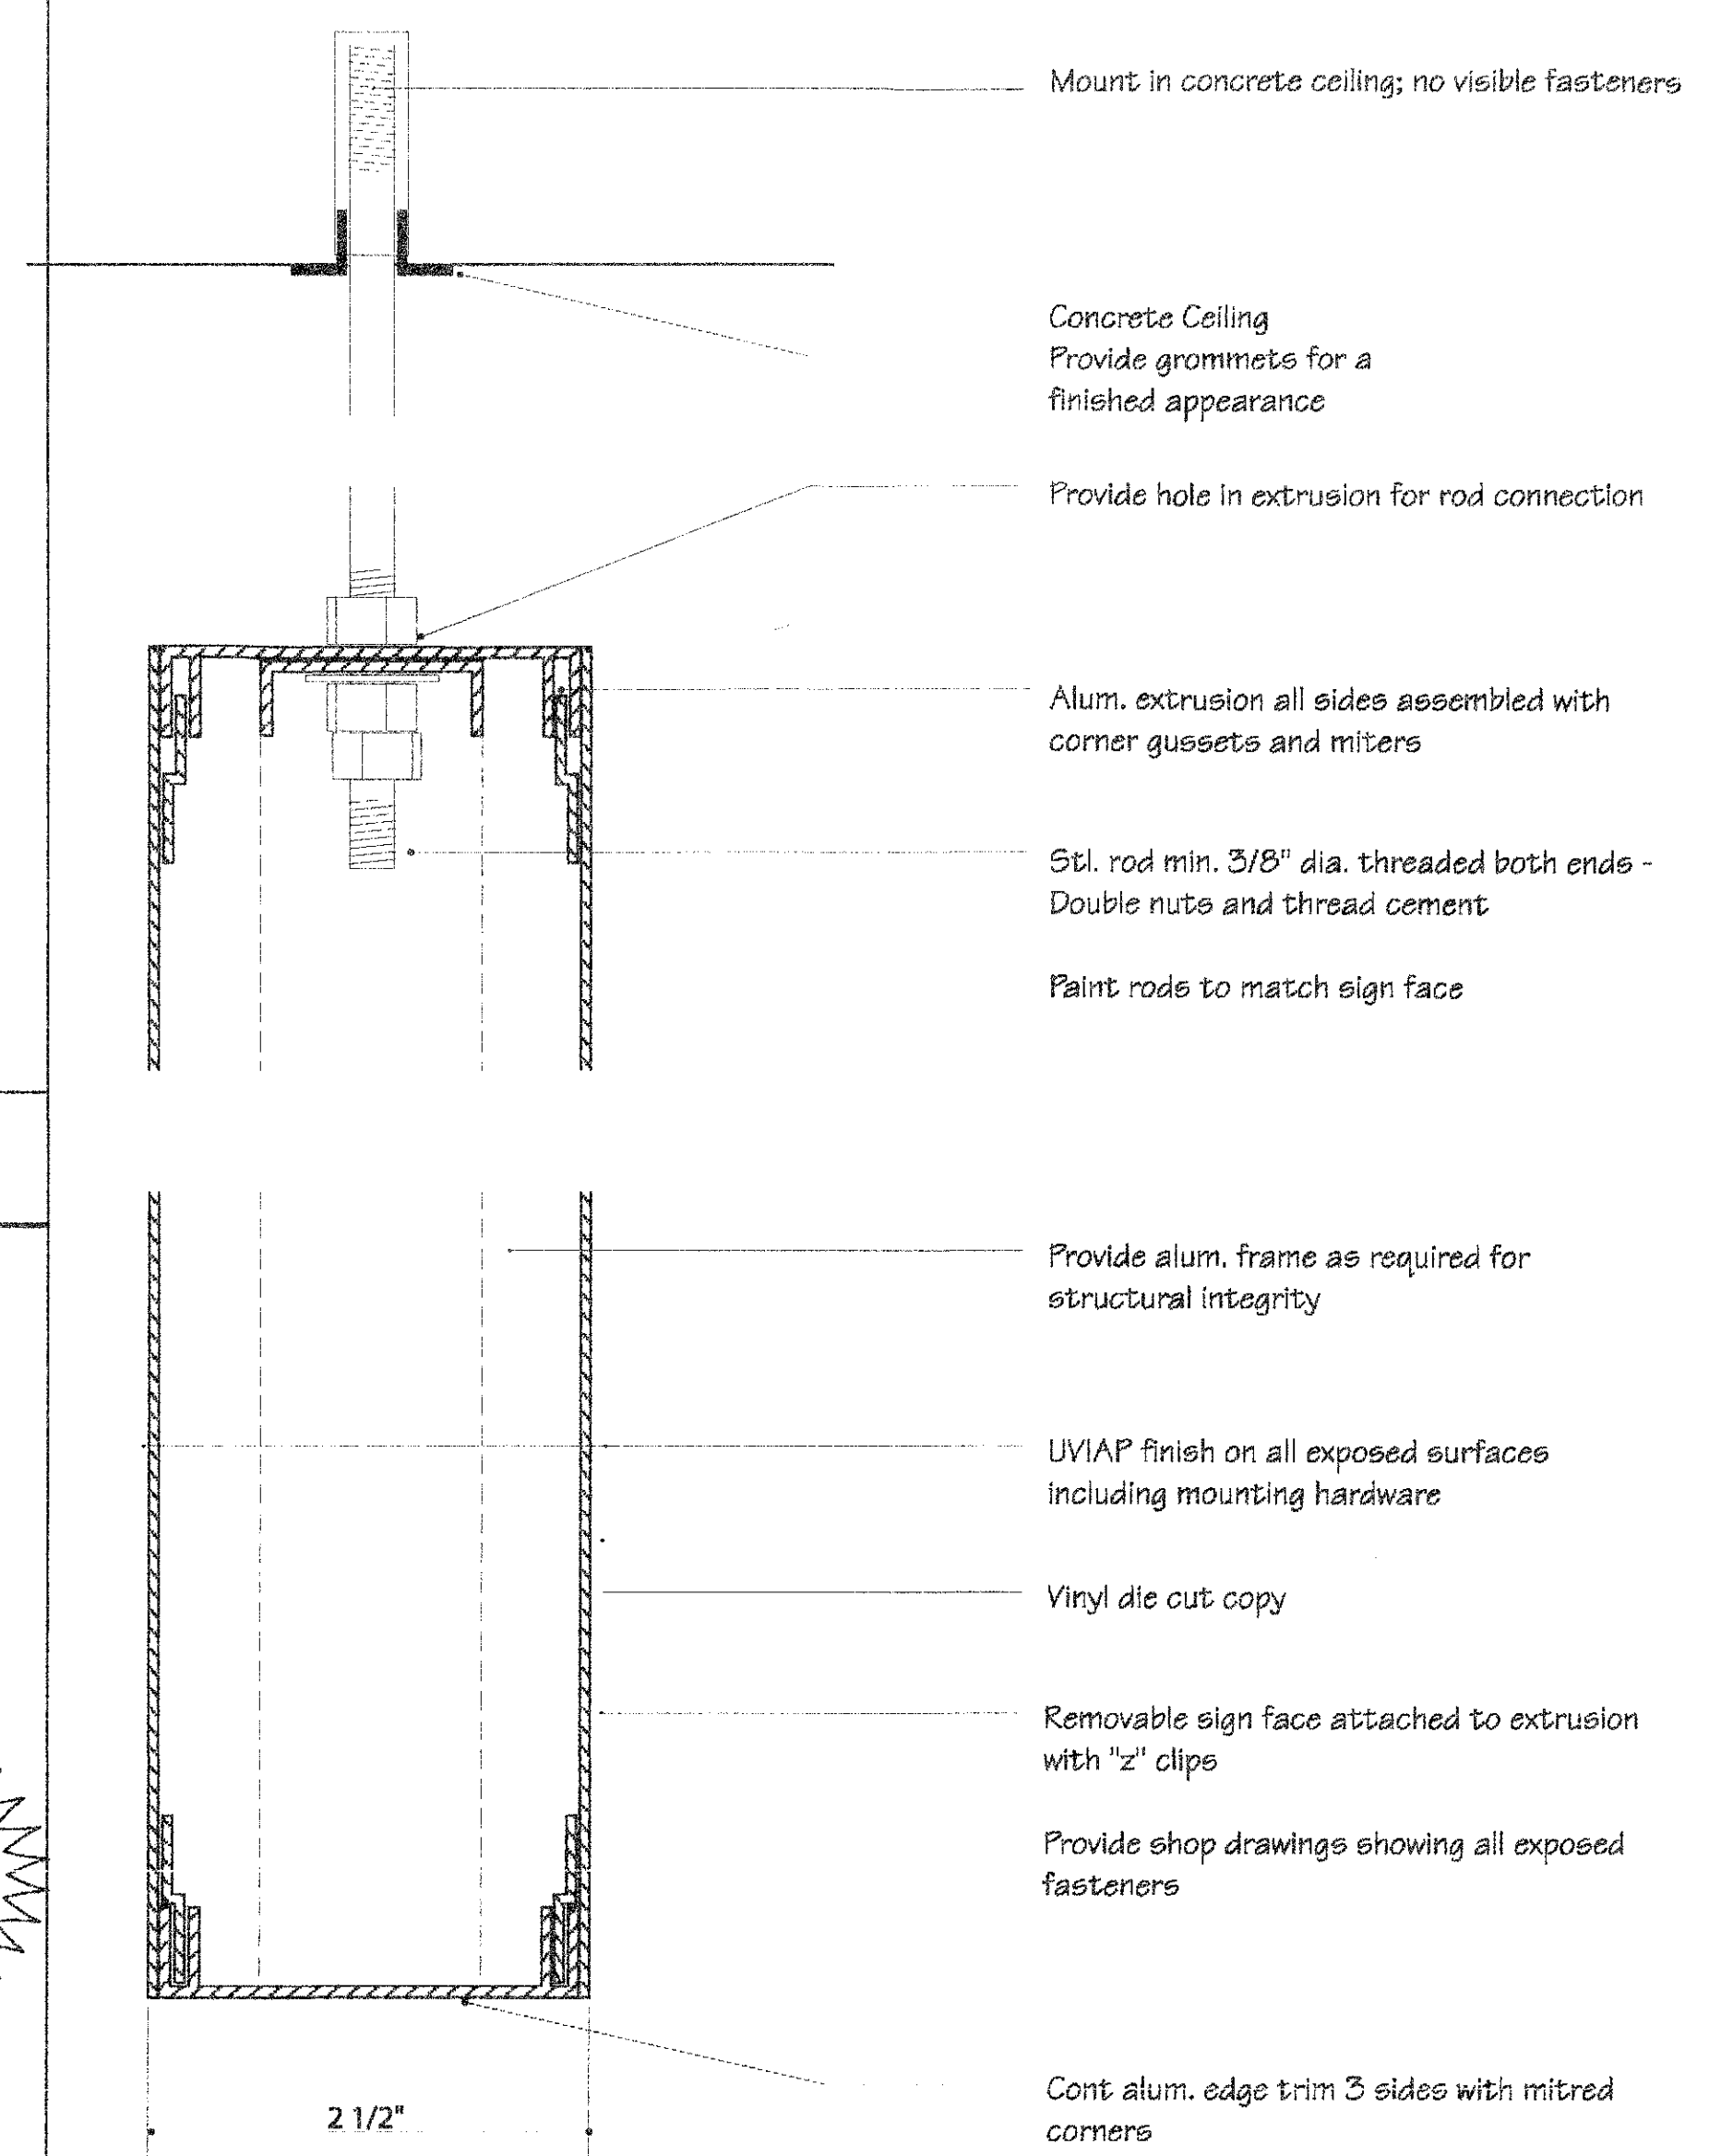


**4** SECTION - Overhead Signs 2.2, 3.2 at Concrete Bulkhead  
SCALE: Full Size

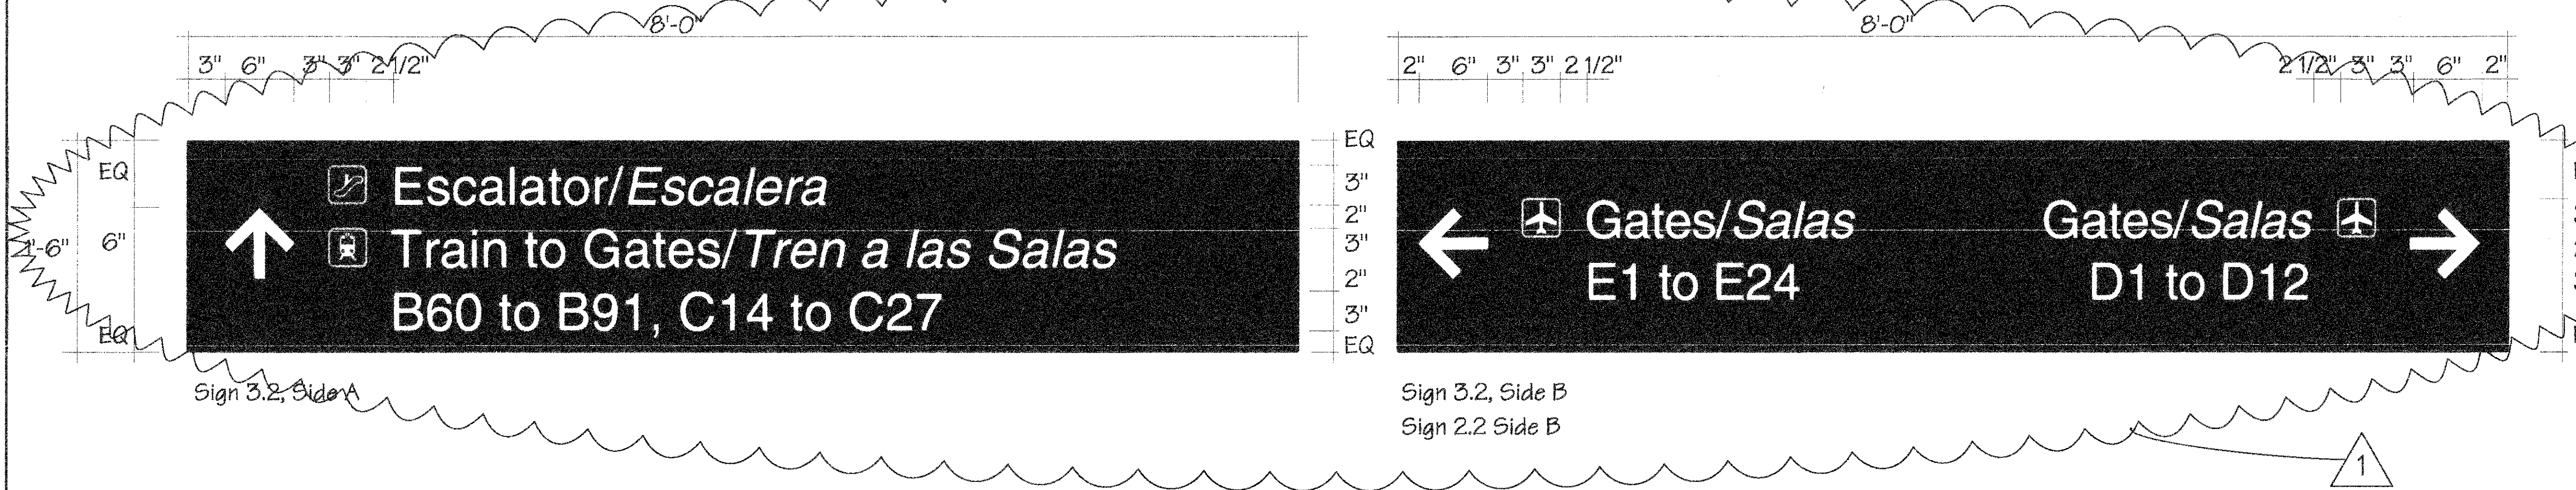


**3** LAYOUT - Overhead Sign 3.2  
SCALE: 1 1/2" = 1'-0"

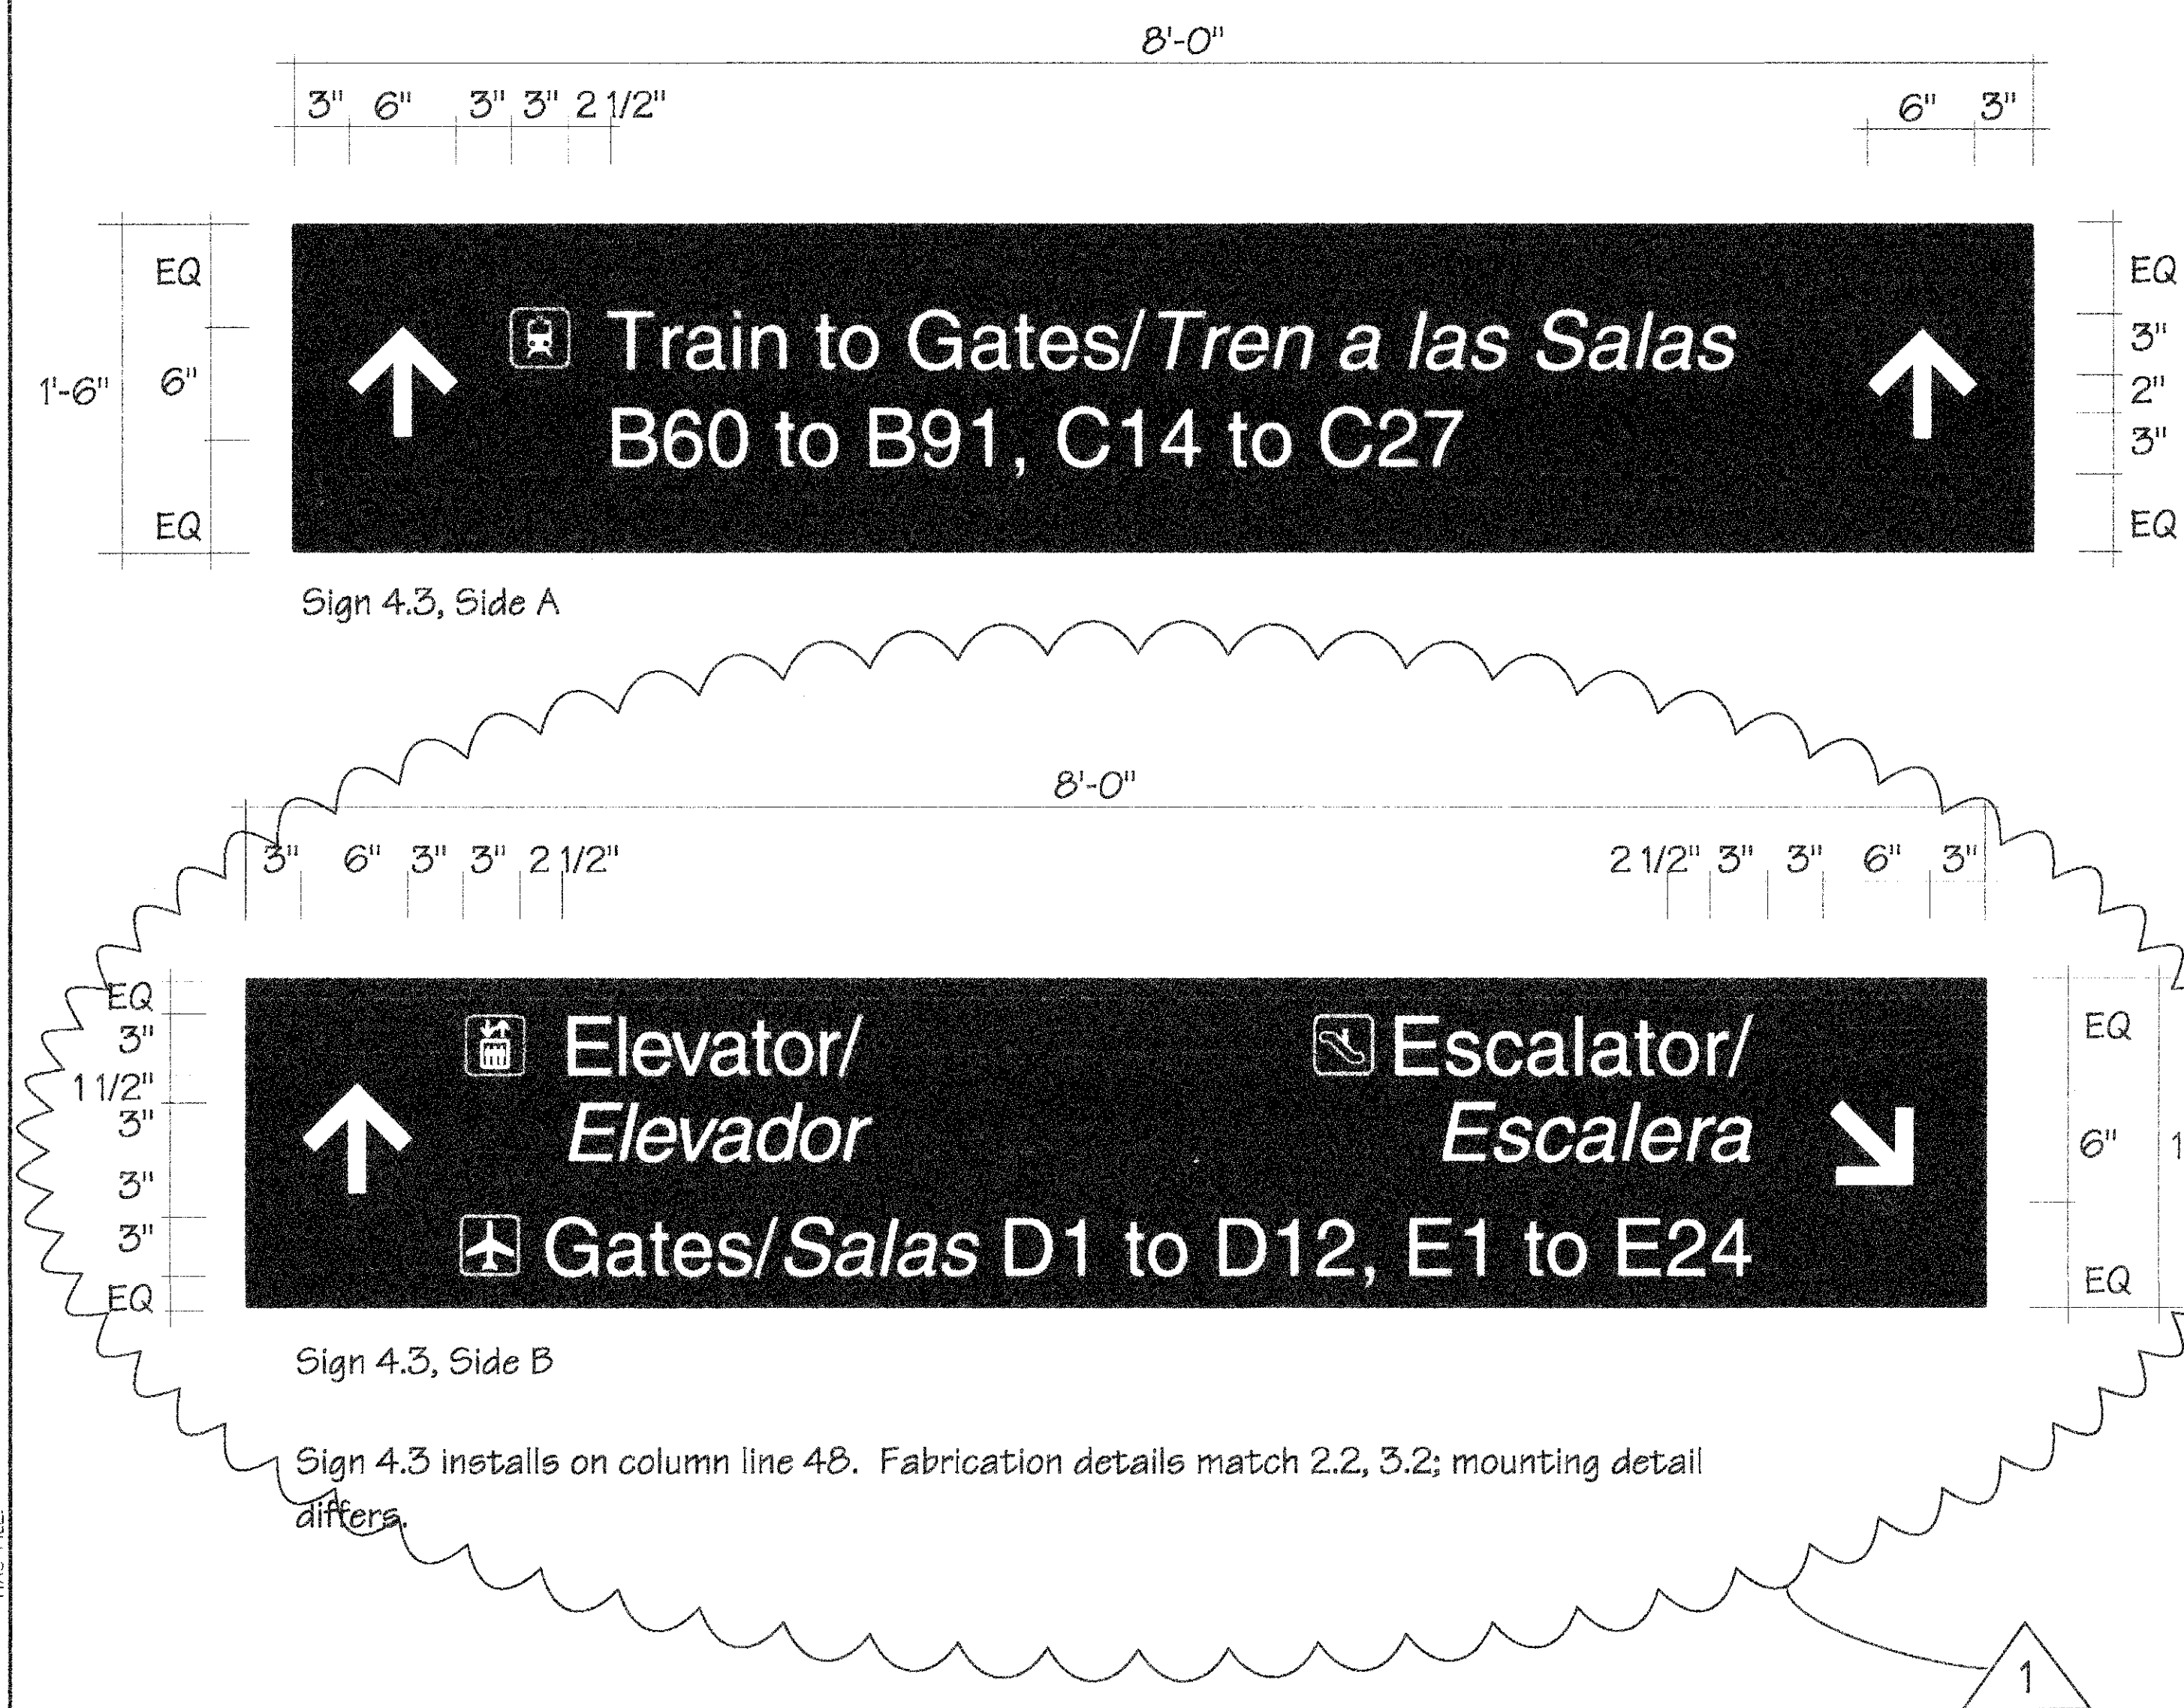

**5** LAYOUT - Overhead Sign 4.3  
SCALE: 1 1/2" = 1'-0"

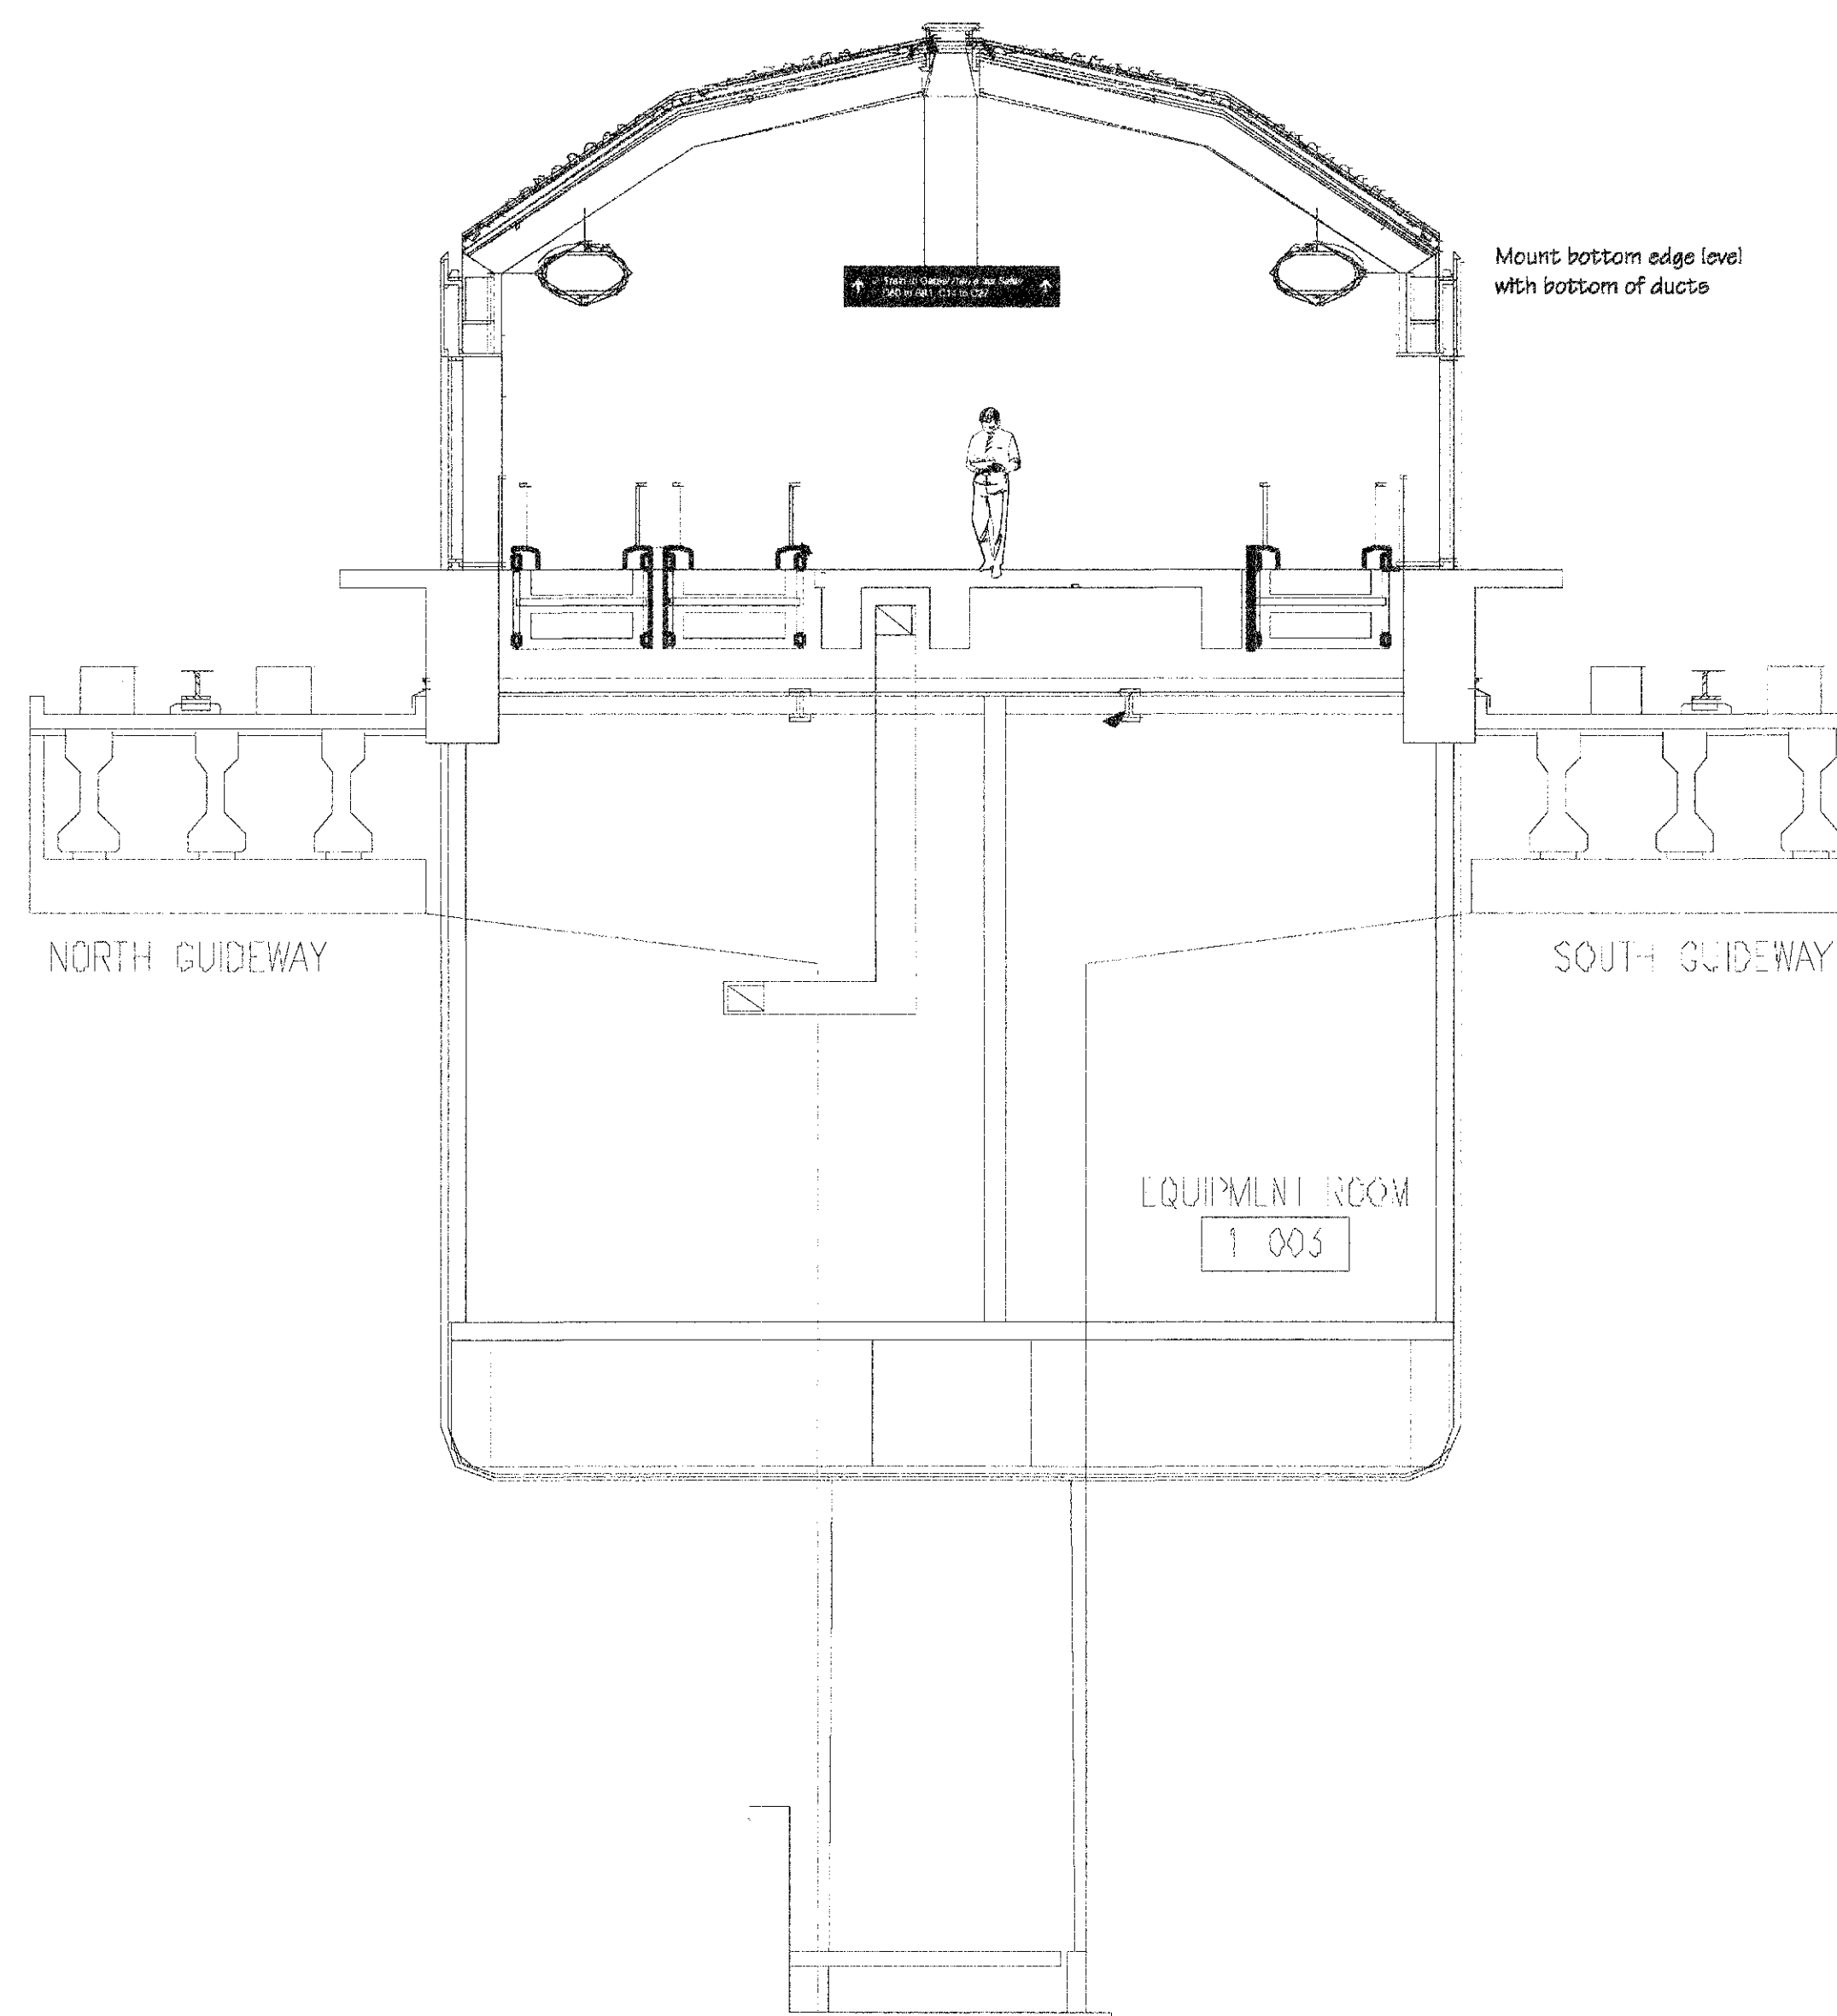

**6** ELEVATION - Signs 3.3 and 4.3 skylight mounting  
SCALE: NTS

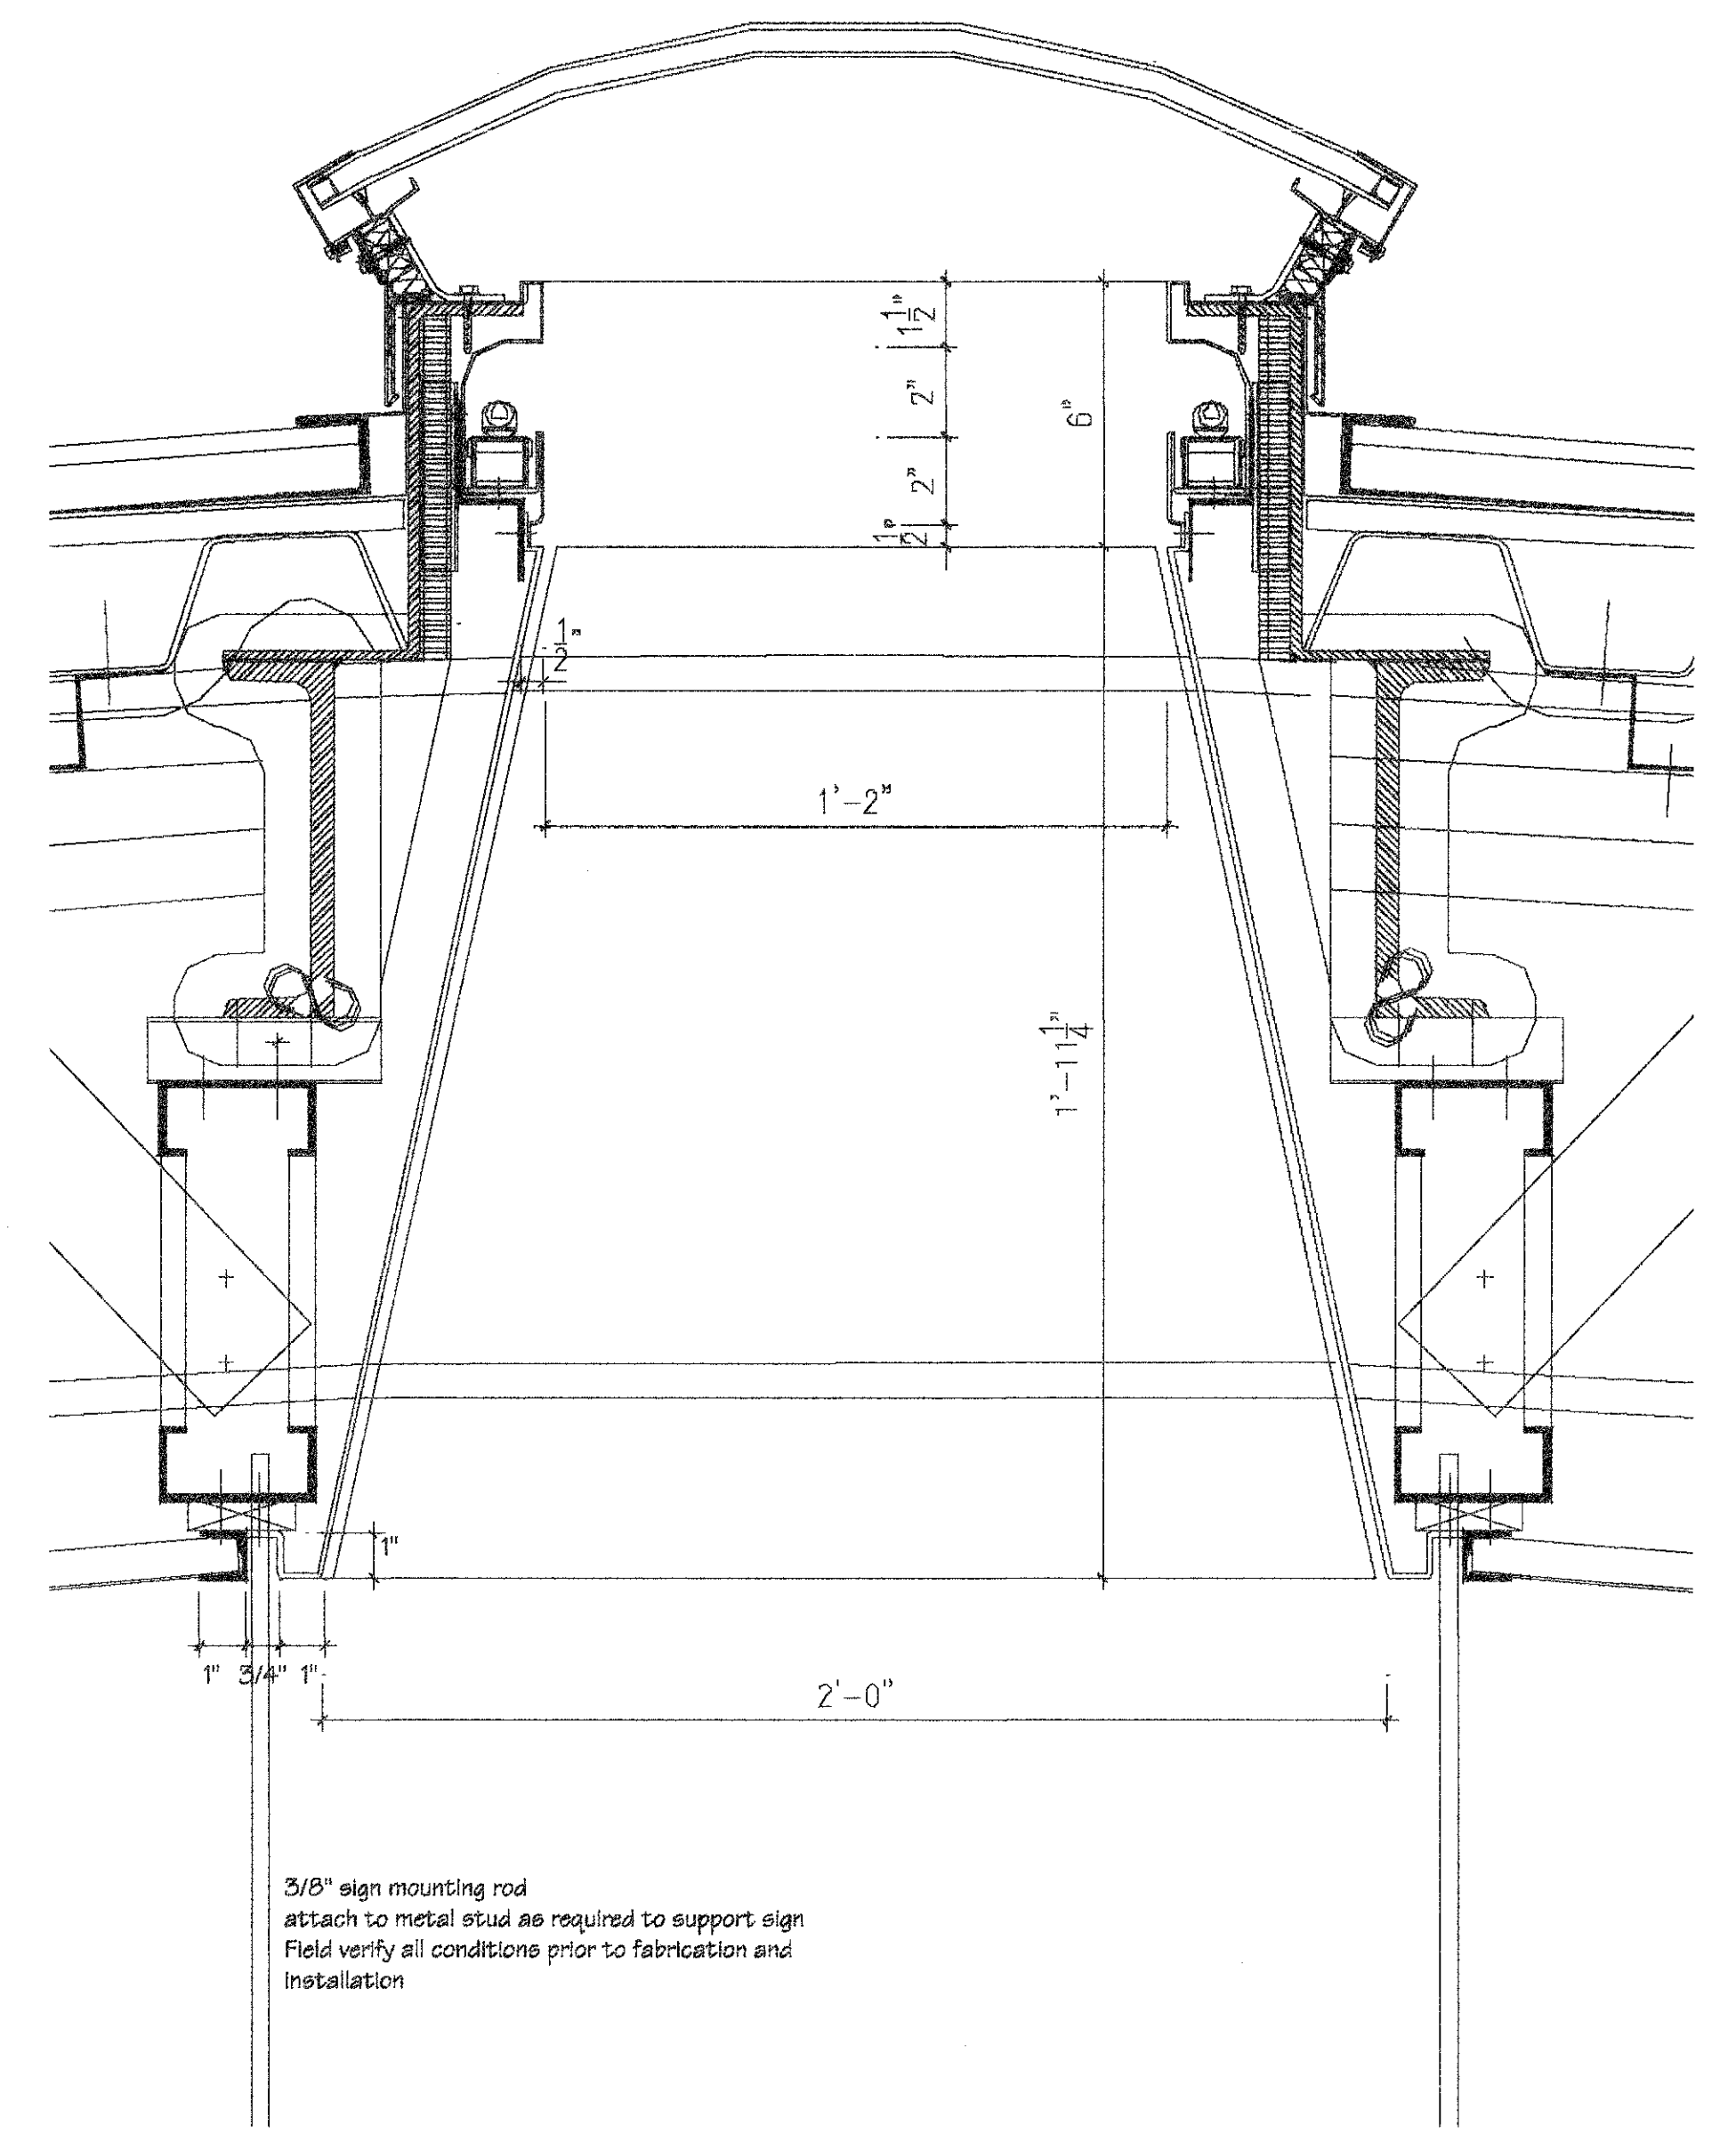

**7** DETAIL - Overhead Signs 3.3, 4.3 skylight mounting  
SCALE: NTS



SYMBOL	ABBREV.	DESCRIPTION	SYMBOL	ABBREV.	DESCRIPTION
		SUPPLY DUCT		CWR	CONDENSING WATER RETURN
		O.A. RETURN OR EXH. DUCT		HWS	HOT WATER SUPPLY
	VD	VOLUME DAMPER		HWR	HOT WATER RETURN
	FD # SD	FIRE OR SMOKE DAMPER		#S	# OF STEAM SUPPLY
		NEW DUCT OR PIPE		#R	# OF STEAM RETURN
		EXISTING DUCT OR PIPE		A	COMPRESSED AIR
		ITEMS TO BE REMOVED		RV	PRESSURE RELIEF VALVE
	MVD	MOTORIZED VOLUME DAMPER		PRV	PRESSURE REDUCING VALVE
	12"	DENOTES ROUND DUCTWORK			THERMOMETER
	22/70 O.	DENOTES OVAL DUCTWORK			UNION
	70/22	DENOTES RECTANGULAR DUCTWORK			STRAINER
	FO	FLAT OVAL			REDUCER
	(E)	EXISTING			GAGE
	OA	OUTSIDE AIR			FLEXIBLE JOINT
	RA	RETURN AIR			ANCHOR
	AFF	ABOVE FINISHED FLOOR			VENTURI FLOW TUBE
	VFD	VARIABLE FREQUENCY DRIVE			SOLENOID VALVE
		SMOKE DETECTOR			BALL VALVE
	TS	TEMPERATURE SENSOR			GATE VALVE
	T	THERMOSTAT			GLOBE VALVE
		DUCT SMOKE DETECTOR			CHECK VALVE
	H	HUMIDISTAT			VALVE BOX
	PD	PRESSURE DIFFERENTIAL SENSOR			GAGE COCK
	PT	PRESSURE TRANSMITTER			BUTTERFLY VALVE
	FT	FLOW TRANSMITTER			PLUG VALVE
	FE	FLOW ELEMENT			TWO-WAY CONTROL VALVE
	CHS	CHILLED WATER SUPPLY			THREE-WAY CONTROL VALVE
	CHR	CHILLED WATER RETURN			THERMOMETER WELL
	CWS	CONDENSING WATER SUPPLY			

DISREGARD LEGEND ITEMS NOT INDICATED ON DRAWINGS

MARK	AHU-1	AHU-2	OAHU-3	FCU-1	FCU-2
LOCATION	MECH. RM.	MECH. RM.	MECH. RM.	MECH. RM.	MECH. RM.
TYPE	BTMZ	BTMZ	HDT	HBT	HBT
TOTAL AIR CFM	11,319	9,975	3,900	1,200	1,800
FRESH AIR CFM	1950	1950	3,900	-	-
EXT SP "H" O	2.75	2.75	3.50	0.35	0.35
TOTAL SP "H" O	4.50	4.50	4.75	-	-
MOTOR HP	20	15	7 1/2	1/2	3/4
VOLT	460	460	460	115	460
PHASE	3	3	3	1	3
HERTZ	60	60	60	60	60
COIL CFM	10,780	9,500	3,900	1,200	1,800
MIN SEN. CAP. MBH	151.2	126.7	201.6	31,780	47,000
MIN TOT. CAP. MBH	198.5	165.2	306.0	34,500	53,200
MIN. ROWS	6	6	8	4	-
ENTERING WTR GPM	28	26	41	6	9.0
EWI "F"	42	42	42	42	42
LWT "F"	57	57	57	57	54
MIN FACE AREA SQ. FT.	24.5	24.5	10.1	3.0	4.25
EDB "F"	63.0	63.0	97.0	80	80
EWB "F"	57.5	57.5	74.0	67	67
COIL CFM	10,780	9,500	3,900		
MIN FACE AREA SQ. FT.	11.5	11.5	7.0		
MIN. ROWS	2	2	2		
ENTERING WTR GPM	34	30	18		
MIN CAP MBH	470.0	414.2	170.0		
EAT "F"	60	60	20		
EWI "F"	180	180	180		
REMARKS	YORK AP250 20" FC FAN WHEEL	YORK AP215 18" FC FAN WHEEL	YORK AP105 12" FC FAN WHEEL	McQUAY SCB	McQUAY SCB

- NOTES:
- PROVIDE PREHEAT COIL SECTION WITH INTEGRAL FACE AND BYPASS DAMPER ON OAHU-3.
  - BTMZ - INDICATES BLOW THRU MULTI-ZONE AIR HANDLING UNIT.  
 HDT - INDICATES HORIZONTAL DRAW THRU AIR HANDLING UNIT.  
 HBT - INDICATES HORIZONTAL BLOW THRU FAN COIL UNIT WITH CABINET, WITH SUPPLY AND RETURN DUCT CONNECTIONS.
  - PROVIDE CHEMICAL FILTERS WITH OAHU-3, AND 30% ASHRAE EFFICIENCY FILTERS ON AHU-1, 2 REFER TO SPECIFICATIONS SECTION 15666.
  - PROVIDE 1" INCH FILTER ON FCU-1 AND FCU-2.

GENERAL NOTES

THESE GENERAL NOTES APPLY TO ALL MECHANICAL DRAWINGS.

IN ANY CASE WHERE A PIPE OR DUCT SHOWN ON A PLAN SHEET DIFFERS FROM THAT SHOWN IN A SCHEMATIC OR DETAIL, USE THE LARGER OF THE TWO SIZES SHOWN.

PIPING SHOWN ON EACH PLAN IS RUN ABOVE THE CEILING ON THE FLOOR WHERE IT IS SHOWN UNLESS OTHERWISE NOTED.

ALL ELEVATIONS INDICATED IN THIS WAY (8'-0") ARE THE ELEVATIONS FROM THE FINISHED FLOOR DIRECTLY BELOW TO THE BOTTOM OF THE BARE PIPE OR DUCT.

MOUNT TEMPERATURE SENSORS, THERMOSTATS AND HUMIDISTATS 48 INCHES ABOVE FINISHED FLOOR AND CENTERED ABOVE THE LIGHT SWITCHES WHERE BOTH OCCUR IN THE SAME LOCATION, UNLESS OTHERWISE NOTED.

NORMAL DESIGN CONDITIONS

	SUMMER (1)	WINTER (2)
OUTSIDE	96 Deg. F db & 77 Deg. F wb	27 Deg. F
INSIDE	75 Deg. F db & 50% RH	70 Deg. F

PROVIDE FIRE DAMPERS IN ALL DUCTWORK PIERCING FLOORS, FIRE WALLS, AND AIR CONDITIONING CHASIS, UNLESS OTHERWISE NOTED.

COORDINATE LOCATION OF CEILING AND DIFFUSERS GRILLES WITH LIGHTING PLANS.

- NOTE:
- SUMMER OUTSIDE DESIGN CONDITIONS ARE BASED ON 2 1/2% ASHRAE WEATHER DATA WITH MEAN COINCIDENT WETBULB TEMP.
  - WINTER OUTSIDE DESIGN CONDITIONS ARE BASED ON 1% ASHRAE WEATHER DATA.
  - ELECTRIC AND ELEVATOR MACHINE ROOM DESIGN TEMPERATURES ARE 80/67.

MARK	A	B	C	D	E
CFM RANGE	350-550	400-600	650-850	900-14000	1000-2000
SUPPLY	X	X	X		X
RETURN				X	X
EXHAUST					
TYPE	LINEAL SLOT	LINEAL SLOT	LINEAL SLOT	LOUVERED	DOUBLE DEFLECTION
DUCT CONN. SIZE	9" DIA	RE: M2.001	RE: M2.001	36x64	REFER M2.000
PATTERN	ADJ.	ADJ.	ADJ.	FIXED	ADJ.
REMARKS	KRUEGER 1910 SERIES W/BOOT REFER TO 02/M5.000	KRUEGER 1910 SERIES IN DUCT REFER TO 02/M5.000	KRUEGER 1910 SERIES IN DUCT REFER TO 02/M5.000	TITUS 355 RS-HD	TITUS 11RS

- NOTE:
- TYPE "A" - PROVIDE 48" LONG x 4-1" SLOTS @ 98 CFM/LF AND NC24, SURFACE MOUNT, CONCEALED FASTENING.
  - TYPE "B" - PROVIDE 48" LONG x 4-1" SLOTS @ 115 CFM/LF AND NC20 MOUNTED BOTTOM OF DUCT FRAME STYLE L, CURVATURE TO MATCH BOTTOM OF OVAL DUCT. REFER TO ARCH. DETAIL OF DUCT WRAP.
  - TYPE "C" - PROVIDE 72" LONG x 6-1" SLOTS @ 120 CFM/LF AND NC22, FRAME STYLE L, CURVATURE TO MATCH SIDE OF OVAL DUCT. REFER TO ARCH. DETAIL OF DUCT WRAP.
  - COLOR AND FINISH OF DIFFUSER AND GRILLES AS SELECTED BY ARCHITECT.
  - TYPE "E" - GRILLE SIZED TO MATCH DUCT SIZES.

MARK	SF-1 & SF-2	VF-1
SERVICE	STARWAY SUPPLY	STARWAY VENT
TYPE	DIRECT DRIVE	IN-LINE
CFM	1,170	2,490
SP "H" O	0.375	0.75
HP	1/4	3/4
VOLTS	115	460
PHSEZ	1/60	3/60
FAN RPM	860	937
INTERLOCK WITH	T-STAT	AHU-1, 2
REMARKS	COOK APD24	SON-HP210

- NOTE:
- PROVIDE WALL INSTALLATION PACKAGE.
  - PROVIDE MOTOR OPERATED DAMPERS AT FAN AND EXHAUST LOUVERS.
  - PROVIDE THERMOSTAT AND FAN MOTOR STARTERS AS REQUIRED.



NO.	DESCRIPTION	DATE	BY
ISSUED FOR BID		10/19/01	
RECORD DRAWING		05/26/15	


INTERNATIONAL SERVICES EXPANSION PROGRAM  
**APM STATION + PLATFORM**  
 LOBBY HVAC PLAN

PROJECT MGR:	A.E. BELTRAN
DESIGNER:	C. COBB
DRAWN BY:	E. STREIBLING
CHECKED BY:	C. COBB
DRAWING STANDARD:	SEP 07.20.2000
SCALE:	AS NOTED
DATE:	09/14/01


**RECORD DRAWING**  
 THIS DRAWING HAS BEEN REVISIONED TO SHOW SIGNIFICANT CHANGES IN THE WORK MADE DURING CONSTRUCTION BASED ON MARKED-UP PRINTS, DRAWINGS AND OTHER DATA.

APPROVED BY:	DATE:
DIRECTOR HOUSTON AIRPORT SYSTEM	
PROJECT NO.	1001-001
C.I.P. NO.	A-034
H.A.S. NO.	536
SHEET NO.	

88 M2.000

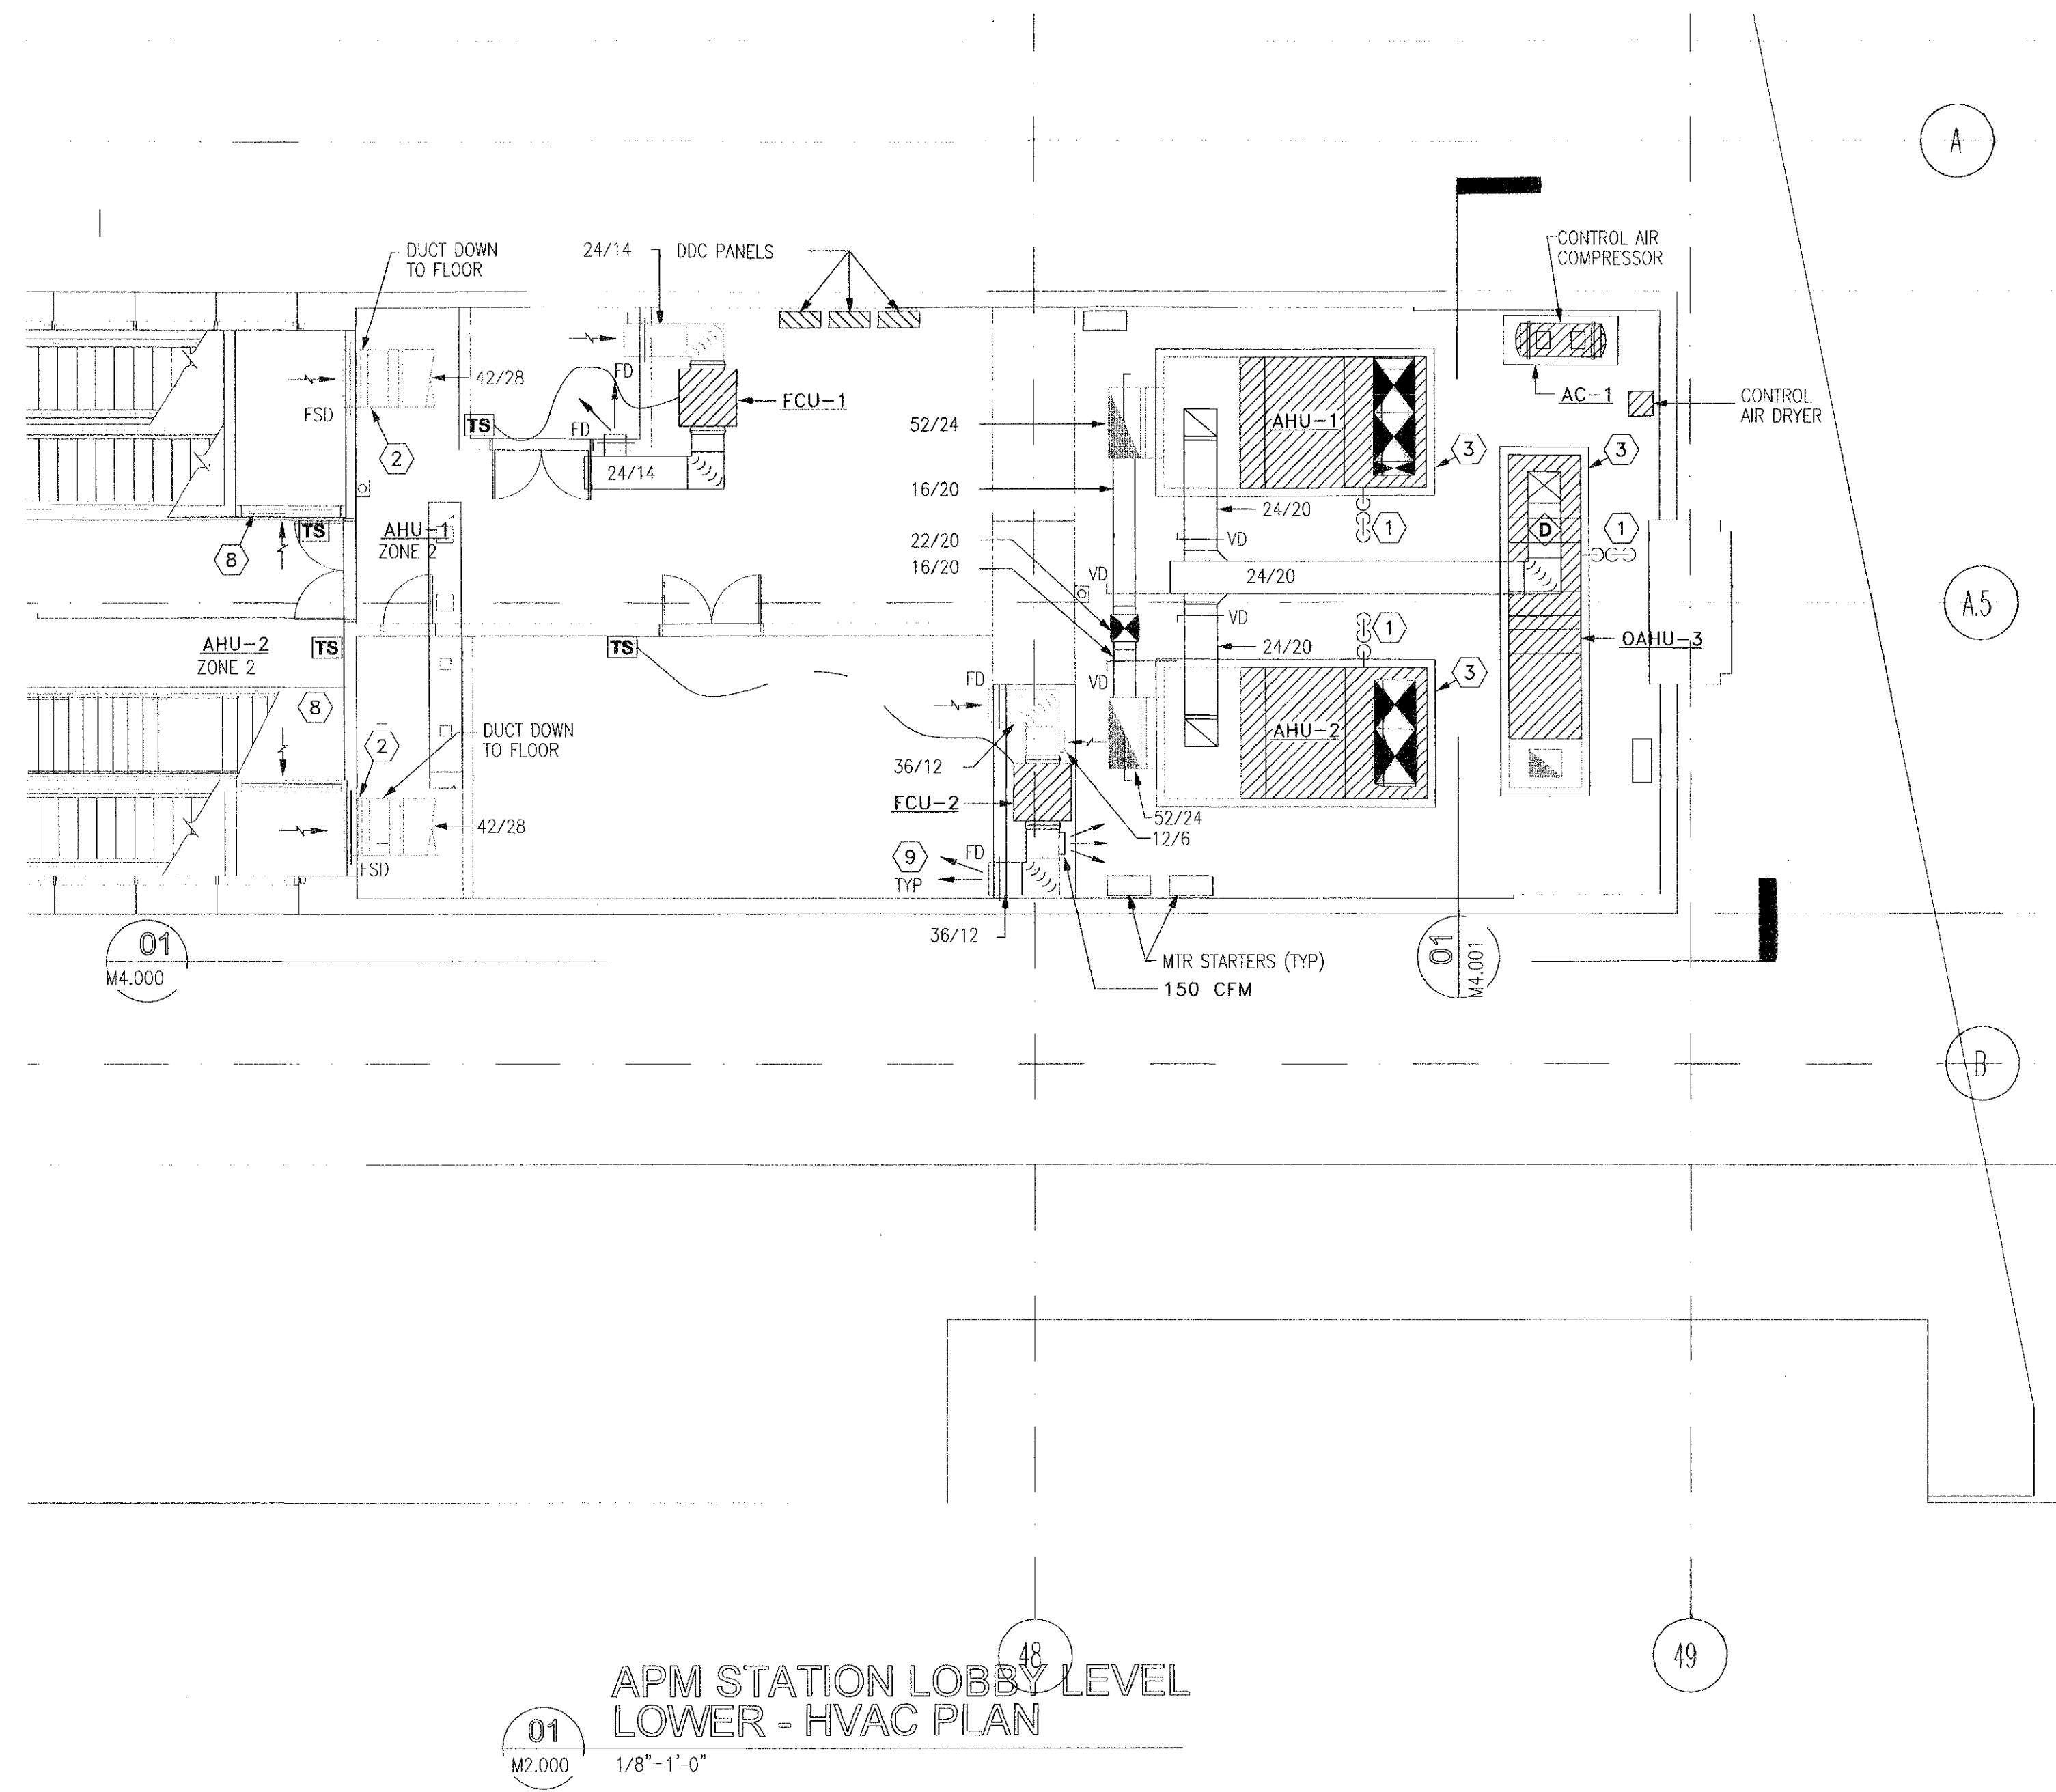

01 M2.000  
**APM STATION LOBBY LEVEL LOWER - HVAC PLAN**  
 1/8"=1'-0"


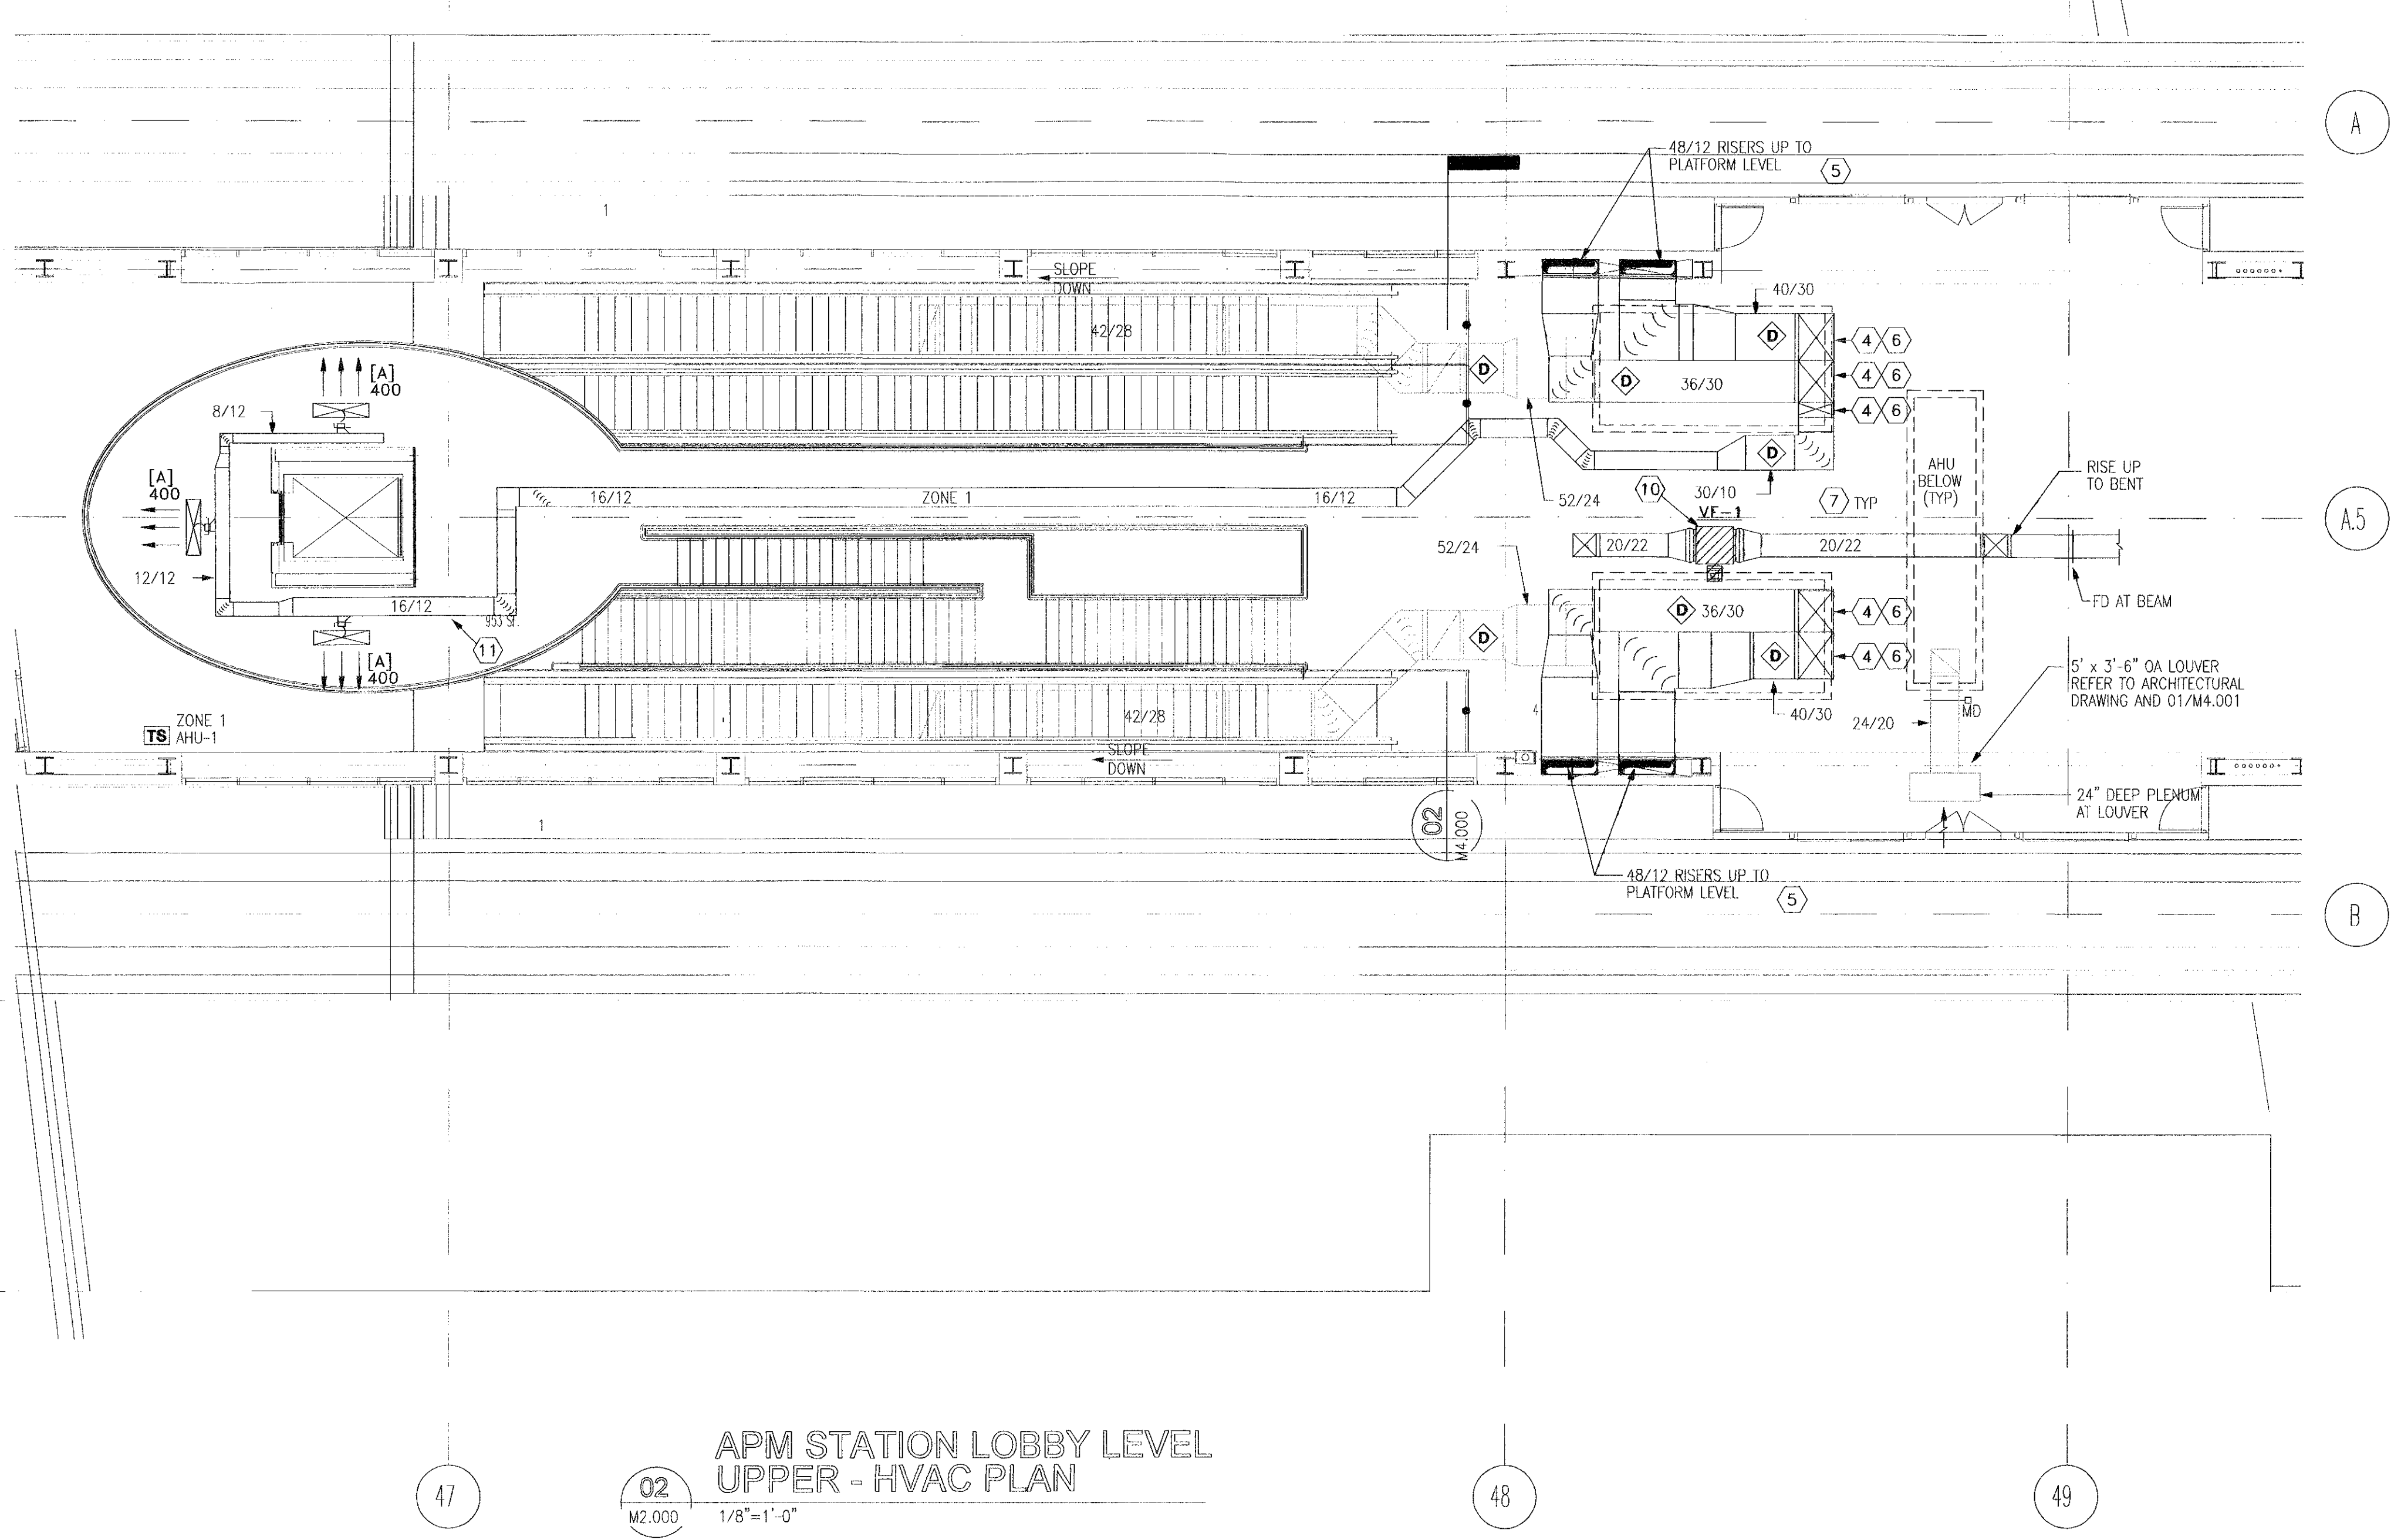


02 M2.000  
**APM STATION LOBBY LEVEL UPPER - HVAC PLAN**  
 1/8"=1'-0"

**KEYED NOTES:**

- 1) PROVIDE FULL SIZE CLEANABLE COND. TRAP PIPED TO FLOOR DRAIN.
- 2) CONNECT 42/28 RETURN AIR DUCT TO RETURN AIR PLENUM BENEATH ESCALATOR. REFER TO ARCHITECTURAL DRAWINGS FOR RETURN AIR GRILLES AT ESCALATOR AND STAIRS.
- 3) INSTALL AIR UNITS ON 6-INCH HOUSEKEEPING PADS.
- 4) PROVIDE VOLUME CONTROL DAMPER IN VERTICAL DUCT FOR EACH ZONE.
- 5) PROVIDE MULTIBLADE FIRE DAMPER IN DUCT AT FIRE RATED FURR-DOWN AT BEAMS, AND AT ENTRANCE TO CHASE. REFER TO ARCHITECTURAL DRAWINGS FOR FURR-DOWN, TRANSITION TO DOUBLE WALL OVAL AT BOTTOM OF CHASE. REFER TO SPECIFICATIONS.
- 6) DIVIDE ZONING DAMPER SECTIONS FREE AREA PROPORTIONAL TO AIR QUANTITY PROVIDED TO EACH ZONE. INDICATE ZONE DUCT CONNECTION DIMENSIONS IN AIR UNIT SUBMITTAL.
- 7) PROVIDE AIR FOIL TURNING VANES IN ALL ELBOWS.
- 8) TRAPEZOIDAL RETURN AIR GRILLE, APPROXIMATELY 72" HIGH x 60" WIDE. REFER ARCHITECTURAL DRAWINGS FOR EXACT SHAPE AND DIMENSIONS.
- 9) PROVIDE VOLUME DAMPER AT [E] (4 EACH) SUPPLY GRILLES SAME SIZE AS DUCT.
- 10) VF-1 WITH TRANSITIONS AND FLEX CONNECTIONS. SUPPORT FAN WITH VIBRATION ISOLATORS AND THRUST RESTRAINTS AS REQUIRED FROM STRUCTURE. PROVIDE FLEX CONNECTIONS AT DUCT CONNECTIONS TO FAN.
- 11) DUCT THRU OPENING IN DUCT BENT 47.

**GENERAL NOTES:**

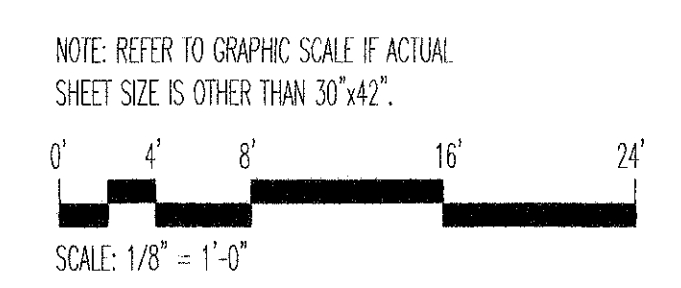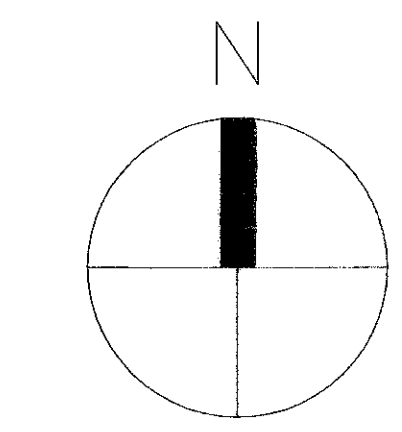




REVISIONS			
NO.	DESCRIPTION	DATE	BY
ISSUED FOR BID		10/19/01	
RECORD DRAWING		05/08/05	

INTERNATIONAL SERVICES EXPANSION PROGRAM  
**APM STATION + PLATFORM**  
 PLATFORM HVAC PLAN

PROJECT MGR: A.EBELFRAN  
 DESIGNER: C. OGBB  
 DRAWN BY: E. STRIBLING  
 CHECKED BY: C. OGBB  
 DRAWING STANDARD: SEP 07.20.2009  
 SCALE: AS NOTED  
 DATE: 09/14/07

**RECORD DRAWING**  
 THIS DRAWING HAS BEEN  
 REUSED TO SHOW  
 SOMEWHAT CHANGES IN  
 THE WORK MADE DURING  
 CONSTRUCTION BASED ON  
 MARKED-UP PRINTS,  
 DRAWINGS AND OTHER  
 DATA.

APPROVED BY: \_\_\_\_\_ DATE: \_\_\_\_\_  
 DIRECTOR  
 HOUSTON AIRPORT SYSTEM  
 PROJECT NO. 1061-001  
 C.L.P. NO. A-0354  
 H.A.S. NO. 538C  
 SHEET NO. 89 M2.001


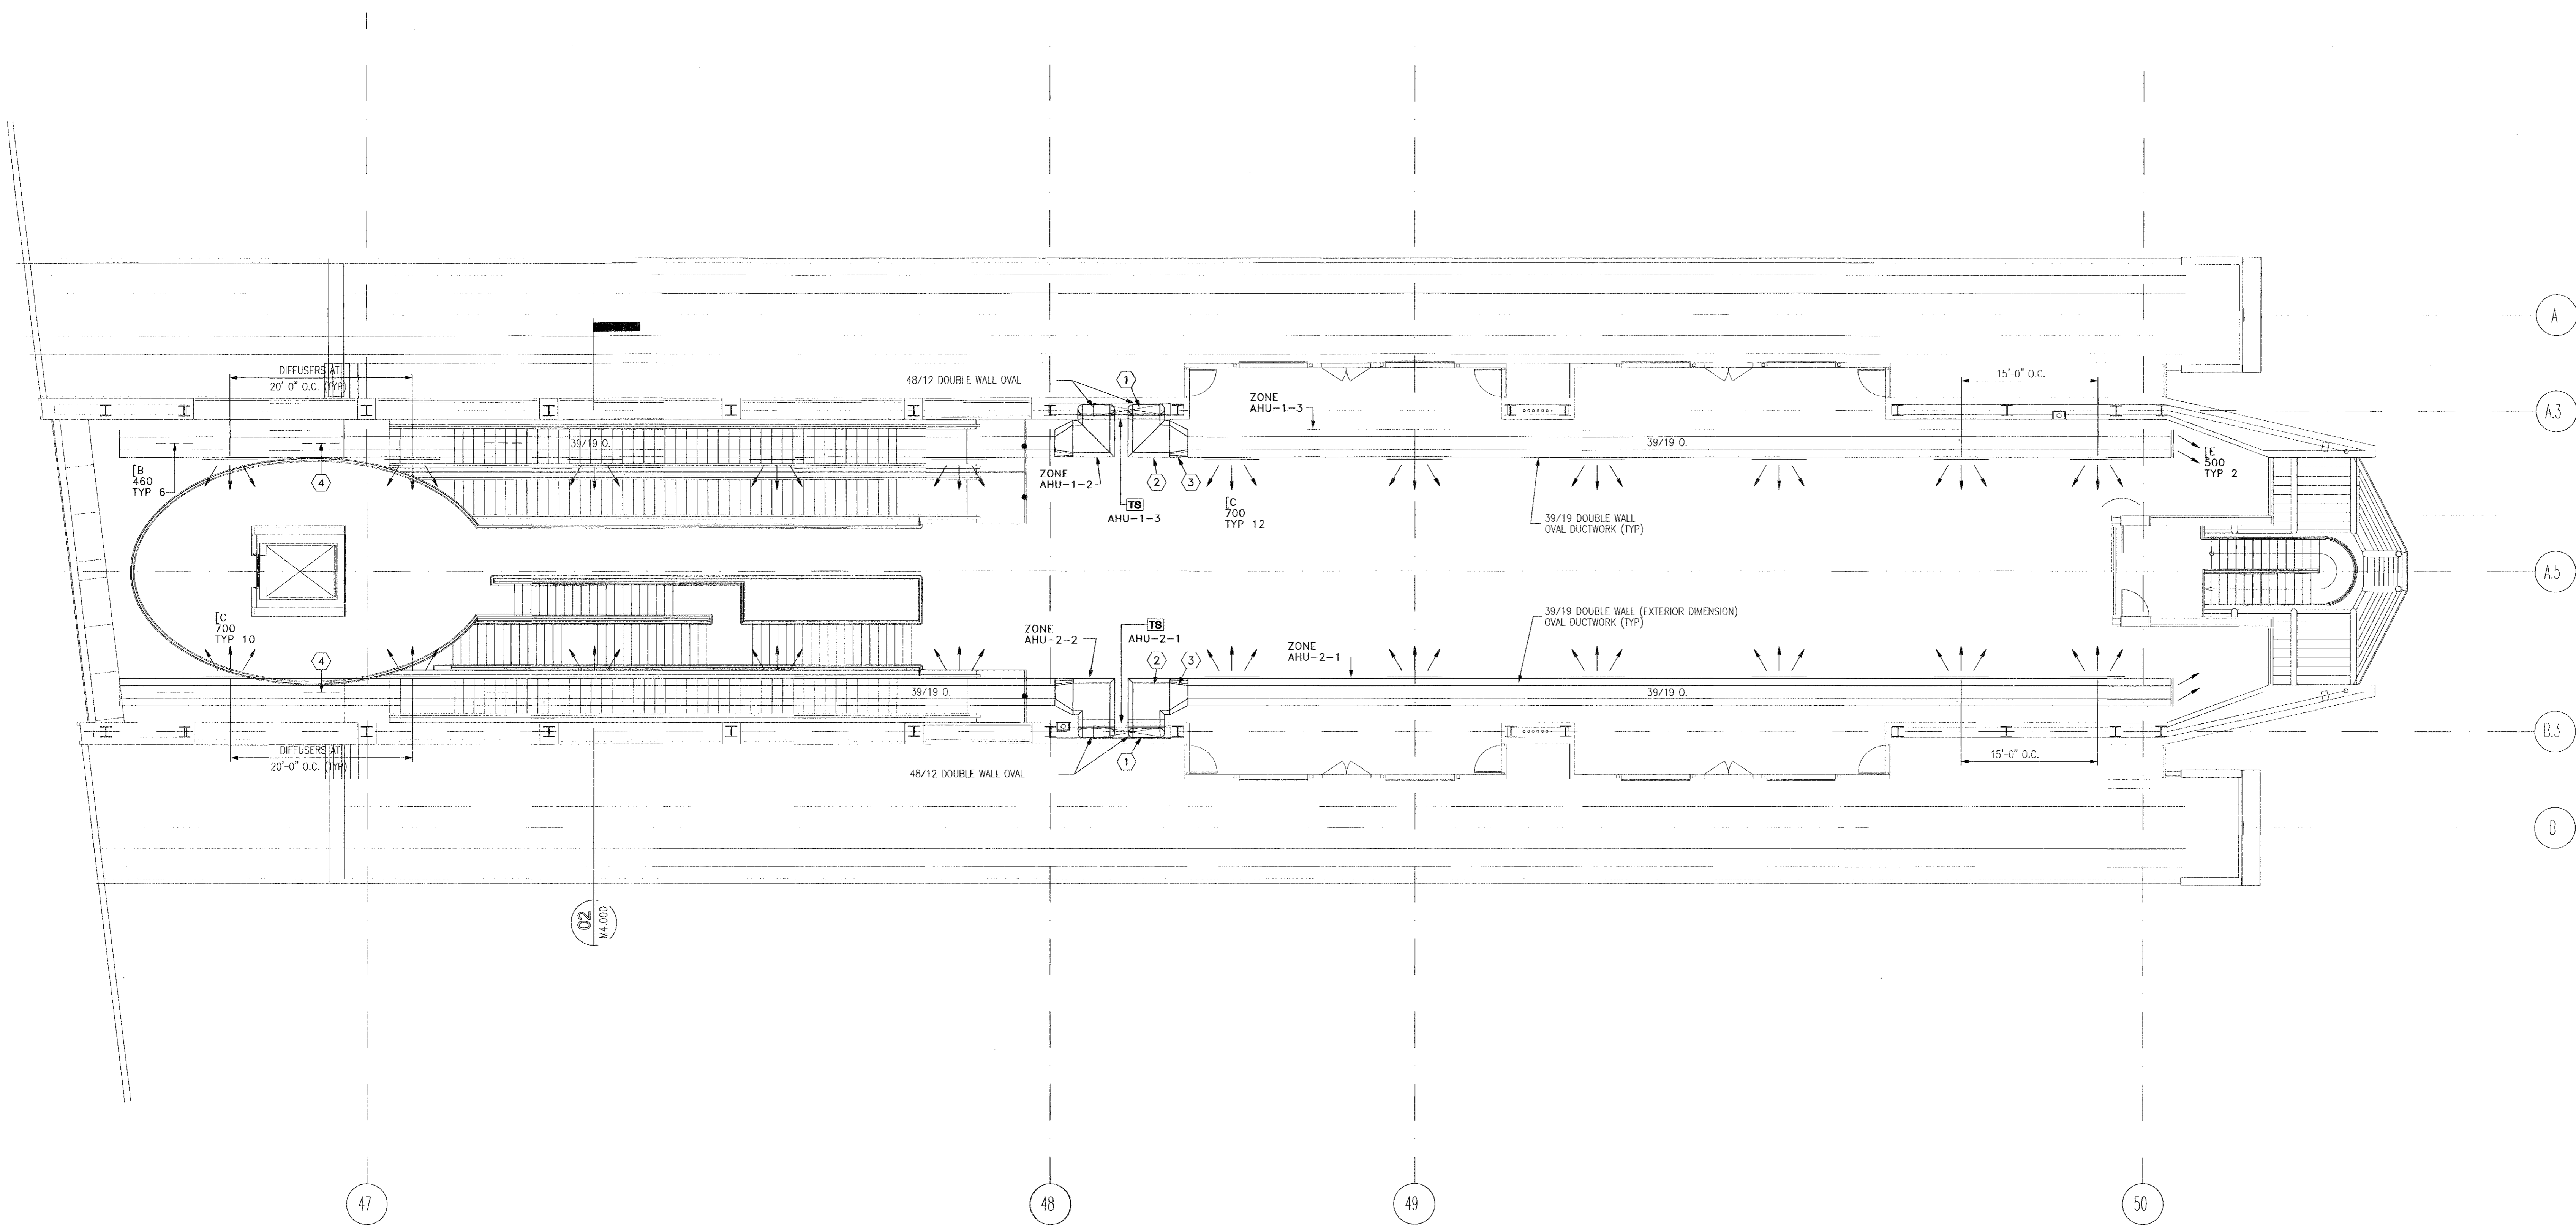


**01 APM STATION PLATFORM LEVEL-HVAC PLAN**  
 1/8"=1'-0"

**KEYED NOTES:**



- ① MITERED 90 DEG. DOUBLE WALL FLAT OVAL ELBOW WITH TURNING WINGS (EAST BEND). PROVIDE FSD AT CHASE.
- ② MITERED 90 DEG. DOUBLE WALL FLAT OVAL ELBOW WITH TURNING WINGS (EAST BEND).
- ③ TRANSITION FROM 48/12 OVAL TO 36/19 OVAL DOUBLE WALL.
- ④ SLOT DIFFUSER ON BOTTOM OF DUCT DISCHARGES TO LOWER LEVEL.

**GENERAL NOTES:**

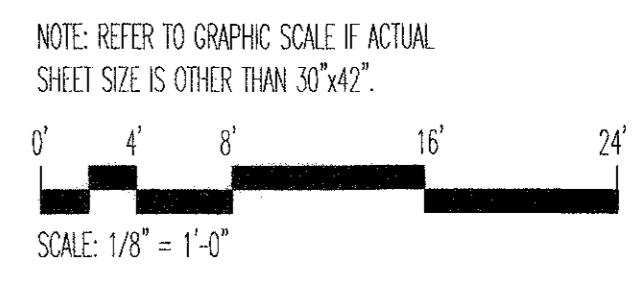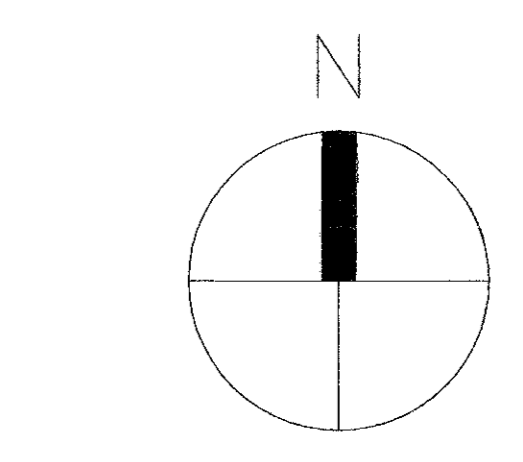





NO.	DESCRIPTION	DATE	BY
ISSUED FOR BID		10/19/01	
RECORD DRAWING		05/06/02	

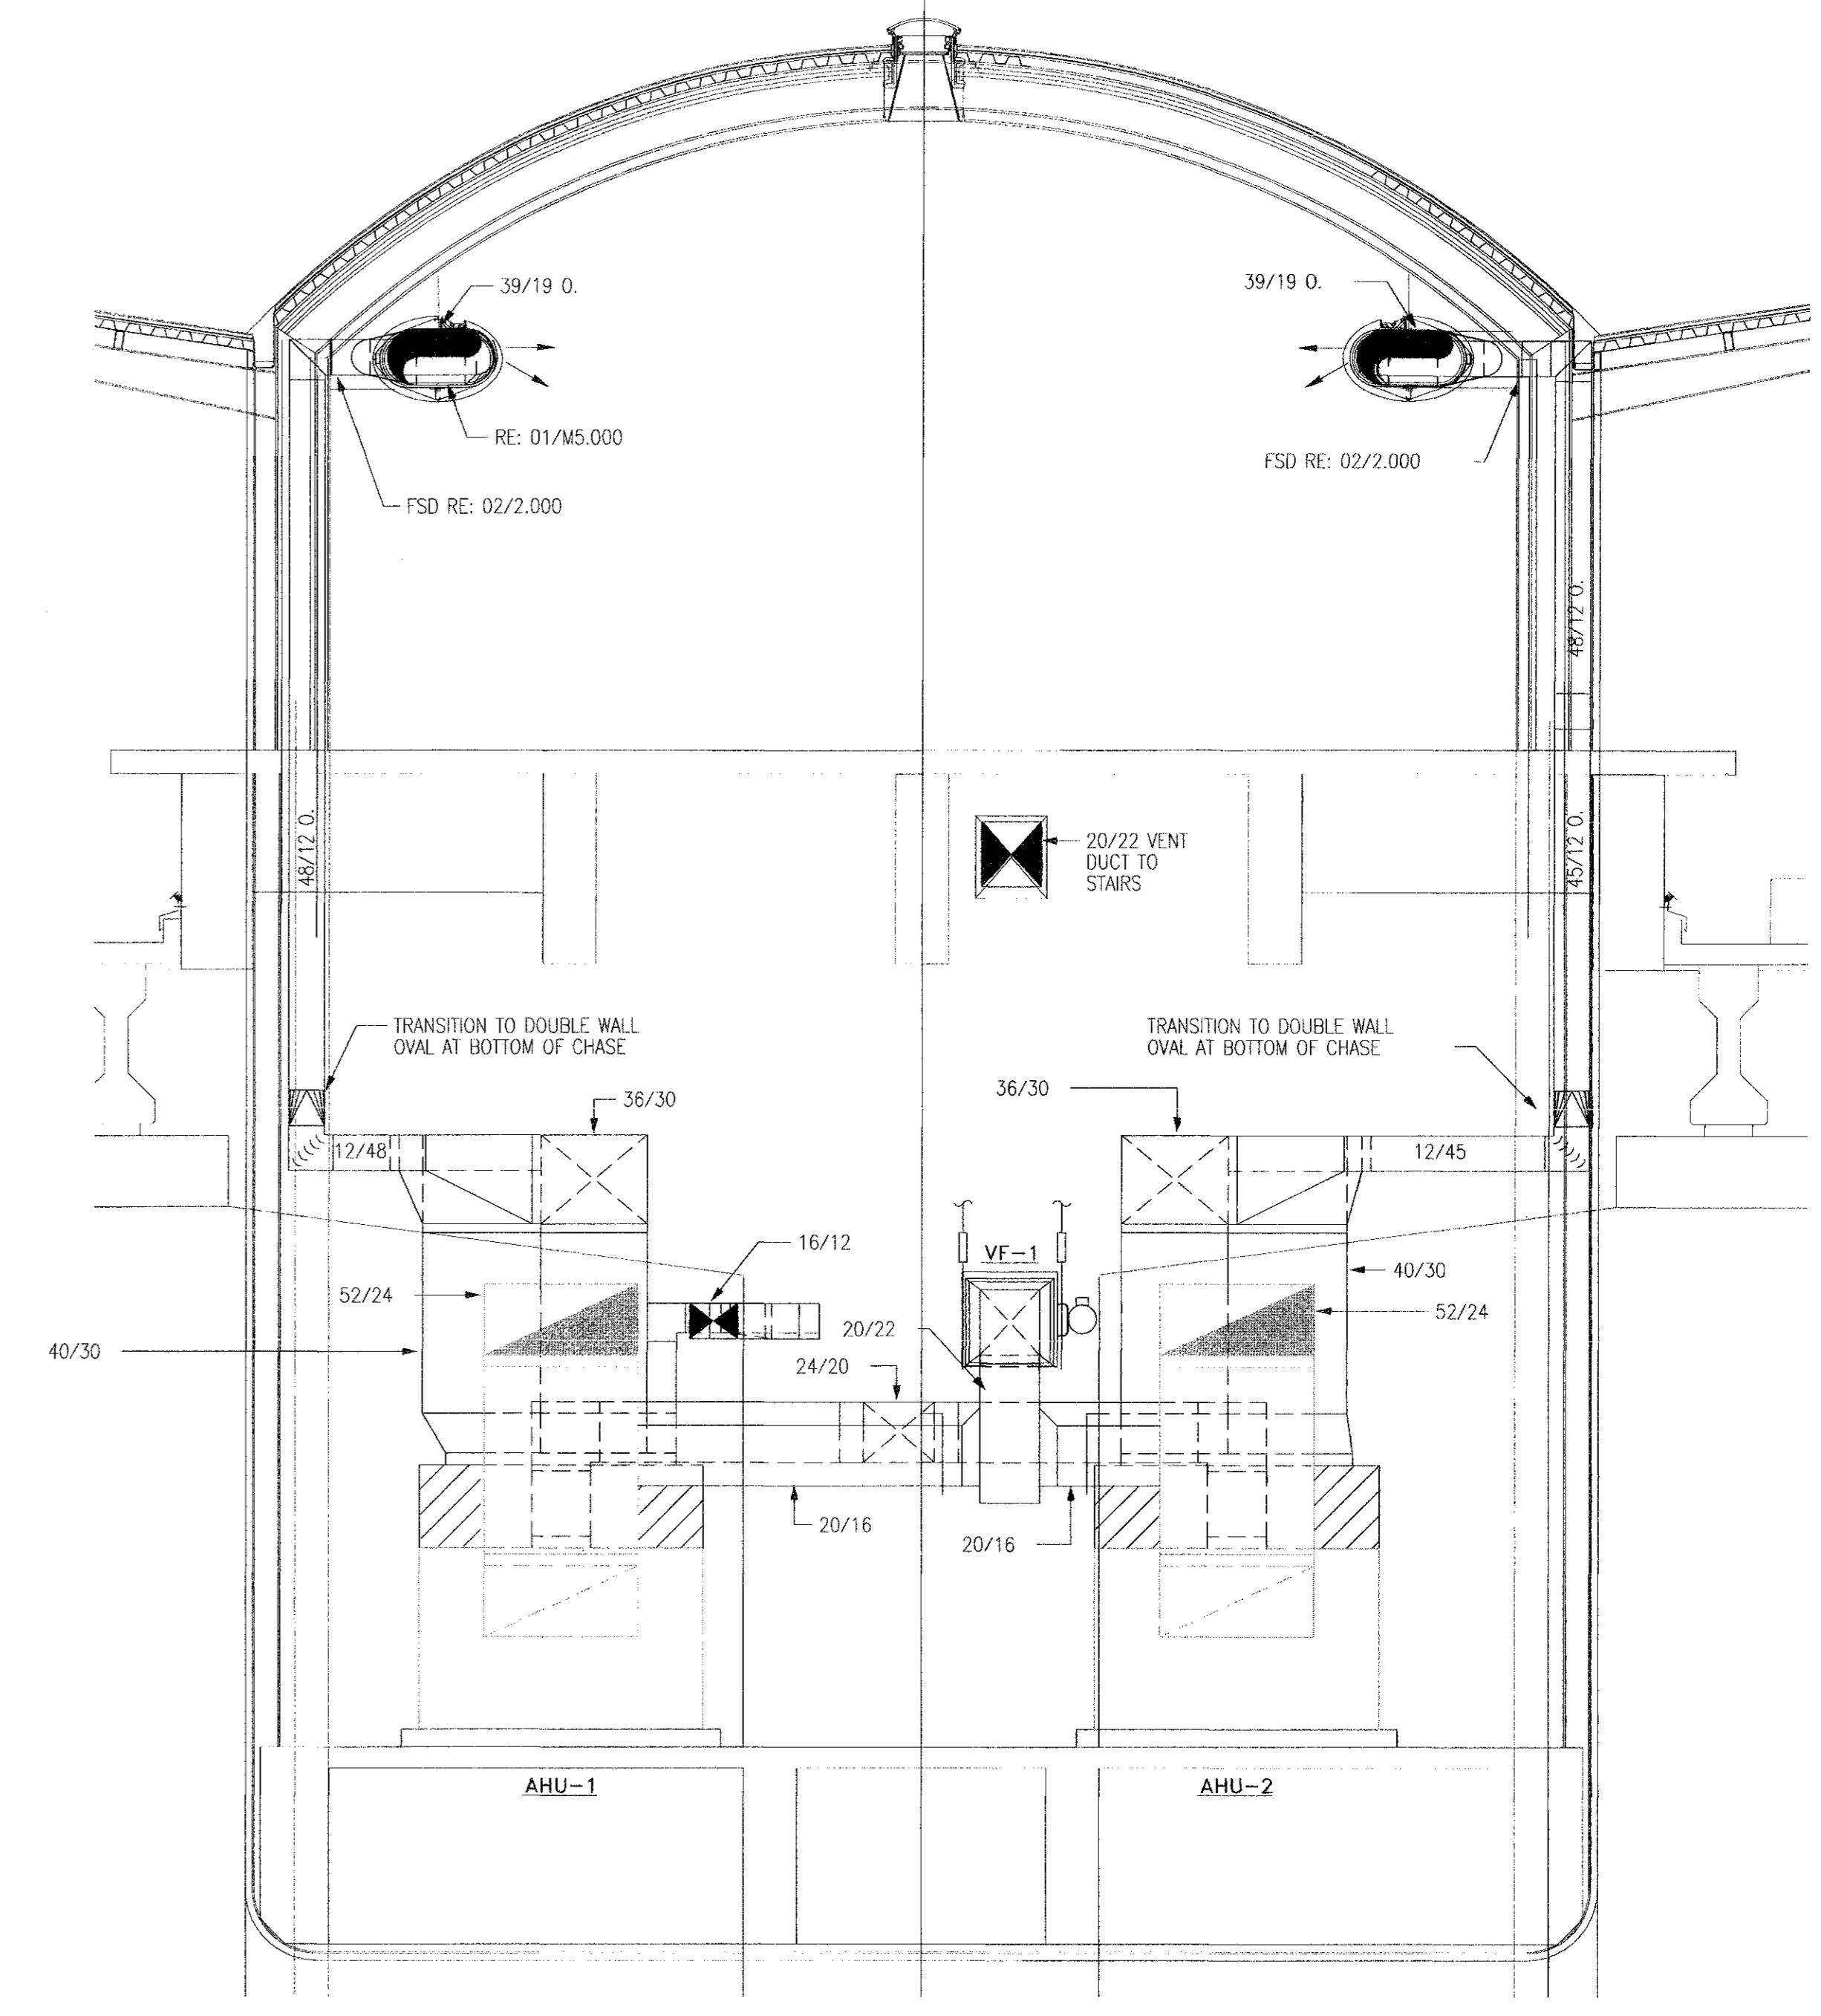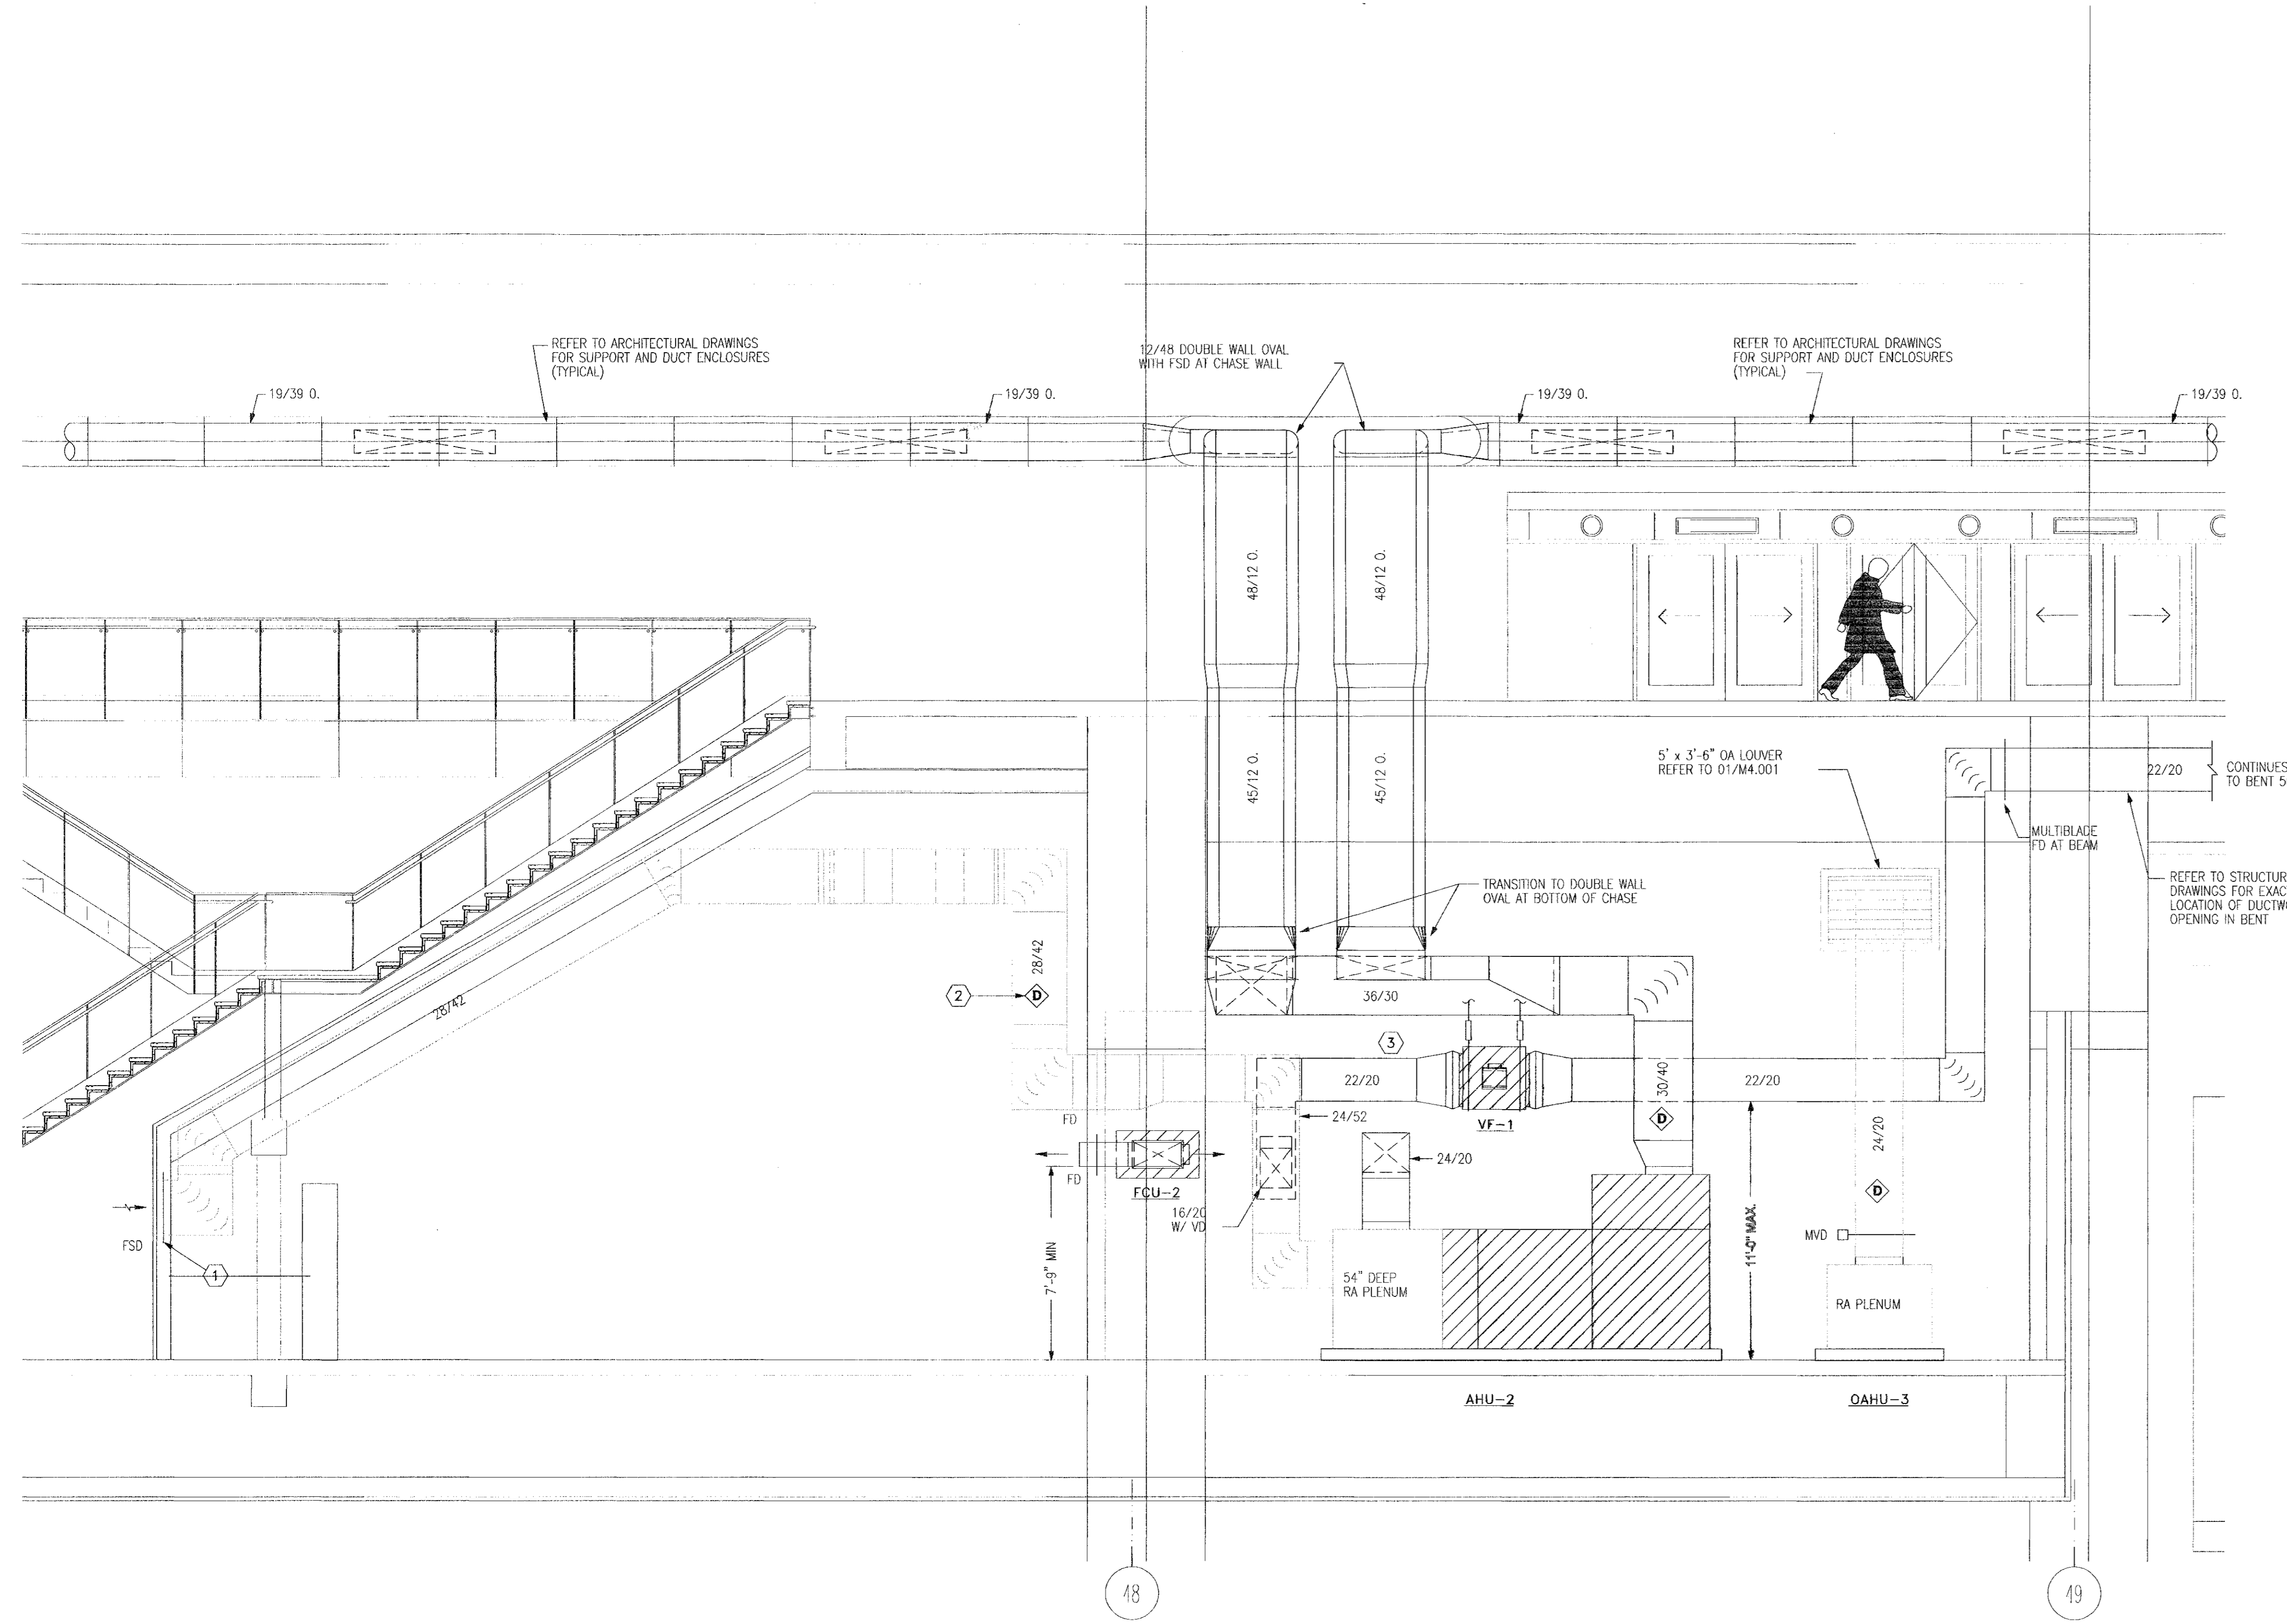

KEYED NOTES:

- ① VF-1 AND AHU-2 SHALL BE DE-ENERGIZED WHEN FSD IN RETURN DUCTWORK IS CLOSED. PROVIDE END SWITCHES, RELAYS, WIRING, CONDUIT, ETC. AS REQUIRED.
- ② VF-1 AND AHU-2 SHALL BE DE-ENERGIZED THRU FIRE ALARM SYSTEM BY Ⓢ ACTIVATION IN RETURN AIR DUCTWORK.
- ③ PROVIDE THRUST RESTRAINTS AT VF-1.

GENERAL NOTES:

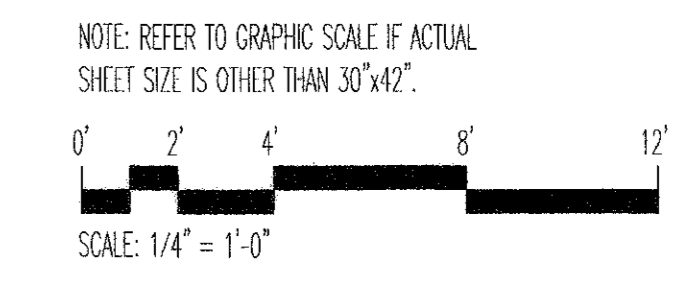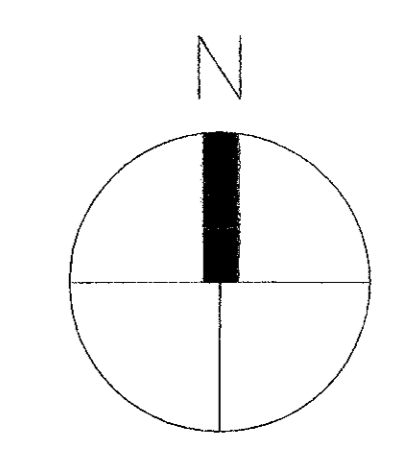

INTERNATIONAL SERVICES EXPANSION PROGRAM  
**APM STATION + PLATFORM**  
 HVAC SECTIONS

PROJECT MGR:	AJ. BELTRAN
DESIGNER:	C. COBB
DRAWN BY:	E. STREBLING
CHECKED BY:	C. COBB
DRAWING STANDARD:	SEP 07.20.2000
SCALE:	AS NOTED
DATE:	06/14/01

**RECORD DRAWING**  
 THIS DRAWING HAS BEEN REVEALED TO SHOW SIGNIFICANT CHANGES IN THE WORK MADE DURING CONSTRUCTION BASED ON MARKED-UP PRINTS, DRAWINGS AND OTHER DATA.

APPROVED BY:	DATE:
DIRECTOR HOUSTON AIRPORT SYSTEM	
PROJECT NO.	1061-001
C.I.P. NO.	A 0354
H.A.S. NO.	538C
SHEET NO.	


M4.000




REVISIONS

NO.	DESCRIPTION	DATE	BY
1	ISSUED FOR BID	10/19/01	
2	RECORD DRAWING	05/06/05	

INTERNATIONAL SERVICES EXPANSION PROGRAM  
**APM STATION + PLATFORM**  
 HVAC SECTIONS

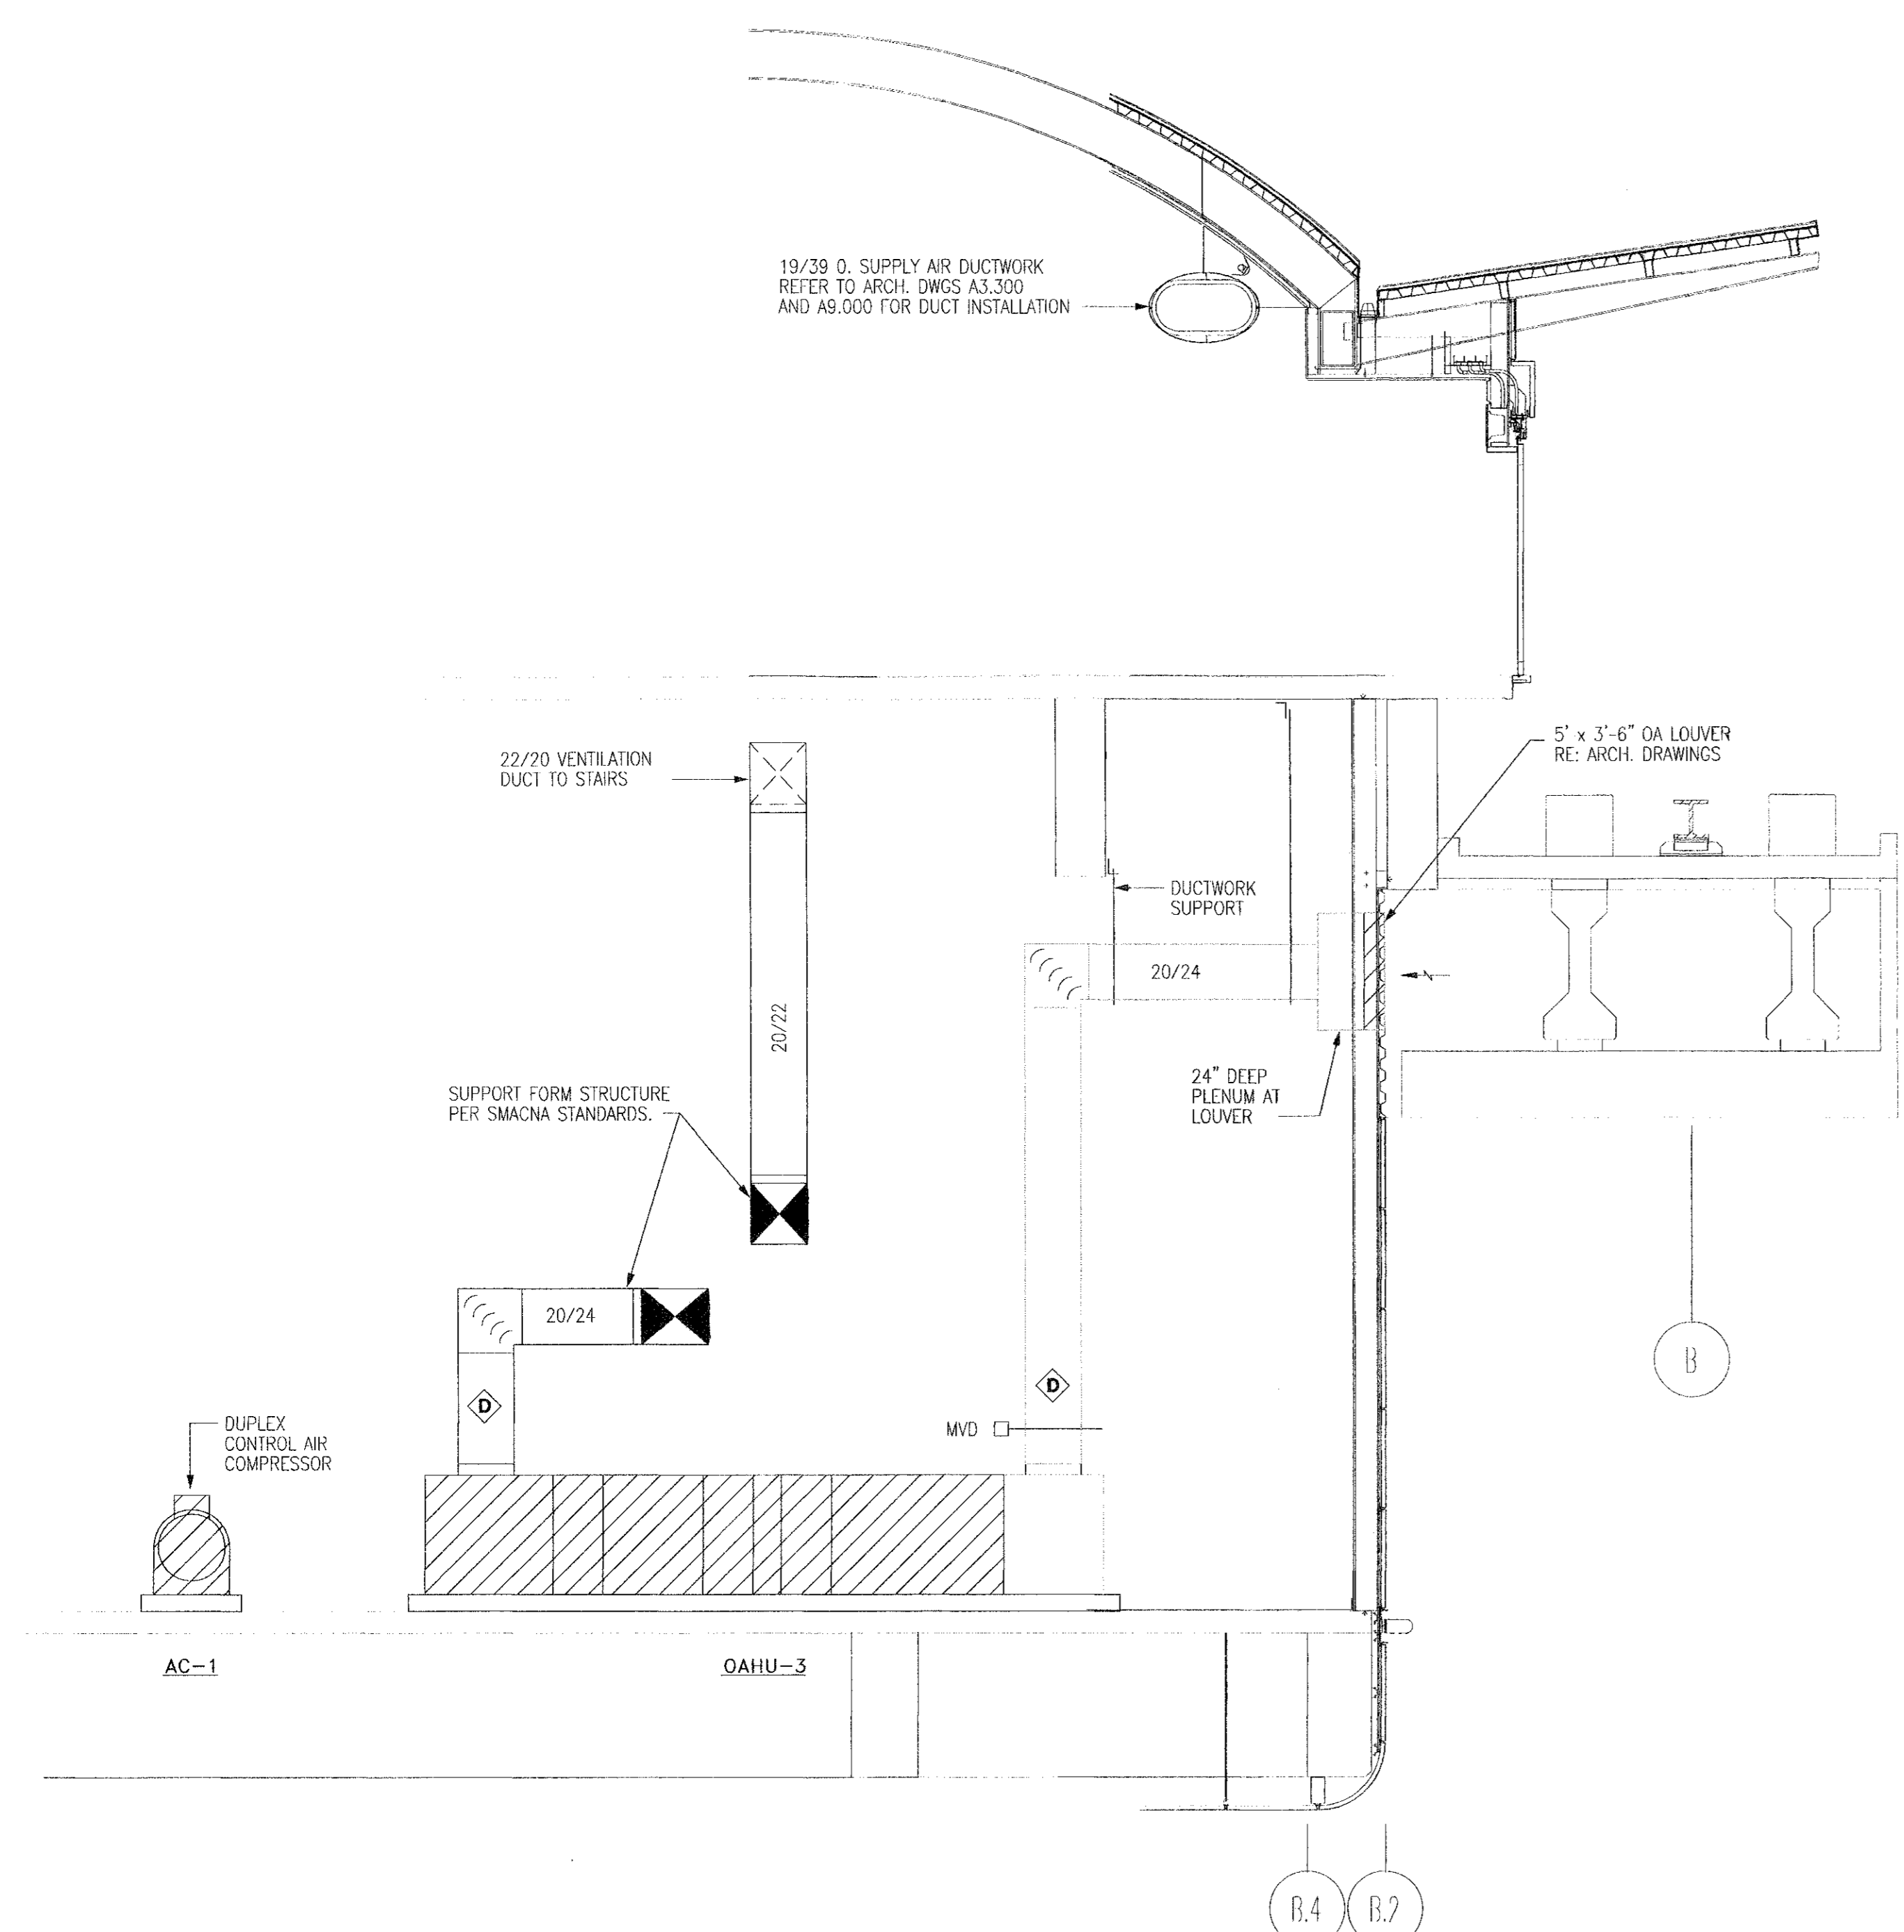

**01** APM STATION-HVAC SECTION  
 M4.001 1/4" = 1'-0"

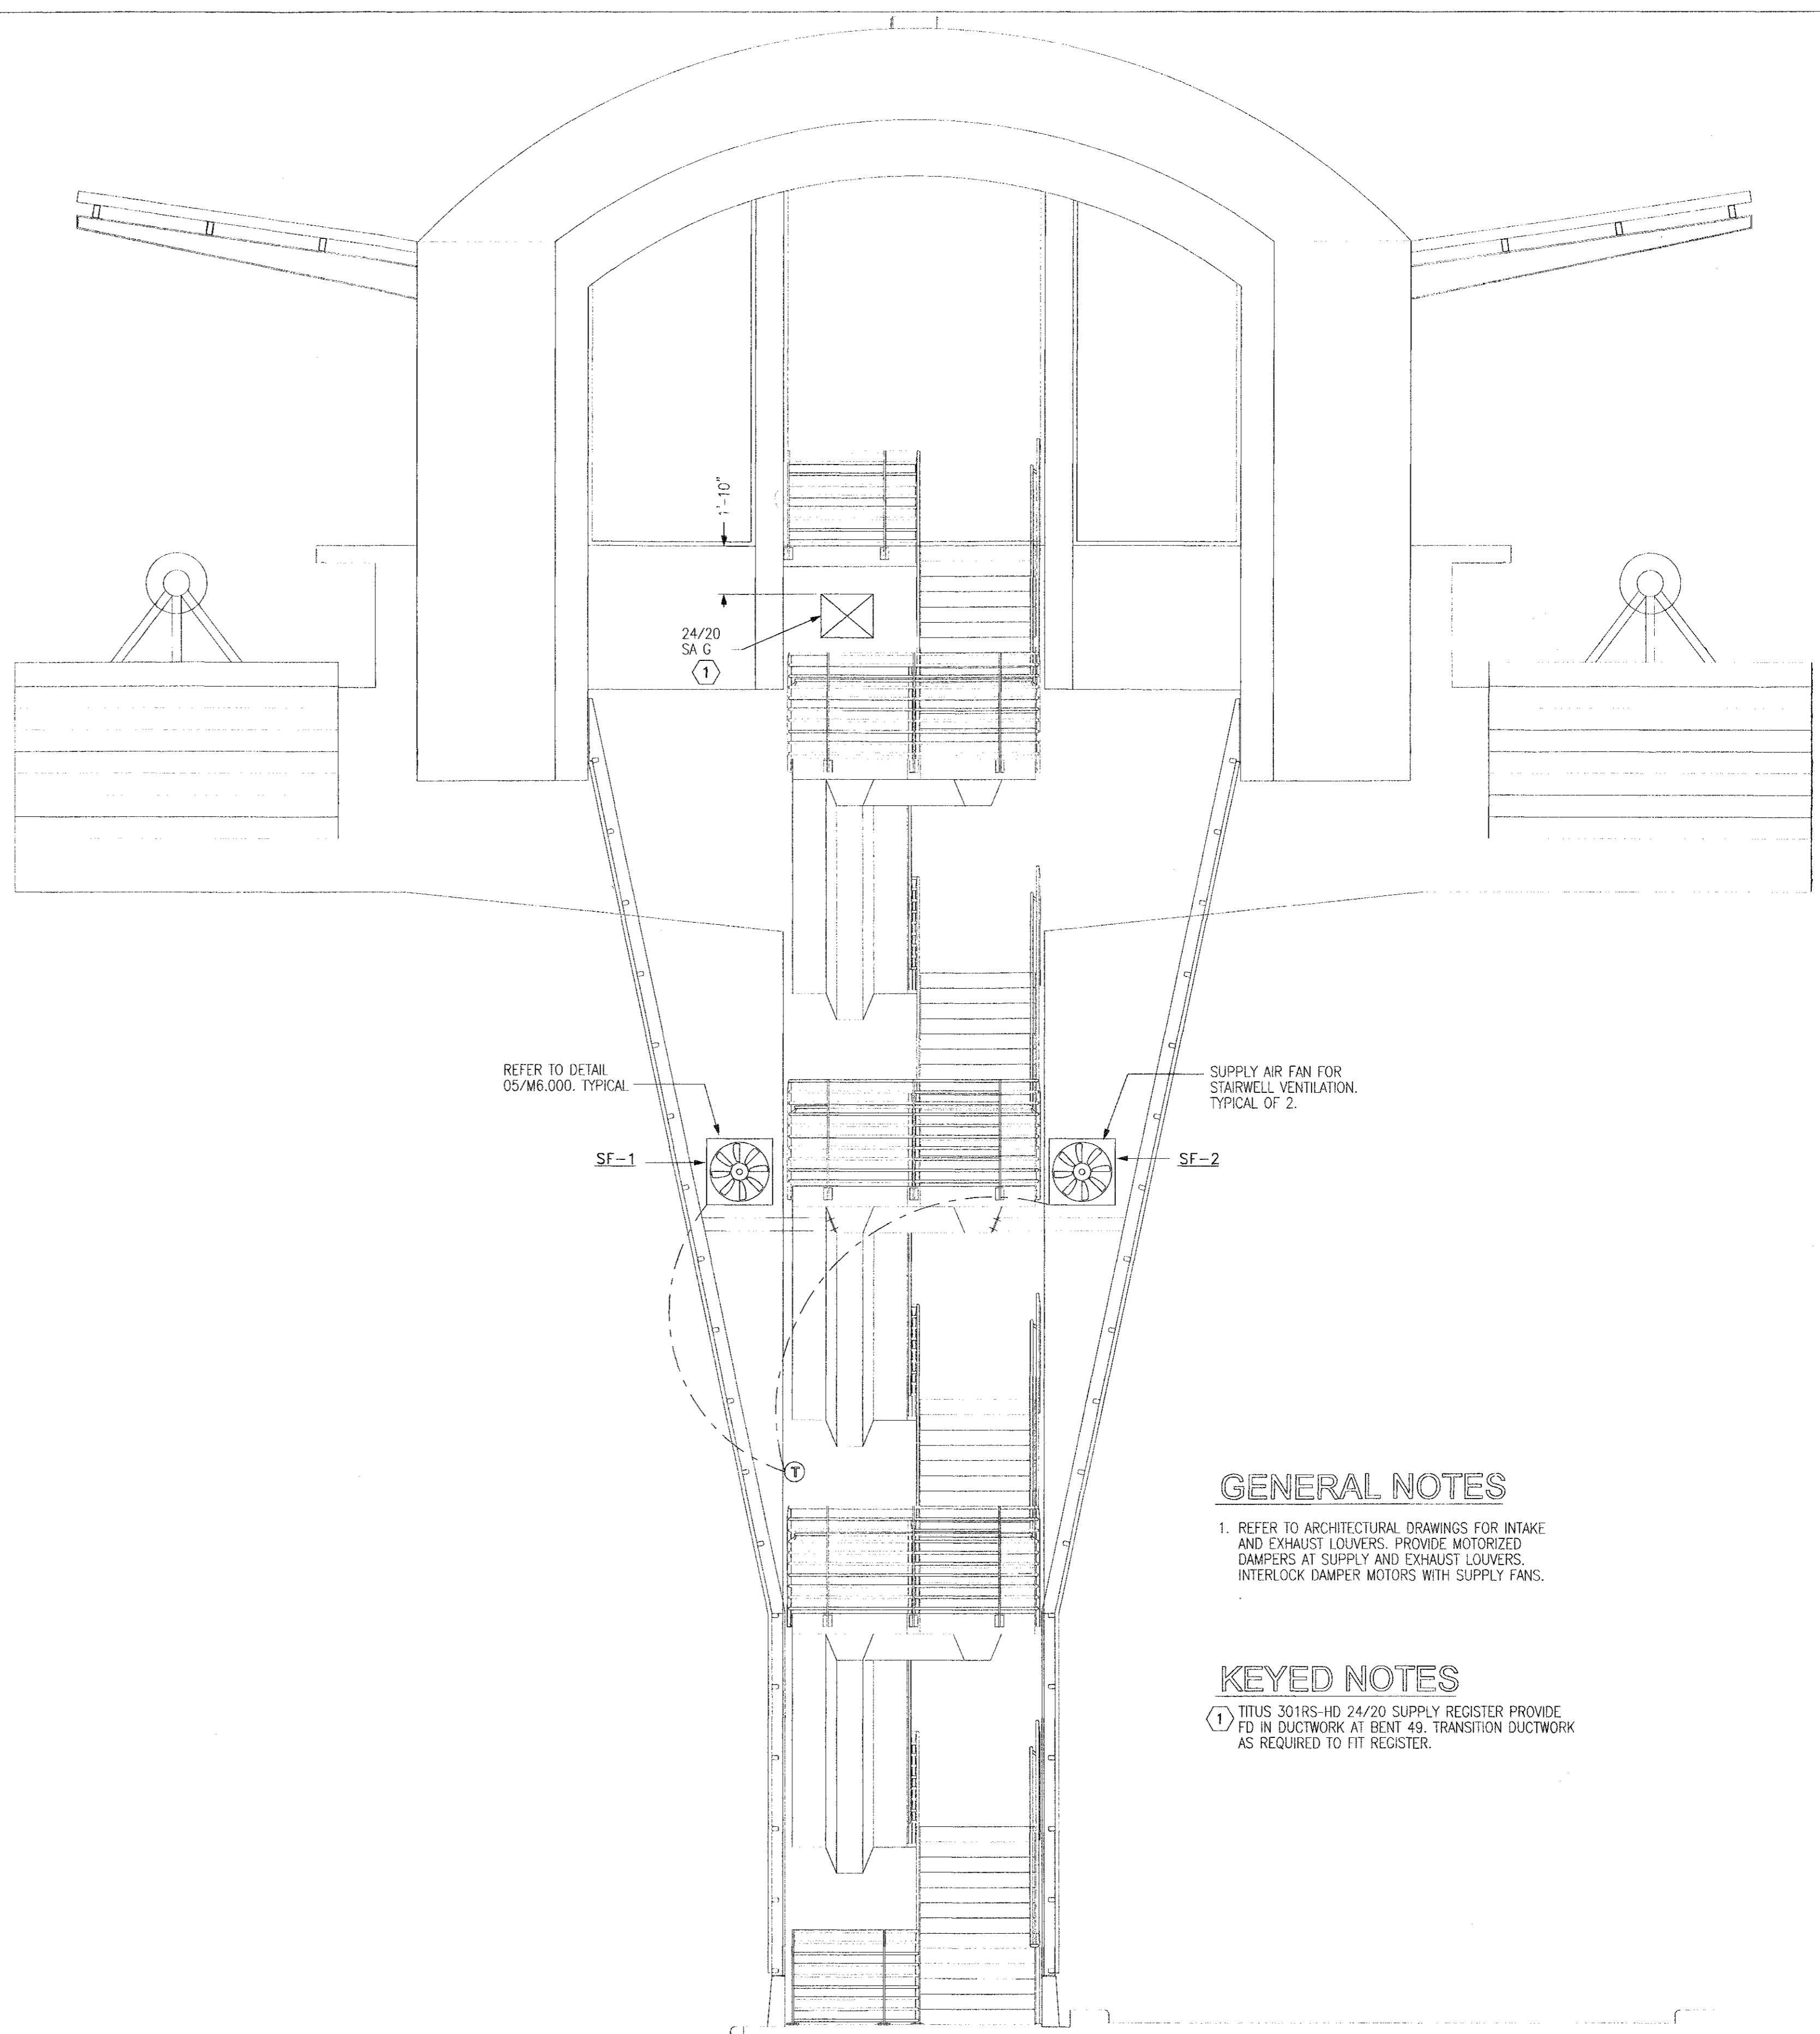

**02** APM STATION-HVAC SECTION  
 M4.001 1/4" = 1'-0"

**GENERAL NOTES**



- REFER TO ARCHITECTURAL DRAWINGS FOR INTAKE AND EXHAUST LOUVERS. PROVIDE MOTORIZED DAMPERS AT SUPPLY AND EXHAUST LOUVERS. INTERLOCK DAMPER MOTORS WITH SUPPLY FANS.

**KEYED NOTES**

- TIUS 301RS-HD 24/20 SUPPLY REGISTER PROVIDED IN DUCTWORK AT BENT 49. TRANSITION DUCTWORK AS REQUIRED TO FIT REGISTER.

**KEYED NOTES:**

**GENERAL NOTES:**

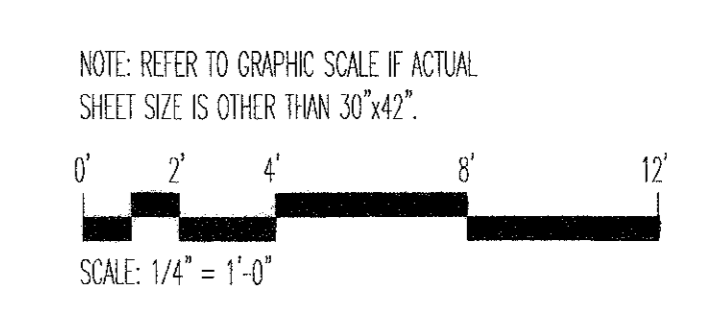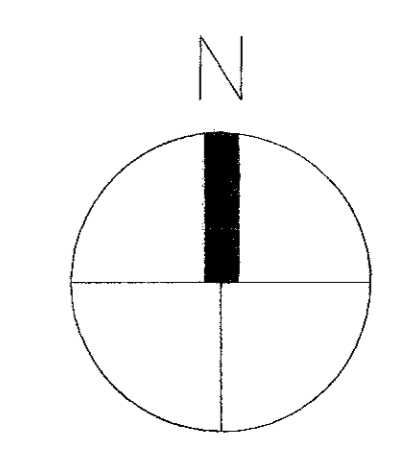

PROJECT MGR: ALEKSIYAN  
 DESIGNER: C. COBB  
 DRAWN BY: E. STREIBLING  
 CHECKED BY: C. COBB  
 DRAWING STANDARD: SEP 07.20.2000  
 SCALE: AS NOTED  
 DATE: 09/14/01

**RECORD DRAWING**  
 THIS DRAWING HAS BEEN REVISED TO SHOW SIGNIFICANT CHANGES IN THE WORK MADE DURING CONSTRUCTION BASED ON MARKED-UP PRINTS, DRAWINGS AND OTHER DATA.



APPROVED BY: \_\_\_\_\_ DATE: \_\_\_\_\_  
 DIRECTOR  
 HOUSTON AIRPORT SYSTEM

PROJECT NO: 1001-001  
 C.L.P. NO: A-0354  
 H.A.S. NO: \_\_\_\_\_  
 SHEET NO: 5/SEC



REVISIONS

NO.	DESCRIPTION	DATE	BY
1	ISSUED FOR BID	10/19/05	
2	RECORD DRAWING	05/08/06	

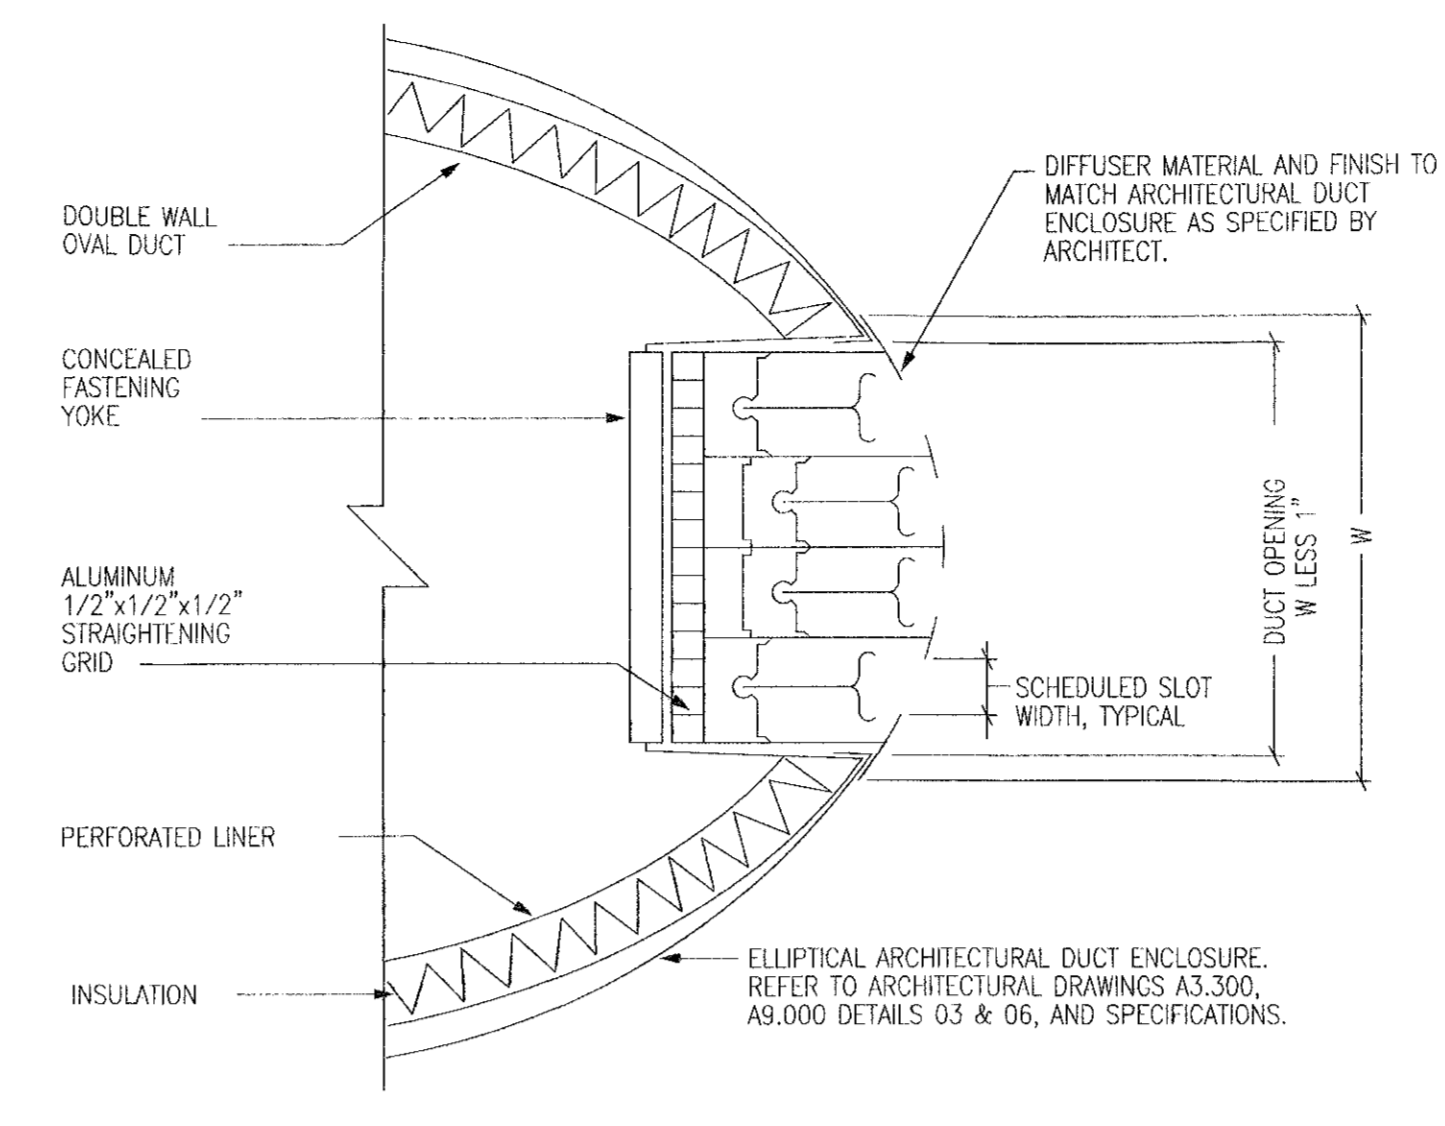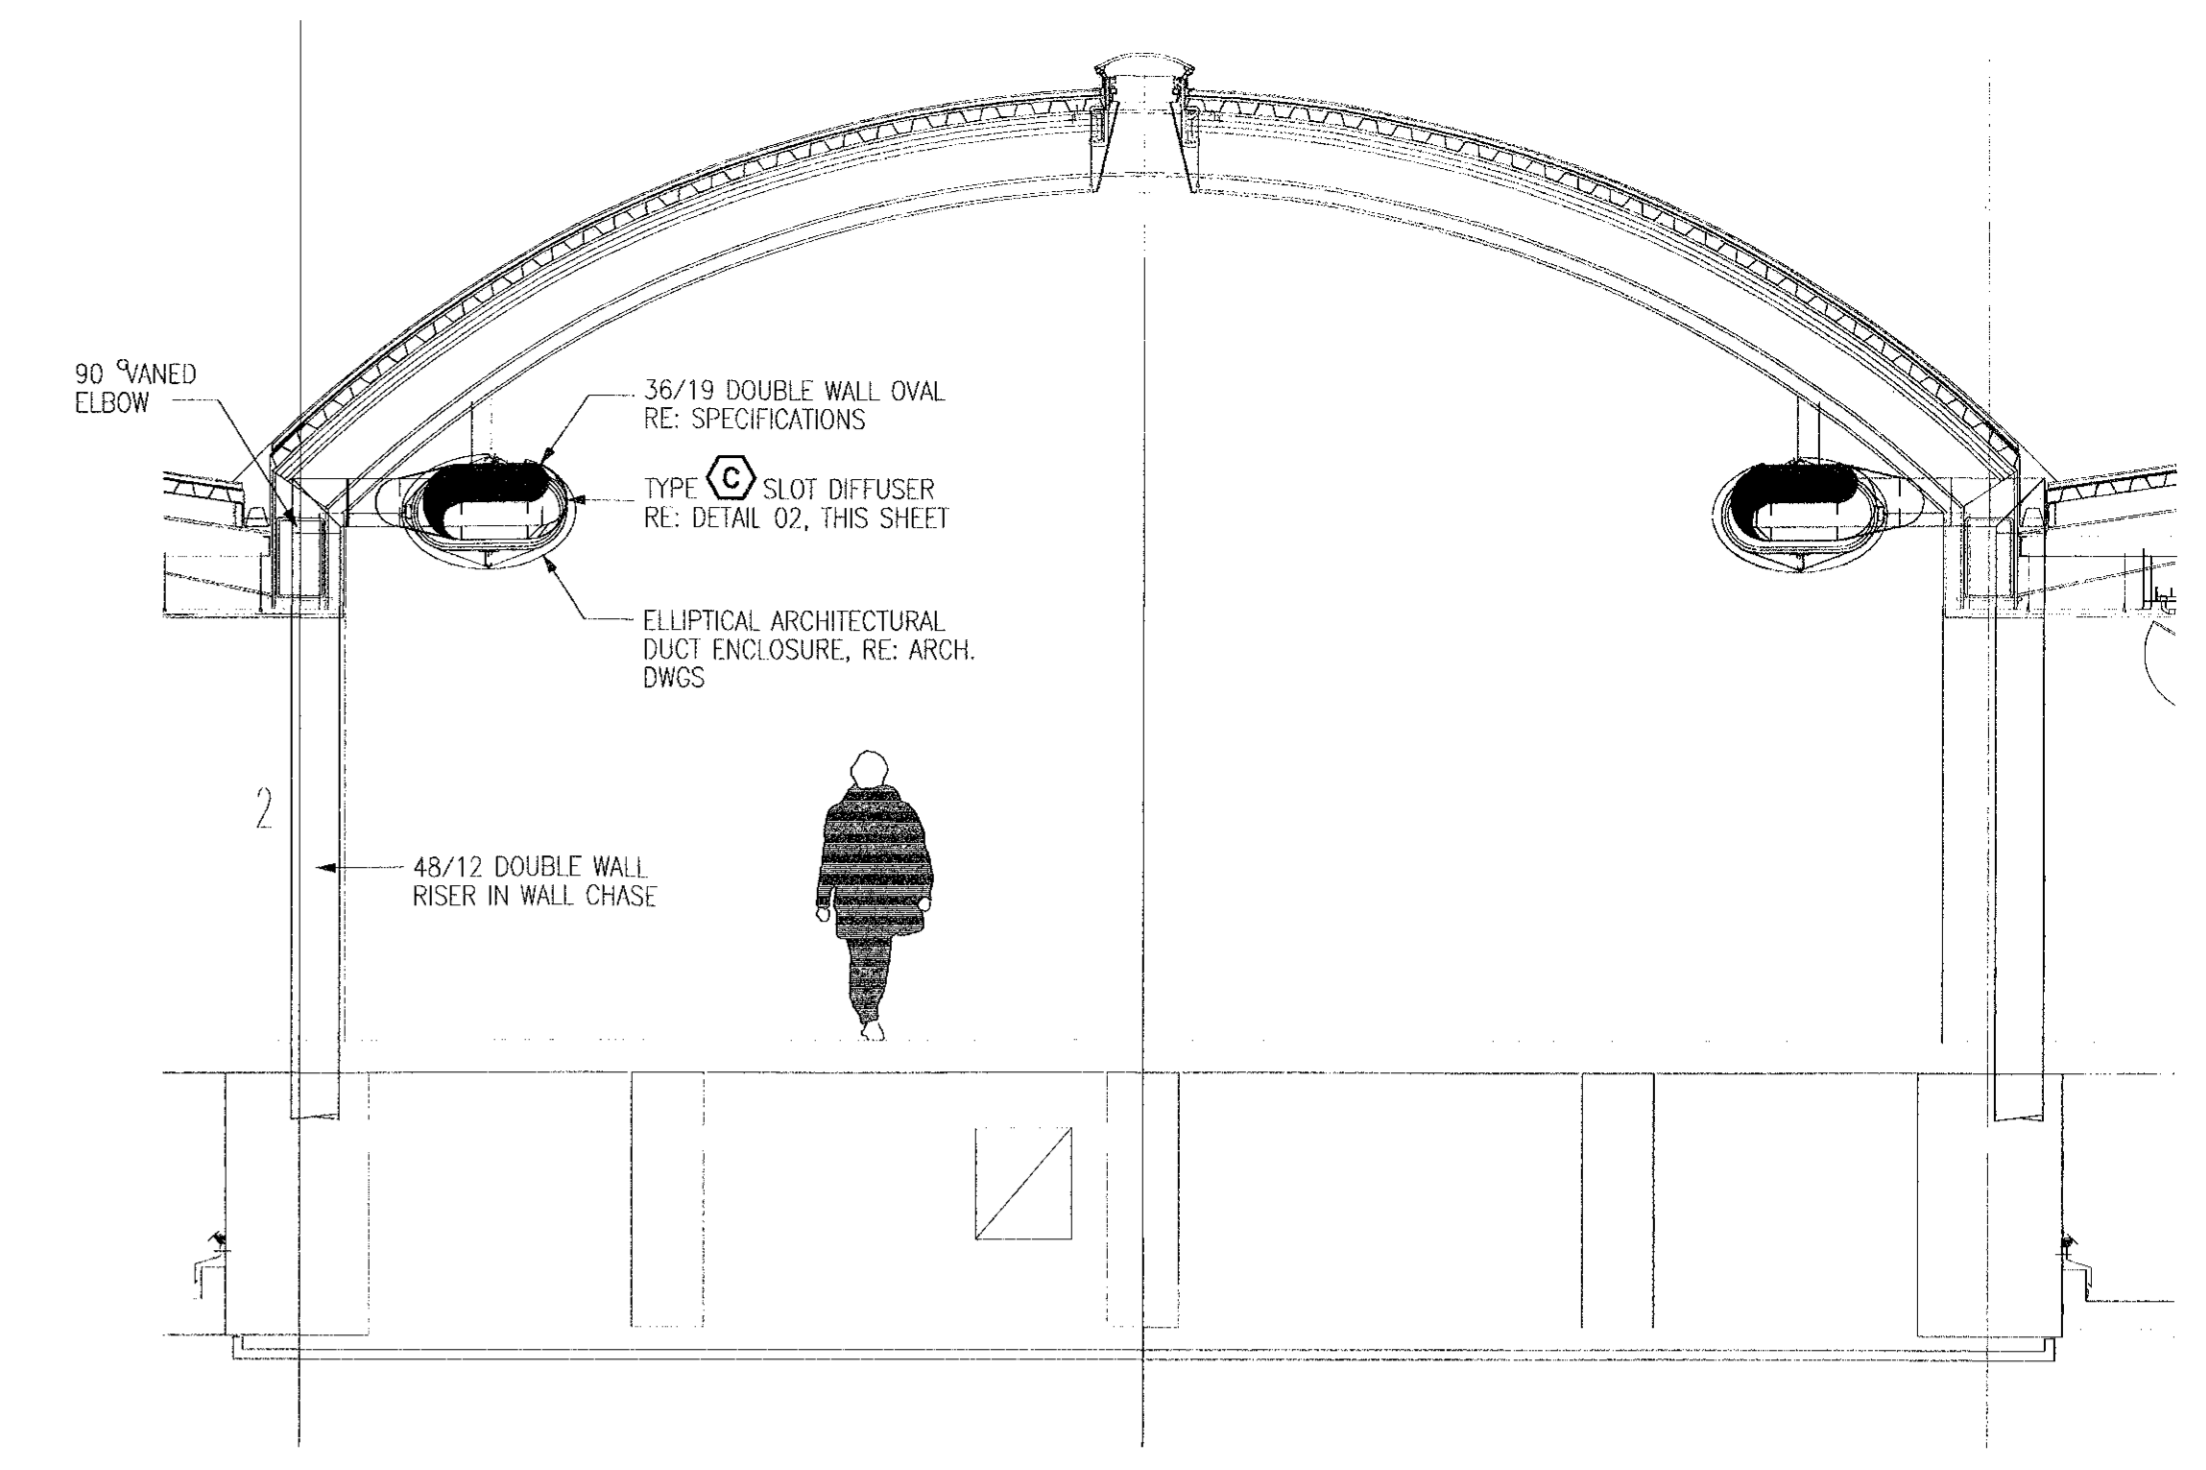


NOTE: PROVIDE SAMPLE SECTION OF DUCTWORK WITH ENCLOSURE AND DIFFUSER INSTALLATION FOR ARCHITECT'S APPROVAL PRIOR TO DUCTWORK INSTALLATION.

01 SECTION DETAIL  
 1/4" = 1'-0"

**AIR HANDLER TRAP DIMENSIONS (MIN)**


UNIT	FAN TYPE	TH	X	H	Z * (MIN)
AHU-1,2	BLOW THRU (+)	11.5	6.5	2.0	1 3/8
DAHU-3	DRAW THRU (-)	12.0	3.0	6.0	1 3/8

\* PLUS INSULATION THICKNESS

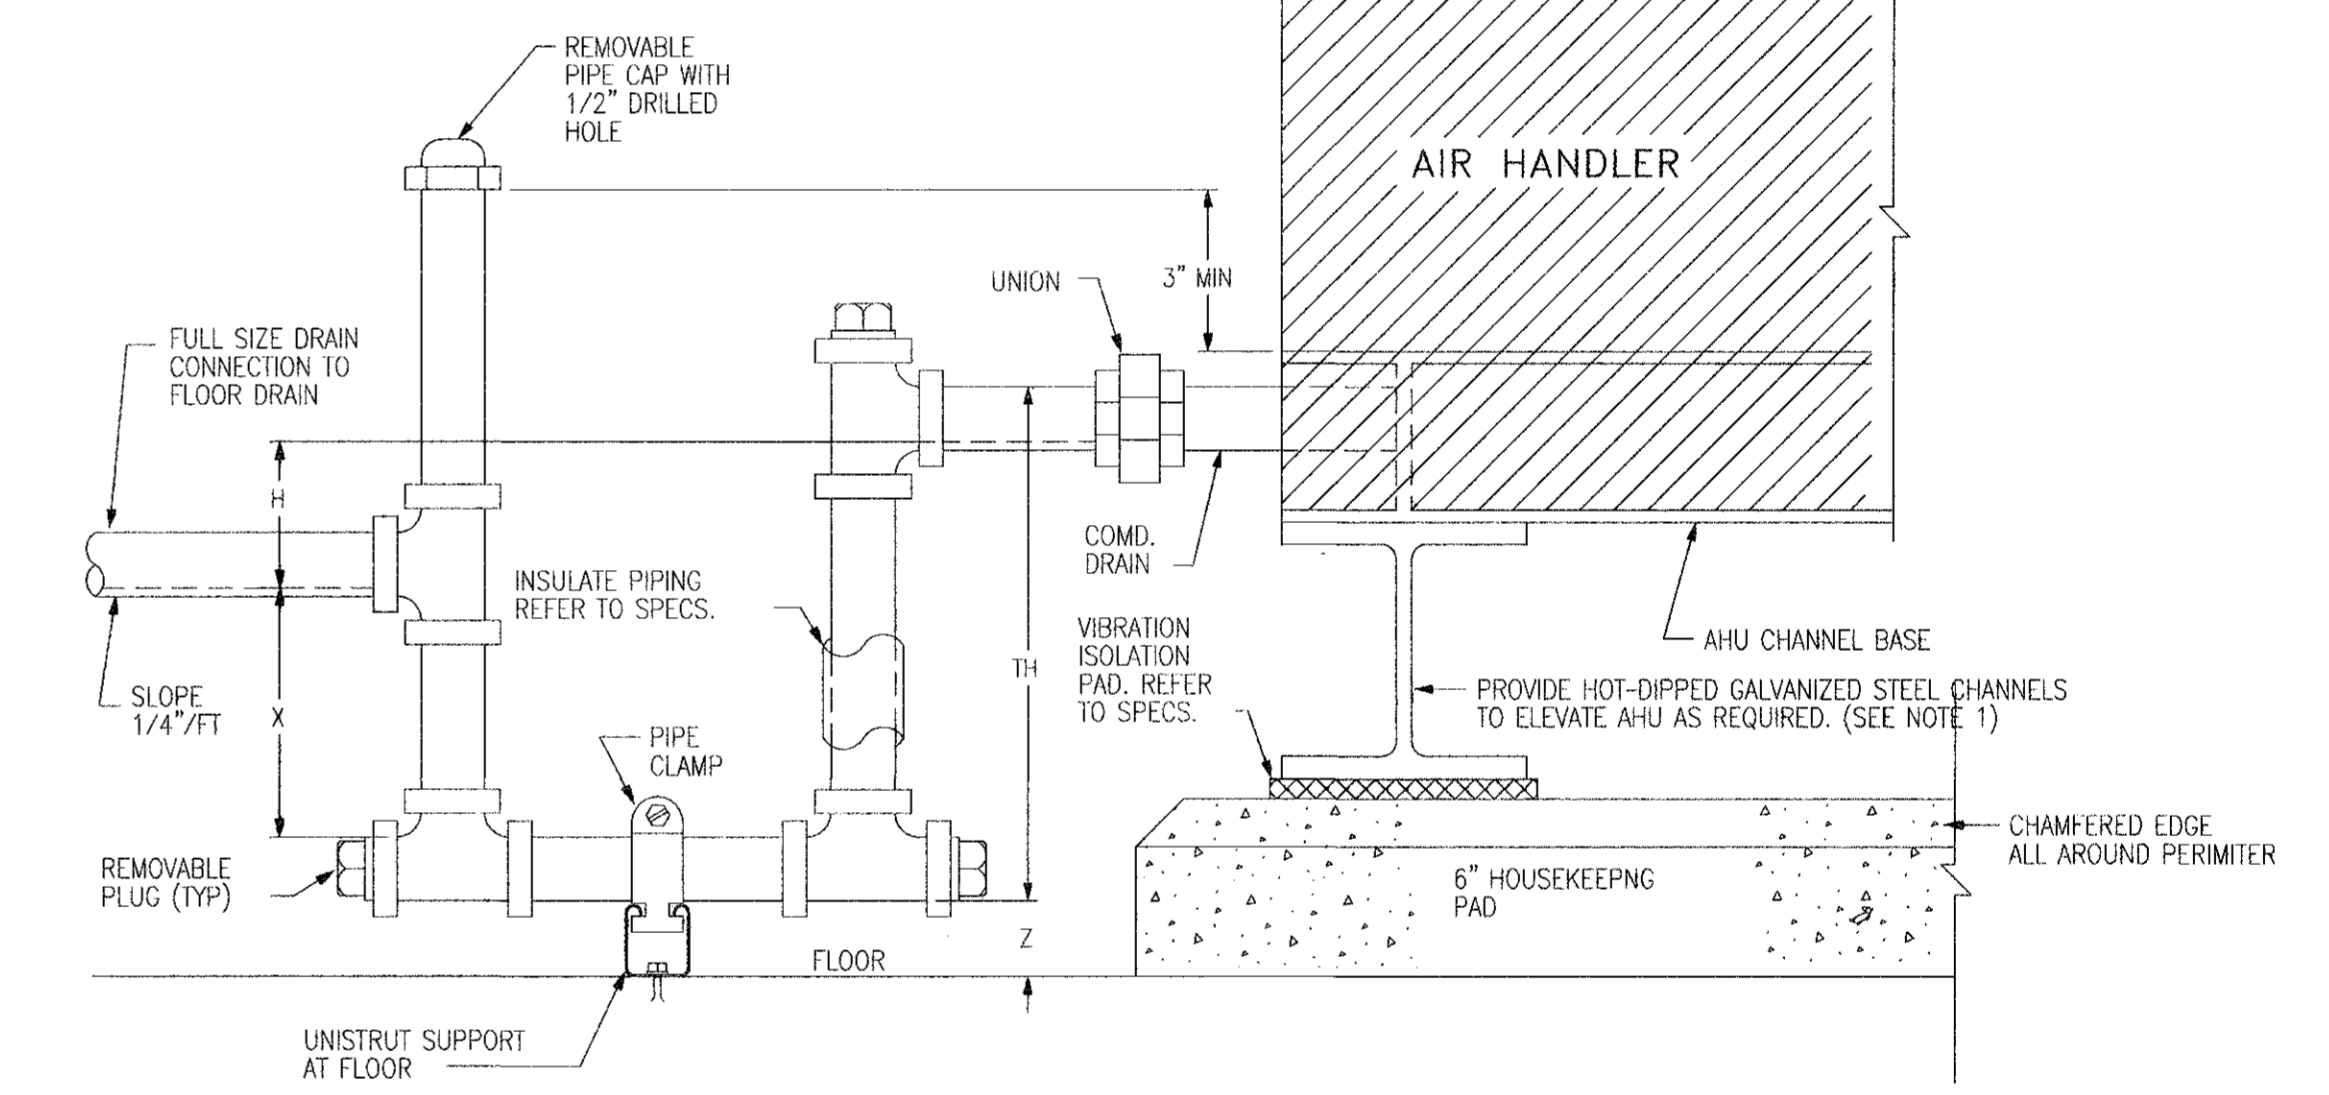


- NOTES
1. IN ACCORDANCE WITH SPECIFICATIONS PROVIDE CHANNEL BASE TO SUPPORT UNIT AS REQUIRED TO ACCOMMODATE TRAP AND SLOPE OF DRAIN LINE TO FLOOR DRAIN.
  2. ADJUST TRAP TO SUIT TOTAL STATIC PRESSURE OF UNITS PROVIDED.
  3. PROVIDE ADDITIONAL HEIGHT AT "Z" AS REQUIRED TO ACCOMMODATE PIPING SLOPE AND ELBOW AT FLOOR DRAIN.

05 CONDENSATE DRAIN DETAIL  
 1/8" = 1'-0"

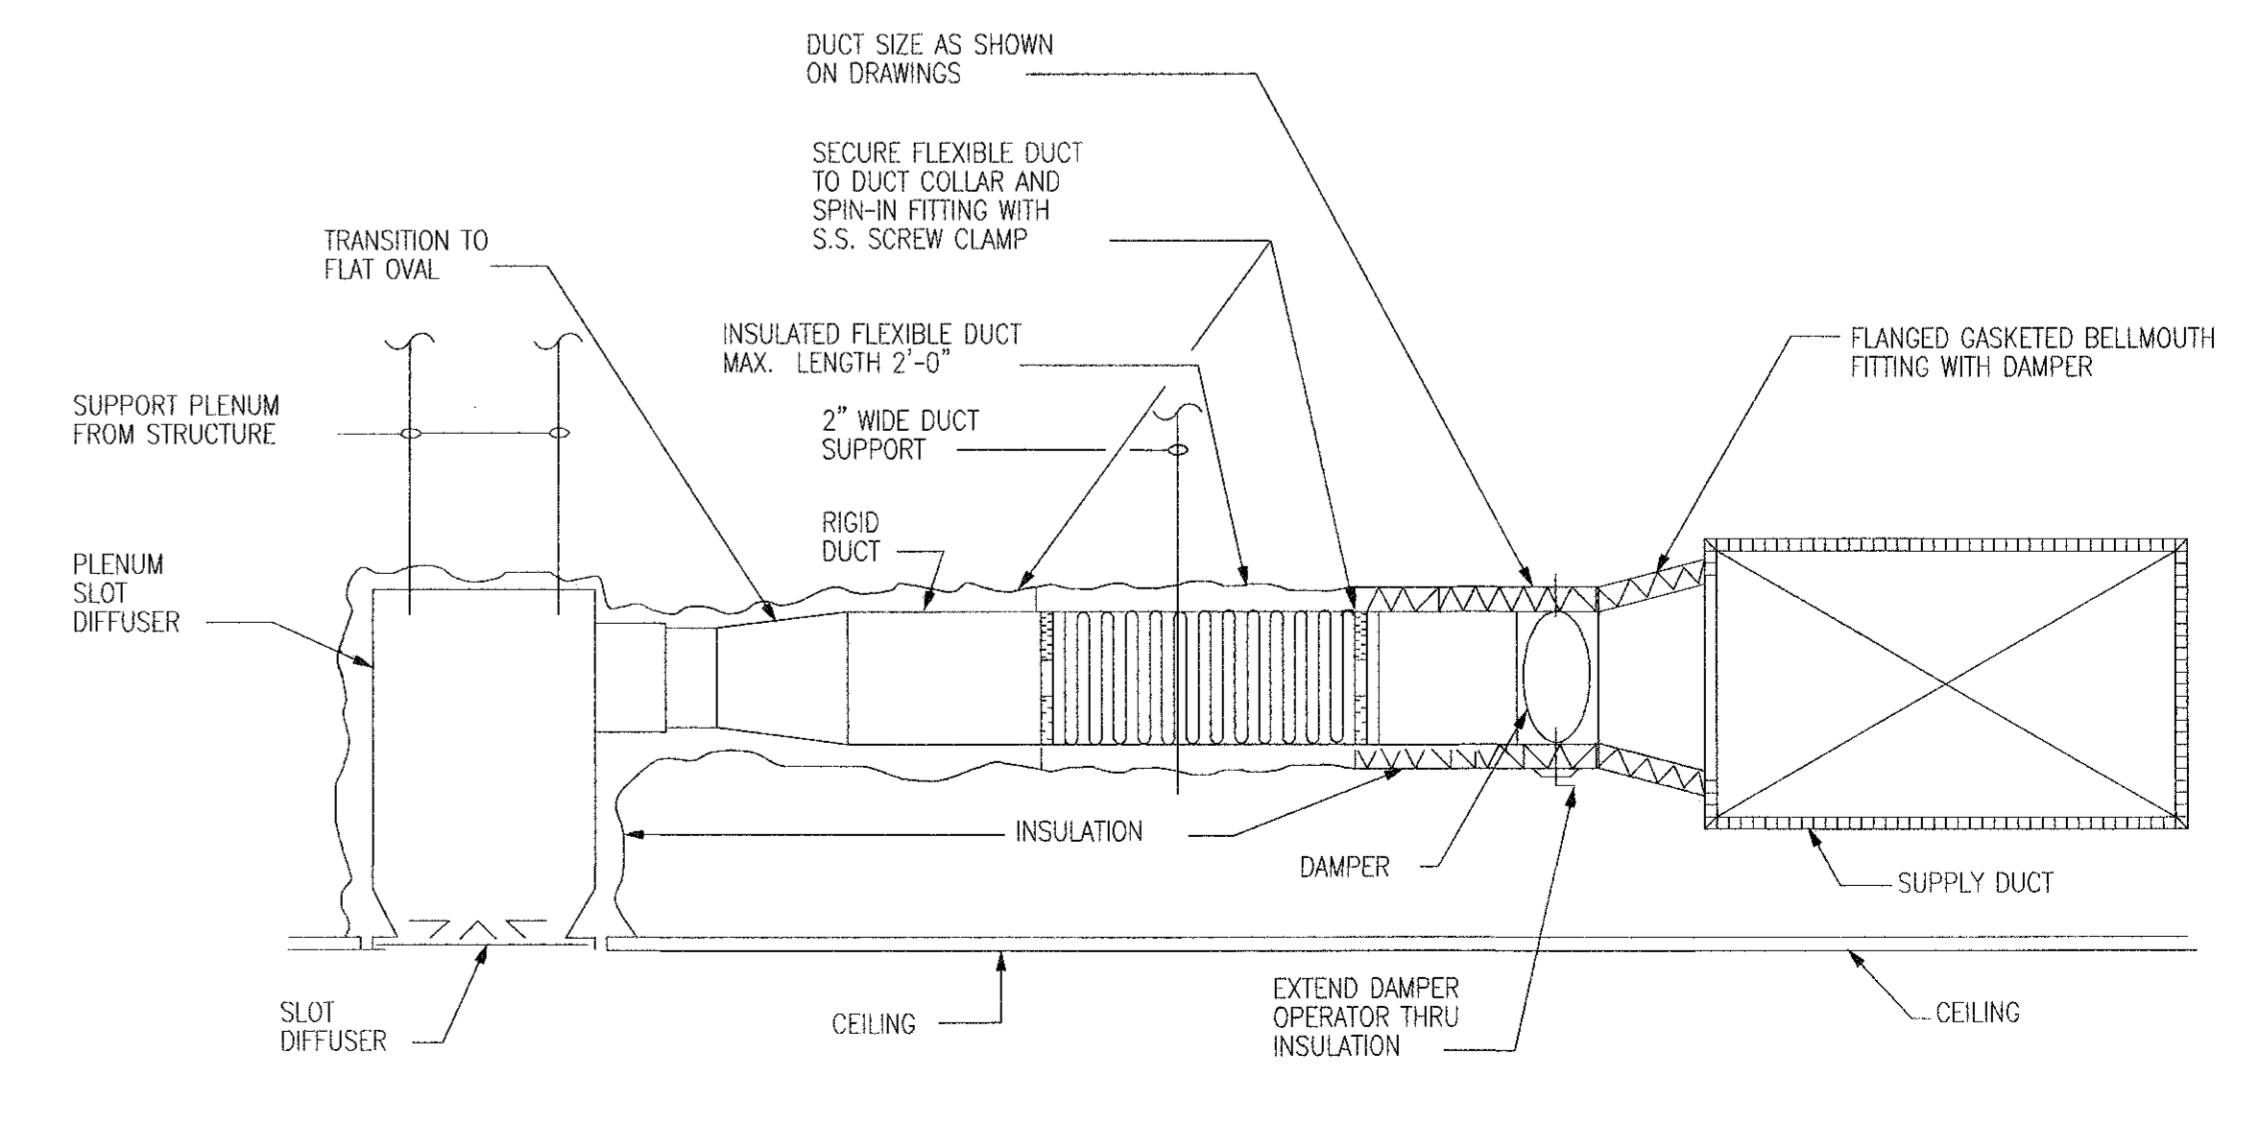


08 PLENUM SLOT DIFFUSER CONNECTION DETAIL  
 1/8" = 1'-0"

02 DIFFUSER INSTALLATION DETAIL  
 1/8" = 1'-0"

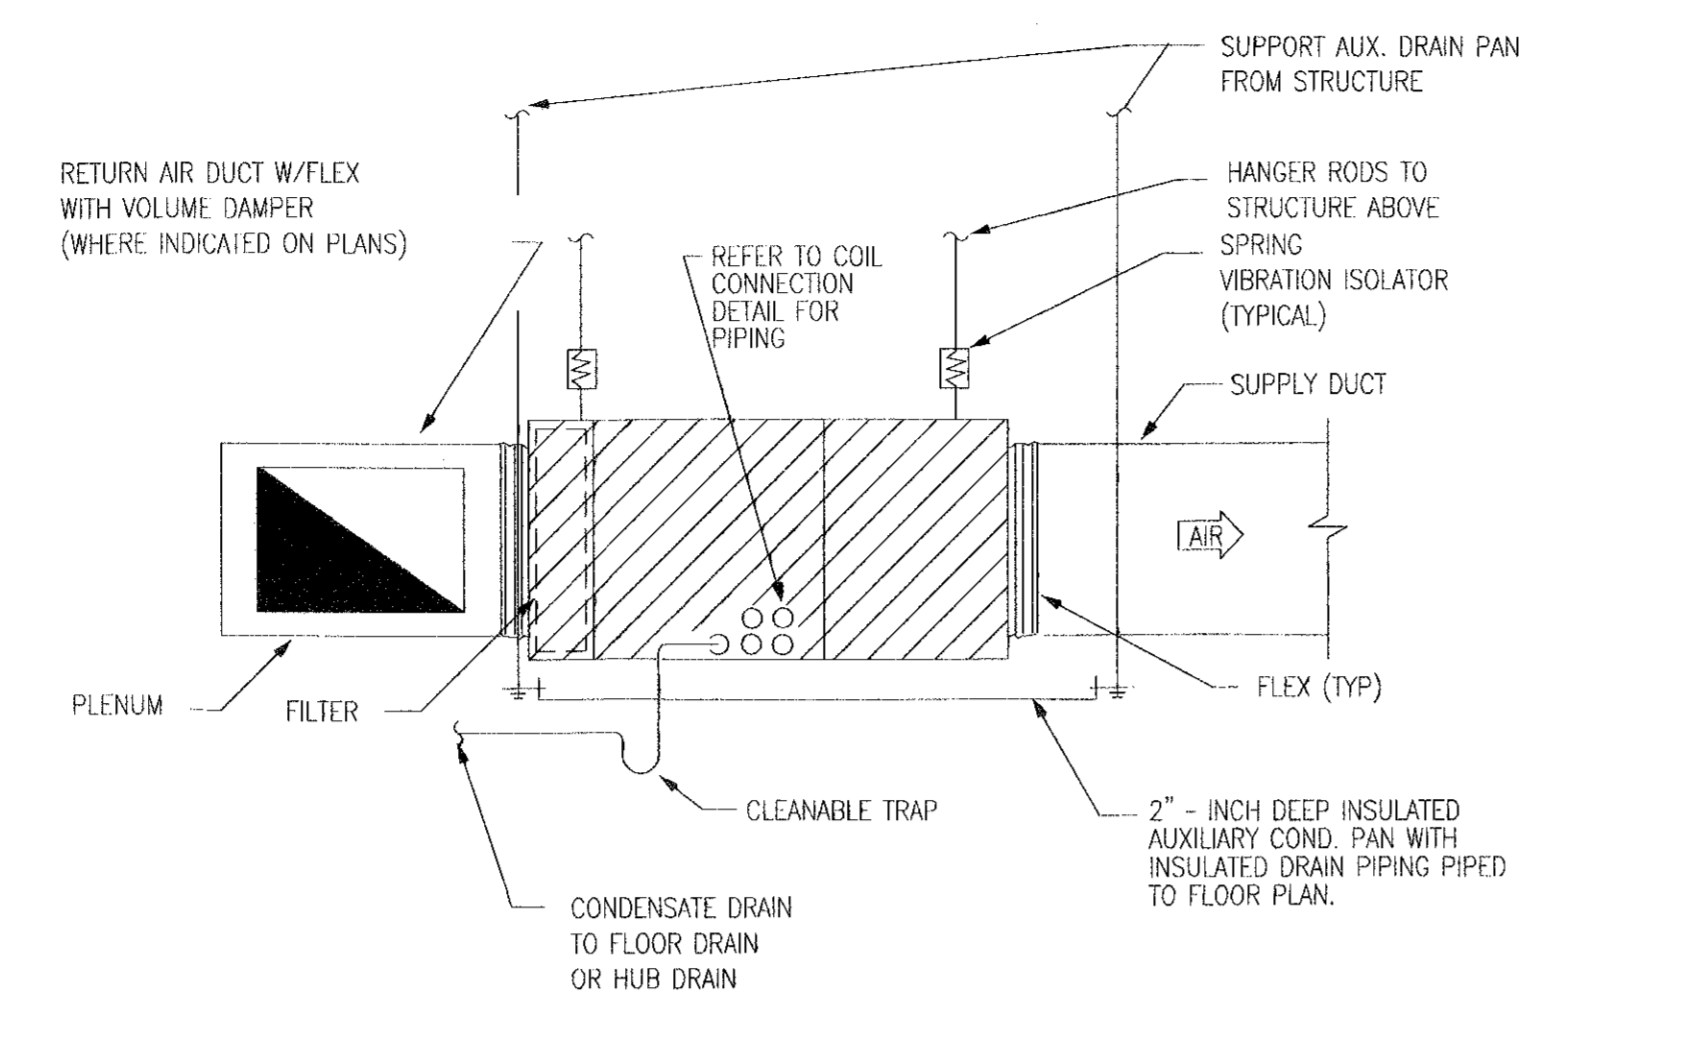


03 FAN COIL UNIT DETAIL  
 1/8" = 1'-0"

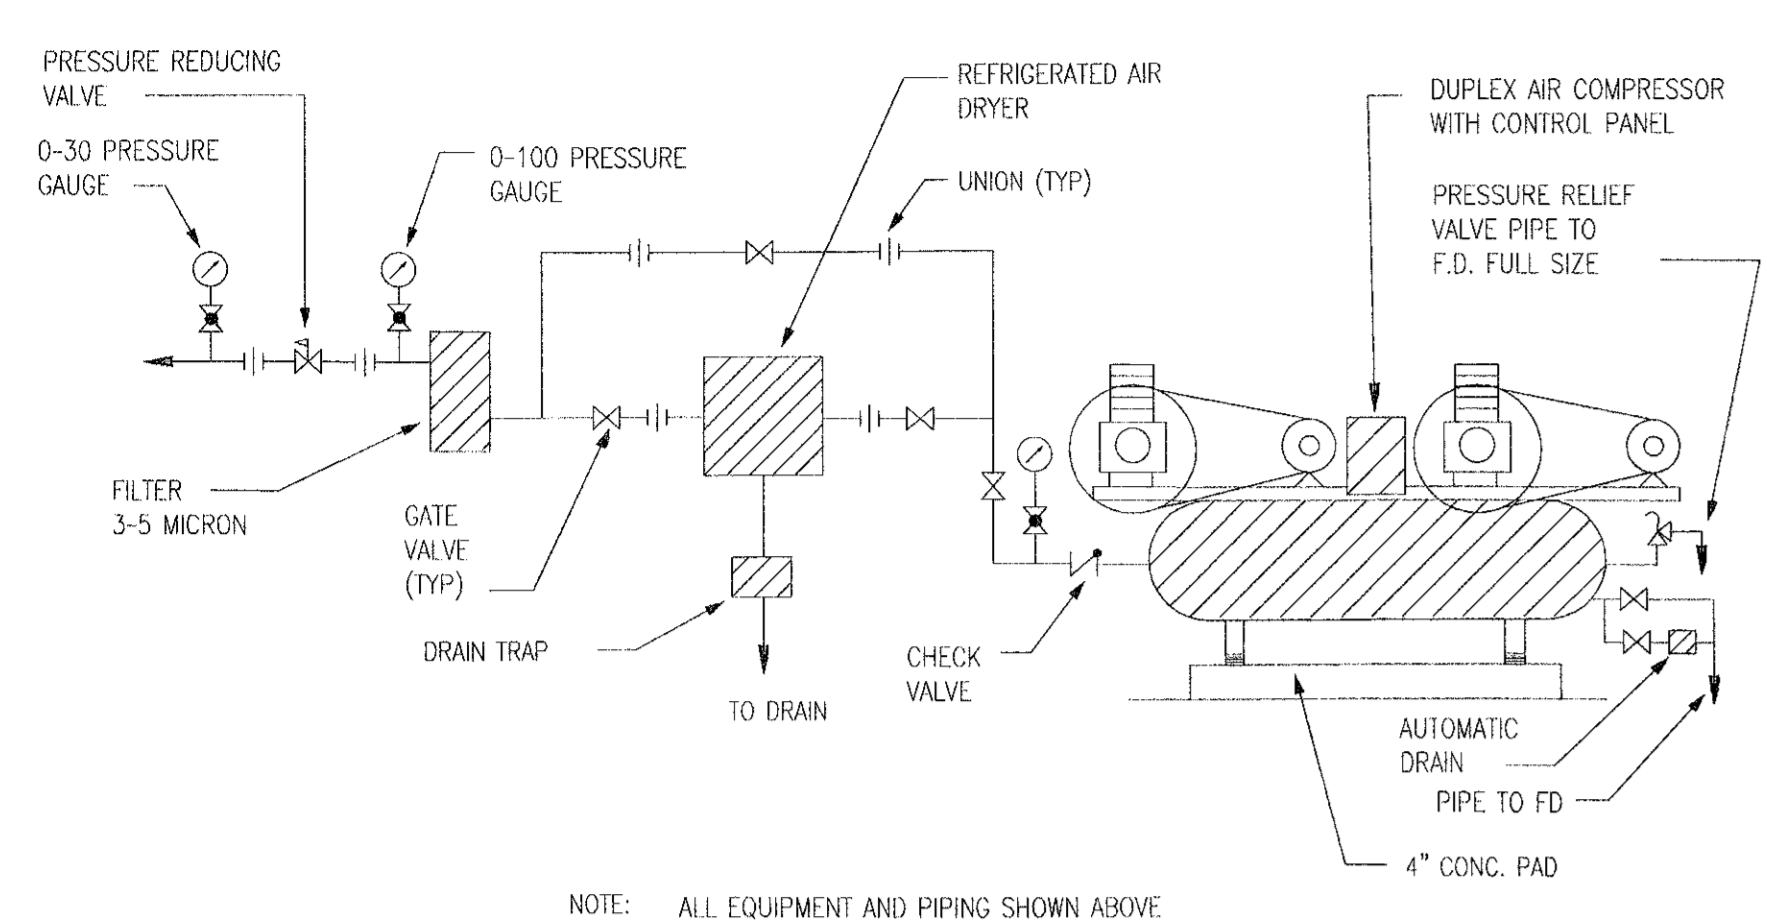


04 CONTROL AIR COMPRESSOR PIPING DETAIL  
 1/8" = 1'-0"


NOTE: ALL EQUIPMENT AND PIPING SHOWN ABOVE IS FURNISHED & INSTALLED BY CONTROL CONTRACTOR. SEE SPEC. (SECTION 15910)

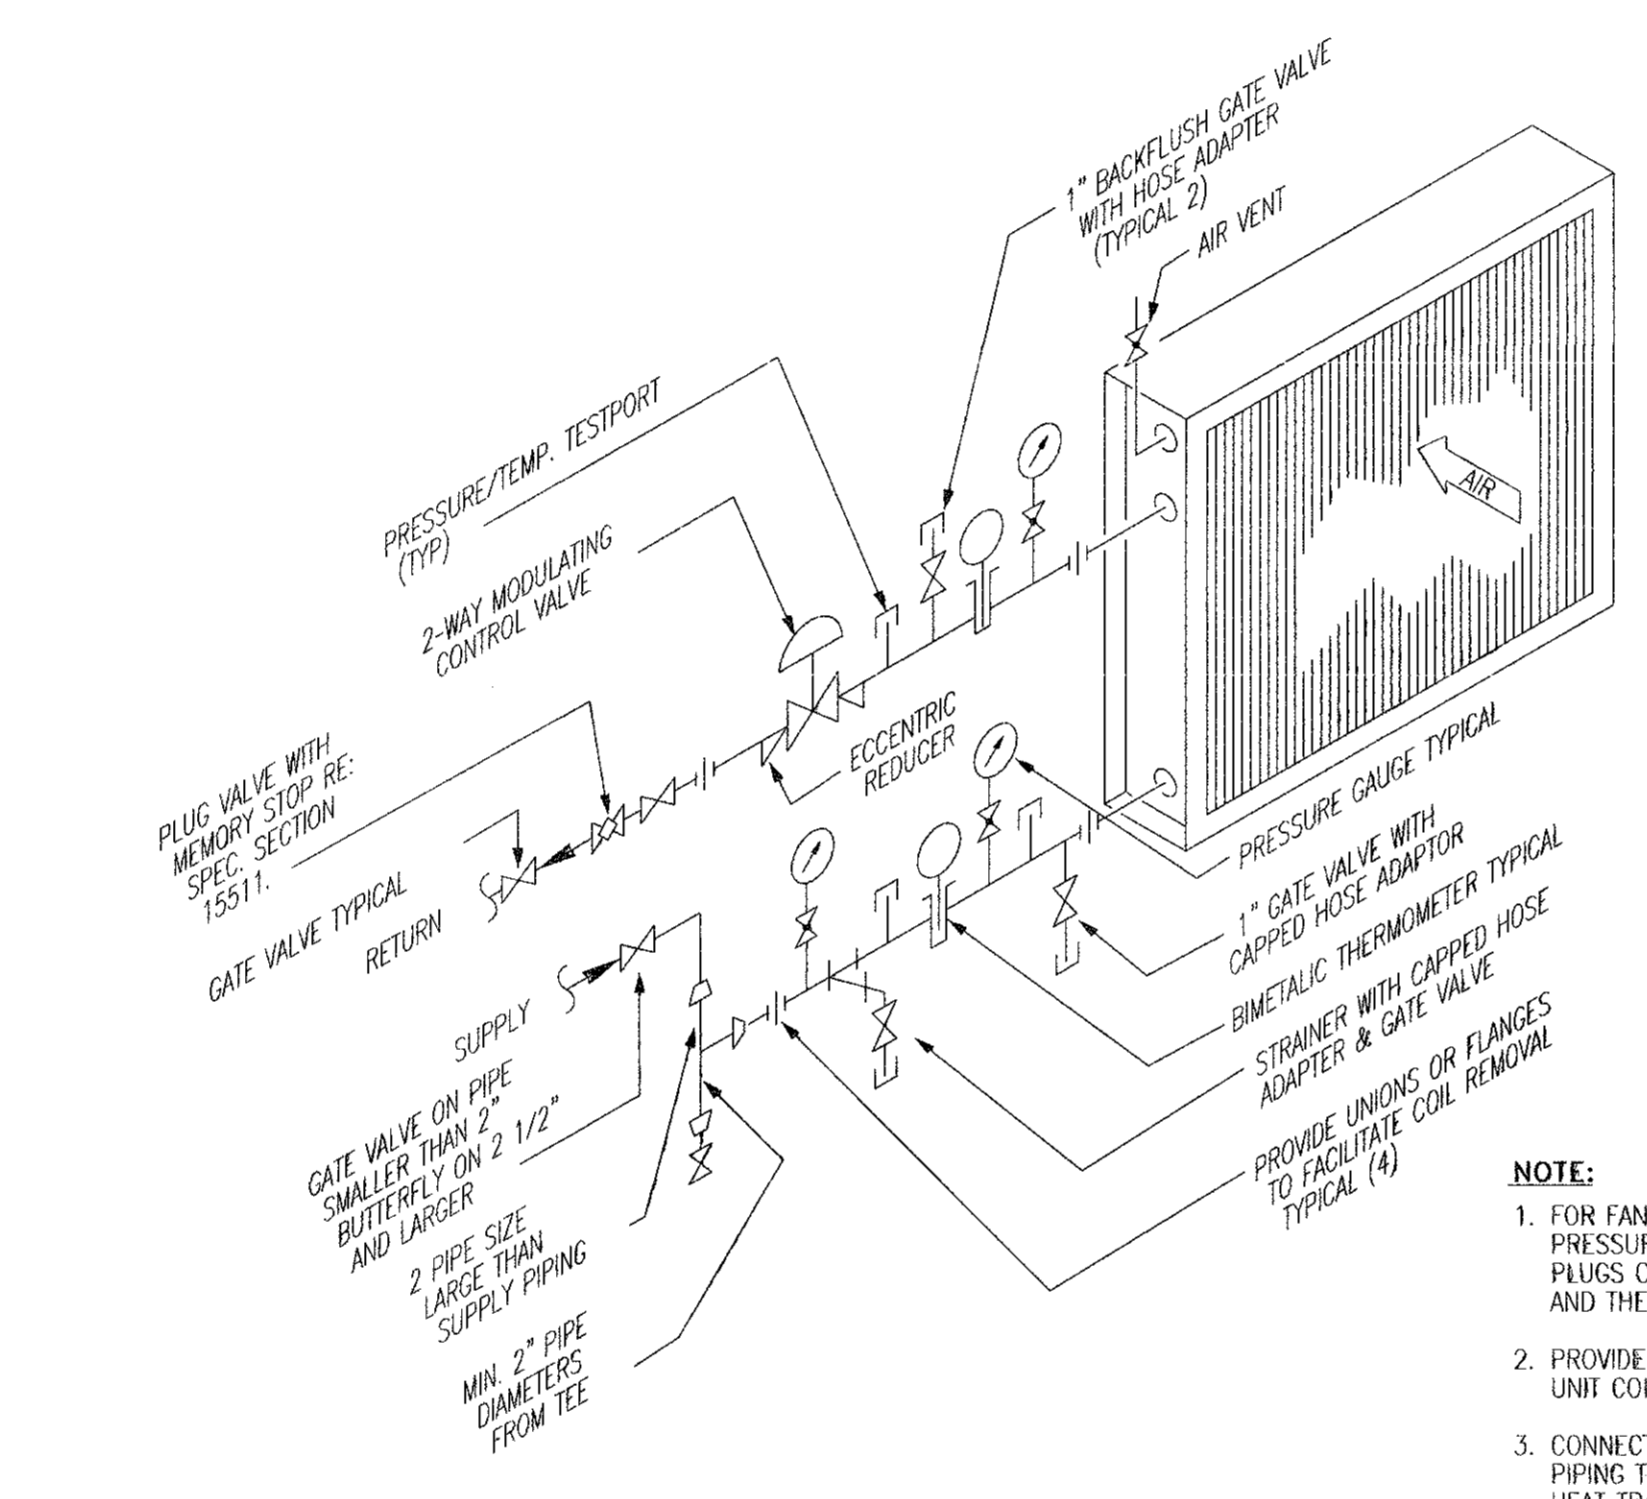


06 HOT WATER COIL CONNECTION WITH 2-WAY CONTROL VALVE  
 1/8" = 1'-0"

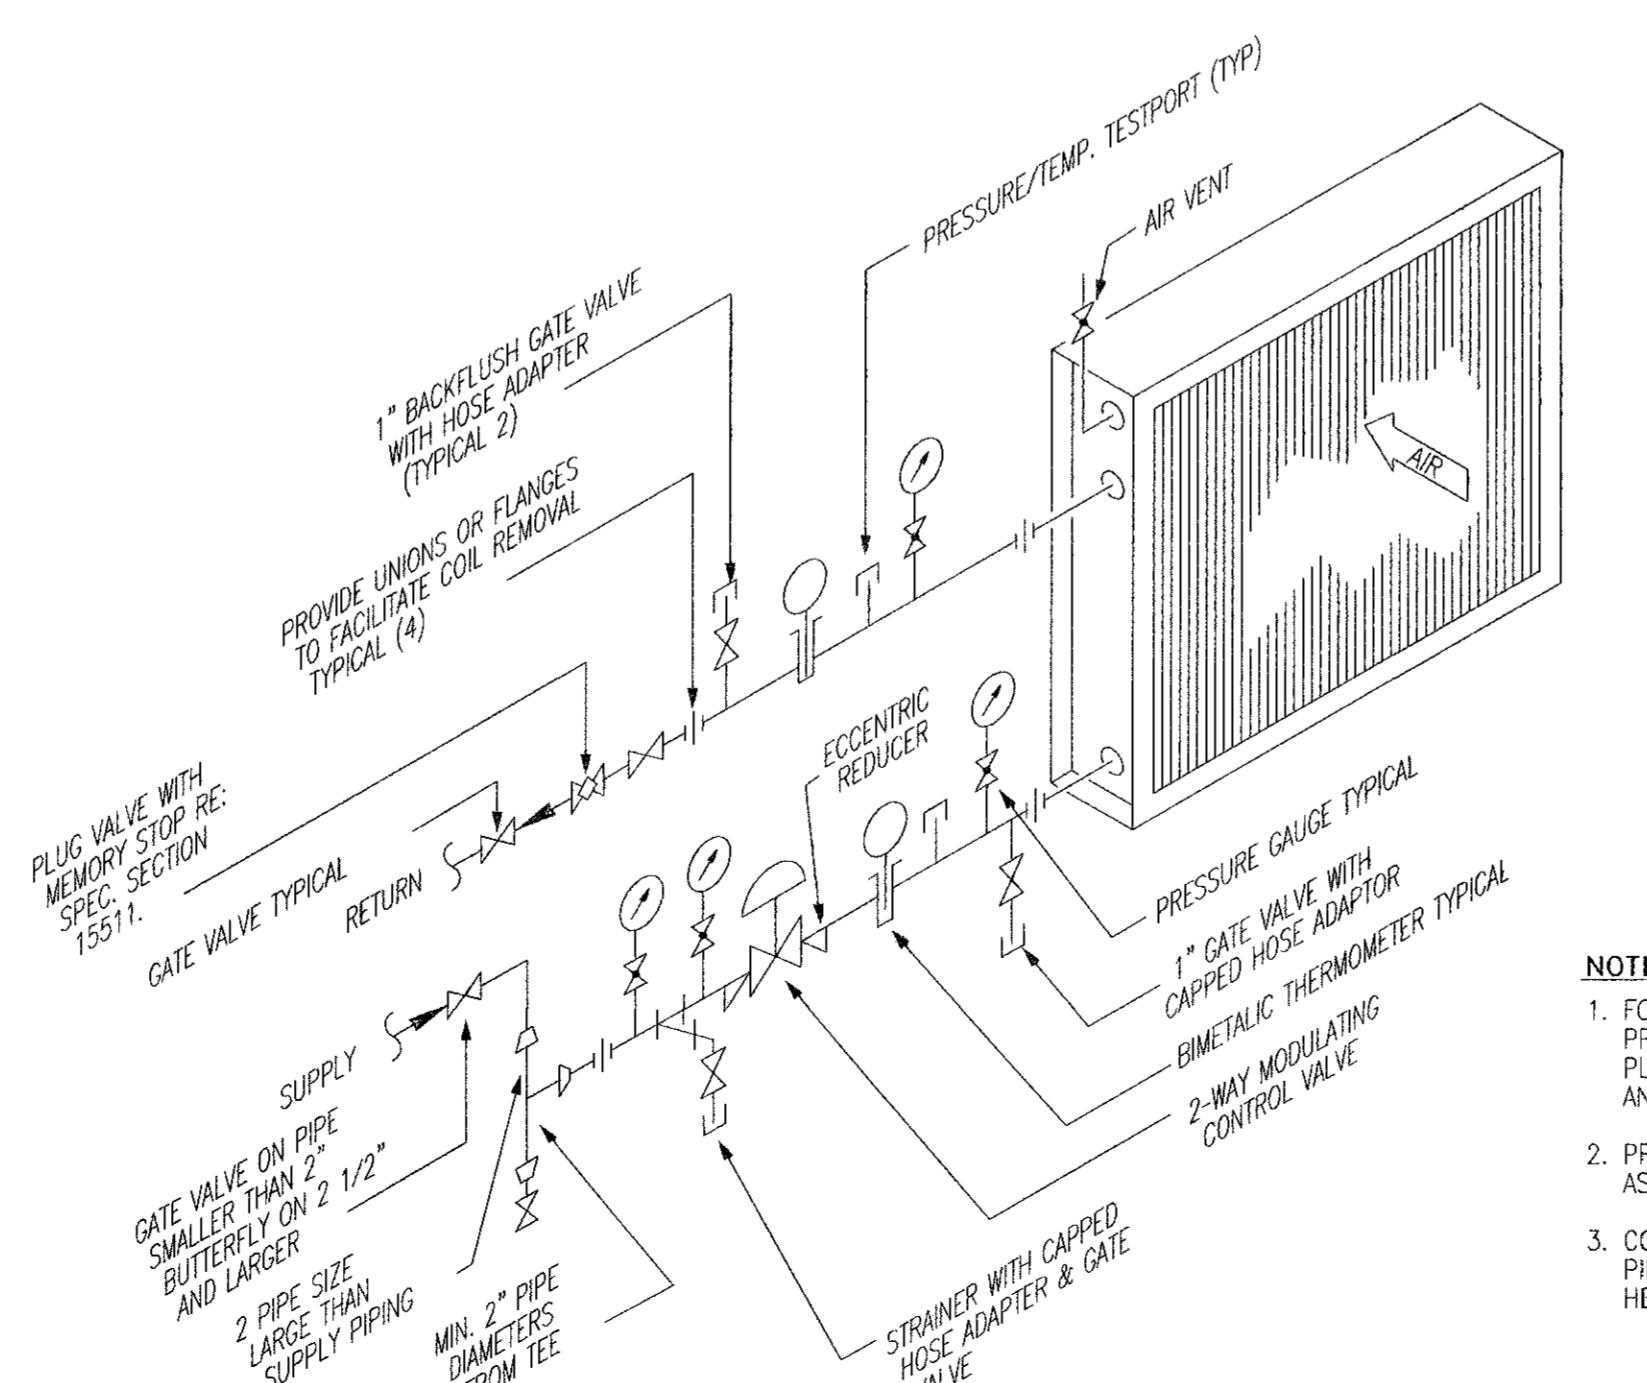

09 CHILLED WATER COIL CONNECTION WITH 2-WAY CONTROL VALVE  
 1/8" = 1'-0"

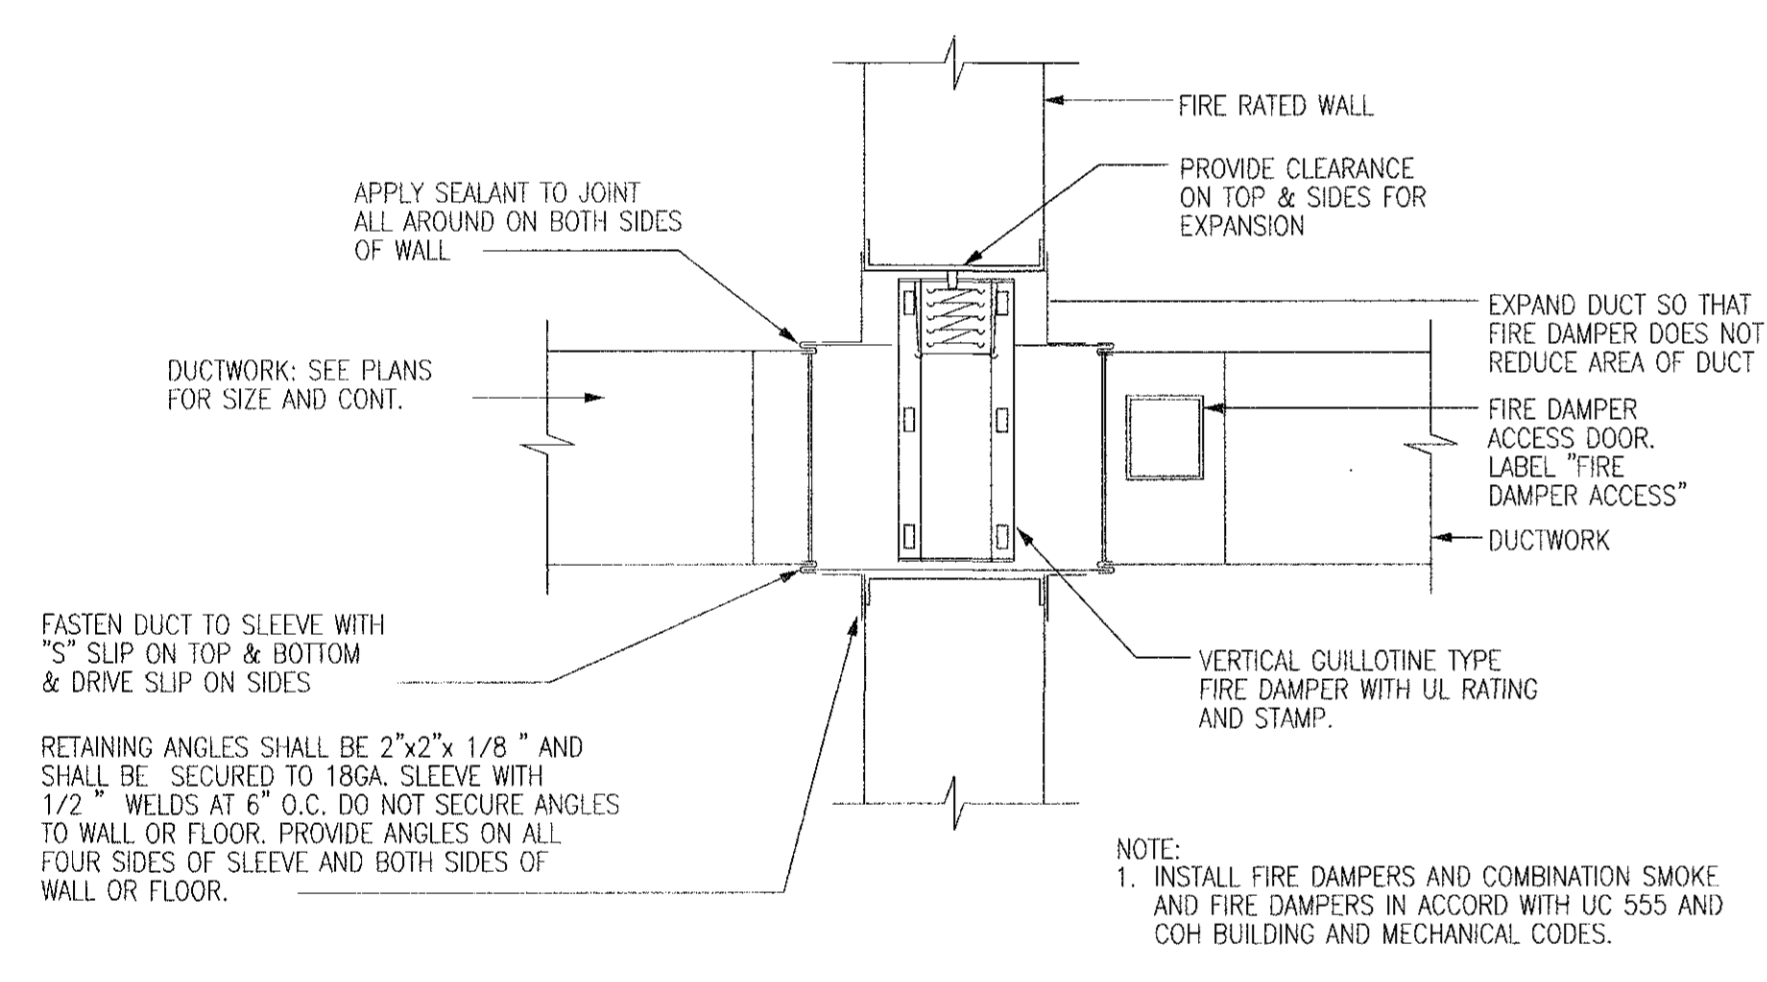


07 DUCT PENETRATION THRU FIRE RATED WALL DETAIL  
 1/8" = 1'-0"

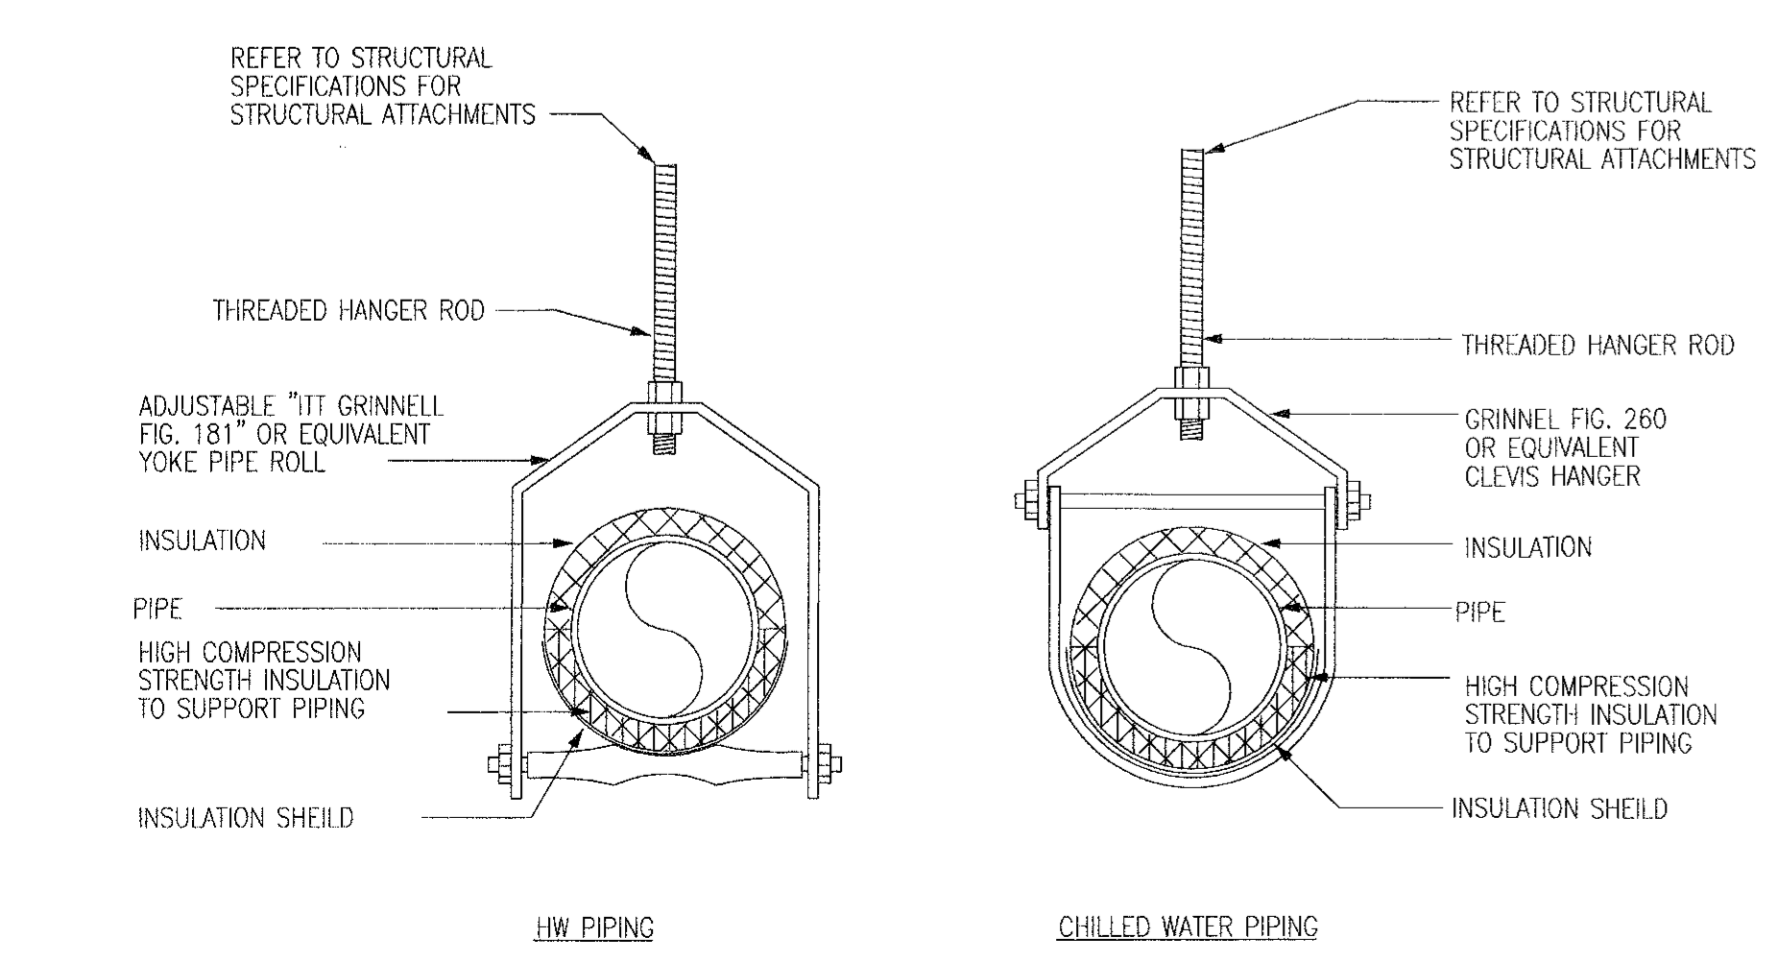


10 PIPE SUPPORT DETAIL  
 1/8" = 1'-0"




REVISIONS			
NO.	DESCRIPTION	DATE	BY
1	ISSUED FOR BID	10/19/01	
2	RECORD DRAWING	05/06/05	

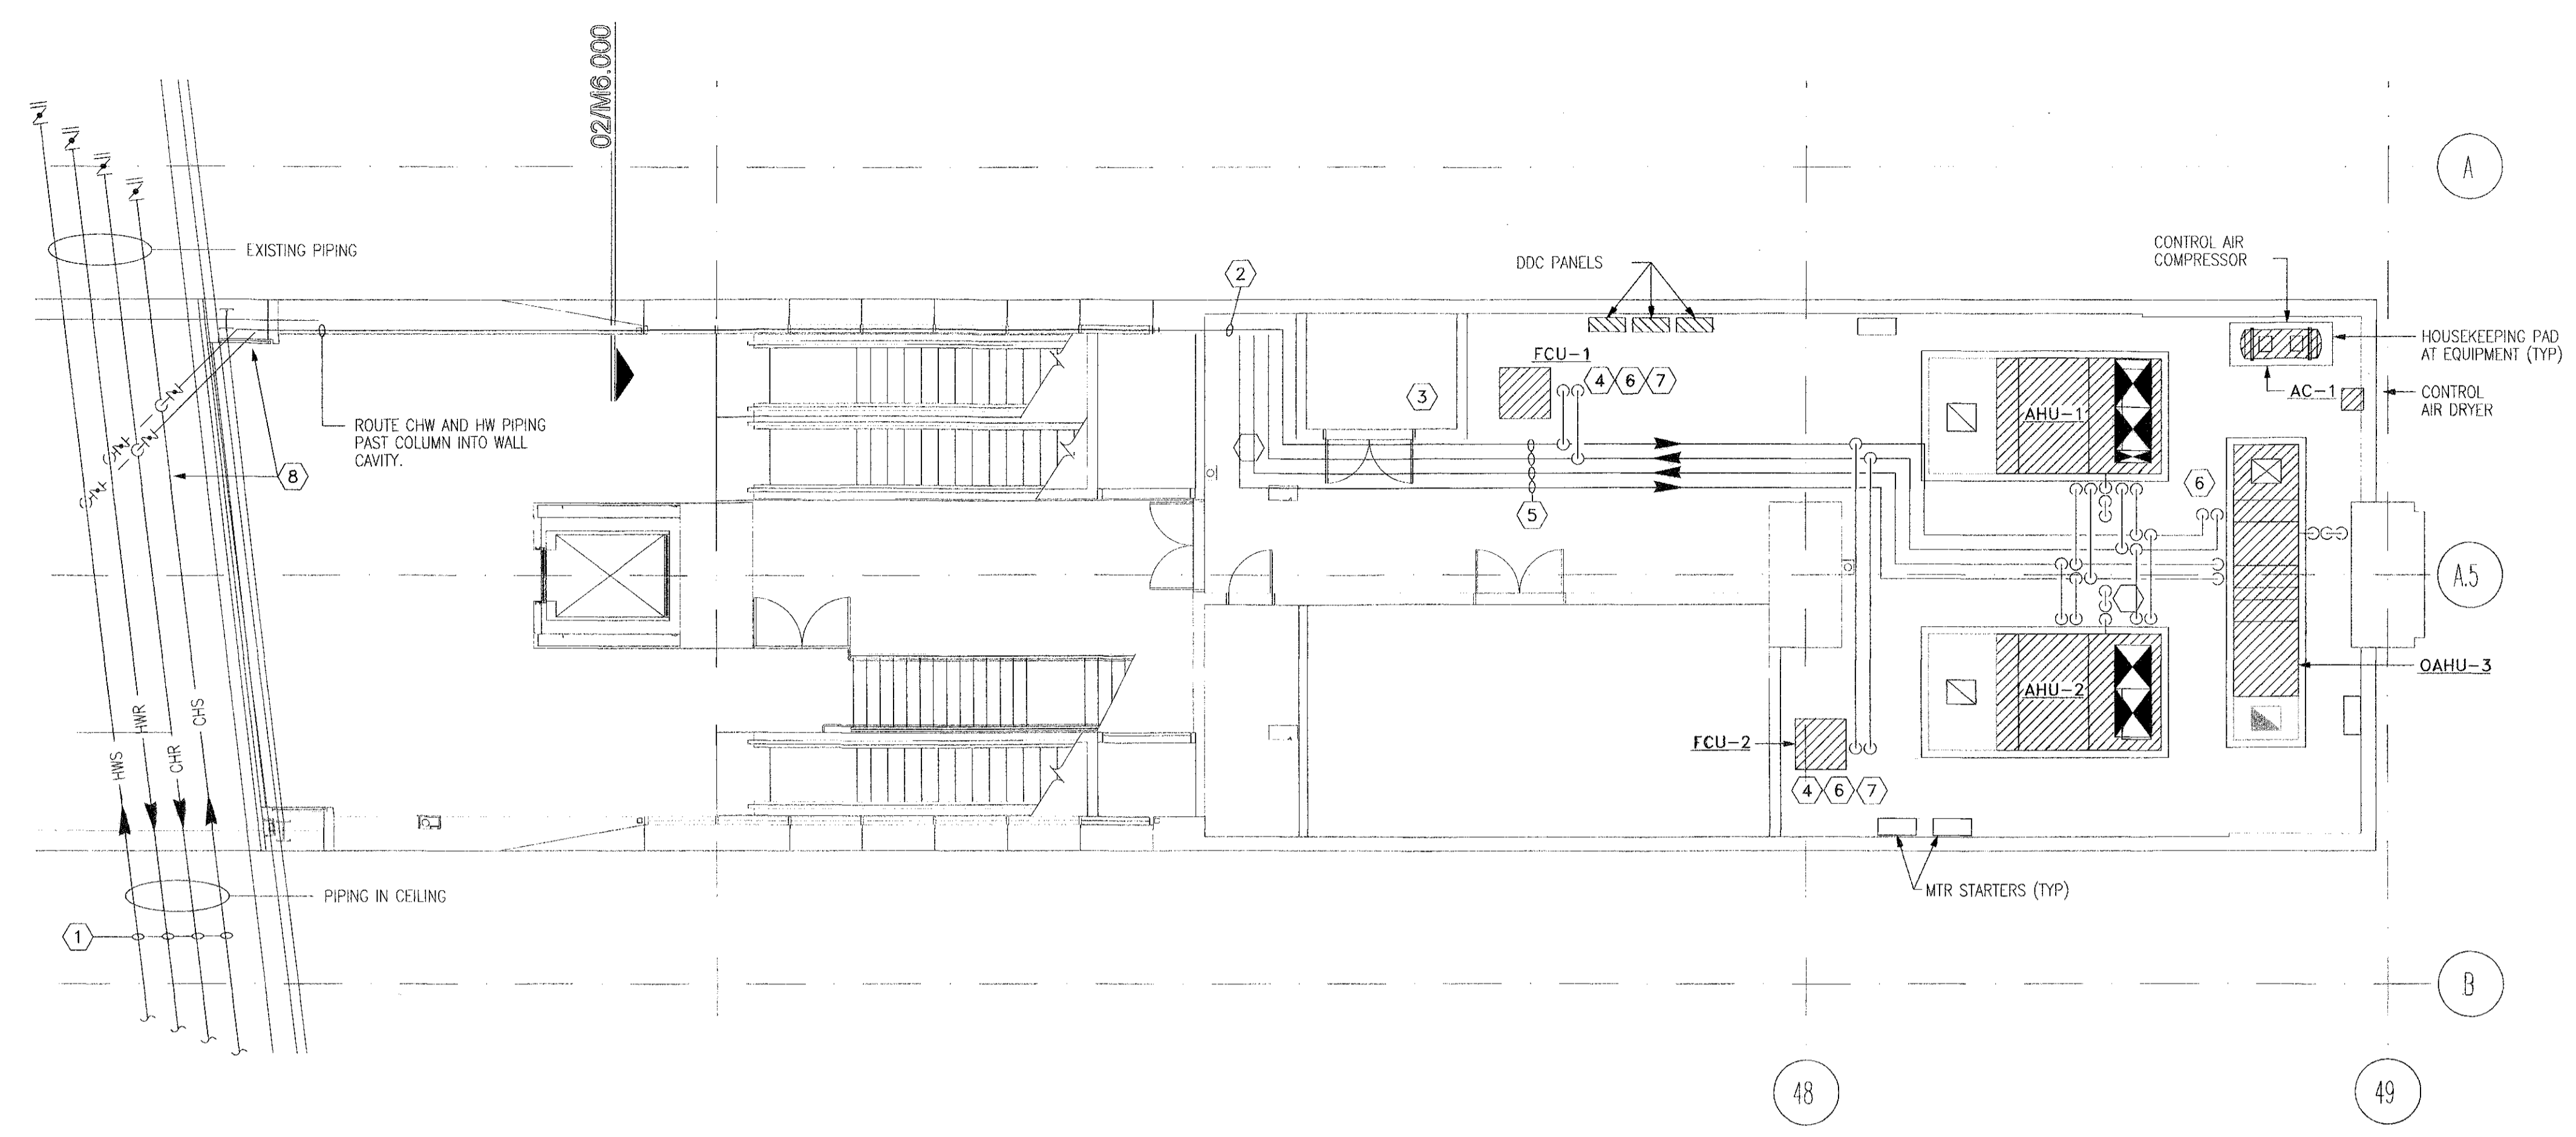


**01 APM STATION LOBBY LEVEL PIPING PLAN**  
 M6.000 1/8"=1'-0"

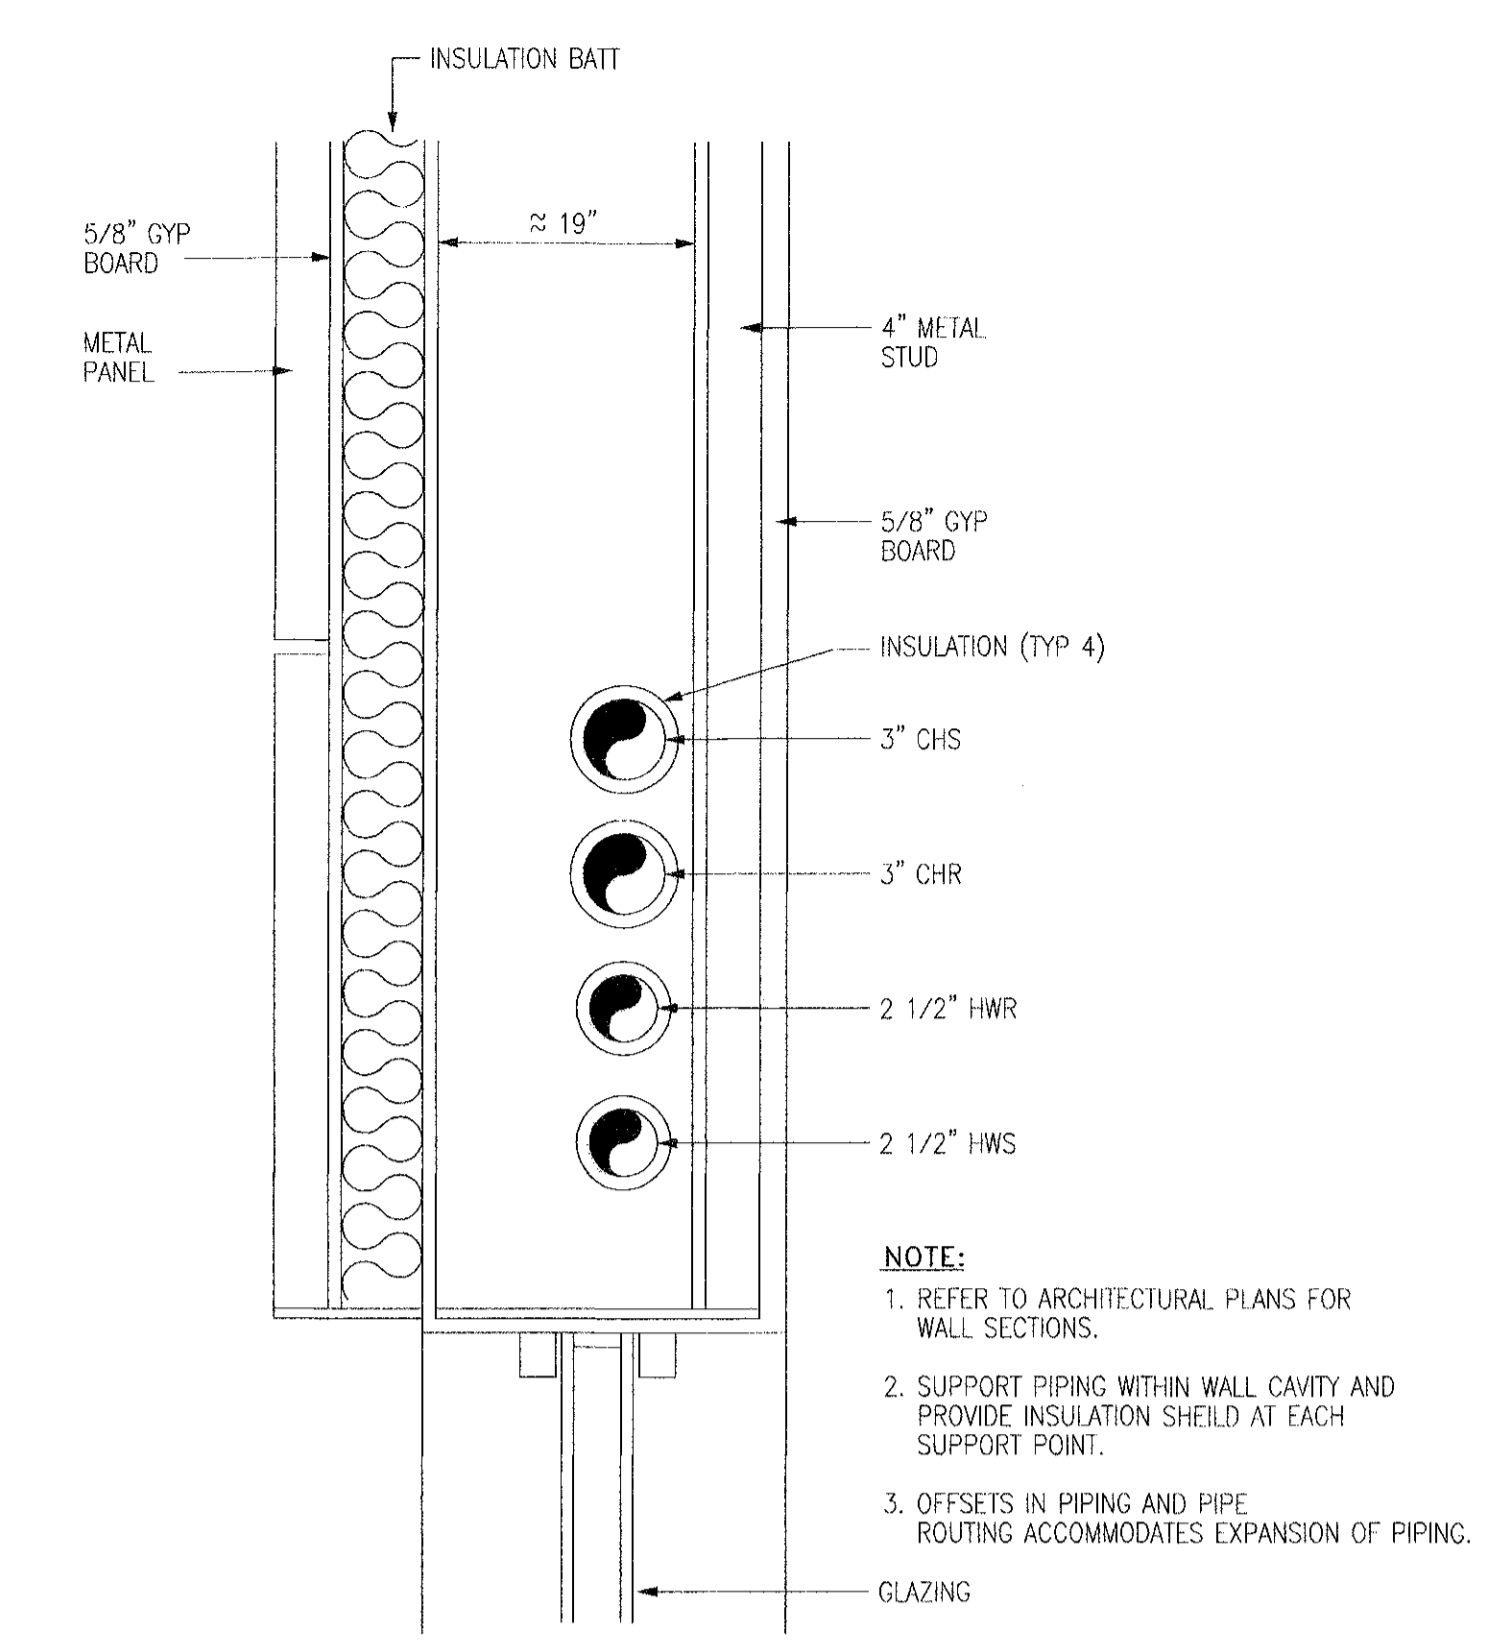


**02 PARTIAL WALL SECTION**  
 M6.000 NOT TO SCALE

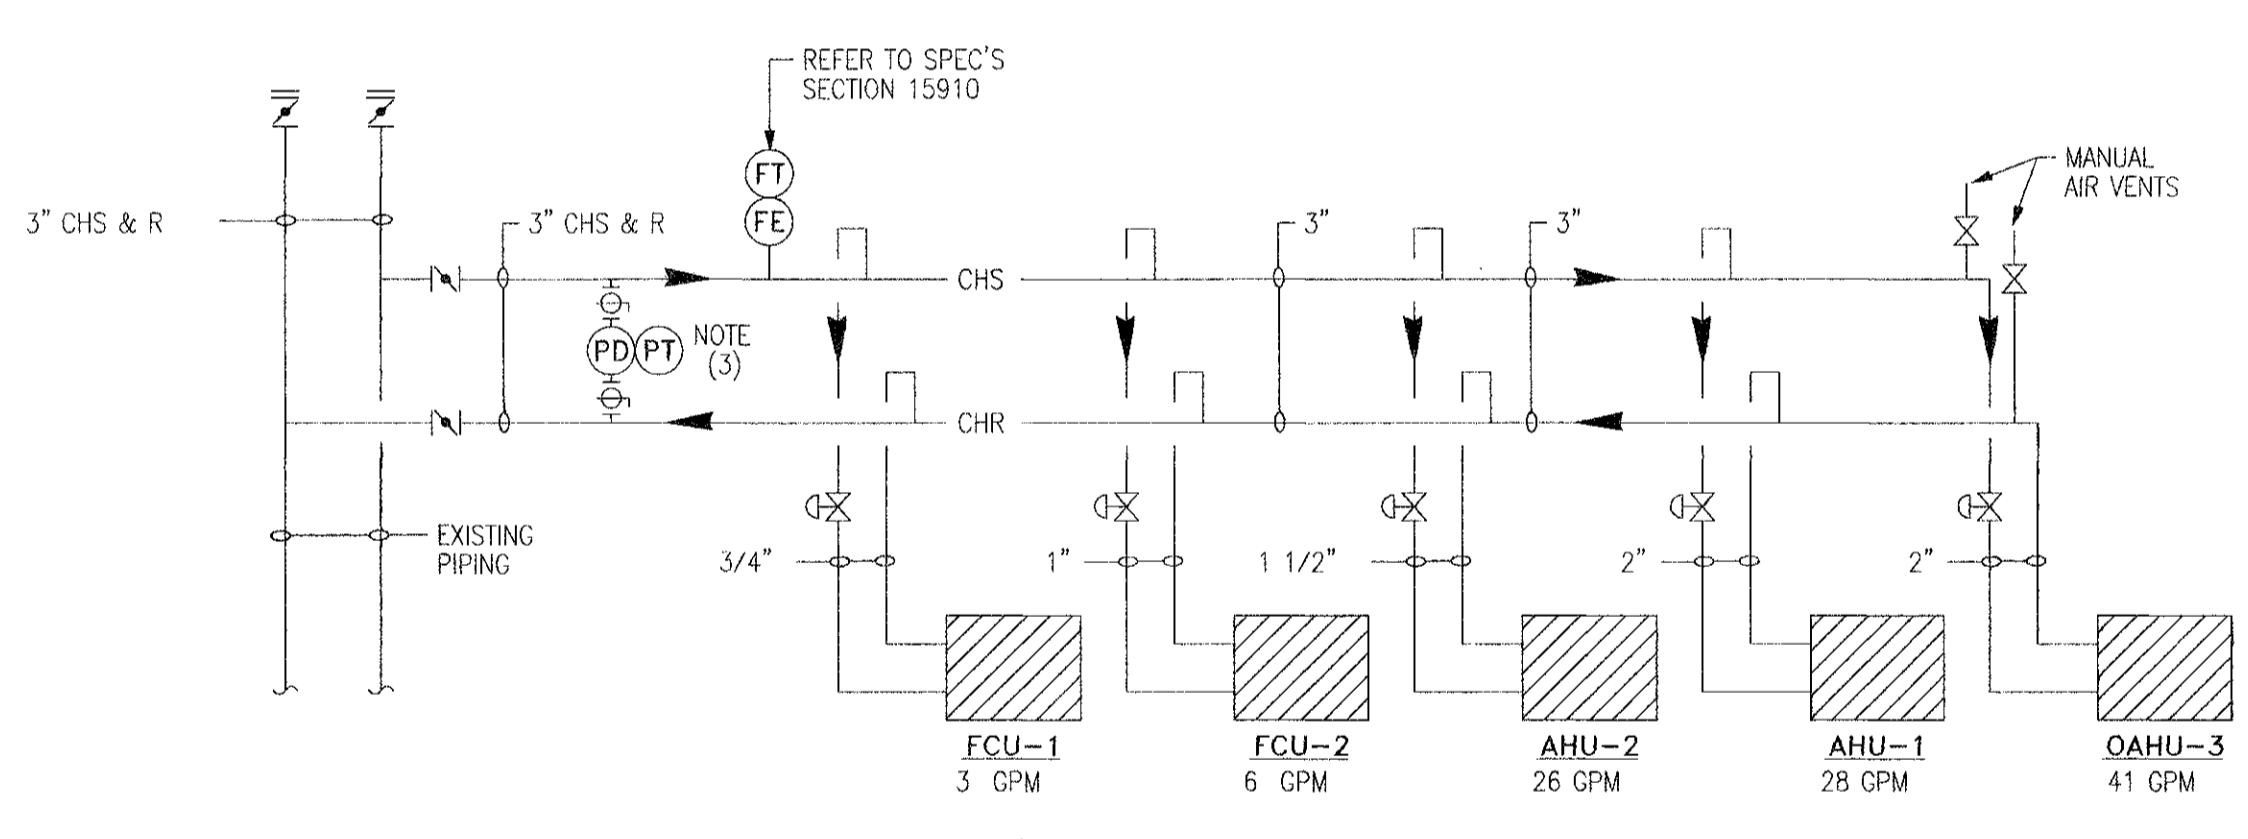

**03 CHILLED WATER FLOW DIAGRAM**  
 M6.000 NOT TO SCALE

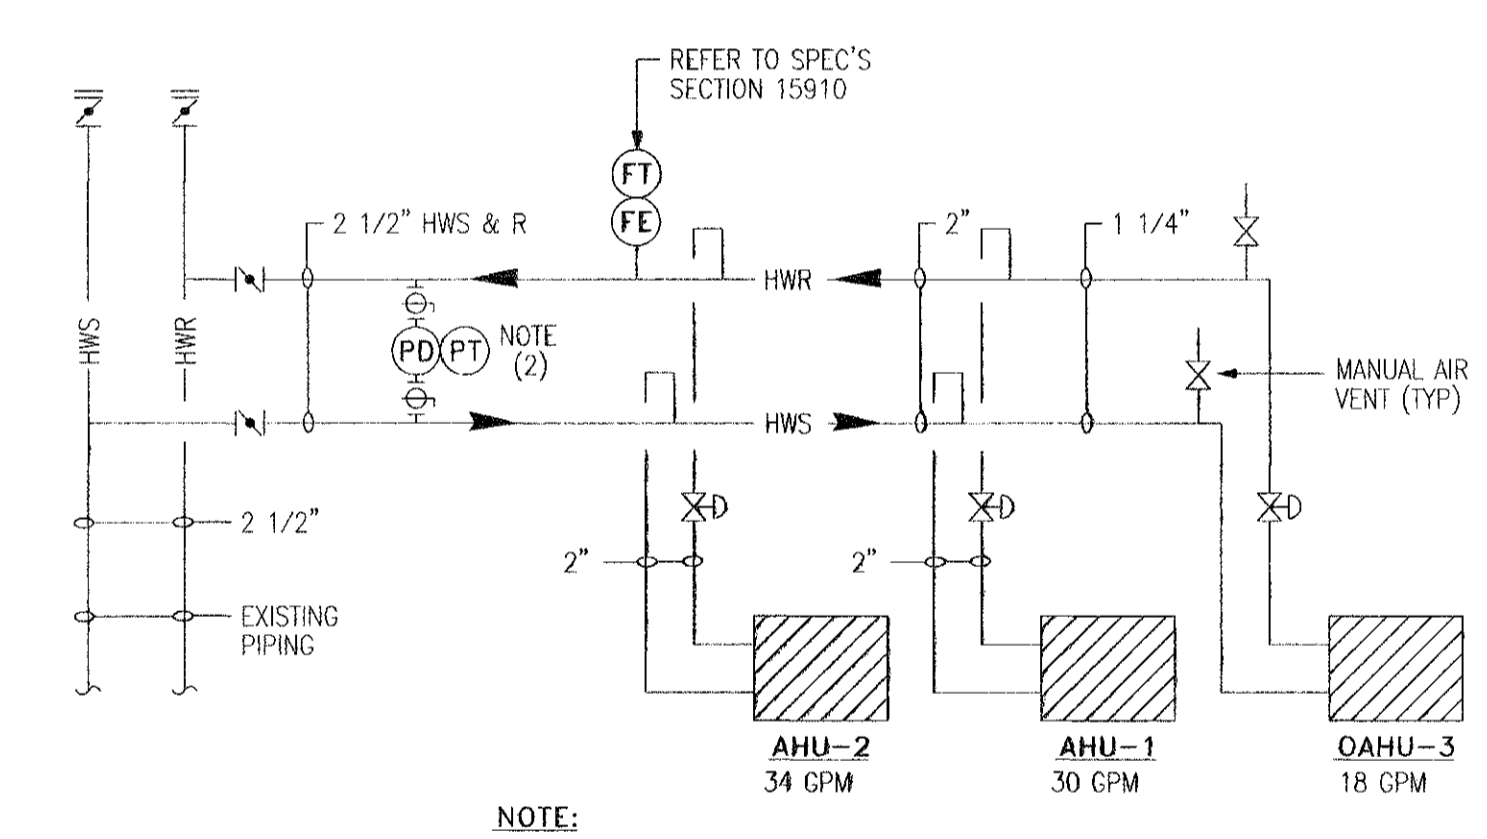

**04 HOT WATER FLOW DIAGRAM**  
 M6.000 NOT TO SCALE


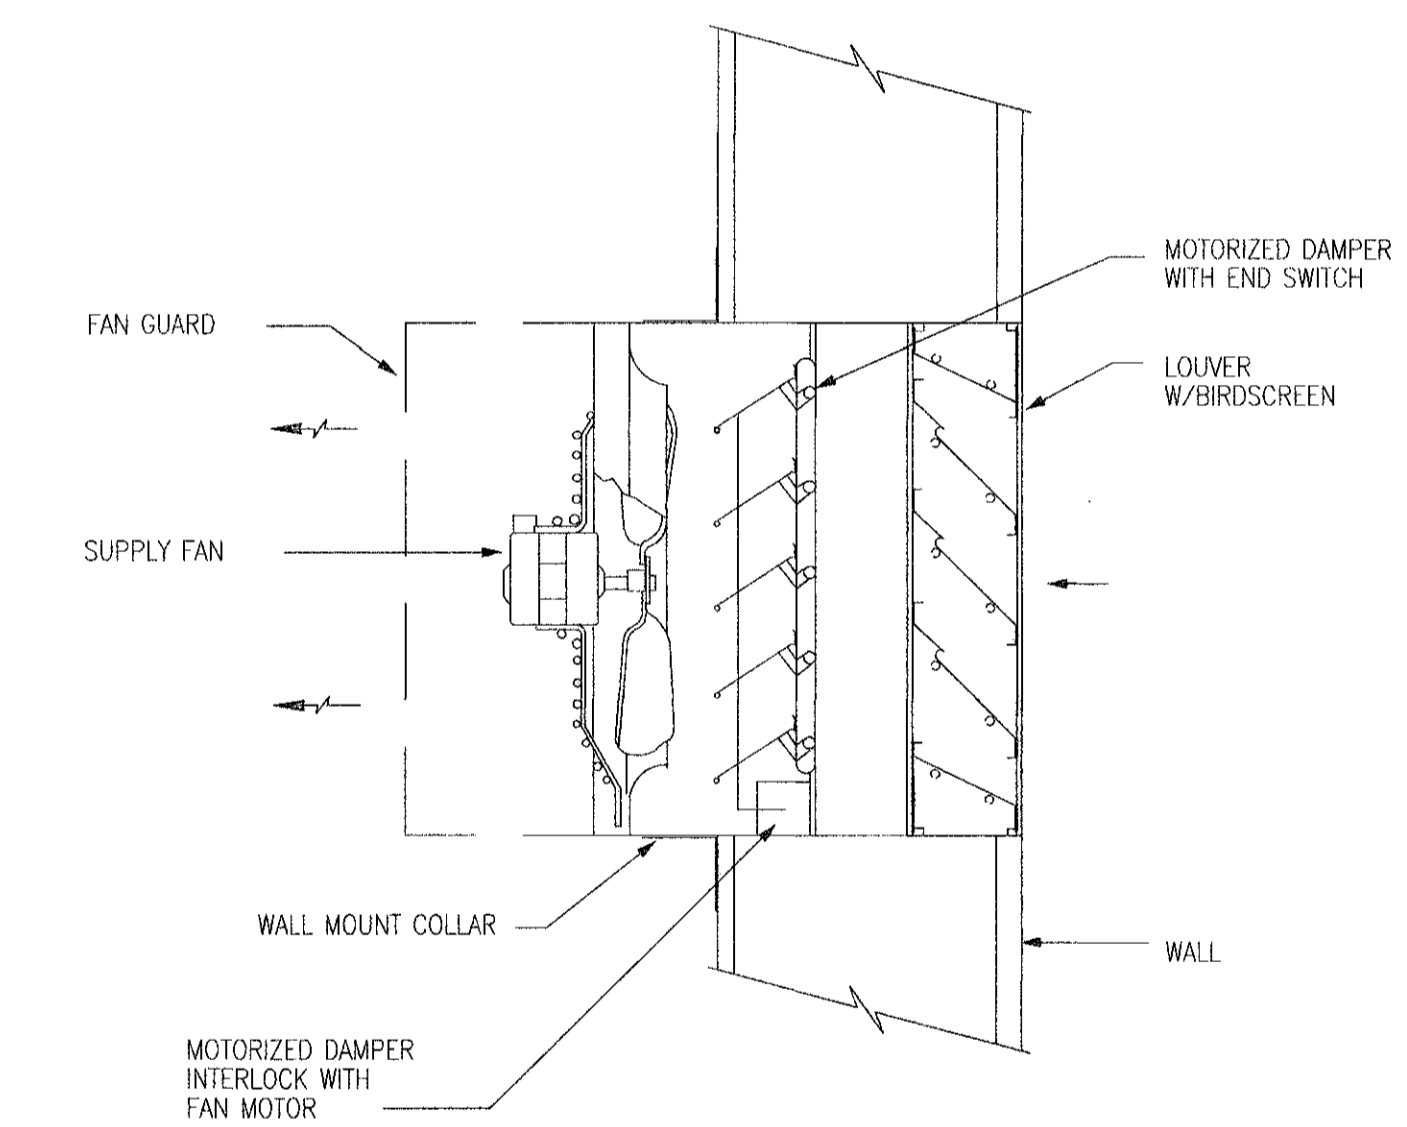


**05 PROPELLER FAN DETAIL**  
 M6.000 NOT TO SCALE

**KEYED NOTES:**

- 1 PROVIDE VALVED CONNECTIONS FOR CHW & HW BRANCHES TO SERVE APM.
- 2 3" CHS & R AND 2 1/2" HWS & R INSULATED PIPING STACKED IN WALL CAVITY. REFER TO 02/M6.000
- 3 REFER TO PIPING SCHEMATIC, 06/M5.000, FOR ADDITIONAL INSTRUMENTATION REQUIREMENTS.
- 4 CHS & R PIPING IN COUNTERFLOW CONFIGURATION SERVES FCU-1 & FCU-2.
- 5 INSULATED CHW & HW PIPING SUPPORTED HIGH AS POSSIBLE ABOVE FLOOR ON TRAPEZOID HANGERS.
- 6 REFER TO CHW & HW COIL PIPING CONNECTION DETAILS, 06 AND 09/M5.000.
- 7 REFER TO DETAIL 03/M5.000 FOR FAN COIL UNIT INSTALLATION DETAIL.
- 8 OFFSET SET PIPING AS REQUIRED FROM CEILING SOFFIT TO AVOID STRUCTURE.

**GENERAL NOTES:**

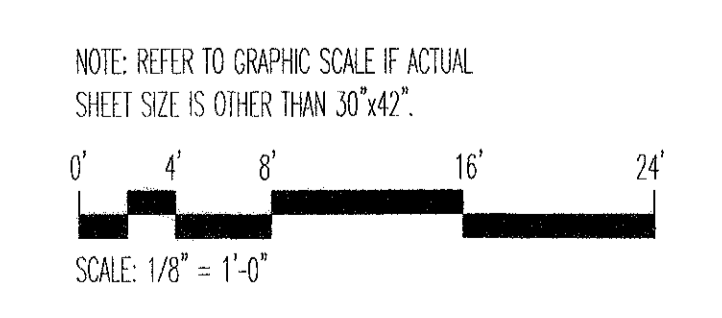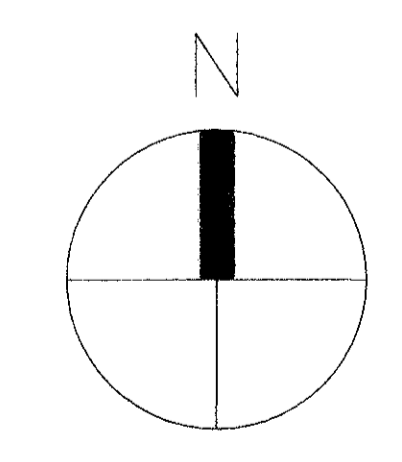

INTERNATIONAL SERVICES EXPANSION PROGRAM  
**APM STATION + PLATFORM**  
 FLOW DIAGRAMS AND DETAILS

PROJECT MGR:	A.E. ALTRIN
DESIGNER:	C. COBB
DRAWN BY:	E. STRUBING
CHECKED BY:	C. COBB
DRAWING STANDARD:	ISP 07.20.2000
SCALE:	AS NOTED
DATE:	09/14/01

**RECORD DRAWING**  
 THIS DRAWING HAS BEEN REVISED TO SHOW SIGNIFICANT CHANGES IN THE WORK MADE DURING CONSTRUCTION BASED ON MARKED-UP PRINTS, DRAWINGS AND OTHER DATA.

APPROVED BY:	DATE:
DIRECTOR	HOUSTON AIRPORT SYSTEM
PROJECT NO.	1061-001
C.I.P. NO.	A-0354
H.A.S. NO.	5382
SHEET NO.	

M6.000



**PLUMBING PIPE MATERIALS SPECIFICATION**

SERVICE	PIPE	FITTING
EQUIPMENT DRAINS AND OVERFLOWS	TYPE "L" HARD DRAWN COPPER (ASTM B88)	SOLDERED (95-5) WROUGHT COPPER, ANSI B16.22
SANITARY DRAINAGE AND VENT ABOVE GRADE	SERVICE WEIGHT CAST IRON, CIPSI 301	SERVICE WEIGHT NO-HUB FITTINGS WITH HEAVY WEIGHT NO-HUB COUPLINGS CIPSI 310, SIMILAR TO AMACO "HUSKEY" CLAMP-ALL, MISSION "HW" OR TYLER WIDE BODY
SANITARY DRAINAGE AND VENT BELOW GRADE	HOT-DIP COATED SERVICE WEIGHT CAST IRON BELL & SPIGOT, ASTM A74.	SERVICE WEIGHT CAST IRON BELL & SPIGOT FITTINGS WITH NEOPRENE GASKETS, ASTM C564
STORM AND OVERFLOW DRAINAGE ABOVE GRADE	SERVICE WEIGHT CAST IRON, CIPSI 301	FOR SIZES UP TO 8", SERVICE WEIGHT NO-HUB FITTINGS WITH HEAVY WEIGHT NO-HUB COUPLINGS CIPSI 310, SIMILAR TO AMACO "HUSKEY" CLAMP-ALL OR MISSION "HW" FOR SIZES OVER 8". SERVICE WEIGHT BELL & SPIGOT FITTINGS WITH ELASTOMER GASKETS, ASTM C564
SANITARY SEWER, STORM AND OVERFLOW DRAINAGE WHERE CAST IN BENTS, BEAMS AND COLUMNS	SCHEDULE 40 TYPE 1 PVC	DWV PATTERN PVC FITTINGS WITH SOLVENT CEMENT JOINTS
STORM AND OVERFLOW DRAINAGE BELOW GRADE	HOT-DIP COATED SERVICE WEIGHT CAST IRON BELL & SPIGOT, ASTM A74.	SERVICE WEIGHT CAST IRON HUBBED FITTINGS WITH NEOPRENE GASKETS, ASTM C564.
DOMESTIC WATER ABOVE GRADE	TYPE "L" HARD DRAWN COPPER (ASTM B88)	ANSI B16.22 WROUGHT COPPER WITH 95-5 SOLDER LEAD-FREE JOINTS, ASTM B32

UNIONS: CLASS 150, 300 POUND WATER-OIL-GAS SERVICE BRONZE. UNION WITH GROUND JOINT AND BRASS SEAT, ANSI B16.39.

**GENERAL NOTES**

- PRIOR TO WORK CONTRACTOR SHALL TIGHTLY COORDINATE PLUMBING WORK WITH OTHER TRADES.
- PROVIDE A UNION DOWNSTREAM FROM EACH BALL VALVE.
- DRAWINGS ARE DIAGRAMATIC IN NATURE. NOT ALL REQUIRED PIPE ELBOWS, TEES, AND ASSOCIATED FITTINGS ARE SHOWN. PROVIDE A COMPLETE WORKING PLUMBING SYSTEM PER THE SPECIFICATIONS AND CITY OF HOUSTON PLUMBING CODE.
- PROVIDE A WET AUTOMATIC SPRINKLER SYSTEM THROUGHOUT, EXCEPT WHERE A DRY PIPE SPRINKLER SYSTEM IS INDICATED ON DRAWINGS. COMPLY WITH NFPA 13 AND SPECIFICATIONS SECTION 15330.
- FIRE PROTECTION PIPING SHALL BE COORDINATED AROUND OTHER TRADES, SUCH AS PLUMBING, HVAC AND ELECTRICAL.
- PROVIDE AN IN-LINE Y-STRAINER UPSTREAM OF ALL TRAP PRIMERS.
- INSULATE AND HEAT TRACE TRAP PRIMER PIPING WHERE EXPOSED TO FREEZING TEMPERATURES.
- INSULATE WASTE, VENT AND STORM PIPING WHERE EXPOSED TO FREEZING TEMPERATURES.
- PROVIDE A WATER CURTAIN TYPE SPRINKLER SYSTEM WHERE INDICATED ON DRAWINGS, AND CONFORMING TO GUIDELINES SET FORTH IN NFPA13.
- PROVIDE SHOP DWGS. INDICATING EXACT LOCATION & COORDINATION WITH STRUCTURAL, REBAR WHERE PIPING IS CAST IN CONC. BEAMS, BENTS AND COLUMNS. COORDINATE PLUMBING SHOP DWGS. WHERE PIPING IS CAST IN STRUCT. BEAMS & COLUMNS WITH STRUCTURAL APPROVED SHOP DWGS. COORDINATE INSTALLATION OF PIPING WITH CONSTRUCTION OF STRUCTURAL COMPONENTS.

**PLUMBING ROUGH-IN SCHEDULE**


FITTURE	MINIMUM SIZES (INCHES)				
	SOIL	WASTE	VENT	HOT WATER	COLD WATER
HB-1	-	-	-	-	3/4
FD-1	-	3	2	-	-

**PUMP SCHEDULE**


MARK	SERVICE	TDH (FEET)	FLOW RATE (GPM)	ELECTRICAL DATA				REMARKS	
				HP	RPM	VOLT	PHASE		HERTZ
SP-1	ELEVATOR SUMP	20	10	1/4	1550	120	1	60	HYDROMATIC NO. W25

**PLUMBING LEGEND**


SYMBOL	ABBREV.	DESCRIPTION	SYMBOL	ABBREV.	DESCRIPTION
DS	4"	DOWNSPOUT & SIZE	U		UNION
		DOWNSPOUT NO. & ROOF AREA	BV		BALL VALVE
VTR		VENT THRU ROOF	GV		GATE VALVE
		ABOVE GROUND SANITARY	CV		CHECK VALVE
		UNDERGROUND SANITARY	FCO		FLOOR CLEANOUT
V		VENT	C		CLEANOUT
SD		ABOVE GROUND STORM DRAIN	COG		CLEANOUT AT GRADE
SD		UNDERGROUND STORM DRAIN	AFF		ABOVE FINISHED FLOOR
CW		DOMESTIC COLD WATER	IE		INVERT ELEVATION
TP		TRAP PRIMER			
AS		WET AUTOMATIC SPRINKLERS			
DAS		DRY AUTOMATIC SPRINKLERS			

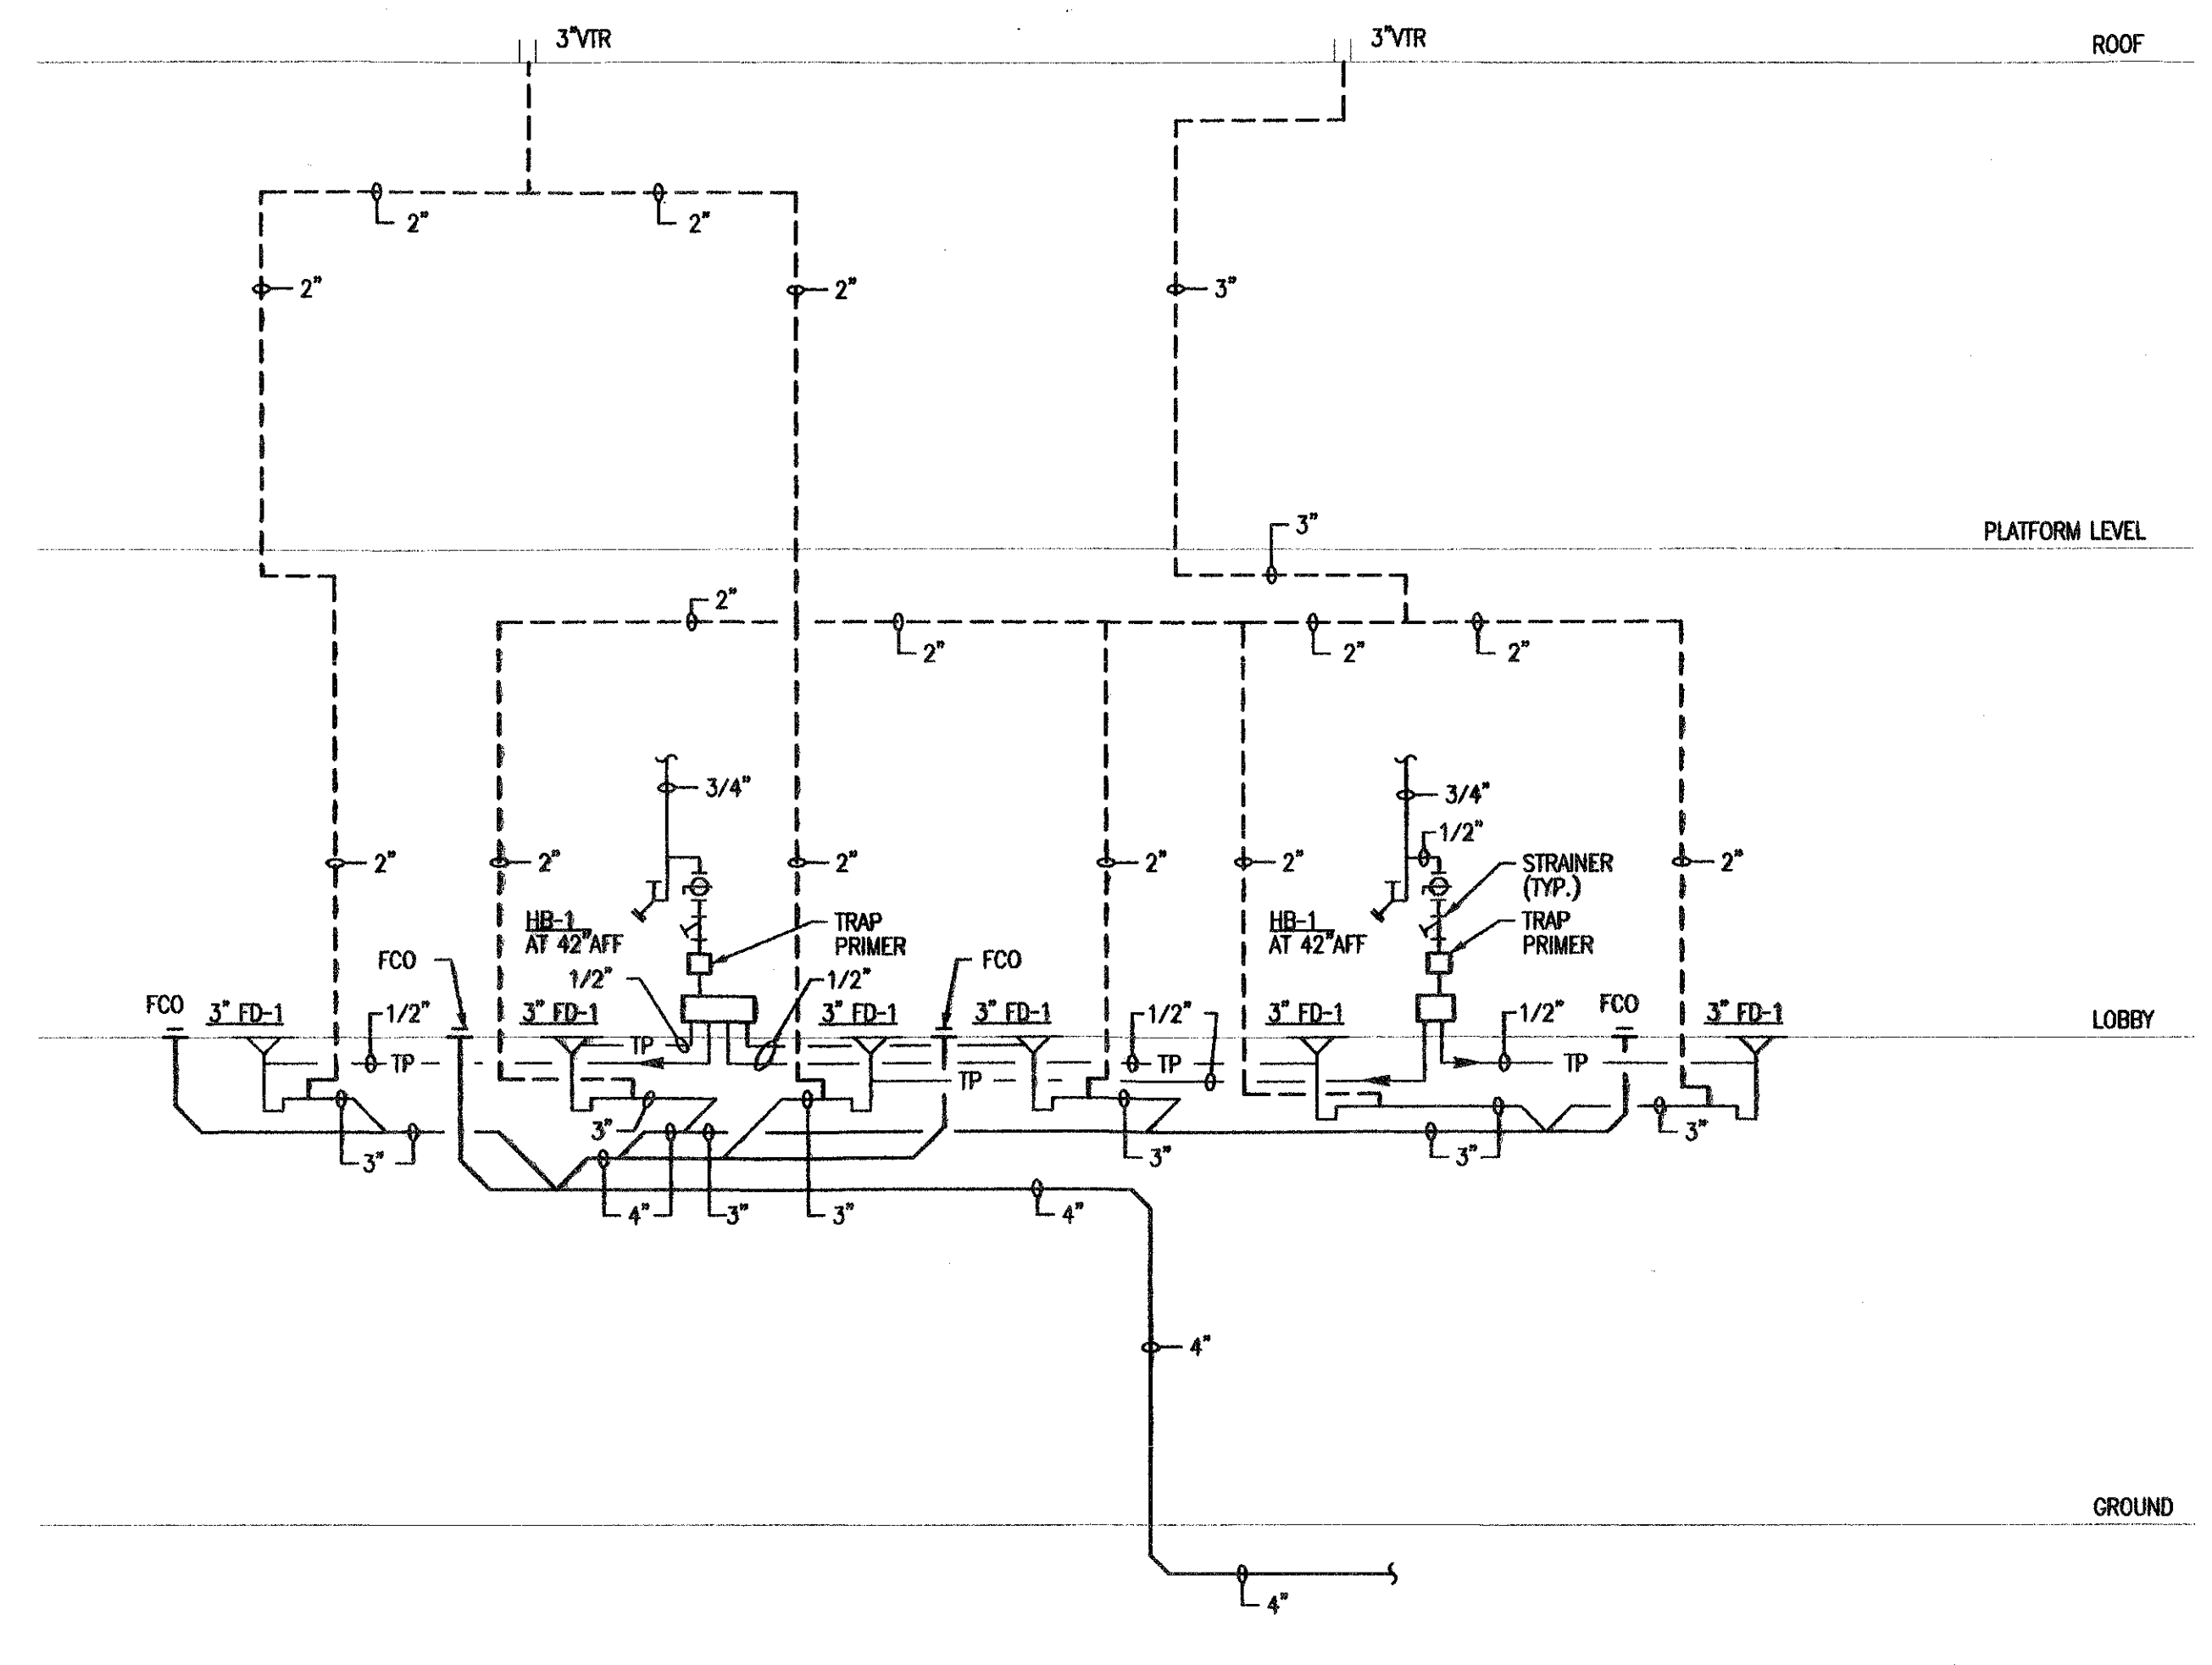


**01 PLUMBING RISER DIAGRAM**  
 P0.001 NO SCALE

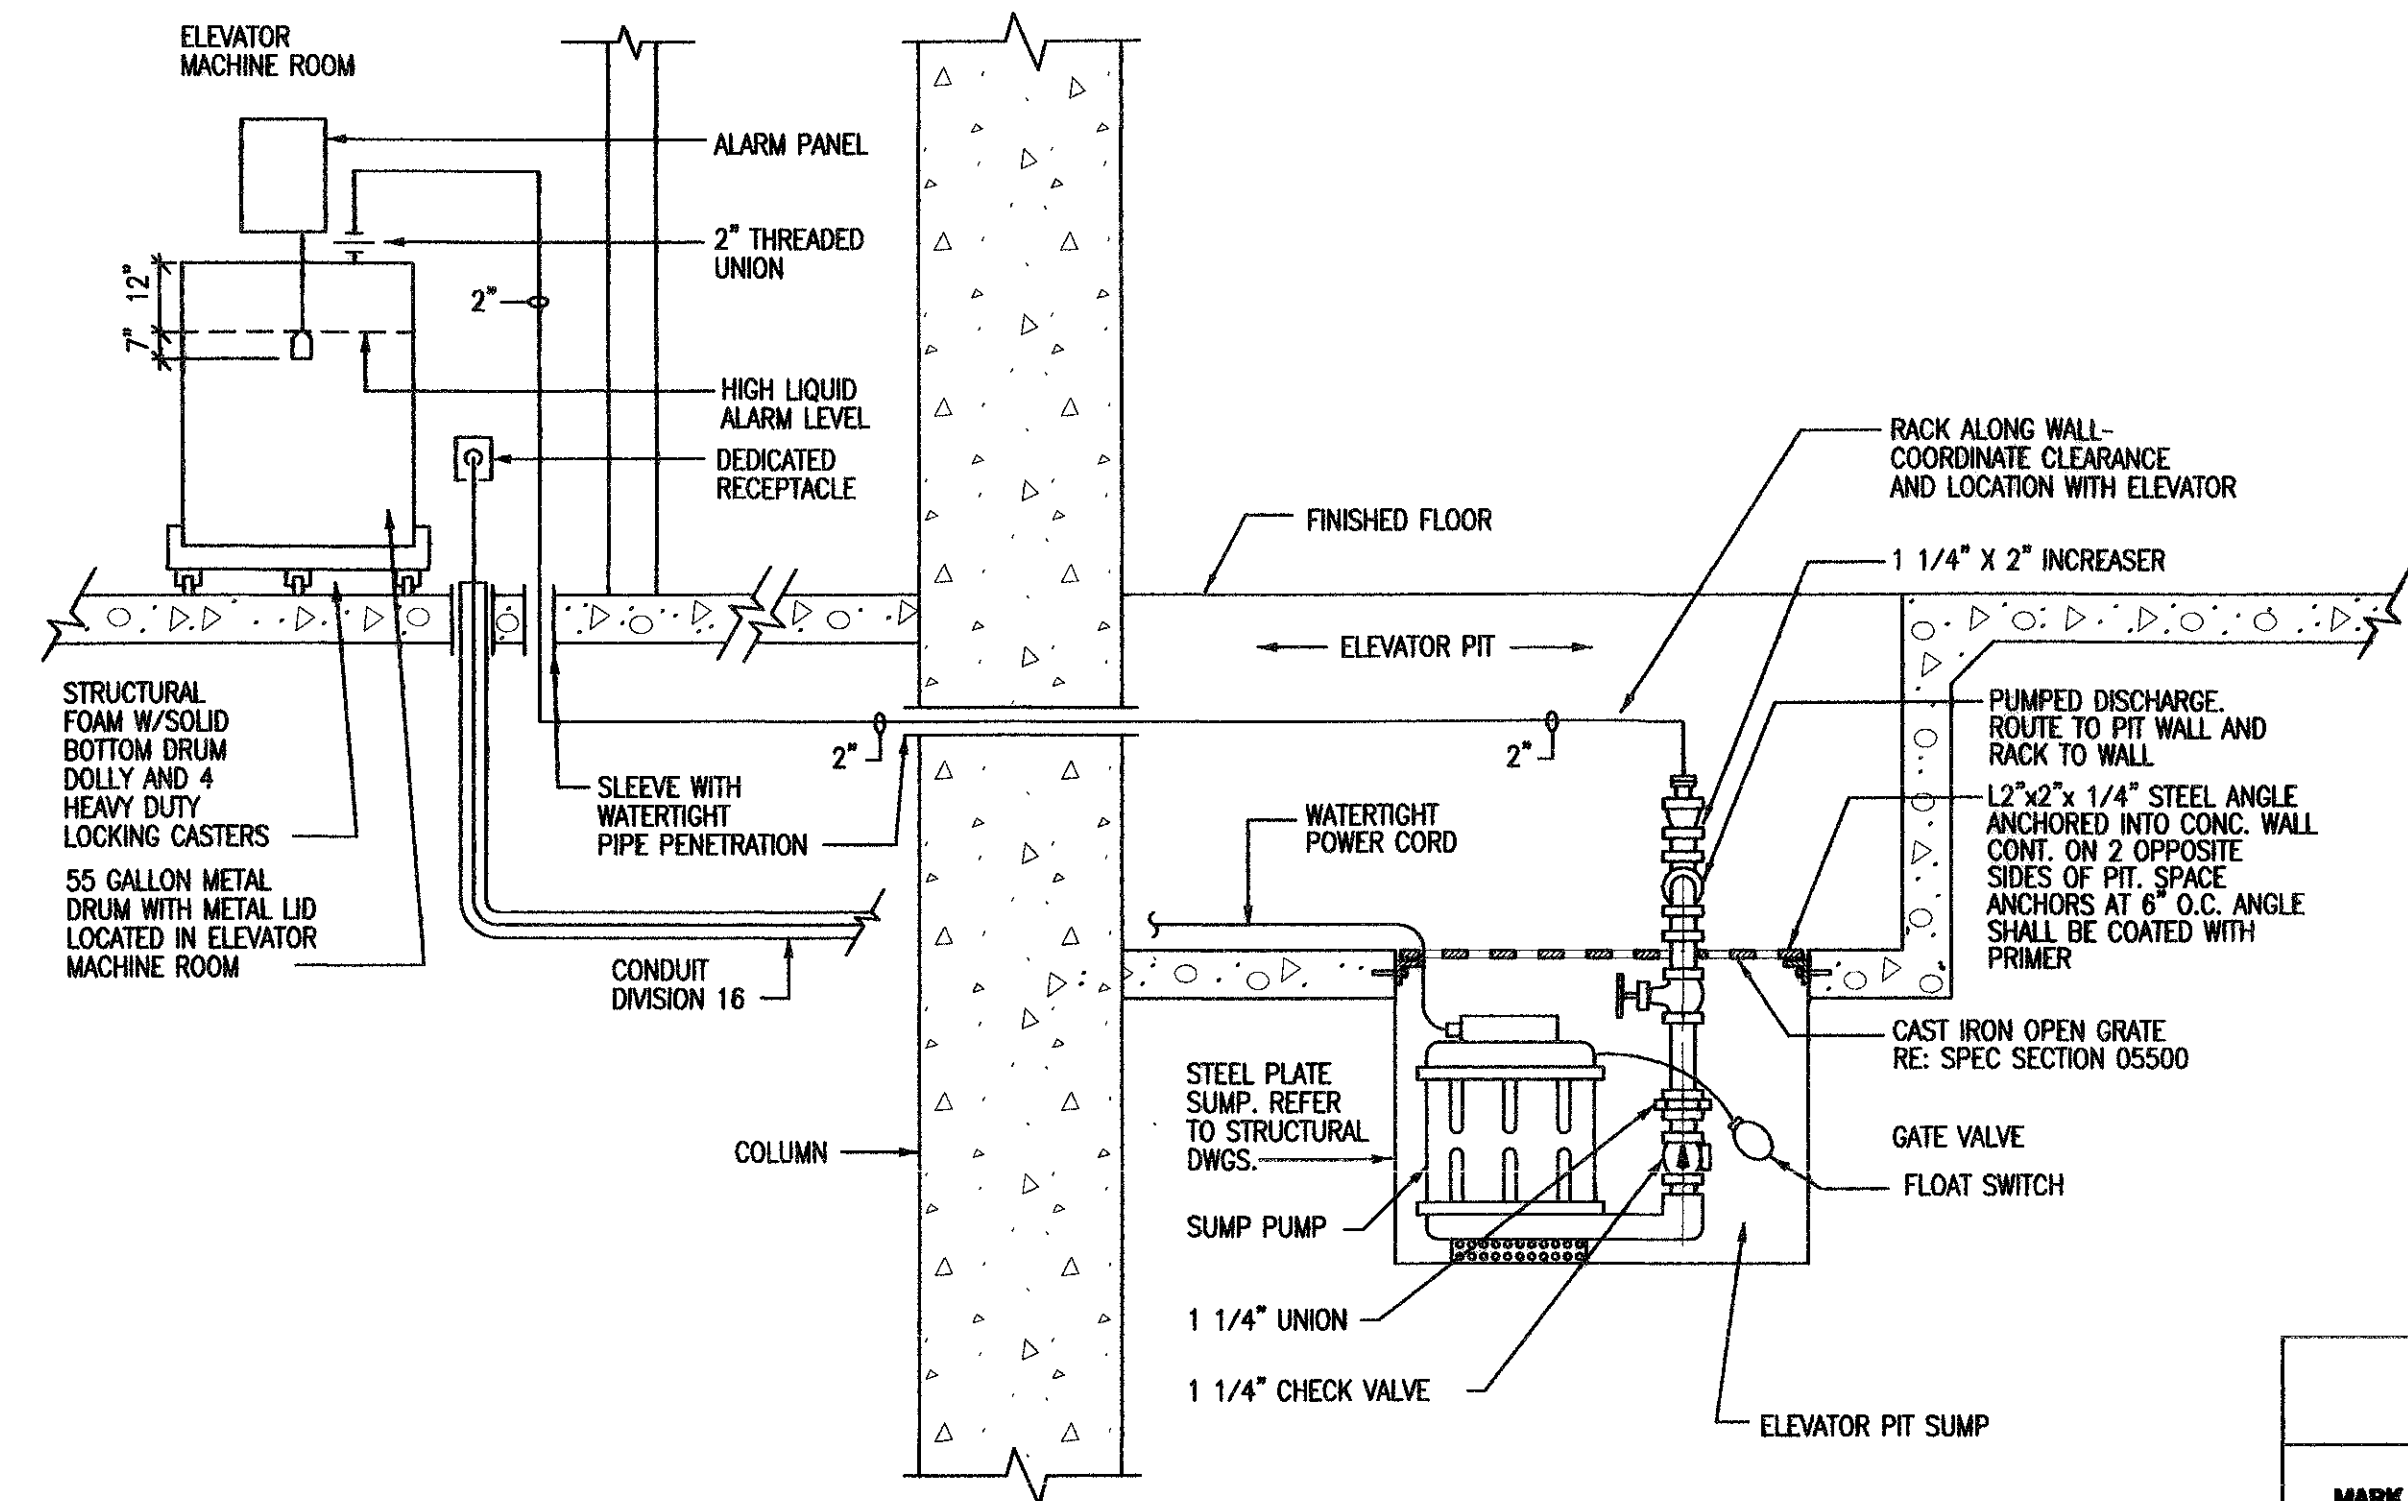

**03 ELEVATOR SUMP PUMP**  
 P0.001 NO SCALE

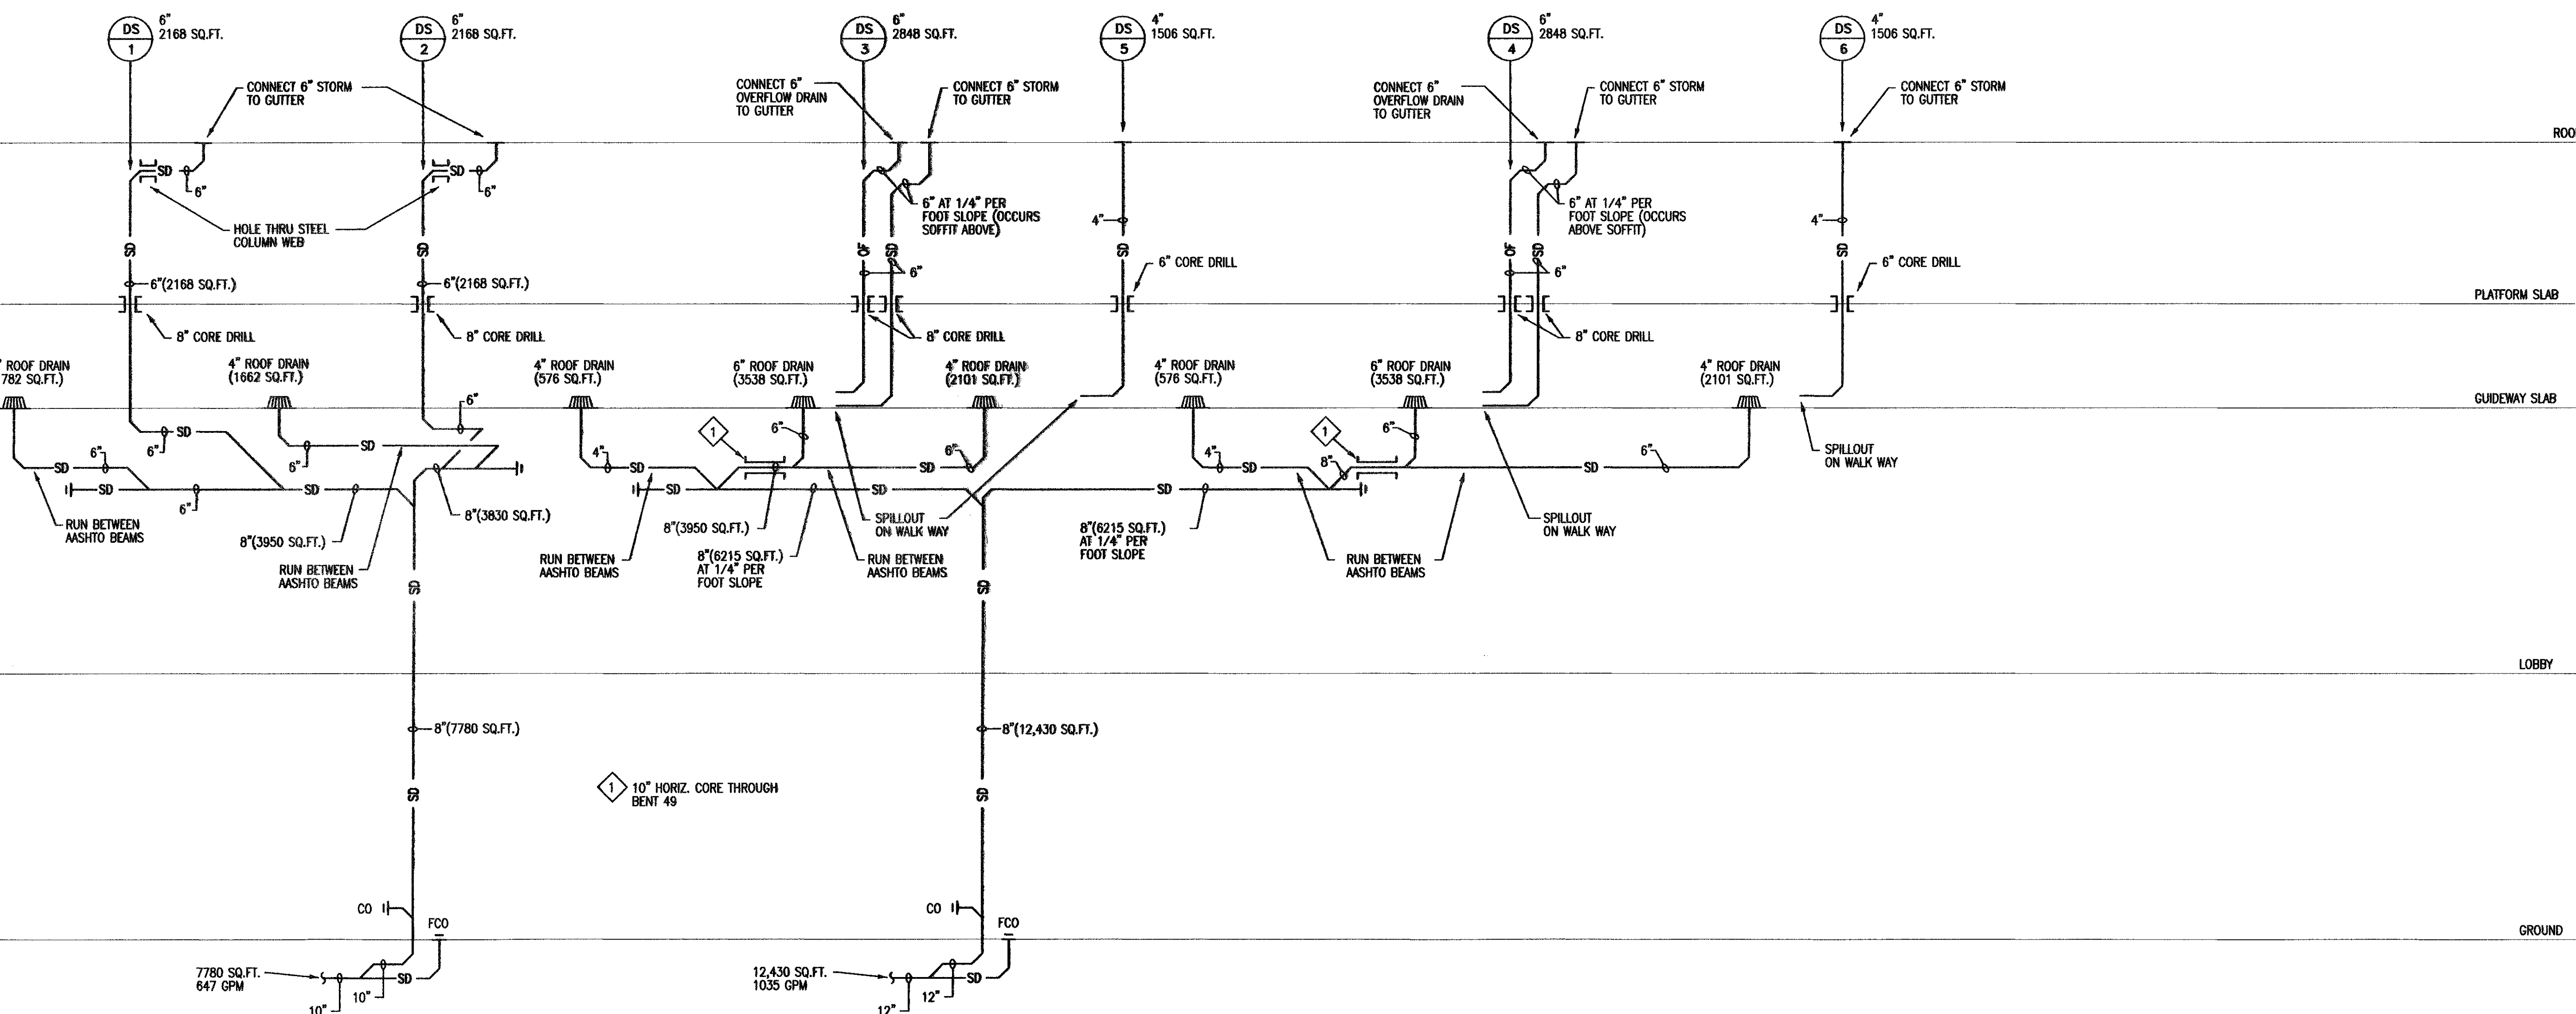

**02 STORM RISER DIAGRAM**  
 P0.001 NO SCALE

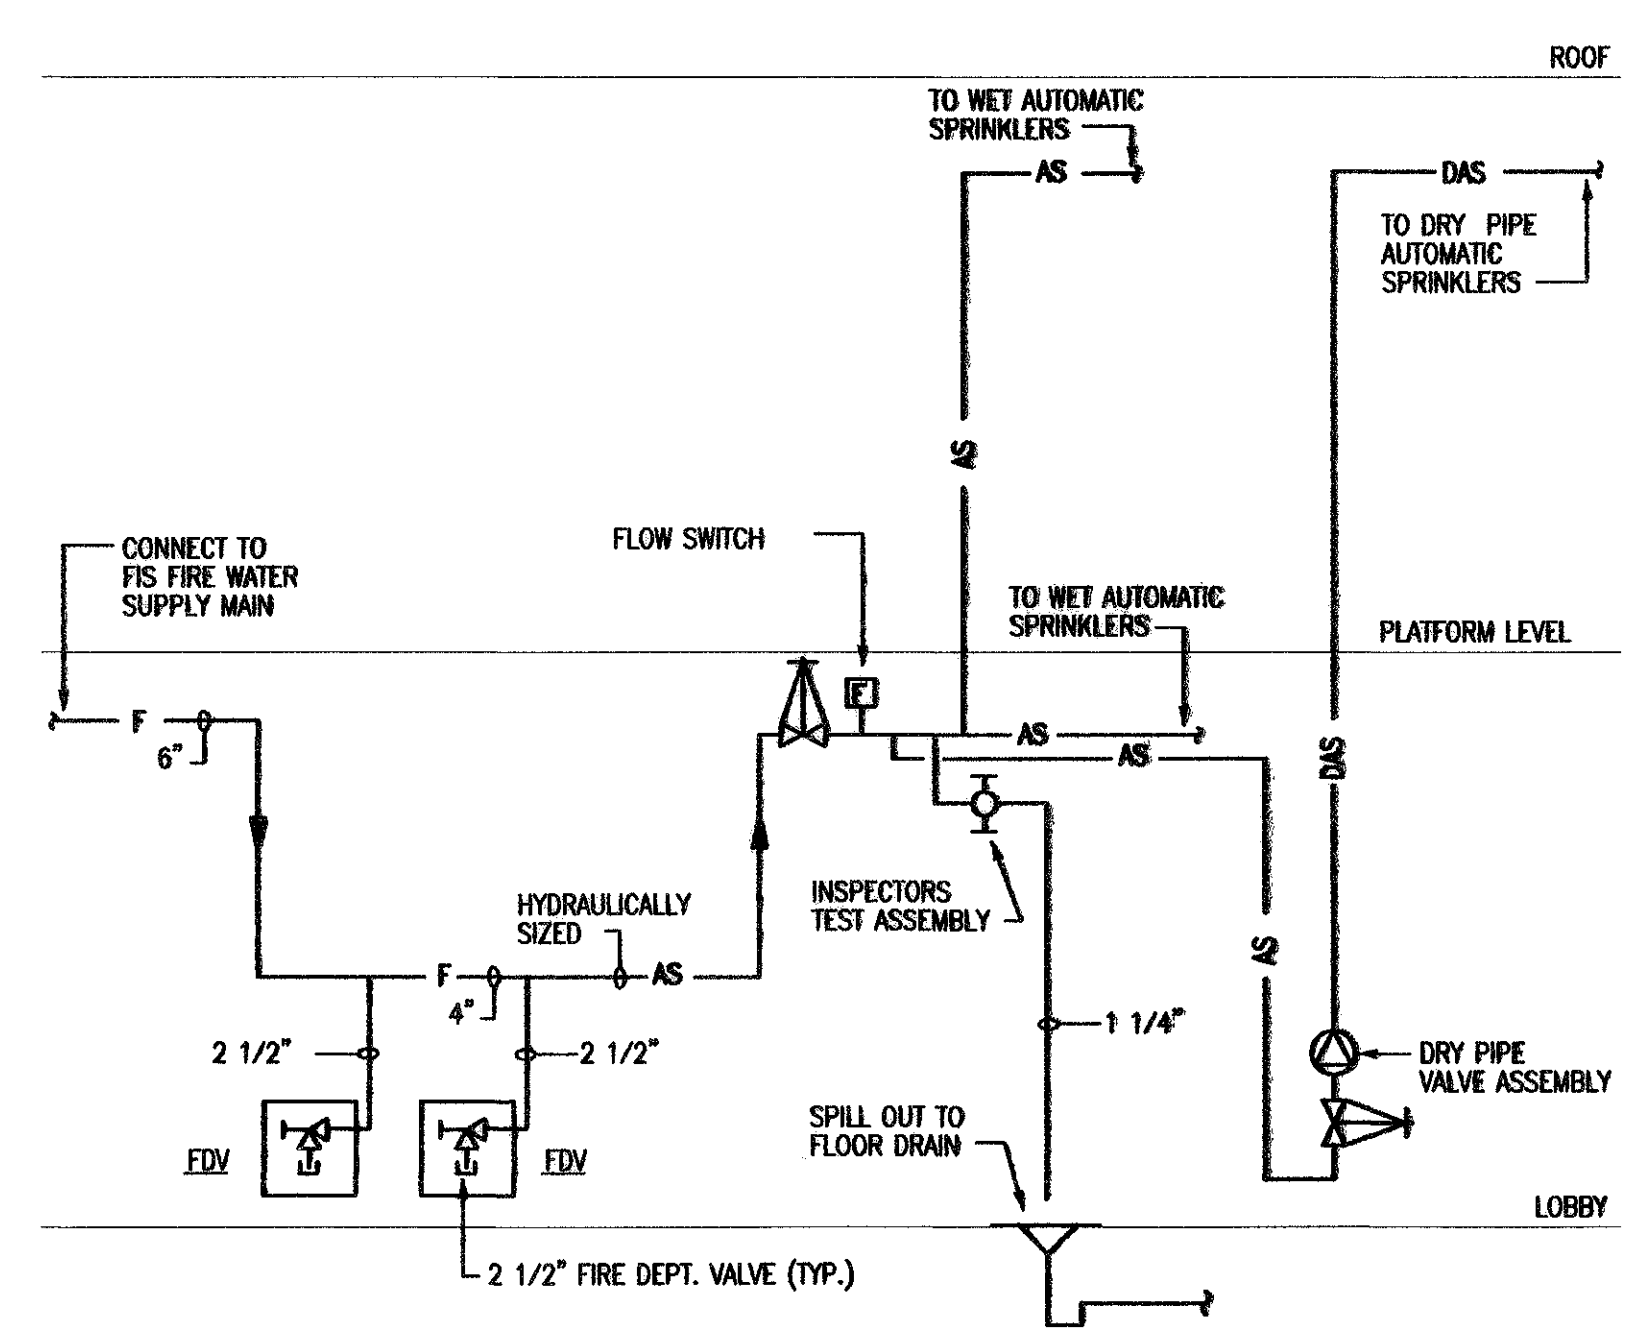

**04 FIRE PROTECTION RISER DIAGRAM**  
 P0.001 NO SCALE



**PLUMBING PIPE MATERIALS SPECIFICATION**

SERVICE	PIPE	FITTING
EQUIPMENT DRAINS AND OVERFLOWS	TYPE 1" HARD DRAWN COPPER (ASTM B88)	SOLDERED (95-5) WROUGHT COPPER, ANSI B16.22
SANITARY DRAINAGE AND VENT ABOVE GRADE	SERVICE WEIGHT CAST IRON, CISPI 301	SERVICE WEIGHT NO-HUB FITTINGS WITH HEAVY WEIGHT NO-HUB COUPLINGS CISPI 310, SIMILAR TO ANACOD THUSKET CLAMP-ALL MISSION TYP OR TYLER WIDE BODY
SANITARY DRAINAGE AND VENT BELOW GRADE	HOT-DIP COATED SERVICE WEIGHT CAST IRON BELL & SPIGOT, ASTM A74.	SERVICE WEIGHT CAST IRON BELL & SPIGOT FITTINGS WITH NEOPRENE GASKETS, ASTM C564.
STORM AND OVERFLOW DRAINAGE ABOVE GRADE	SERVICE WEIGHT CAST IRON, CISPI 301	FOR SIZES UP TO 8": SERVICE WEIGHT NO-HUB FITTINGS WITH HEAVY WEIGHT NO-HUB COUPLINGS CISPI 310, SIMILAR TO ANACOD THUSKET CLAMP-ALL MISSION TYP FOR SIZES OVER 8": SERVICE WEIGHT BELL & SPIGOT FITTINGS WITH ELASTOMER GASKETS, ASTM C564
SANITARY SEWER, STORM AND OVERFLOW DRAINAGE WHERE CAST IN BENTS, BEAMS AND COLUMNS	SCHEDULE 40 TYPE 1 PVC	DNV PATTERN PVC FITTINGS WITH SOLVENT CEMENT JOINTS
STORM AND OVERFLOW DRAINAGE BELOW GRADE	HOT-DIP COATED SERVICE WEIGHT CAST IRON BELL & SPIGOT, ASTM A74.	SERVICE WEIGHT CAST IRON HUBBED FITTINGS WITH NEOPRENE GASKETS, ASTM C564.
DOMESTIC WATER ABOVE GRADE	TYPE 1" HARD DRAWN COPPER (ASTM B88)	ANSI B16.22 WROUGHT COPPER WITH 95-5 SOLDER LEAD-FREE JOINTS, ASTM B32

UNIONS: CLASS 150, 300 POUND WATER-OIL-GAS SERVICE BRONZE. UNION WITH GROUND JOINT AND BRASS SEAT, ANSI B16.39.

**GENERAL NOTES**

- PRIOR TO WORK CONTRACTOR SHALL THOROUGHLY COORDINATE PLUMBING WORK WITH OTHER TRADES.
- PROVIDE A UNION DOWNSTREAM FROM EACH BALL VALVE.
- DRAWINGS ARE DIAGNOSTIC IN NATURE. NOT ALL REQUIRED PIPE ELBOWS, TEES, AND ASSOCIATED FITTINGS ARE SHOWN. PROVIDE A COMPLETE WORKING PLUMBING SYSTEM PER THE SPECIFICATIONS AND CITY OF HOUSTON PLUMBING CODE.
- PROVIDE A WET AUTOMATIC SPRINKLER SYSTEM THROUGHOUT, EXCEPT WHERE A DRY PIPE SPRINKLER SYSTEM IS INDICATED ON DRAWINGS. COMPLY WITH NFPA 13 AND SPECIFICATIONS SECTION 15330.
- FIRE PROTECTION PIPING SHALL BE COORDINATED AROUND OTHER TRADES, SUCH AS PLUMBING, HVAC AND ELECTRICAL.
- PROVIDE AN IN-LINE Y-STRAINER UPSTREAM OF ALL TRAP PRIMERS.
- INSULATE AND HEAT TRACE TRAP PRIMER PIPING WHERE EXPOSED TO FREEZING TEMPERATURES. INSULATE WASTE, VENT AND STORM PIPING WHERE EXPOSED TO FREEZING TEMPERATURES.
- PROVIDE A WATER CURTAIN TYPE SPRINKLER SYSTEM WHERE INDICATED ON DRAWINGS, AND CONFORMING TO GUIDELINES SET FORTH IN NFPA13.
- PROVIDE SHOP DWGS. INDICATING EXACT LOCATION & COORDINATION WITH STRUCTURAL REPAIR WHERE PIPING IS CAST IN CONC. BEAMS AND COLUMNS. COORDINATE PLUMBING SHOP DWGS. WHERE PIPING IS CAST IN STRUCT. BEAMS & COLUMNS WITH STRUCTURAL APPROVED SHOP DWGS. COORDINATE INSTALLATION OF PIPING WITH CONSTRUCTION OF STRUCTURAL COMPONENTS.

**PLUMBING ROUGH-IN SCHEDULE**


FIXTURE	MINIMUM SIZES (INCHES)				
	SOIL	WASTE	VENT	HOT WATER	COLD WATER
HB-1	-	-	-	-	3/4
FD-1	-	3	2	-	-

**PUMP SCHEDULE**


MARK	SERVICE	TDH (FEET)	FLOW RATE (GPM)	ELECTRICAL DATA					REMARKS
				HP	RPM	VOLT	PHASE	HERTZ	
SP-1	ELEVATOR SUMP	20	10	1/4	1550	120	1	60	HYDROMATIC NO. W25

**PLUMBING LEGEND**


SYMBOL	ABBREV.	DESCRIPTION	SYMBOL	ABBREV.	DESCRIPTION
DS	4"	DOWNSPOUT & SIZE	U		UNION
		DOWNSPOUT NO. & ROOF AREA	B		BALL VALVE
VTR		VENT THRU ROOF	G		GATE VALVE
		ABOVE GROUND SANITARY	C		CHECK VALVE
		UNDERGROUND SANITARY	FCD		FLOOR CLEANOUT
V		VENT	CL		CLEANOUT
SD		ABOVE GROUND STORM DRAIN	ODG		CLEANOUT AT GRADE
SD		UNDERGROUND STORM DRAIN	AF		ABOVE FINISHED FLOOR
CW		DOMESTIC COLD WATER	IE		INVERT ELEVATION
TP		TRAP PRIMER			
AS		WET AUTOMATIC SPRINKLERS			
DAS		DRY AUTOMATIC SPRINKLERS			

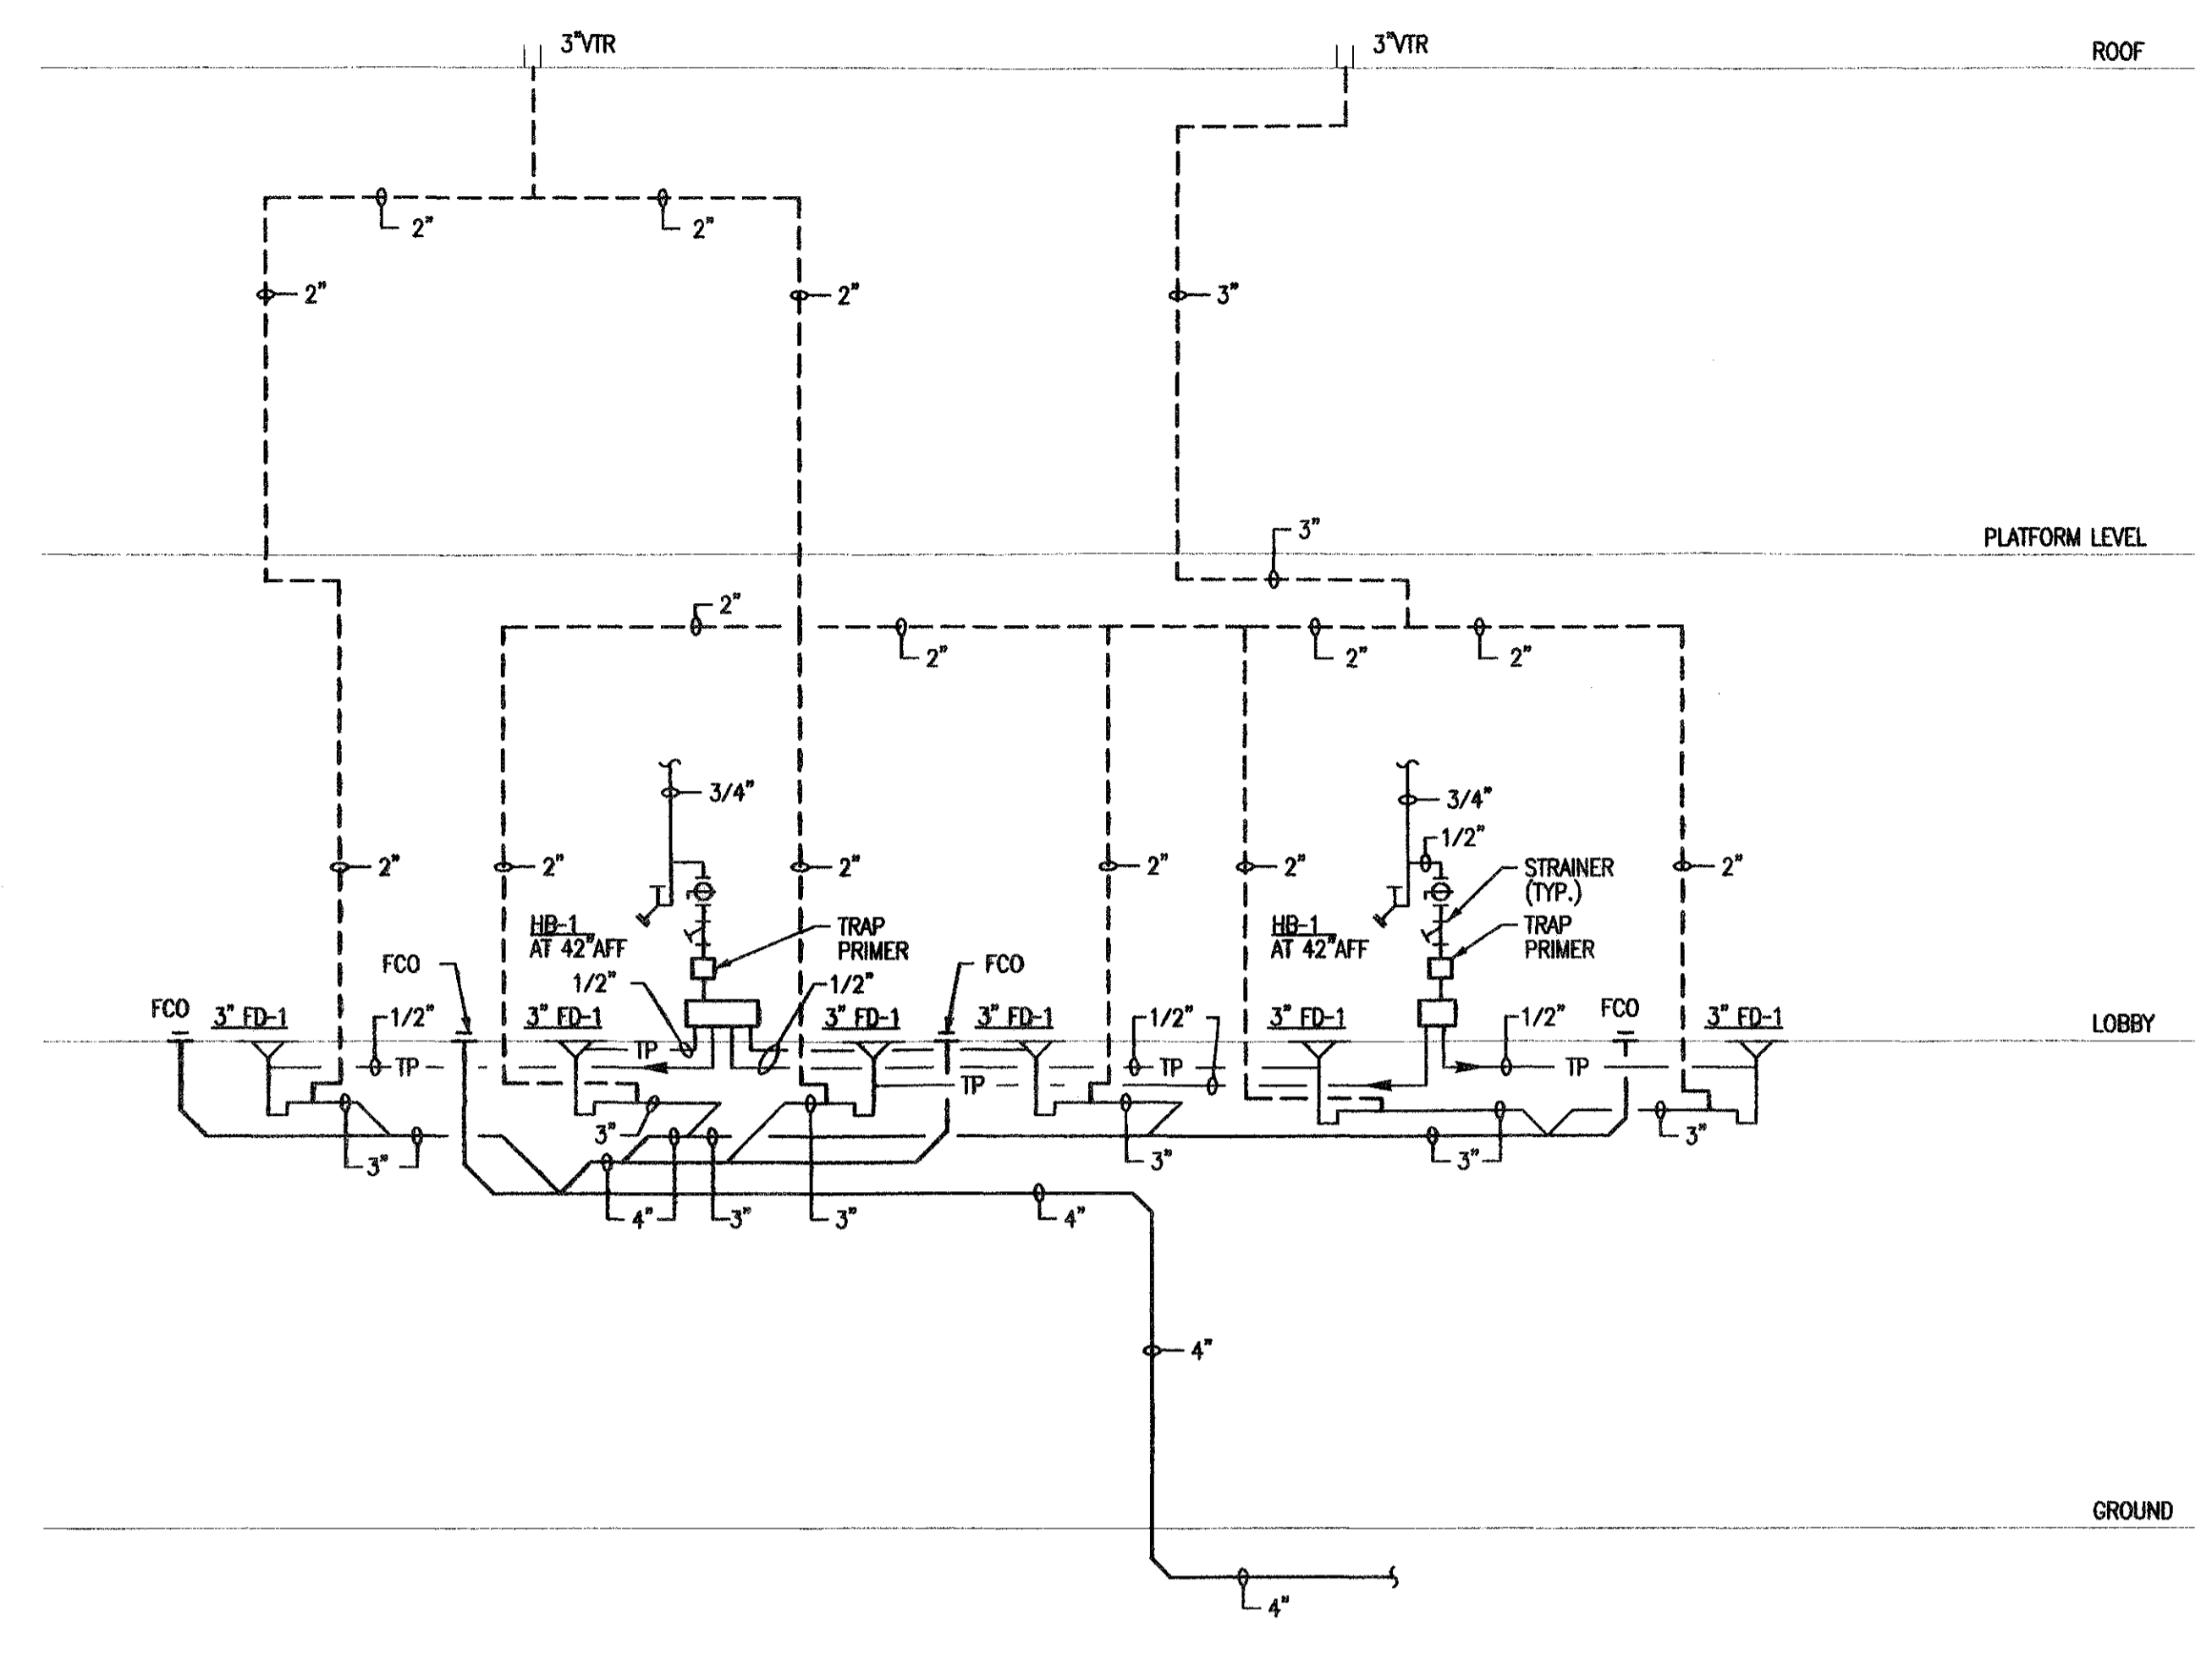


**01 PLUMBING RISER DIAGRAM**  
 P0.001 NO SCALE

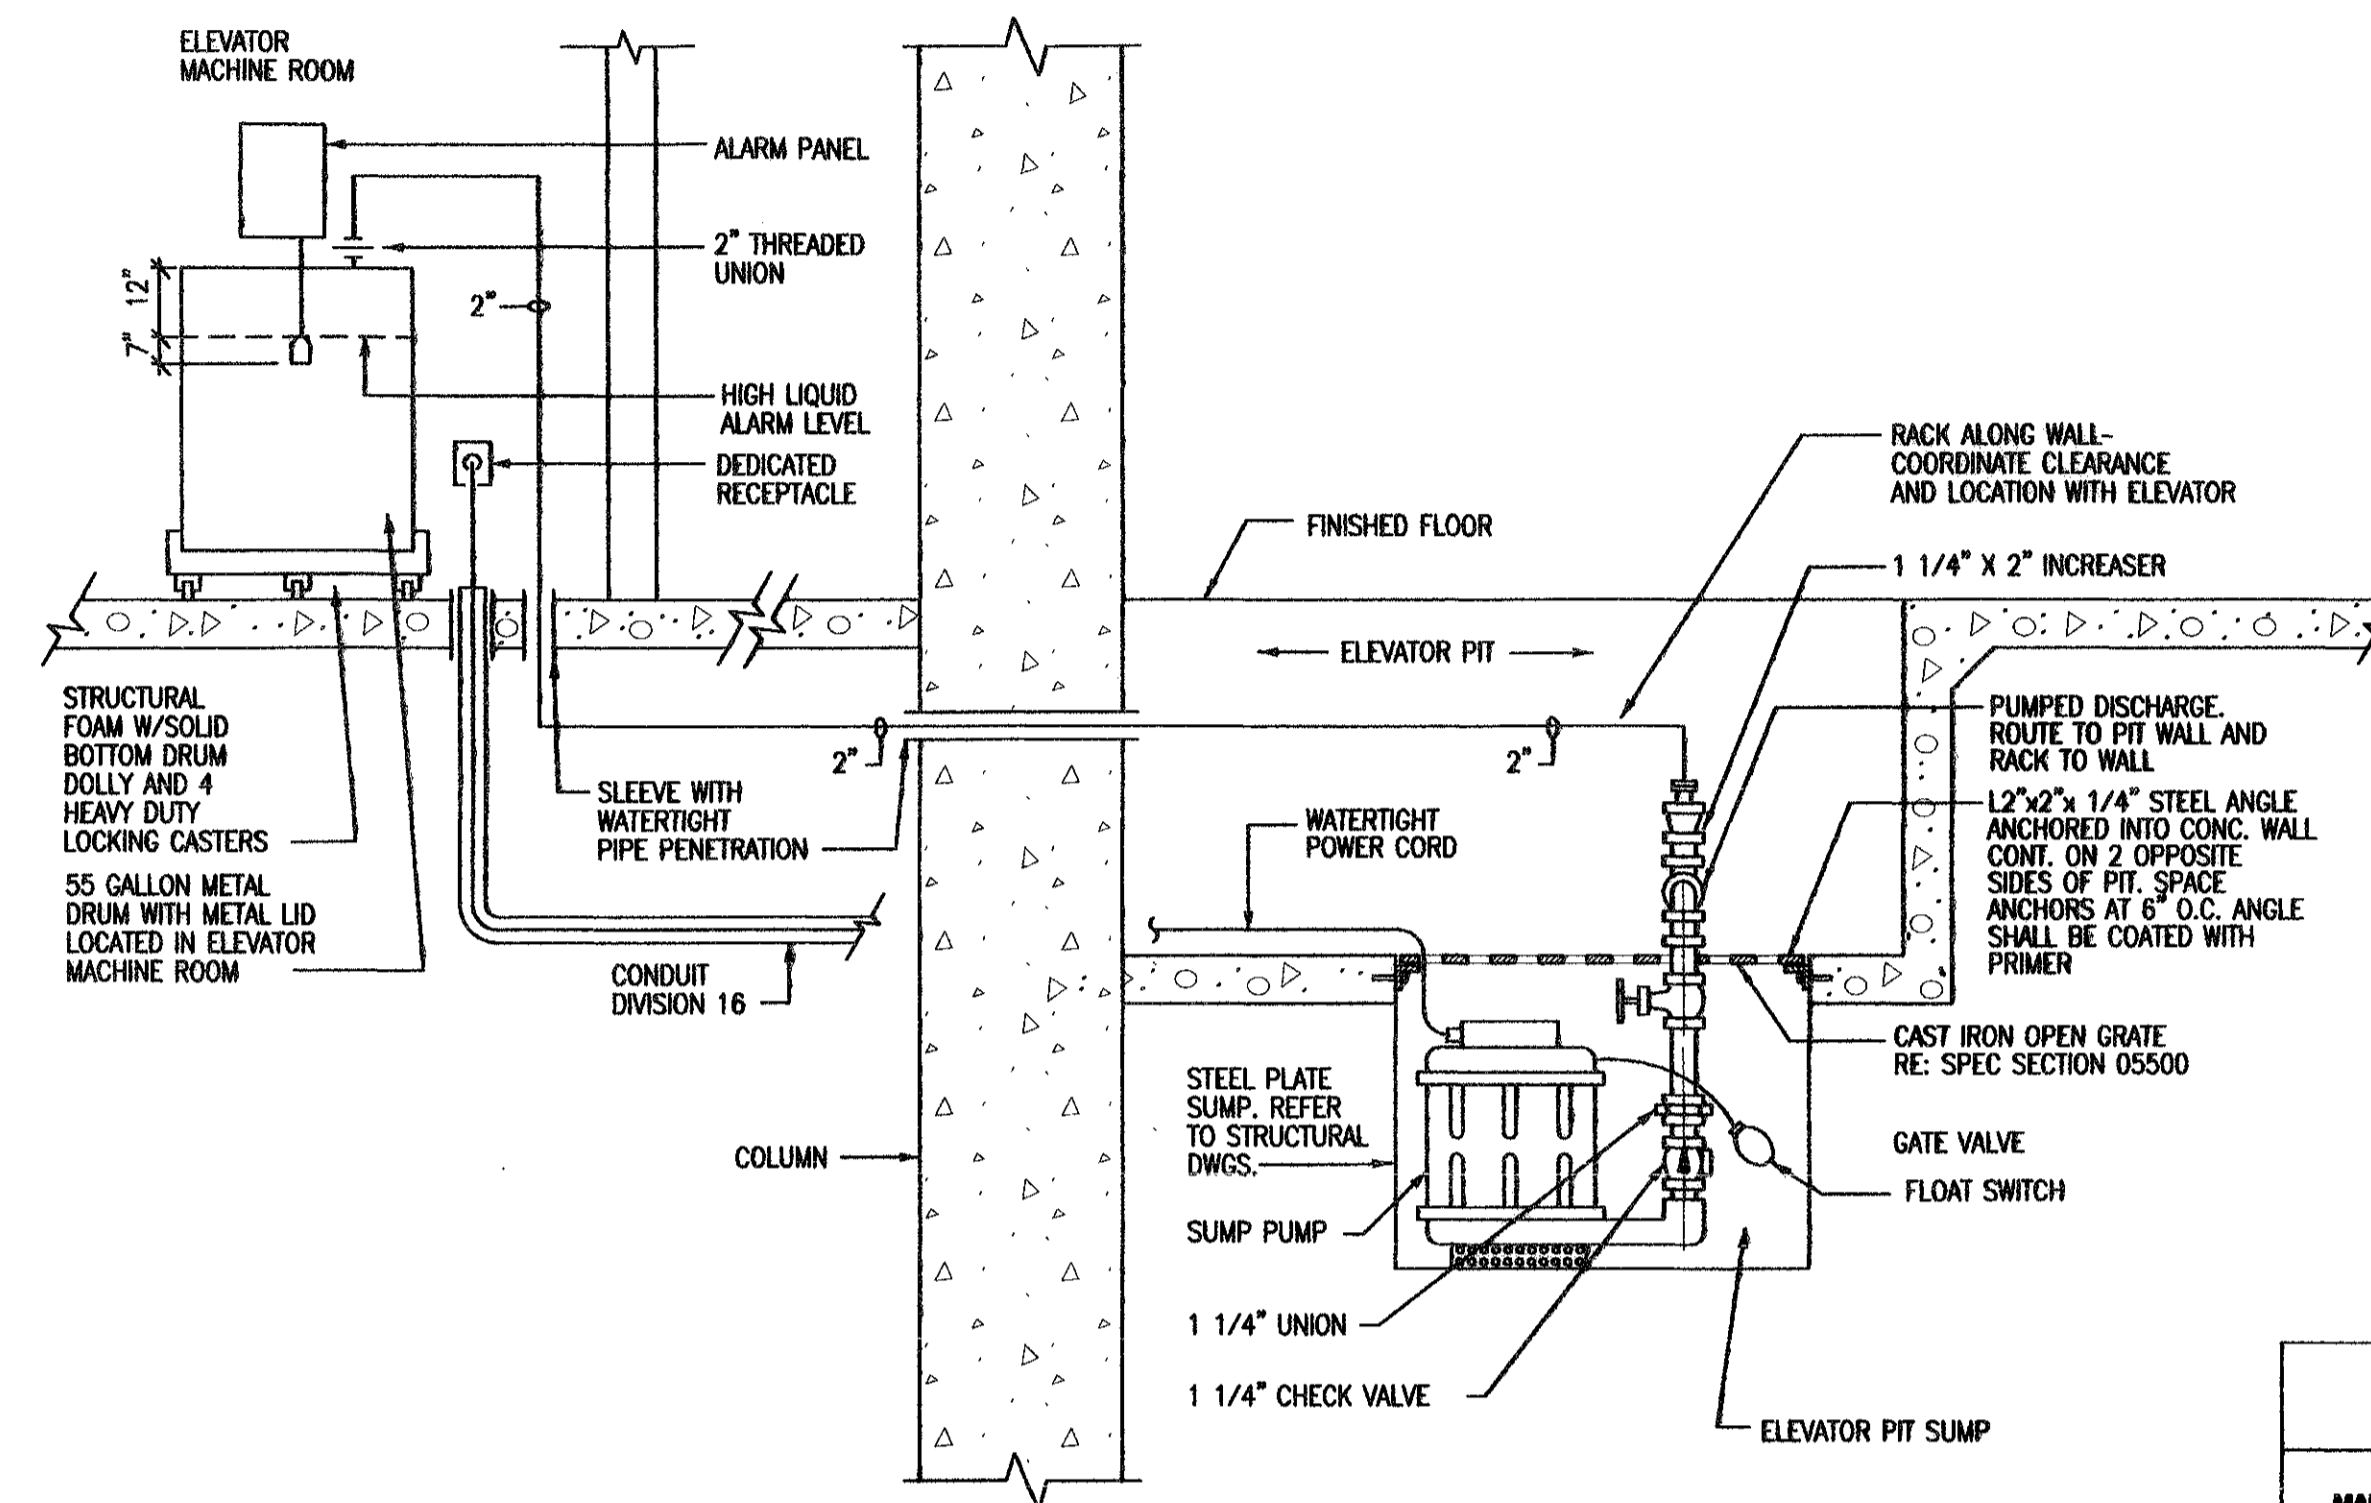

**03 ELEVATOR SUMP PUMP**  
 P0.001 NO SCALE

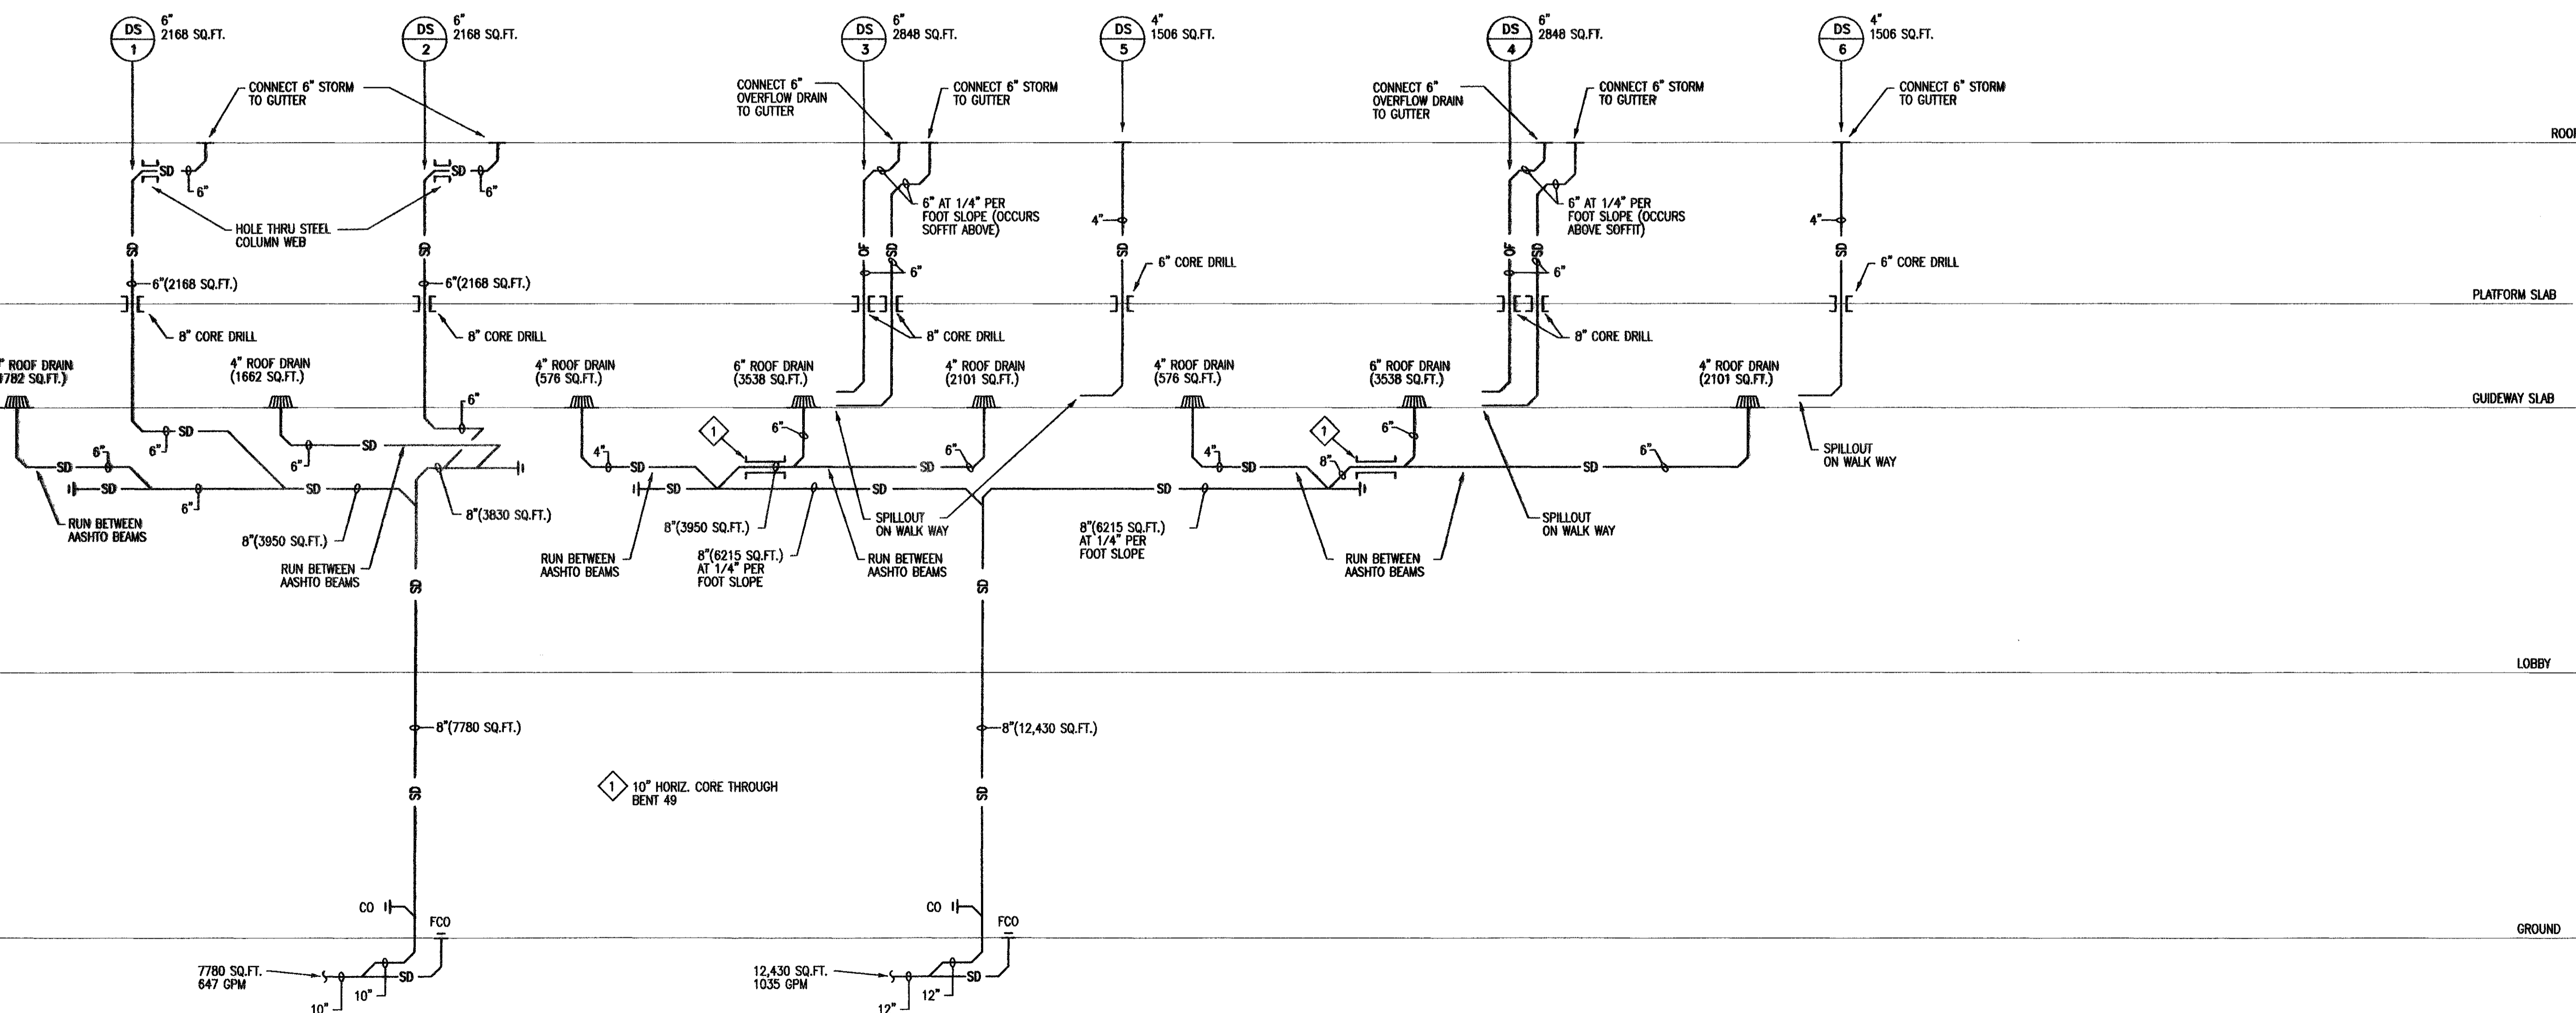


**02 STORM RISER DIAGRAM**  
 P0.001 NO SCALE

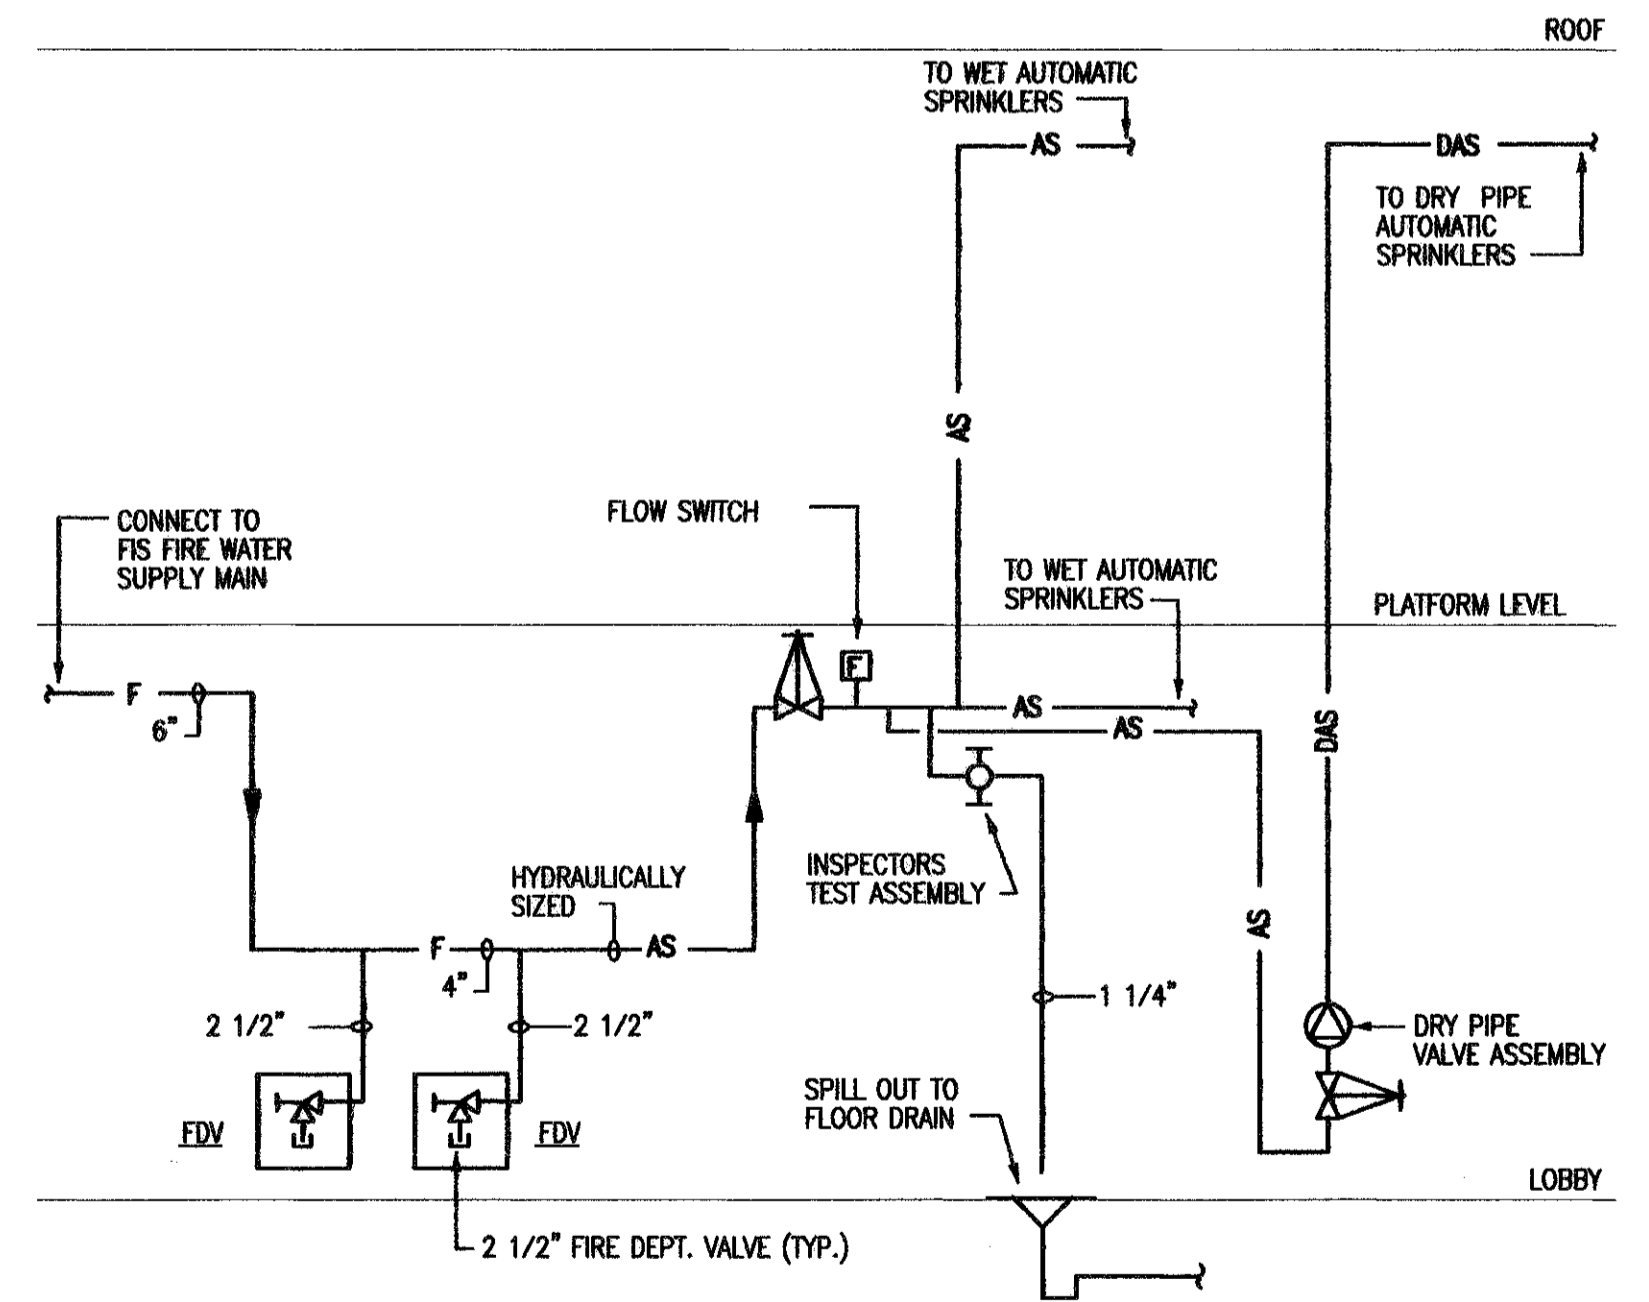

**04 FIRE PROTECTION RISER DIAGRAM**  
 P0.001 NO SCALE



NO.	DESCRIPTION	DATE	BY
1	ISSUED FOR BID	10/19/05	
	RECORD DRAWING	05/06/05	
	<b>1</b> <b>REVISION</b>	<b>06/22/05</b>	

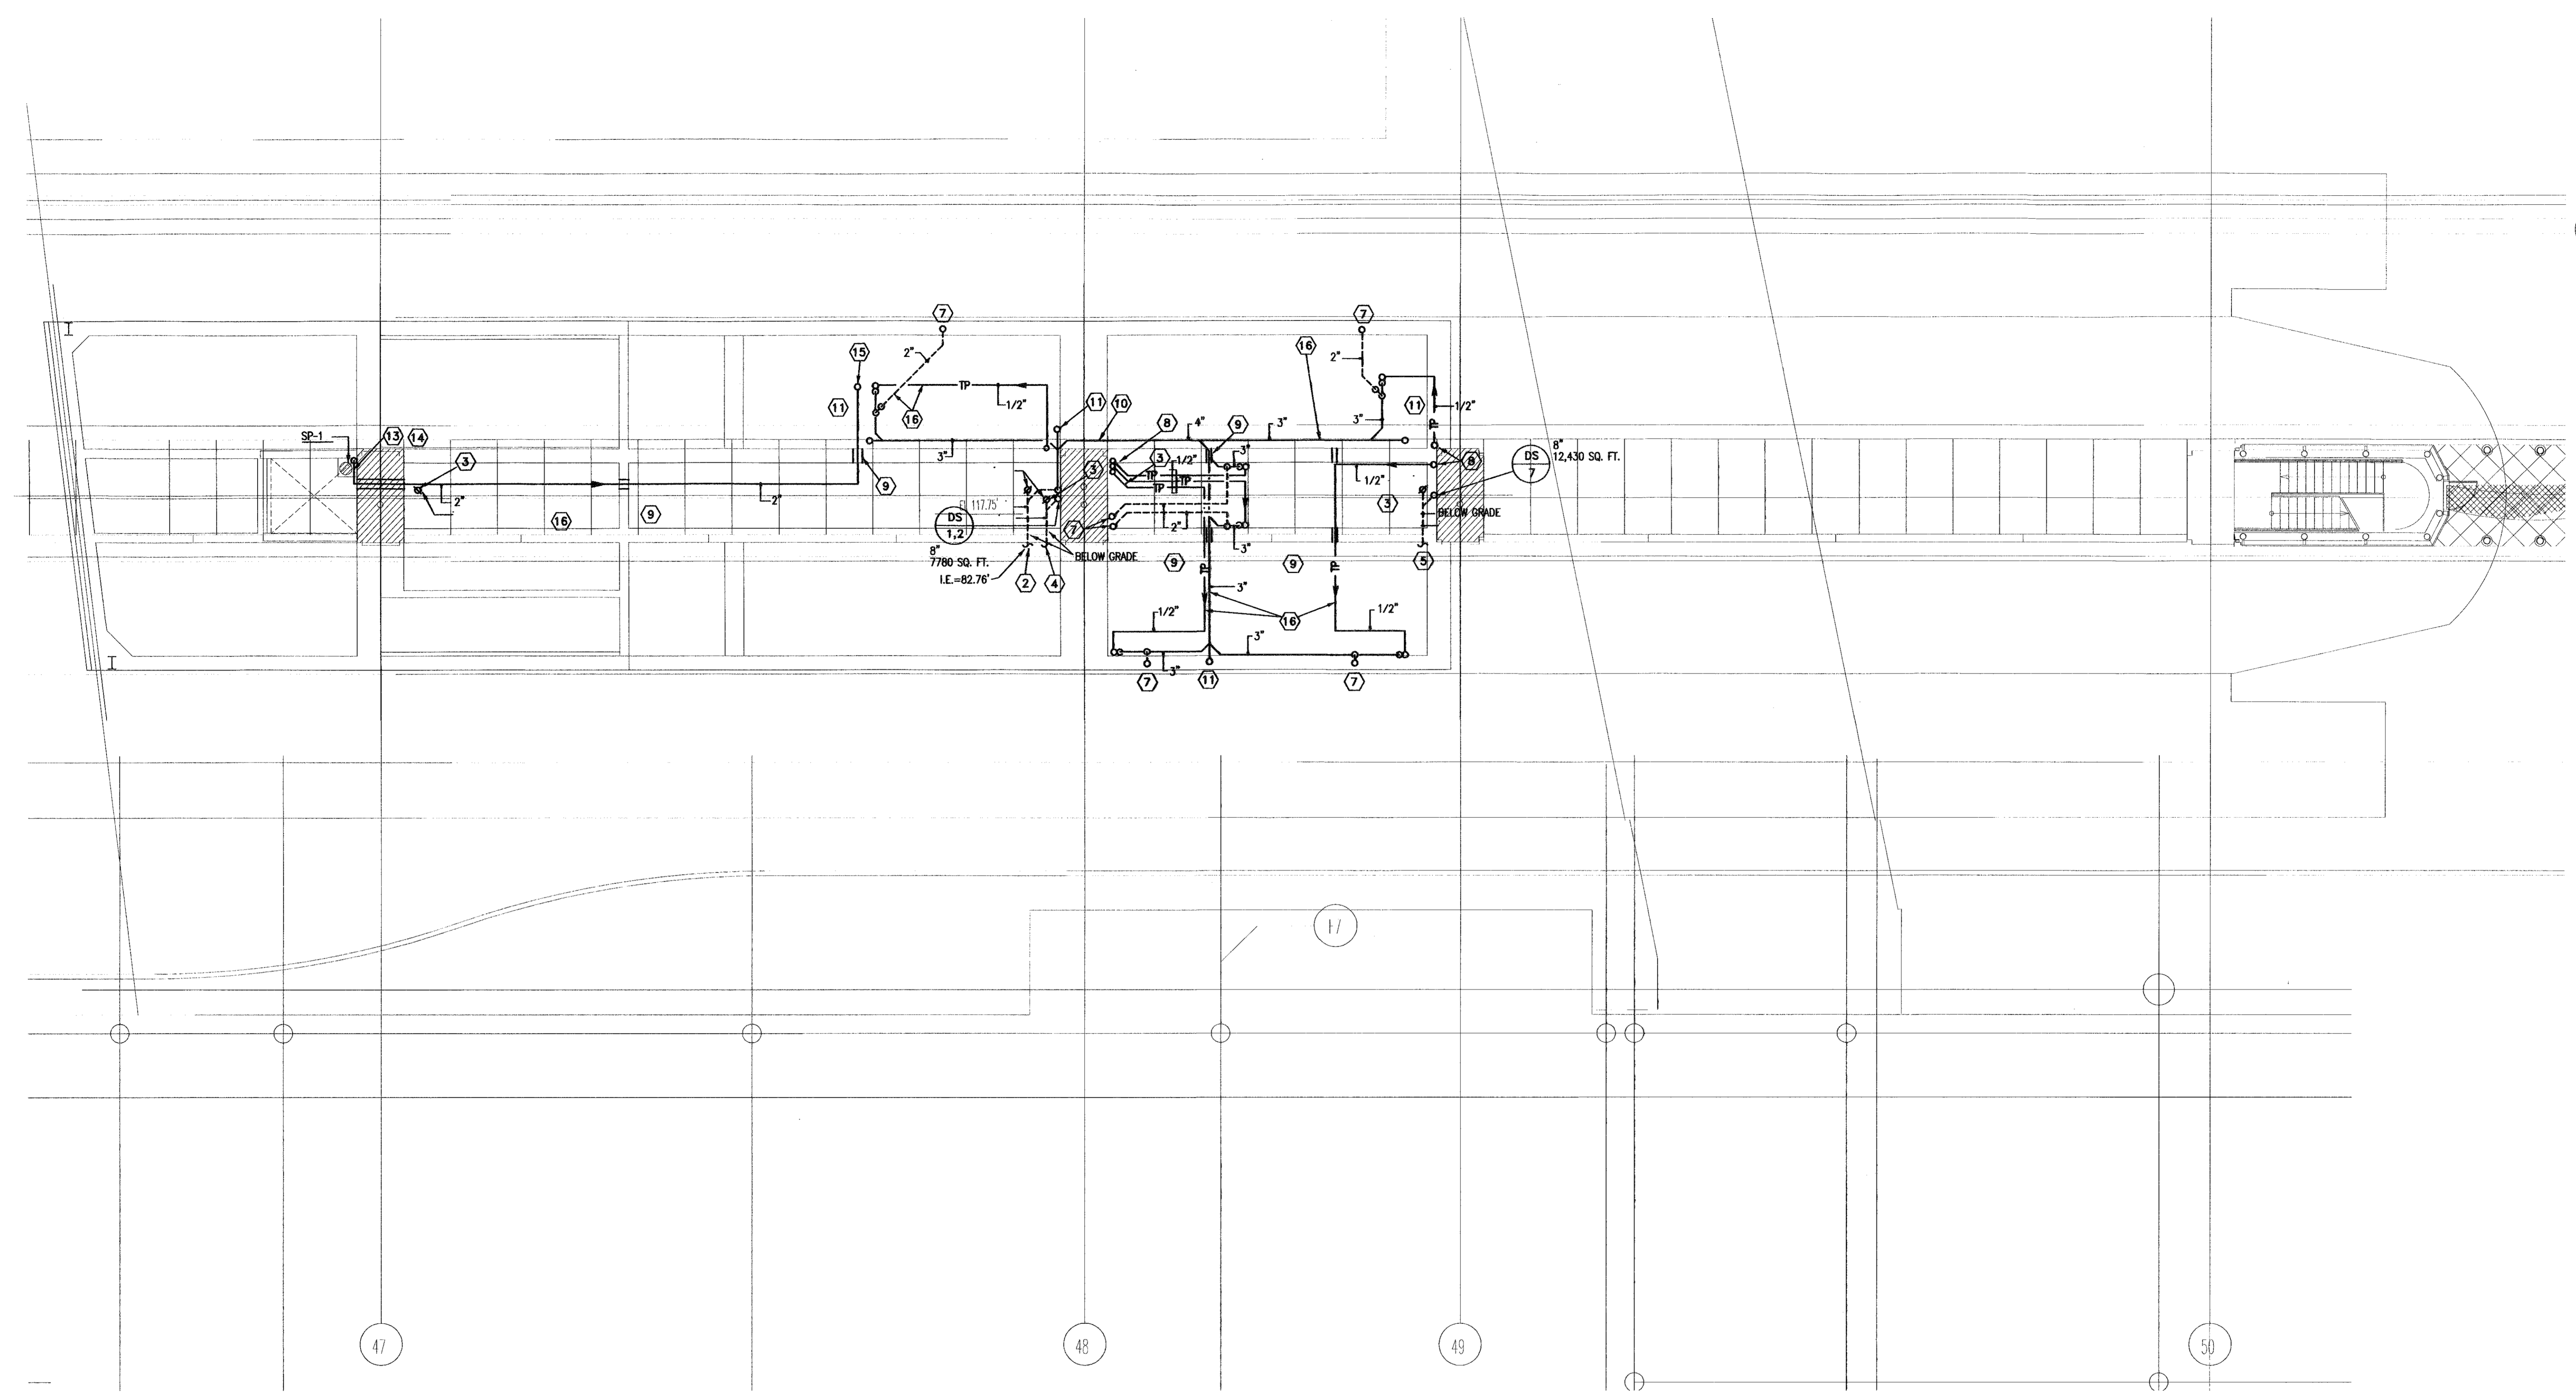



**01** GROUND FLOOR PLUMBING PLAN  
P2.001 1/8" = 1'-0"

**KEYED NOTES:**

- ① NOT USED
- ② 4" SANITARY SEWER (BELOW GRADE). REFER TO HAS JOB NO. 536A-3 FOR CONT. 36 DFL-236PM
- ③ FLUSH CLEANOUT WITH PAVING.
- ④ 10" STORM SEWER (BELOW GRADE) REFER TO HAS JOB NO. 536A-2 FOR CONT. 7780 SQ.FT.-6476PM
- ⑤ 12" STORM SEWER (BELOW GRADE) REFER TO HAS JOB NO. 536A-2 FOR CONT. 12,430 SQ.FT.-1036GPM
- ⑥ NOT USED
- ⑦ 2" VENT UP.
- ⑧ 1/2" TRAP PRIMER LINES FROM ABOVE.
- ⑨ ROUTE PIPING THRU SLEEVE IN CONCRETE BEAM. REFER TO STRUCTURAL DWGS. FOR LOCATION.
- ⑩ CAST 4" WASTE IN CONCRETE BEAM. REFER TO STRUCTURAL DWGS. FOR LOCATION.
- ⑪ UP TO FGD (CAST IN CONCRETE BEAM).
- ⑫ CAST DOWNSPOUT AND WASTE LINE IN COLUMN. REFER TO STRUCTURAL DWGS. FOR LOCATION.
- ⑬ SUMP PUMP LOCATED IN ELEVATOR PIT SUMP. 2" SUMP PUMP DISCHARGE LINE OUT OF PIT - ROUTE AS SHOWN.
- ⑭ 2" PUMP DISCHARGE THROUGH SLEEVE IN COLUMN, COORDINATE WITH STRUCTURAL DWGS.
- ⑮ 2" PUMP DISCHARGE UP.
- ⑯ LOCATED IN SOFFIT.

**GENERAL NOTES:**

1. COORDINATE STORM SEWER STUB-OUTS WITH JOB NO. 536A-2. COORDINATE SANITARY SEWER STUB-OUTS WITH JOB NO. 536A-3.
2. INSULATE & HEAT TRACE TRAP PRIMER PIPING WHERE IN SOFFIT.
3. INSULATE WASTE & VENT PIPING WHERE LOCATED IN SOFFIT.
4. PROVIDE CLEANOUT CAST IN COLUMN & BASE OF DOWNSPOUTS.
5. COORDINATE LOCATION OF PIPE WITH CONCRETE REBAR PRIOR TO INSTALLATION AND APPROVED STRUCTURAL DWGS.
6. PIPING CAST IN CONCRETE BEAMS, BENTS AND COLUMNS SHALL BE SCHEDULE 40 PVC WITH DWV PATTERN FITTINGS WITH SOLVENT CEMENT JOINTS.

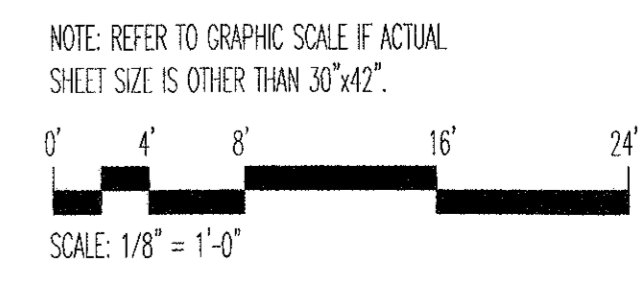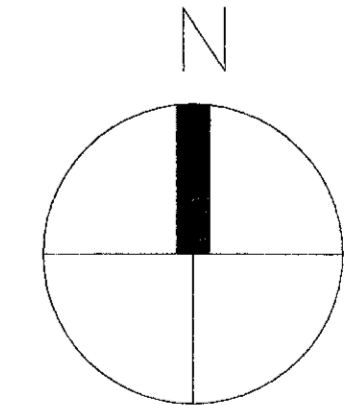

INTERNATIONAL SERVICES EXPANSION PROGRAM  
**APM STATION + PLATFORM**  
GROUND FLOOR PLUMBING

PROJECT MGR.	A.E. BELTRIN
DESIGNER	C. COBB
DRAWN BY	E. STREIBLING
CHECKED BY	C. COBB
DRAWING STANDARD	SEP 07.20.2000
SCALE	AS NOTED
DATE	09/14/05



**RECORD DRAWING**  
THIS DRAWING HAS BEEN REVISED TO SHOW SIGNIFICANT CHANGES IN THE WORK MADE DURING CONSTRUCTION BASED ON MARKED-UP PRINTS, DRAWINGS AND OTHER DATA.

APPROVED BY:	DATE:
DIRECTOR	HOUSTON AIRPORT SYSTEM
PROJECT NO.	1061-001
C.I.P. NO.	A-034
H.A.S. NO.	536C
SHEET NO.	

P2.001



NO.	DESCRIPTION	DATE	BY
1	BULLETIN #33 09/22/03		

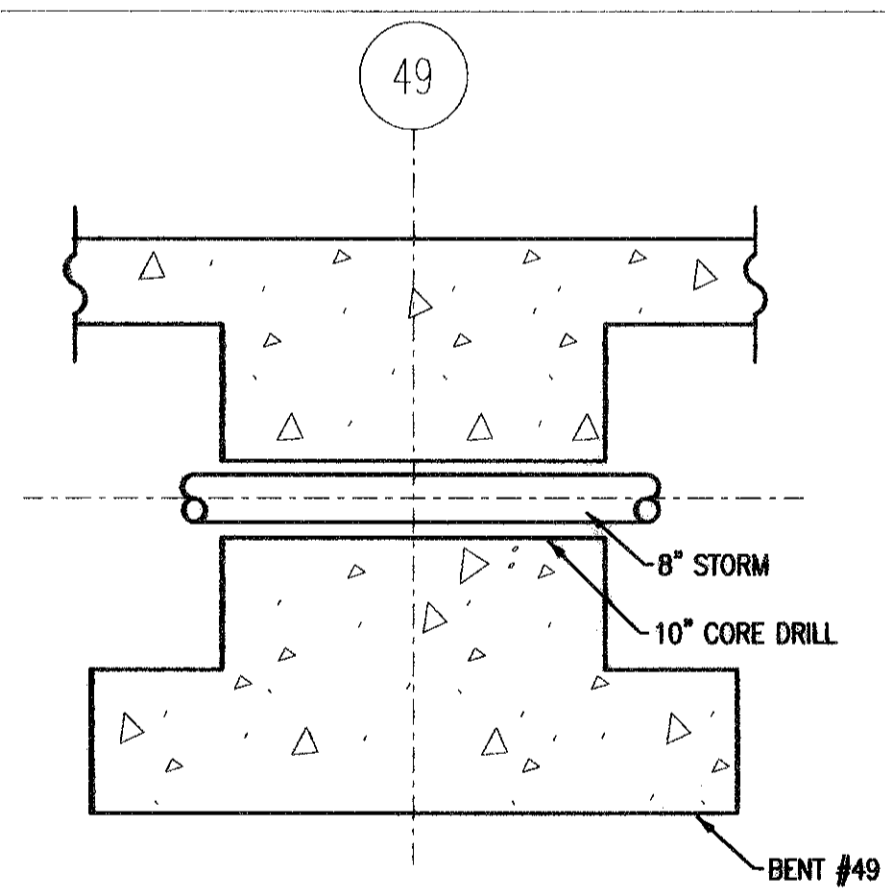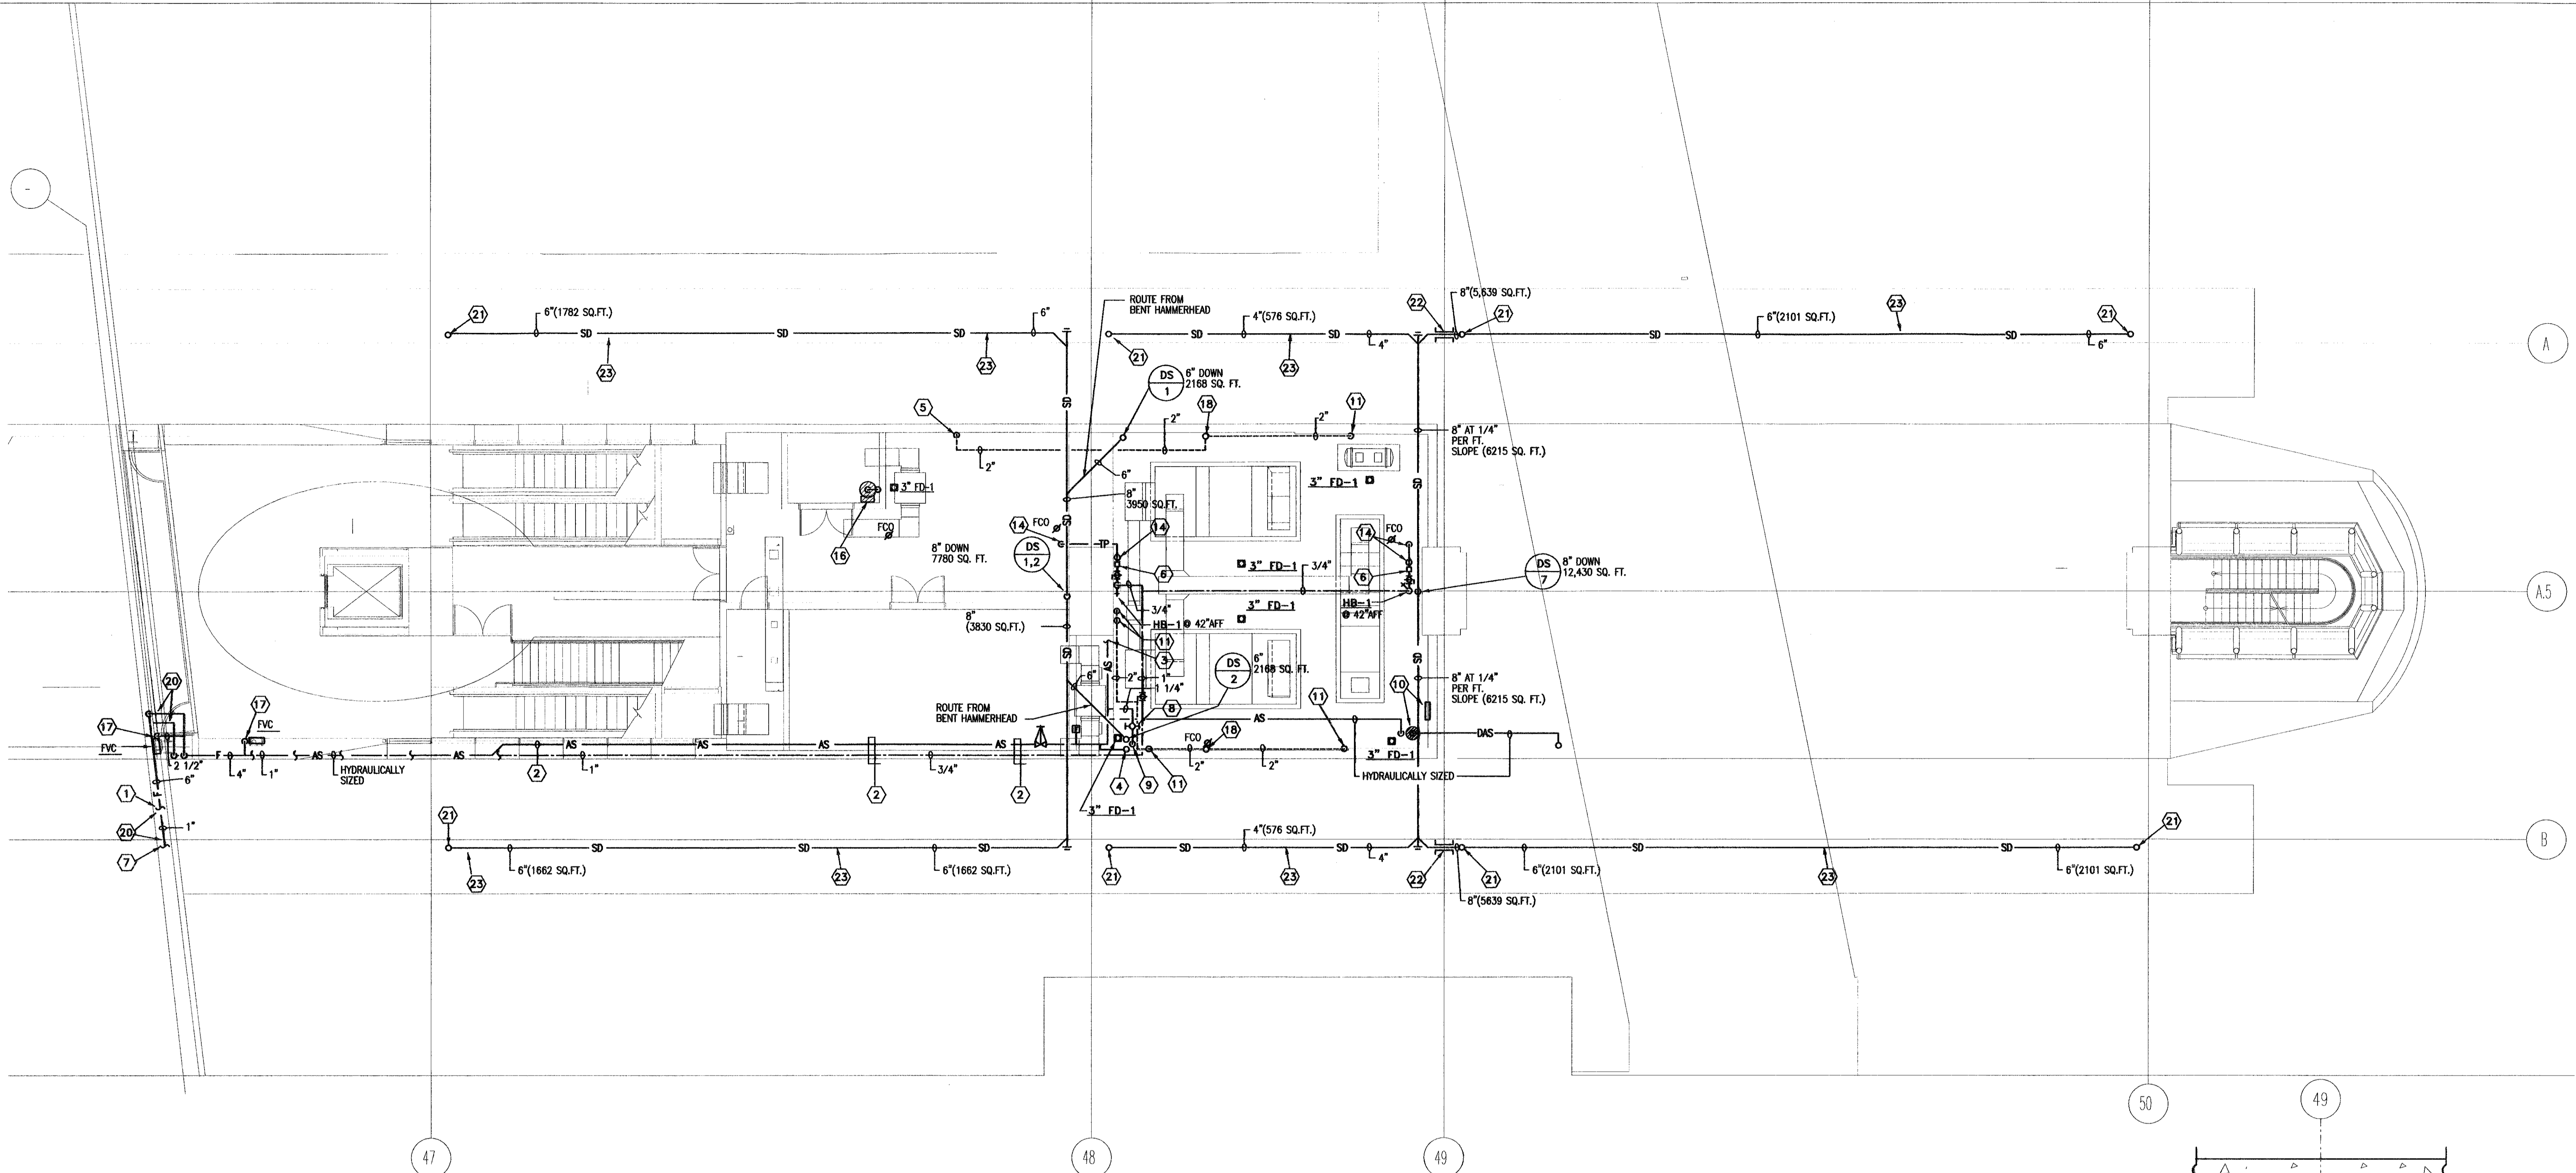

01 LOBBY LEVEL PLUMBING PLAN  
 P2.002 1/8"=1'-0"



02 SECTION  
 P2.002 NO SCALE

KEYED NOTES:

- 1 FIELD ROUTE 6" FIRE PROTECTION LINE TO ITS BUILDING AND CONNECT TO FIRE WATER SUPPLY MAIN. PROJECT NO. 500F-1
- 2 ROUTE PIPING CONCEALED IN WALL CHASE.
- 3 TO WET AUTOMATIC SPRINKLERS.
- 4 SPRINKLER SUPPLY LINE UP.
- 5 2" VENT UP
- 6 TRAP PRIMER.
- 7 FIELD ROUTE 1" DOMESTIC COLD WATER TO ITS BUILDING AND CONNECT TO DOMESTIC COLD WATER MAIN. PROJECT NO. 500F-1.
- 8 SPRINKLER SYSTEM INSPECTOR'S TEST ASSEMBLY
- 9 1 1/4" FIRE DRAIN TO SPILL OUT AT FLOOR DRAIN.
- 10 DRY PIPE SPRINKLER SYSTEM DELUGE VALVE AND AIR COMPRESSOR.
- 11 2" VENT FROM BELOW.
- 12 CAST STORM DRAINAGE PIPING (MINIMUM 1/8" PER FOOT SLOPE) IN CONCRETE BEAM/REFER TO S3.002 FOR DETAIL AND EXACT LOCATION. COORDINATE WITH STRUCTURAL AND ARCHITECTURAL.
- 13 CAST DOWNSPOUT IN CONCRETE COLUMNAL. REFER TO S7.102 FOR DETAIL AND EXACT LOCATION.
- 14 1/2" TP LINE DOWN THRU SLAB.
- 15 CAST FLOOR CLEANOUT IN SLAB AND FLOOR SUPPORT CONCRETE BEAM.
- 16 2" ELEVATOR PIT SUMP PUMP DISCHARGE FROM BELOW. 55 GALLON DRUM WITH ELEVATOR PIT SUMP PUMP ALARM PANEL. REFER TO P0.001 FOR DETAIL.
- 17 2 1/2" FIRE LINE TO FIRE VALVE CABINET. REFER TO ARCH. DWGS. FOR EXACT LOCATION OF CABINET.
- 18 3" VENT UP
- 19 REFER TO S6.702 FOR LOCATION OF STORM LINE.
- 20 ROUTE PIPING IN SOFFIT. COORDINATE WITH ARCH. DWGS.
- 21 4" STORM FROM ABOVE. CAST IN CONCRETE BENT. CONNECT STORM TO 4" ROOF DRAIN.
- 22 10" DIAMETER CORE DRILL AT BENT 49.
- 23 ALL PIPING UNDER GUIDEWAY SHALL BE RUN BETWEEN ASHTO BEAMS AND ABOVE LOWER EDGE OF THE ASHTO BEAMS.

GENERAL NOTES:

1. PROVIDE A WATER CURTAIN TYPE SPRINKLER SYSTEM TO PROTECT ESCALATORS. SPRINKLER HEADS ADDITIONAL TO THE SPRINKLER SYSTEM FOR THE FLOOR SHOULD BE PROVIDED AS OUTLINED IN NFPA 13.
2. NO PLUMBING PIPING SHALL BE ALLOWED WITHIN ELEVATOR/ESCALATOR MACHINE ROOMS, EXCEPT FOR SPRINKLER PIPING SERVING ONLY THOSE ROOMS, ELEVATOR SUMP PUMP DISCHARGE PIPING, AND 55 GALLON DRUM & PANEL.
3. COORDINATE LOCATION OF PIPE WITH CONCRETE REBAR PRIOR TO INSTALLATION AND APPROVED STRUCTURAL DWGS. (SLOPE STORM PIPING AT A MIN. 1/8" PER FT.)
4. PIPING CAST IN CONCRETE BEAMS, BENTS AND COLUMNS SHALL BE SCHEDULE 40 PVC WITH DWY PATTERN FITTINGS WITH SOLVENT CEMENT JOINTS.
5. REFER TO A3.200 FOR PROPOSED LOCATION OF SPRINKLER HEADS AND SUPPLY LINES.

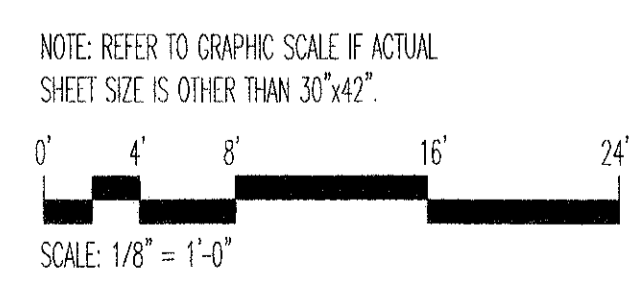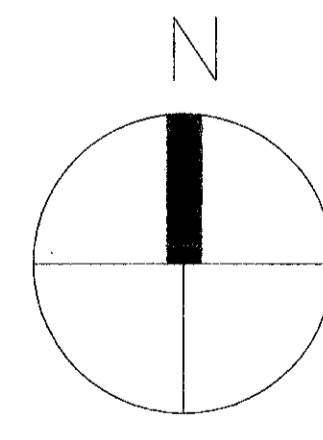


INTERNATIONAL SERVICES EXPANSION PROGRAM  
**APM STATION + PLATFORM**  
 LOBBY LEVEL PLUMBING

PROJECT MGR:	A.E.BELTRAN
DESIGNER:	C. OSB
DRAWN BY:	E. STRUBING
CHECKED BY:	C. OSB
DRAWING STANDARD:	ISEP 07.20.2000
SCALE:	AS NOTED
DATE:	09/14/01

**RECORD DRAWING**  
 THIS DRAWING HAS BEEN REVISED TO SHOW SIGNIFICANT CHANGES IN THE WORK. MAKE DURING CONSTRUCTION BASED ON MARKED-UP PRINTS, DRAWINGS AND OTHER DATA.

APPROVED BY:	DATE:
PROJECT NO.:	1061-001
C.I.P. NO.:	A-635A
H.A.S. NO.:	5382
SHEET NO.:	P2.002



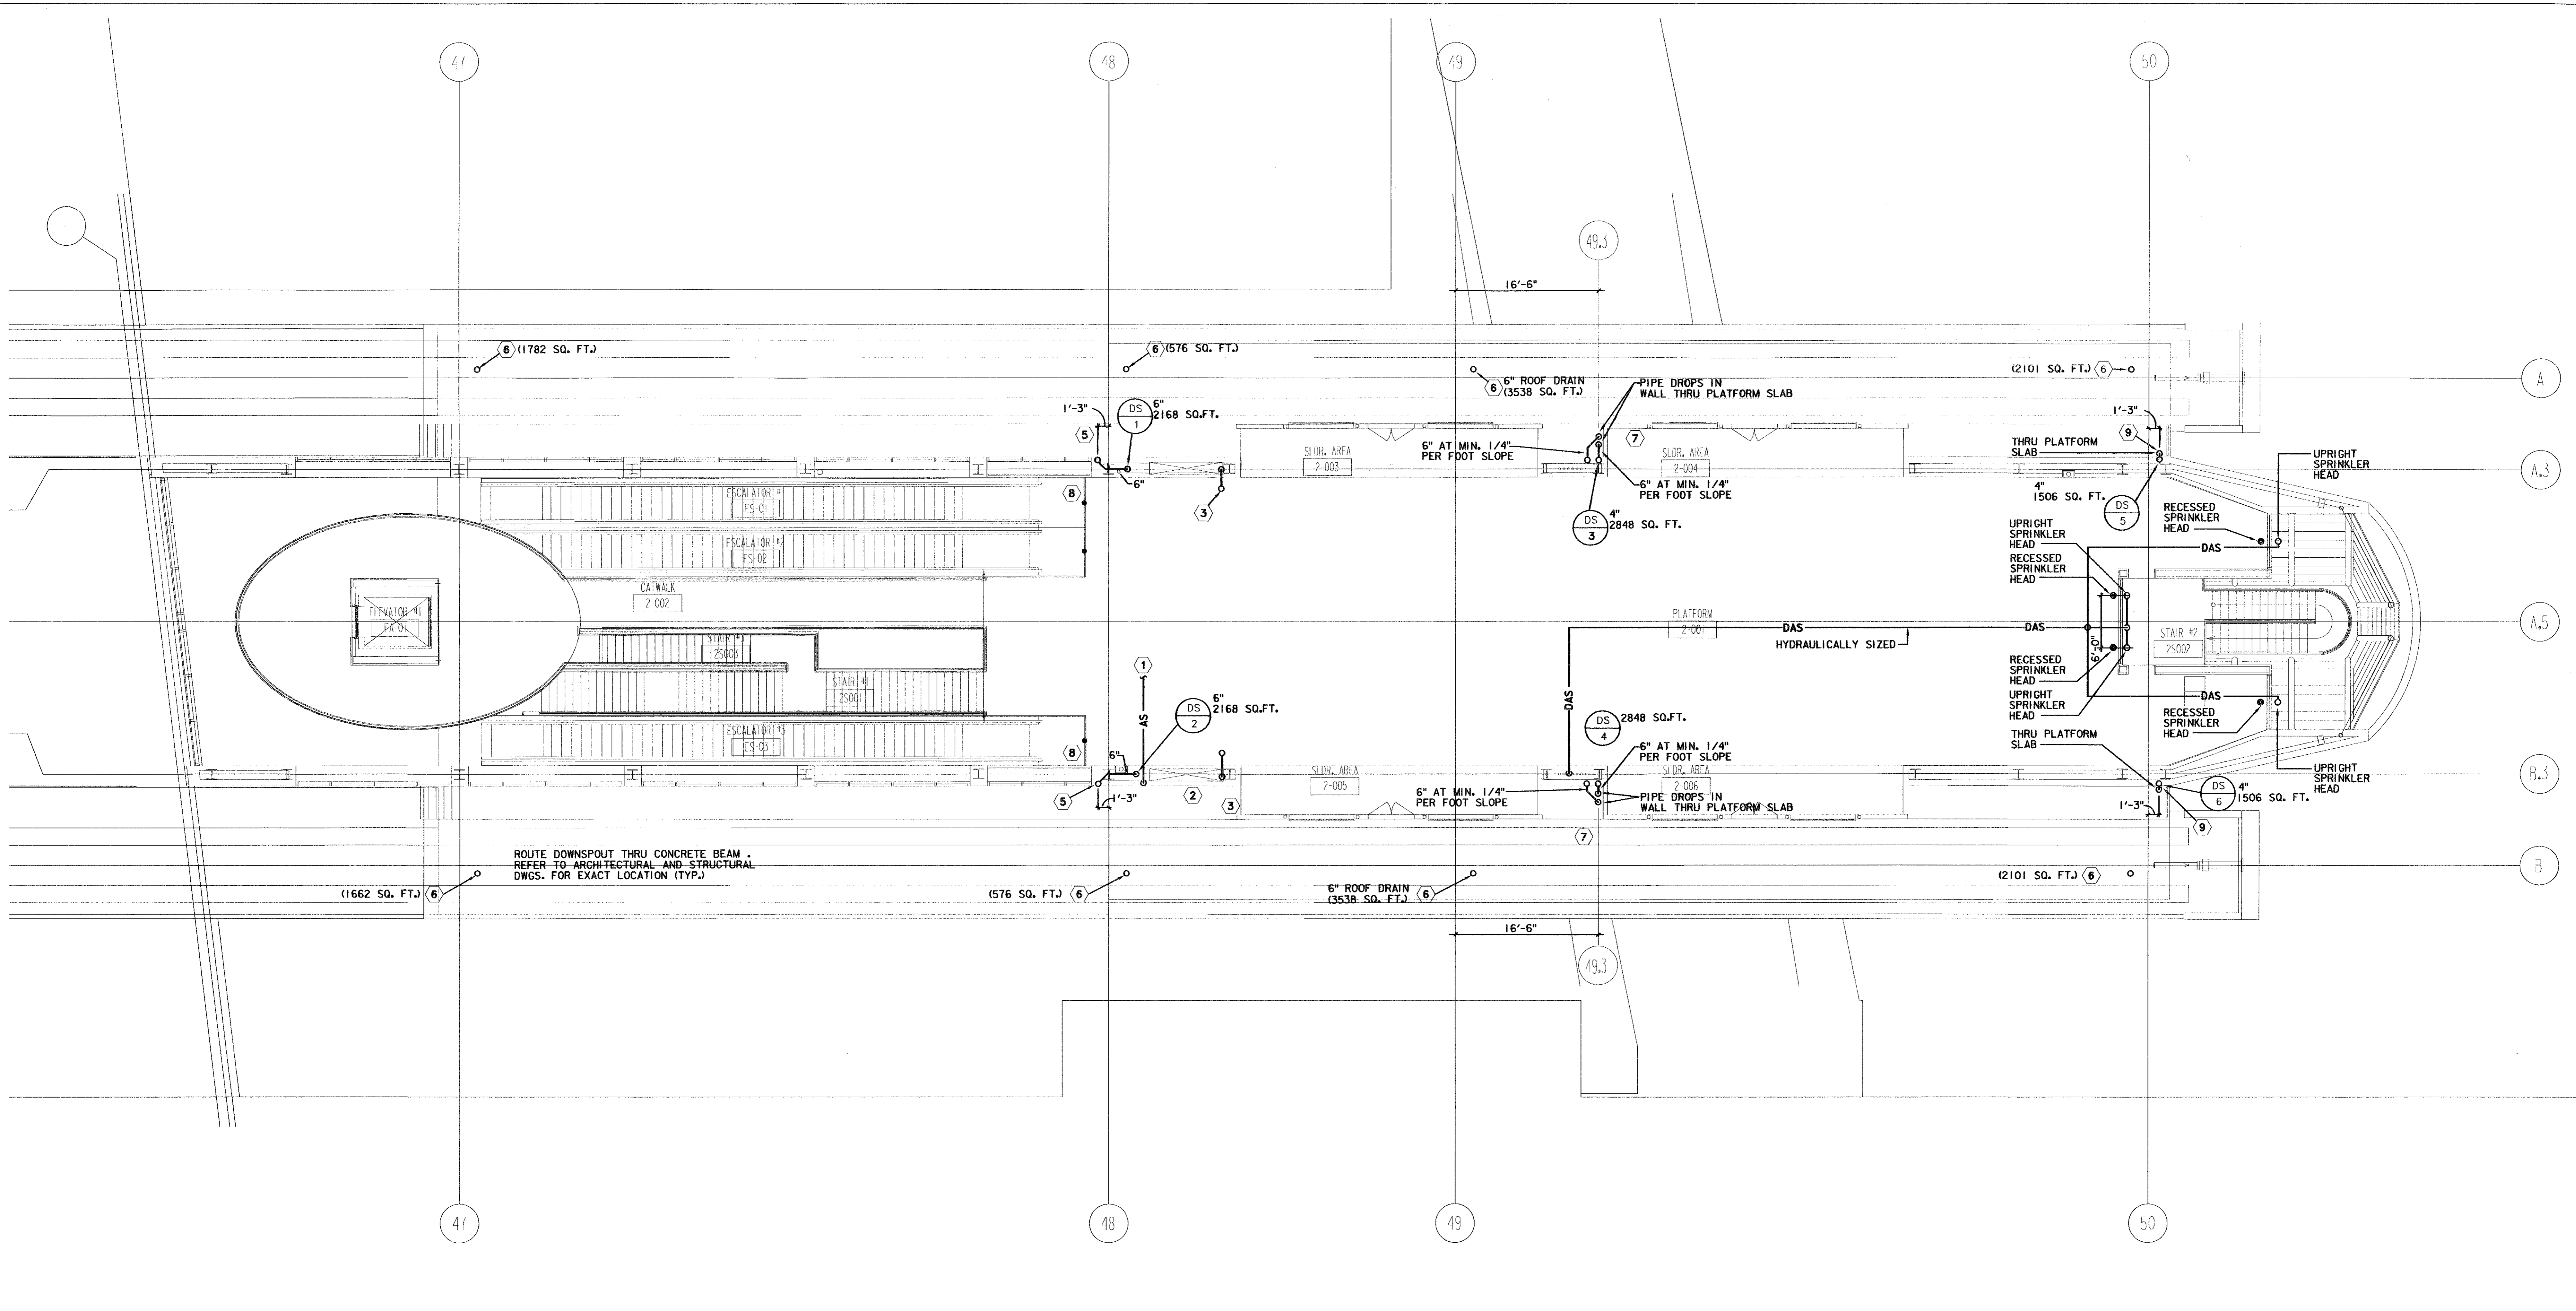



01 PLATFORM LEVEL PLUMBING PLAN  
 P2.003 1/8"=1'-0"

KEYED NOTES:

- 1 TO WET AUTO SPRINKLERS.
- 2 HYDRAULICALLY SIZE SPRINKLER SUPPLY LINE FROM BELOW.
- 3 3" VENT FROM BELOW AND UP.
- 4 CONNECT 4" OVERFLOW DRAIN TO GUTTER OVERFLOW DRAIN OUTLET. MAKE CONNECTION W/HEAVY DUTY NO-HUB COUPLING TO GUTTER. ROUTE 4" OVERFLOW AT 1/2" PER FOOT SLOPE. CONNECT TO DOWNSPOUT.
- 5 CONNECT 4" STORM TO GUTTER DRAIN OUTLET W/HEAVY-DUTY NO-HUB COUPLING.
- 6 REFER TO 6/S6.502 & 11/S6.502 FOR DETAIL. ROOF DRAIN PROVIDED BY STRUCTURAL TRADE.
- 7 CORE DRILL THROUGH SIDEWALK & ROUTE OVERFLOW DRAIN & STORM THRU CORED HOLE. DISCHARGE OVERFLOW DRAIN & STORM DRAIN LINES ONTO GUIDEWAY. REFER TO ARCH. DWGS. FOR DETAIL.
- 8 ROUTE 6" STORM THRU HOLE CUT IN COLUMN WEB. REFER TO STRUCT. FOR SIZE, LOCATION AND REQUIRED REINFORCING
- 9 CORE DRILL THROUGH SIDEWALK & ROUTE STORM THRU CORED HOLE- DISCHARGE ONTO GUIDEWAY. REFER TO ARCH. DWGS. FOR DETAIL.

GENERAL NOTES:


1. PROVIDE A WATER CURTAIN TYPE SPRINKLER SYSTEM TO PROTECT ESCALATORS AND GLASS STAIRWELL SPRINKLER HEADS ADDITIONAL TO THE SPRINKLER SYSTEM FOR THE FLOOR SHOULD BE PROVIDED AS OUTLINED IN NFPA 13. AT STAIRWELL, INSTALL SPRINKLER HEADS ON EACH SIDE OF GLAZING AT 6'-0" O.C. AND 1'-0" FROM GLAZING. SPRINKLER HEADS OUTSIDE WILL BE ON DRY PIPE SYSTEM.
2. COORDINATE LOCATION OF PIPE WITH CONCRETE REBAR PRIOR TO INSTALLATION AND APPROVED STRUCTURAL DWGS.
3. PIPING CAST IN CONCRETE BEAMS, BENTS AND COLUMNS SHALL BE SCHEDULE 40 PVC WITH DWV PATTERN FITTINGS WITH SOLVENT CEMENT JOINTS.
4. REFER TO A3.200 FOR PROPOSED LOCATION OF SPRINKLER HEADS AND SUPPLY LINES.

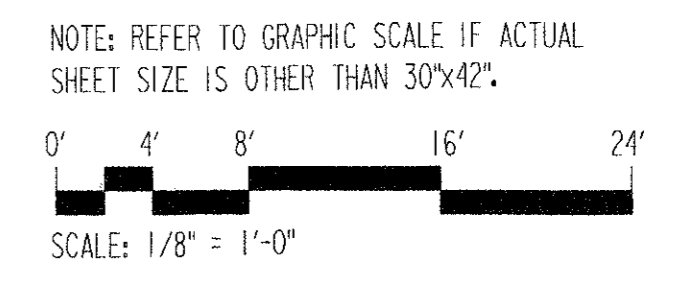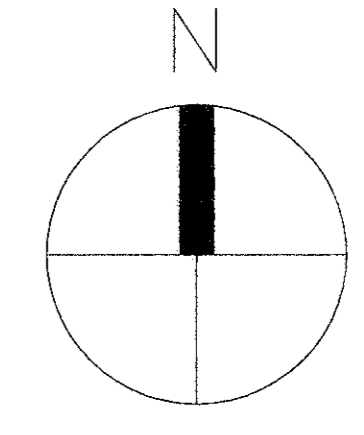

S:\1061\001\Record Drawings\A33602\2003.dwg, Ltpat1 - 5/6/2005 2:26:08 PM, dlmec, Dwg 9602 PostScript.plt,3



NO.	DESCRIPTION	DATE	BY
1	ISSUED FOR BID	10/19/01	
2	RECORD DRAWING	05/06/05	
3	BULLETIN #33	06/22/03	


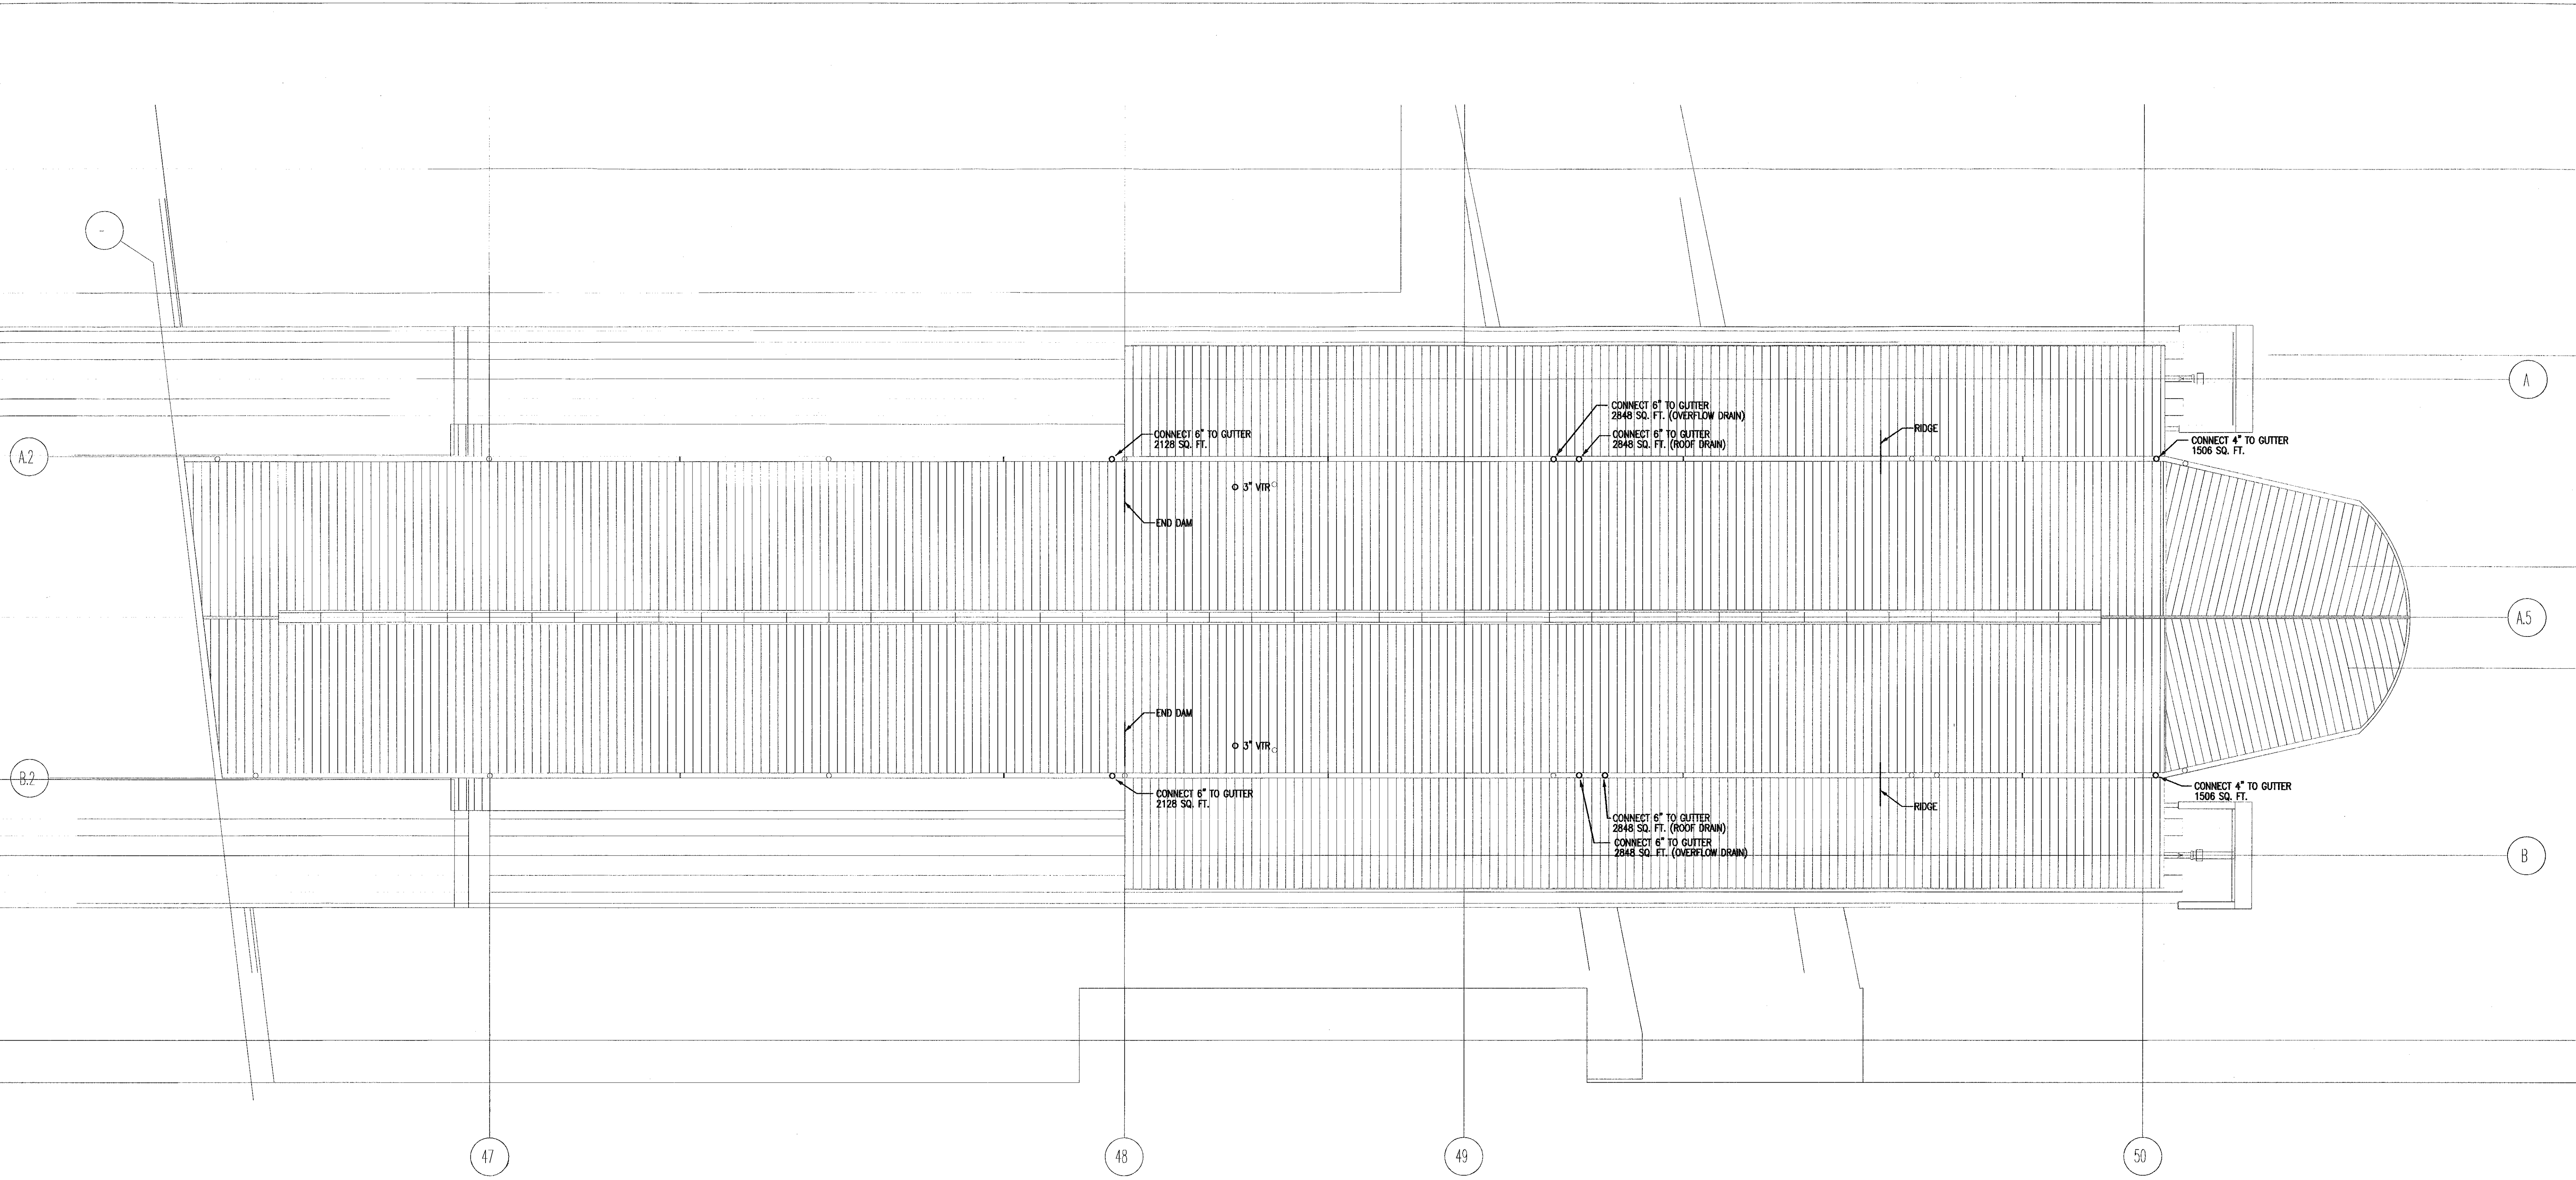


**01 ROOF PLAN**  
 P2.004 1/8"=1'-0"

**KEYED NOTES:**

**GENERAL NOTES:**

- COORDINATE EXACT LOCATION OF STORM DRAINAGE PIPING CONNECTION TO GUTTERS WITH ARCH. DWGS.

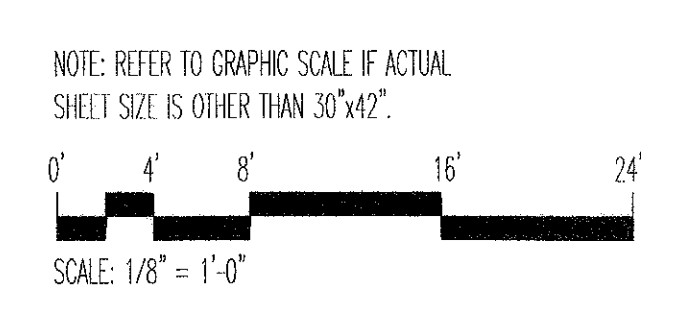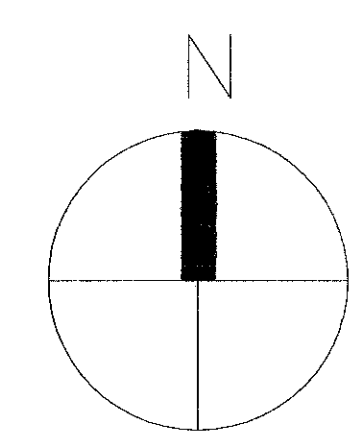

INTERNATIONAL SERVICES EXPANSION PROGRAM  
**APM STATION + PLATFORM**  
 ROOF PLAN

PROJECT MGR: A. R. LUTWYN  
 DESIGNER: C. COBB  
 DRAWN BY: E. STRICKLING  
 CHECKED BY: C. COBB  
 DRAWING STANDARD: SEP 07.20.2000  
 SCALE: AS NOTED  
 DATE: 06/14/01

**RECORD DRAWING**  
 THIS DRAWING HAS BEEN REVISIONED TO SHOW SIGNIFICANT CHANGES IN THE WORK MADE DURING CONSTRUCTION BASED ON MARKED-UP PRINTS, DRAWINGS AND OTHER DATA.







APPROVED BY: \_\_\_\_\_ DATE: \_\_\_\_\_  
 DIRECTOR  
 HOUSTON AIRPORT SYSTEM  
 PROJECT NO. 1081-001  
 C.I.P. NO. A-0354  
 H.A.S. NO. 539C  
 SHEET NO. 118 P2.004

S:\1081\001\Record Drawings\A-0354\02004.dwg, \_copy.plt, 5/6/2005, 2:26:17 PM, d:\namec, 0m 9630 PostScript.ac



REVISIONS			
NO.	DESCRIPTION	DATE	BY
1	ISSUED FOR BID	10/19/01	
2	RECORD DWGS	04/22/05	JM

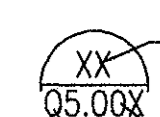**CONVENTIONS**

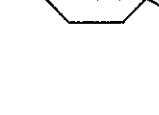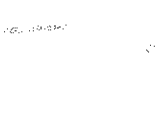-  DETAIL NO.
-  SHEET NO.
-  EQUIPMENT NUMBER
-  SHEET NUMBER
-  SCP NUMBER
-  SECURITY CONTROL PANEL











**GENERAL NOTES**

1. ALL SECURITY SYSTEM EQUIPMENT, FURNISHINGS, CONDUIT, CABLING AND OTHER RELATED MATERIALS AND INTERFACES SHALL BE INSTALLED IN ACCORDANCE WITH PROJECT CONSTRUCTION SCHEDULES.
2. SECURITY SYSTEM EQUIPMENT, FURNISHINGS, CONDUIT, CABLING AND OTHER RELATED MATERIALS SHALL BE INSTALLED AS SHOWN.
3. EQUIPMENT MOUNTING PLYWOOD SHALL BE 3/4" FIRE RATED AND PAINTED WHITE.  
ALL CONDUIT (NEW) SHALL NOT BE LESS THAN 1" DIAMETER AND NO MORE THAN 40% FILLED.
4. ALL SECURITY JUNCTION BOXES ARE TO BE TAMPER PROTECTED AND CONNECTED TO INDIVIDUAL MONITOR POINTS.
5. SECURITY CONTROL PANELS SHALL BE INSTALLED AT LOCATIONS AS SHOWN.
6. CONTRACTOR SHALL ENSURE THAT ALL SECURITY INTERFACES WITH FIRE, ELECTRICAL AND DOOR HARDWARE PROJECT PACKAGES ARE PROVIDED AND THAT WORK IS COMPLETE AND CORRECTLY INSTALLED.
7. CONTRACTOR SHALL FURNISH AND INSTALL CABLING AND CONDUIT FROM SECURITY DEVICE LOCATIONS TO DESIGNATED EQUIPMENT ROOM.
8. THE BOTTOM OF ALL CARD READERS AND KEYPAD DEVICES SHALL NOT EXCEED 45 INCHES AFF.
9. ALL CCTV CAMERA LOCATIONS SHALL BE COORDINATED WITH OWNER BEFORE INSTALLATION.
10. UNLESS OTHERWISE NOTED ALL SECURITY SYSTEM RELATED CONDUIT IS TO ROOM 1-003.
11. SECURITY SYSTEM INTERFACES INCLUDE INTEGRATION WITHIN THE SYSTEM AND OTHER PROJECT PACKAGES.
12. CONTRACTOR SHALL BE RESPONSIBLE FOR FURNISHING AND INSTALLING CABLING. CONTRACTOR SHALL ALSO BE RESPONSIBLE FOR FURNISHING AND INSTALLING CONDUIT FROM ALL SECURITY EQUIPMENT DEVICE LOCATIONS TO DESIGNATED EQUIPMENT ROOM.
13. ALL DOOR LOCKING MECHANISMS AND HARDWARE, SHALL BE FURNISHED AND INSTALLED BY DOOR HARDWARE CONTRACTOR. ALL WIRING AND LOW VOLTAGE TERMINATIONS ARE TO BE DONE BY THE SECURITY CONTRACTOR.
14. POWER SUPPLIES FOR CAMERAS, SECURITY CONTROL PANEL, AUDIO / VISUAL ALARM HORNS, AND FIBER TRANSCEIVERS SHALL BE PROVIDED BY SECURITY CONTRACTOR.
15. ALL SECURITY DEVICES SHALL BE POWERED BY EMERGENCY BACK UP POWER CIRCUITS.

**ABBREVIATIONS**

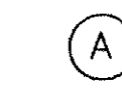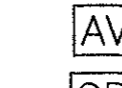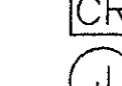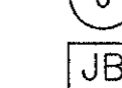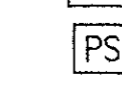- A INTRUSION DETECTION ALARM CONTACT
- AFF ABOVE FINISHED FLOOR
- AH ALARM HORN
- AV ALARM HORN/STROBE LIGHT
- BLDG BUILDING
- C CONDUIT/CENTER
- CC COMMUNICATION CONTRACTOR
- CCTV CLOSED CIRCUIT TELEVISION
- CR CARD READER
- CPU CENTRAL PROCESSING UNIT/COMPUTER
- D DURESS ALARM
- EC ELECTRICAL CONTRACTOR
- EPH ELECTRIFIED PANIC HARDWARE
- FRP FIRE RELEASE PANEL
- JB JUNCTION BOX
- MPH MECHANICAL PANIC HARDWARE
- MUX MULTIPLEXER
- OFF OFFICE
- OPNS OPERATIONS
- PIR PASSIVE INFRARED
- PTZ PAN, TILT, AND ZOOM
- REX REQUEST TO EXIT DEVICE
- SC SECURITY CONTRACTOR
- SJB SECURITY JUNCTION BOX
- SM SECURITY SYSTEM MONITOR
- SS SECURITY SYSTEM
- TBD TO BE DETERMINED
- TDR TIME DELAY RELEASE

**SYMBOL LIST**

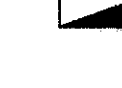-  DOOR ALARM CONTACT
-  ALARM HORN/STROBE LIGHT
-  CARDREADER
-  JUNCTION BOX 4" X 4"
-  SECURITY JUNCTION BOX WITH TAMPER SWITCH
-  POWER SUPPLY
-  REQUEST TO EXIT PASSIVE INFRARED
-  FIXED CAMERA
-  PAN, TILT, ZOOM CAMERA
-  SECURITY CONTROL PANEL

CABLE SCHEDULE		
TYPE	WIRE DESCRIPTION	USAGE (TYPICAL)
A	3 PAIR, 18 AWG STRANDED, INDIVIDUALLY SHEILDDED AND DRAINED PAIRS	READER CABLE
B	1 PAIR, 18 AWG STRANDED	REX/DOOR CONTACT/CAMERA/AV POWER
C	RG 59-U COAXIAL CABLE 20 AWG CENTER COND, 95% OVERALL BRAID	VIDEO CABLE
D	1 PAIR, 16 AWG STRANDED	NETWORK CABLE
E	1 PAIR, 18 AWG STRANDED, SHIELDED	PTZ DATA


INTERNATIONAL - SERVICES - EXPANSION - PROGRAM  
**APM STATION + PLATFORM**  
 COVER SHEET, CONVENTIONS AND NOTES

PROJECT MOR: W. GLOVER  
 DESIGNER: G. RESNICK  
 DRAWN BY: K. BUTLER  
 CHECKED BY:  
 DRAWING STANDARD: ISEP 07.20.2000  
 SCALE: N/A  
 DATE: September 19, 2001

APPROVED BY: \_\_\_\_\_ DATE: \_\_\_\_\_  
 DIRECTOR  
 HOUSTON AIRPORT SYSTEM  
 PROJECT NO. 1140  
 C.I.P. NO. A-0354  
 H.A.S. NO. 538C  
 SHEET NO.





NO.	DESCRIPTION	DATE	BY
ISSUED FOR BID		10/19/01	
RECORD DWGS		04/22/05	JM

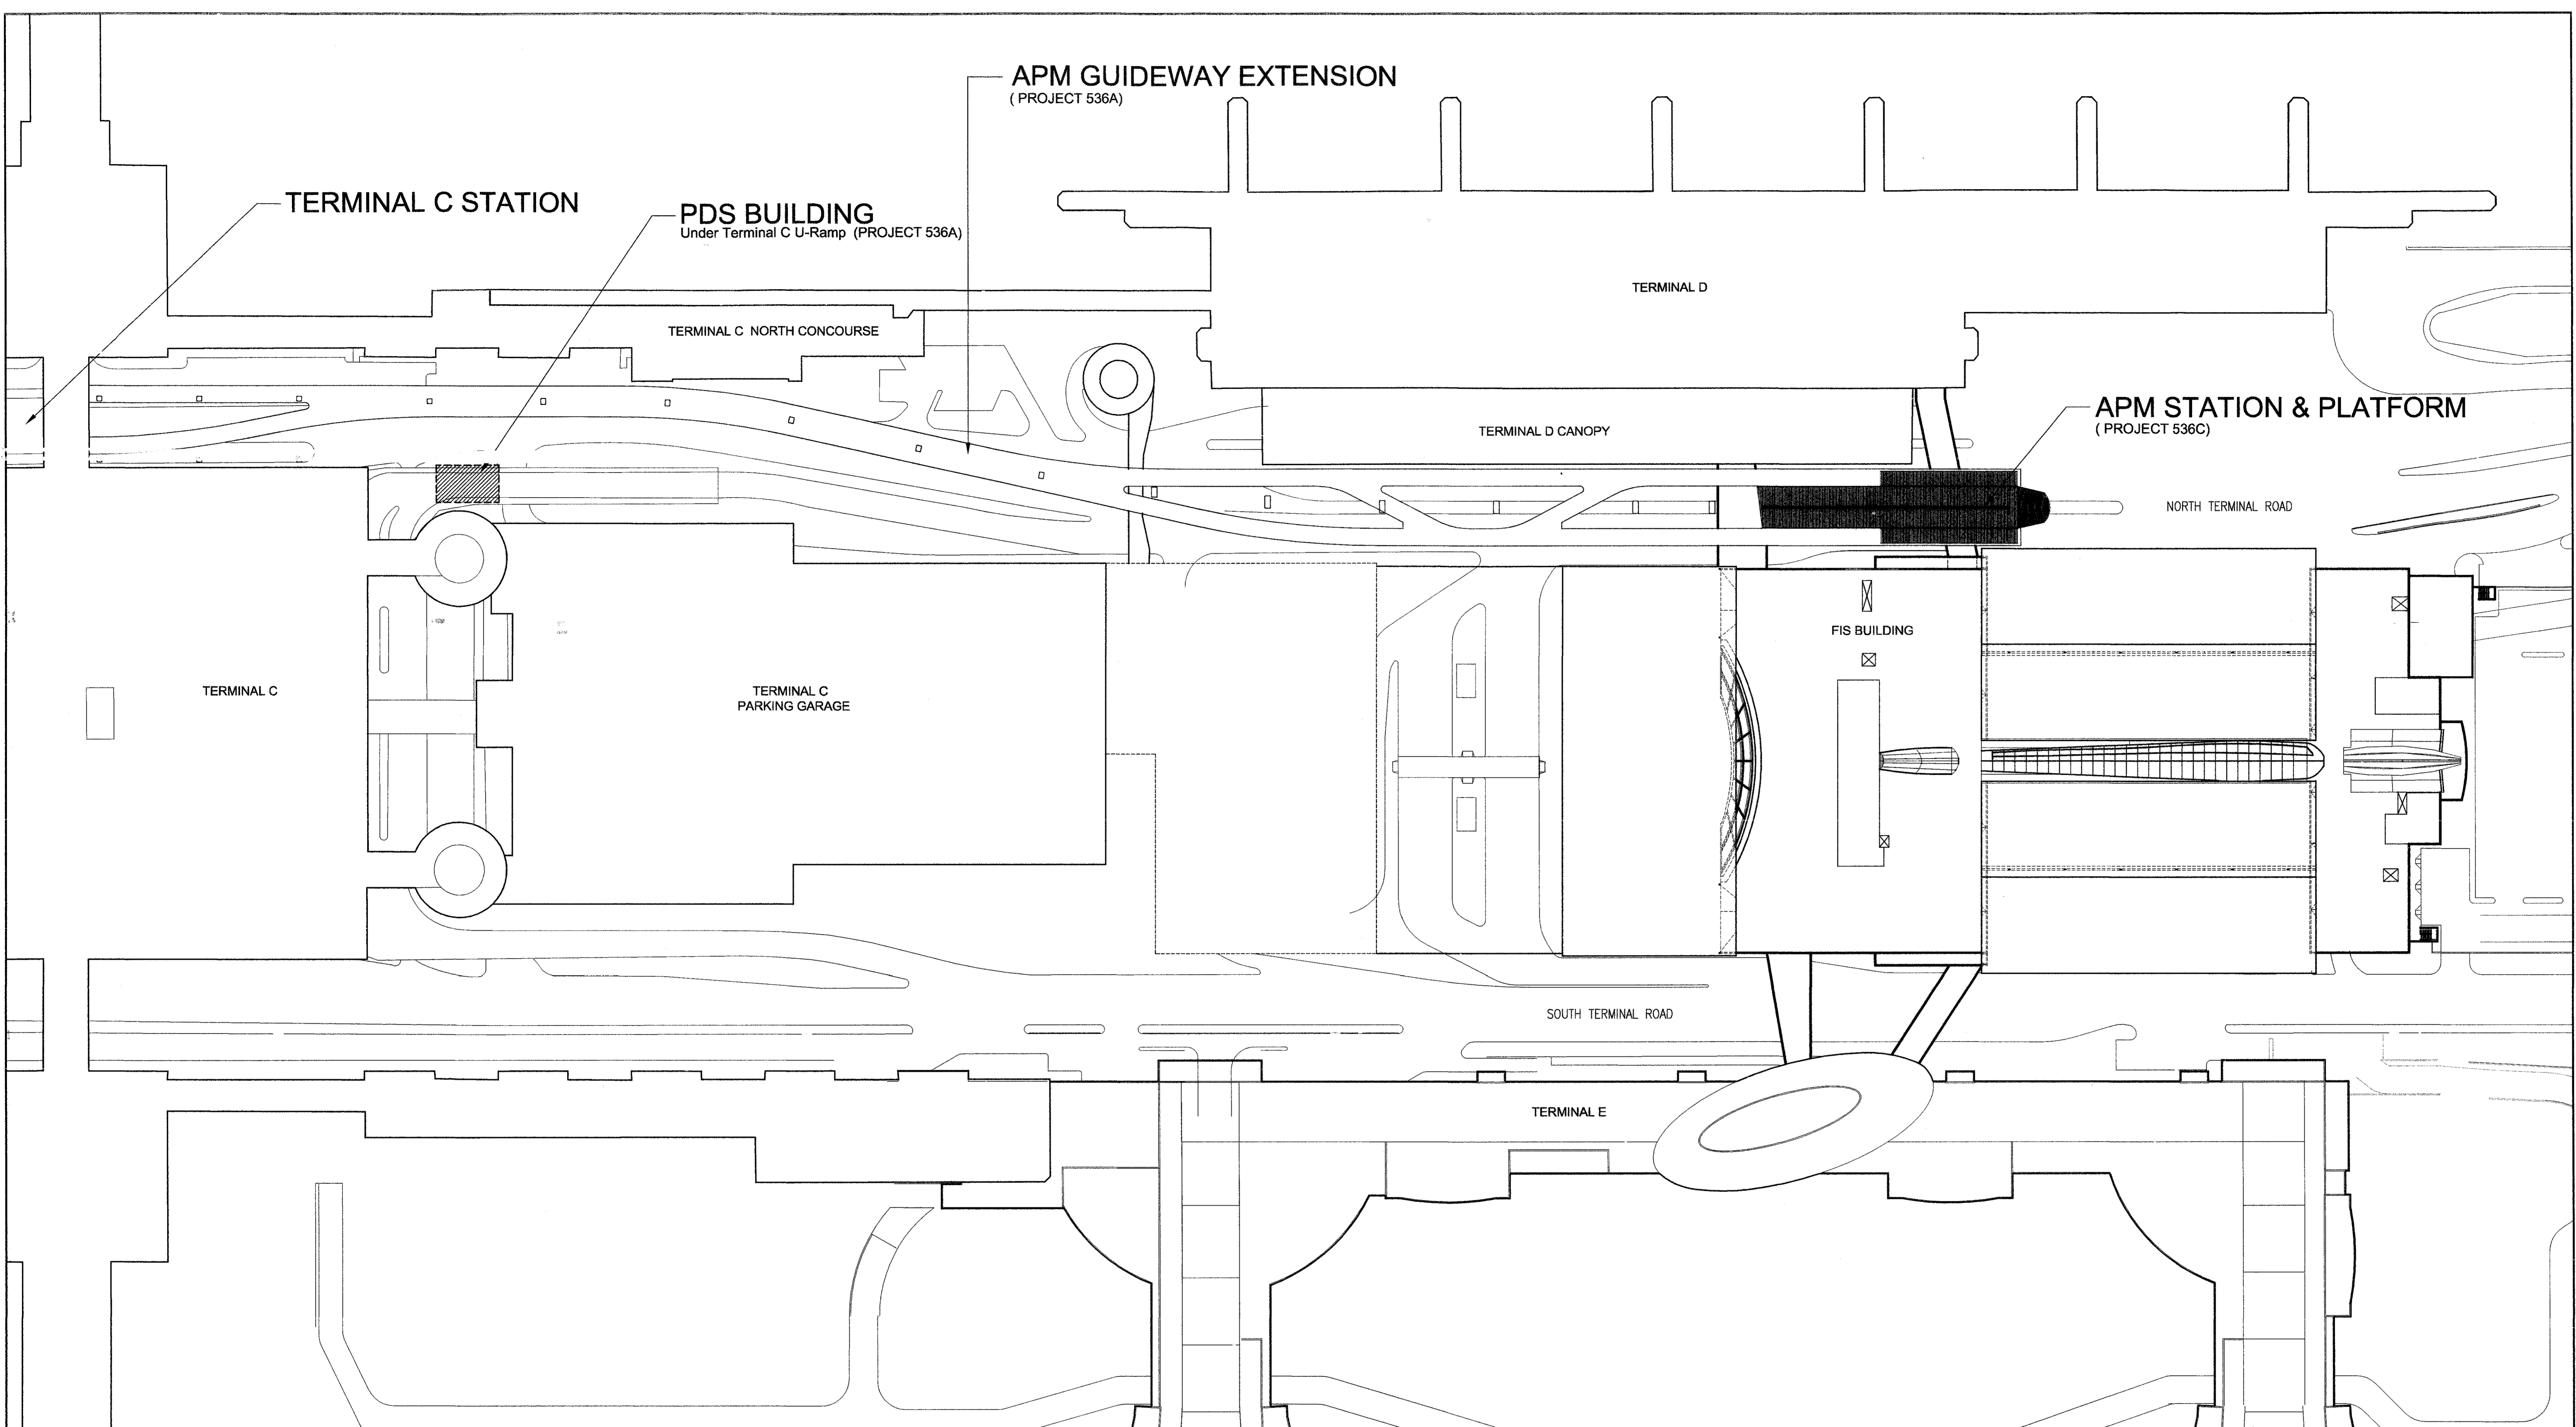

INTERNATIONAL • SERVICES • EXPANSION • PROGRAM  
**APM STATION + PLATFORM**  
 GENERAL SITE PLAN

**GENERAL NOTES:**

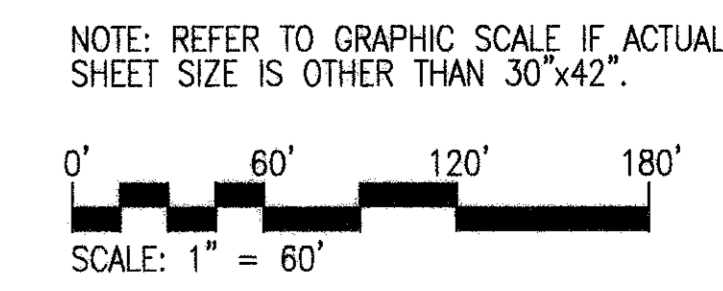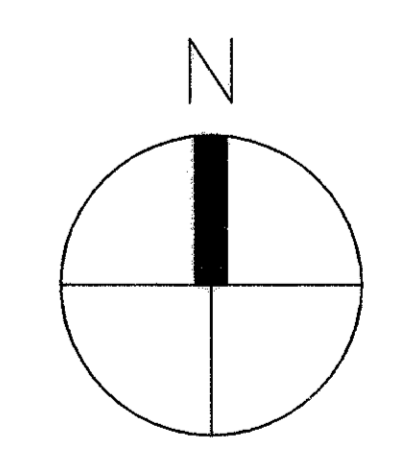


PROJECT MGR: W. GLOVER  
 DESIGNER: G. RESNICK  
 DRAWN BY: R. BUTLER  
 CHECKED BY:  
 DRAWING STANDARD: ISEP 07.20.2000  
 SCALE: 1"=60'  
 DATE: September 14, 2001


APPROVED BY: \_\_\_\_\_ DATE: \_\_\_\_\_  
 DIRECTOR  
 HOUSTON AIRPORT SYSTEM  
 PROJECT NO. 1140  
 C.I.P. NO. A-0354  
 H.A.S. NO. 536C  
 SHEET NO. 1/6

**Q1.000**




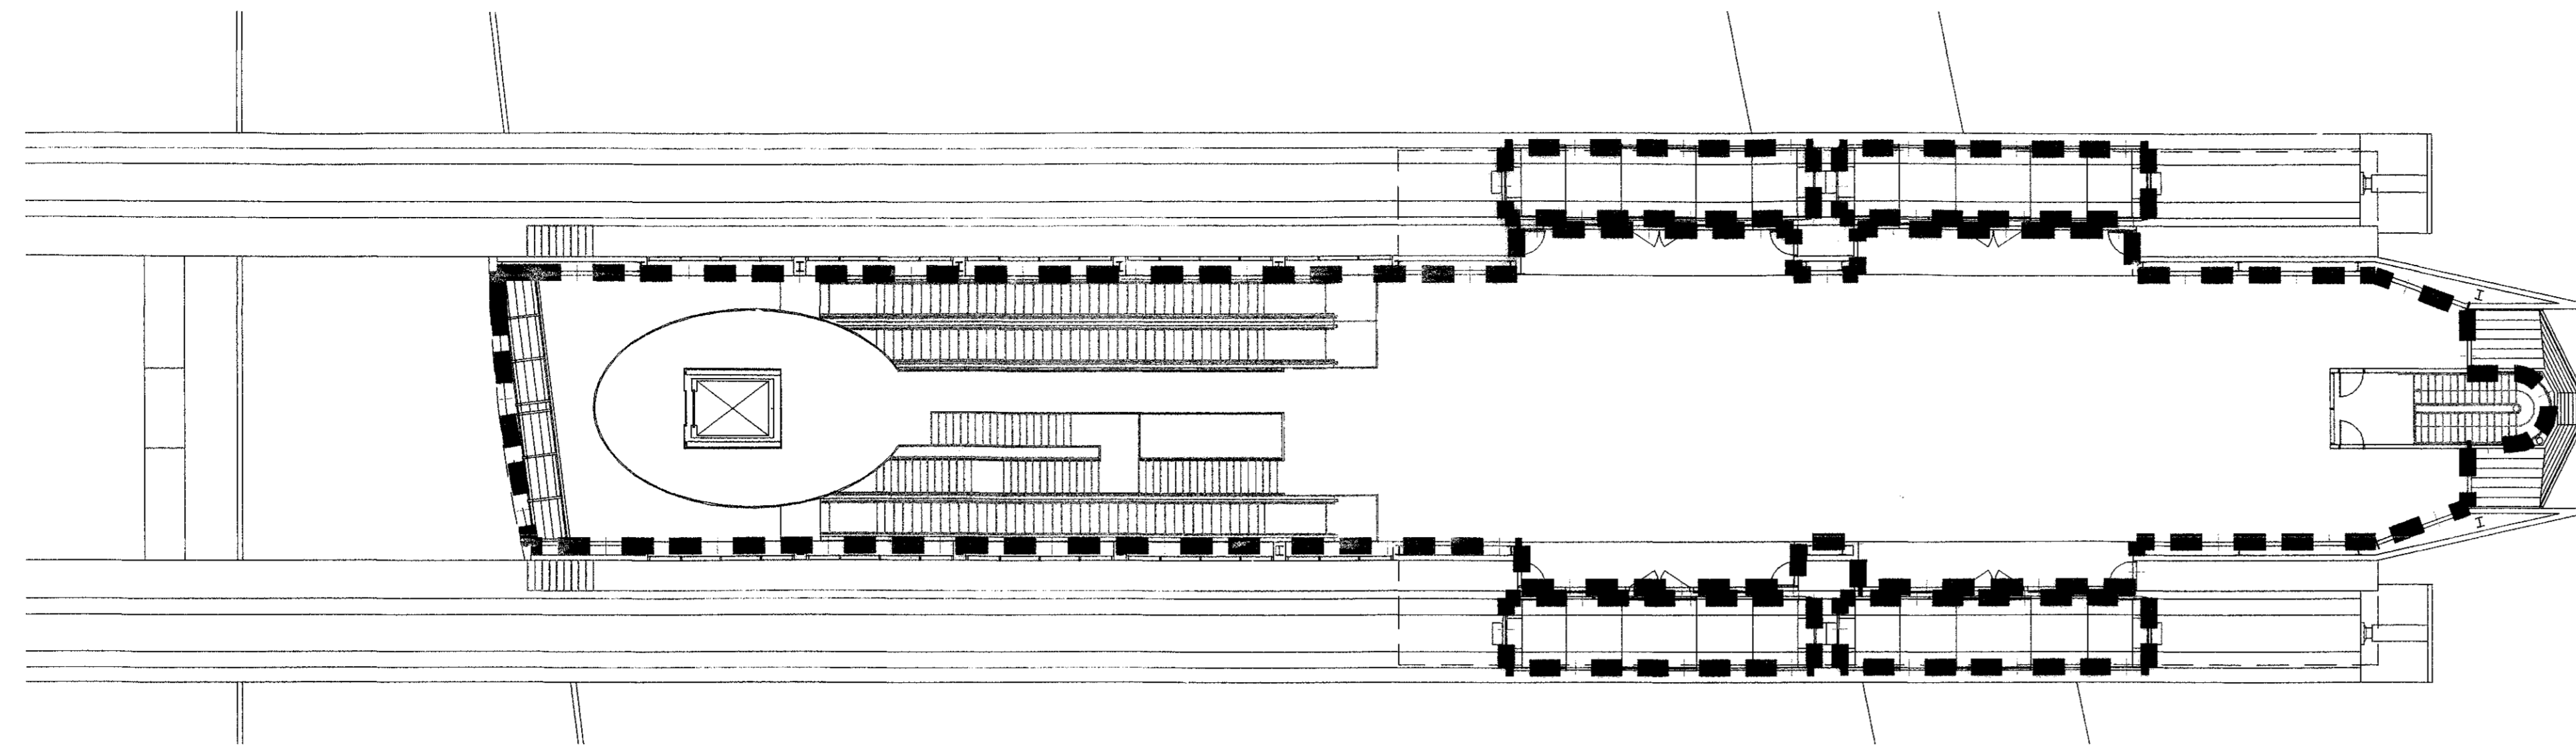

01 PLATFORM LEVEL  
Z2.000 1/16"=1'-0"

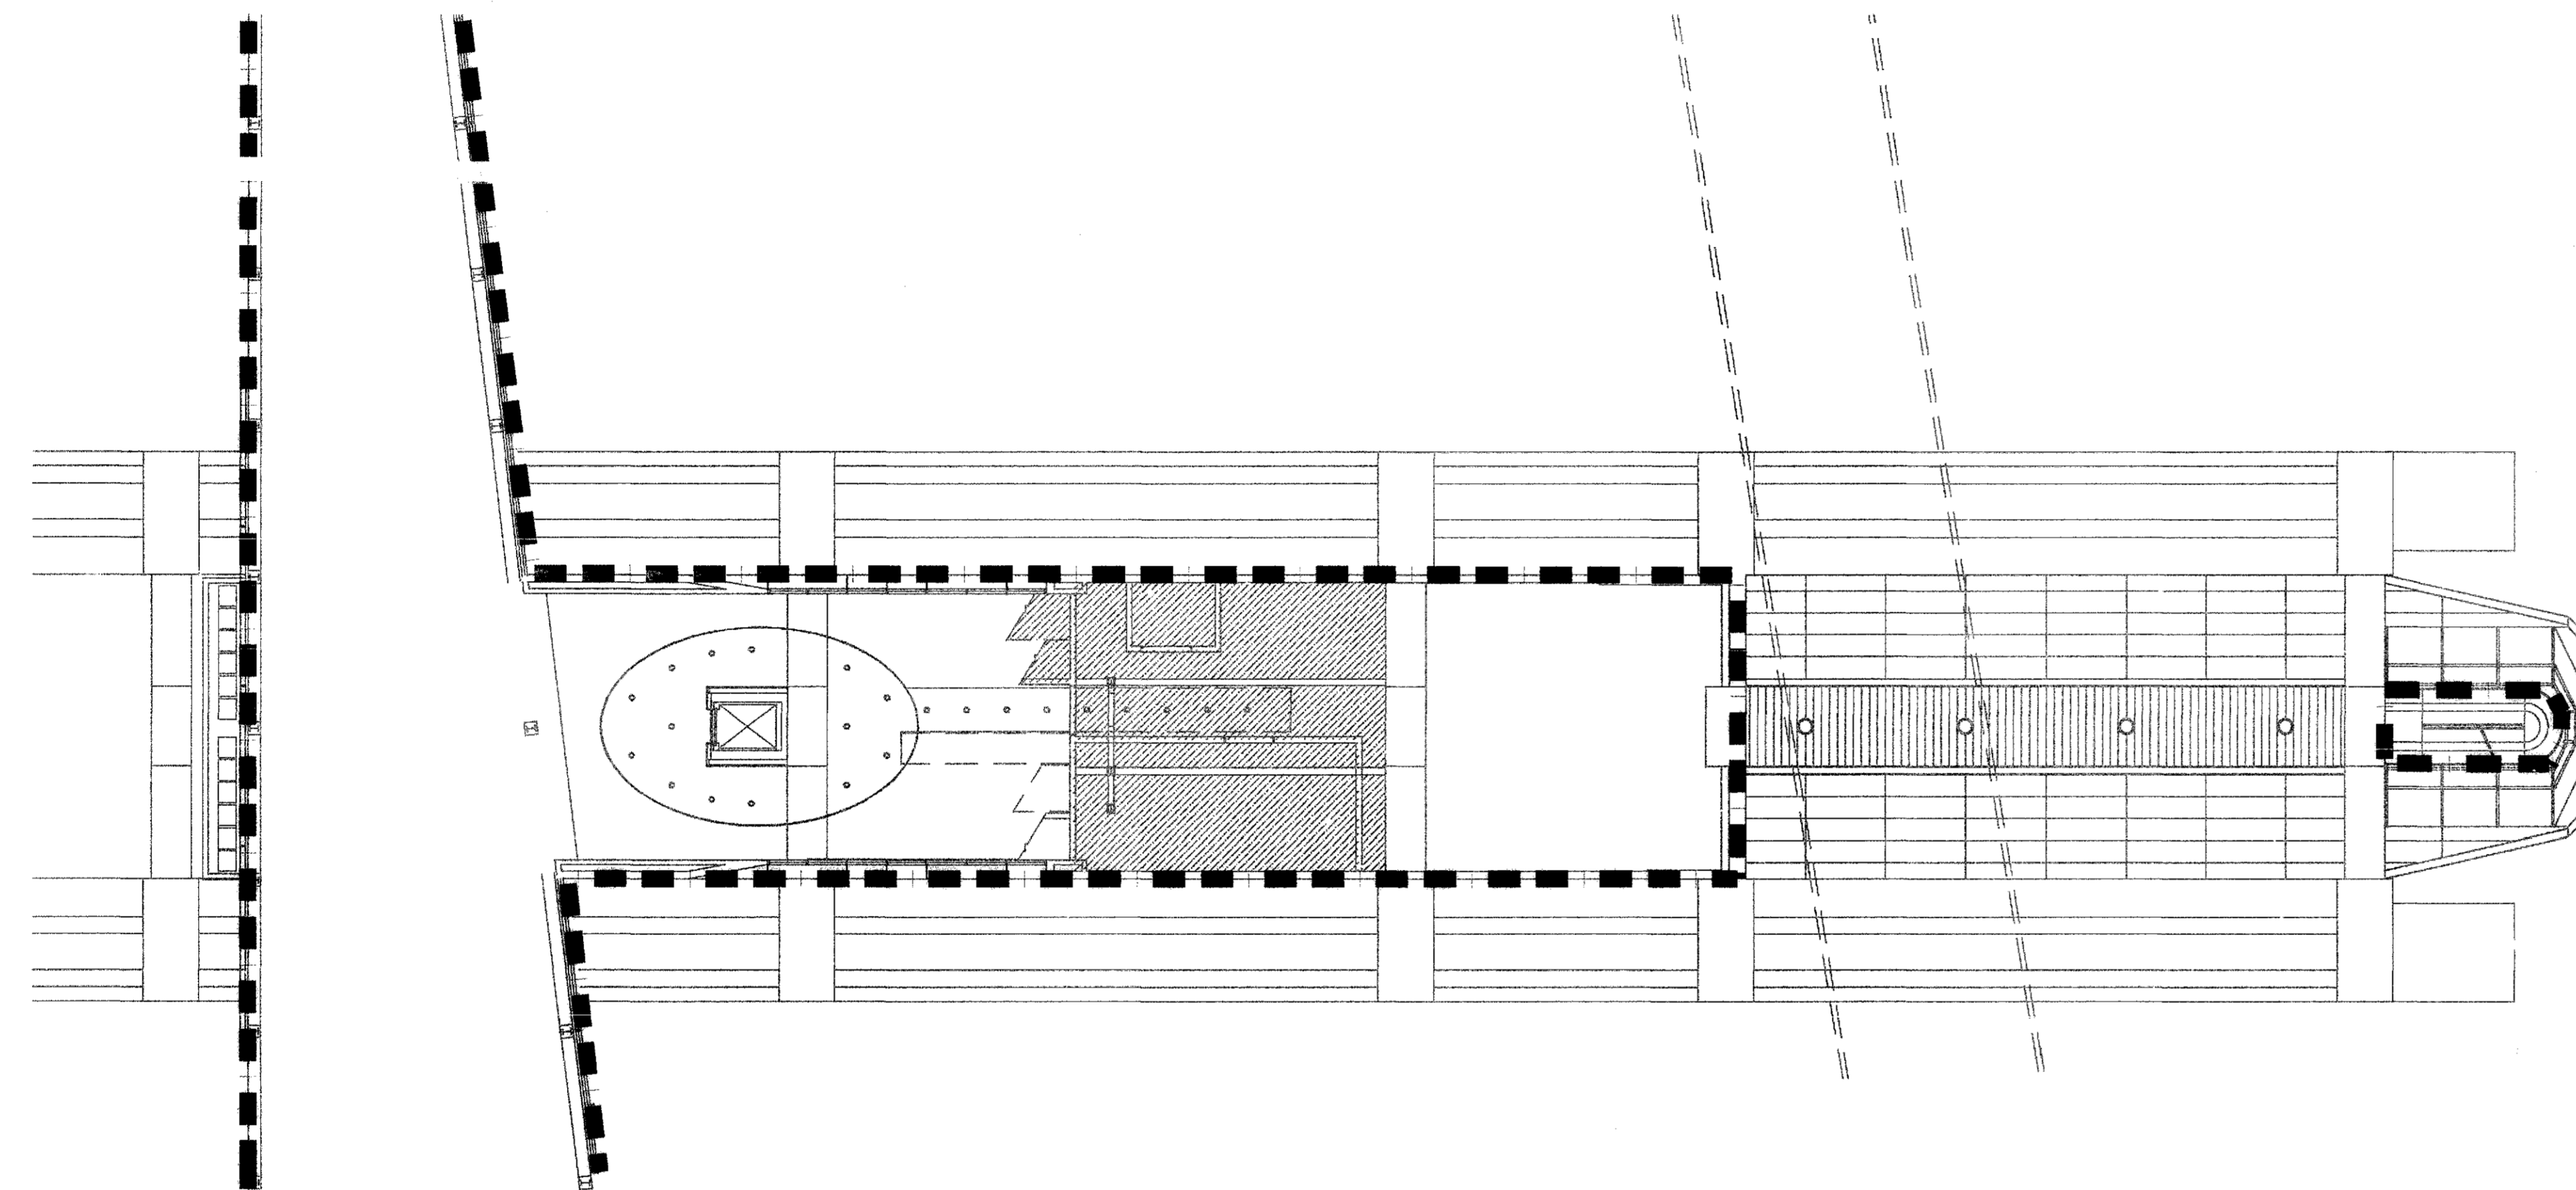

02 LOBBY LEVEL  
Z2.000 1/16"=1'-0"

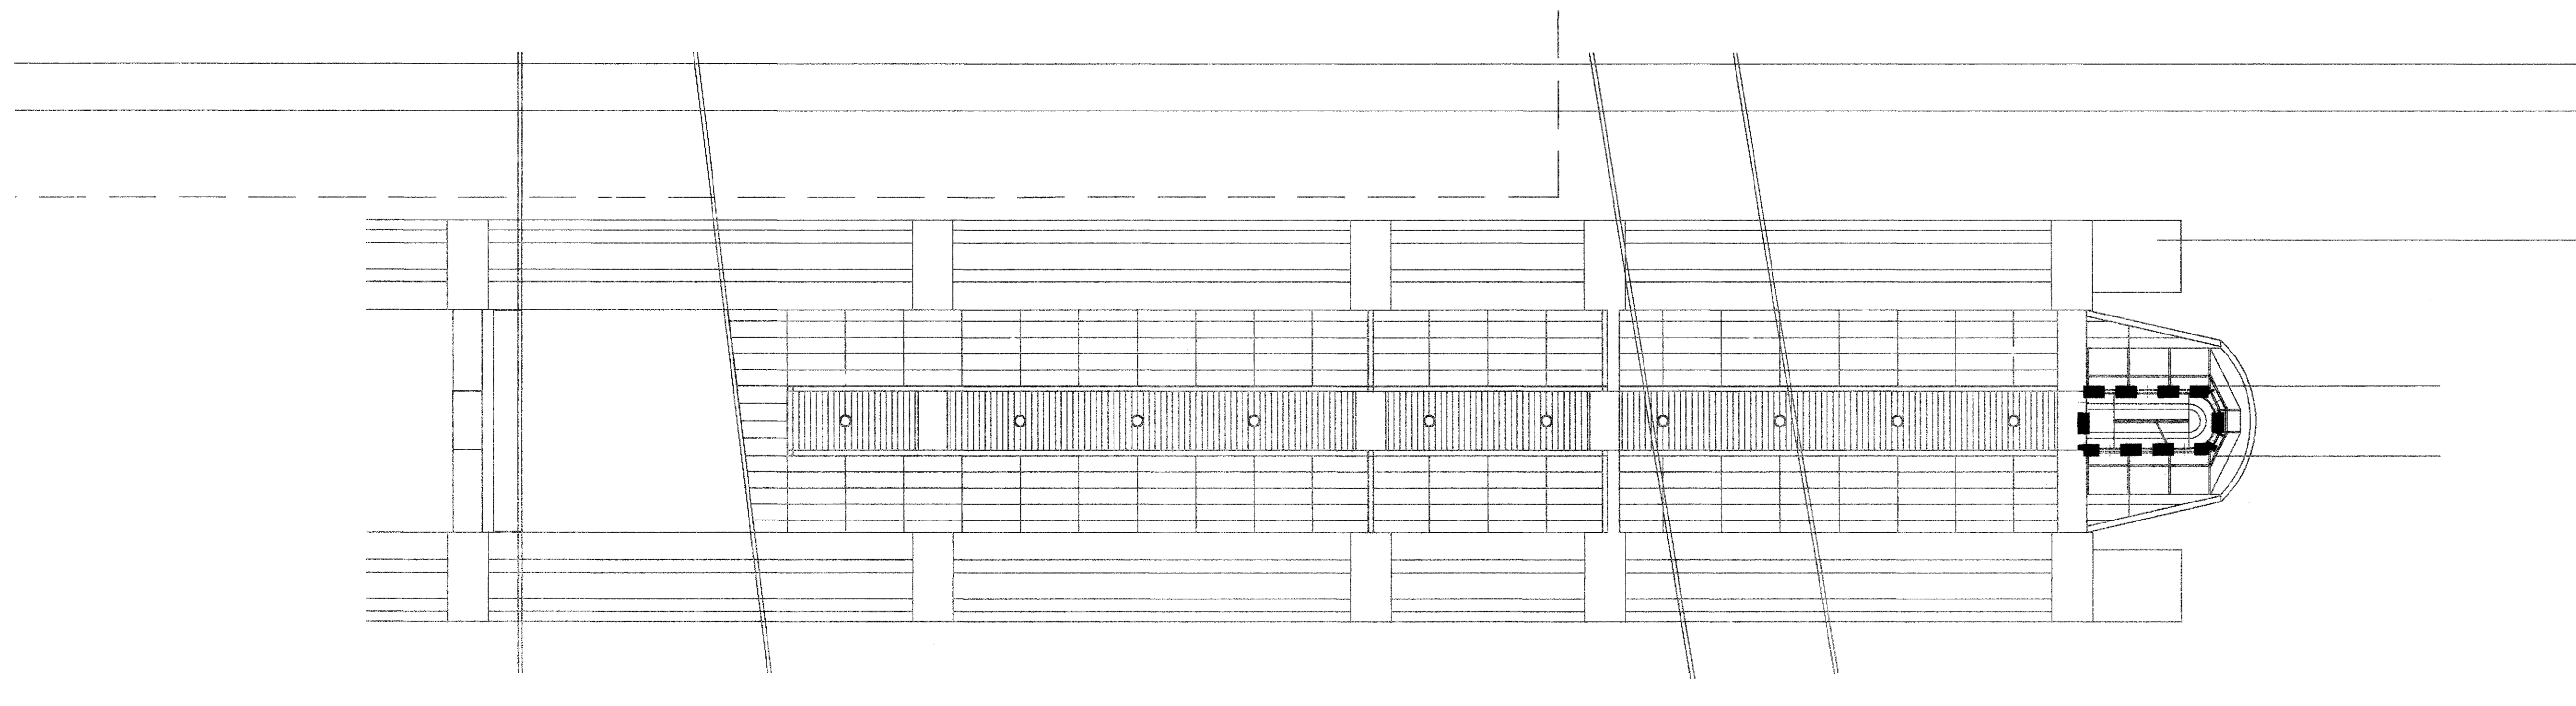

03 GROUND FLOOR  
Z2.000 1/16"=1'-0"

GENERAL NOTES:

----- SECURED AREA


HOUSTON AIRPORT SYSTEM  
GEORGE BUS  
INTERCONTINENTAL AIRPORT  
HOUSTON TEXA

**GRA**  
Glover/Resnick and  
Associates, Inc.  
215 Estates Drive,  
Suite 3  
Roseville, CA 95678  
(916) 786-3552  
Fax (916) 786-3821

REVISIONS			
NO.	DESCRIPTION	DATE	BY
ISSUED FOR BID		10/19/01	
RECORD DWGS		04/22/05	JM

INTERNATIONAL • SERVICES • EXPANSION • PROGRAM  
**APM STATION + PLATFORM**  
DEMARICATION PLAN

PROJECT MGR: W. GLOVER  
DESIGNER: G. RESNICK  
DRAWN BY: R. BUTLER  
CHECKED BY:  
DRAWING STANDARD: ISEP 07.20.2000  
SCALE: 1/16"=1'-0"  
DATE: September 14, 2001

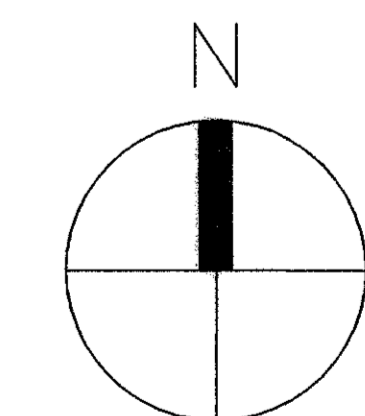


NOTE: REFER TO GRAPHIC SCALE IF ACTUAL SHEET SIZE IS OTHER THAN 30"x42".  
0' 8' 16' 32' 48'  
SCALE: 1/16" = 1'-0"

APPROVED BY: \_\_\_\_\_ DATE: \_\_\_\_\_  
DIRECTOR  
HOUSTON AIRPORT SYSTEM  
PROJECT NO. 1140  
C.I.P. NO. A-0354  
H.A.S. NO. 538C  
SHEET NO. 117

Q1.100



NO.	DESCRIPTION	DATE	BY
1	ISSUED FOR BID	10/19/01	
2	RECORD DWGS	04/22/05	JM

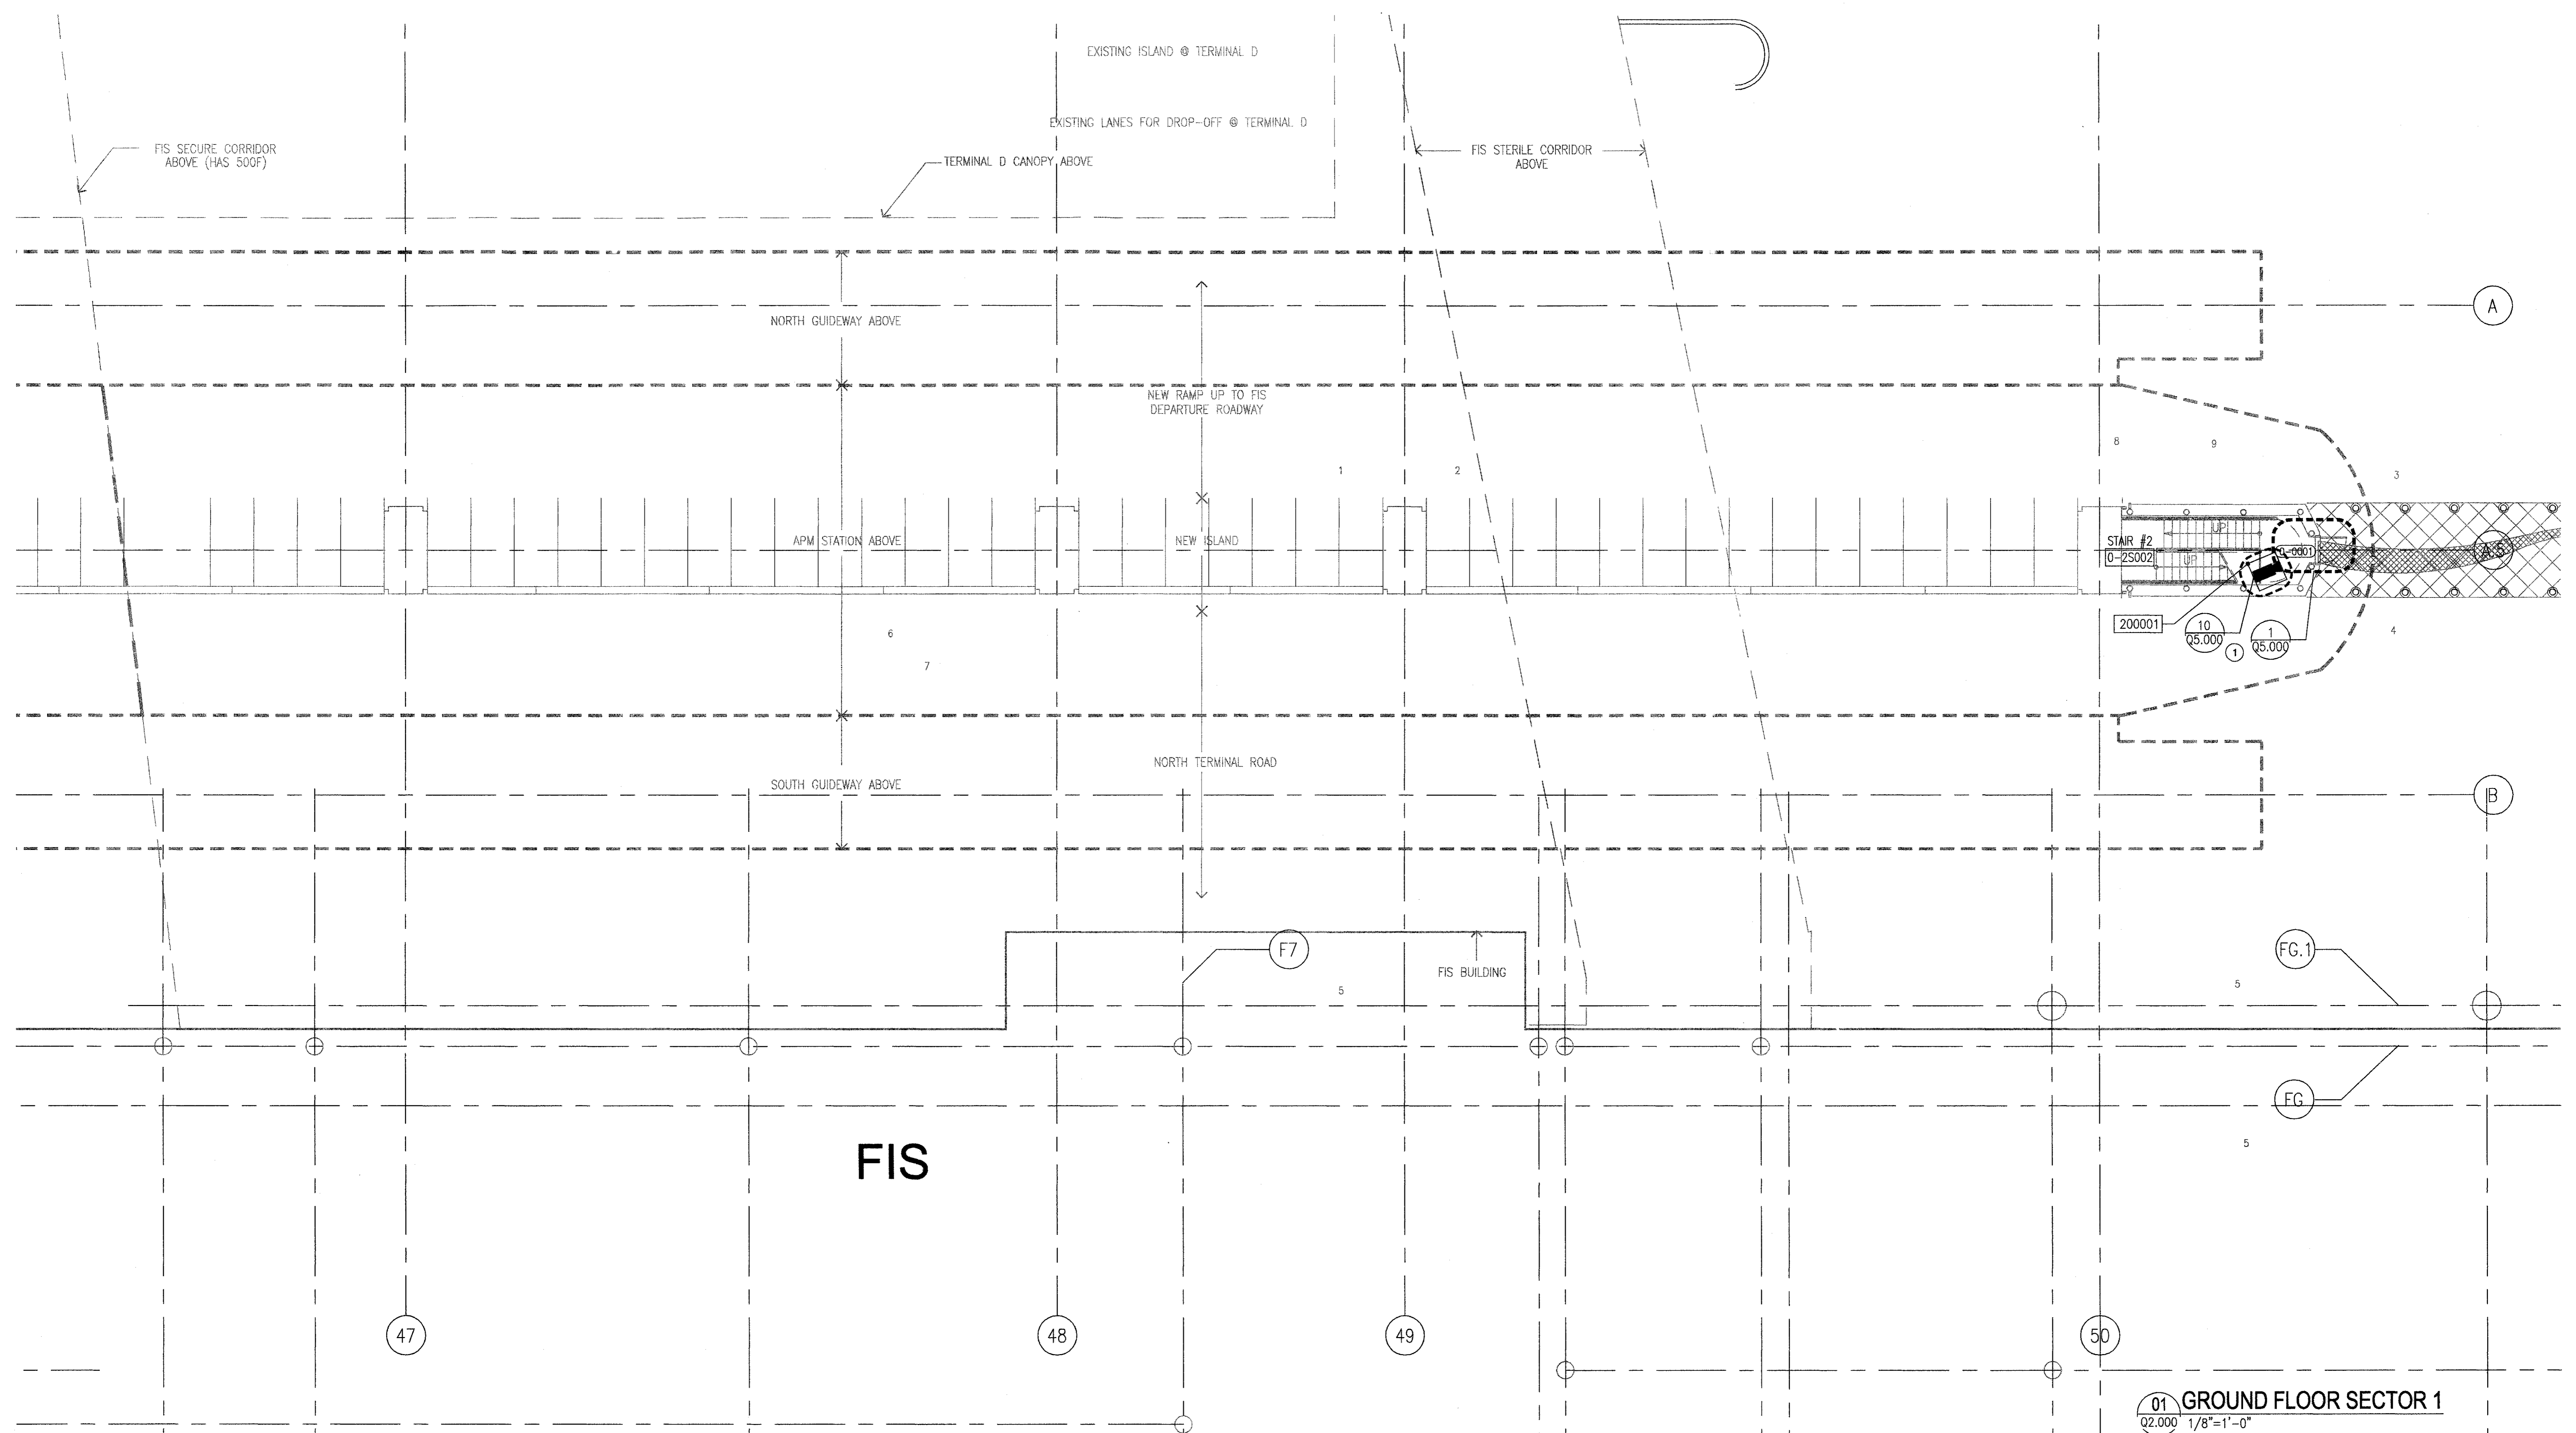

INTERNATIONAL • SERVICES • EXPANSION • PROGRAM


**APM STATION + PLATFORM**

GROUND FLOOR

**KEYED NOTES:**

- CONTRACTOR SHALL FIELD VERIFY MOUNTING REQUIREMENTS FOR STAIR #2 FIXED CAMERA.

**GENERAL NOTES:**

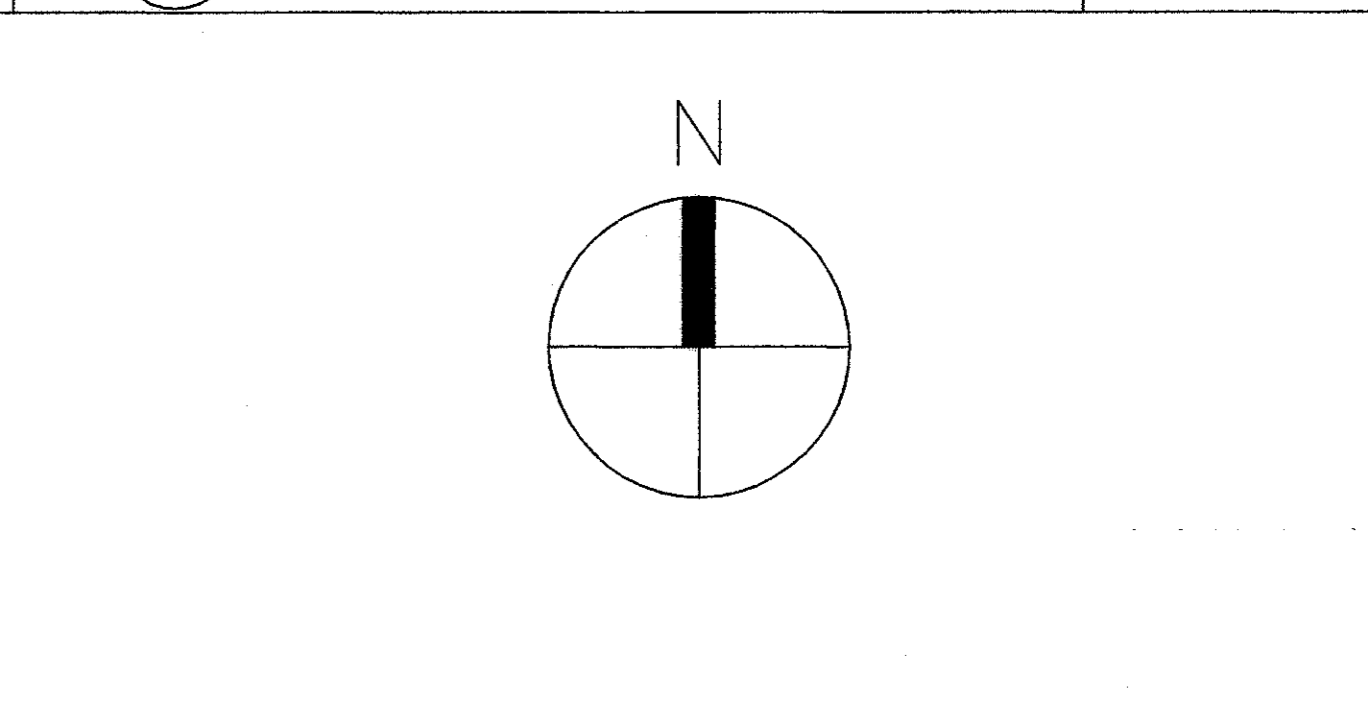

NOTE: REFER TO GRAPHIC SCALE IF ACTUAL SHEET SIZE IS OTHER THAN 30"x42".

SCALE: 1/8" = 1'-0"


PROJECT MGR: W. GLOVER  
 DESIGNER: G. RESNICK  
 DRAWN BY: R. BUTLER  
 CHECKED BY:  
 DRAWING STANDARD: ISEP 07.20.2000  
 SCALE: 1/8"=1'-0"  
 DATE: September 14, 2001

APPROVED BY: \_\_\_\_\_ DATE: \_\_\_\_\_  
 DIRECTOR  
 HOUSTON AIRPORT SYSTEM  
 PROJECT NO. 1140  
 C.I.P. NO. A-0354  
 H.A.S. NO. 538C  
 SHEET NO.

**Q2.000**



NO.	DESCRIPTION	DATE	BY
ISSUED FOR BID		10/19/01	
BULLETIN #60		04/16/04	RE
RECORD DWGS		04/22/05	JM

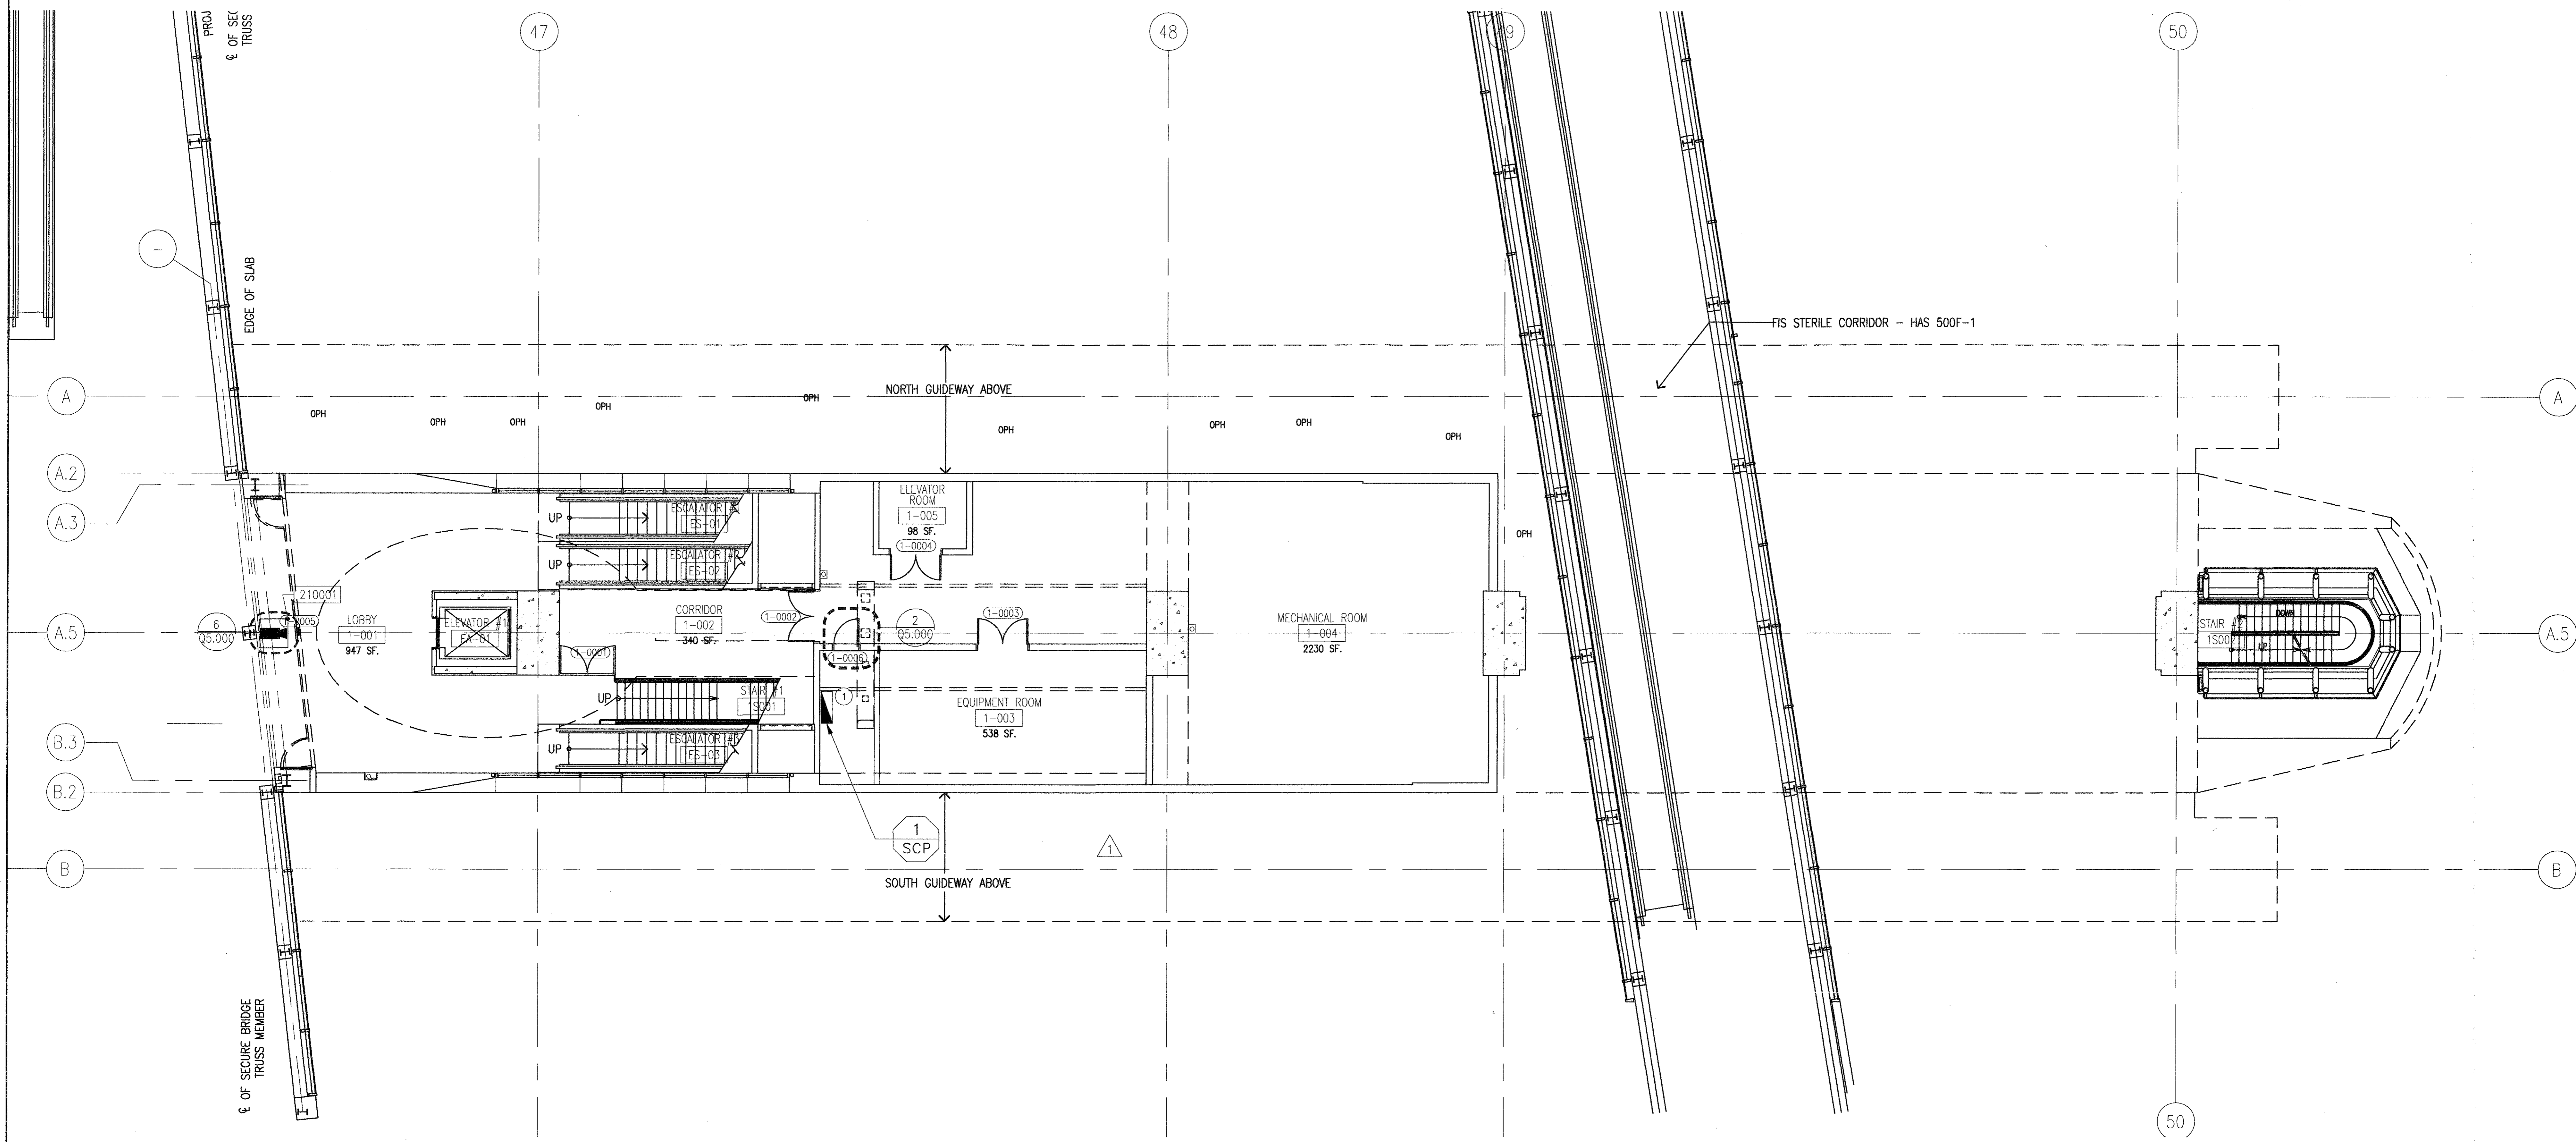



INTERNATIONAL • SERVICES • EXPANSION • PROGRAM  
**APM STATION + PLATFORM**  
 LOBBY LEVEL

**01 LOBBY LEVEL SECTOR 1**  
 Q2.100 1/8"=1'-0"

**KEYED NOTES**

- SEE SHEET Q5.101 FOR SECURITY EQUIPMENT LAYOUT.

**GENERAL NOTES:**

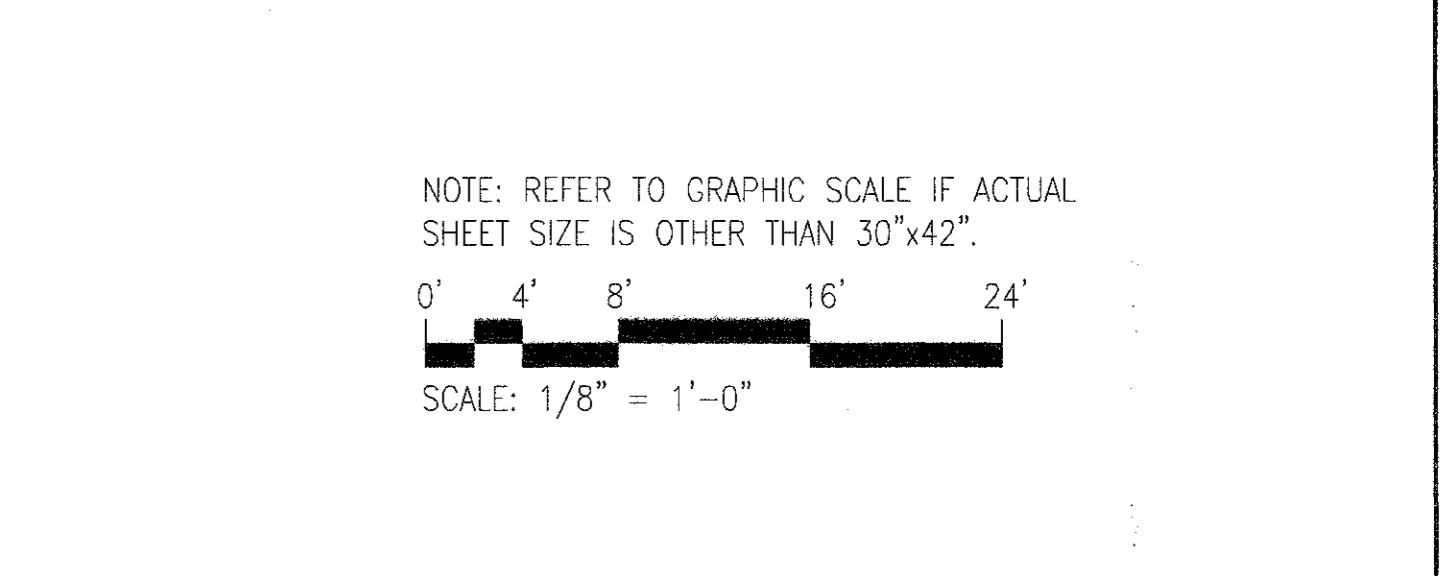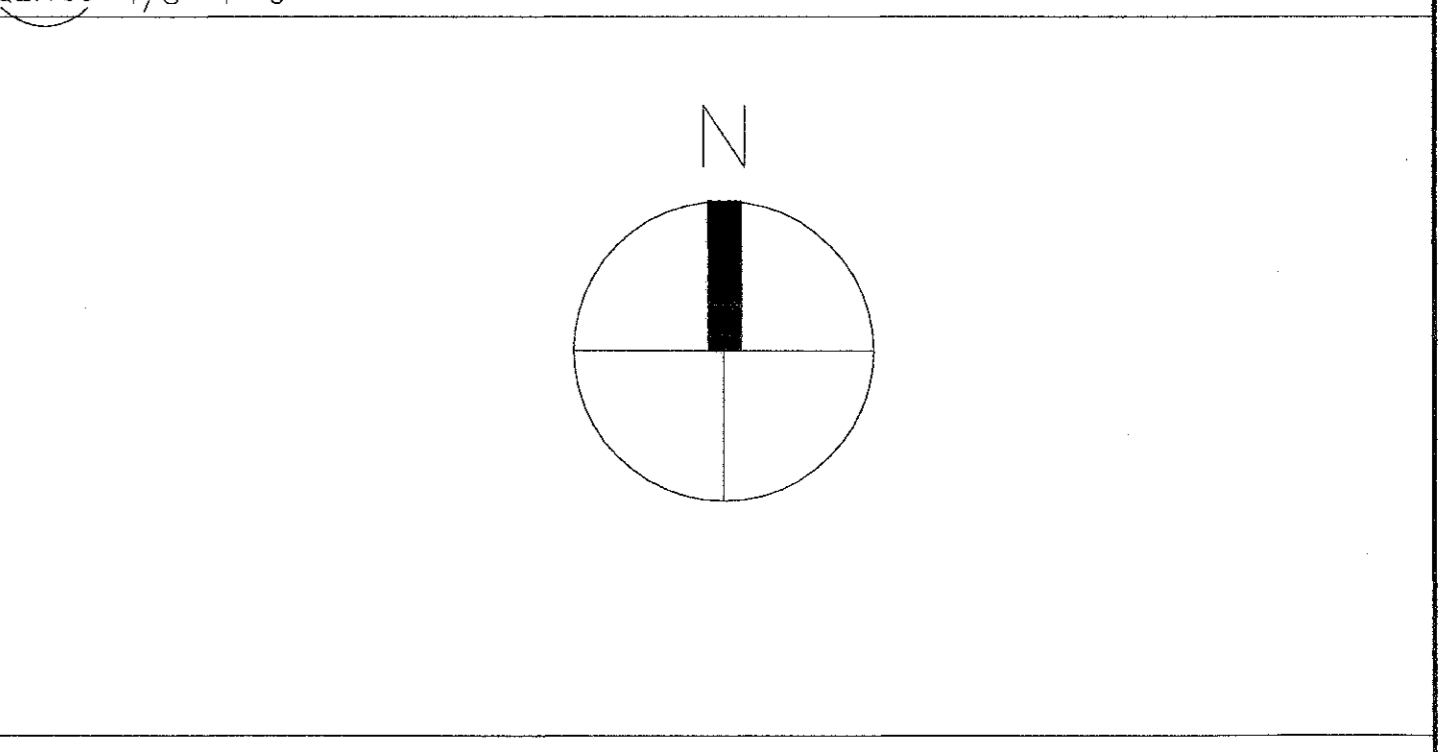

PROJECT MGR: W. CLOVER  
 DESIGNER: G. RESNICK  
 DRAWN BY: R. BUTLER  
 CHECKED BY:  
 DRAWING STANDARD:  
 ISEP 07.20.2000  
 SCALE: 1/8"=1'-0"  
 DATE: September 14, 2001


APPROVED BY: \_\_\_\_\_ DATE: \_\_\_\_\_  
 DIRECTOR  
 HOUSTON AIRPORT SYSTEM  
 PROJECT NO. 1140  
 C.I.P. NO. A-0354  
 H.A.S. NO. 536C  
 SHEET NO. 119

**Q2.100**

PLOT DATE: 04.22.05 HAS FILE#A36002-100





NO.	DESCRIPTION	DATE	BY
	ISSUED FOR BID	10/19/01	
1	BULLETIN #60	04/16/04	RM
2	RECORD DWGS	04/22/05	JM

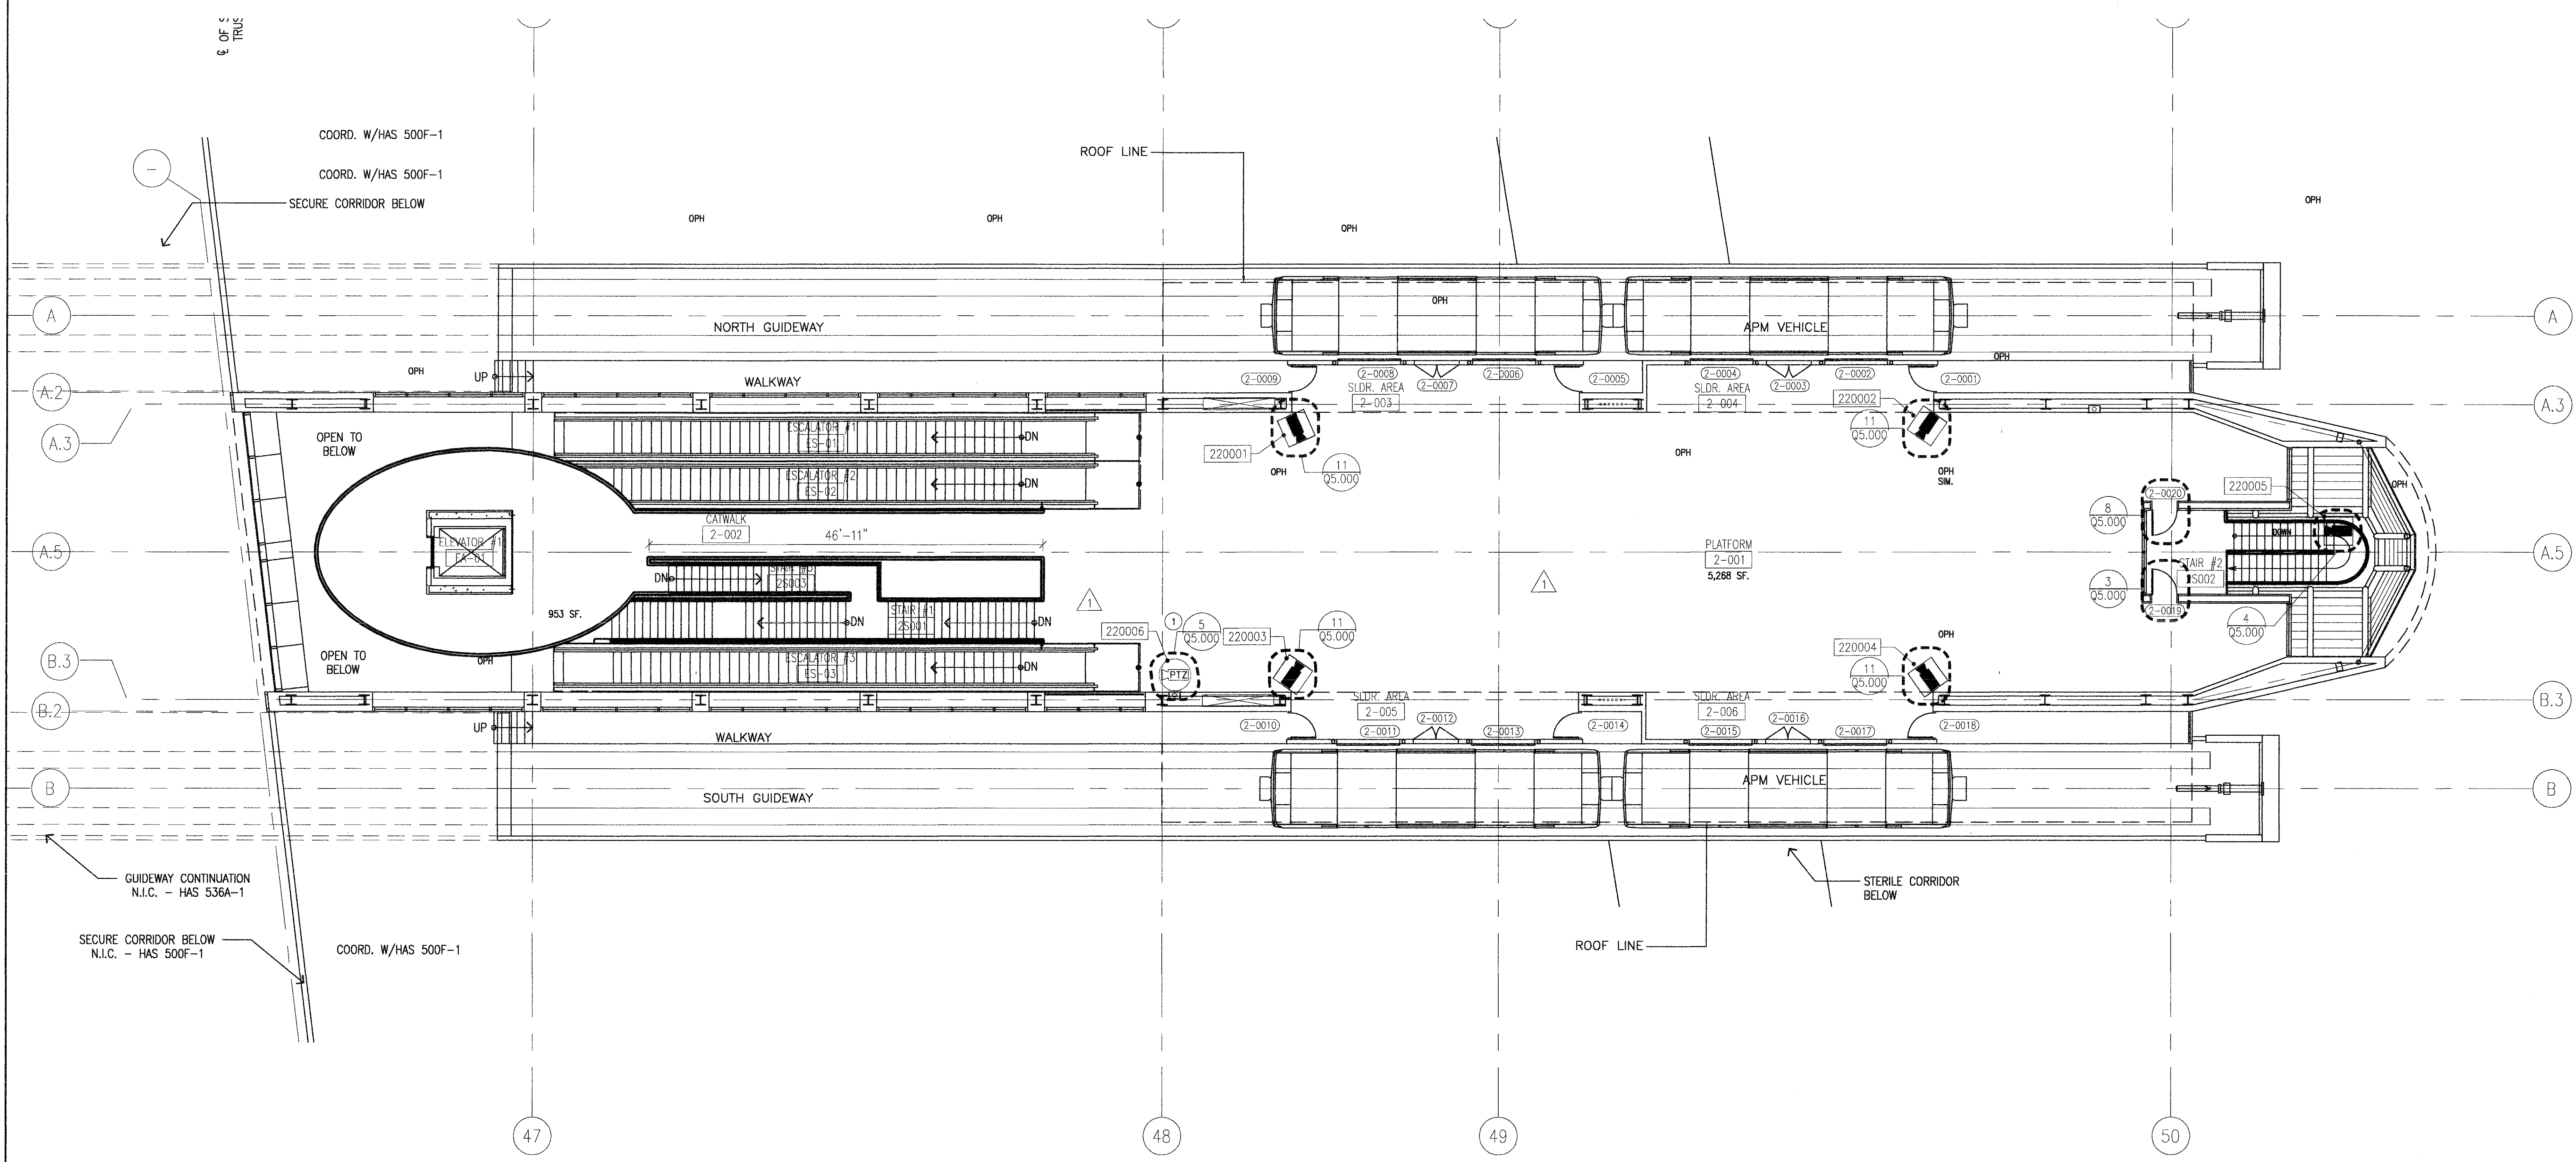

**01 PLATFORM LEVEL SECTOR 1**  
 02.200 1/8"=1'-0"

KEYED NOTES	GENERAL NOTES:
<p>1. PTZ CAMERA SHALL BE PENDANT MOUNTED FROM DUCT SUPPORT STRUCTURE.</p> <p>2. DOOR TO BE MONITORED ONLY BY BOMBARDIER.</p>	

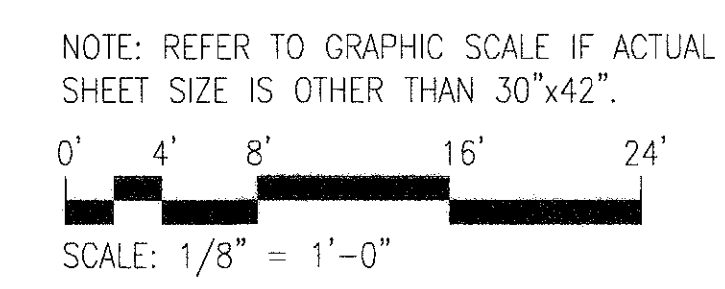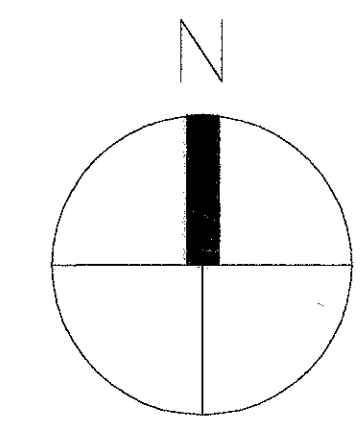

INTERNATIONAL SERVICES EXPANSION PROGRAM  
**APM STATION + PLATFORM**  
 PLATFORM LEVEL


PROJECT MGR: W. GLOVER  
 DESIGNER: G. RESNICK  
 DRAWN BY: R. BUTLER  
 CHECKED BY:  
 DRAWING STANDARD:  
 ISEP 07.20.2000  
 SCALE: 1/8"=1'-0"  
 DATE: September 14, 2001

APPROVED BY: \_\_\_\_\_ DATE: \_\_\_\_\_  
 DIRECTOR  
 HOUSTON AIRPORT SYSTEM  
 PROJECT NO. 1140  
 C.I.P. NO. A-0354  
 H.A.S. NO. 538C  
 SHEET NO. **Q2.200**


PLOT DATE: 04/22/05 HAS FILE: HAS3602-200




NO.	DESCRIPTION	DATE	BY
ISSUED FOR BID		10/19/01	
1	BULLETIN #60	04/16/04	RE
2	RECORD DWGS	04/22/05	JM

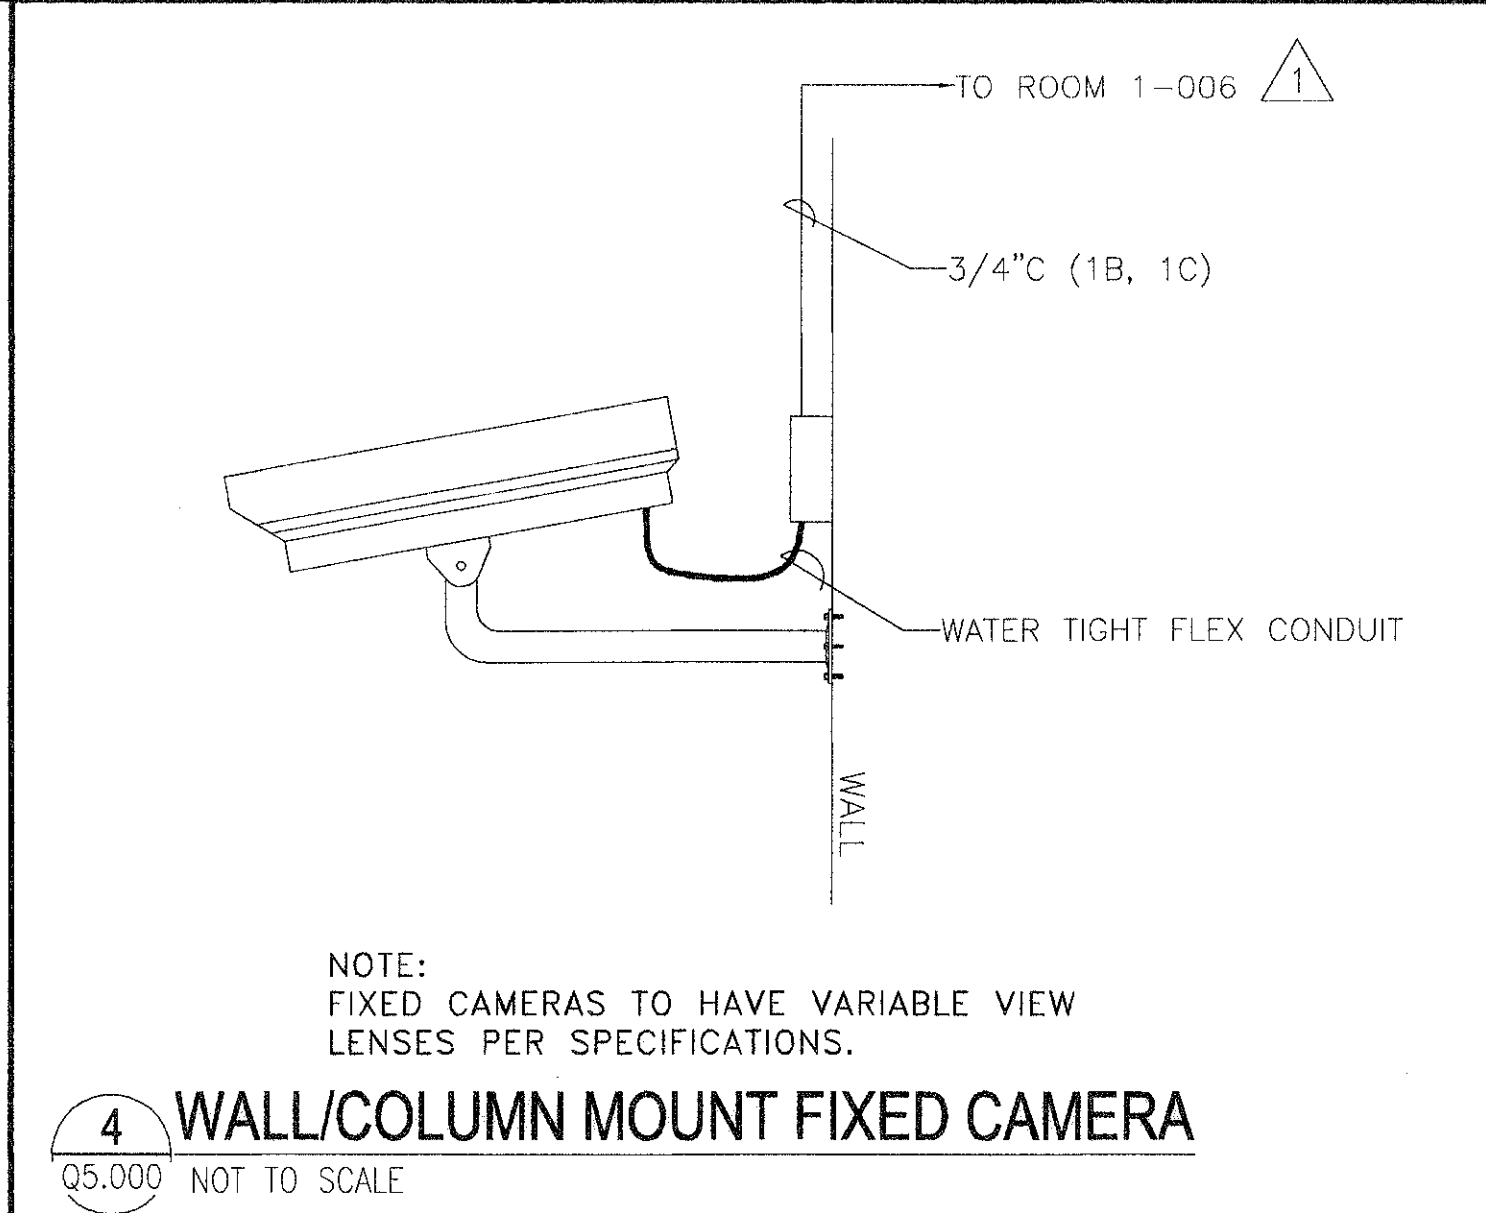


**4 WALL/COLUMN MOUNT FIXED CAMERA**  
 Q5.000 NOT TO SCALE

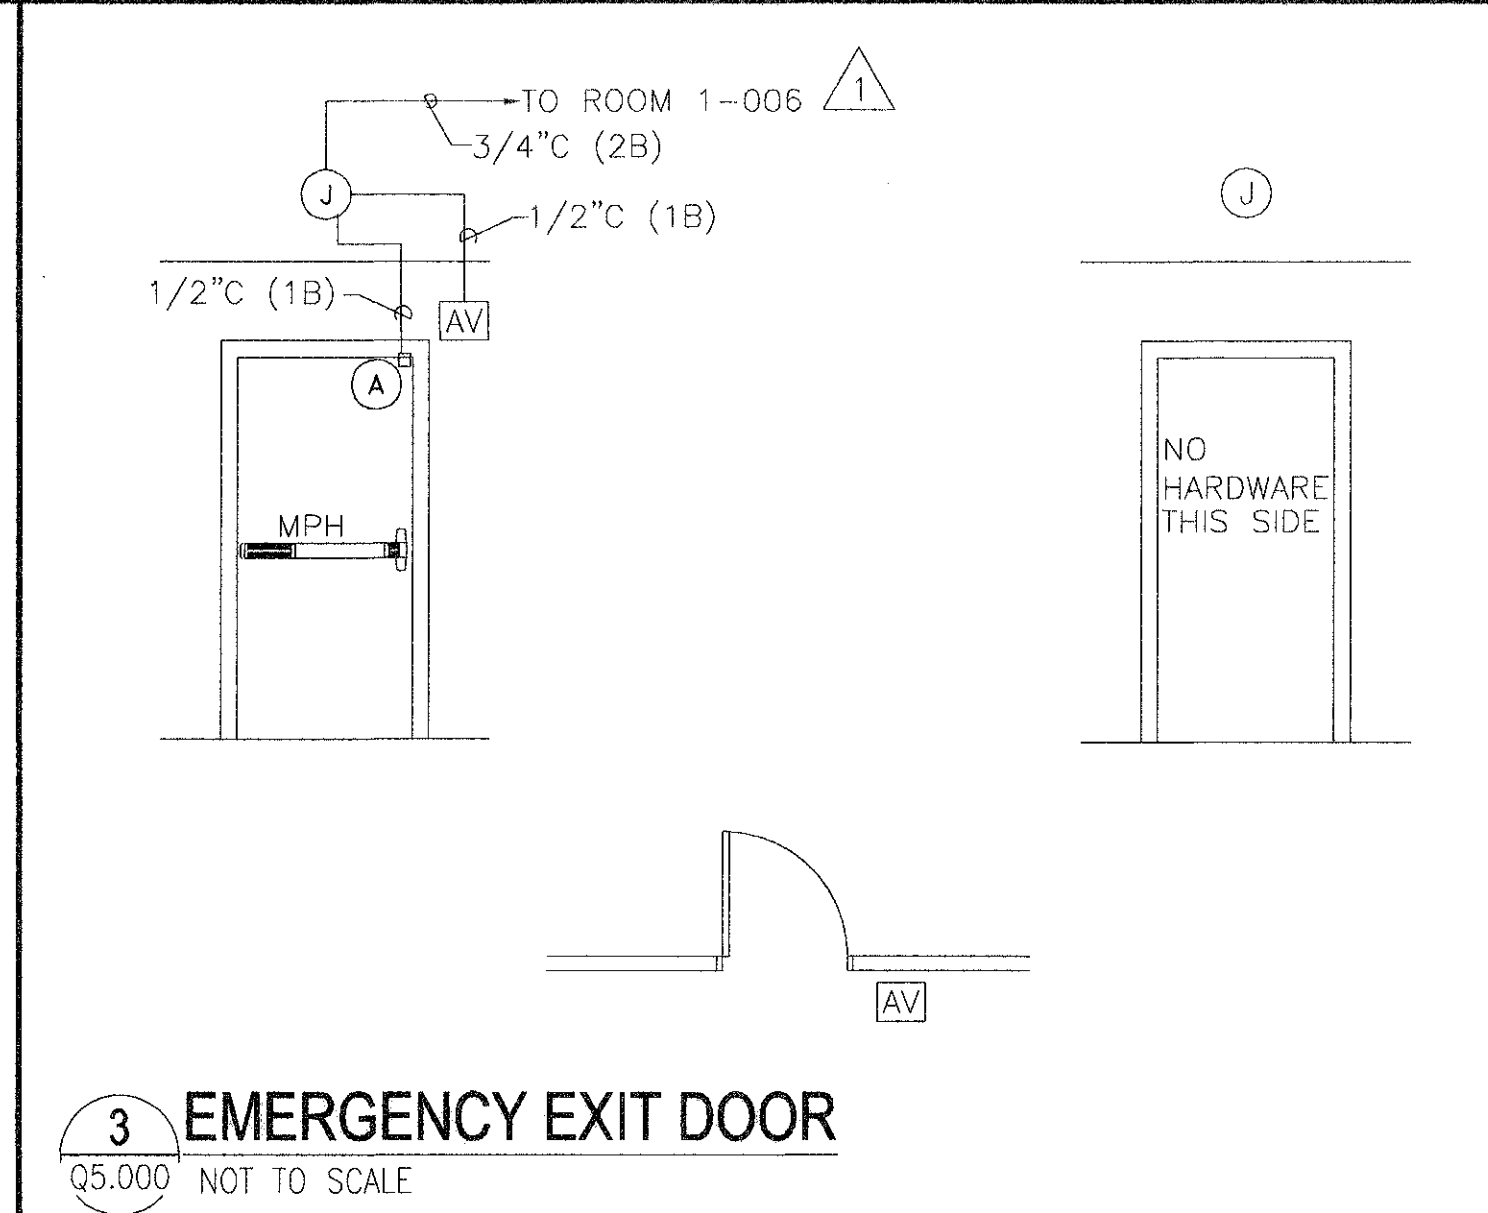


**3 EMERGENCY EXIT DOOR**  
 Q5.000 NOT TO SCALE

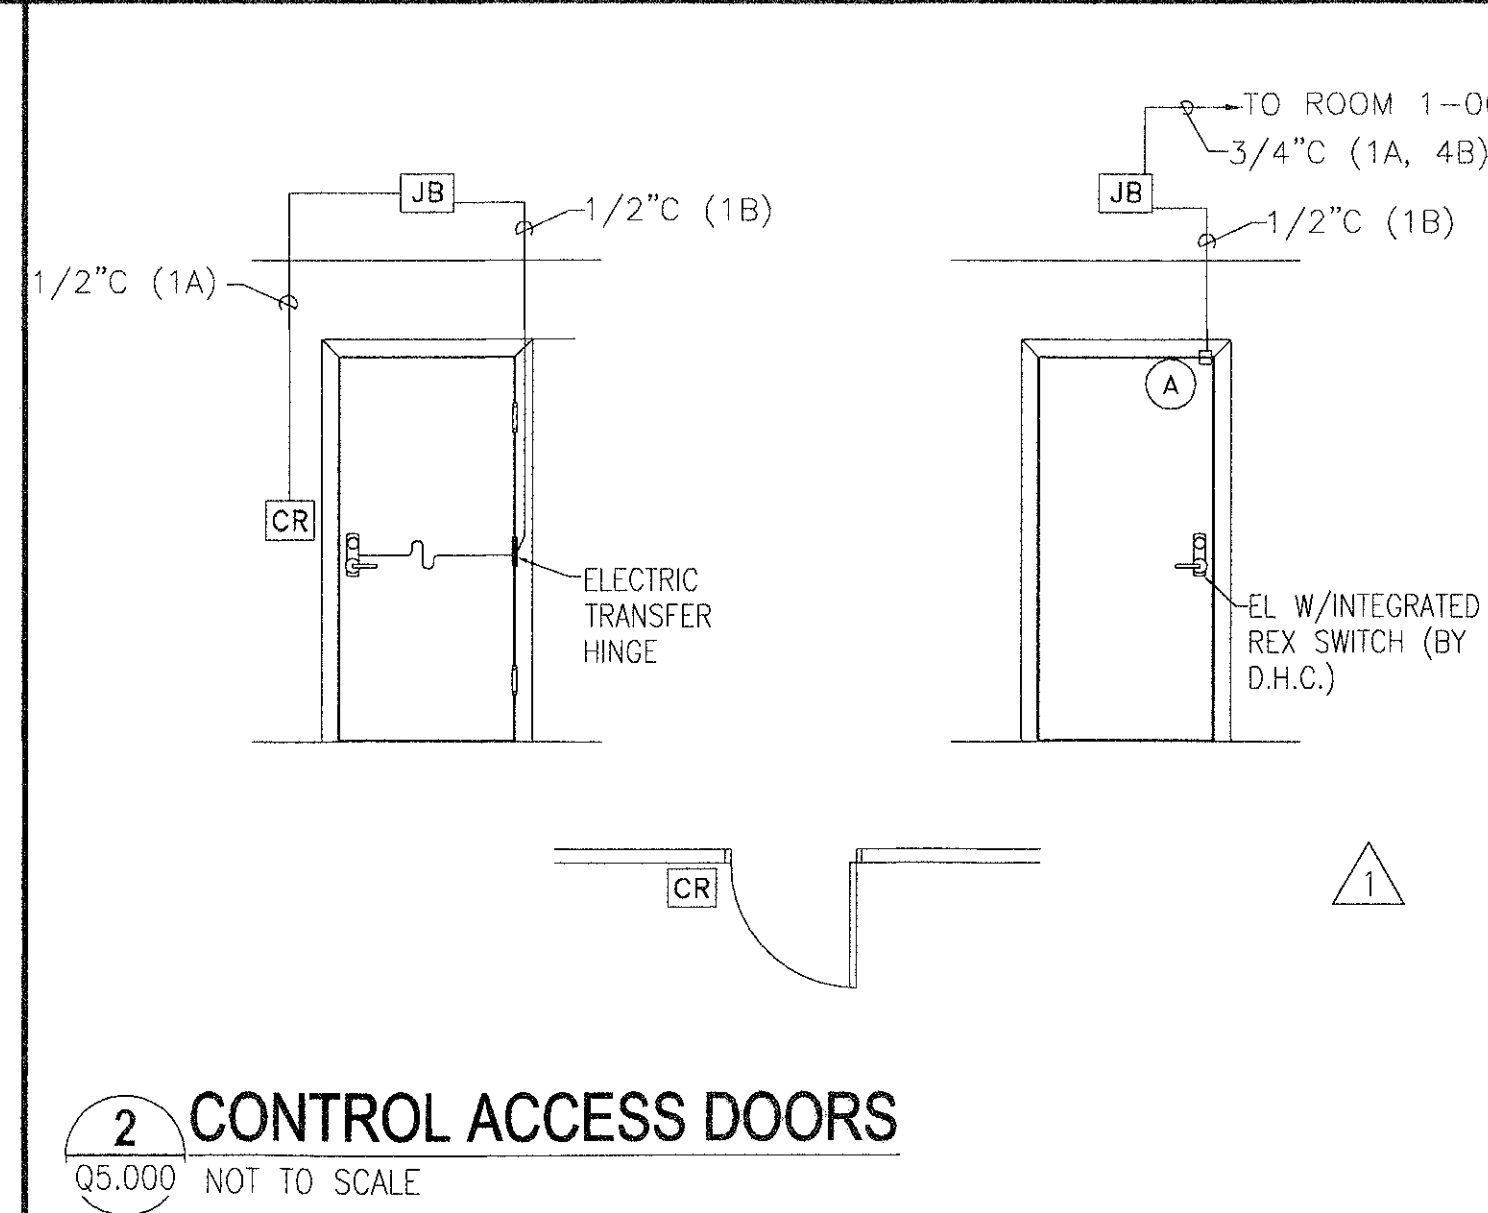


**2 CONTROL ACCESS DOORS**  
 Q5.000 NOT TO SCALE

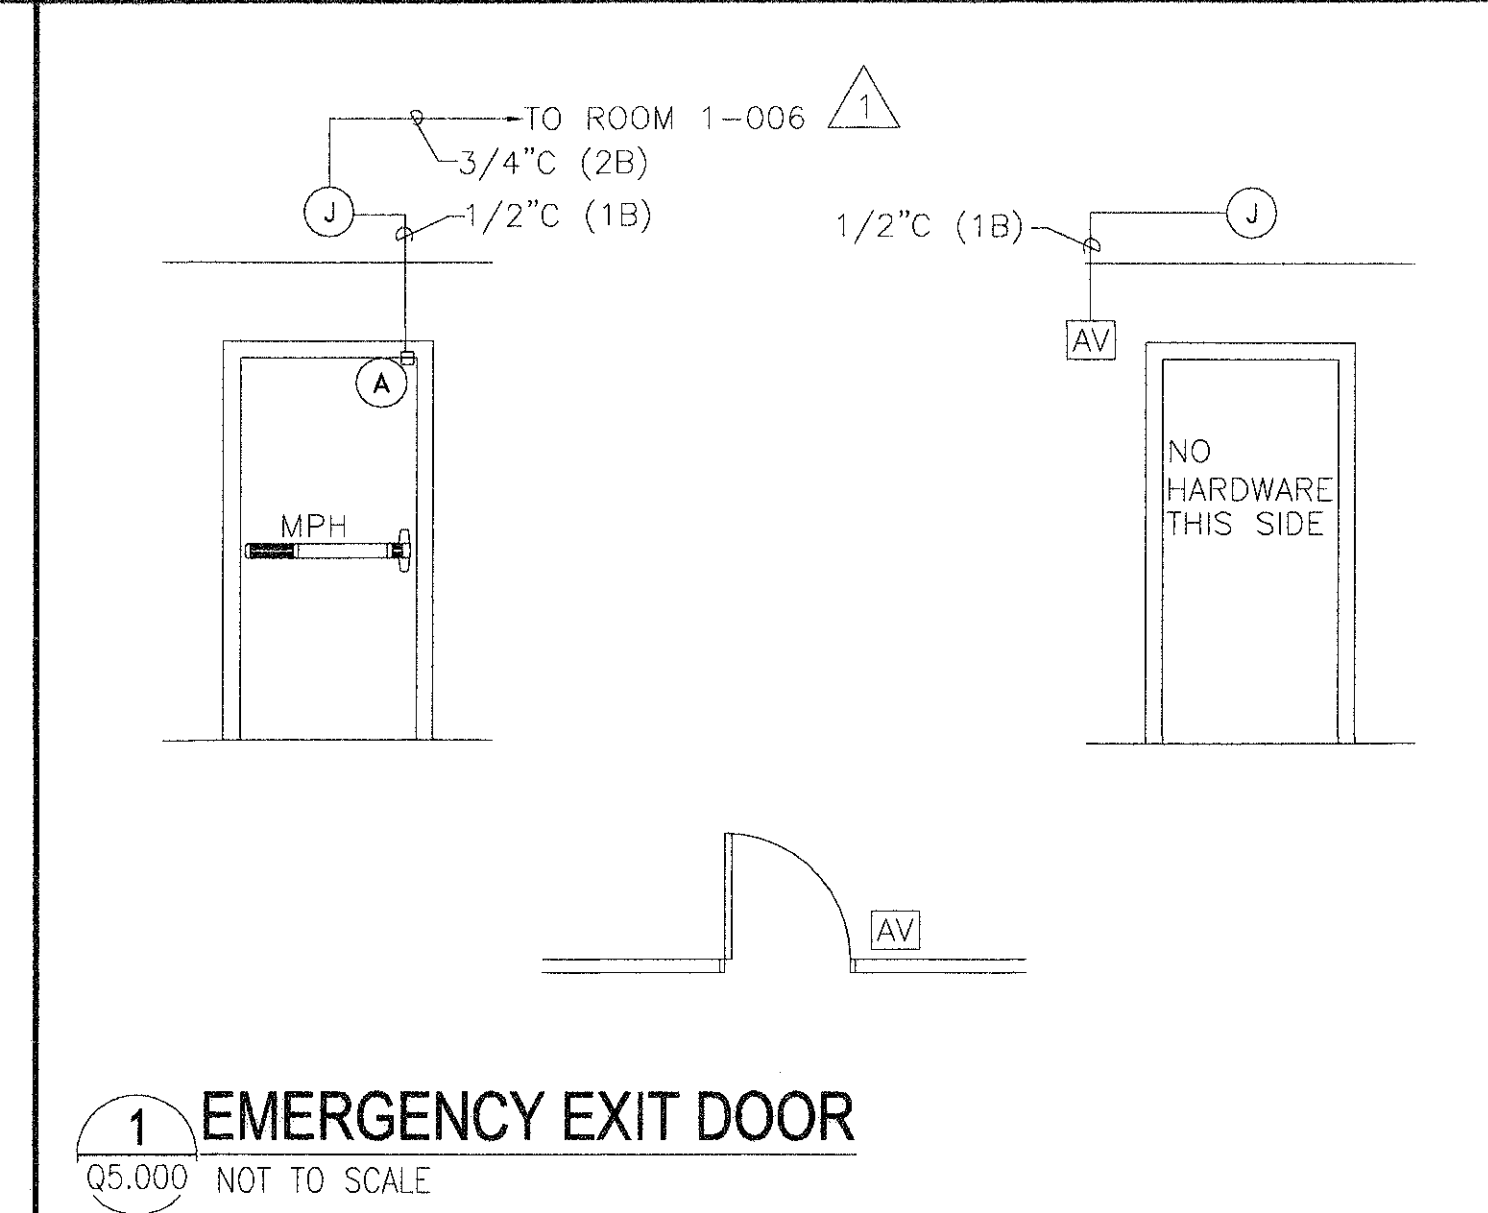


**1 EMERGENCY EXIT DOOR**  
 Q5.000 NOT TO SCALE

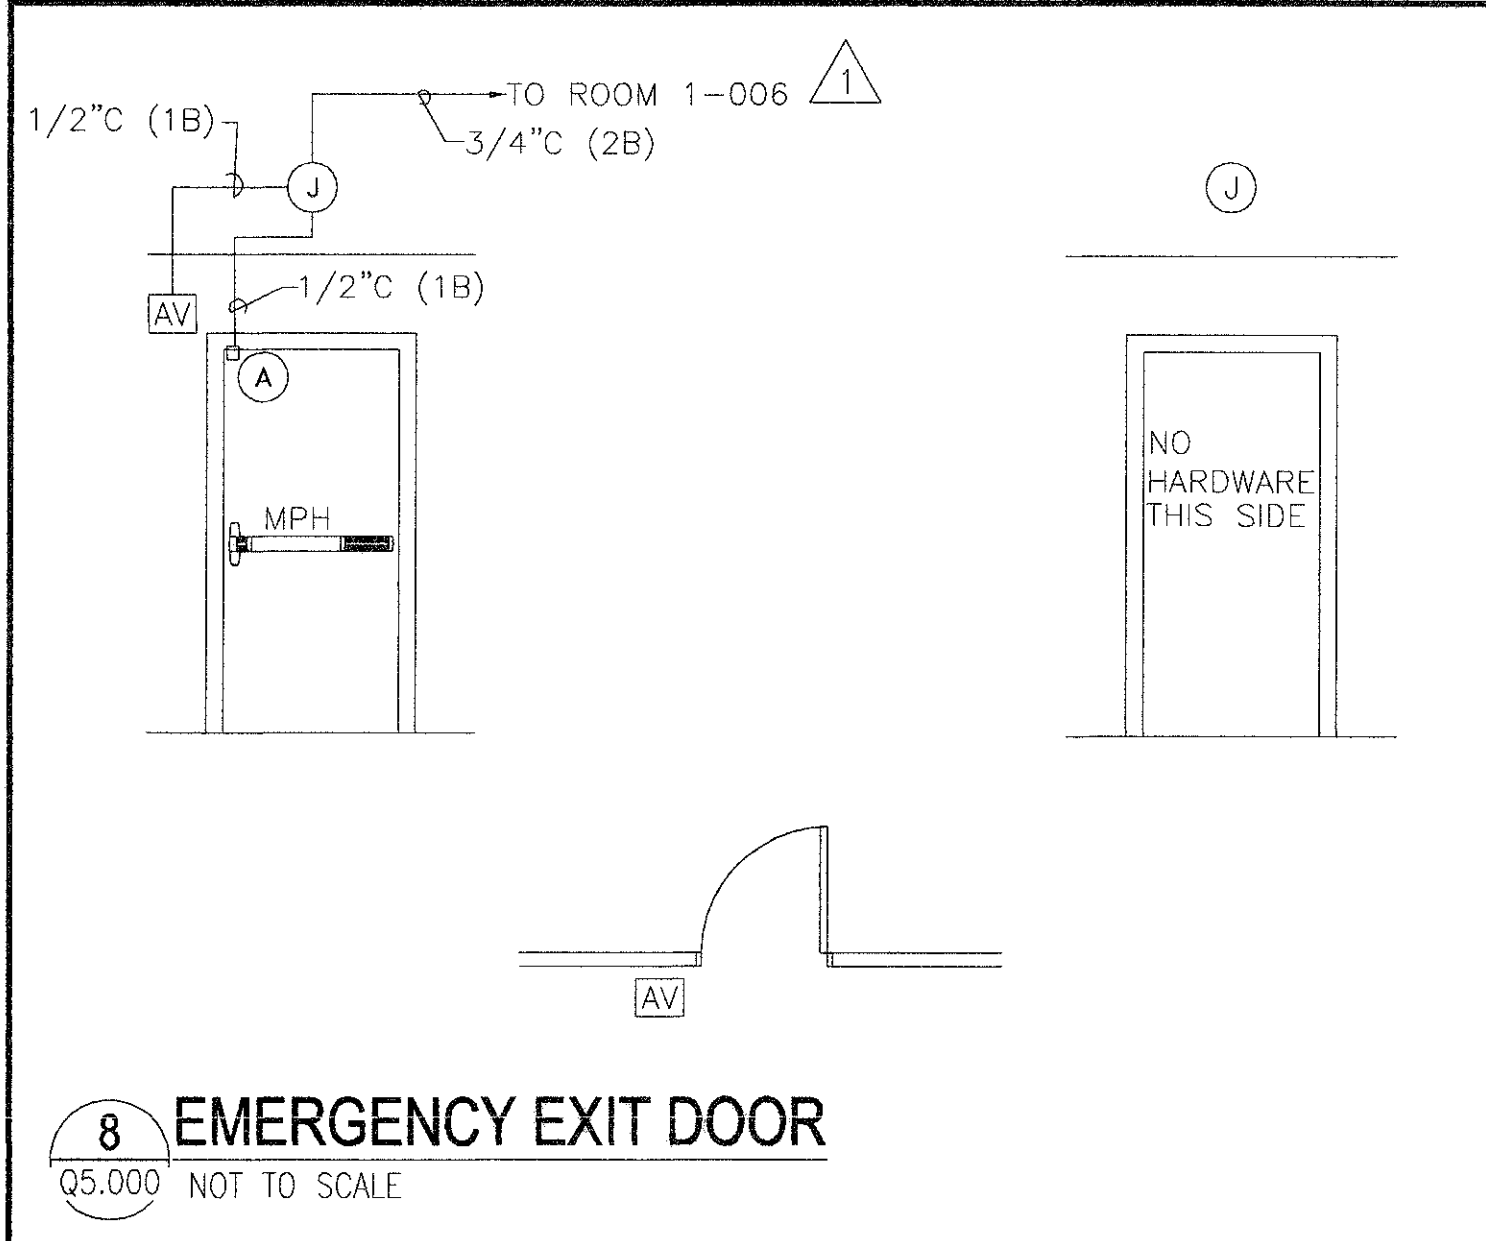


**8 EMERGENCY EXIT DOOR**  
 Q5.000 NOT TO SCALE

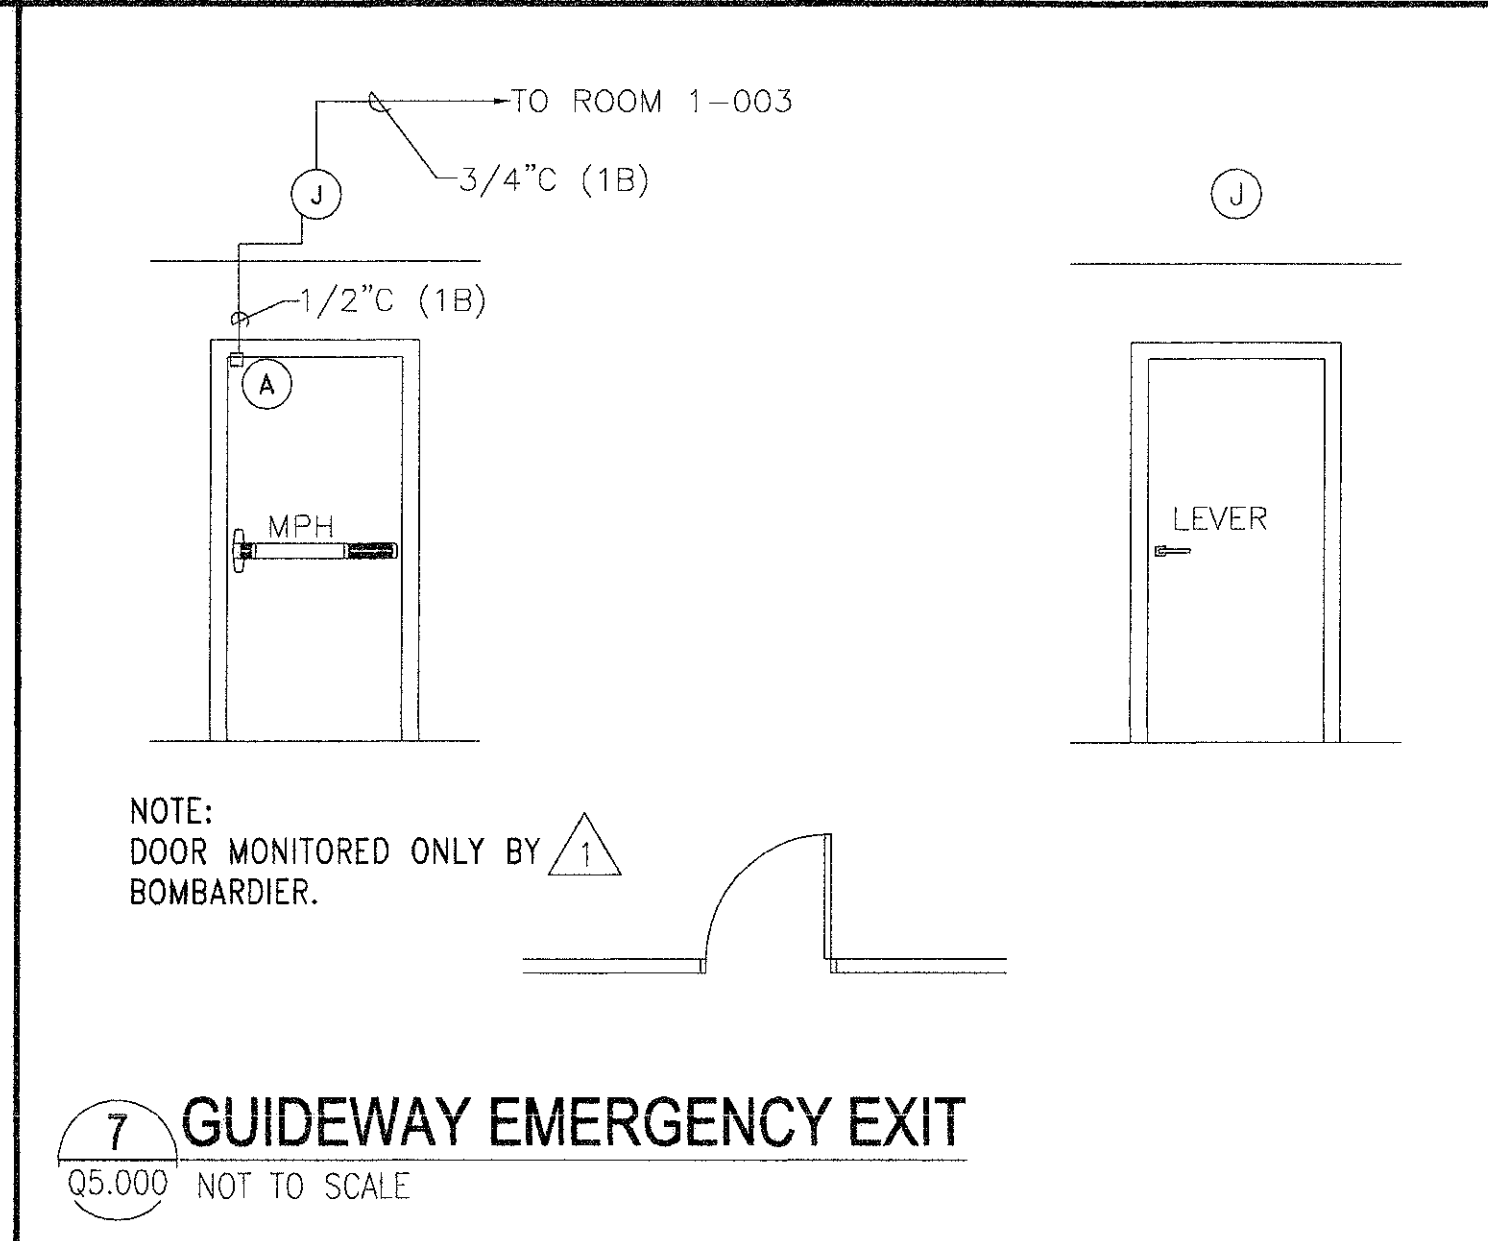

**7 GUIDEWAY EMERGENCY EXIT**  
 Q5.000 NOT TO SCALE

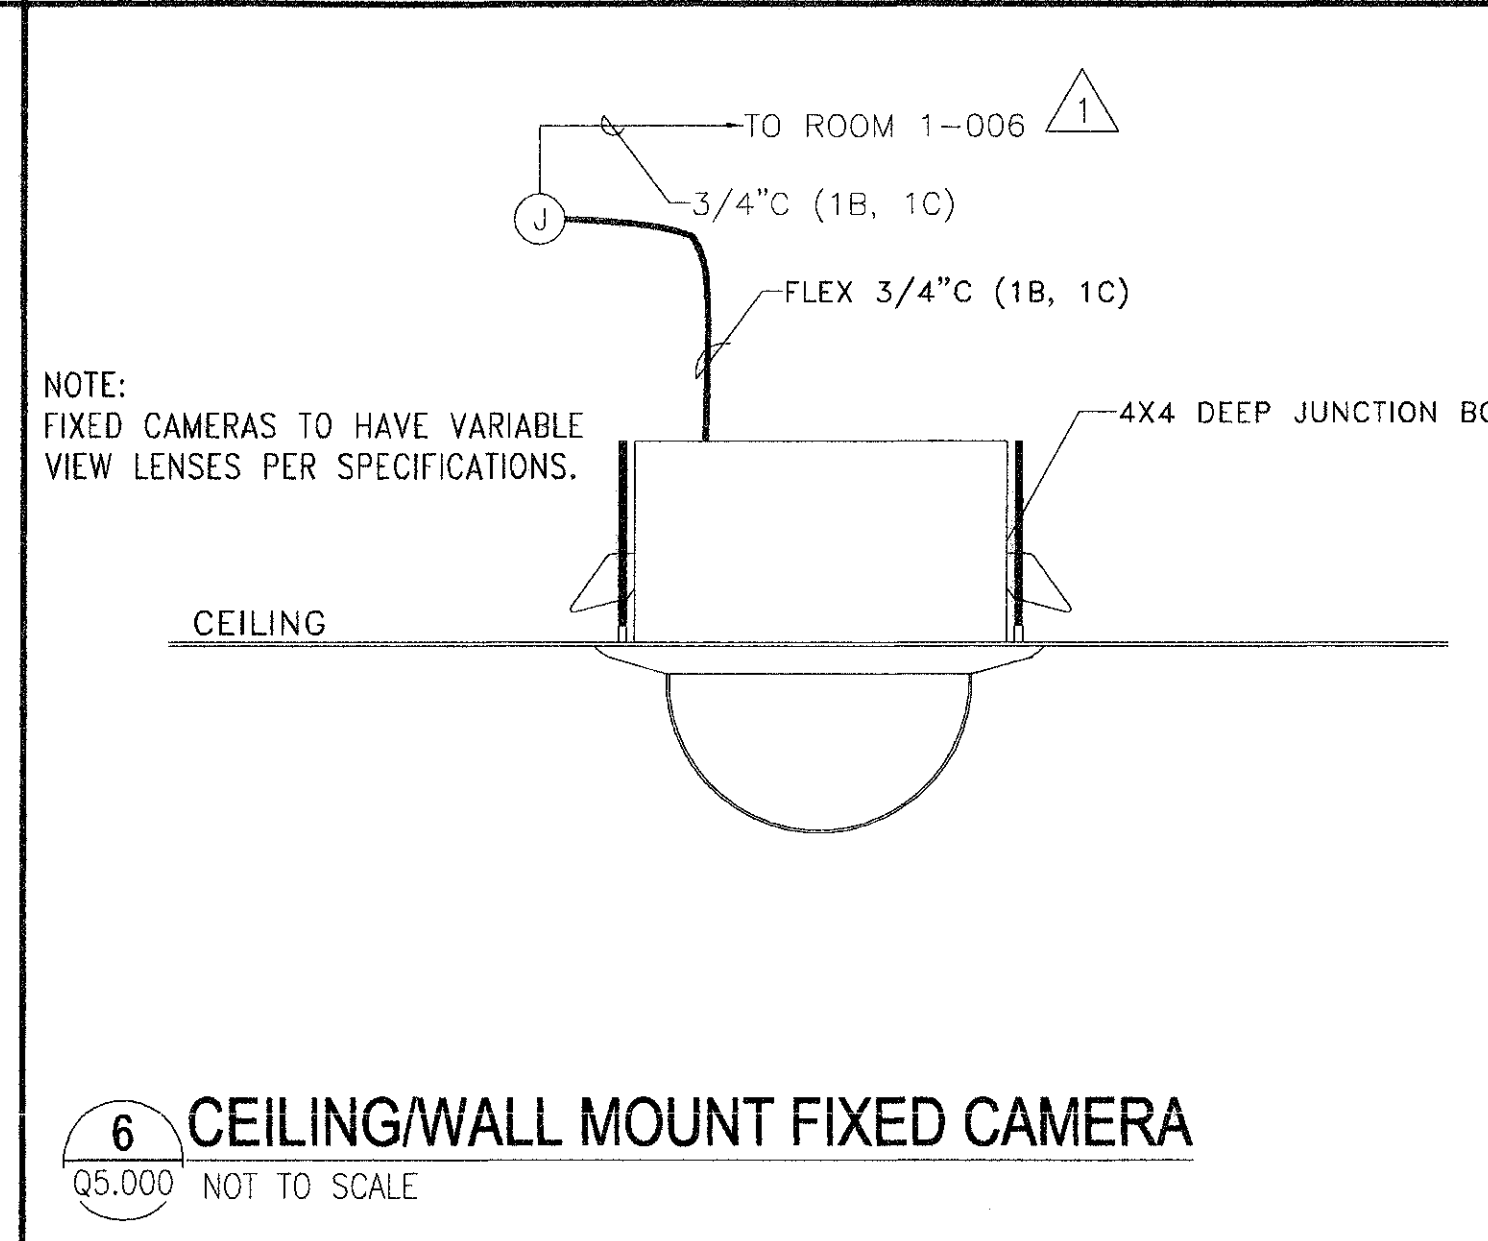

**6 CEILING/WALL MOUNT FIXED CAMERA**  
 Q5.000 NOT TO SCALE

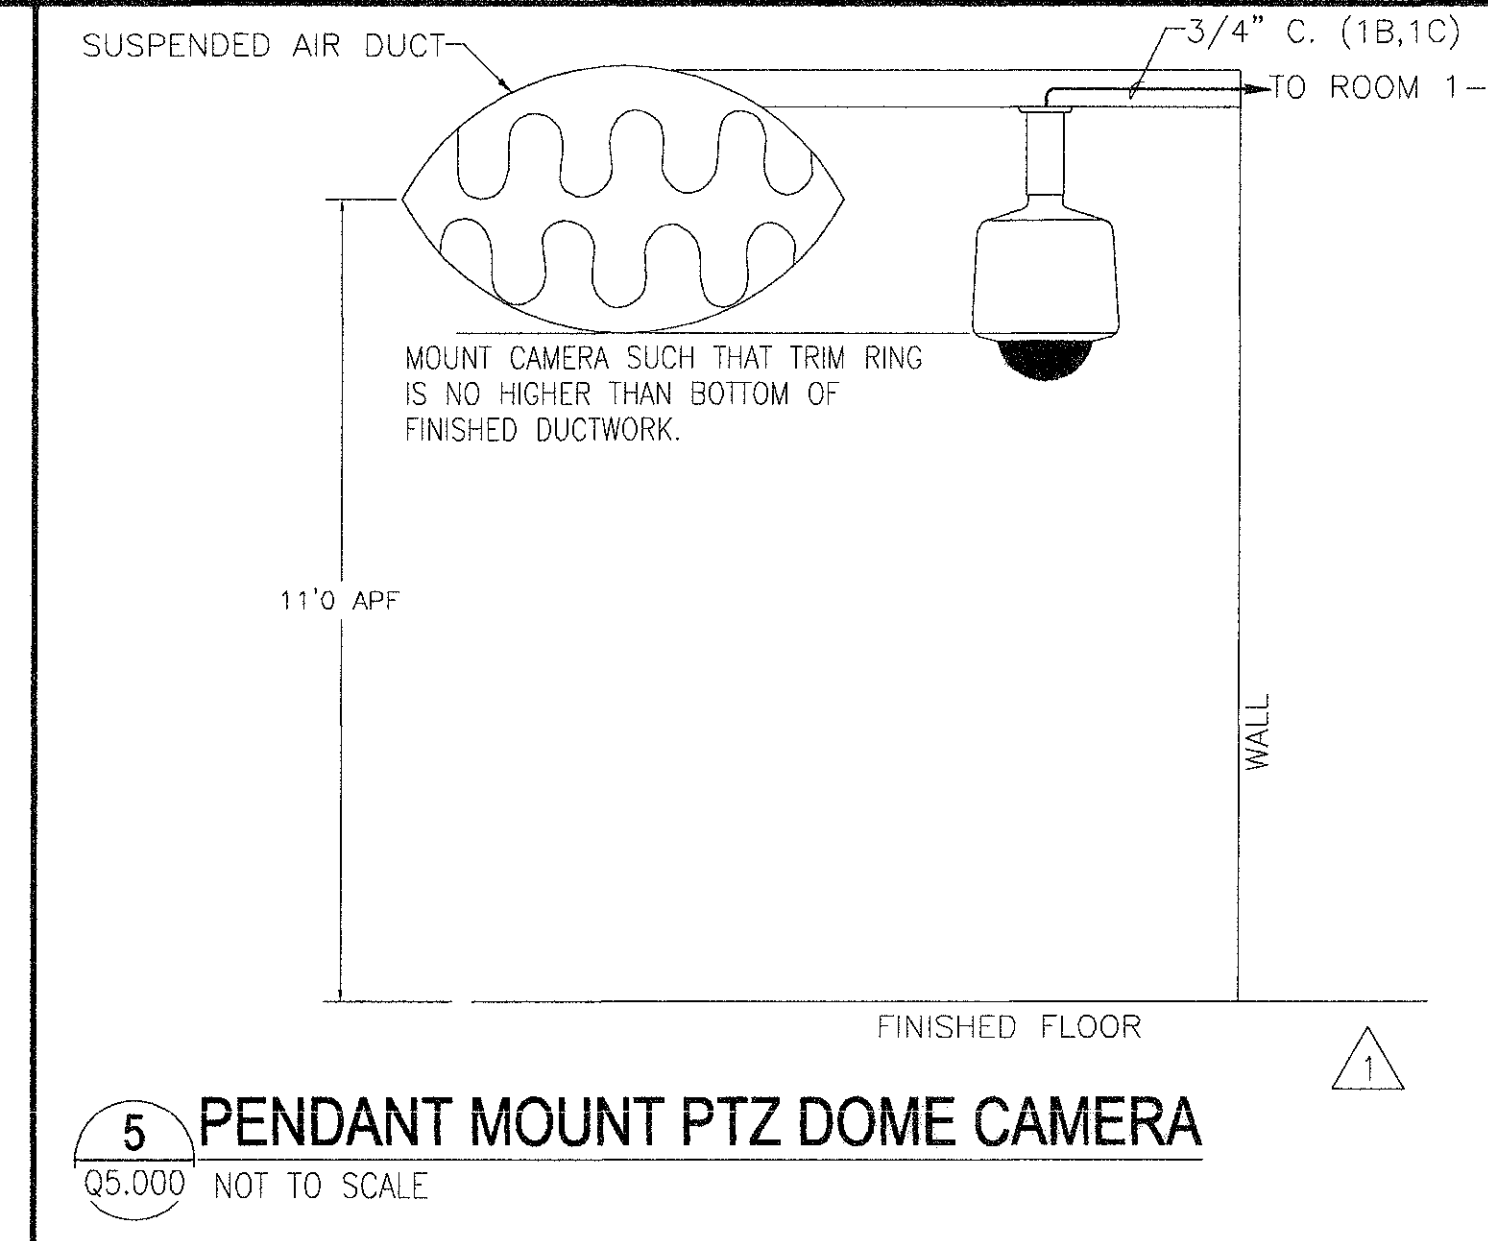


**5 PENDANT MOUNT PTZ DOME CAMERA**  
 Q5.000 NOT TO SCALE

	LEVEL	PORTAL/ ROOM NO.	LOCATION	DETAIL	CR	REX	A	AV	TO ROOM	PANEL NO.
1	GROUND FLOOR	0-0001	Q2.000	1			1	1	1-006	1
2	LOBBY LEVEL	1-0006	Q2.100	2	1	1	1	1	1-006	1
3	PLATFORM LEVEL	2-0019	Q2.200	3			1	1	1-006	1
4	PLATFORM LEVEL	2-0020	Q2.200	8			1	1	1-006	1
5	PLATFORM LEVEL	2-0001 *	Q2.200	7			1	1	1-003	1
6	PLATFORM LEVEL	2-0005 *	Q2.200	7			1	1	1-003	1
7	PLATFORM LEVEL	2-0009 *	Q2.200	9			1	1	1-003	1
8	PLATFORM LEVEL	2-0010 *	Q2.200	7			1	1	1-003	1
9	PLATFORM LEVEL	2-0014 *	Q2.200	9			1	1	1-003	1
10	PLATFORM LEVEL	2-0018 *	Q2.200	9			1	1	1-003	1

\* = MONITORED BY BOMBARDIER ONLY

**ACCESS CONTROL POINT SCHEDULE**  
 Q5.000 NOT TO SCALE

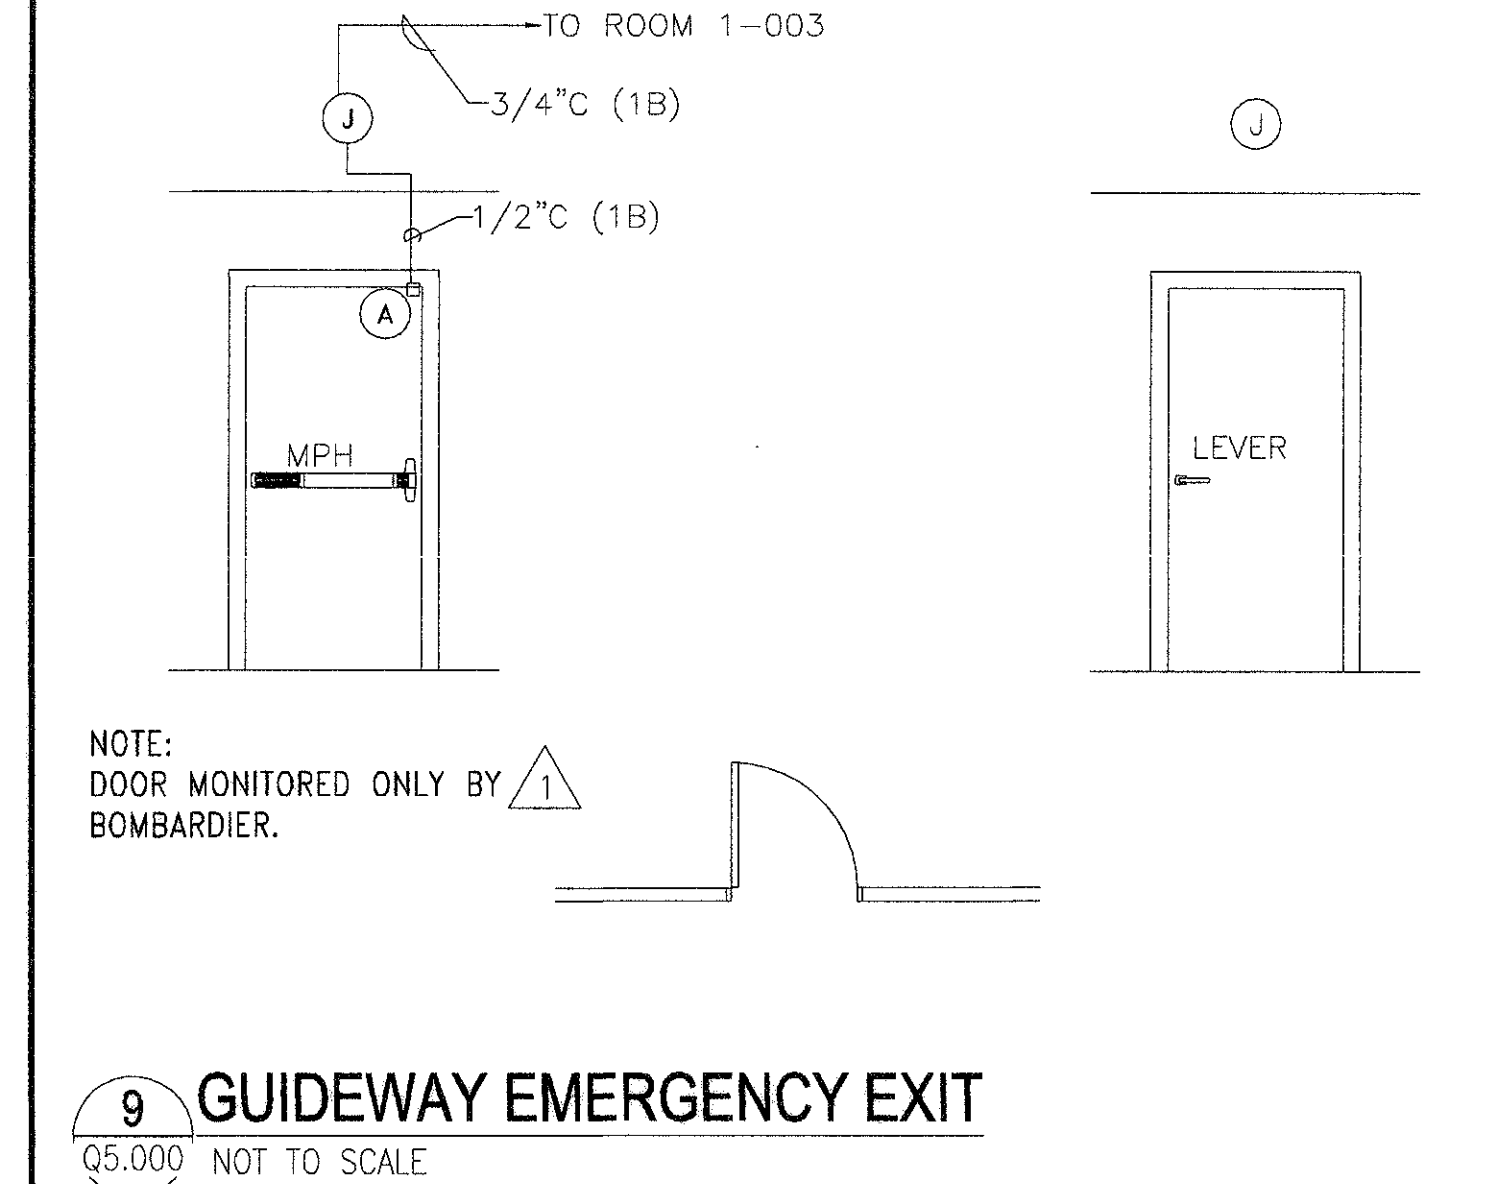


**9 GUIDEWAY EMERGENCY EXIT**  
 Q5.000 NOT TO SCALE


NUMBER	CAMERA	SHEET	DETAIL	WALL/COLUMN MOUNT FIXED CAMERA	CEILING MOUNT PTZ DOME CAMERA	CEILING MOUNT FIXED DOME CAMERA	MESH MOUNT FIXED CAMERA	WALL MOUNT FIXED DOME CAMERA	ROOM NUMBER
1	200001	Q2.000	10				1		1-006
2	210001	Q2.100	6			1			1-006
3	220001 *	Q2.200	11					1	1-006
4	220002 *	Q2.200	11					1	1-006
5	220003 *	Q2.200	11					1	1-006
6	220004 *	Q2.200	11					1	1-006
7	220005	Q2.200	4	1				1	1-006
8	220006	Q2.200	5		1				1-006

\* = SHARE CAMERA SIGNAL WITH BOMBARDIER.

**CCTV POINT SCHEDULE**  
 Q5.000 NOT TO SCALE

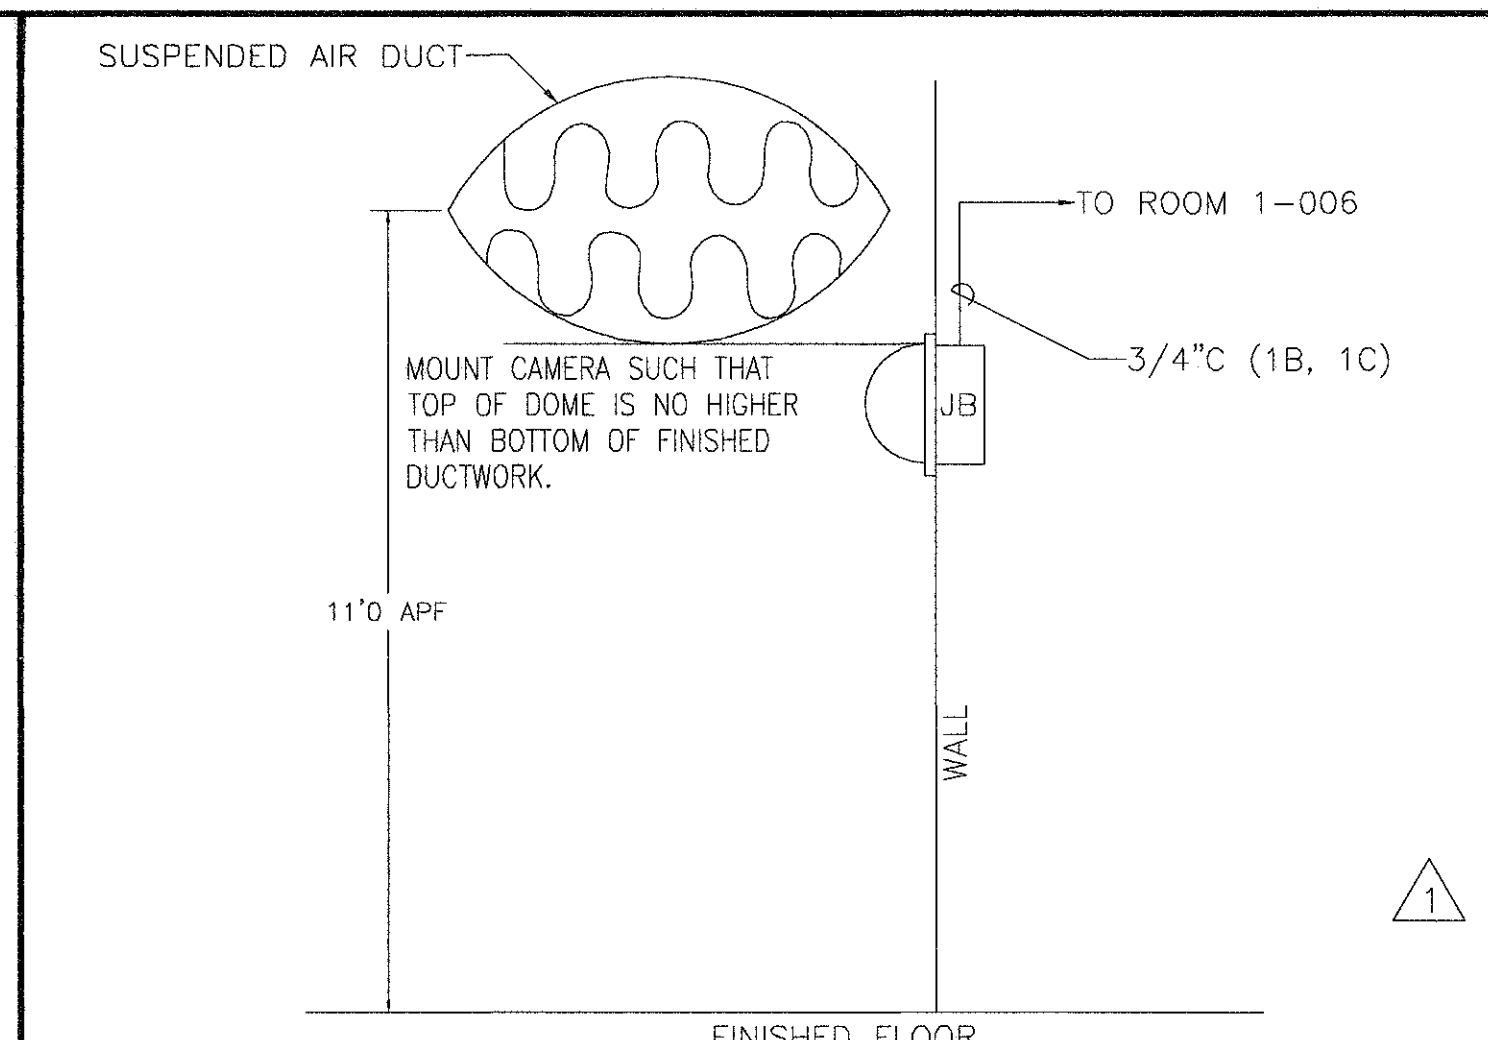

**11 WALL MOUNT FIXED DOME CAMERA**  
 Q5.000 NOT TO SCALE

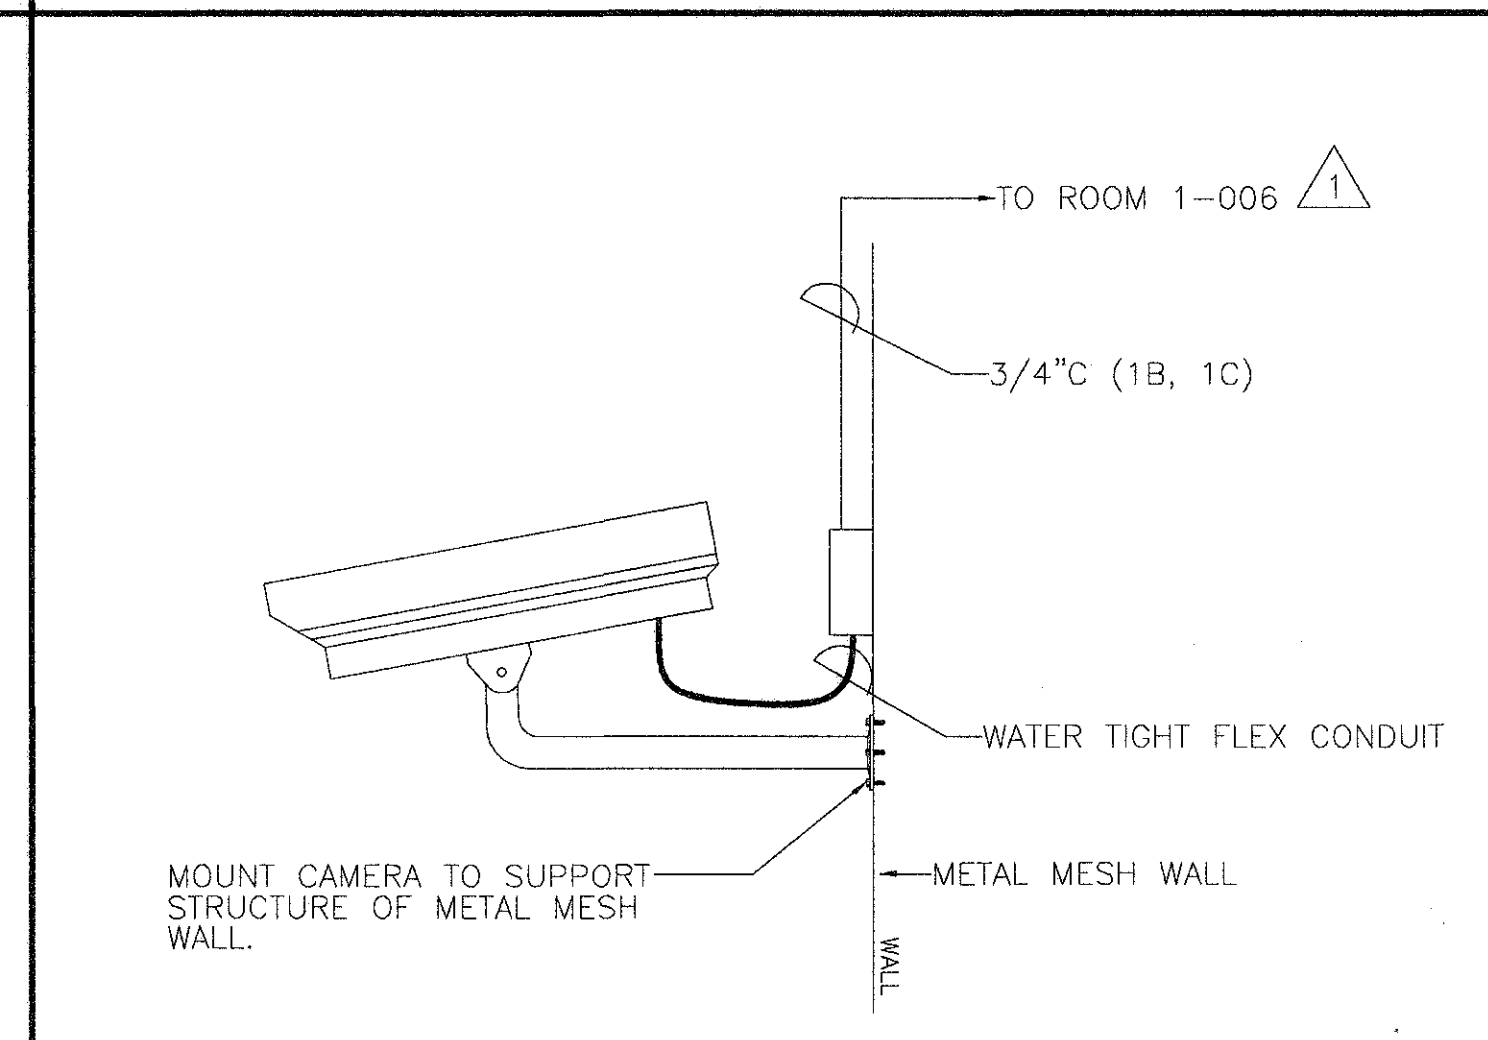

**10 MESH MOUNT FIXED CAMERA**  
 Q5.000 NOT TO SCALE

CABLE SCHEDULE		
TYPE	WIRE DESCRIPTION	USAGE (TYPICAL)
A	3 PAIR, 18 AWG STRANDED, INDIVIDUALLY SHEILDLED AND DRAINED PAIRS	READER CABLE
B	1 PAIR, 18 AWG STRANDED	REX/DOOR CONTACT/CAMERA/AV POWER
C	RG 59-U COAXIAL CABLE 20 AWG CENTER COND, 95% OVERALL BRAID	VIDEO CABLE
D	1 PAIR, 16 AWG STRANDED	NETWORK CABLE
E	1 PAIR, 18 AWG STRANDED, SHIELDED	PTZ DATA

INTERNATIONAL SERVICES EXPANSION PROGRAM  
**APM STATION + PLATFORM**  
 SECURITY DETAILS AND POINT SCHEDULES

PROJECT MGR: W. GLOVER  
 DESIGNER: G. RESNICK  
 DRAWN BY: R. BUTLER  
 CHECKED BY:  
 DRAWING STANDARD:  
 ISEP 07.20.2000  
 SCALE: N/A  
 DATE: September 14, 2001


APPROVED BY: DATE:  
 DIRECTOR  
 HOUSTON AIRPORT SYSTEM

PROJECT NO. 1140  
 C.I.P. NO. A-0354  
 H.A.S. NO. 536C  
 SHEET NO. 1


**Q5.000**




REVISIONS			
NO.	DESCRIPTION	DATE	BY
1	ISSUED FOR BID	10/19/01	
2	BULLETIN #60 04/16/04	04/16/04	RB
3	ENTIRE SHEET REVISED		
4	RECORD DWGS	04/22/05	JW

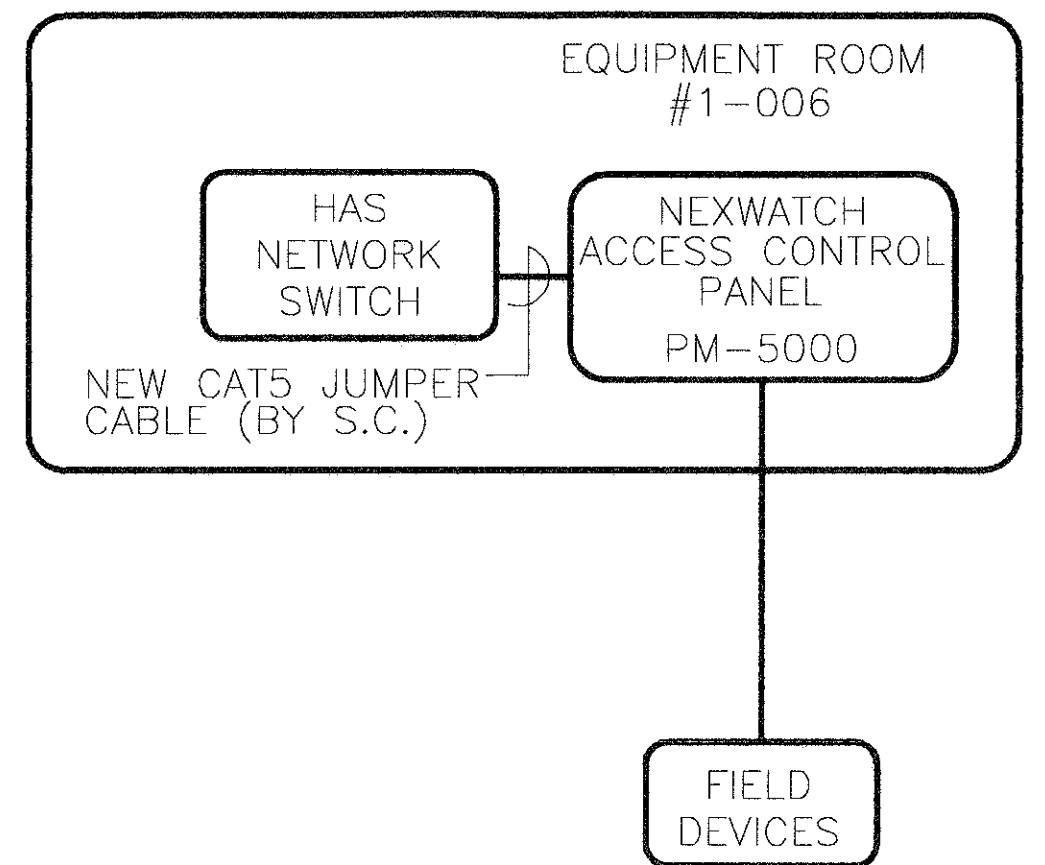


1 ACCESS CONTROL SYSTEM BLOCK DIAGRAM  
 Q5.100

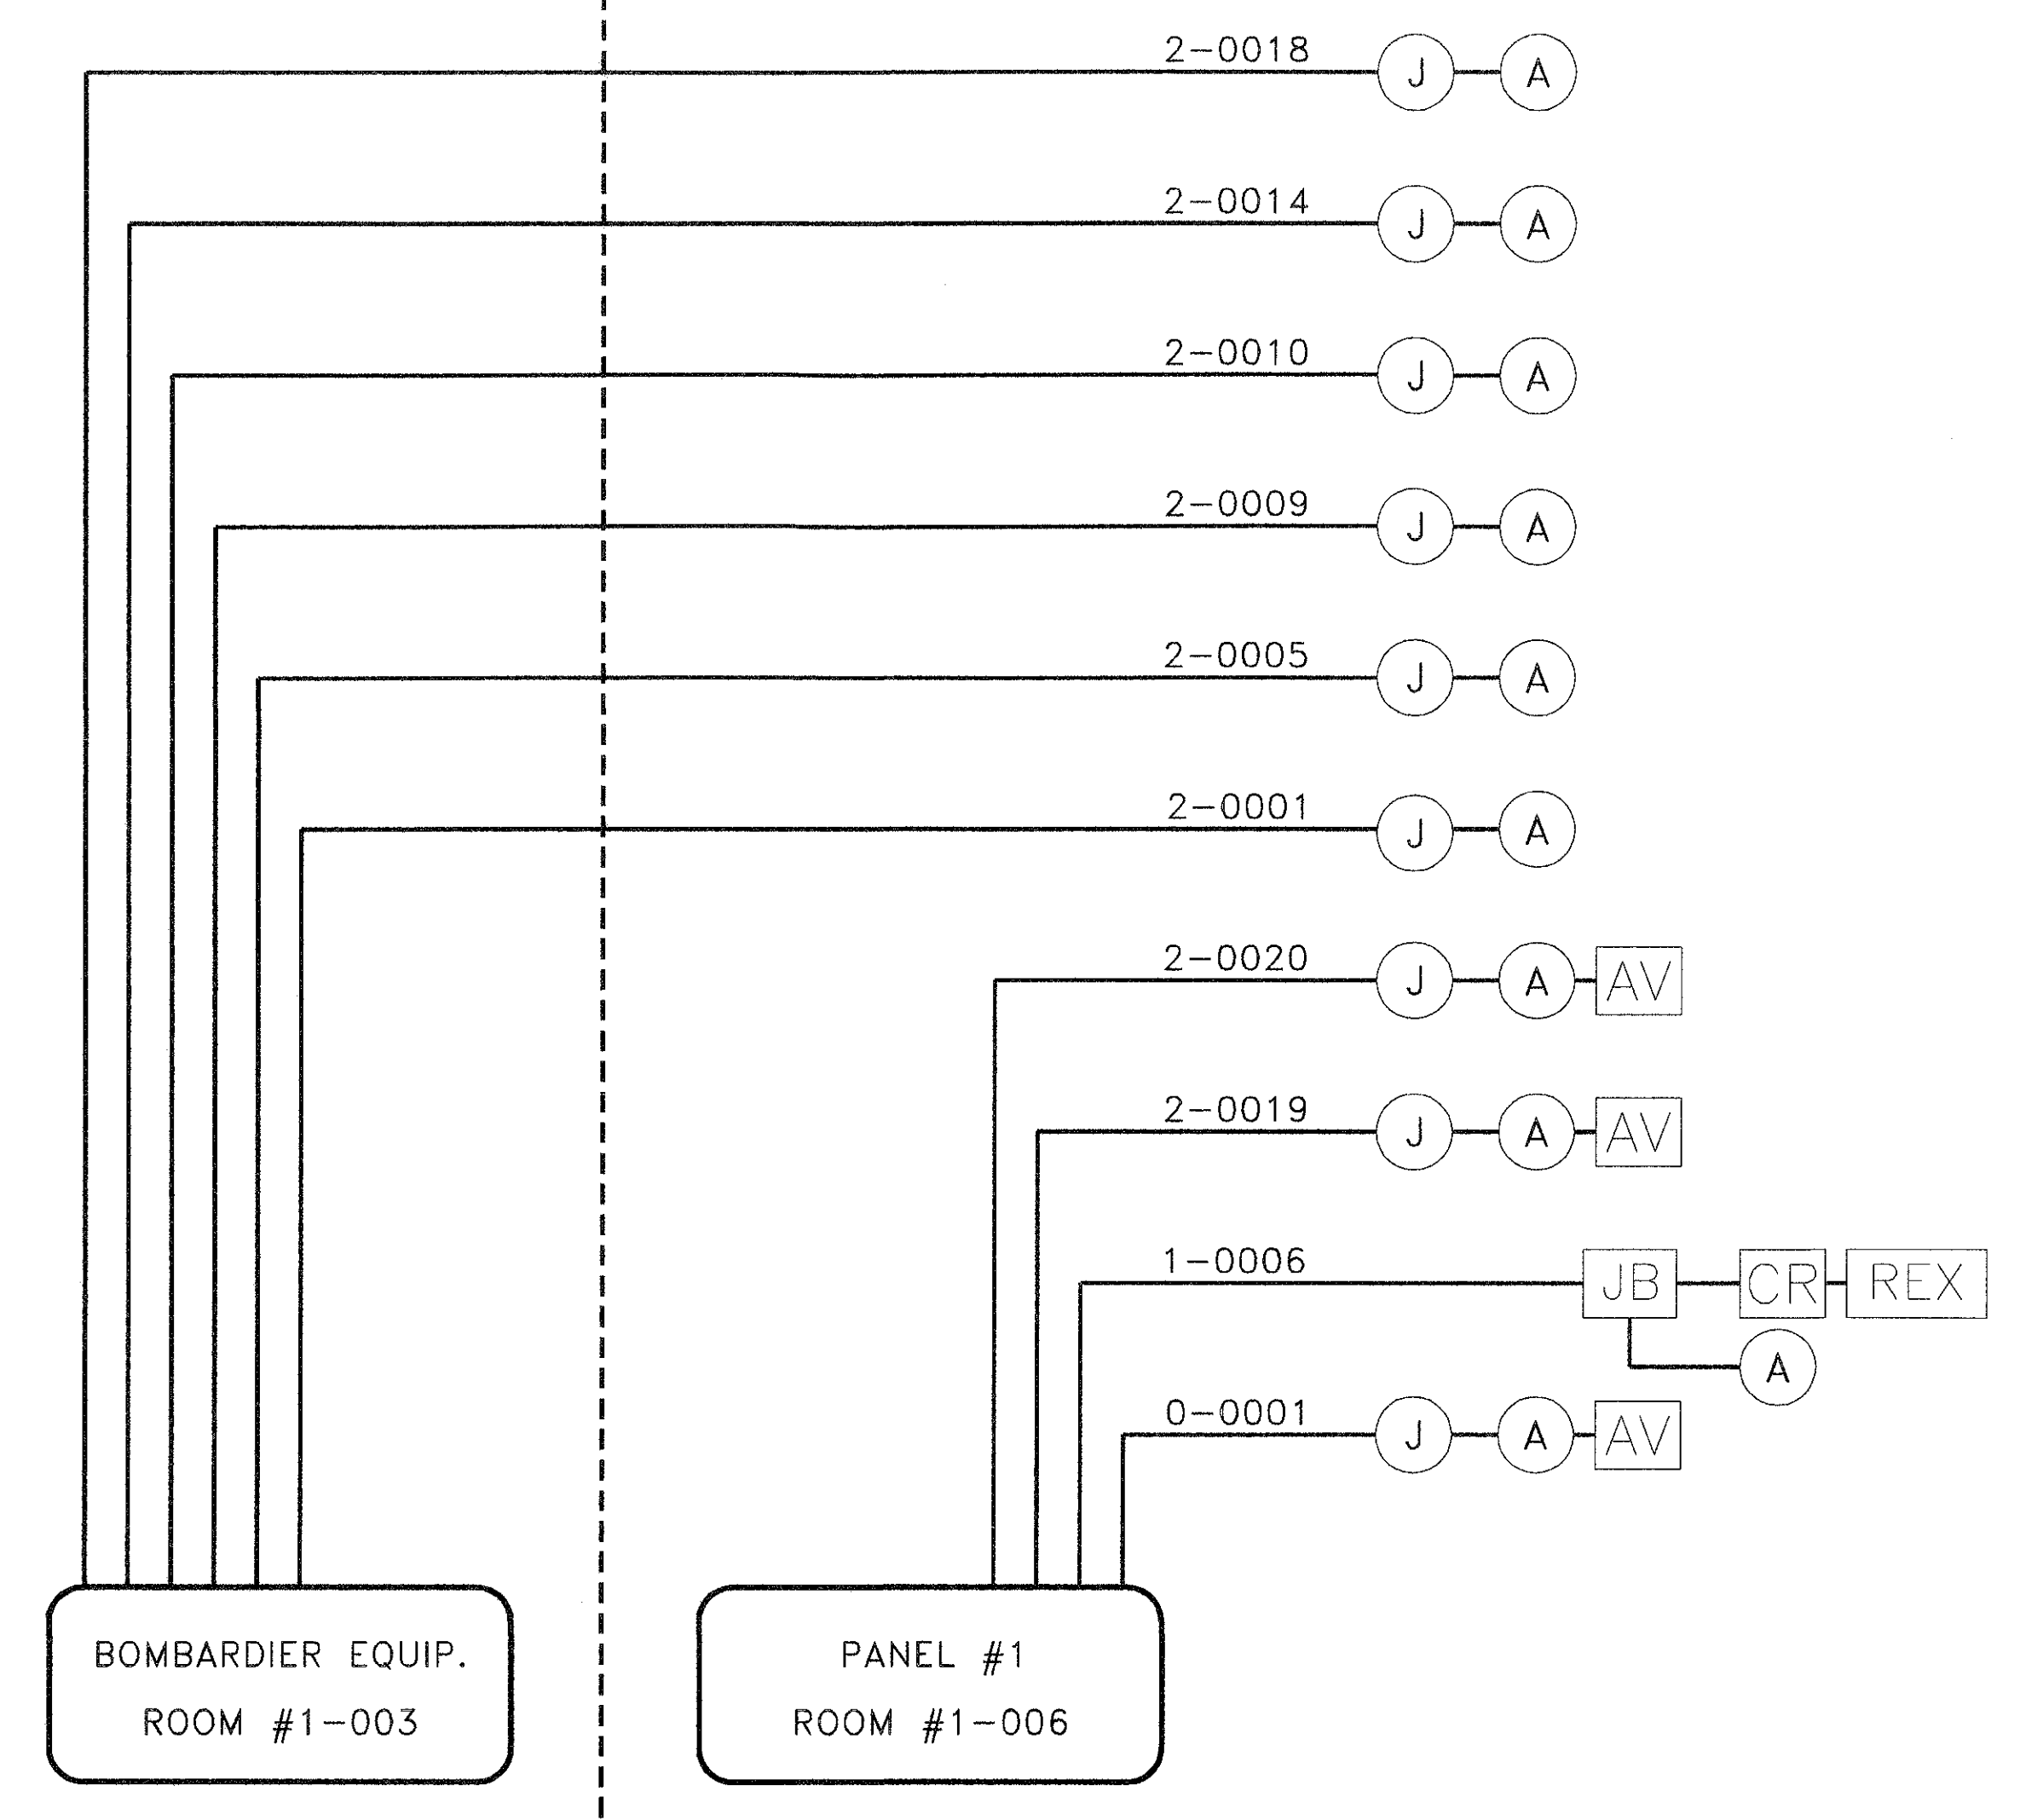

2 ACCESS CONTROL PANEL DIAGRAM  
 Q5.100

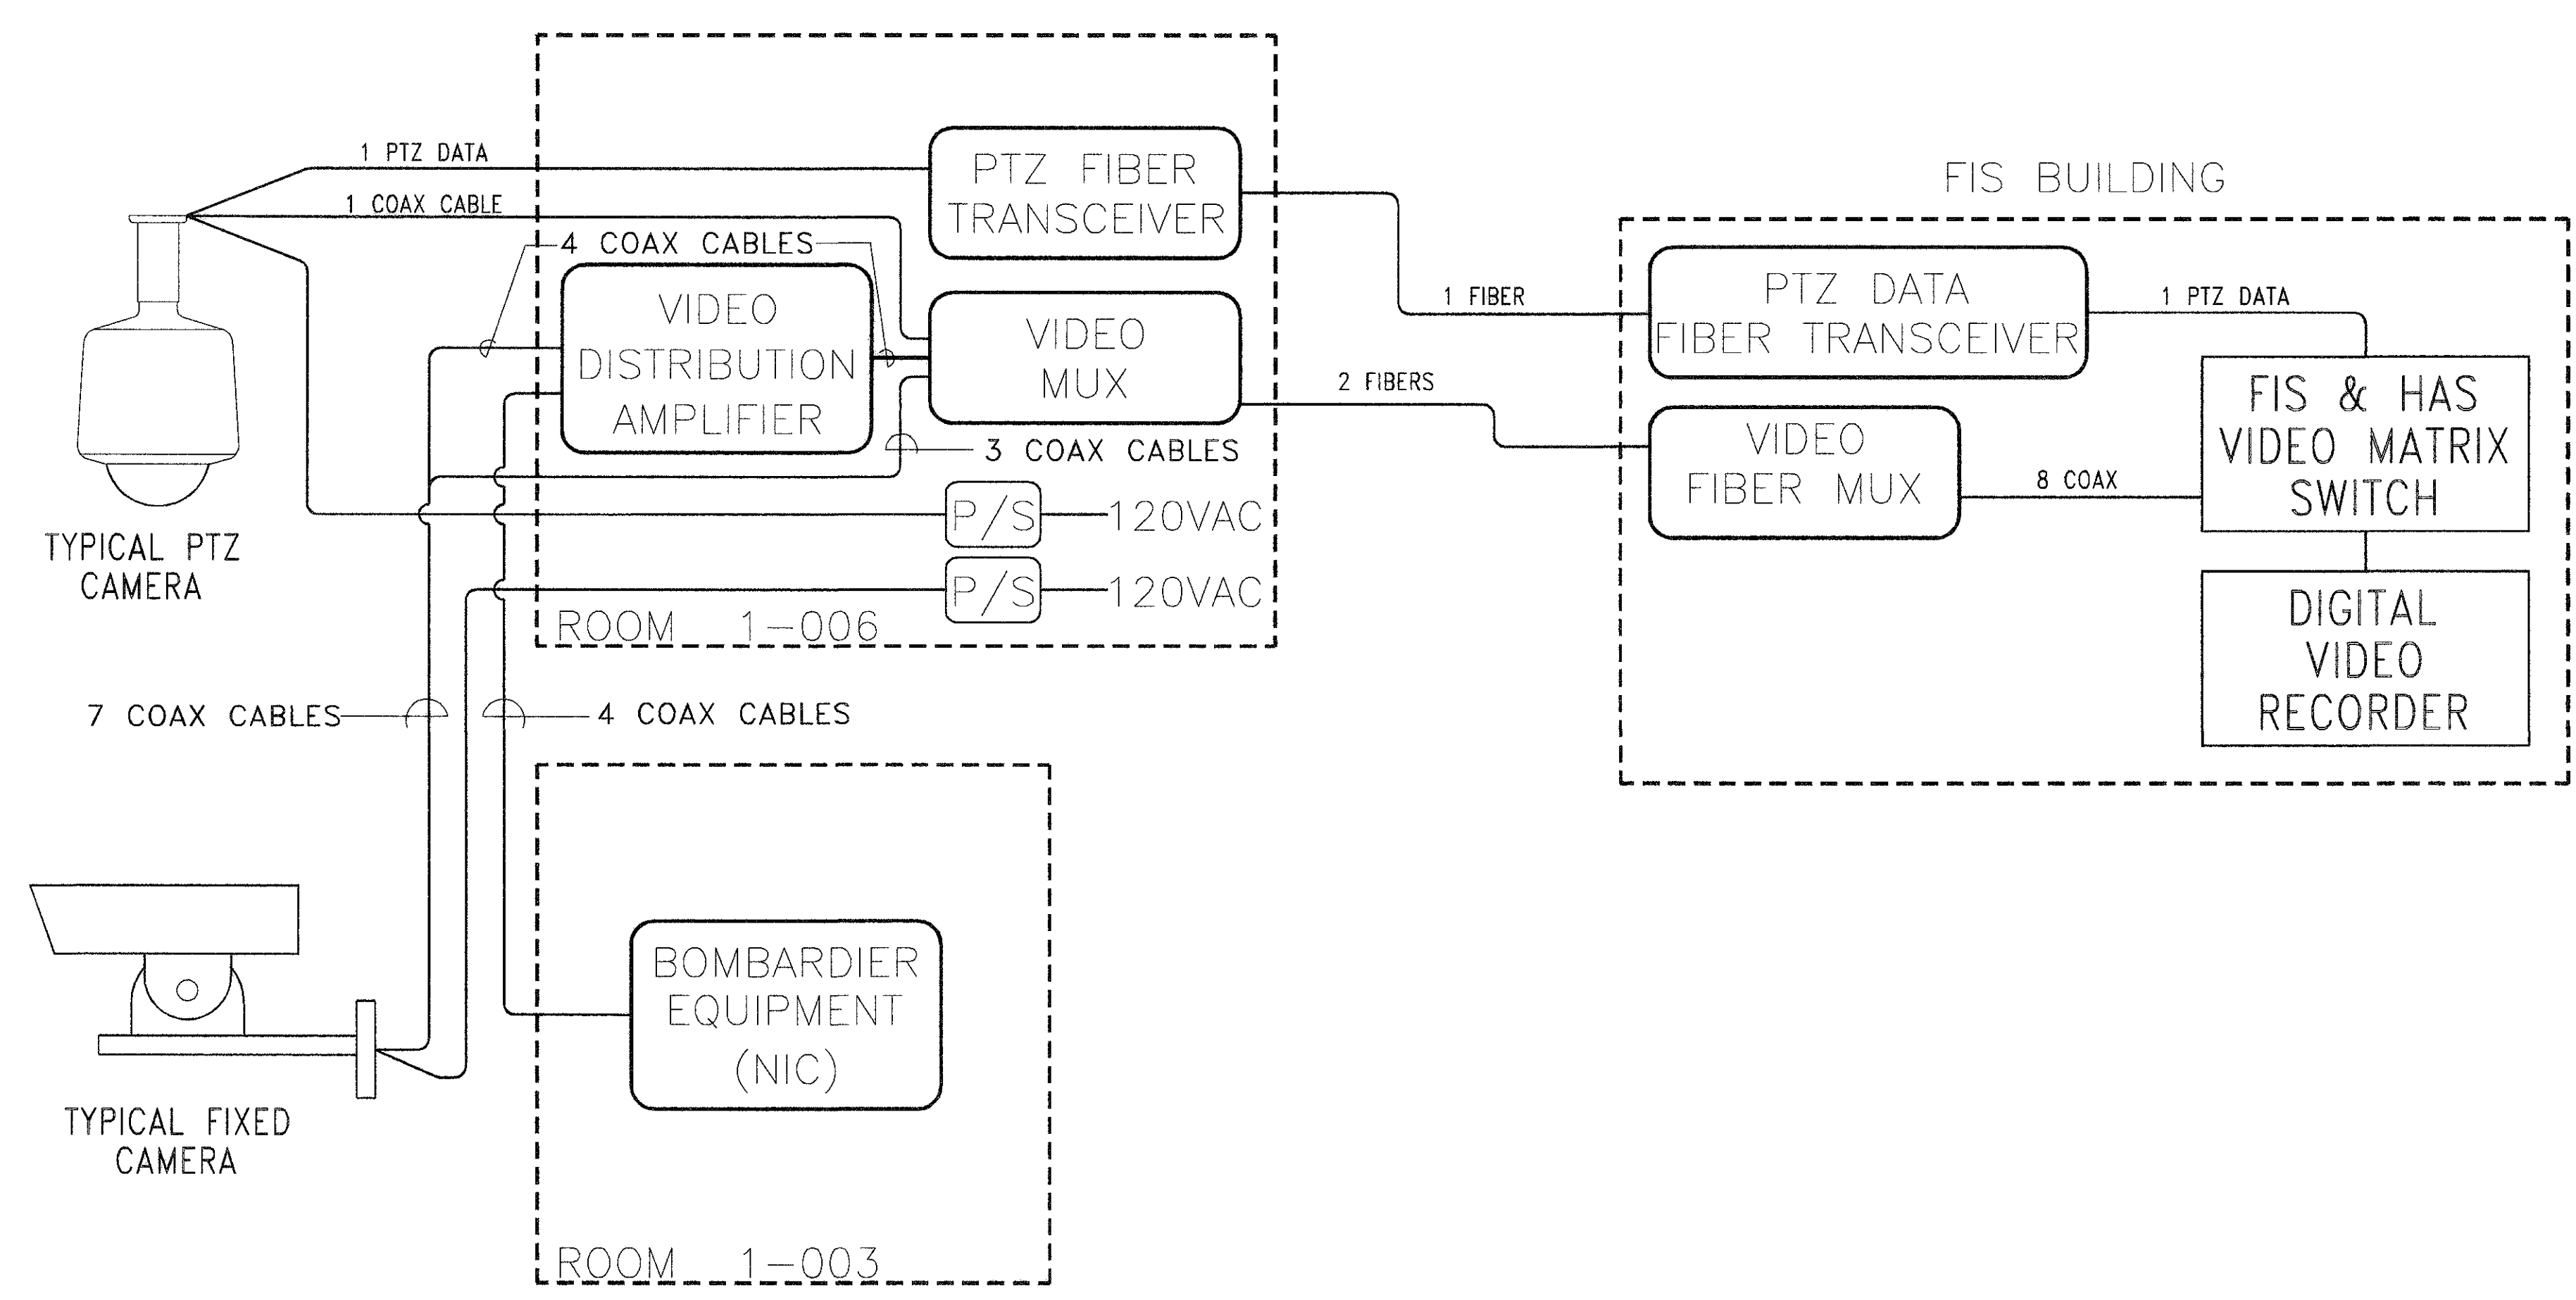

3 CCTV BLOCK DIAGRAM  
 Q5.100

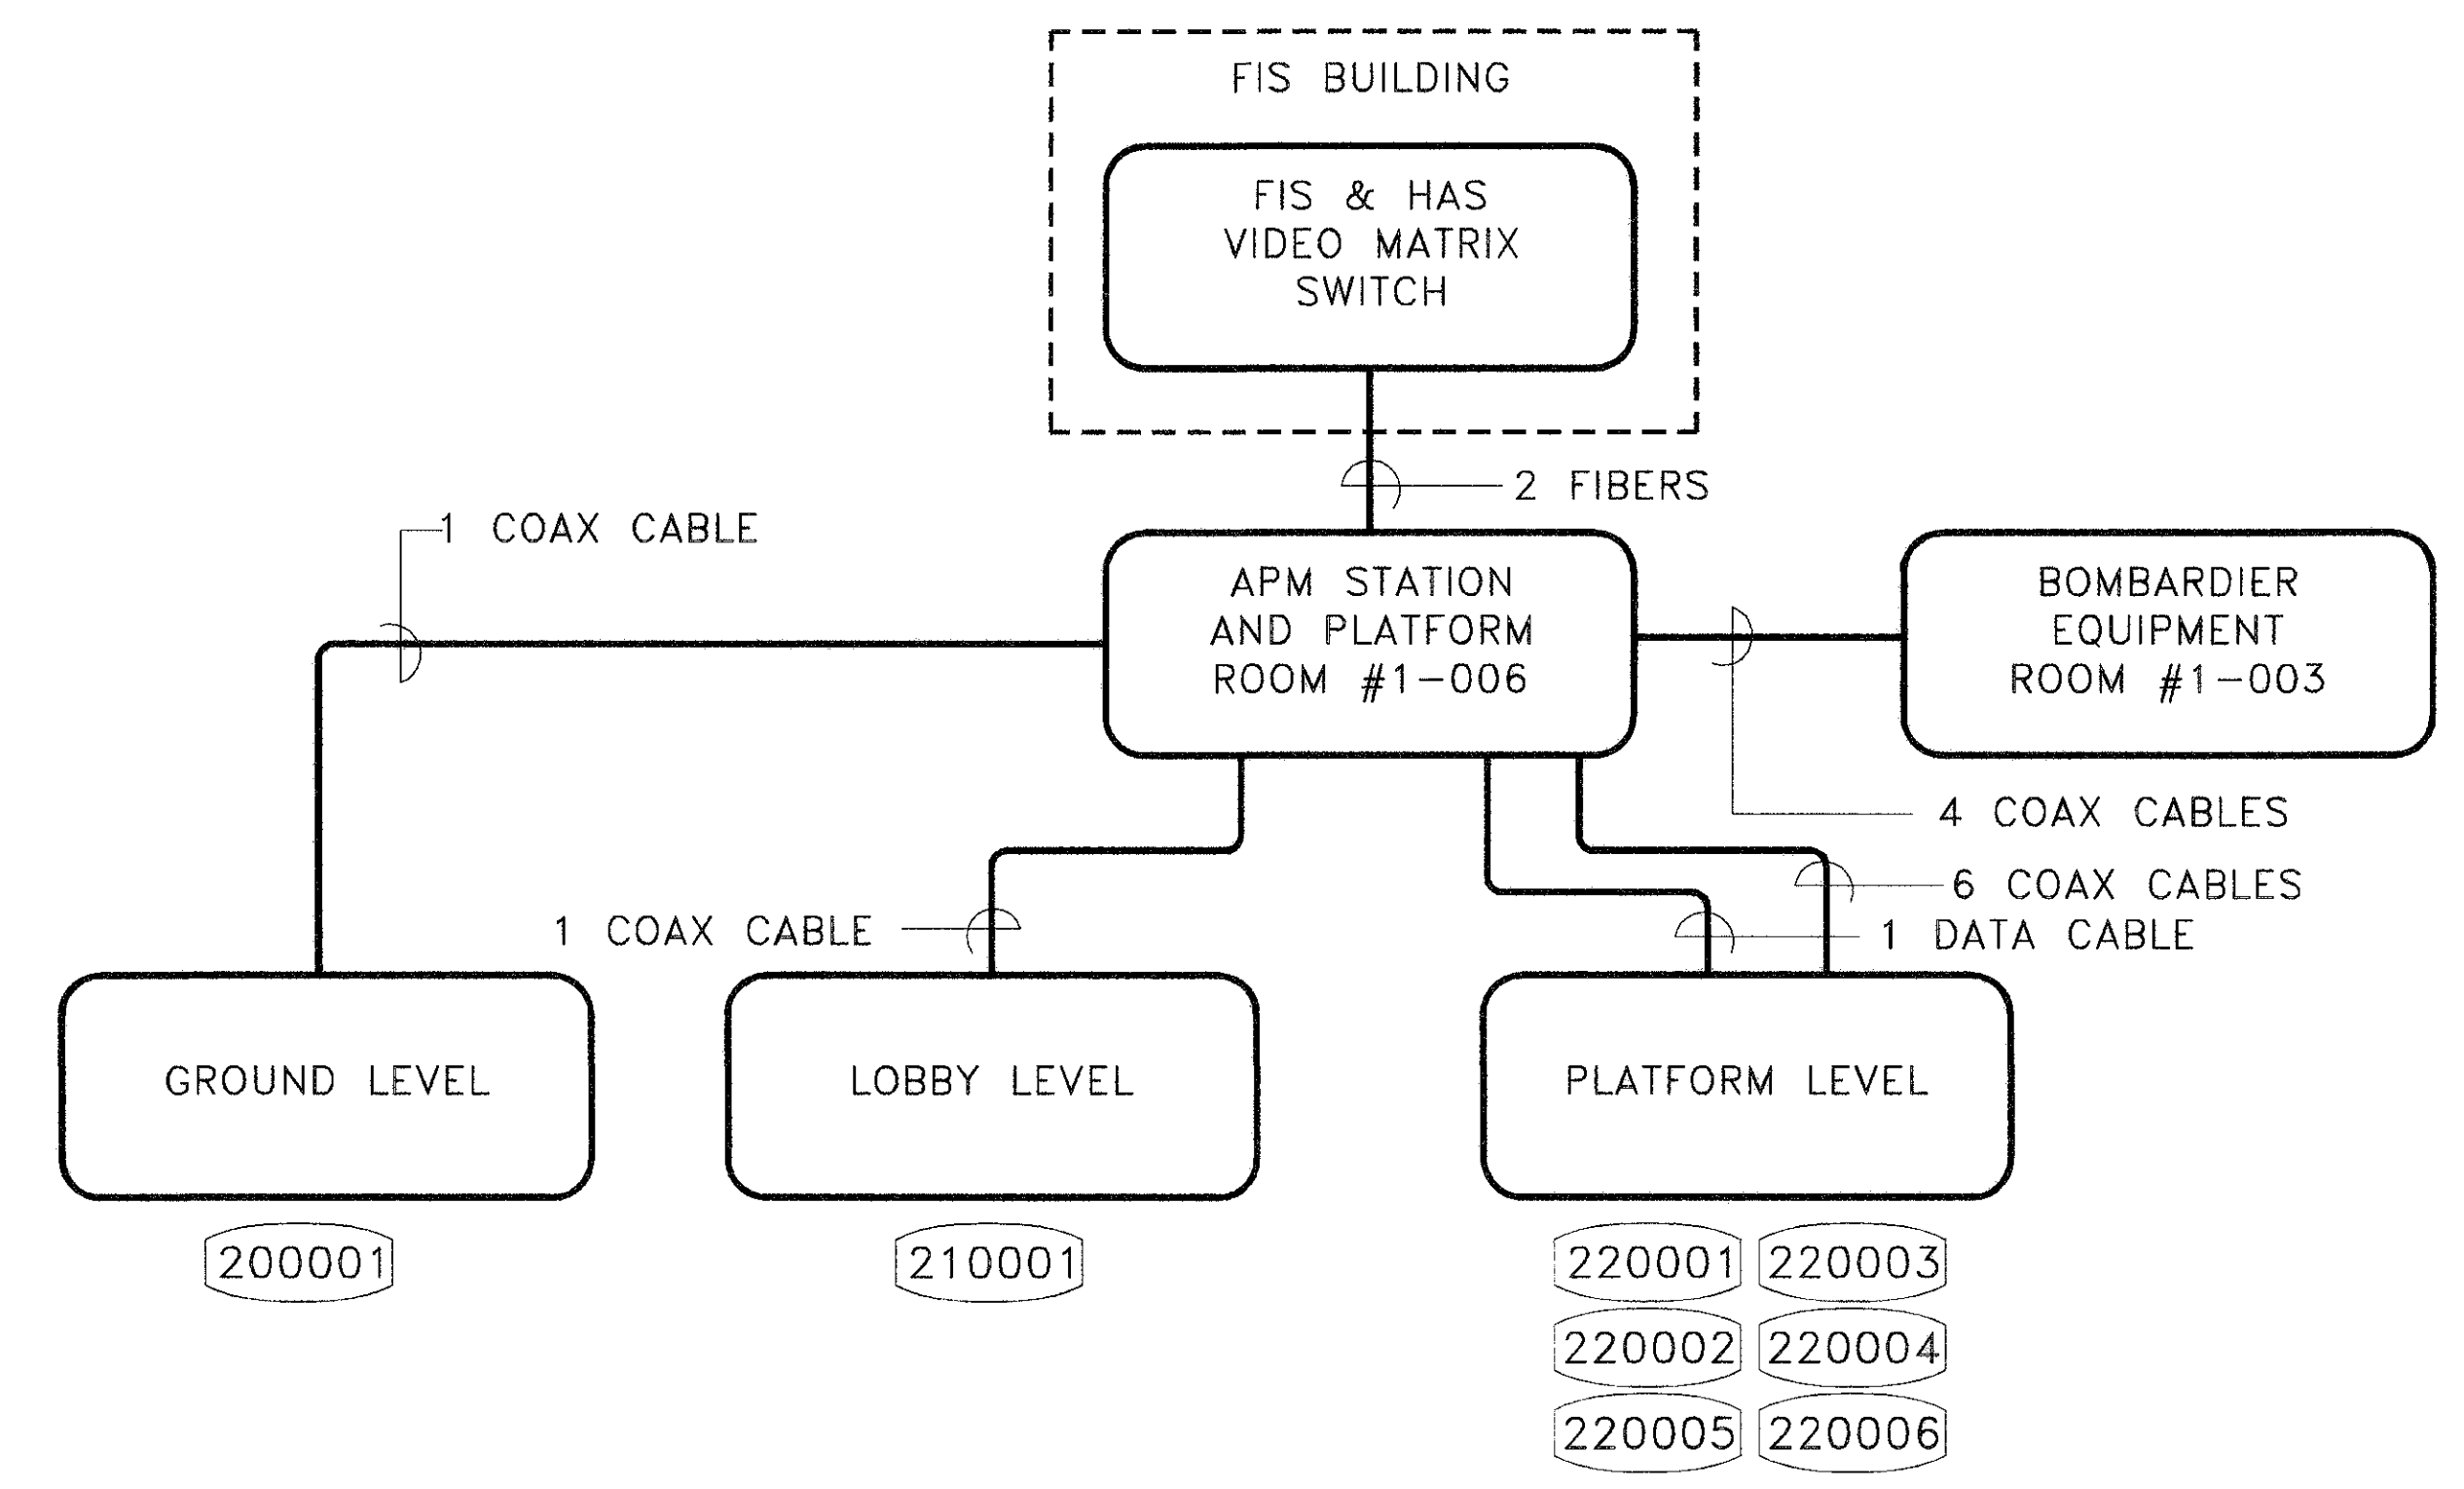

4 CCTV RISER DIAGRAM  
 Q5.100

INTERNATIONAL SERVICES EXPANSION PROGRAM  
**APM STATION + PLATFORM**  
 BLOCK AND RISER DIAGRAMS

PROJECT MGR:	W. GLOVER
DESIGNER:	G. RESNICK
DRAWN BY:	R. BUTLER
CHECKED BY:	
DRAWING STANDARD:	ISEP 07.20.2000
SCALE:	N/A
DATE:	September 14, 2001

APPROVED BY: \_\_\_\_\_ DATE: \_\_\_\_\_  
 DIRECTOR  
 HOUSTON AIRPORT SYSTEM

PROJECT NO.	1140
C.I.P. NO.	A-0354
H.A.S. NO.	536C
SHEET NO.	Q5.100




NO.	DESCRIPTION	DATE	BY
1	ISSUED FOR BID	10/19/01	
2	BULLETIN #60	04/16/04	RE
3	RECORD DWGS	04/22/05	JW

INTERNATIONAL • SERVICES • EXPANSION • PROGRAM  
**APM STATION + PLATFORM**  
 SECURITY EQUIPMENT CONFIGURATIONS


PROJECT MGR:	W. GLOVER
DESIGNER:	G. RESNICK
DRAWN BY:	R. BULLER
CHECKED BY:	
DRAWING STANDARD:	
ISDP:	07.20.2000
SCALE:	N/A
DATE:	September 14, 2001

APPROVED BY: \_\_\_\_\_ DATE: 9/14/01  
 ECW

PROJECT NO.	1140
C.I.P. NO.	A-0354
H.A.S. NO.	536C
SHEET NO.	Q5.101

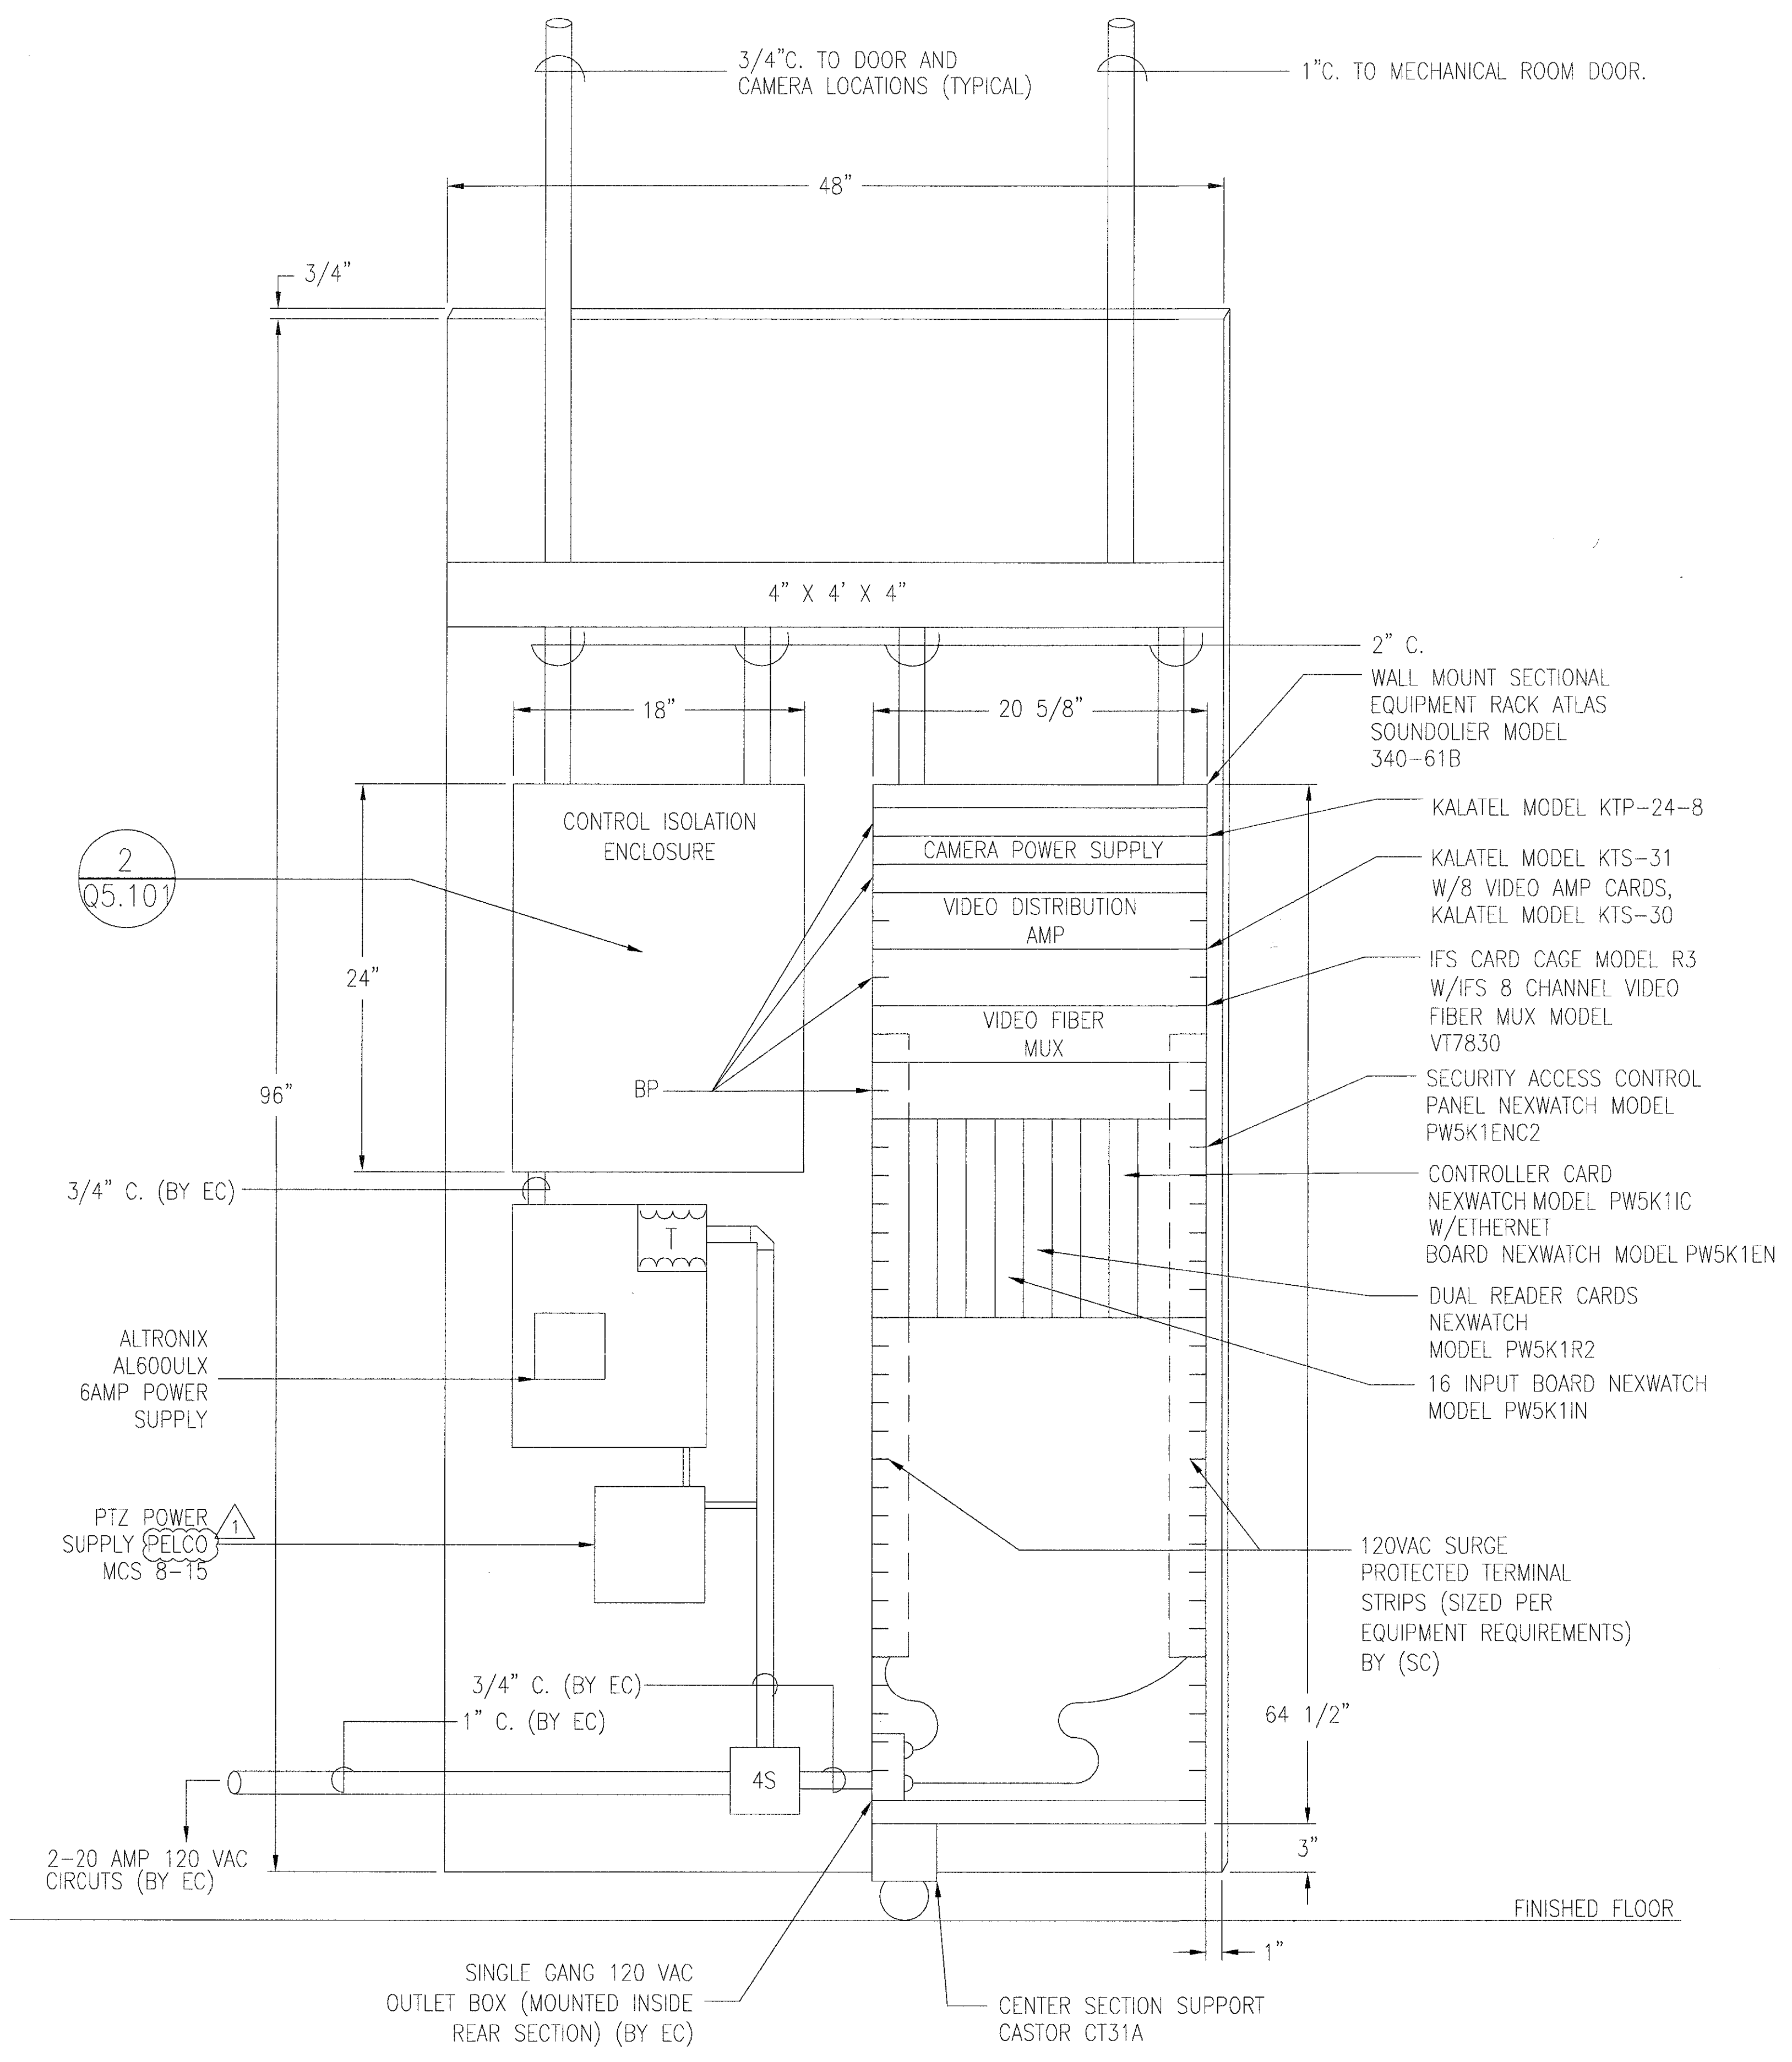

**1 ROOM #215 SECURITY EQUIPMENT LAYOUT**  
 Q5.101 NOT TO SCALE

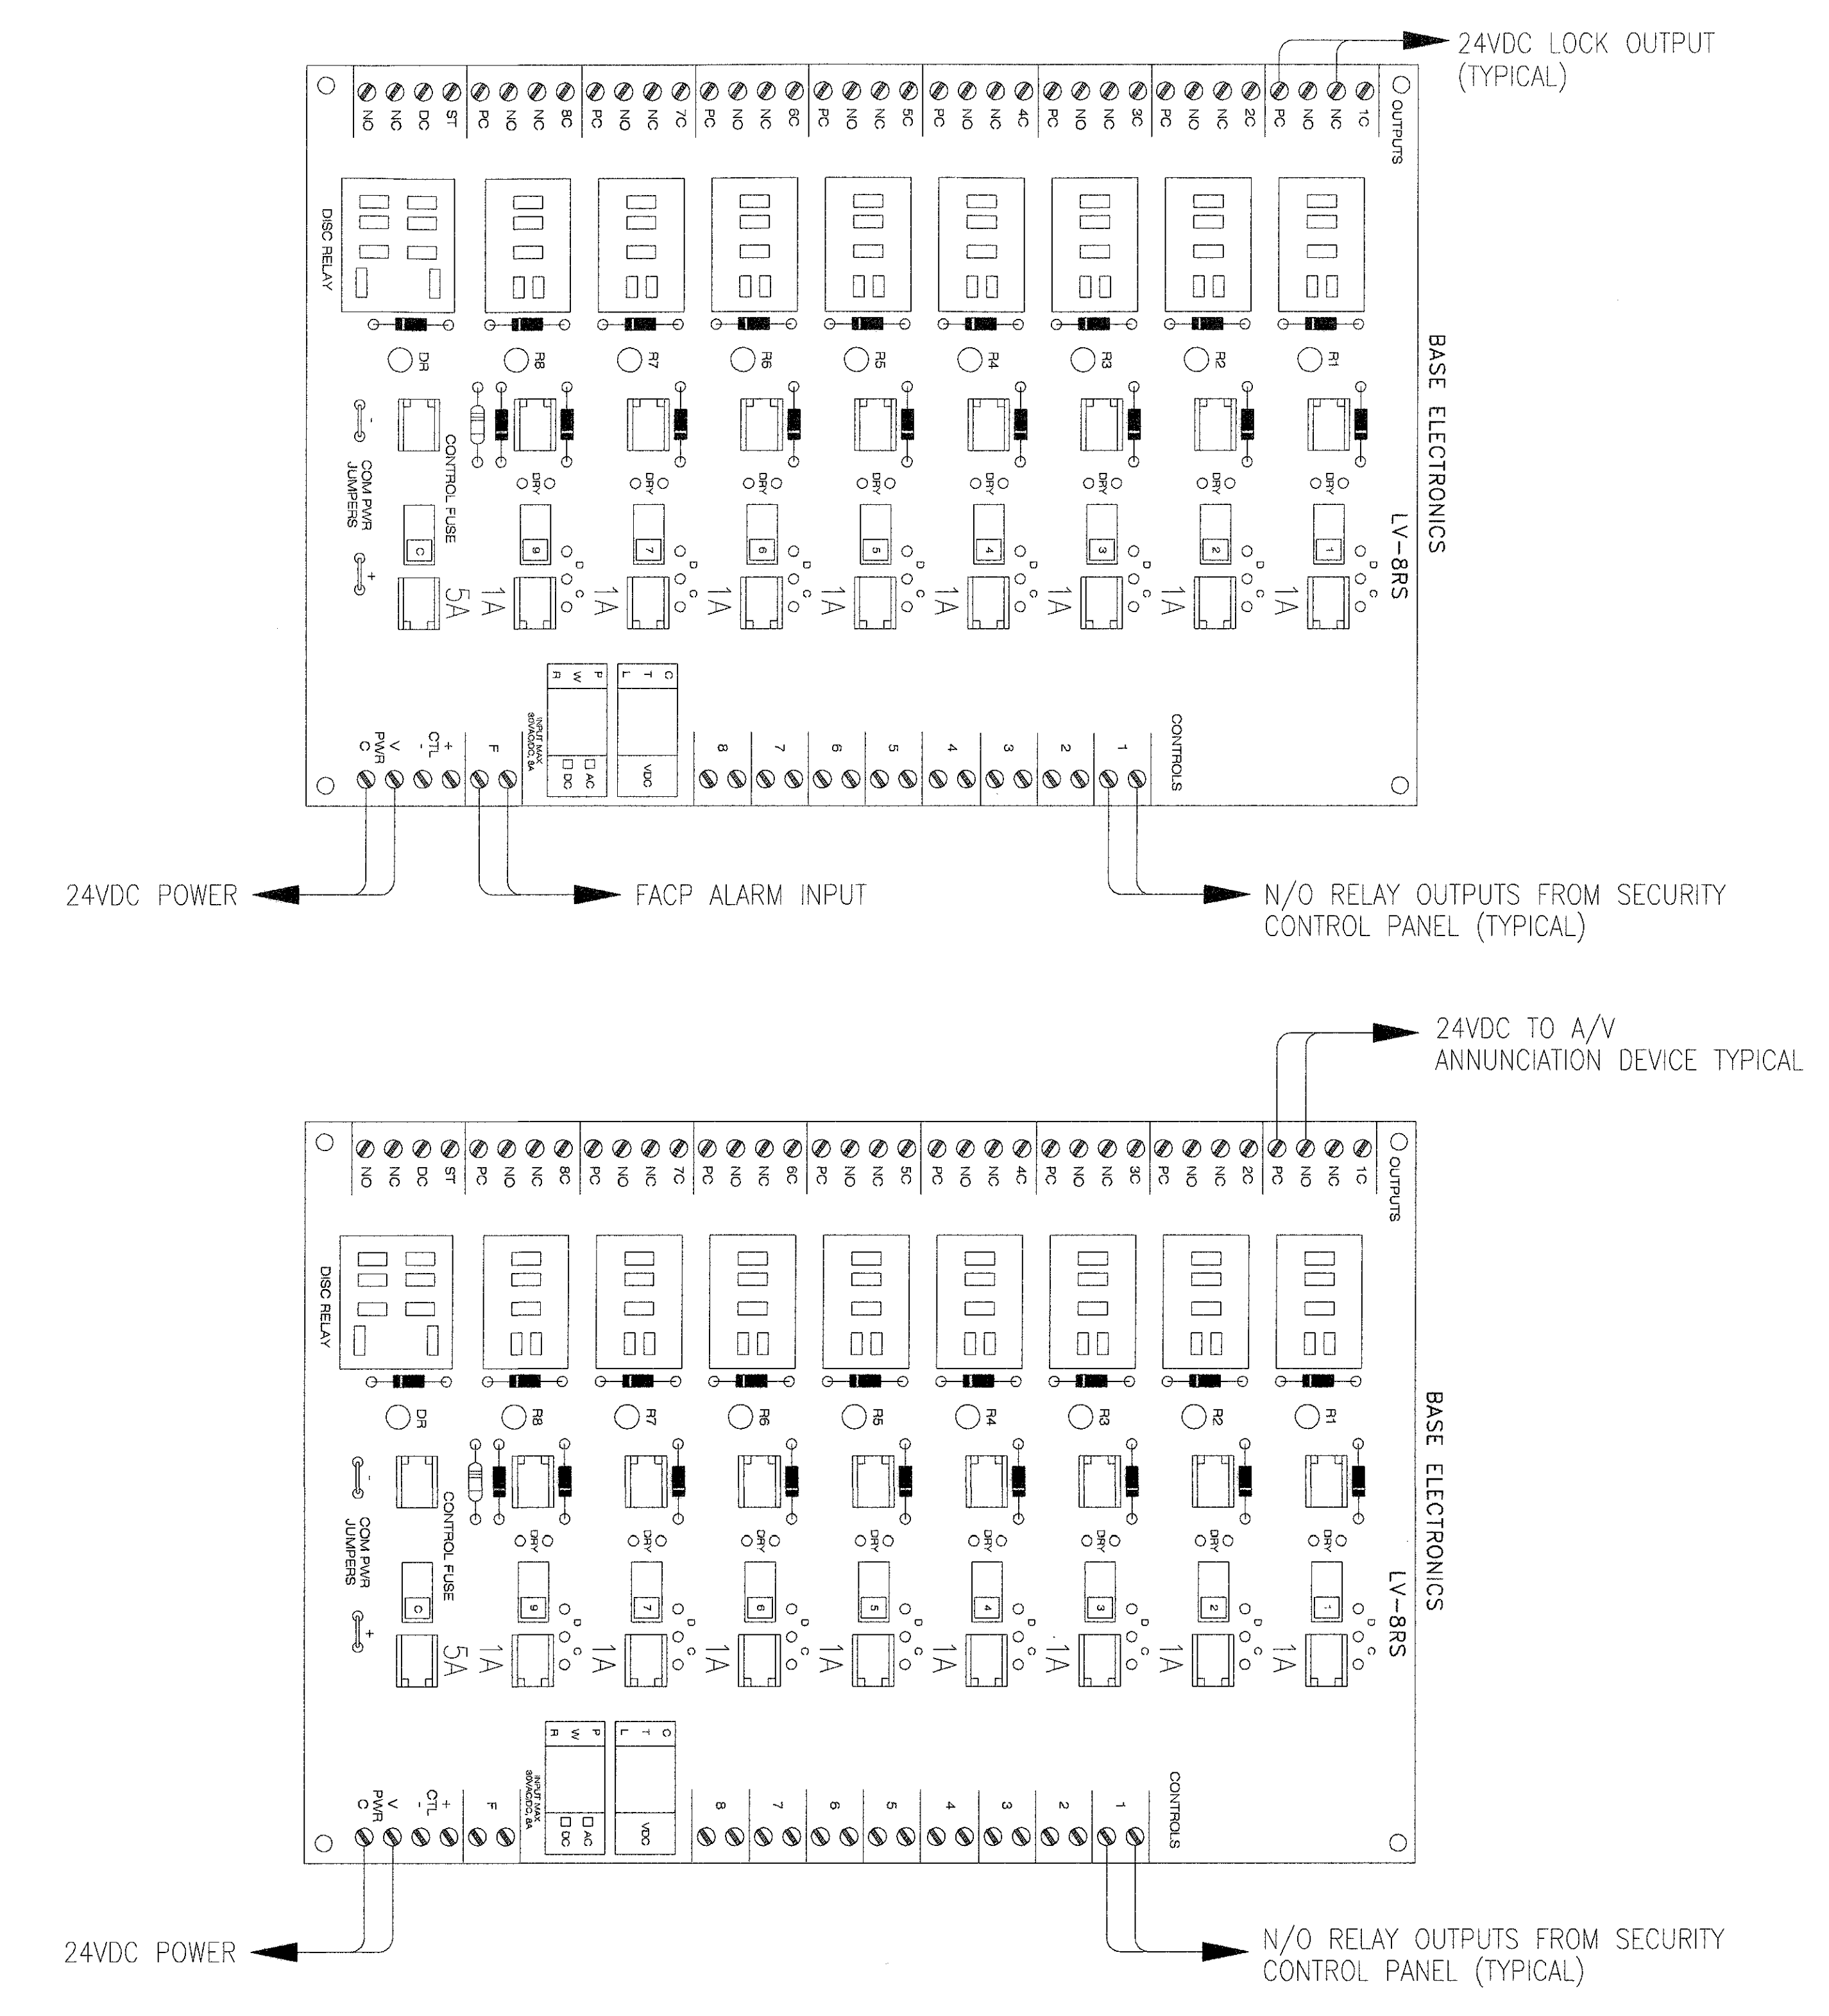

- NOTES:
1. PROVIDE IDEC RELAY FOR ALL RELAY BASES.
  2. PROVIDE FUSES AS INDICATED

**2 SECURITY EQUIPMENT RACK CONFIGURATION**  
 Q5.101 NOT TO SCALE



GENERAL NOTES

- DESIGN LOADS  
 DESIGN LIVE LOADS:  
 ROOF 20 PSF  
 MECHANICAL/EQUIPMENT ROOMS 100 PSF  
 CONDUIT/LOBBY 100 PSF  
 PLATFORM 100 PSF  
 VEHICLE LOAD IN ACCORDANCE WITH LOADS PROVIDED BY BOMBARDIER  
 WIND LOADS: 90 MPH BASIC SPEED (EXPOSURE C)  
 MAIN WIND FRAME 20 PSF  
 CONCRETE UPLIFT (NET) 40 PSF  
 DESIGN DEAD LOADS: WEIGHT OF STRUCTURE PLUS  
 MECHANICAL/ELECTRICAL LOADS WEIGHT OF EQUIPMENT FURNISHED + PADS  
 MECHANICAL/ELECTRICAL LOADS 8 PSF  
 MECHANICAL/ELECTRICAL LOADS 8 PSF  
 MECHANICAL/ELECTRICAL LOADS 8 PSF
- THE CONTRACTOR SHALL EXAMINE THE ARCHITECTURAL, MECHANICAL, PLUMBING, AND ELECTRICAL DRAWINGS FOR REQUIRED OPENINGS TO BE PROVIDED. VERIFY SIZE AND LOCATION OF ALL OPENINGS.
- ANY REQUIRED CHANGES TO THE STRUCTURE DUE TO THE ACCEPTANCE OF ALTERNATES AND/OR SUBSTITUTES IS THE RESPONSIBILITY OF THE CONTRACTOR AND SHALL BE SUBMITTED TO THE OWNER FOR APPROVAL.
- THE CONTRACTOR SHALL COMPARE STRUCTURAL SECTIONS WITH ARCHITECTURAL SECTIONS AND REPORT ANY DISCREPANCY TO THE OWNER PRIOR TO FABRICATION OR INSTALLING STRUCTURAL MEMBERS.
- DETAILS AND SECTIONS SHOWN FOR THE INDIVIDUAL STRUCTURES ARE INTENDED TO BE TYPICAL FOR THE STRUCTURE AND SHALL BE CONSIDERED TO APPLY TO ANY SIMILAR SITUATION UNLESS NOTED ON THE DRAWINGS EXCEPT WHERE SHOWN OTHERWISE. STANDARD DETAILS SHALL APPLY TO ALL STRUCTURES WHERE APPLICABLE.
- THE UNIFORM BUILDING CODE IS THE AUTHORITY HAVING JURISDICTION.
- SLOPE ALL CONCRETE SURFACES TO DRAIN TO FLOOR DRAINS, TRENCH DRAINS, ETC. MINIMUM SLOPE IS 1/8" PER FOOT, UNLESS SHOWN OTHERWISE.
- THE USE OF REPRODUCTIONS OF THESE CONTRACT DRAWINGS BY CONTRACTOR, SUB-CONTRACTOR, ERECTOR, FABRICATOR OR MATERIAL SUPPLIER IN LIEU OF PREPARATION OF SHOP DRAWINGS SIGNIFIES HIS ACCEPTANCE OF INFORMATION SHOWN AS CORRECT AND DELEGATES HIMSELF TO ANY EXPENSE, REAL OR IMPLIED, ARISING DUE TO THEIR USE.

FOUNDATION NOTES

- FOUNDATION DESIGN IS BASED ON THE GEOTECHNICAL INVESTIGATION (SOIL REPORT) AS FOLLOWS:  
 "FINAL GEOTECHNICAL EVALUATION REPORT FOR THE AUTOMATED PEOPLE MOVER (APM) (APM) AT GEORGE BUSH INTERCONTINENTAL AIRPORT, ATISER PROJECT NO. H1-24-008 H1-24-008 DATED MARCH 29, 2001."  
 THE SOIL REPORT IS AVAILABLE TO THE GENERAL CONTRACTOR UPON REQUEST TO THE OWNER. THE INFORMATION INCLUDED THEREIN MAY BE USED BY THE GENERAL CONTRACTOR FOR HIS GENERAL INFORMATION ONLY. THE ARCHITECT AND ENGINEER AND OWNER WILL NOT BE RESPONSIBLE FOR THE ACCURACY OR APPLICABILITY OF SUCH DATA THEREIN.


EMBEDS IN CONCRETE ELEMENTS NOTES

- EMBED SUPPLIER SHALL PREPARE SHOP DRAWINGS BASED ON STRUCTURAL AND ARCHITECTURAL DETAILS AND GENERAL REQUIREMENTS OF THE CONTRACT DOCUMENTS. INDICATE SPECIFIC LOCATIONS, SIZES, ETC. THESE DRAWINGS SHALL BE USED TO INSTALL EMBEDS.
- UNLESS NOTED OTHERWISE, ALL WELD PLATES SHALL BE 3/4" THICK.
- CONTRACTOR TO COORDINATE WITH EMBED SUPPLIER AND VARIOUS TRADES AND PRODUCT SUPPLIERS AND PROVIDE NECESSARY INFORMATION TO EMBED SUPPLIER SO THAT SHOP DRAWINGS CAN BE PREPARED.
- WHEREVER SPACE PERMITS, ALL WELD PLATES SHALL BE INSTALLED SO THAT STUDS LINE UP VERTICALLY.
- MINIMUM WELD SIZE TO ATTACH SUPPORTED STEEL ANGLES, CHANNELS, CHANNELS, POSTS HANGERS, BRACKETS, ETC., SHALL BE 1/4" CONTINUOUS FILLET WELD.
- PROVIDE ERECTION BOLTS, GUSSET PLATES, ETC., IF REQUIRED.
- EMBEDS DIRECTLY EXPOSED TO WEATHER SHALL BE GALVANIZED.

PRESTRESSED CONCRETE BEAM NOTES

- DESIGNED IN ACCORDANCE WITH CURRENT A.A.S.H.T.O. SPECIFICATIONS.
- ALL CONCRETE FOR PRESTRESSED CONCRETE BEAM SHALL BE CLASS II.
- WHEN SHOWN ON THE DRAWINGS, THE FABRICATOR HAS THE OPTION OF FURNISHING EITHER THE DESIGNED DEPRESSED STRAND BEAM OR AN APPROVED OPTIONAL BEAM DESIGN USING STRESS RELIEVED OR LOW RELAXATION STRANDS. OPTIONAL DESIGN FOR BEAMS 120 FOOT OR LONGER SHALL HAVE A CALCULATED RESIDUAL CAMBER EQUAL TO OR GREATER THAN THAT OF THE DESIGNED BEAM.
- PRESTRESS LOSSES FOR THE DESIGNED BEAMS HAVE BEEN CALCULATED ACCORDING TO THE CURRENT A.A.S.H.T.O. STANDARD AND INTERIM SPECIFICATIONS. A RELATIVE HUMIDITY OF 75% OPTIONAL DESIGN SHALL LIKEWISE CONFORM.
- CERTAIN BEAMS WITH DEPRESSED STRANDS ARE SUBJECT TO CRACKING IN THE END OF THE BEAM. WHEN SUCH CRACKS OCCUR, ALL SUBSEQUENT BEAMS OF THE SAME TYPE AND STRAND PATTERN SHALL HAVE STRANDS WRAPPED IN THE FOLLOWING MANNER:  
 A. ALTERNATE ROWS OF DEPRESSED STRANDS SHALL BE WRAPPED FOR 2 FEET FROM EACH END OF THE BEAM.  
 B. ONE HALF OF THE STRAIGHT STRANDS, AS NEARLY AS POSSIBLE, SHALL BE WRAPPED FOR 4 FEET FROM EACH END OF THE BEAM.  
 C. THE WRAPPING PATTERN SHALL BE SYMMETRICAL ABOUT THE VERTICAL AXIS OF THE BEAM FOR BOTH DEPRESSED AND STRAIGHT STRANDS.  
 D. STRANDS SHALL BE WRAPPED SO THAT THE CENTERS OF GRAVITY OF THE DEPRESSED STRANDS AND THE STRAIGHT STRANDS WILL REMAIN WITHIN 1 INCH OF THEIR ORIGINAL LOCATION.  
 E. STRANDS SHALL BE TIGHTLY WRAPPED WITH PLASTIC TUBING. BOTH ENDS AND THE SEAM OF THE TUBE SHALL BE SEALED WITH WATERPROOF TAPE.  
 F. REVERSED SHOP DRAWINGS WILL NOT BE REQUIRED.
- FOR DEPRESSED STRAND DESIGNED BEAMS, STRANDS SHALL BE LOCATED AS LOW AS POSSIBLE ON THE 2" GRID SYSTEM SHOWN HEREON UNLESS A NON-STANDARD STRAND PATTERN IS INDICATED. FULL ROW "2", THEN ROW "4", THEN ROW "6", ETC., BEGINNING EACH ROW IN THE "A" POSITION AND WORKING OUTWARD UNTIL THE REQUIRED NUMBER OF STRANDS IS REACHED. ALL STRANDS IN THE "A" POSITION SHALL BE DEPRESSED, MAINTAINING THE 2" SPACING SO THAT THE UPPER TWO STRANDS ARE IN THE POSITION SHOWN IN THE TABLE AT THE BEAM ENDS.
- INITIAL PRETENSION FOR 1/2" 270 K STRANDS = 28.9 K FOR STRESS RELIEVED STRANDS OR 31.0 K FOR LOW RELAXATION STRANDS.
- DESIGN SHOWN BASED ON INITIAL PRETENSION OF 31.0 K.

SYMBOLS

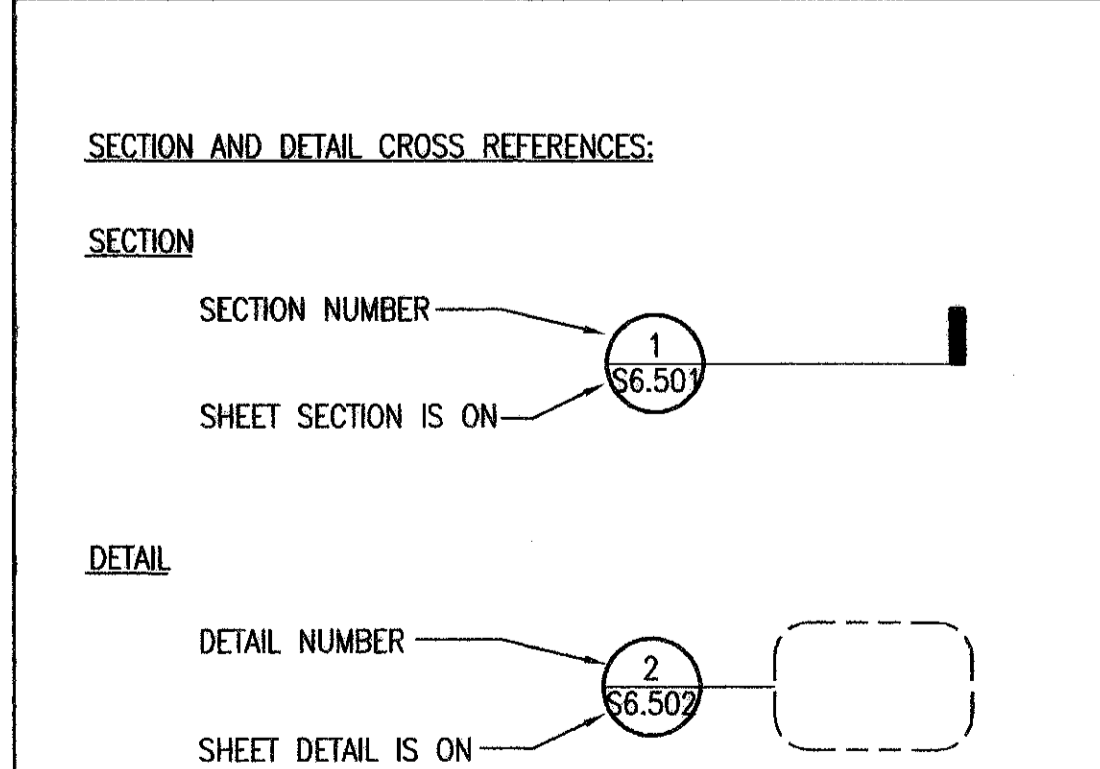

CONCRETE NOTES

- CONCRETE CONSTRUCTION SHALL BE IN ACCORDANCE WITH THE AMERICAN CONCRETE INSTITUTE BUILDING CODE REQUIREMENTS FOR REINFORCED CONCRETE, ACI 318 AND COMMENTARY (LATEST EDITION).
- CONCRETE SHALL HAVE 28-DAY COMPRESSIVE STRENGTH OF 4000 PSI.
- ALL CONCRETE SHALL BE NORMAL WEIGHT CONCRETE AND SHALL WEIGH NO MORE THAN 150 PCF. SEE CONCRETE SPECS FOR SLUMP REQUIREMENTS.
- DETAILING, FABRICATION AND ERECTION OF REINFORCED BARS SHALL COMPLY WITH ACI "MANUAL OF STANDARD PRACTICE FOR DETAILING REINFORCED CONCRETE STRUCTURES" (ACI 315).
- STEEL REINFORCING BARS SHALL BE DEFORMED BARS CONFORMING TO ASTM A 615, GRADE 60.
- PROVIDE TWO NO. 5 X 4" -0" BAR AT RE-ENTRANT CORNERS, PLACED ON THE DIAGONAL WITH 1-INCH CLEARANCE FROM CORNER AND TOP OF SLAB INCLUDING ANY RECTILINEAR HOLES.
- ALL EQUIPMENT HOUSEKEEPING PADS SHALL BE 6" THICK UNLESS SHOWN OTHERWISE REINFORCED WITH #3 @ 12" EW, DOWEL TO SLAB WITH #3 DOWELS @ 24" EW FOR SIZES AND LOCATIONS OF PADS. SEE MECHANICAL, ELECTRICAL, AND PLUMBING DRAWINGS AND SPECIFICATIONS, UNLESS NOTED OTHERWISE.
- FOR LOCATION, SIZE AND TYPE OF EMBEDDED INSERTS REQUIRED FOR HANGER CONNECTION POINTS TO CONCRETE STRUCTURE FOR MECHANICAL OR ELECTRICAL PIPE, DUCTS, PLUMBING, FIRE SPRINKLER, CONDUIT, EQUIPMENT, ETC., REFER TO MECHANICAL, PLUMBING OR ELECTRICAL CONTRACT DOCUMENTS.
- LAP CONTINUOUS REINFORCING BARS - PER SCHEDULE.  
 1. EXCEPT AS OTHERWISE SHOWN, PROVIDE A CLEAR COVER MEASURED FROM REINFORCEMENT TO THE FACE OF THE CONCRETE AS LISTED:  
 SURFACES MINIMUM COVER IN INCHES  
 INTERIOR NOT EXPOSED TO WEATHER SLABS AND WALLS 3/4  
 BEAMS 1-1/2  
 EXTERIOR NOT IN CONTACT WITH EARTH OR WATER SLABS AND WALLS, NO. 5 AND SMALLER BARS 1  
 SLABS AND WALLS, NO. 8 THRU NO. 11 BARS FORMED SURFACES 1-1/2  
 BEAMS 2  
 EXTERIOR FORMED SURFACES IN CONTACT WITH EARTH OR WATER SLAB AND WALLS NO. 5 AND SMALLER BARS 1-1/2  
 BEAMS 2  
 FOOTINGS SLABS AND WALLS, NO. 6 THRU NO. 11 2-1/2  
 TOP AND SIDES 3  
 BOTTOM 3  
 ALL SURFACES CAST AGAINST AND PERMANENTLY EXPOSED TO EARTH 3
- BEAM WIDTH AND DEPTH DIMENSIONS SHOWN ARE FOR FORMED CONDITIONS. IF THE BEAMS ARE CAST AGAINST "EARTH FORMS" THE WIDTH SHALL BE INCREASED 2" AND THE DEPTH 1" AND ALL STEEL SHALL HAVE A MINIMUM 3" CLEAR COVER.
- THE LOCATION OF CONSTRUCTION JOINTS SHALL BE AS SHOWN ON THE DRAWINGS AND/OR APPROVED BY THE OWNER. CONSTRUCTION JOINTS SHALL BE MADE IN THE CENTER OF SPANS WITH VERTICAL BULKHEADS UNLESS NOTED OTHERWISE. THERE SHALL BE NO HORIZONTAL CONSTRUCTION JOINTS IN CONCRETE PILES.
- PROVIDE FULL EMBEDMENT WITH 90° HOOKS FOR ALL DOWELS UNLESS SHOWN OTHERWISE. DOWEL SIZE AND SPACING IS SAME AS MAIN REINFORCING.
- HORIZONTAL WALL REINFORCEMENT SHALL BE CONTINUOUS WITH 90-DEGREE BENDS AND 12-INCH RETURNS ALONG EACH WALL AT CORNERS, UNLESS SHOWN OTHERWISE.
- NO CONCRETE SHALL BE PLACED IN THE GUIDEWAY SLAB UNTIL THE DIAPHRAGMS ARE IN PLACE. THE DIAPHRAGM CONCRETE HAS REACHED A MINIMUM 28 DAY COMPRESSIVE STRENGTH OF 4000 P.S.I., AND THE NUTS OF BARS ON HAVE SUBSEQUENTLY BEEN FIRMLY TIGHTENED.

STEEL NOTES


- STEEL SHAPES AND PLATES SHALL CONFORM TO ASTM A 36 UNO. STEEL TUBES SHALL CONFORM TO ASTM A500, GRADE B. STEEL PIPES SHALL CONFORM TO ASTM A53 GRADE B.
- DETAIL, FABRICATION AND ERECTION OF STRUCTURAL STEEL SHALL COMPLY WITH THE AISC "SPECIFICATIONS FOR THE DESIGN, FABRICATION AND ERECTION OF STRUCTURAL STEEL FOR BUILDINGS, "AS" CODE OF STANDARD PRACTICE" AS MODIFIED IN THE PROJECT SPECIFICATION, AND ALL UPDATING PUBLICATIONS, MIN WELD SHALL BE 5/16" FILLET.
- UNLESS SHOWN OTHERWISE ON THE DRAWINGS, CONNECTIONS SHALL BE FIELD WELDED. BOLTS SHALL CONFORM TO ASTM A325. CONNECTION SHALL BE A MINIMUM OF TWO BOLTS. CONNECTIONS NOT DETAILED OR NOTED SHALL BE AS FOLLOWS: BEAM TO BEAM OR BEAM TO COLUMN CONNECTIONS SHALL CONFORM TO "FRAME BEAM CONNECTIONS" OR "SINGLE PLATE SHEAR CONNECTIONS" PART 4 OF AISC MANUAL AND SHALL BE DESIGNED FOR THE SHEAR LISTED IN THE TABLE FOR ALLOWABLE LOADS ON BEAMS" PART 2 AISC MANUAL, UNLESS NOTED OTHERWISE. PIPE TO PIPE CONNECTIONS SHALL BE FIELD WELDED. COPE PIPE END TO FIT THE CURVED SURFACE.
- WELDING SHALL CONFORM TO THE AMERICAN WELDING SOCIETY "STRUCTURAL WELDING CODE," LATEST EDITION. ELECTRODES SHALL CONFORM TO AWS A5.5, E70XX. ULTRASONIC INSPECTION SHALL BE PROVIDED FOR ANY FULL PENETRATION WELDS.
- ALL MISCELLANEOUS WELDS (FIELD OR SHOP) SHALL BE MINIMUM SIZE FILLET ALL AROUND IN ACCORDANCE WITH AISC. WELDING OF CONTINUOUS MEMBERS SHALL BE A MINIMUM OF 3-INCHES OF 3/16-INCH FILLET STITCH WELD AT 12-INCHES O.C., STAGGERED EACH SIDE, UNLESS OTHERWISE NOTED.
- SPACING OF STRUCTURAL STEEL MEMBERS IS PROHIBITED WITHOUT THE APPROVAL OF THE OWNER AS TO LOCATION AND TYPE OF SPLICE.
- ANCHOR BOLTS SHALL COMPLY WITH ASTM A 307 UNO AND SHALL BE SET USING RIGID TEMPLATES. PROVIDE ANCHOR BOLTS FOR ALL EQUIPMENT WHEN ANCHOR BOLTS ARE NOT PROVIDED BY THE MANUFACTURER. ANCHOR BOLTS SIZE AND LENGTH SHALL CONFORM TO THE REQUIREMENTS AND/OR RECOMMENDATIONS OF THE EQUIPMENT MANUFACTURER. PROVIDE TEMPLATES TO ACCURATELY POSITION THE ANCHOR BOLTS.
- BURNING OF HOLES IN STRUCTURAL STEEL IS PROHIBITED. ANY MEMBER WITH BURNED HOLES SHALL BE REPLACED.
- STRUCTURAL STEEL SHALL BE PUNCHED FOR WOOD BLOCKING AND MILLERS. SEE ARCHITECT'S DRAWINGS.
- GROUT UNDER BASE PLATE SHALL BE NON-SHRINK GROUT. PRE GROUTING OF THE BASE PLATES WILL NOT BE PERMITTED.
- SEE ARCHITECTURAL DRAWINGS AND SPECIFICATIONS FOR FIREPROOFING REQUIREMENTS.
- EXAMINE THE ARCHITECTURAL AND STRUCTURAL DRAWINGS FOR ALL ITEMS REQUIRED TO BE HOT-DIP GALVANIZED AFTER FABRICATION. GALVANIZING DAMAGED IN FIELD SHALL HAVE DAMAGE REPAIRED AS SPECIFIED.
- WELD 3/8" COP PLATE TO THE TOP OF ALL COLUMNS.

STEEL DECK


- CONFORM TO SPECIFICATIONS OF THE STEEL DECK INSTITUTE LATEST EDITION.
- TYPE - ASTM A446 GRADES A THRU E OR A611 GRADES C THRU E AND A525, G60.
- ROOF DECK:  
 - FOR SPAN 11'-6" OR LESS: 3" DEEP, TYPE N, 22 GA. GALV.  
 - FOR SPAN OVER 12': 3" DEEP, TYPE N, 20 GA. GALV.
- FORM DECK (PMDF) AT GUIDEWAY SLAB: 2" DEEP SEE NOTE AND DETAIL ON S5-502.

ROOF CONSTRUCTION

- SUSPEND NO MECHANICAL, ELECTRICAL, PLUMBING OR OTHER EQUIPMENT FROM METAL DECK.
- FURNISH ALL SIZES AND LOCATIONS OF ROOF OPENINGS TO SUIT ACTUAL MECHANICAL EQUIPMENT PURCHASED.
- LOCATION OF ROOF TOP MOUNTED UNITS NOT SHOWN ON STRUCTURAL DRAWINGS ARE SUBJECT TO REVIEW BY THE ARCHITECT.
- OPENINGS OVER 10' - USE L3 1/2x3 1/2x 1/4 FRAME.

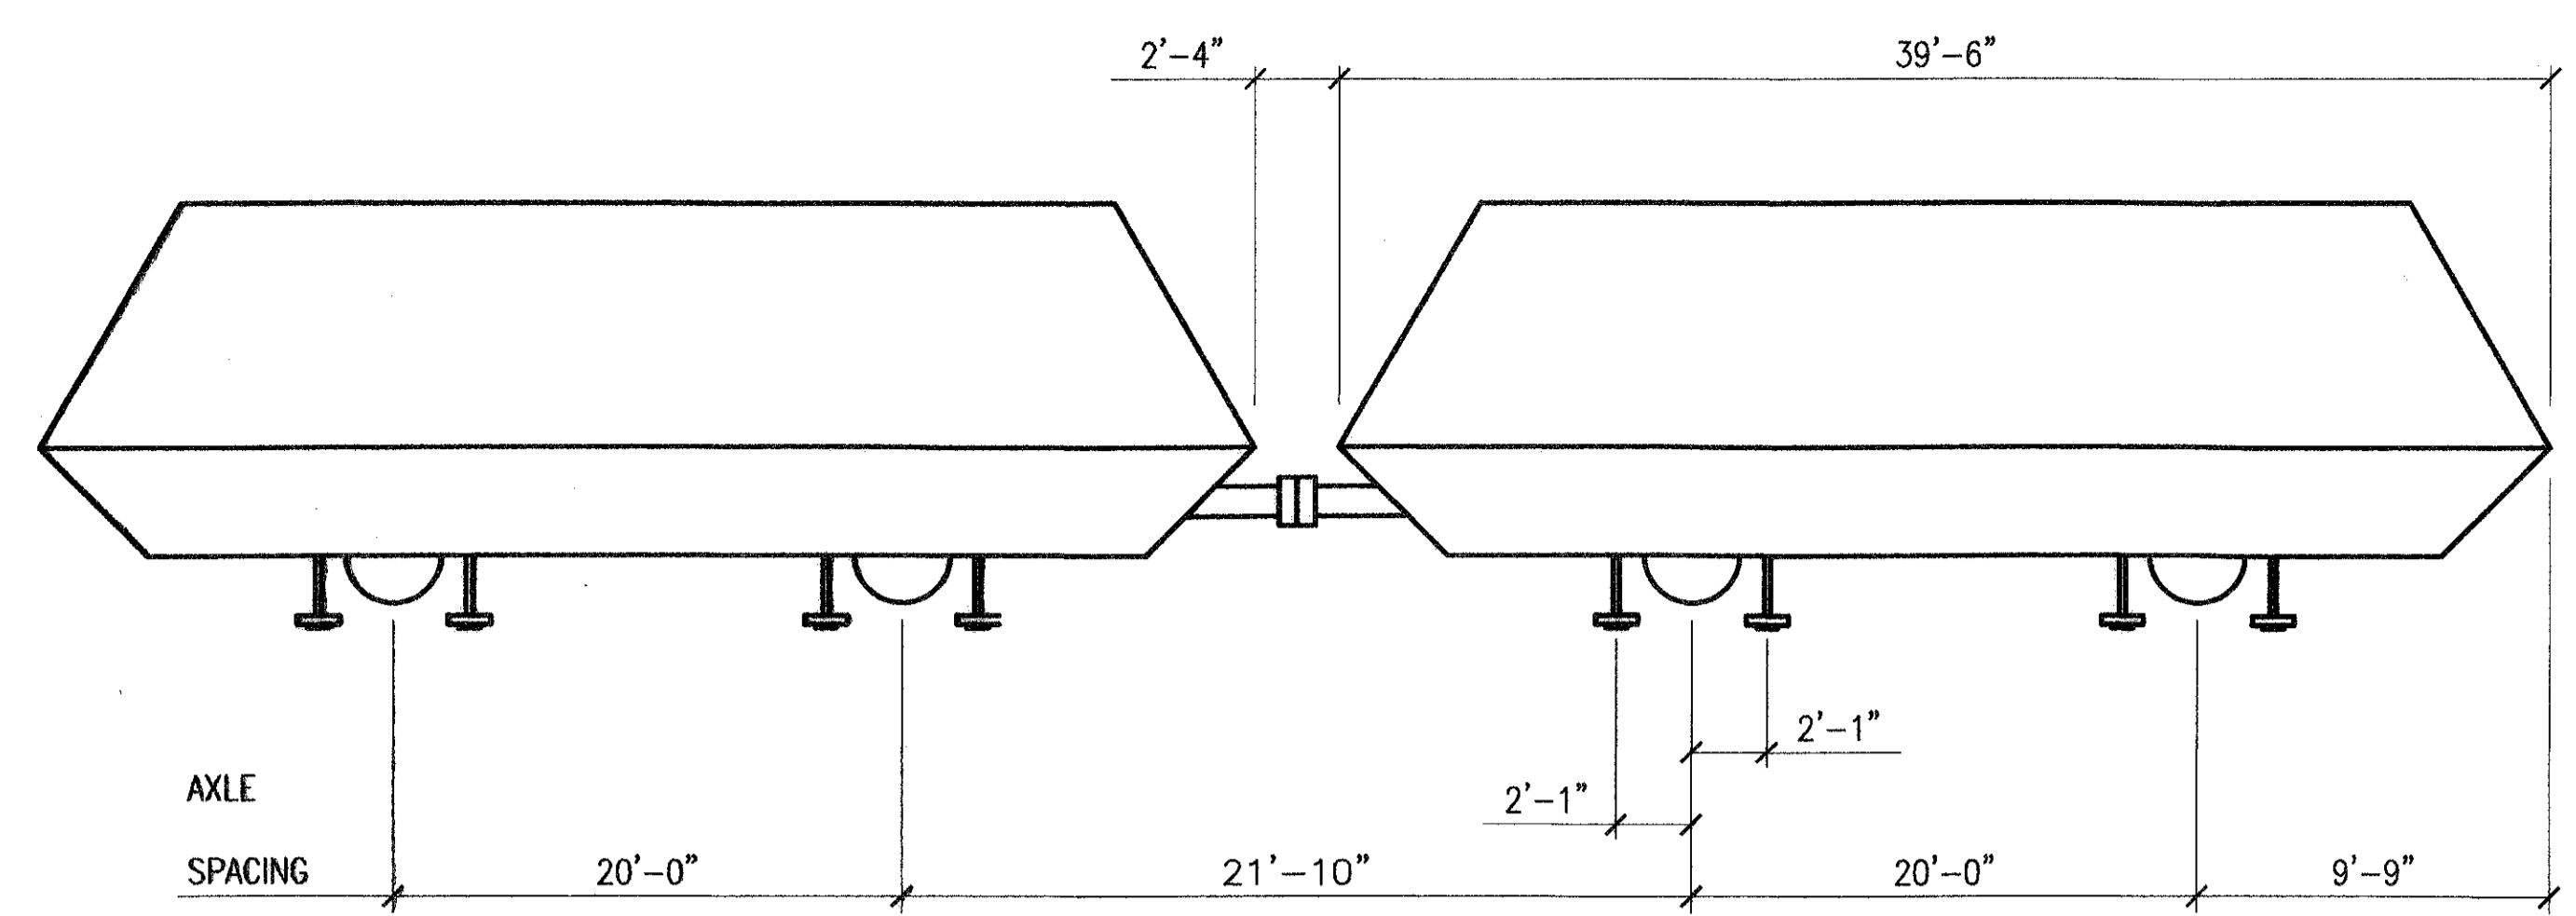

	AXLE LOAD	AXLE LOAD	AXLE LOAD	AXLE LOAD	Y
AWO EMPTY VEHICLE	16.5 KIPS	16.5 KIPS	16.5 KIPS	16.5 KIPS	44.0"
AW1 NORMAL LOAD (100 PASSENGERS @ 160 LBS)	24.5 KIPS	24.5 KIPS	24.5 KIPS	24.5 KIPS	54.0"
AW2 MAXIMUM LOAD (150 PASSENGERS @ 160 LBS)	28.5 KIPS	28.5 KIPS	28.5 KIPS	28.5 KIPS	59.0"

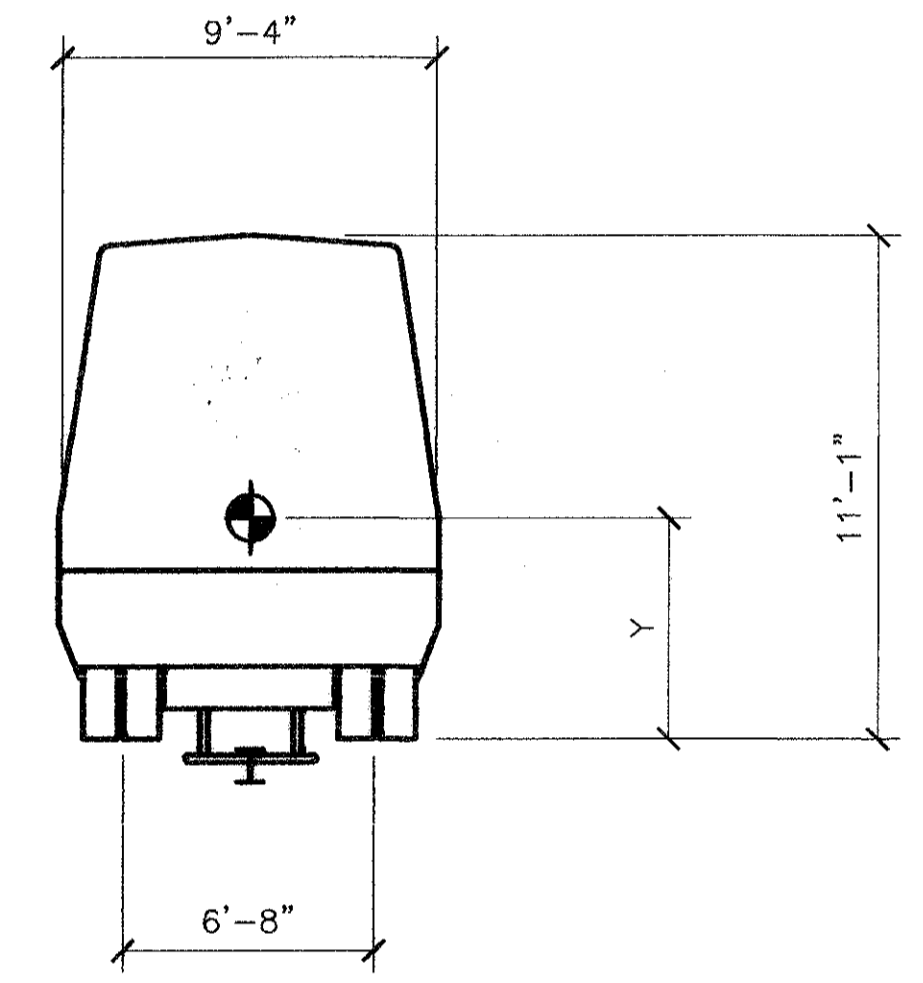

DEVELOPMENT AND LAP LENGTHS FOR REINFORCEMENT

f'c = 4000 psi  
 fy = 60000 psi

TOP BARS\*

BAR SIZE	DEVELOPMENT LENGTH (IN)	LAP LENGTH (IN)
3	14	23
4	19	29
5	24	36
6	28	45
7	33	57
8	42	72
9	54	92
10	69	118
11	84	143

OTHER BARS


BAR SIZE	DEVELOPMENT LENGTH (IN)	LAP LENGTH (IN)
3	12	16
4	15	21
5	18	26
6	22	31
7	25	40
8	30	51
9	38	65
10	49	84
11	60	102

\* TOP BARS ARE HORIZONTAL BARS PLACED SO THAT MORE THAN 12 INCHES OF CONCRETE IS CAST IN THE MEMBER BELOW THE BAR

RECORD DRAWINGS DO NOT MODIFY  
 DATE: MAY 6, 2005  
 HUITT-ZOLLARS, INC.  
 NOTE: INFORMATION USED TO DEVELOP THESE DOCUMENTS WAS TAKEN FROM RECORD OF THE WORK DRAWINGS PREPARED BY THE CONSTRUCTION CONTRACTOR. CLARK/MISSION A JOINT VENTURE. THE INFORMATION PROVIDED BY THE CONTRACTOR WAS NOT VERIFIED BY THE DESIGN FIRM NAMED ABOVE.




STRUCTURE	SPAN	BEAM NO.	BEAM TYPE	NON-STD. STRAND PAT-TERN	DESIGNED BEAMS (DEPRESSED STRANDS)						OPTIONAL DESIGN					
					PRESTRESSING STRANDS						CONCRETE		DN. LOAD COMP. STRESS (TOP $\phi$ )	DN. LOAD TENSILE STRESS (BOTT $\phi$ )	REQUIRED MINIMUM ULTIMATE MOMENT CAPACITY (Ft.Kips)	
					TOTAL			DEPRESSED			RELEASE STRGTH f'ci (psi)	MINIMUM 28 DAY COMP. STRGTH f'c (psi)				
					NO	SIZE	STRGTH	"e" $\phi$ in.	"e" END in.	NO			TO			
APM STATION AND PLATFORM (AT TERMINAL D)	47	1-6	IV	—	30	1/2	270	21.15	11.95	6	A-52	4000	5000	1684	1535	2570
	48	1-6	IV	—	14	1/2	270	22.46	22.46	0	STRAIGHT	4000	5000	432	416	678
	49	1-6	IV	—	32	1/2	270	21.00	12.38	6	A-52	4000	5000	1925	1769	2884

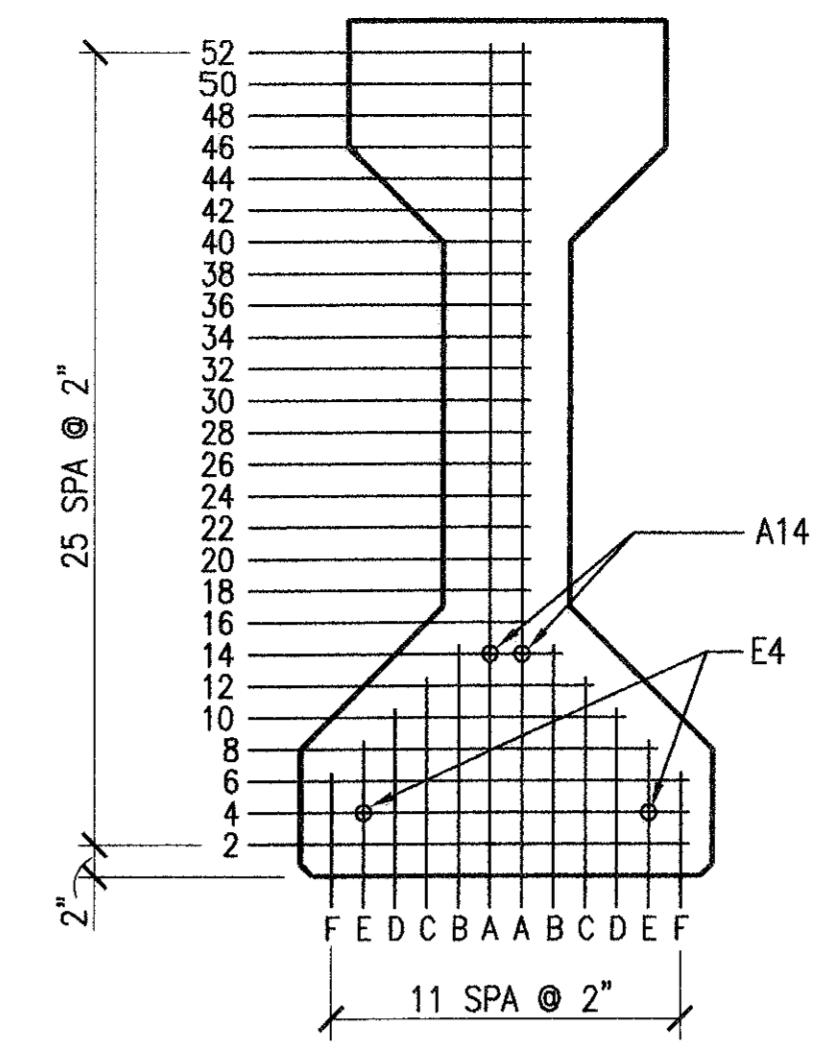

1 AASHTO TYPE IV BEAM DETAIL  
S0.201 NTS

GUIDEWAY PRESTRESSED BEAM DEFLECTION AND CAMBER SUMMARY TABLE							
SPAN NO.	BEAM NO.	BEAM TYPE	(1) THEOR. CAMBER (INCHES)	SLAB DL DEFLECTION (INCHES)	SUPERIMPOSED DL DEFLECTION (INCHES)	(2) TRAIN DEAD LOAD DEFLECTION (INCHES)	(3) TRAIN LIVE LOAD DEFLECTION (INCHES)
47	1-6	IV	+2.014	-0.214	-0.290	-0.144	-0.098
48	1-6	IV	+0.336	-0.011	-0.018	-0.010	-0.007
49	1-6	IV	+2.383	-0.237	-0.384	-0.191	-0.129

(1) CAMBER: THEORETICAL VALUE BASED ON BEAM UPWARD DEFLECTION DUE TO PRESTRESS FORCE MINUS BEAM OWN WEIGHT DOWNWARD DEFLECTION  
(2) TRAIN LL: DEFLECTION OF TRAIN LL BASED ON TWO AW2 + ONE AW0  
(3) TRAIN LL: DEFLECTION OF TRAIN LL BASED ON ONE AW0 + HALF AW1

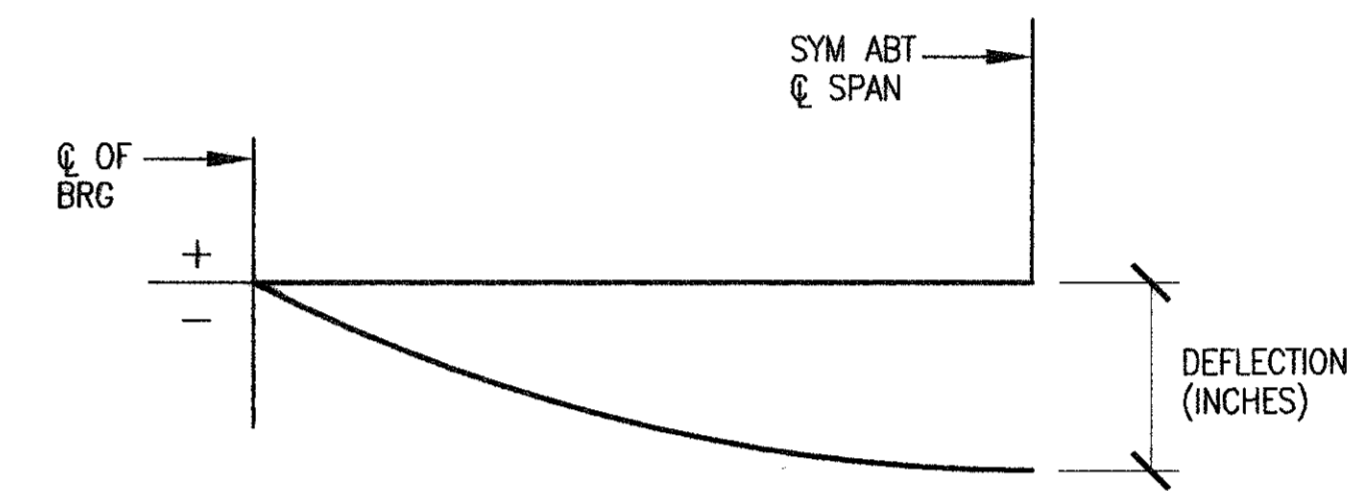

5 DEFLECTION DIAGRAM  
S0.201 NTS

NOTES TO SHEET

- REFER TO SHEET S0.100 FOR STRUCTURAL GENERAL NOTES.
- REFER TO SHEET S3.004 FOR GUIDEWAY BEAM FRAMING PLAN.
- REFER TO SHEET S5.501 FOR PRESTRESSED CONCRETE BEAM STANDARD DETAILS.

**HOUSTON AIRPORT SYSTEM**  
GEORGE BUSH  
INTERCONTINENTAL AIRPORT  
HOUSTON TEXAS


**HUITT-ZOLLARS**  
Engineering / Architecture  
1800 West Loop South, Suite 200, Houston, TX 77057  
Phone: (281) 492-0046 Fax: (281) 492-0252

**CHARLES F. TERRY, INC.**  
Consulting Engineers  
1000 West Loop South, Suite 200, Houston, TX 77057  
Phone: (281) 492-0046 Fax: (281) 492-0252

REVISIONS			
NO.	DESCRIPTION	DATE	BY
ISSUED FOR BID		10/19/01	

INTERNATIONAL • SERVICES • EXPANSION • PROGRAM  
**APM STATION & PLATFORM**  
PRESTRESSED CONCRETE BEAM SCHEDULES AND DETAILS

PROJECT MGR:	GRW
DESIGNER:	JUC
DRAWN BY:	KLV
CHECKED BY:	MMR
DRAWING STANDARD:	SEP 07.20.2000
SCALE:	As Noted
DATE:	09/14/01

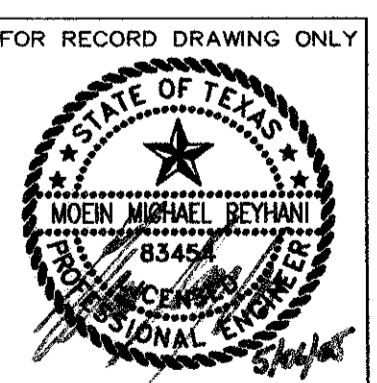

APPROVED BY: DATE:

DIRECTOR  
HOUSTON AIRPORT SYSTEM

PROJECT NO. 02-2025-01

C.I.P. NO. A-0354

H.A.S. NO. 536C

SHEET NO.

RECORD DRAWINGS  
DO NOT MODIFY

DATE: MAY 6, 2005


HUITT-ZOLLARS, INC.

NOTE: INFORMATION USED TO DEVELOP THESE DOCUMENTS WAS TAKEN FROM RECORD OF THE WORK DRAWINGS PREPARED BY THE CONSTRUCTION CONTRACTOR, CLARK/MISSON A JOINT VENTURE. THE INFORMATION PROVIDED BY THE CONTRACTOR WAS NOT VERIFIED BY THE DESIGN FIRM NAMED ABOVE.




CONCRETE BEAM SCHEDULE


MARK	SIZE		TYPE	LONGITUDINAL REINFORCING							STIRRUPS			REMARKS
	WIDTH (INCH)	DEPTH (INCH)		D1 D2	S	B1 B2	T1 T2	C1 C2	M	SIZE	TYPE	SPACING		
B101	23	66	9			8 #11			4 #6	#4	5	10"	TAPER TO 42 INCHES @ BOTTOM-SEE ARCH	
B102	23	66	2		2 #11	6 #11	8 #11		4 #6	#4	5	12"		
B103	23	66	3	4 #9	2 #9	4 #9			4 #6	#4	4	12"		
B104	18	60	9			6 #11			4 #6	#4	5	10"	TAPER TO 42 INCHES	
B105	18	66	2		2 #11	6 #11	6 #11		4 #6	#4	5	12"		
B106	18	66	3	4 #8	2 #8	4 #8			4 #6	#4	4	12"		
B107	18	60	9			6 #11			4 #6	#4	5	10"	TAPER TO 42 INCHES	
B108	18	66	2		2 #11	6 #11	6 #11		4 #6	#4	5	12"		
B109	18	66	3	4 #8	2 #8	4 #8			4 #6	#4	4	12"		
B110	23	66	9			8 #11			4 #6	#4	5	10"	TAPER TO 42 INCHES	
B111	23	66	2		2 #11	6 #11	6 #11		4 #6	#4	5	12"		
B112	23	66	3	4 #9	2 #9	4 #9			4 #6	#4	4	12"		
B113	12	42	1	2 #8	2 #8	2 #8	2 #8		2 #6	#4	4	12"		
B114	12	42	2			2 #8			2 #6	#4	4	12"		
B115	12	42	3	2 #8	2 #8	2 #8			2 #6	#4	4	12"		
B116	12	60	5			2 #8	2 #8		4 #6	#3	1	12"		
B117	12	66	5			2 #8	2 #8		4 #6	#4	4	12"		
B118	12	66	1	2 #8	2 #8	2 #8	2 #8		4 #6	#4	4	12"		
B119	12	66	2			2 #8	2 #8		4 #6	#4	4	12"		
B120	12	66	3	2 #8	2 #8	2 #8			4 #6	#4	4	12"		
B121	24	66	5			4 #8	4 #8		4 #6	#4	5	12"	STIRRUP SPACING IS THE SAME IN ENTIRE LENGTH OF BEAM	
B122	24	30	5			4 #8	4 #8		2 #6	#4	5	12"	STIRRUP SPACING IS THE SAME IN ENTIRE LENGTH OF BEAM	
GB1	18	36	3	2 #8	4 #11	2 #8			2 #6	#4	5	12"	CONTINUE S BAR AS T2 BAR OF GB3	
GB2	18	36	5			2 #8	2 #6		2 #6	#4	4	9"		
GB3	18	36	9			4 #11			2 #6	#4	5	9"		
GB4	24	36	5			2 #8	2 #8		2 #6	#4	5	12"		
B201	36	74	9			10 #11		10 #8		#4	5	12"	STIRR SPACING IS UNIFORM IN ENTIRE LENGTH OF BEAM. CONTINUE "M" REINF INTO B202	
B202	36	74	2		2 #10	8 #10	8 #10		10 #8	#4	5	12"		
B203	24	74	2		2 #10	6 #10	9 #11		6 #6	#4	4	12"		
B204	36	74	2		2 #10	8 #10	6 #10		6 #6	#4	5	12"		
B205	24	40	5			2 #8	2 #9		2 #6	#4	1	6"		
B206	18	74	1	4 #8	2 #8	4 #8	4 #10		6 #6	#4	1	12"		
B207	18	74	3	4 #8	2 #8	4 #10			6 #6	#4	1	12"		
B208	12	34	9			2 #8			2 #6	#4	4	6"	PROVIDE BOTTOM REINF PER SCHEDULE	
B209	18	74	2		2 #8	4 #10			6 #6	#4	1	12"		
B210	18	74	2	4 #8	2 #8	4 #10			6 #6	#4	1	12"		
B211	18	36	9			4 #8			2 #6	#4	1	6"		
B212	12	34	5			2 #6	2 #6		2 #6	#3	1	12"		
B213	18	36	9			4 #8			2 #6	#4	1	6"	PROVIDE 2 #8 BOT BAR. CONTINUE ALL REINF INTO NEXT BEAM & BEND @ END OF PLATFORM	
B214	18	36	1	2 #8	2 #8	2 #8	2 #8		2 #6	#4	1	12"	CONTINUE "D" BAR INTO ADJACENT BEAM WHERE APPLICABLE	
B215	18	36	3	2 #8	2 #8	2 #8			2 #6	#4	1	12"	CONTINUE "D" BAR INTO ADJACENT BEAM WHERE APPLICABLE	
B216	12	40	5			2 #8	2 #8		2 #6	#3	1	12"		
B217	18	36	5			4 #10	4 #8		4 #8	#4	5	6"	STIRRUP SPACING IS UNIFORM IN THE ENTIRE LENGTH	
B218	12	36	5			2 #8	2 #8		2 #6	#4	4	12"	B, T & M REINF ARE ADD'L REINF INSIDE WALL	
B219	36	74	9			6 #10			2 #6	#4	5	12"	T & M REINF ARE CONTINUATION OF T & M FROM BEAM B204. STIRR SPACING IS UNIFORM	
B220	12	74	4			2 #8	2 #8		2 #6	#3	1	12"		
B221	18	36	5			2 #8	2 #8		2 #6	#4	5	12"		

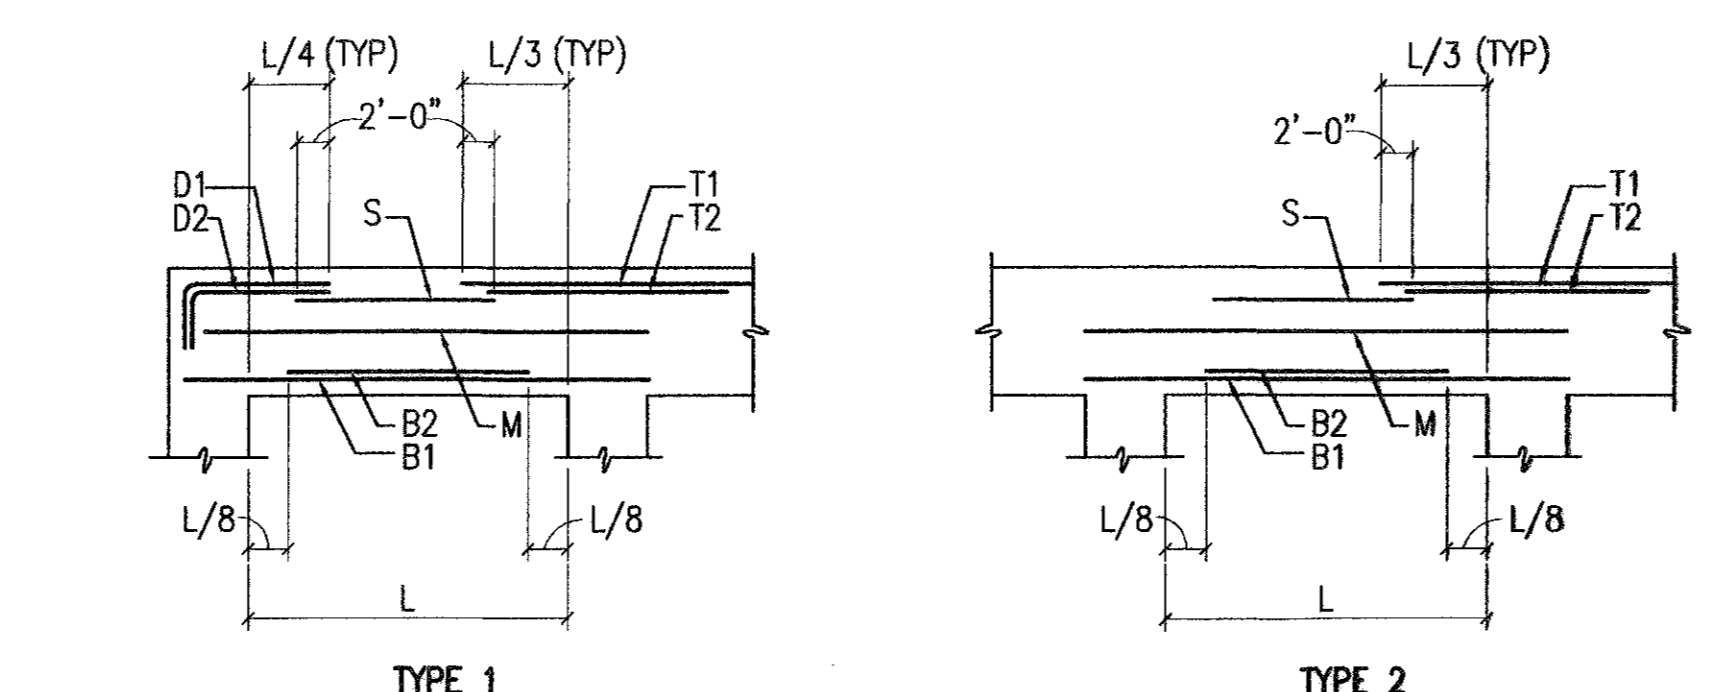


TYPE 1

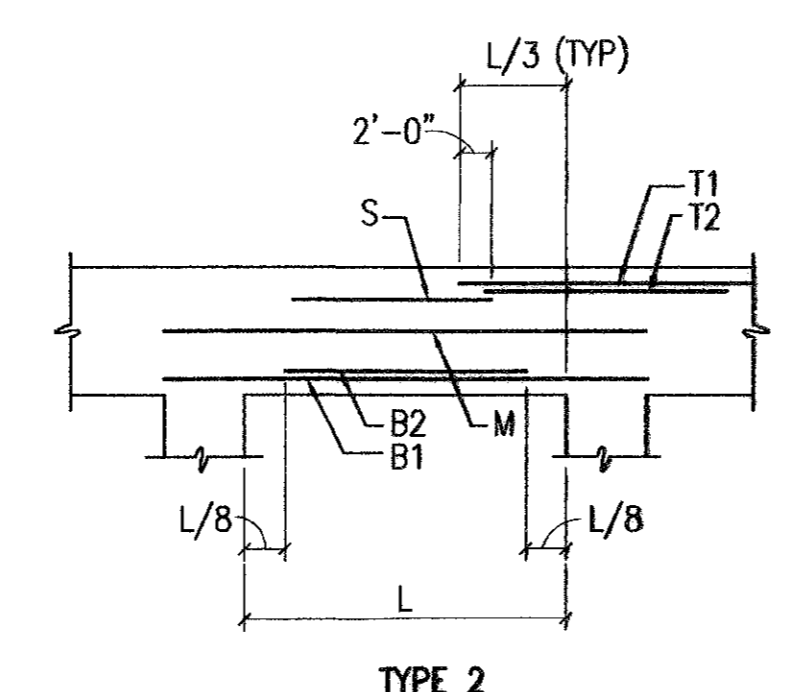


TYPE 2

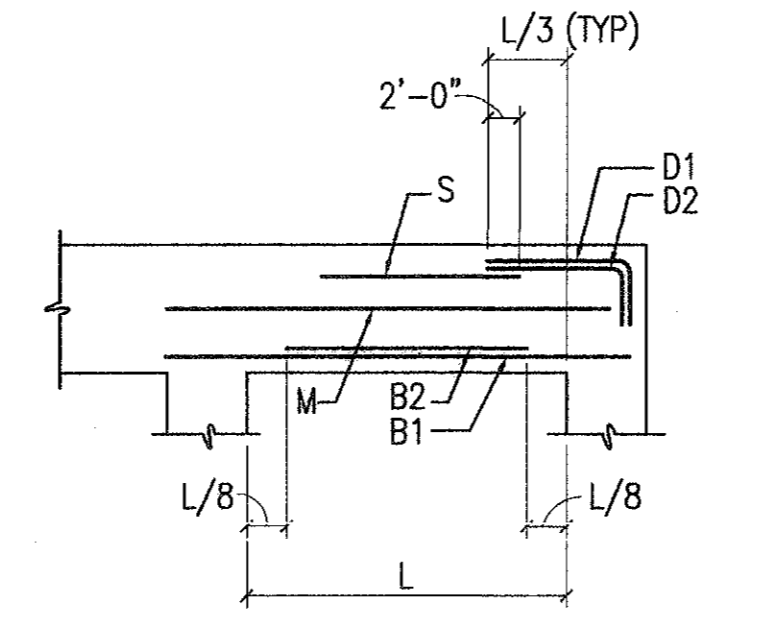


TYPE 3

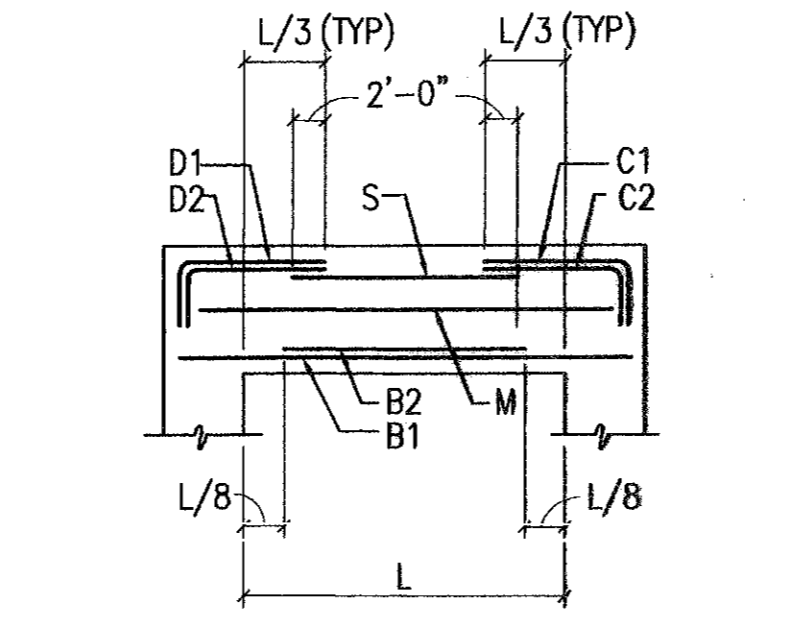


TYPE 4

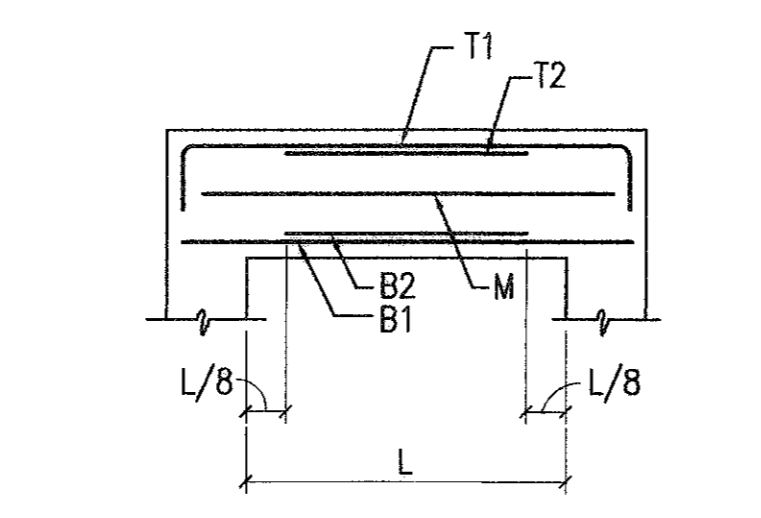


TYPE 5

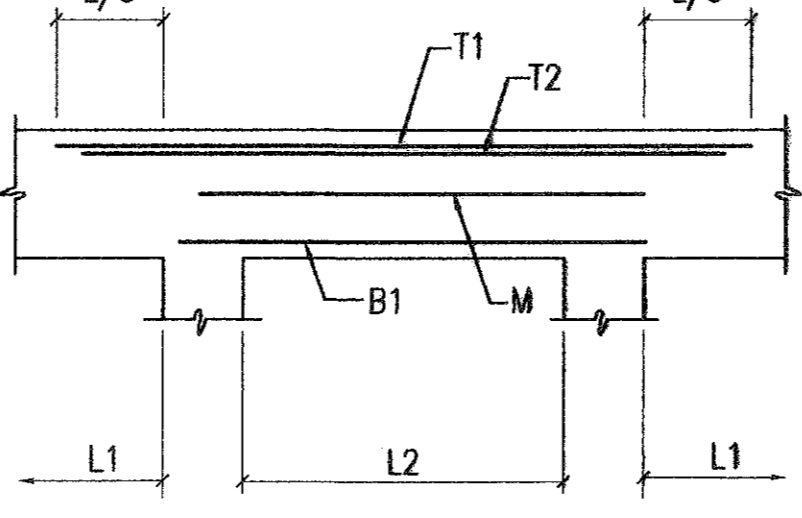


TYPE 6

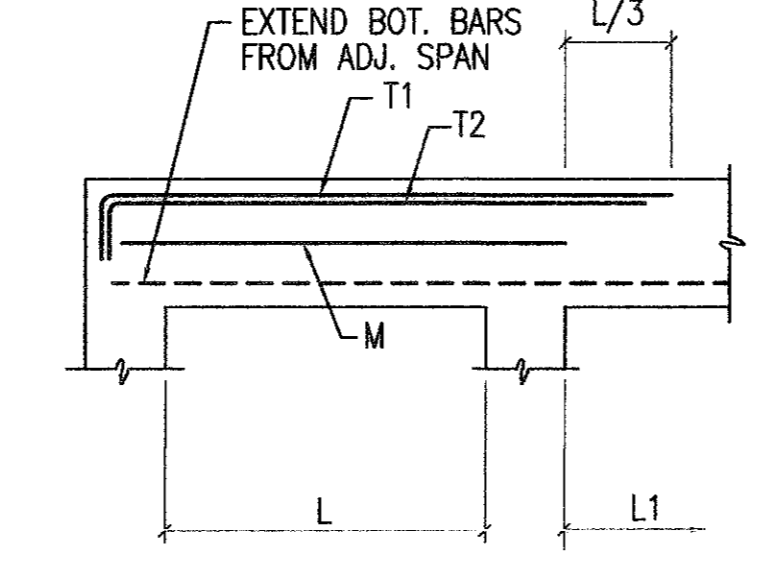


TYPE 7

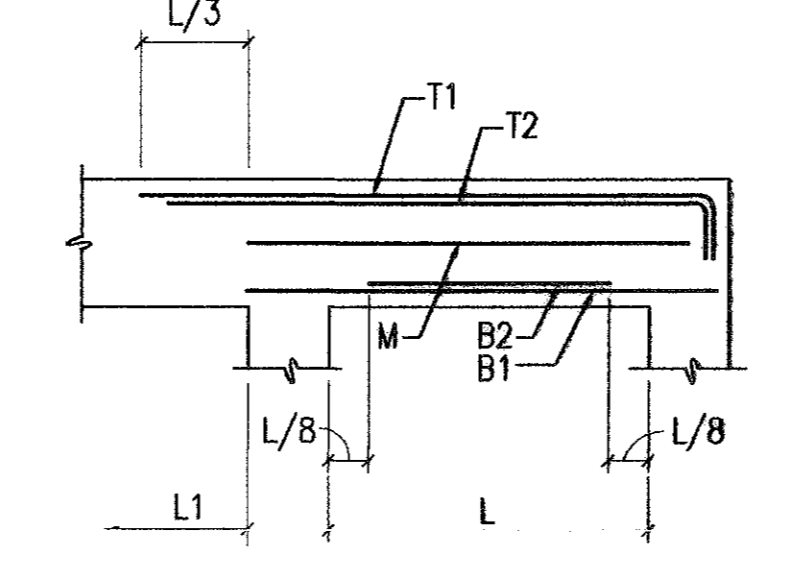


TYPE 8

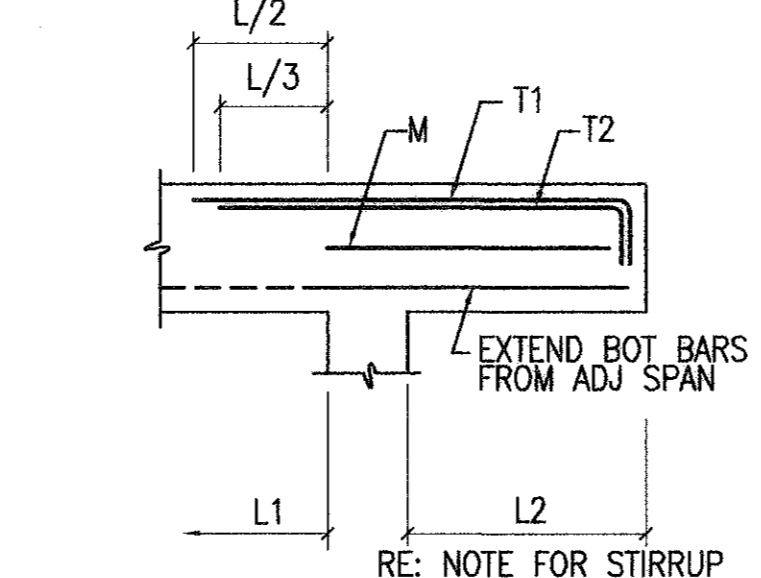


TYPE 9

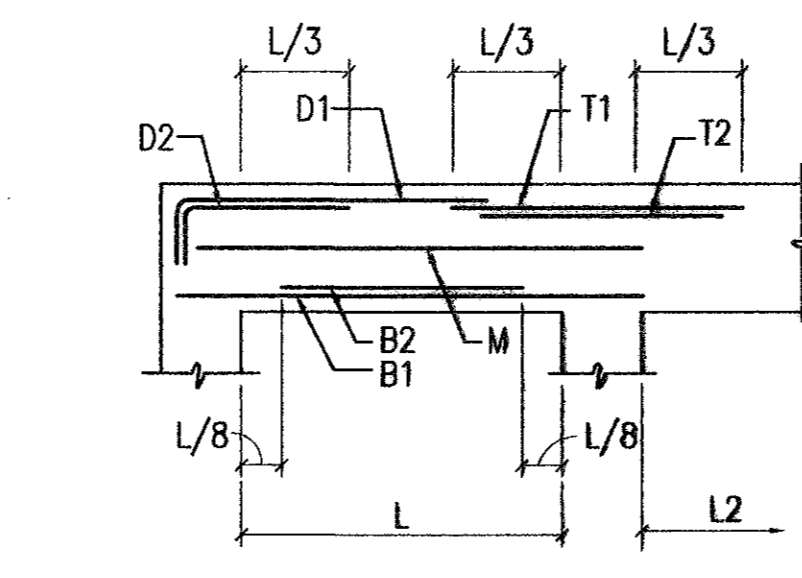

TYPE 10

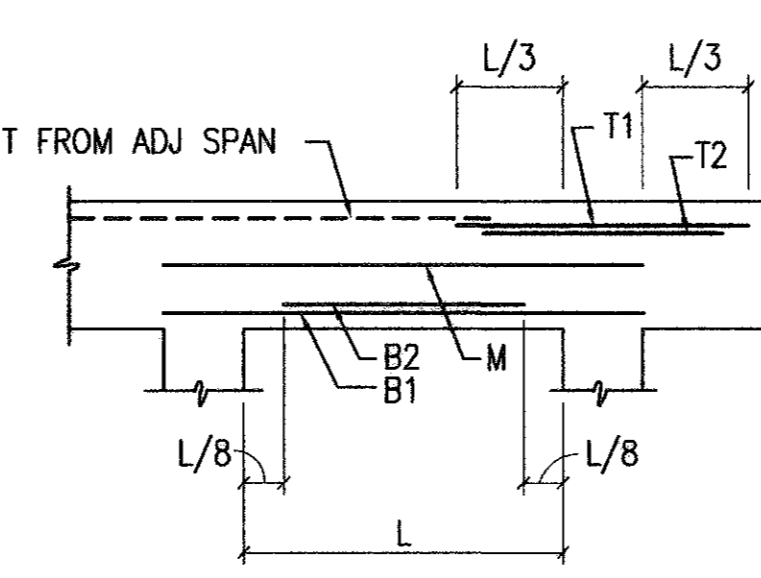


TYPE 11

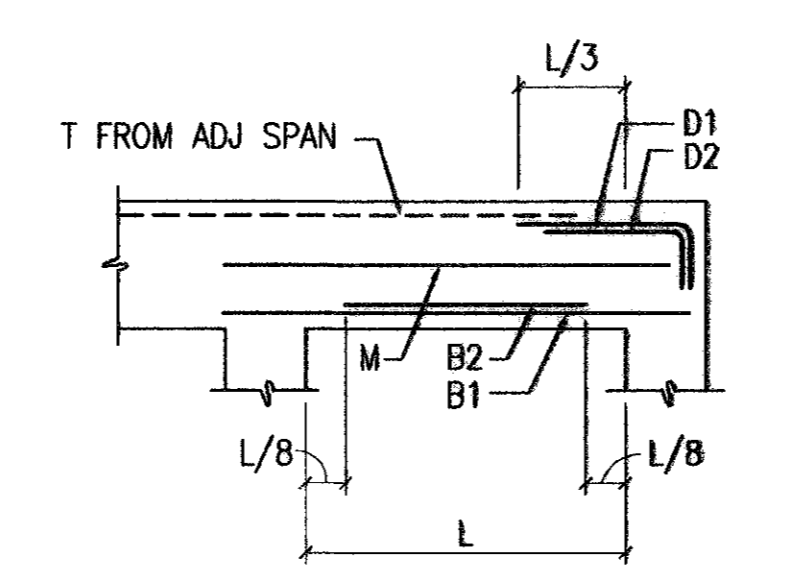


TYPE 12

1 DETAIL-BEAM REINFORCING  
S0.301 NTS


NOTE: M BARS ARE AT EACH FACE OF THE BEAM (TYP).

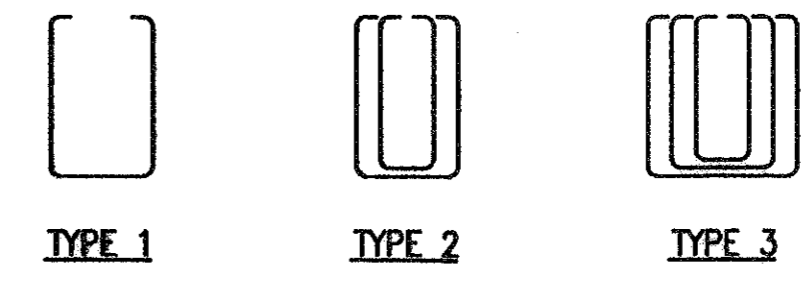


TYPE 1

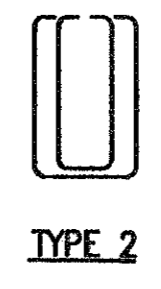


TYPE 2

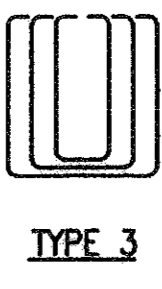


TYPE 3

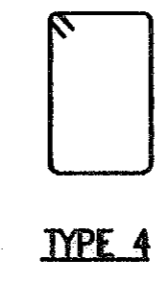

TYPE 4

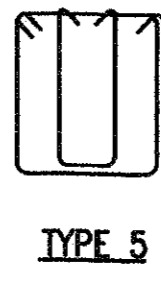


TYPE 5

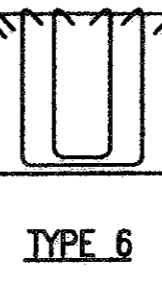

TYPE 6

2 DETAIL-STIRRUP TYPE  
S0.301 NTS

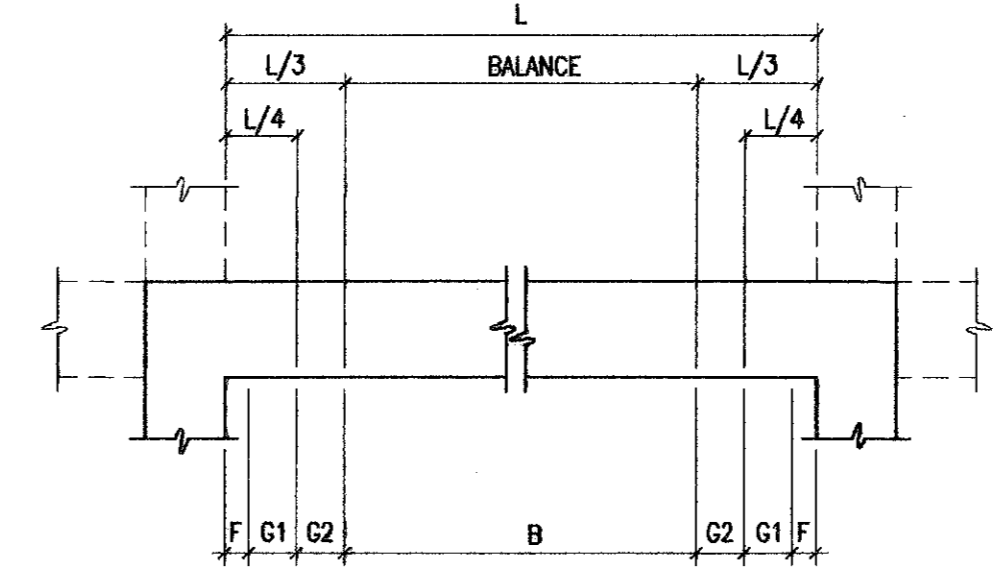

NOTE: STIRRUP SPACING IS UNIFORM FOR THE ENTIRE LENGTH OF CANTILEVER BEAMS.

3 DETAIL-STIRRUP GROUPING  
S0.301 NTS

STIRRUP GROUPING NOTES:  
F=DISTANCE IN INCHES EQUALS TO HALF OF STIRRUP SPACING AS SHOWN ON BEAM SCHEDULE.  
G1=PROVIDE STIRRUP SPACING AS SHOWN ON BEAM SCHEDULE FOR THIS DISTANCE.  
G2=WITHIN THIS DISTANCE, PROVIDE STIRRUP WITH TWO TIMES THE SPACING AS SHOWN ON BEAM SCHEDULE, BUT IN NO CASE SHALL THE SPACING BE GREATER THAN HALF BEAM DEPTH LESS 5 INCHES.  
B (BALANCE)=WITHIN THIS DISTANCE, PROVIDE STIRRUPS WITH THREE TIMES THE SPACING AS SHOWN ON SCHEDULE BUT IN NO CASE SHALL THE SPACING BE GREATER THAN BEAM DEPTH LESS 5 INCHES.

NOTES TO SHEET

RECORD DRAWINGS  
DO NOT MODIFY  
DATE: MAY 6, 2005  
HURTT-ZOLLARS, INC.  
NOTE: INFORMATION USED TO DEVELOP THESE DOCUMENTS WAS TAKEN FROM RECORD OF THE WORK DRAWINGS PREPARED BY THE CONSTRUCTION CONTRACTOR. CLARK/MISSION A JOINT VENTURE. THE INFORMATION PROVIDED BY THE CONTRACTOR WAS NOT VERIFIED BY THE DESIGN FIRM NAMED ABOVE.

HOUSTON AIRPORT SYSTEM  
GEORGE BUSH  
INTERCONTINENTAL AIRPORT  
HOUSTON TEXAS


HURTT-ZOLLARS  
1400 Dairy Ashford, Suite 200, Houston, TX 77077  
Phone (281) 488-0066 Fax (281) 488-0220

CHARLES F. TERRY, INC.  
Consulting Engineers  
2801 Gessner Avenue  
Houston, Texas 77056  
Tel: 281-488-0066

REVISIONS  
NO. DESCRIPTION DATE BY  
ISSUED FOR BID 10/19/01  
ADDENDUM #1 02/01/02 MR

INTERNATIONAL • SERVICES • EXPANSION • PROGRAM  
APM STATION & PLATFORM  
CONCRETE BEAM/SLAB SCHEDULES AND REINFORCING DETAILS

PROJECT MGR: GRW  
DESIGNER: JUC  
DRAWN BY: KLV  
CHECKED BY: MMR  
DRAWING STANDARD: ISEP 07.20.2000  
SCALE: AS NOTED  
DATE: 09/14/01


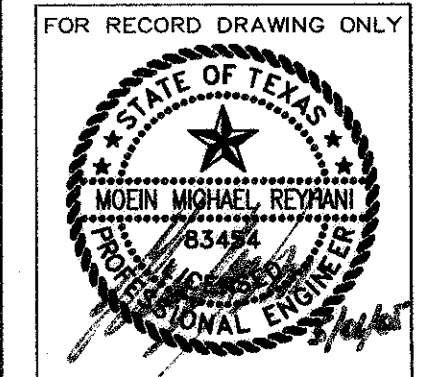


APPROVED BY: DATE:  
DIRECTOR  
HOUSTON AIRPORT SYSTEM  
PROJECT NO. 02-2025-01  
C.I.P. NO. A-0354  
H.A.S. NO. 536C  
SHEET NO.




REVISIONS

NO.	DESCRIPTION	DATE	BY
1	ISSUED FOR BID	10/19/01	DB
2	REVIEW	4/11/02	DB
3	CONFORM PLAN	7/31/03	DB
4	GEOMETRY & CURVE DATA W/		
5	BITS/TCI & ZIMMERMAN DWGS.		

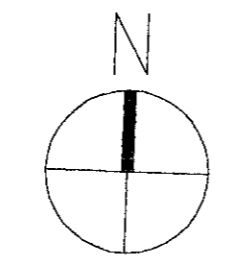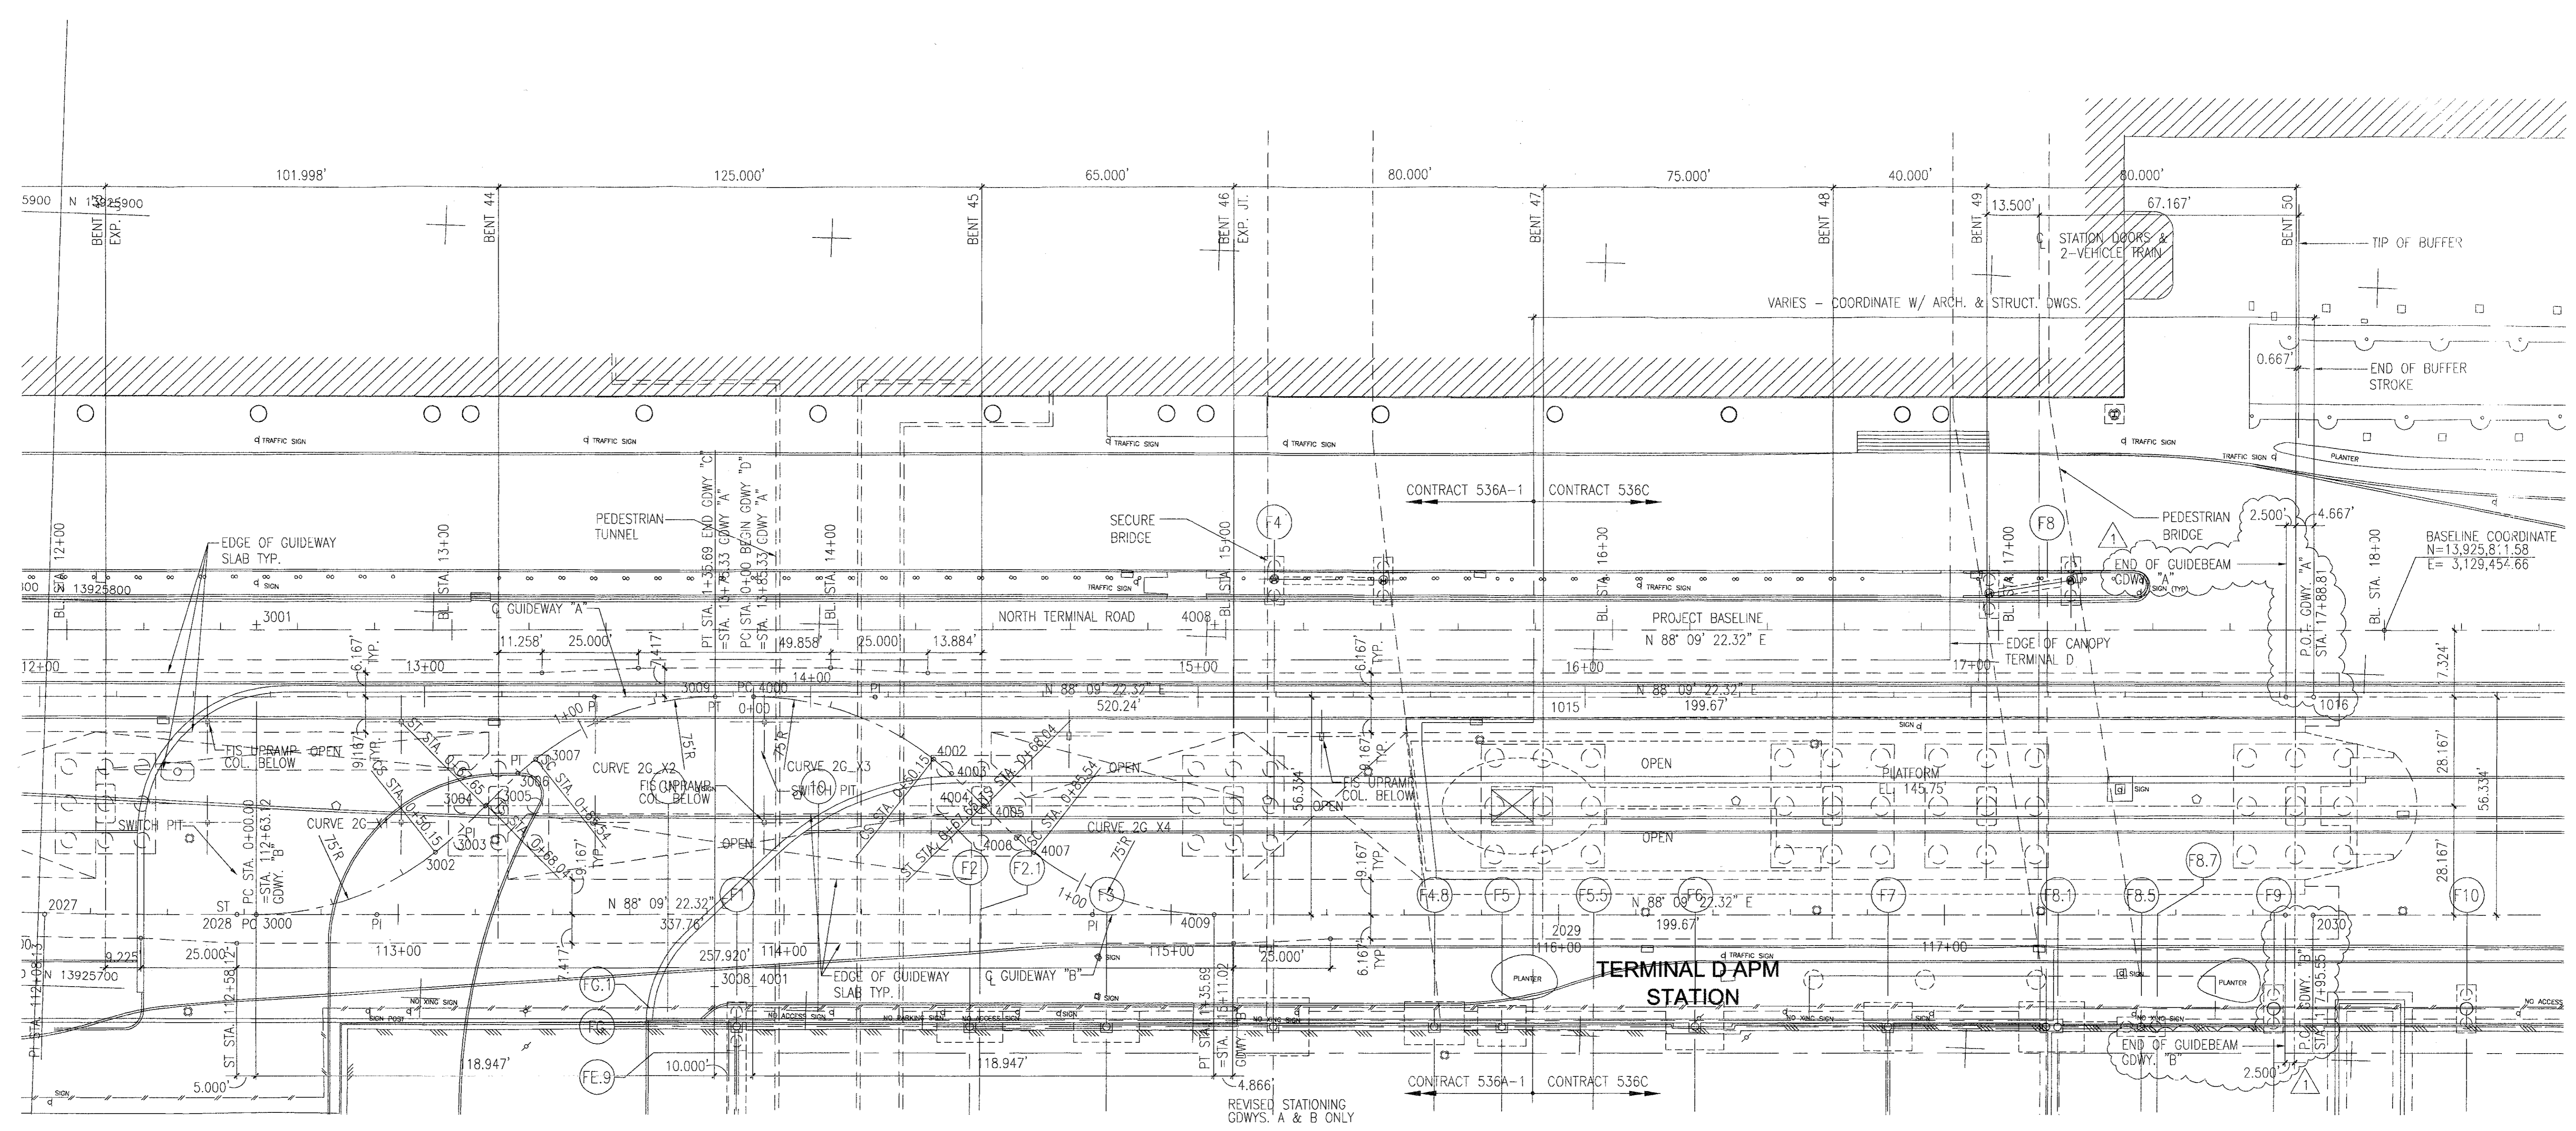

**HORIZONTAL CONTROL ALIGNMENT**

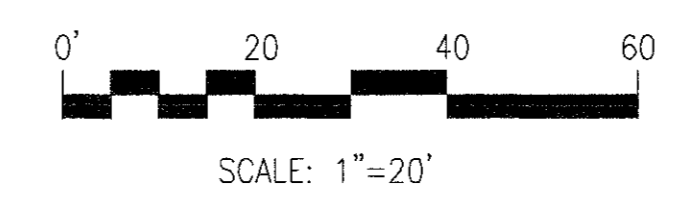

**NOTES:**

- ALL ELEVATIONS ARE REFERENCED TO NAVD 88 (JUNE 1991 ADJUSTMENT), AND BASED ON THE CITY OF HOUSTON SURVEY, MONUMENTATION AND MAPPING PROGRAM.
- ALL COORDINATES ARE REFERENCED TO THE TEXAS STATE PLANE COORDINATE SYSTEM (SOUTH CENTRAL ZONE) NAD 83 (1993 ADJUSTMENT), SURFACE COORDINATES.
- SEE SCHEDULES BELOW FOR HORIZONTAL ALIGNMENT CONTROL POINTS FOR CONTRACT 536C. SEE CONTRACT 536A-1 FOR OTHER DATA.
- HORIZONTAL CONTROL ALIGNMENT POINTS 1016 & 2030 INDICATE END OF PISTON STROKE FOR APM BUFFER AT APM STATION PLATFORM (4.667' EAST OF CL BENT 50).
- HORIZONTAL CONTROL ALIGNMENT POINTS 1015 & 2029 INDICATE INTERFACE POINTS BETWEEN CONTRACTS 536A-1 AND 536C (ALONG CL BENT 47).

**HORIZONTAL ALIGNMENT GUIDEWAY "A"**


POINT	BEARING	DISTANCE	NORTHING	EASTING
1015	BEGIN GDWY. "A" AT CL BENT 47 STATION = N 88° 09' 22.32" E	15 + 89.14 199.67' (TANGENT)	13,925,787.25	3,129,237.41
1016	END GDWY. STATION =	17 + 88.81	13,925,793.67	3,129,436.98

**HORIZONTAL ALIGNMENT GUIDEWAY "B"**

POINT	BEARING	DISTANCE	NORTHING	EASTING
2029	BEGIN GDWY. "B" AT CL BENT 47 STATION = N 88° 09' 22.32" E	115 + 95.88 199.67' (TANGENT)	13,925,730.95	3,129,239.23
2030	END GDWY. STATION =	117 + 95.55	13,925,737.37	3,129,438.80

**BENCHMARKS:**

- CITY OF HOUSTON SURVEY MARKER 5467-2824 LOCATED BETWEEN MARRIOTT HOTEL AND TERMINAL "C" PARKING GARAGE. PREVIOUSLY KNOWN AS A.S.D. POINT #71.
- CITY OF HOUSTON SURVEY MARKER 5467-3325 LOCATED IN THE PARKING LOT NEAR GATE NV12 AND EAST OF TERMINAL "D". PREVIOUSLY KNOWN AS A.S.D. POINT #10.
- CITY OF HOUSTON SECONDARY AIRPORT MONUMENT SURVEY MARKER POINT #60.

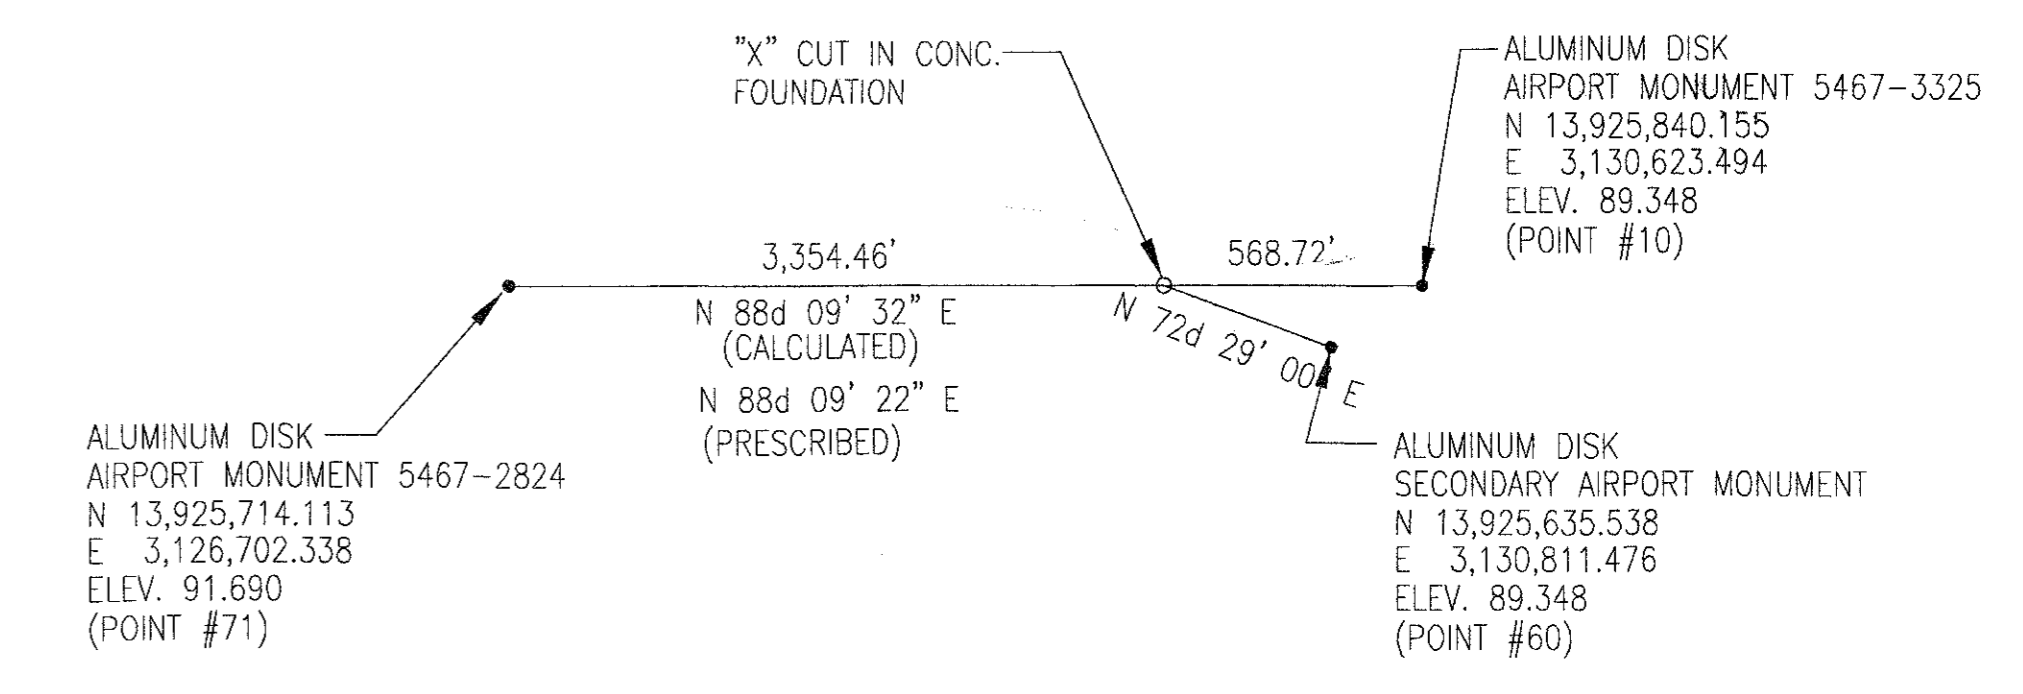


**HORIZONTAL CONTROL BENCHMARKS**

**RECORD DRAWINGS**  
 DO NOT MODIFY  
 Terry + Moore Inc.  
 27 May 2005

Note: Information used to develop these documents was taken from Record of the Work Drawings prepared by the construction contractor, Clark Construction Group - Texas. The information provided by the contractor was not verified by the design firm named above.

PROJECT MGR: P.J.M.  
 DESIGNER: P.J.M.  
 DRAWN BY: D.E.B.  
 CHECKED BY: P.J.M.  
 DRAWING STANDARD: ISRP 07.20.2000  
 SCALE: 1"=20'  
 DATE: 05/14/01

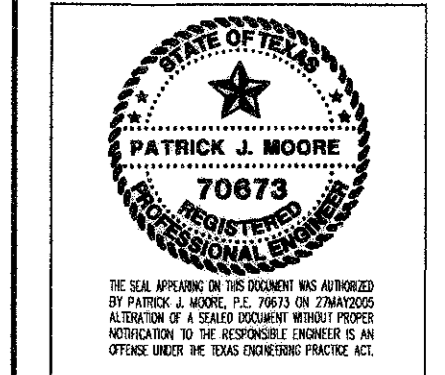

APPROVED BY: \_\_\_\_\_ DATE: \_\_\_\_\_  
 DIRECTOR  
 HOUSTON AIRPORT SYSTEM


PROJECT NO. 98-1951  
 C.I.P. NO. A-0354  
 H.A.S. NO. 536C  
 SHEET NO. 59



NO.	DESCRIPTION	DATE	BY
1	ISSUED FOR BID	10/19/01	DB
2	REVIEW	4/11/02	DB
3	CONFORM PLAN 7/31/03	DB	
4	GEOMETRY & CURVE DATA w/ STS/TCI & ZIMMERMAN DWGS.		


INTERNATIONAL SERVICES EXPANSION PROGRAM  
**APM STATION AND PLATFORM**  
 APM GUIDEWAY PLAN + PROFILE

PROJECT MGR:	P.J.M.
DESIGNER:	P.J.M.
DRAWN BY:	D.E.R.
CHECKED BY:	P.J.M.
DRAWING STANDARD:	ISEP 07.20.2000
SCALE:	1"=20'
DATE:	09/14/01

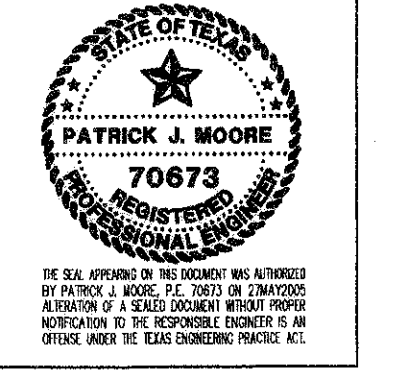


APPROVED BY:	DATE:
DIRECTOR	HOUSTON AIRPORT SYSTEM
PROJECT NO.:	98-1965.1
C.I.P. NO.:	A-0354
H.A.S. NO.:	536C
SHEET NO.:	

W S1.101  
 RECORD DRAWING

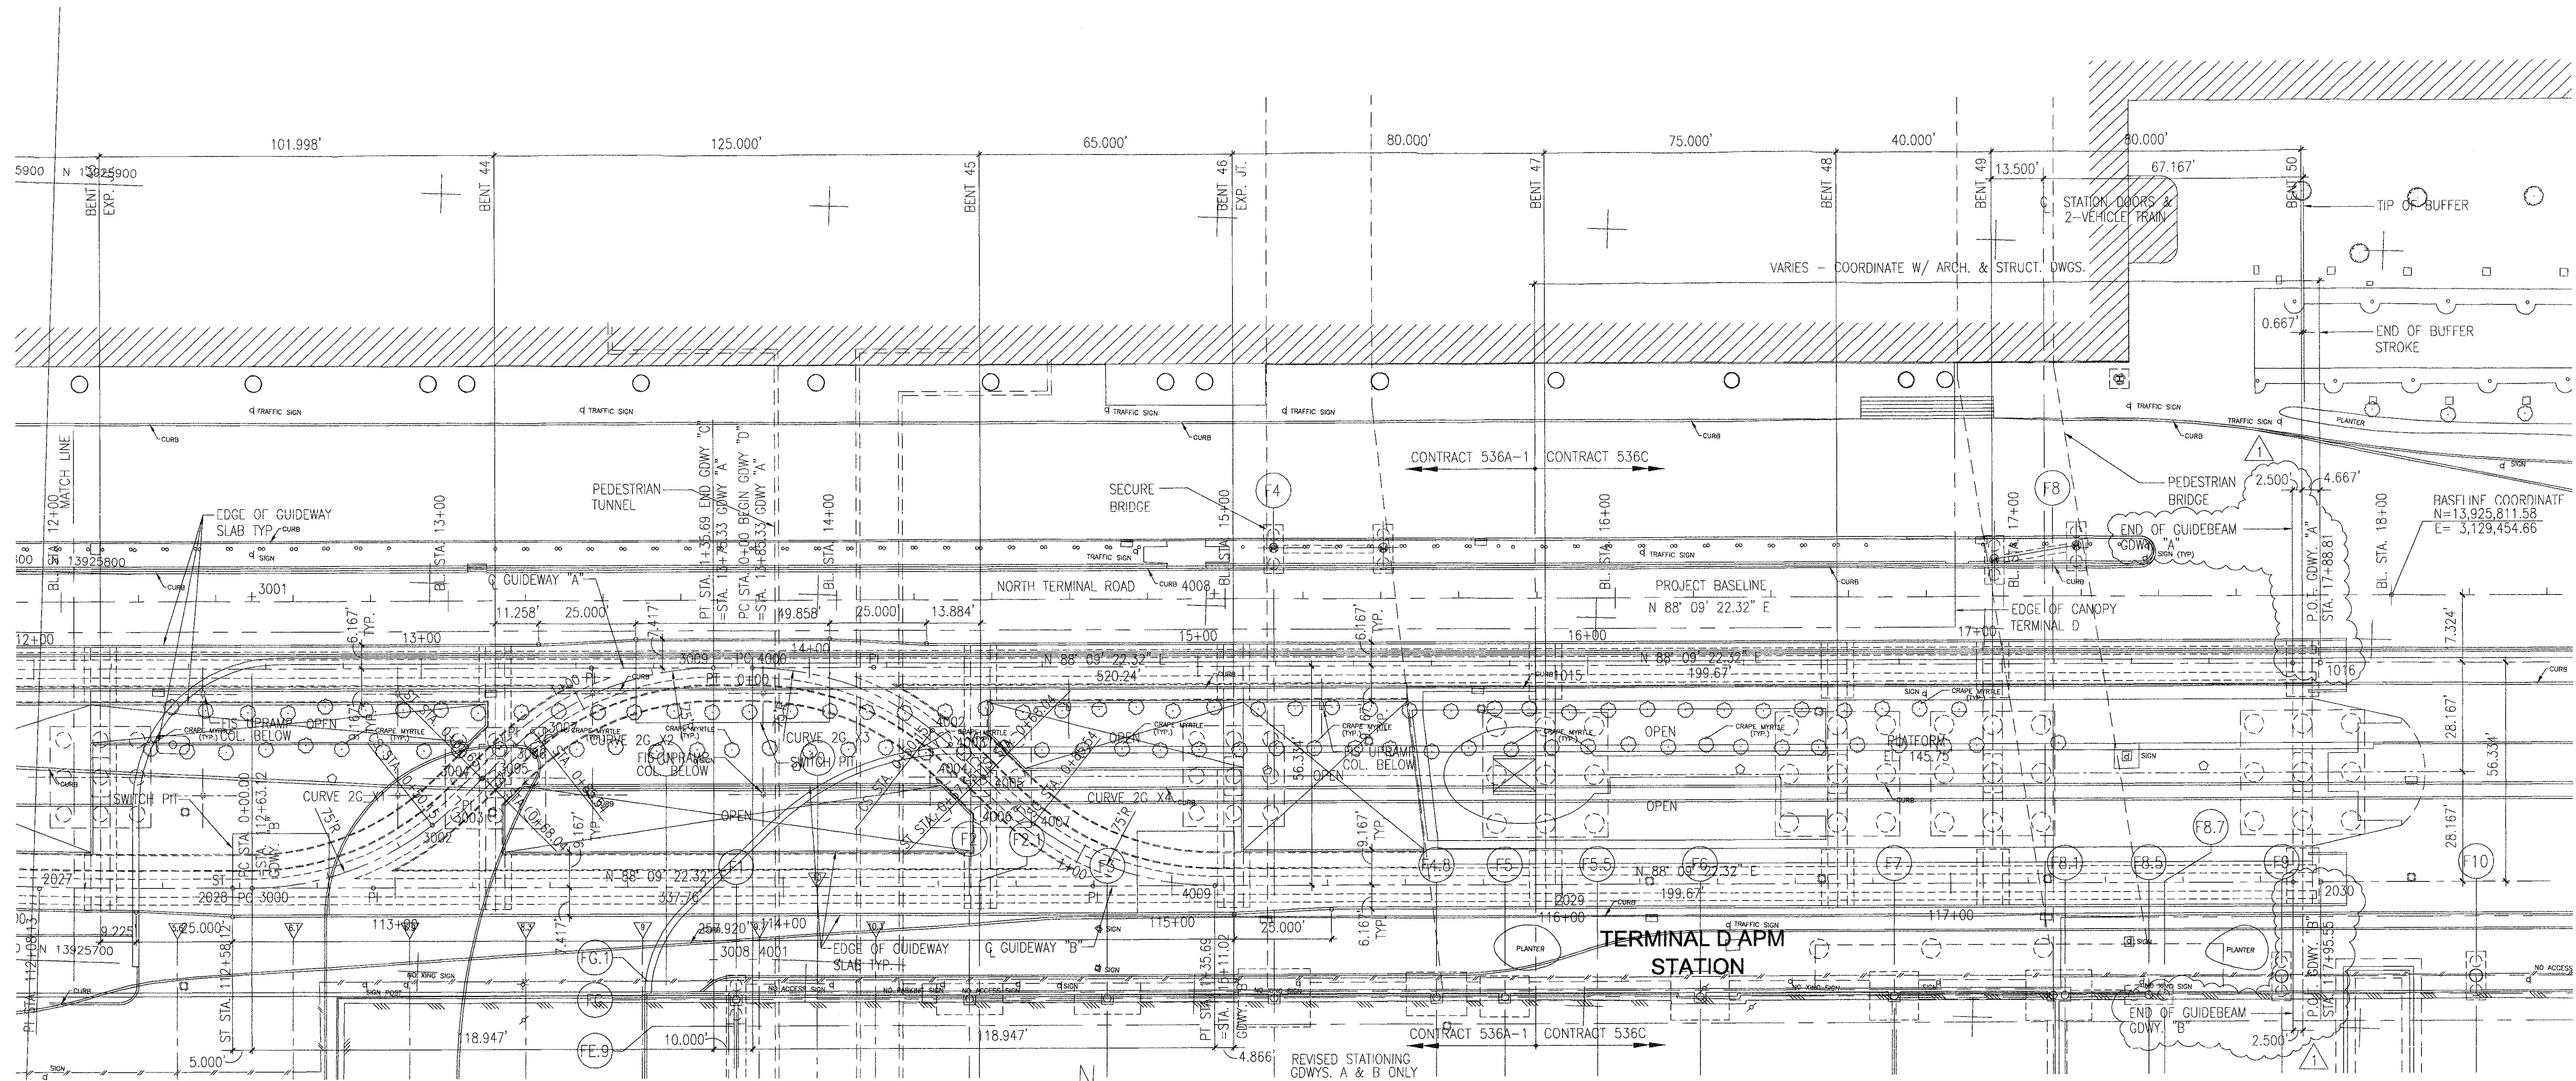

1 APM GUIDEWAY PLAN  
 S1.104

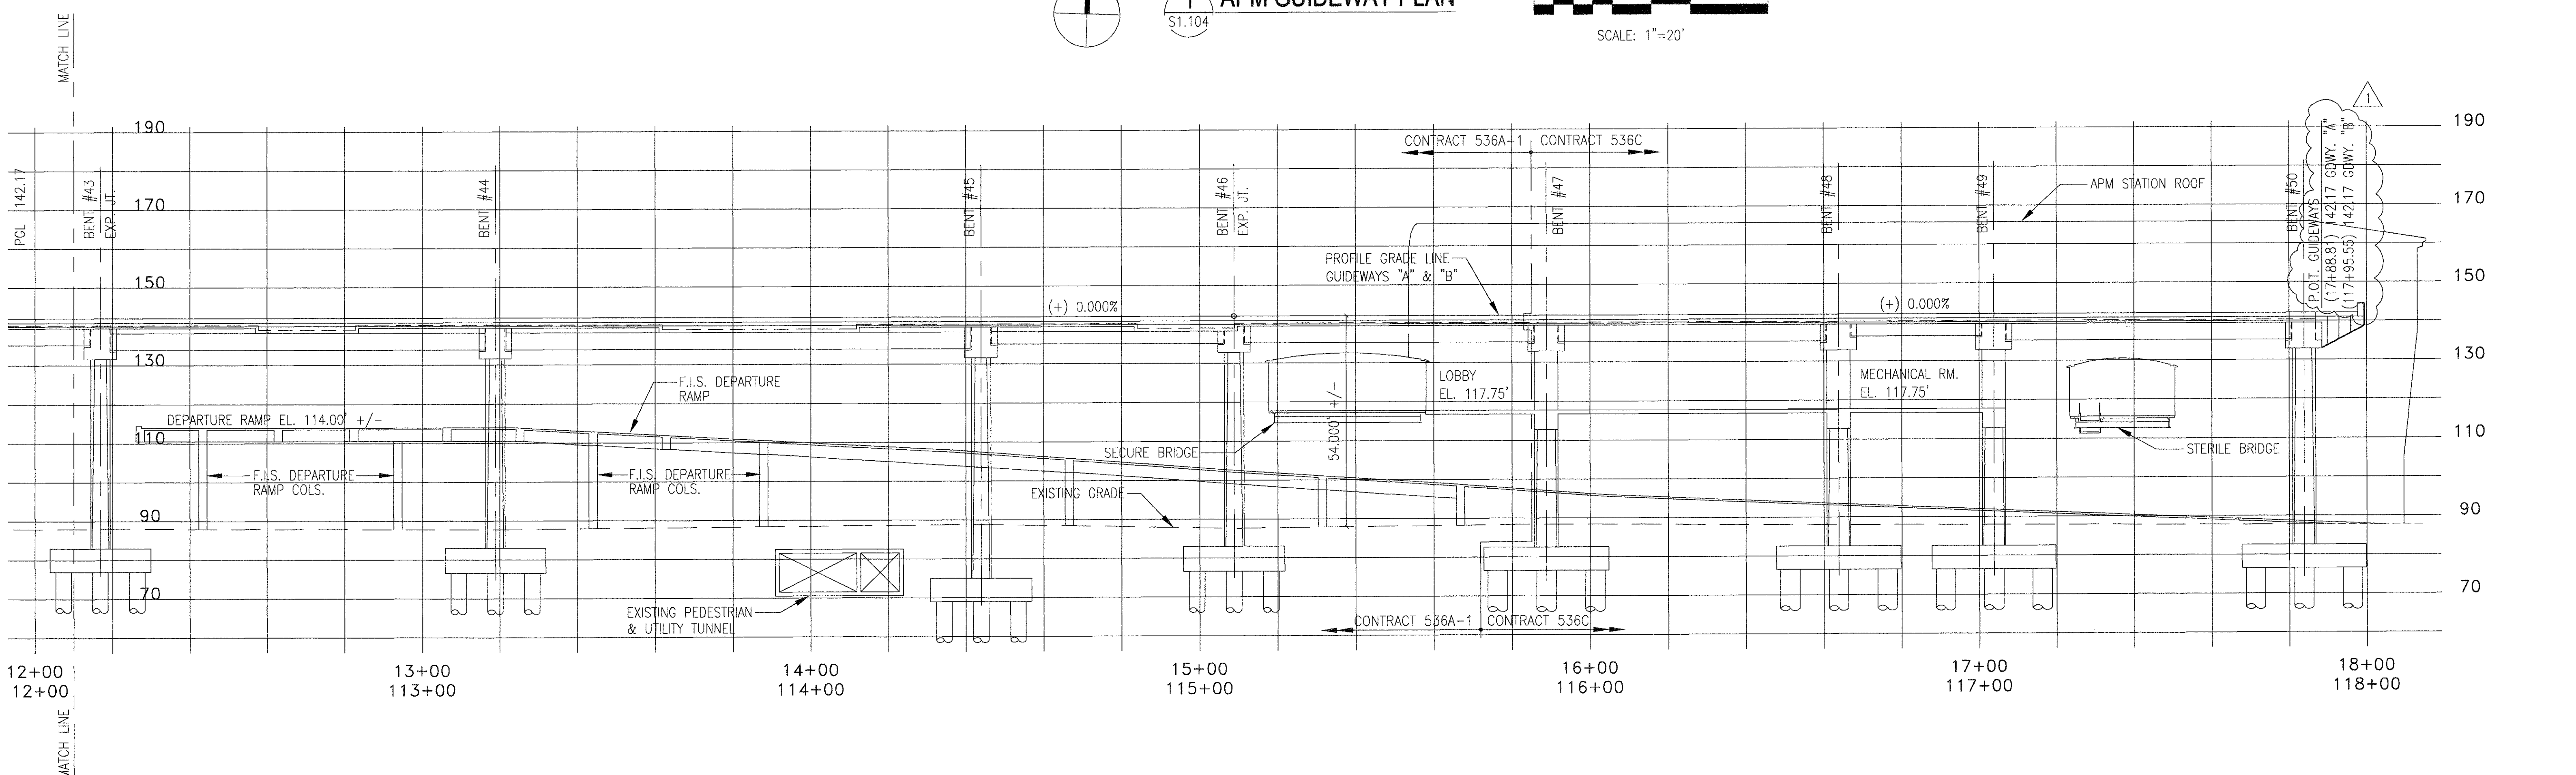

2 APM GUIDEWAY PROFILE  
 S1.104


- NOTES:
- ALL ELEVATIONS ARE REFERENCED TO NAVD 88 (JUNE 1991 ADJUSTMENT), AND BASED ON THE CITY OF HOUSTON SURVEY, MONUMENTATION AND MAPPING PROGRAM.
  - ALL COORDINATES ARE REFERENCED TO THE TEXAS STATE PLANE COORDINATE SYSTEM (SOUTH CENTRAL ZONE) NAD 83 (1993 ADJUSTMENT), SURFACE COORDINATES.

**RECORD DRAWINGS**  
 DO NOT MODIFY  
 Terry + Moore Inc.  
 27 May 2005

Note: Information used to develop these drawings was taken from Record of the Work Drawings prepared by the construction contractor, Clark Construction Group - Texas. The information provided by the contractor was not verified by the design firm named above.




TERMINAL D BUILDING

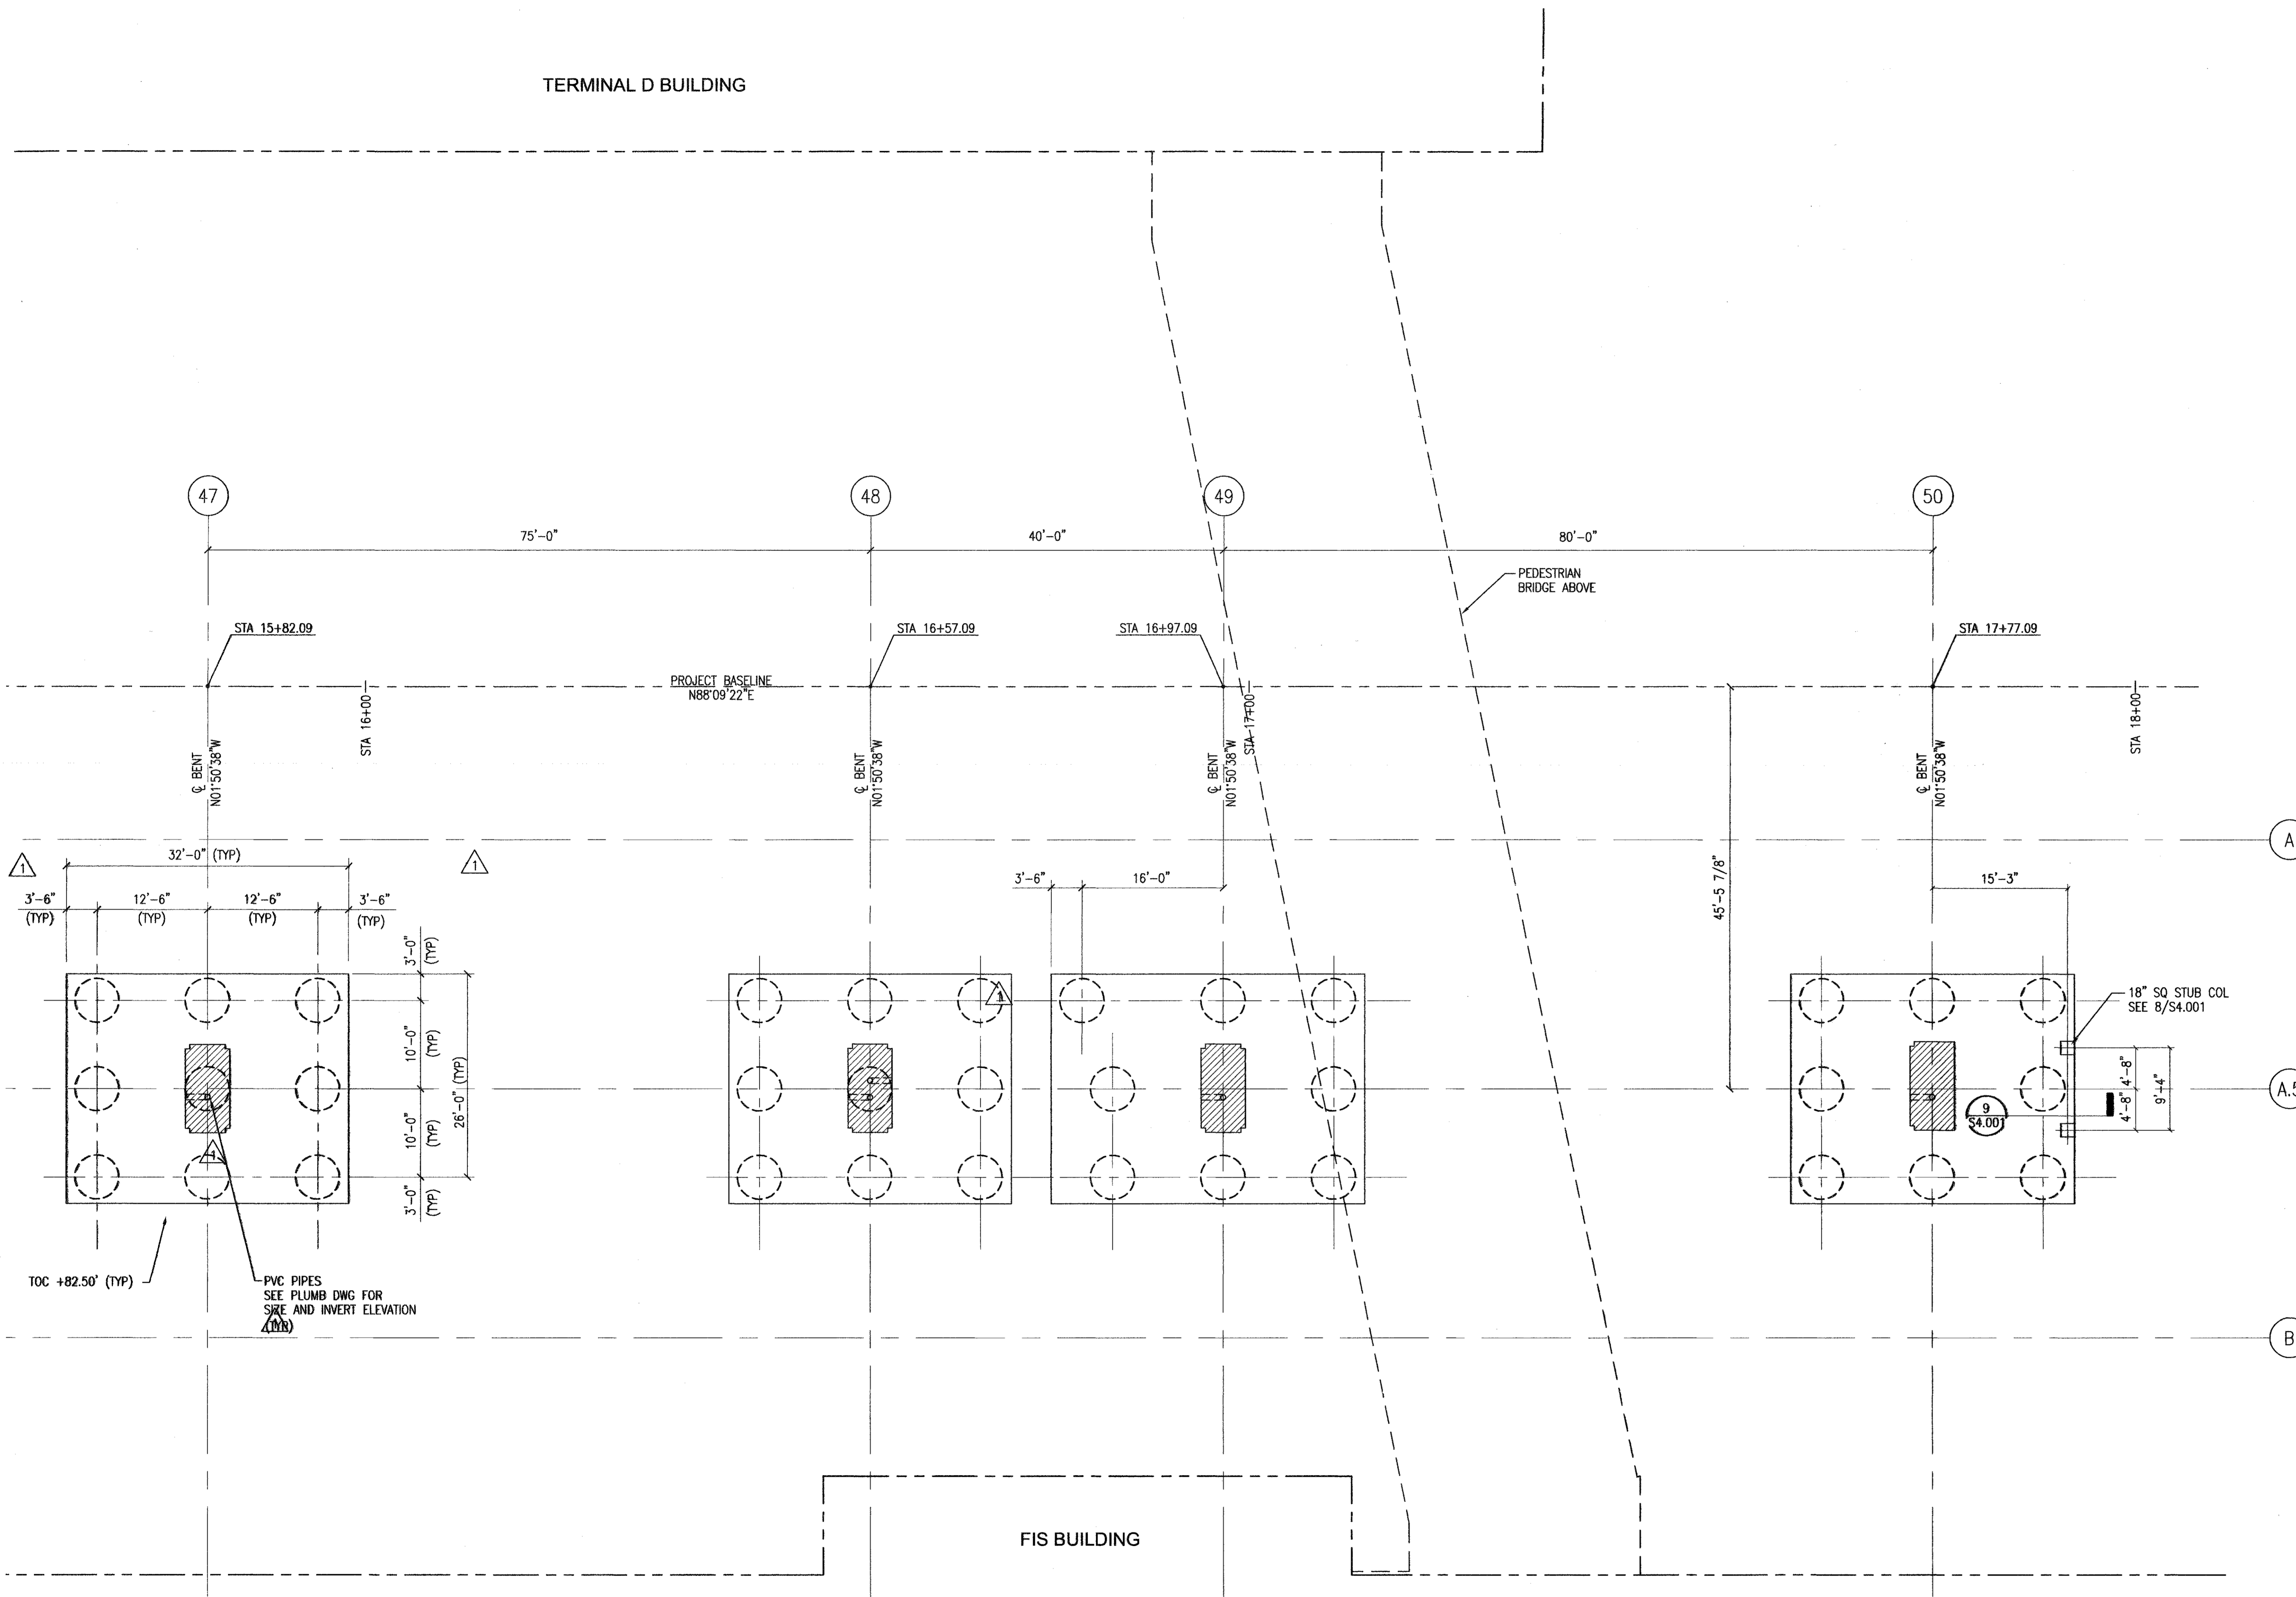

FIS BUILDING

PEDESTRIAN BRIDGE ABOVE

PROJECT BASELINE  
N88°09'22\"/>

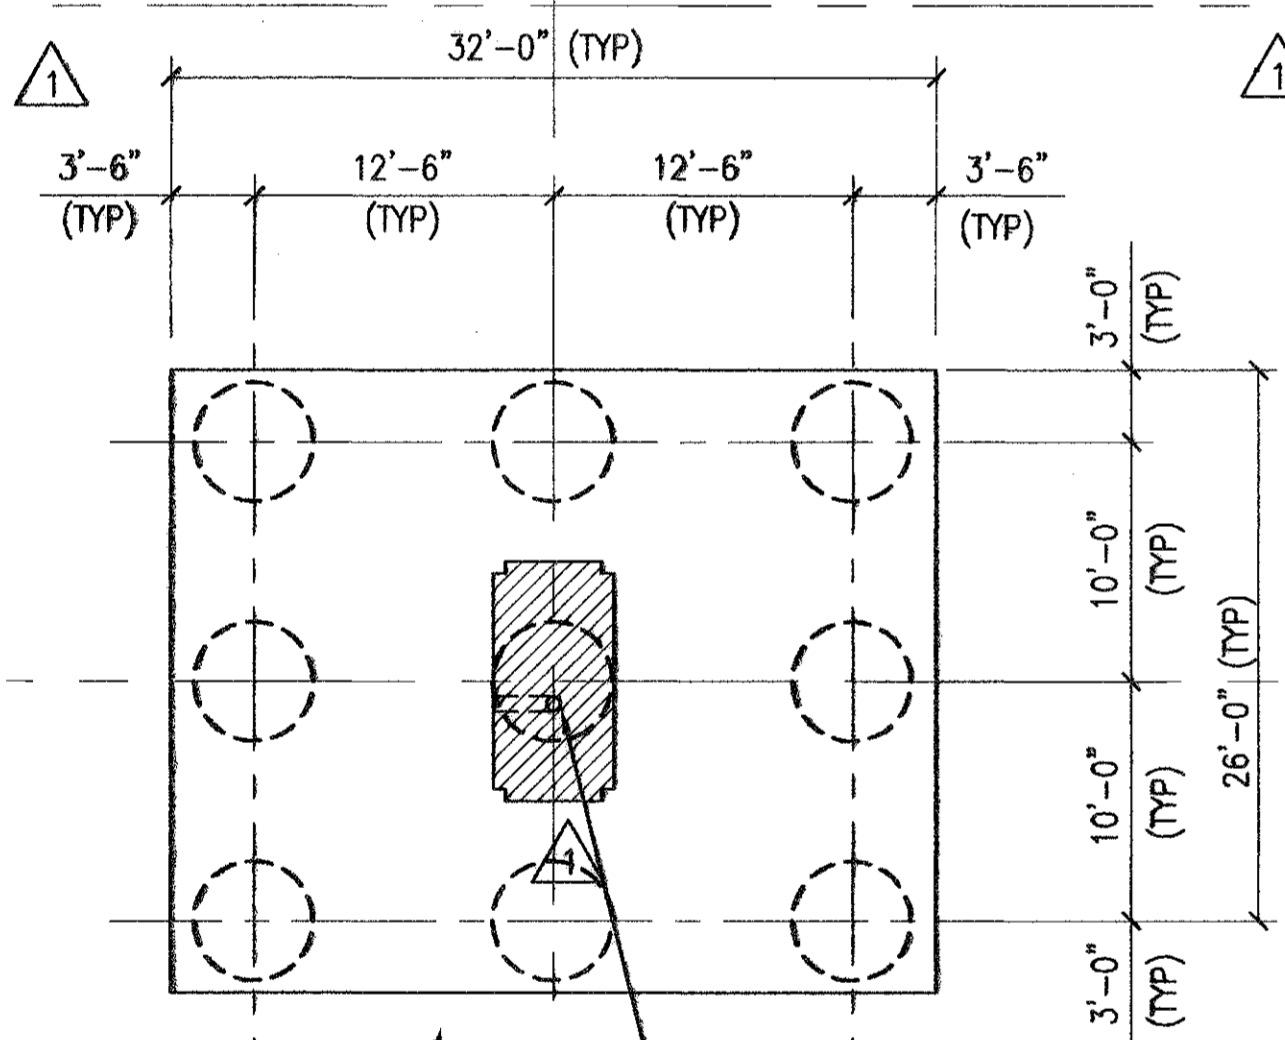

TOC +82.50' (TYP)  
PVC PIPES  
SEE PLUMB DWG FOR  
SIZE AND INVERT ELEVATION  
(10)

18" SQ STUB COL  
SEE 8/S4.001

9  
S4.001

1 FOUNDATION PLAN  
S2.001 1/8"=1'-0"

NOTES TO SHEET

- REFER TO SHEET S0.100 FOR STRUCTURAL GENERAL NOTES.
- REFER TO SHEET S6.001 FOR DRILLED SHAFT FOOTING DETAIL.

**HOUSTON AIRPORT SYSTEM**  
GEORGE BUSH  
INTERCONTINENTAL AIRPORT  
HOUSTON TEXAS

**HUITT-ZOLLARS**  
Huitt-Zollars, Inc. Engineering / Architecture  
2500 West Loop South, Suite 200, Houston, TX 77027  
Phone (281) 465-0066 Fax (281) 465-0252

**CHARLES F. TENNY, INC.**  
Consulting Engineers  
3000 West Loop South, Suite 200  
Houston, Texas 77028  
Phone (281) 465-0066 Fax (281) 465-0252

NO.	DESCRIPTION	DATE	BY
ISSUED FOR BID		10/19/01	

INTERNATIONAL • SERVICES • EXPANSION • PROGRAM  
APM STATION & PLATFORM  
FOUNDATION PLAN

PROJECT MGR:	GRW
DESIGNER:	JUC
DRAWN BY:	KLV
CHECKED BY:	MMR
DRAWING STANDARD:	ISEP 07.20.2000
SCALE:	1/8"=1'-0"
DATE:	09/14/01

N

NOTE: REFER TO GRAPHIC SCALE IF ACTUAL SHEET SIZE IS OTHER THAN 30"x42".


SCALE: 1/8" = 1'-0"

**RECORD DRAWINGS  
DO NOT MODIFY**

DATE: MAY 6, 2005

HUITT-ZOLLARS, INC.

NOTE: INFORMATION USED TO DEVELOP THESE DOCUMENTS WAS TAKEN FROM RECORD OF THE WORK DRAWINGS PREPARED BY THE CONSTRUCTION CONTRACTOR, CLARK/MISSION A JOINT VENTURE. THE INFORMATION PROVIDED BY THE CONTRACTOR WAS NOT VERIFIED BY THE DESIGN FIRM NAMED ABOVE.

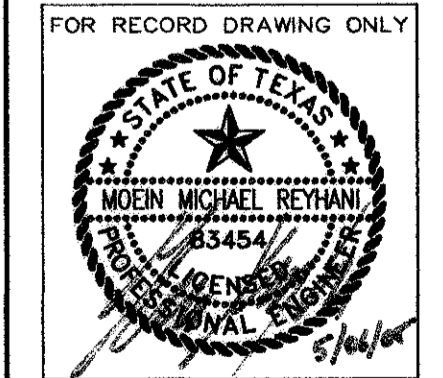

APPROVED BY:	DATE:
DIRECTOR HOUSTON AIRPORT SYSTEM	
PROJECT NO.	02-2025-01
C.I.P. NO.	A-0354
H.A.S. NO.	538C
SHEET NO.	

S2.001



PLOT DATE: 10/19/01 HAS FILE: IAS9663B01.DWG



NO.	DESCRIPTION	DATE	BY
ISSUED FOR BID	10/19/01		
ADDENDUM #1	02/01/02 MR		

NOTES TO SHEET

- REFER TO SHEET S0.100 FOR STRUCTURAL GENERAL NOTES.
- REFER TO SHEET S0.301 FOR CONCRETE BEAM SCHEDULE.
- CONCRETE STUB COLUMN AS REQ'D FOR ESCALATOR INTERMEDIATE SUPPORT. 3'-1 1/4" HIGH AFF. 12" SQ REINF W/ (4) #6 VERT AND #3 TIES @ 6" OC. PROVIDE EMBED PLATE 1/2"x8"x8" MIN W/ (4) 3/4" HEADED STUDS 8" LONG @ TOP (TYP).
- LOCATION OF STUB COLUMN TO BE VERIFIED W/ ESCALATOR MANUFACTURER PRIOR TO SUBMITTING SHOP DRAWINGS.
- PROVIDE 12" SQ CONCRETE COLUMN W/ (8) #6 VERT AND #3 TIES @ 6" OC.
- PROVIDE 12"x24" CONCRETE COLUMN W/ (10) #6 VERT AND #3 TIES @ 6" OC, (4) BARS ON EACH SHORTER SIDE.

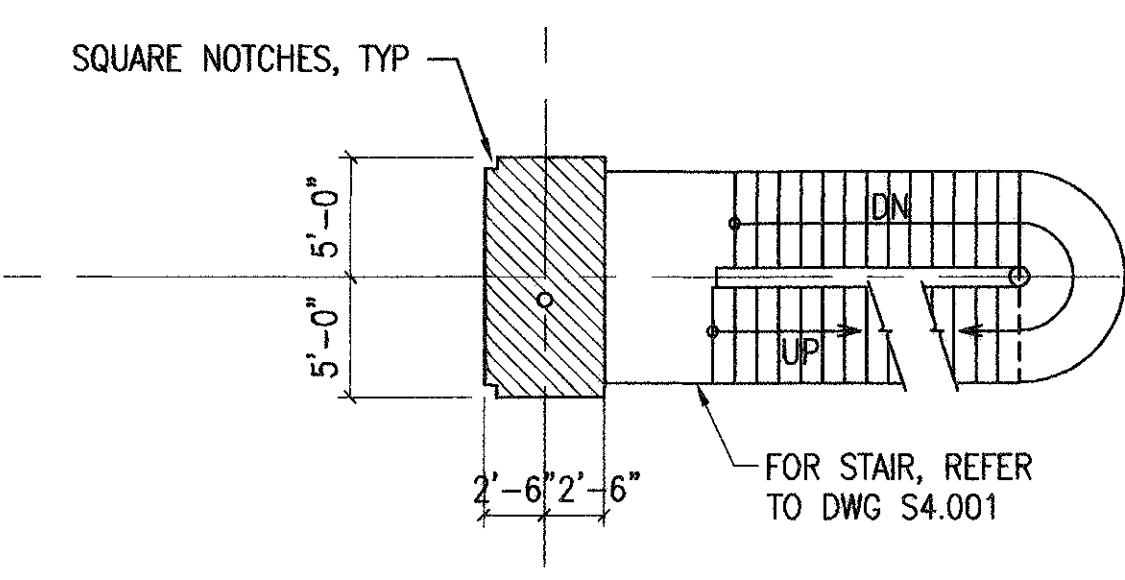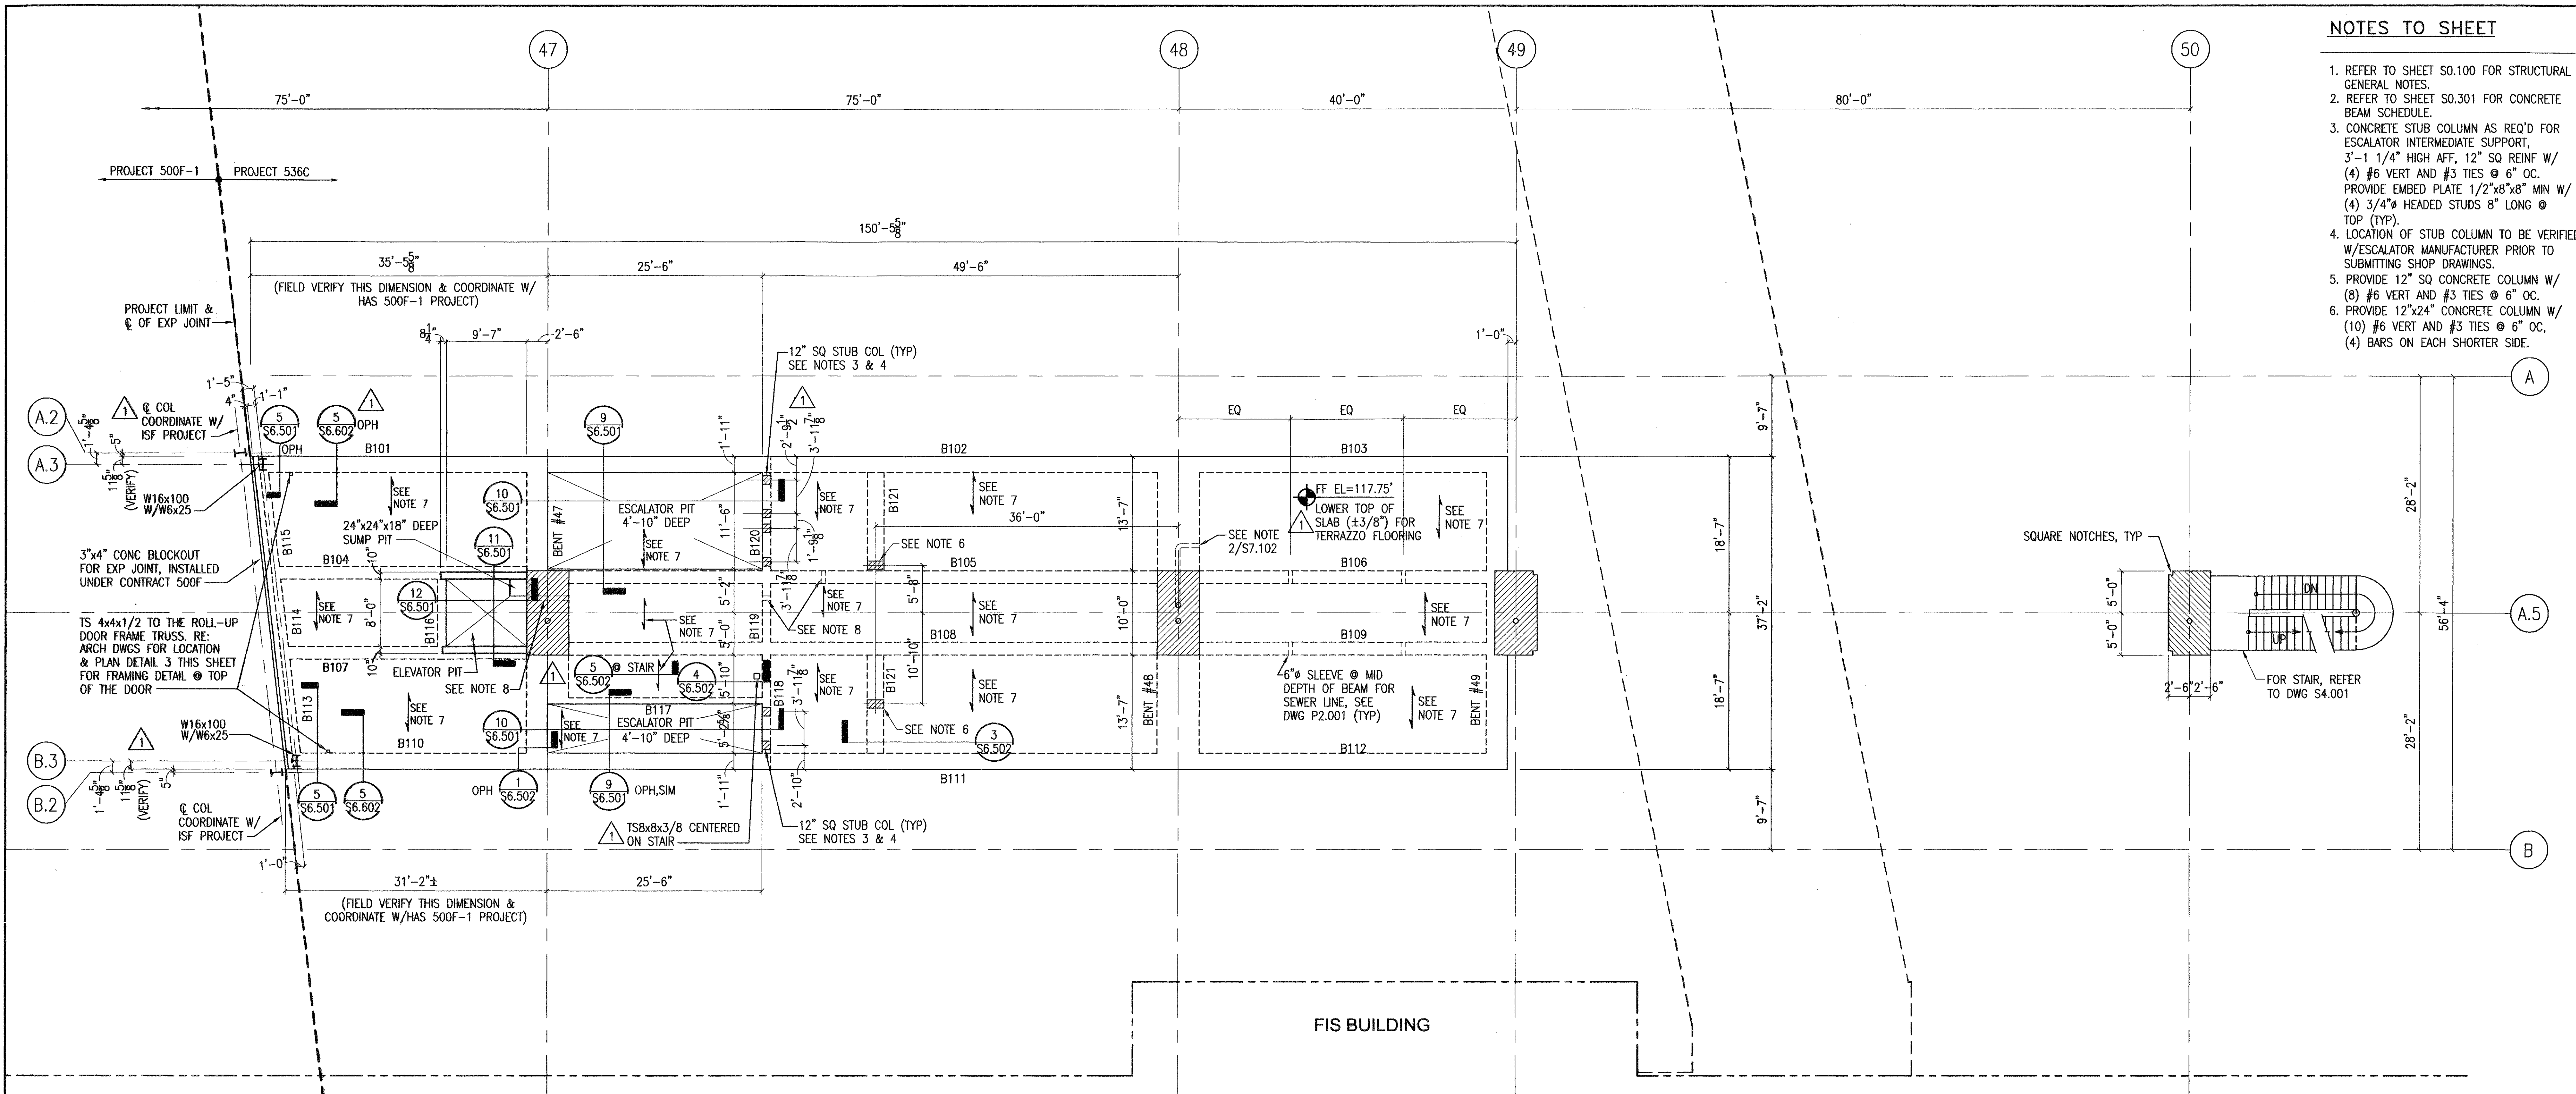


NOTES TO SHEET (CONT)

- 8" THK SLAB W/ #5 @ 12" CONT T&B IN NORTH-SOUTH DIRECTION AND #4 CONT TEMPERATURE REINF @ 16" T&B IN EAST-WEST DIRECTION. #5 TOP REINF IS CONT THROUGH ALL ADJACENT SLABS. CONTINUE & BEND THIS #5 TOP REINF FOR 3'-6" MIN INTO END SUPPORTS ALONG THE FAR END FACE.
- PVC SLEEVE THROUGH BENT, SEE NOTE 2 ON DWG S7.102.


1 LOBBY LEVEL FRAMING PLAN

S3.001 1/8"=1'-0" FIN. FLR. EL. +117'-9"

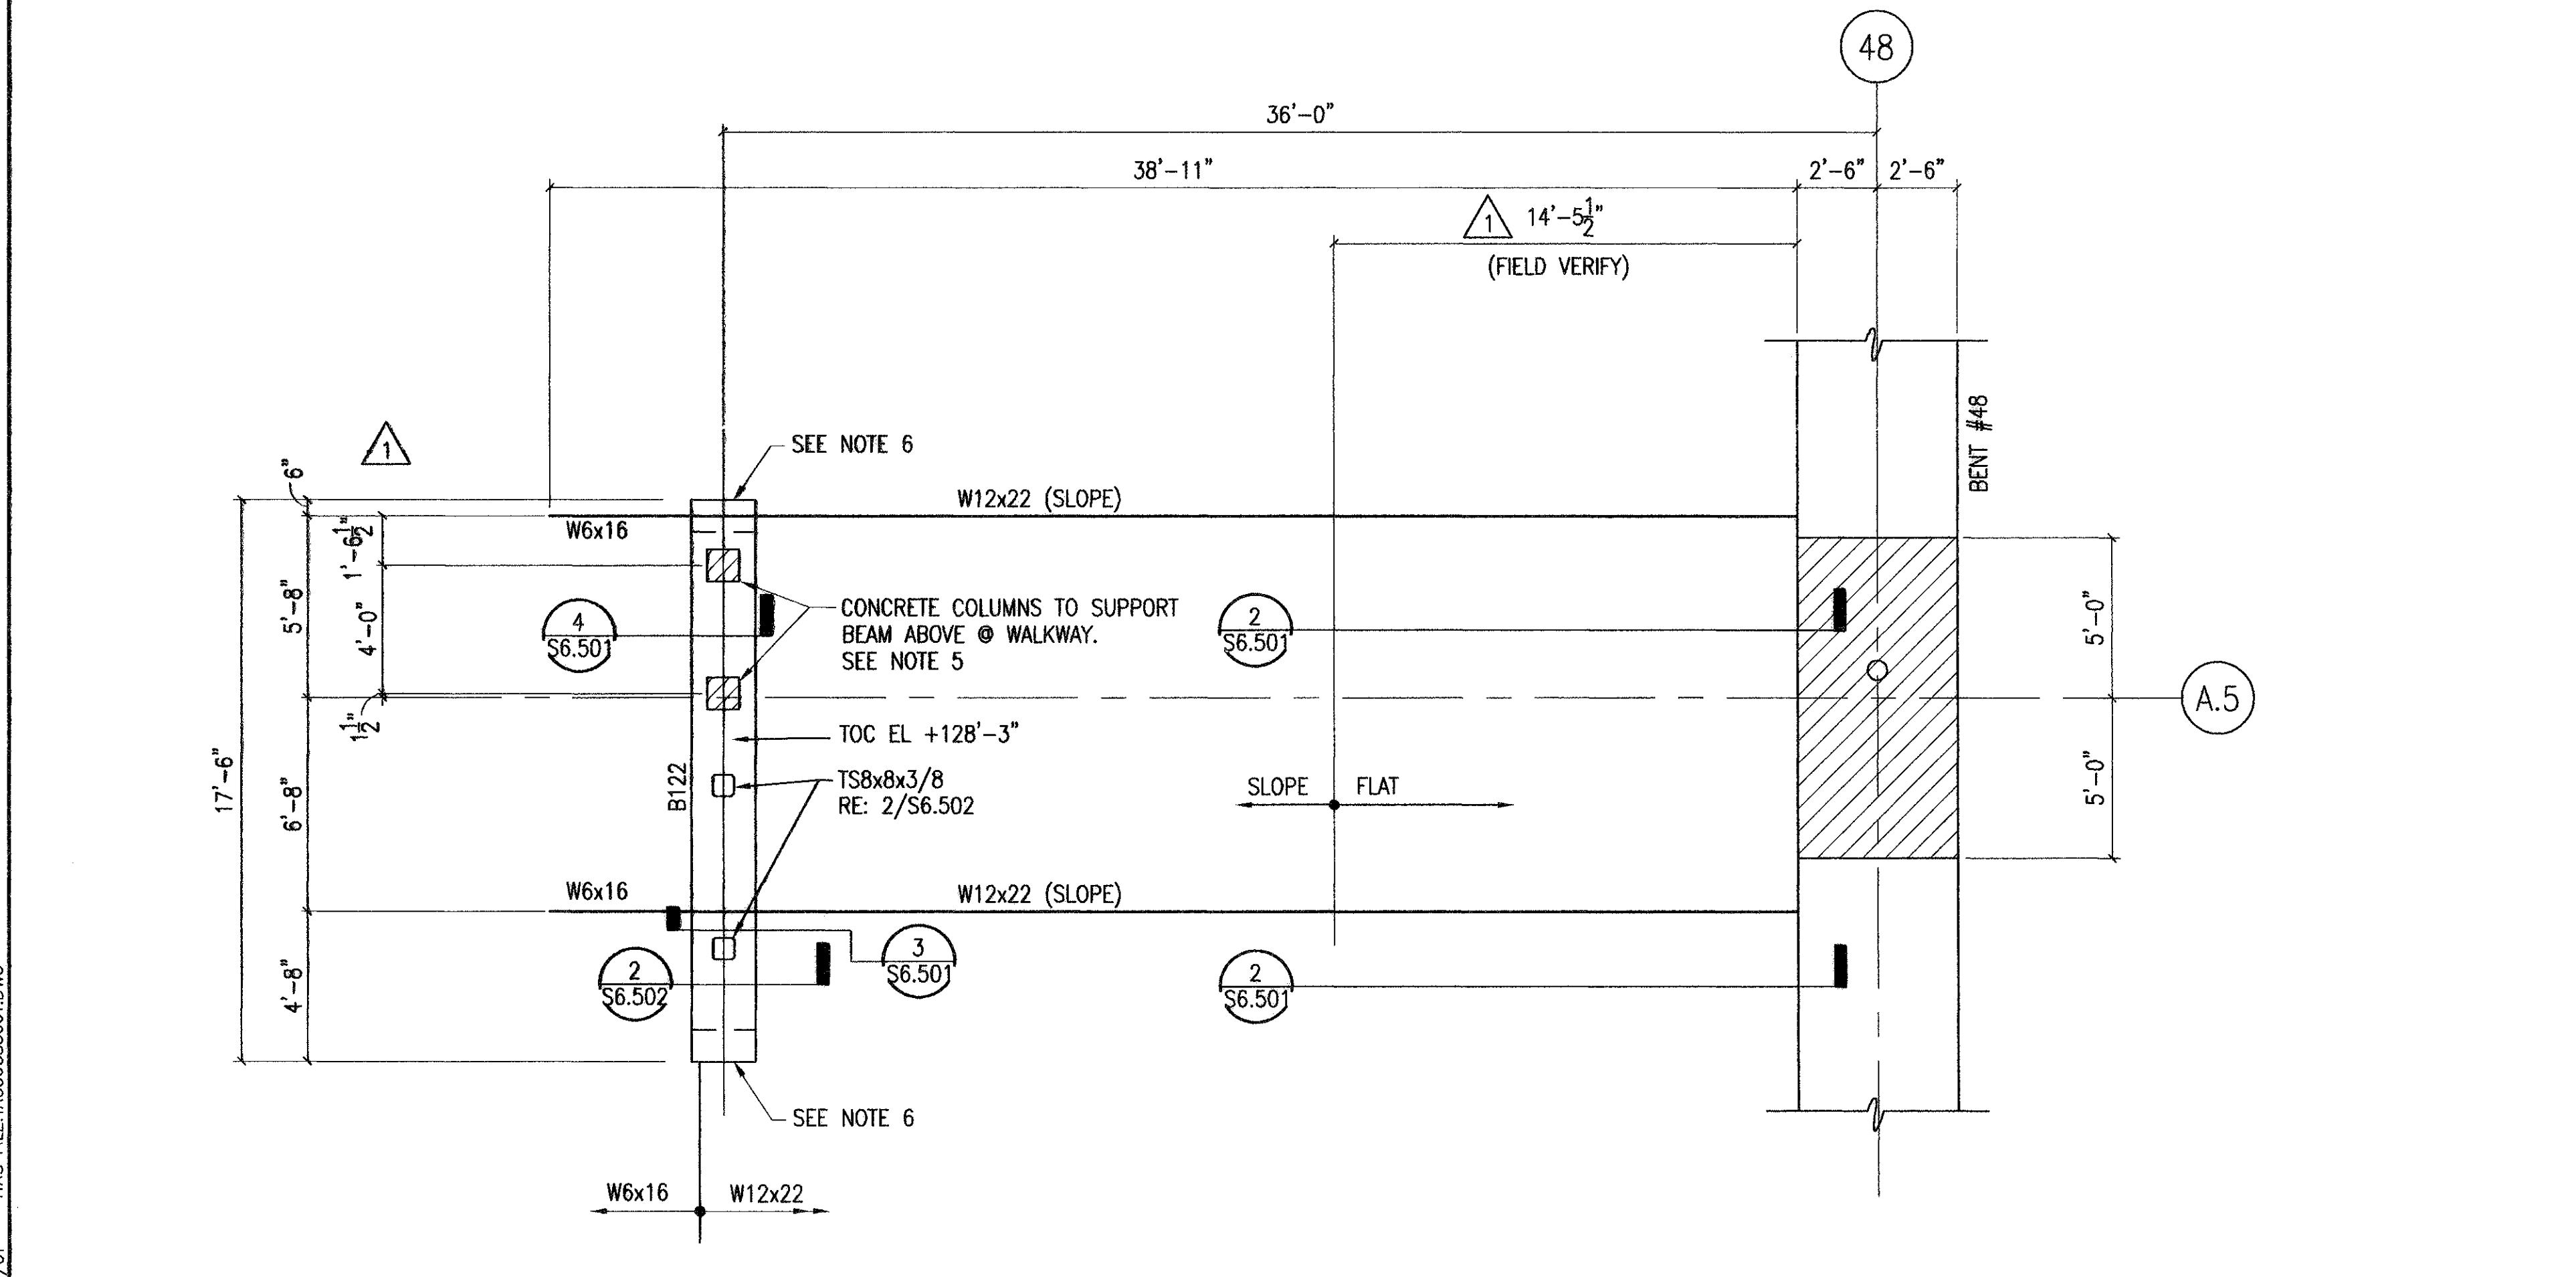


2 STAIR LANDING AND SHAFT WALL SUPPORT FRAMING PLAN

S3.001 1/4"=1'-0"

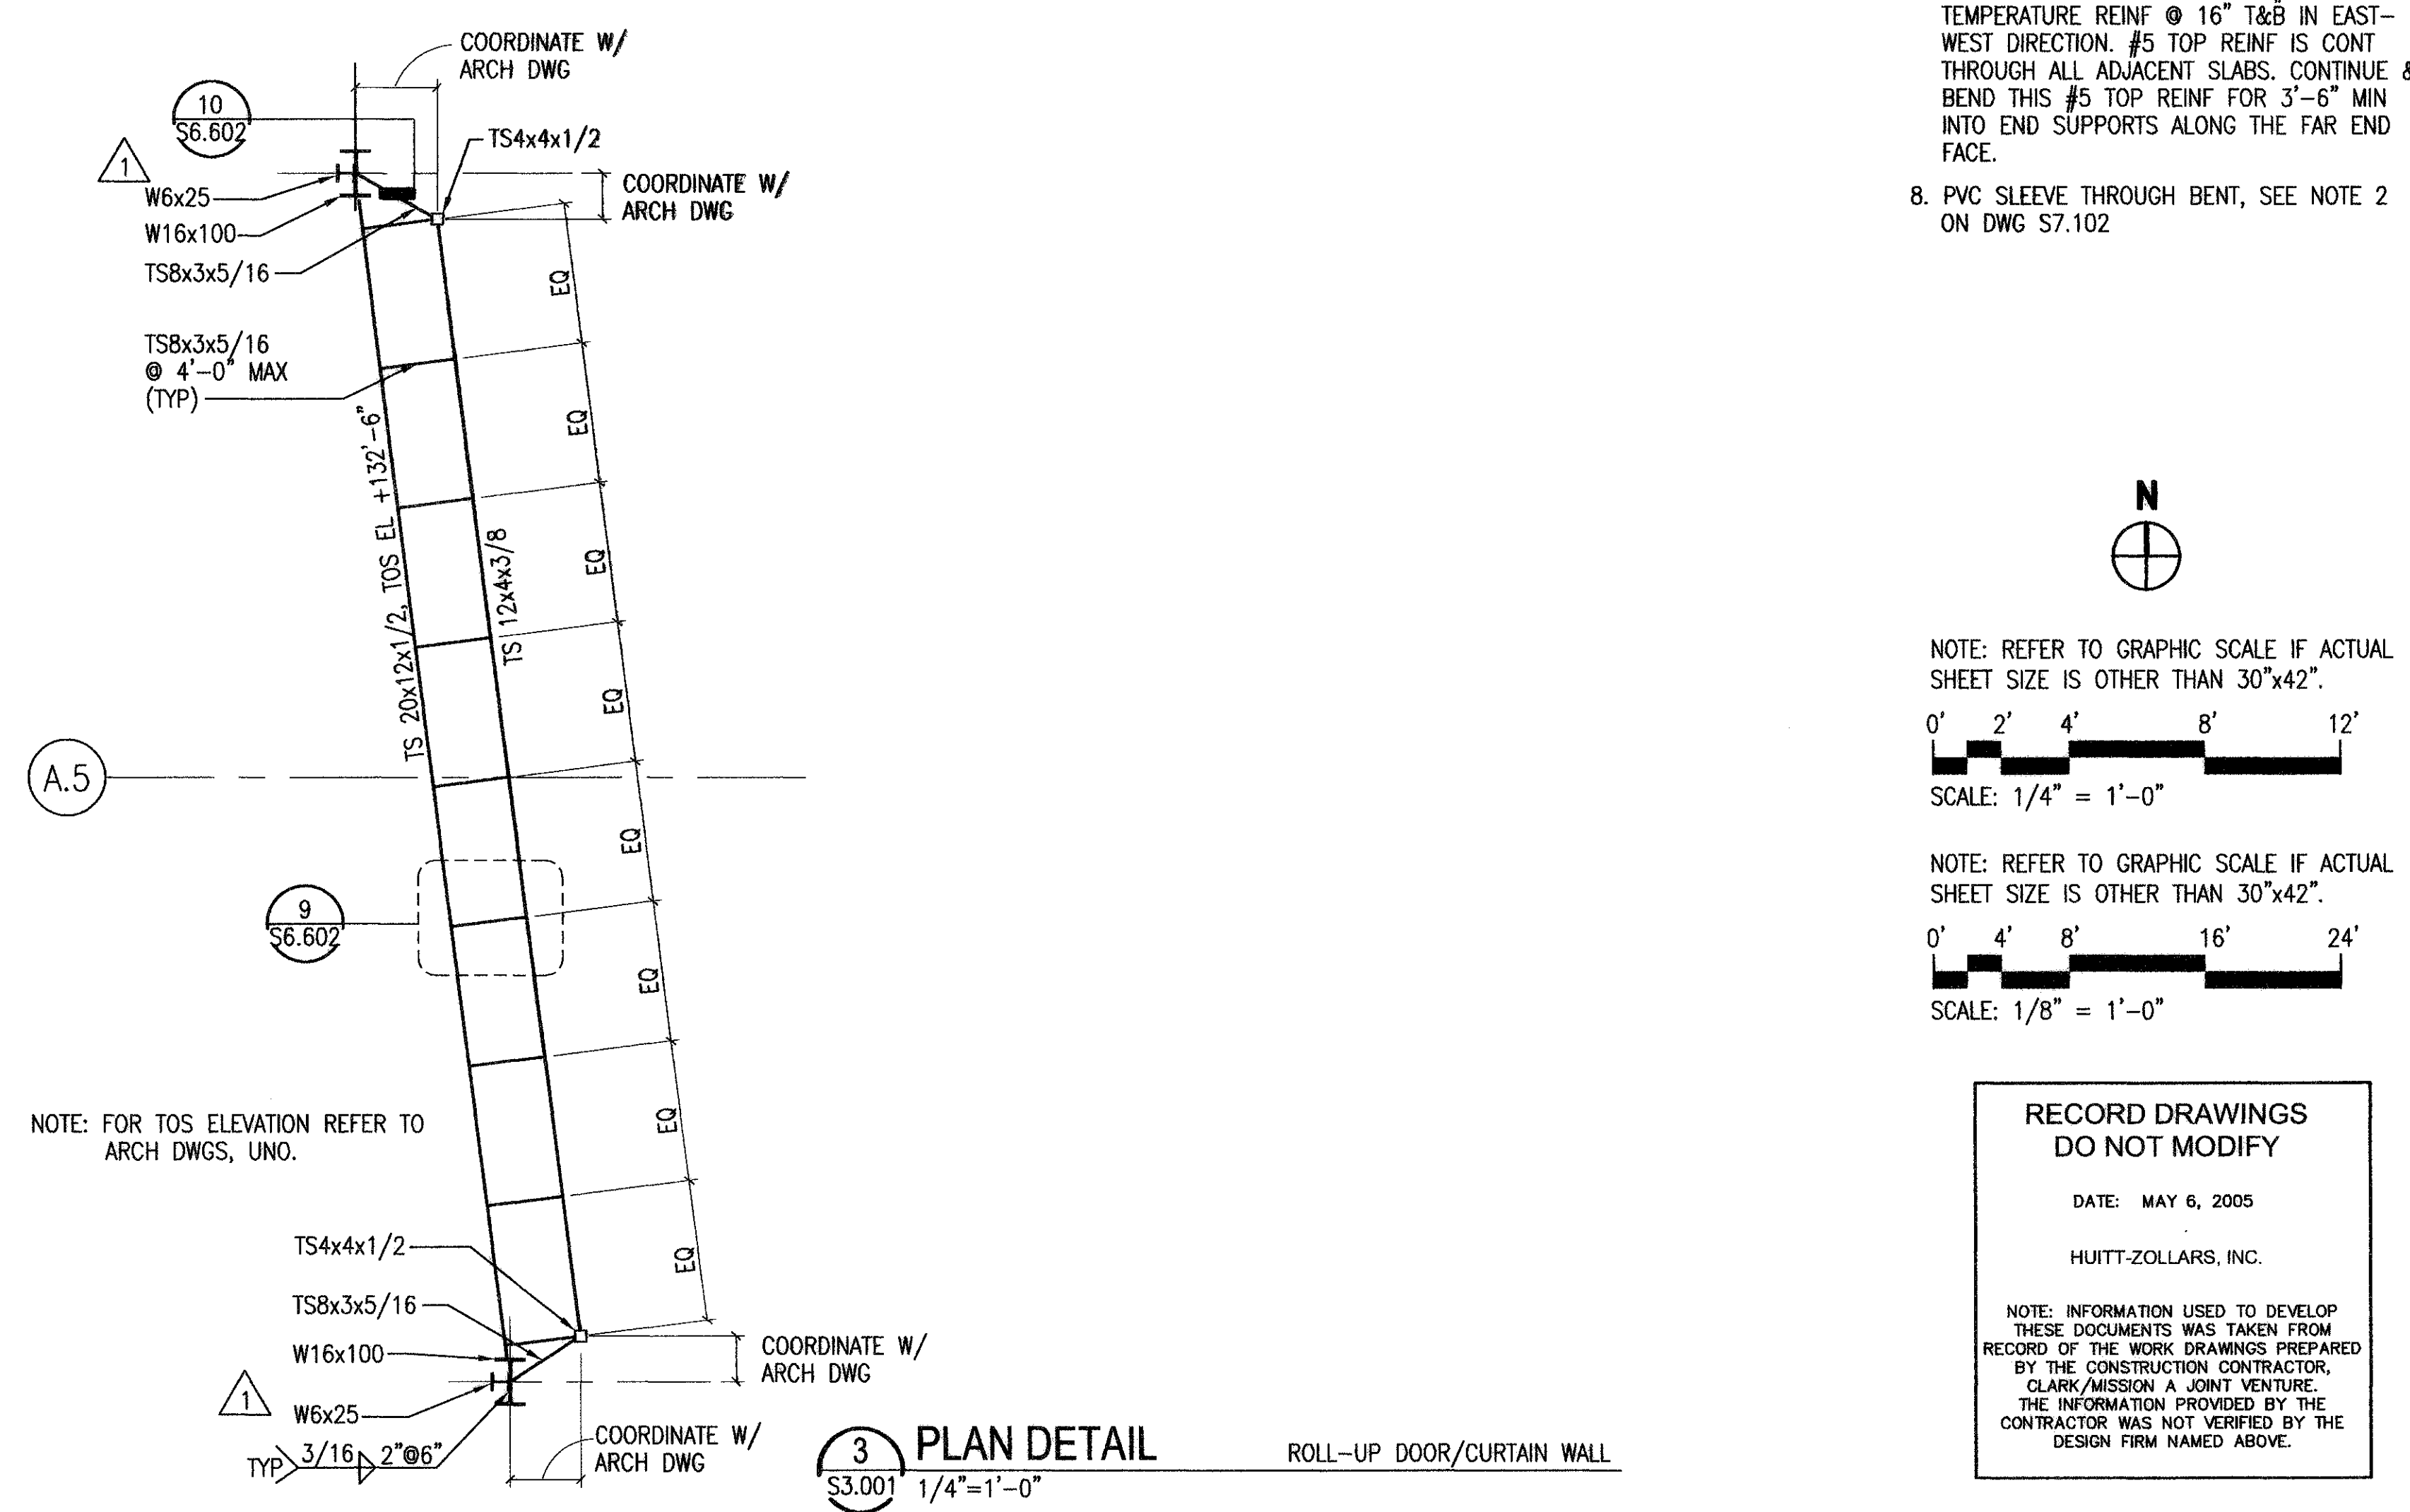

3 PLAN DETAIL

S3.001 1/4"=1'-0"

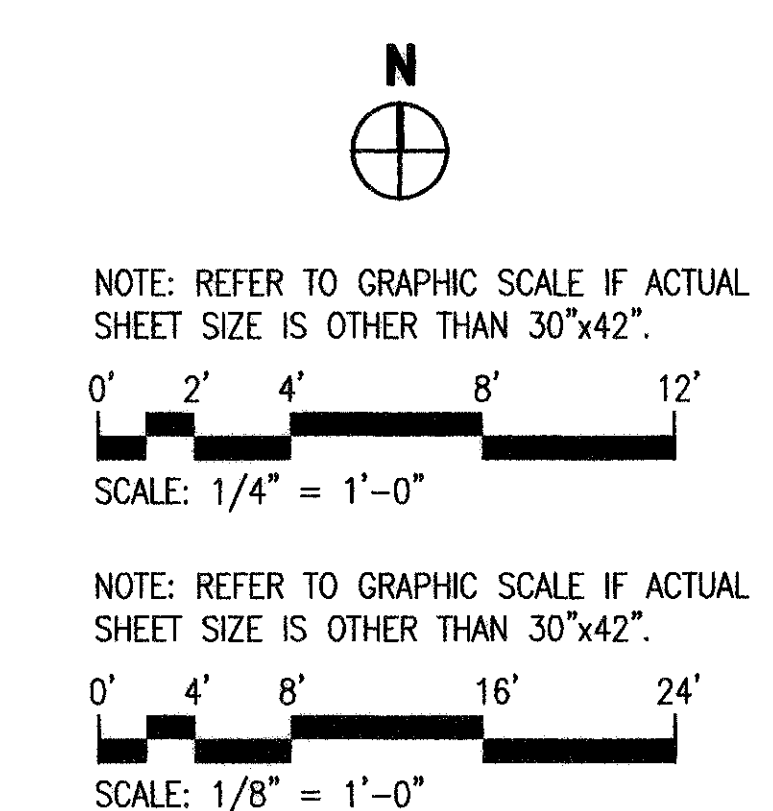

RECORD DRAWINGS  
 DO NOT MODIFY

DATE: MAY 6, 2005  
 HUTT-ZOLLARS, INC.

NOTE: INFORMATION USED TO DEVELOP THESE DOCUMENTS WAS TAKEN FROM RECORD OF THE WORK DRAWINGS PREPARED BY THE CONSTRUCTION CONTRACTOR, CLARK/MISSION A JOINT VENTURE. THE INFORMATION PROVIDED BY THE CONTRACTOR WAS NOT VERIFIED BY THE DESIGN FIRM NAMED ABOVE.

INTERNATIONAL SERVICES EXPANSION PROGRAM  
 APM STATION & PLATFORM  
 LOBBY LEVEL FRAMING PLANS

PROJECT MGR: GRW  
 DESIGNER: JUC  
 DRAWN BY: KLV  
 CHECKED BY: MMR  
 DRAWING STANDARD: ISEP 07.20.2000  
 SCALE: 1/8"=1'-0"  
 DATE: 09/14/01


FOR RECORD DRAWING ONLY  
 STATE OF TEXAS  
 MOEN MICHAEL REHMAN  
 63454  
 PROFESSIONAL SEAL

APPROVED BY: DATE:  
 DIRECTOR  
 HOUSTON AIRPORT SYSTEM

PROJECT NO. 02-2025-01  
 C.I.P. NO. A-0354  
 H.A.S. NO. 538C  
 SHEET NO.



TERMINAL D BUILDING

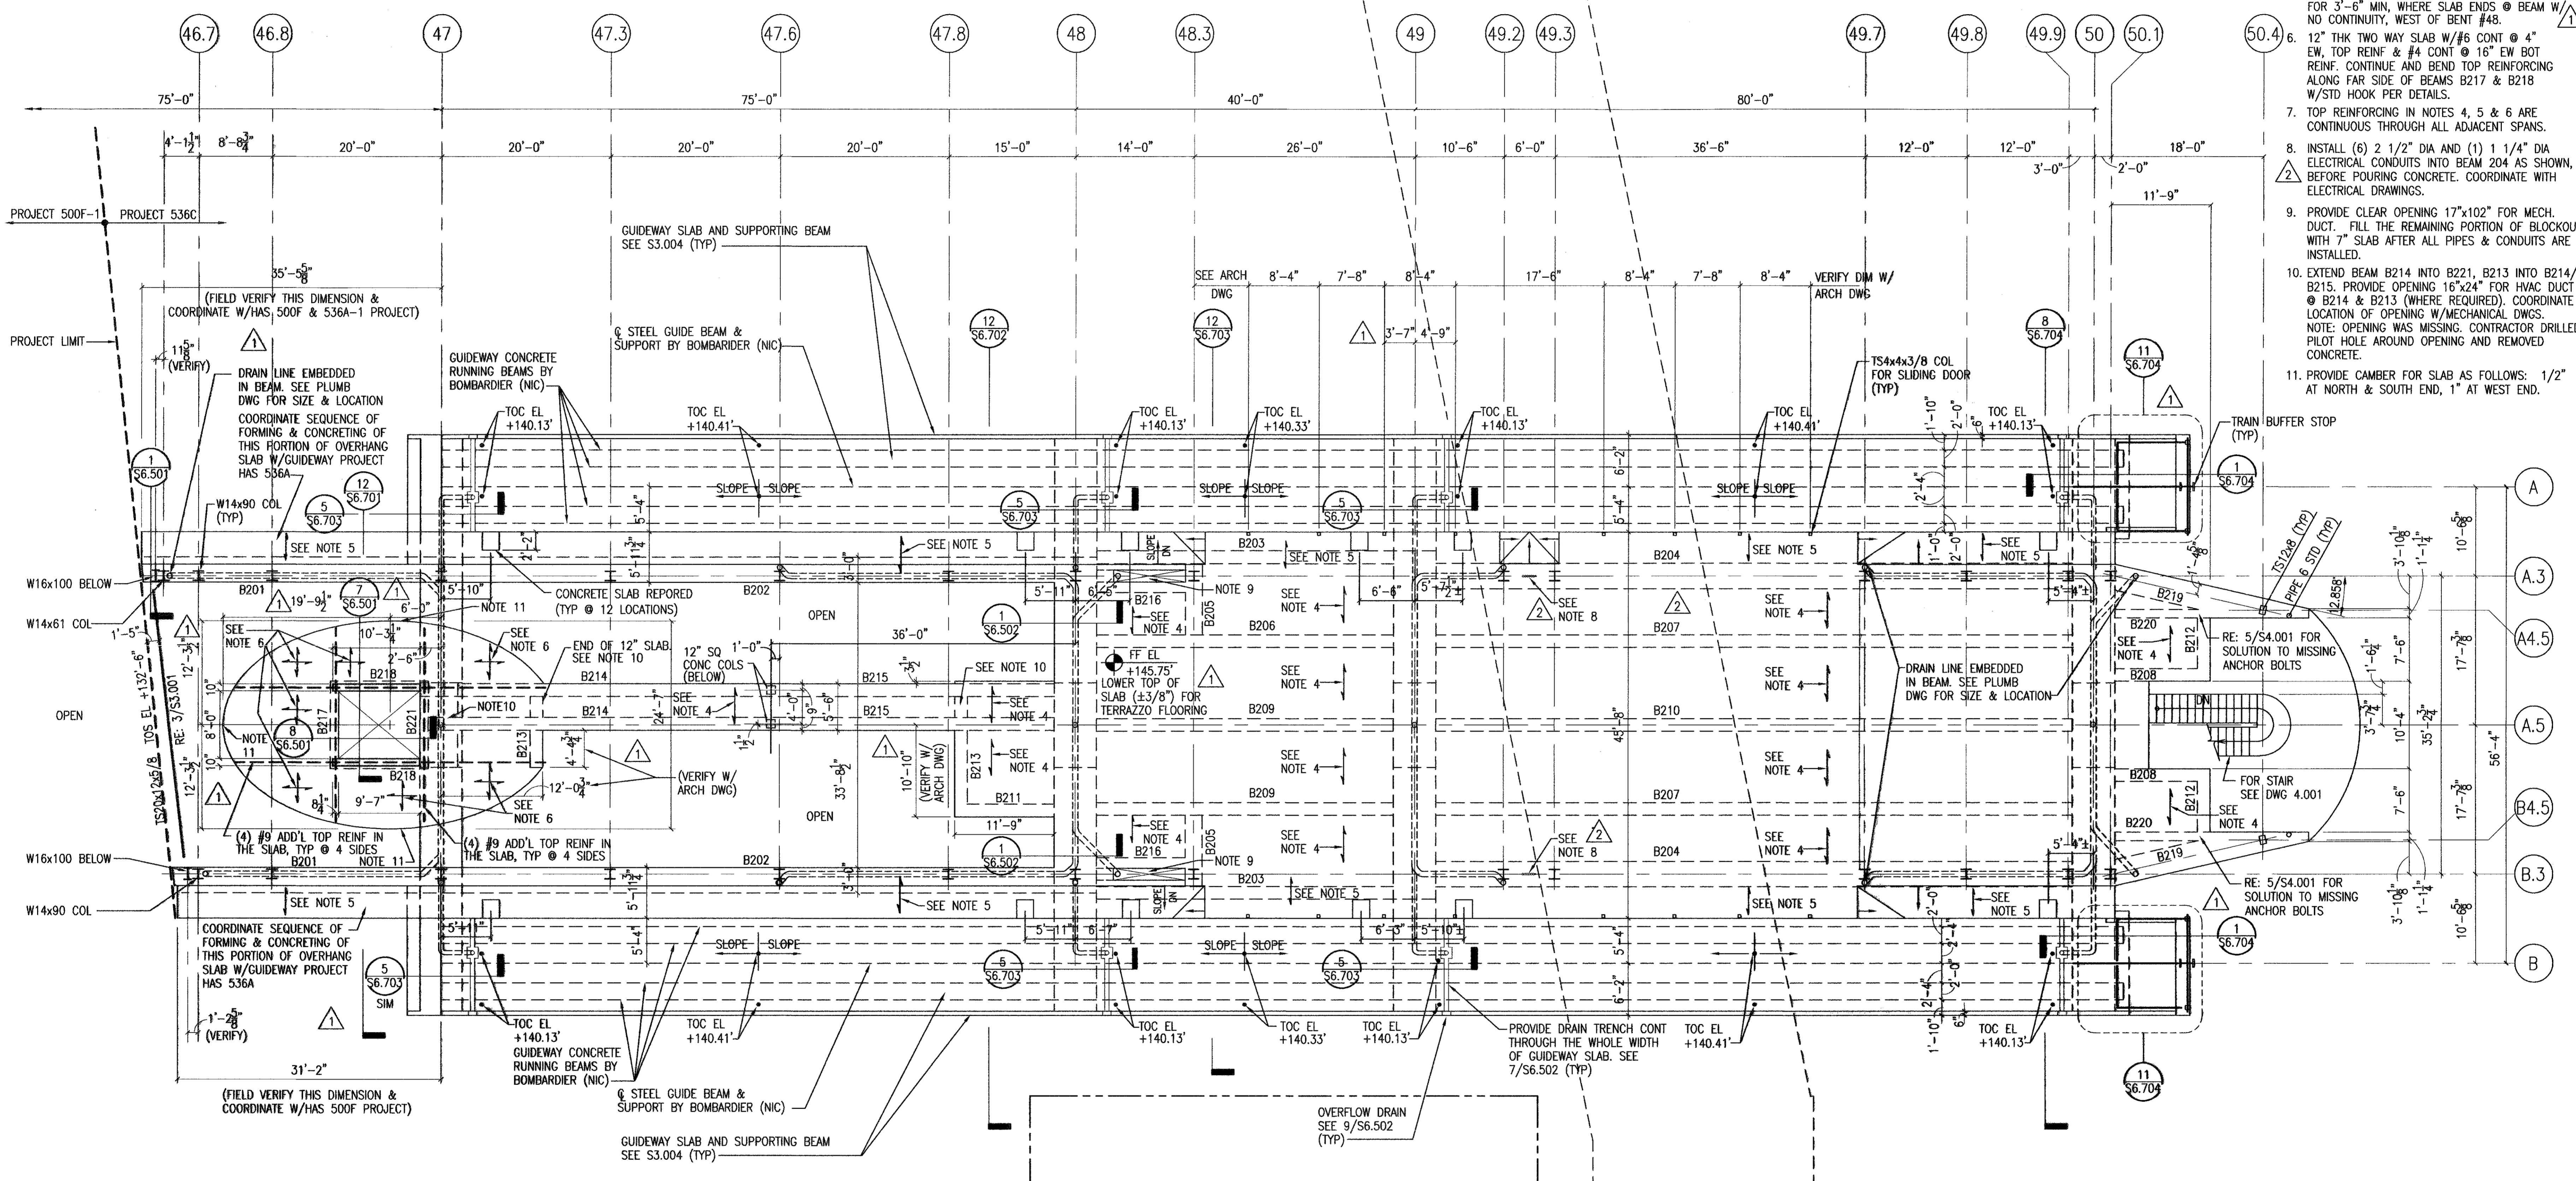

FIS BUILDING

NOTES TO SHEET

- REFER TO SHEET S0.100 FOR STRUCTURAL GENERAL NOTES.
- REFER TO SHEET S0.301 FOR CONCRETE BEAM SCHEDULE.
- DRAIN LINE TO BE EMBEDDED IN CONCRETE. SEE DWG P2.002 FOR PIPE SIZE AND LOCATION.
- 7" THK ONE WAY SLAB W/#5 CONT @ 12" T&B IN NORTH-SOUTH DIRECTION AND #4 TEMPERATURE REINFORCING @ 16" TOP & BOTTOM CONT IN EAST-WEST DIRECTION. CONTINUE AND BEND #5 TOP REINF FOR 3'-6" MIN INTO END SUPPORTS ALONG FAR END FACE.
- SLAB PER NOTE #4. CONTINUE AND BEND TOP REINFORCING ALONG FAR FACE OF BEAMS FOR 3'-6" MIN. WHERE SLAB ENDS @ BEAM W/ NO CONTINUITY, WEST OF BENT #48.
- 12" THK TWO WAY SLAB W/#6 CONT @ 4" EW, TOP REINF & #4 CONT @ 16" EW BOT REINF. CONTINUE AND BEND TOP REINFORCING ALONG FAR SIDE OF BEAMS B217 & B218 W/STD HOOK PER DETAILS.
- TOP REINFORCING IN NOTES 4, 5 & 6 ARE CONTINUOUS THROUGH ALL ADJACENT SPANS.
- INSTALL (6) 2 1/2" DIA AND (1) 1 1/4" DIA ELECTRICAL CONDUITS INTO BEAM 204 AS SHOWN, BEFORE POURING CONCRETE. COORDINATE WITH ELECTRICAL DRAWINGS.
- PROVIDE CLEAR OPENING 17"x102" FOR MECH. DUCT. FILL THE REMAINING PORTION OF BLOCKOUT WITH 7" SLAB AFTER ALL PIPES & CONDUITS ARE INSTALLED.
- EXTEND BEAM B214 INTO B221, B213 INTO B214/B215. PROVIDE OPENING 16"x24" FOR HVAC DUCT @ B214 & B213 (WHERE REQUIRED). COORDINATE LOCATION OF OPENING W/MECHANICAL DWGS. NOTE: OPENING WAS MISSING. CONTRACTOR DRILLED PILOT HOLE AROUND OPENING AND REMOVED CONCRETE.
- PROVIDE CAMBER FOR SLAB AS FOLLOWS: 1/2" AT NORTH & SOUTH END, 1" AT WEST END.

**HUITT-ZOLLARS**  
 Huitt-Zollars, Inc. Engineering / Architecture  
 1900 West Loop South, Suite 200, Houston, TX 77027  
 Phone (281) 486-0068 Fax (281) 486-0220


**CHARLES F. TERRY, INC.**  
 Consulting Engineers  
 3801 Dallas Avenue  
 Dallas, Texas 75226  
 Telephone: 714.636.6044

NO.	DESCRIPTION	DATE	BY
ISSUED FOR BID		10/19/01	
ADDENDUM #1		02/01/02	MR
REVISION #1		01/27/03	MR


INTERNATIONAL SERVICES • EXPANSION • PROGRAM

**APM STATION & PLATFORM**  
 PLATFORM LEVEL FRAMING PLAN

PROJECT MGR:	GRW
DESIGNER:	JUC
DRAWN BY:	KLV
CHECKED BY:	MMR
DRAWING STANDARD:	ISEP 07.20.2000
SCALE:	1/8" = 1'-0"
DATE:	09/14/01

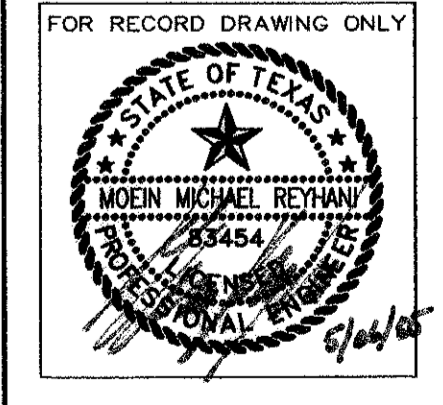

APPROVED BY:	DATE:
DIRECTOR	HOUSTON AIRPORT SYSTEM
PROJECT NO.	02-2025-01
C.I.P. NO.	A-0354
H.A.S. NO.	S302
SHEET NO.	

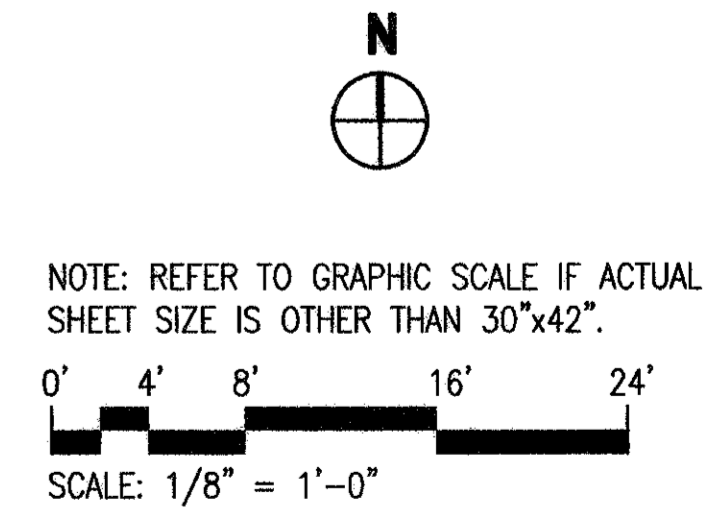

**1** PLATFORM LEVEL FRAMING PLAN  
 S3.002 1/8" = 1'-0" FIN. FLR. EL. +145'-9", UNO

**RECORD DRAWINGS DO NOT MODIFY**

DATE: MAY 6, 2005

HUITT-ZOLLARS, INC.

NOTE: INFORMATION USED TO DEVELOP THESE DOCUMENTS WAS TAKEN FROM RECORD OF THE WORK DRAWINGS PREPARED BY THE CONSTRUCTION CONTRACTOR, CLARK/MISSION A JOINT VENTURE. THE INFORMATION PROVIDED BY THE CONTRACTOR WAS NOT VERIFIED BY THE DESIGN FIRM NAMED ABOVE.



TERMINAL D BUILDING

BEAM SCHEDULE NOTES

- FR1 = W16x77 CURVED ROOF BEAM & W14x90 COL
- FR2 = W16x77 CURVED ROOF BEAM & W14x90 COL
- FR3 = W16x77 CURVED ROOF BEAM & W14x90 COL
- FR4 = W16x77 CURVED ROOF BEAM & W14x90 COL
- FR5 = PIPE 12 X-STRONG CURVED ROOF BEAM & TS 12x8x1/2 COL
- FR6 = W12x65 CURVED ROOF BEAM & W14x90 COL
- RB1 = W16 (SPLIT W12x45 SECTION TO FORM W16-W6 TAPERED BEAM)
- RB2 = W16x77 (CURVED)
- RB3 = W14x34 (CURVED)
- RB4 = C8x11.5
- RB5 = TS 20x12x3/8
- RB6 = TS 20x12x5/8
- RB7 = W14x34 (CURVED)
- RB8 = TS 6x3x1/4 (FIELD SPICE CONNECTION @ SUPPORT W/PARTIAL PENETRATION WELD)
- RB9 = W14x34 (CURVED)
- RB10 = W16x40
- RB11 = W16x77
- C10 = C10x15.3 W/FLANGES TURNED UP VERTICALLY (SEE ARCH DWGS FOR TOS ELEVATION IN RELATION TO DOOR FRAME AND ENCLOSURE)

NOTES TO SHEET


- REFER TO SHEET S0.100 FOR STRUCTURAL GENERAL NOTES.
- TOS=+156'-11 1/4" FOR PIPE 6 STD COL. PROVIDE 1/4" THK CAP PLATE WELDED TO PIPE AND PROVIDE 1" THK WING PLATE CONNECTION, FIELD WELD TO RB5.
- TOS=+156'-7 7/8" FOR PIPE 6 DIAGONAL.
- TOS=+160'-5" FOR PIPE 6 DIAGONAL @ CONNECTION TO COLUMN. COPE PIPE AND FIELD WELD TO COLUMN @ EACH END.
- PROVIDE CAP PLATE 1/4" THK, TOS=+160'-7" TO PIPE 6 STD COLUMN.
- PROVIDE 2" CAMBER TO RB1 AT END OF CANTILEVER.
- LOCATE W6x20 VERTICAL AND AT CENTER OF FRAME AND ROOF BEAM. PROVIDE SIMPLE SHEAR CONNECTION AT EACH END.
- PROVIDE 1/4" THK CAP PLATE BOLTED TO BOTTOM OF C10. PROVIDE 1/2" THK x 8" SQ BASE PLATE WELDED TO COL AND (4) 1/2"x1'-0" ANCHOR BOLTS. BASE PLATE TO BE POSITION FLUSH WITH EDGE OF SLAB. PROVIDE BLOCK-OUT IN SLAB SO THAT TOP OF BASE PLATE IS SAME ELEVATION AS TOP OF SLAB. SEE ARCH DWG FOR LOCATION OF TS4.
- PROVIDE CAP PLATE WITH AB FOR W14x61 SIMILAR TO W14x90. FOR CAP PLATE CONN TO RB5 SEE 12/S6.601 (SIM).
- PROVIDE 6" OPENING AT MID DEPTH OF RB11. VERIFY SIZE & LOCATION WITH PLUMBING DRAWINGS.

**HOUSTON AIRPORT SYSTEM**  
 GEORGE BUSH  
 INTERCONTINENTAL AIRPORT  
 HOUSTON TEXAS

**HUITT-ZOLLARS**  
 HZ-2000, Inc. Engineering / Architecture  
 1500 West Loop South, Suite 200, Houston, TX 77027  
 Phone (281) 466-0000 Fax (281) 466-0020

**CHARLES F. YENNY, INC.**  
 Consulting Engineers  
 2007 Station Avenue  
 Dallas, Texas 75228  
 (214) 343-0000

NO.	DESCRIPTION	DATE	BY
1	ISSUED FOR BD 10/19/01		
2	ADDENDUM #1 02/01/02 MR		

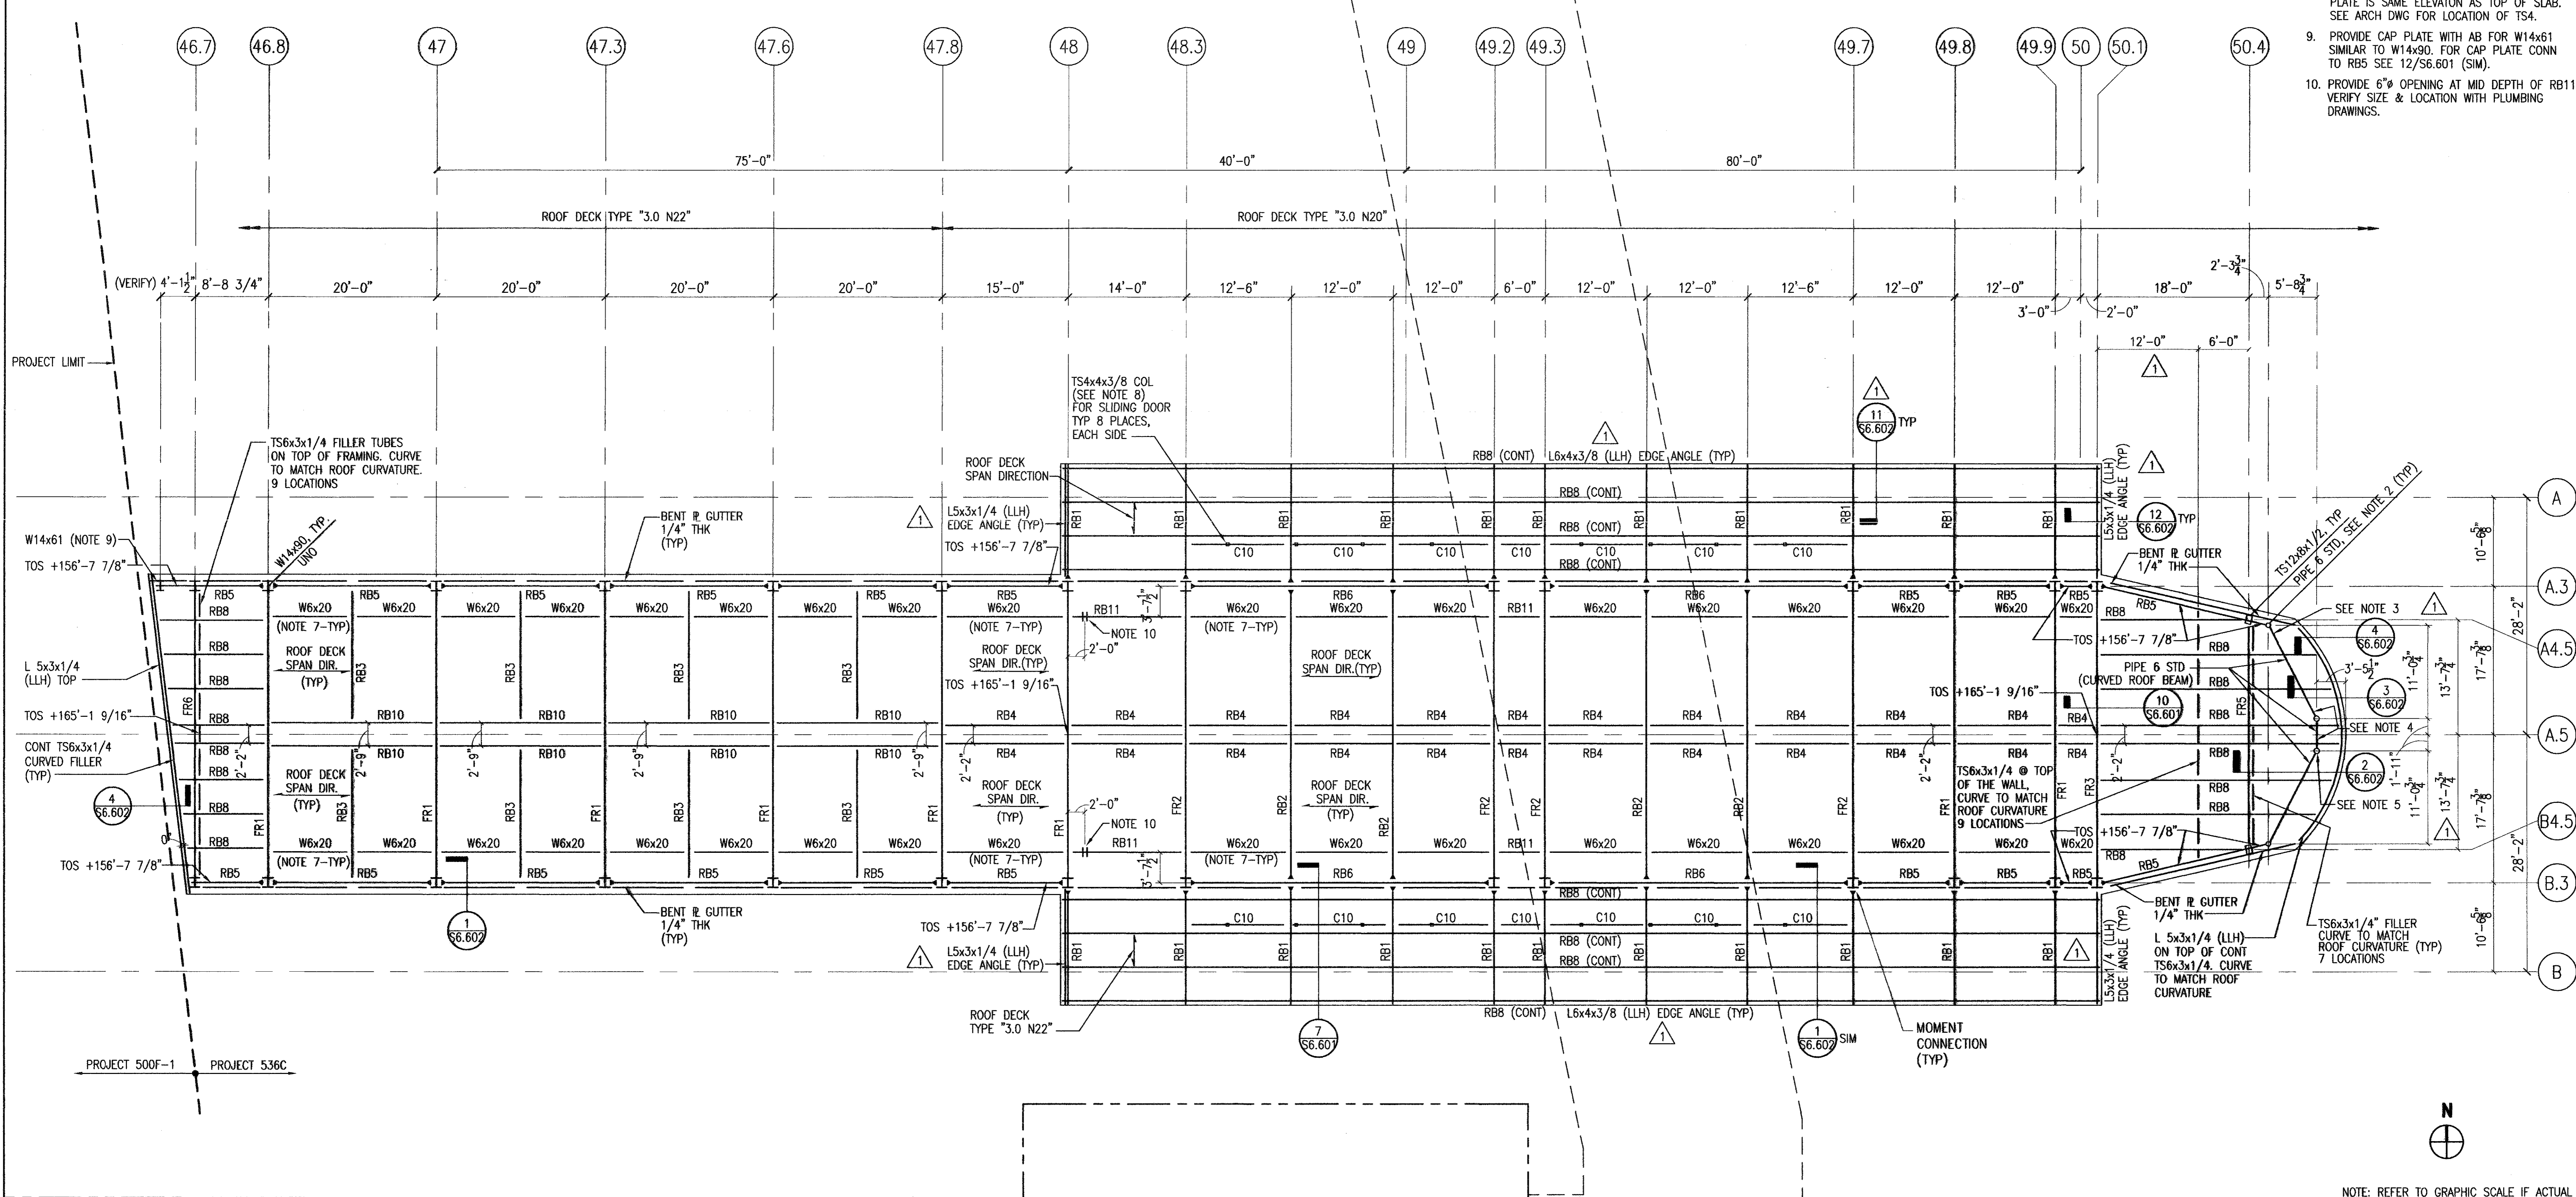

FIS BUILDING

1 ROOF FRAMING PLAN  
S3.003 1/8"=1'-0"

NOTE: REFER TO GRAPHIC SCALE IF ACTUAL SHEET SIZE IS OTHER THAN 30"x42".

0' 4' 8' 16' 24'

SCALE: 1/8" = 1'-0"

**RECORD DRAWINGS DO NOT MODIFY**

DATE: MAY 6, 2005


HUITT-ZOLLARS, INC.

NOTE: INFORMATION USED TO DEVELOP THESE DOCUMENTS WAS TAKEN FROM RECORD OF THE WORK DRAWINGS PREPARED BY THE CONSTRUCTION CONTRACTOR. CLARK/MISSION A JOINT VENTURE. THE INFORMATION PROVIDED BY THE CONTRACTOR WAS NOT VERIFIED BY THE DESIGN FIRM NAMED ABOVE.

INTERNATIONAL SERVICES • EXPANSION • PROGRAM

APM STATION & PLATFORM  
 ROOF FRAMING PLAN

PROJECT MGR: GRW  
 DESIGNER: JUC  
 DRAWN BY: KLV  
 CHECKED BY: MMR  
 DRAWING STANDARD: ISEP 07.20.2000  
 SCALE: 1/8"=1'-0"  
 DATE: 09/14/01

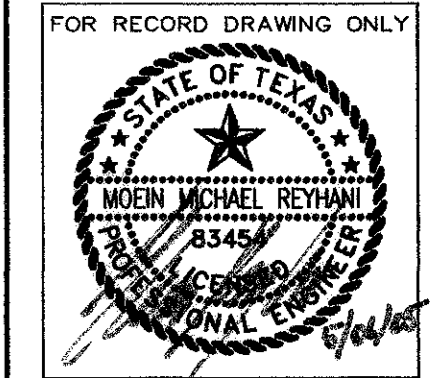

APPROVED BY: DATE:

DIRECTOR  
 HOUSTON AIRPORT SYSTEM

PROJECT NO. 02-2025-01  
 C.I.P. NO. A-0354  
 H.A.S. NO. S38C  
 SHEET NO.

S3.003

PLOT DATE: 10/19/01 HAS FILE: A363633003.DWG



NOTES TO SHEET

1. REFER TO SHEET S0.100 FOR STRUCTURAL GENERAL NOTES.
2. REFER TO SHEET S0.201 FOR PRESTRESSED CONCRETE BEAM SCHEDULES.

**HOUSTON AIRPORT SYSTEM**  
 GEORGE BUSH  
 INTERCONTINENTAL AIRPORT  
 HOUSTON TEXAS


**HUITT-ZOLLARS**  
 Engineering / Architecture  
 1500 Gray Industrial, Suite 200, Houston, TX 77077  
 Phone (281) 498-0066 Fax (281) 498-0252

**CHARLES F. YENNY, INC.**  
 Consulting Engineers  
 2801 Galveston Avenue  
 Dallas, Texas 75228  
 Phone (214) 752-1000 Fax (214) 752-1001

NO.	DESCRIPTION	DATE	BY
ISSUED FOR BID		10/19/01	

INTERNATIONAL • SERVICES • EXPANSION • PROGRAM  
**APM STATION & PLATFORM**  
 APM GUIDEWAY BEAM FRAMING PLAN

PROJECT MGR:	GRW
DESIGNER:	JUC
DRAWN BY:	CTA
CHECKED BY:	MMR
DRAWING STANDARD:	ISEP 07.20.2000
SCALE:	1"=10'
DATE:	09/14/01

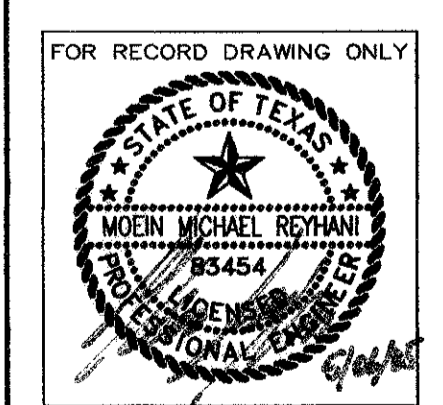


APPROVED BY:	DATE:
DIRECTOR	
HOUSTON AIRPORT SYSTEM	
PROJECT NO.	02-2025-01
C.I.P. NO.	A-0354
H.A.S. NO.	538C
SHEET NO.	

**RECORD DRAWINGS  
 DO NOT MODIFY**

DATE: MAY 6, 2005

HUITT-ZOLLARS, INC.

NOTE: INFORMATION USED TO DEVELOP THESE DOCUMENTS WAS TAKEN FROM RECORD OF THE WORK DRAWINGS PREPARED BY THE CONSTRUCTION CONTRACTOR, CLARK/MISSION A JOINT VENTURE. THE INFORMATION PROVIDED BY THE CONTRACTOR WAS NOT VERIFIED BY THE DESIGN FIRM NAMED ABOVE.

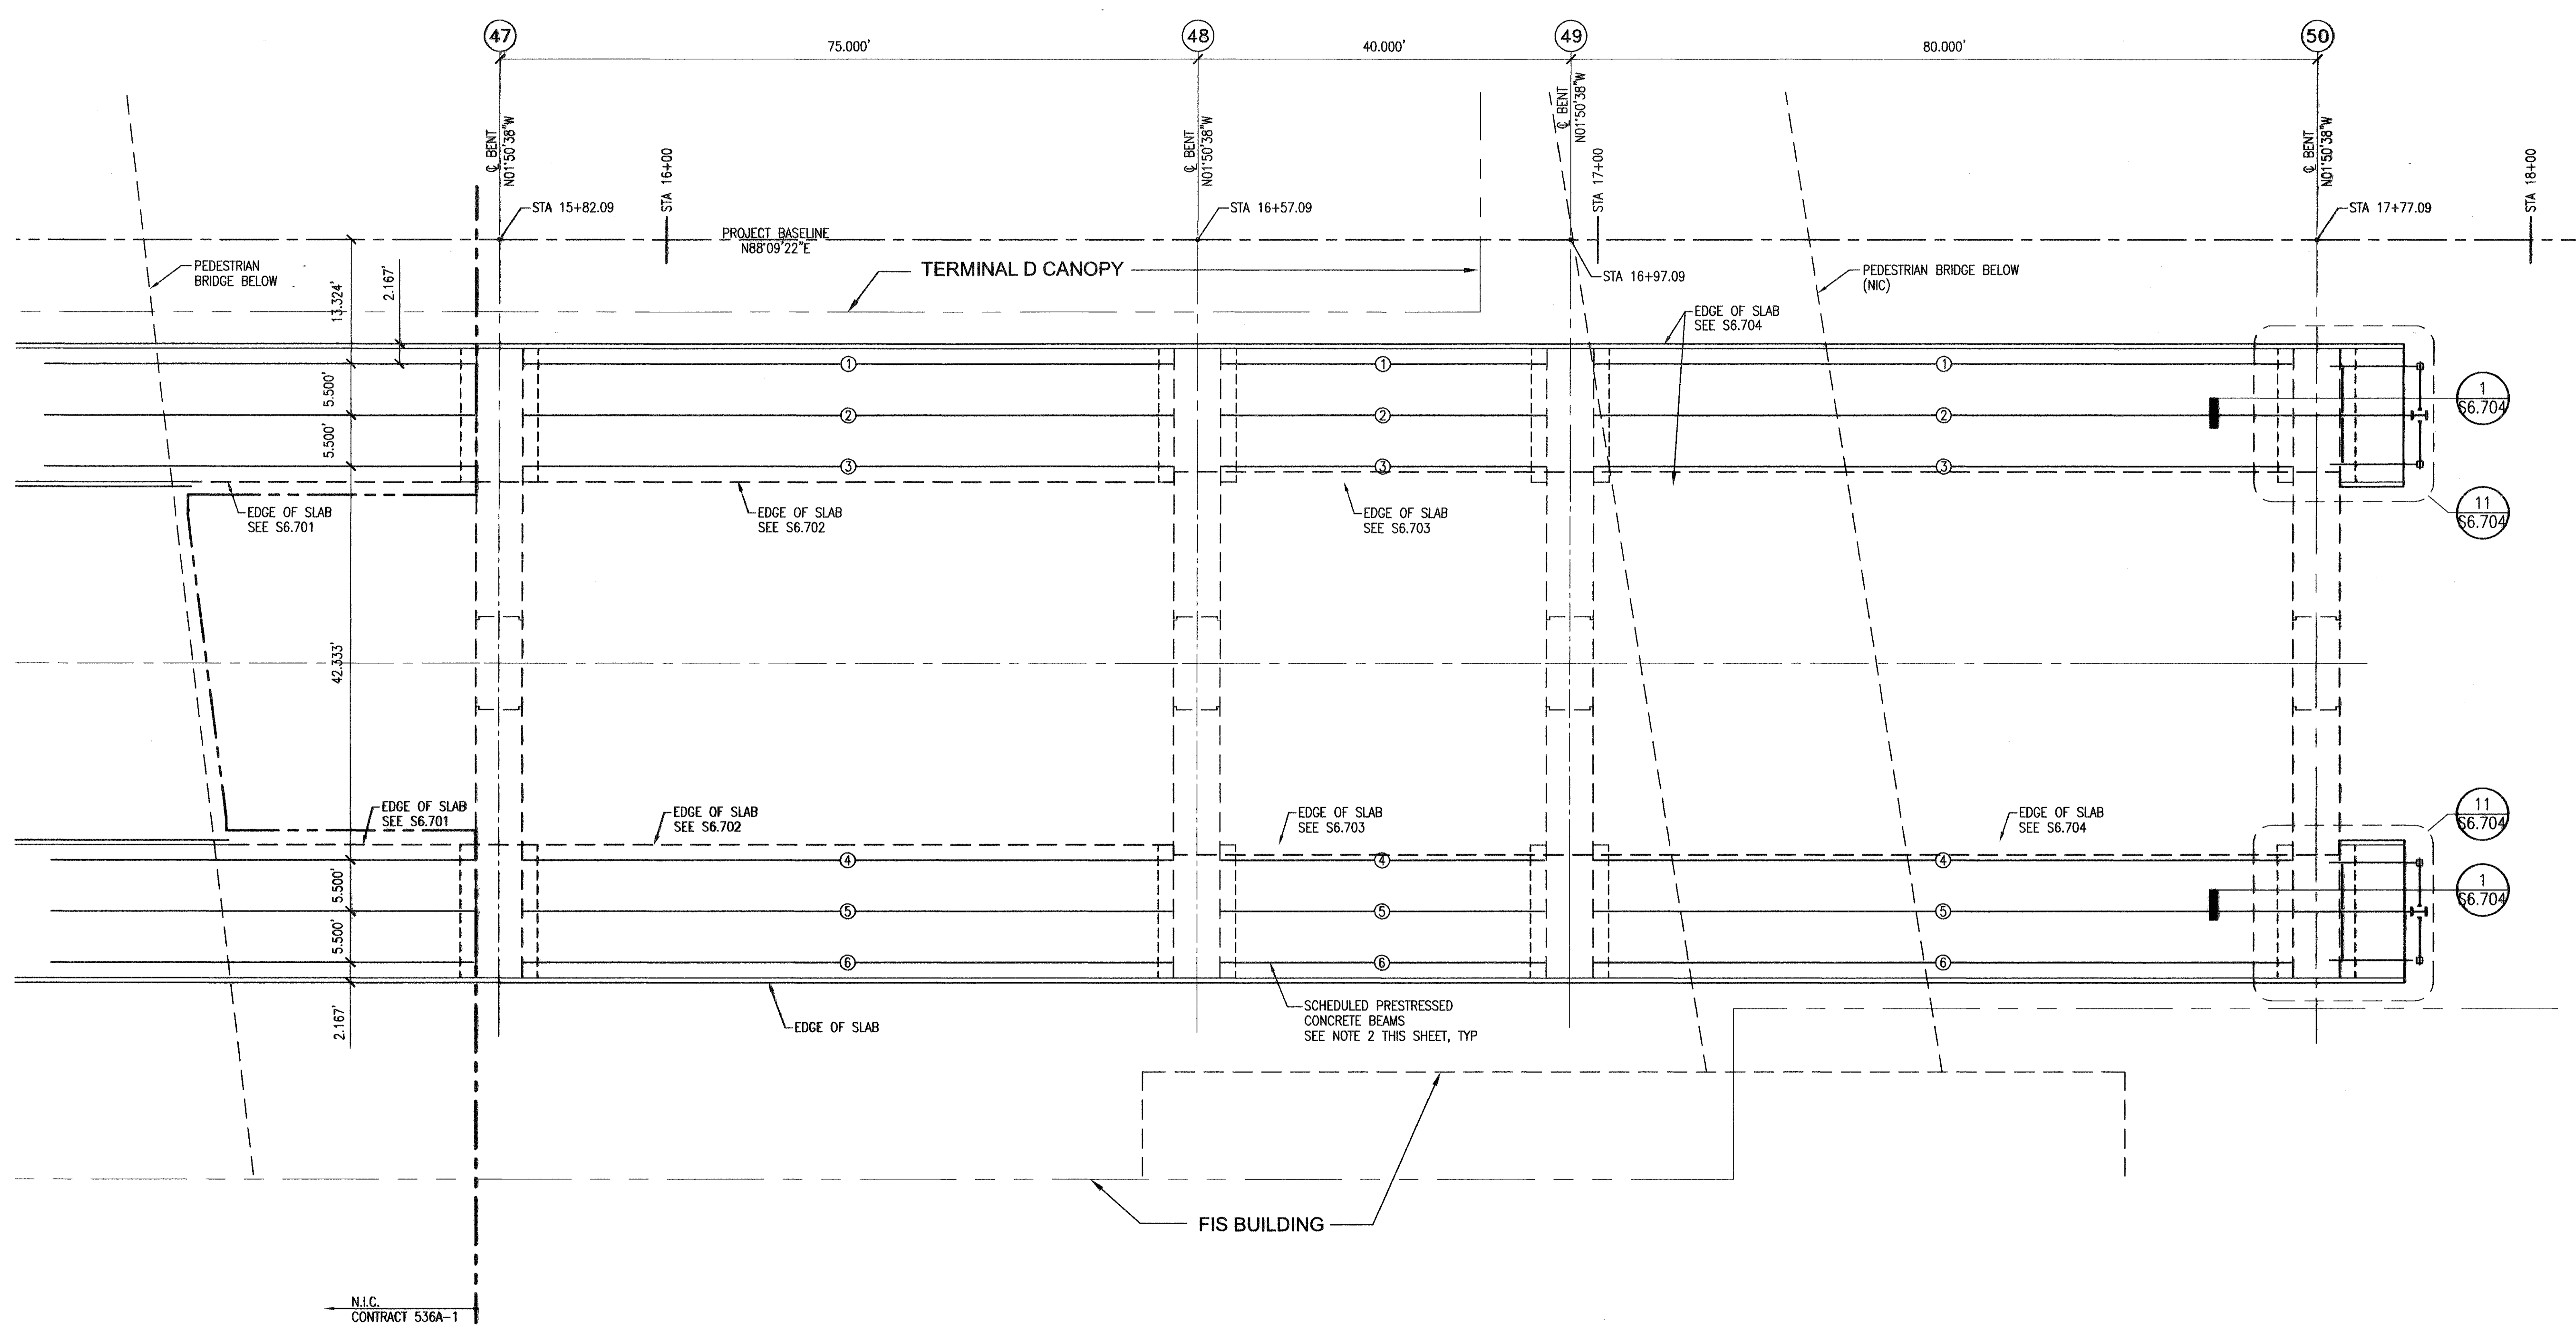


N.I.C.  
 CONTRACT 536A-1

**1 APM GUIDEWAY FRAMING PLAN**  
 S3.004 1" = 10'


S3.004

PLOT DATE: 10/19/01 HAS FILE: A3363633004.DWG




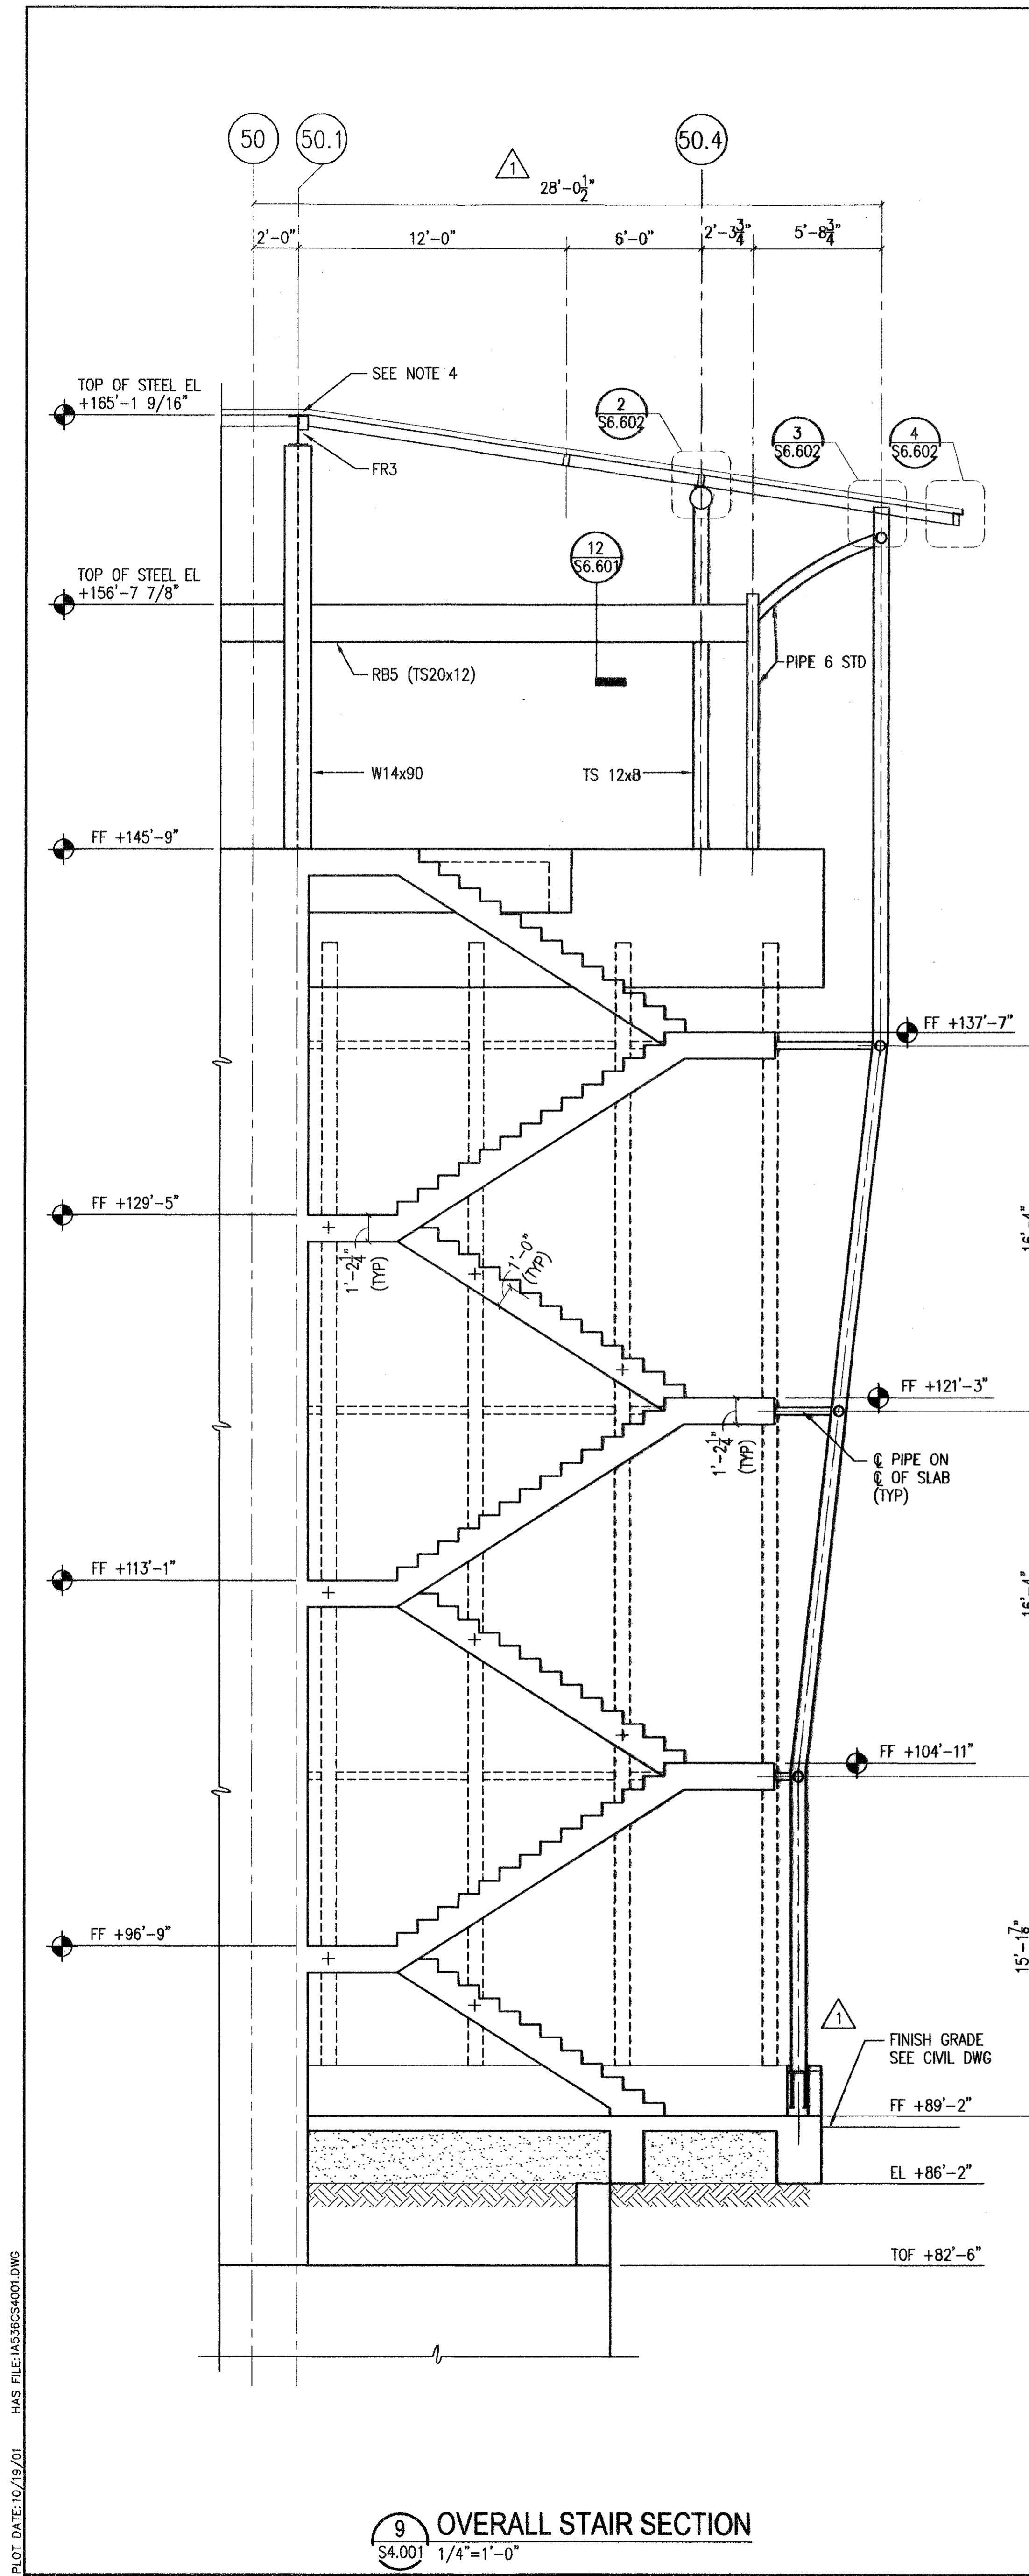


**9 OVERALL STAIR SECTION**  
S4.001 1/4"=1'-0"

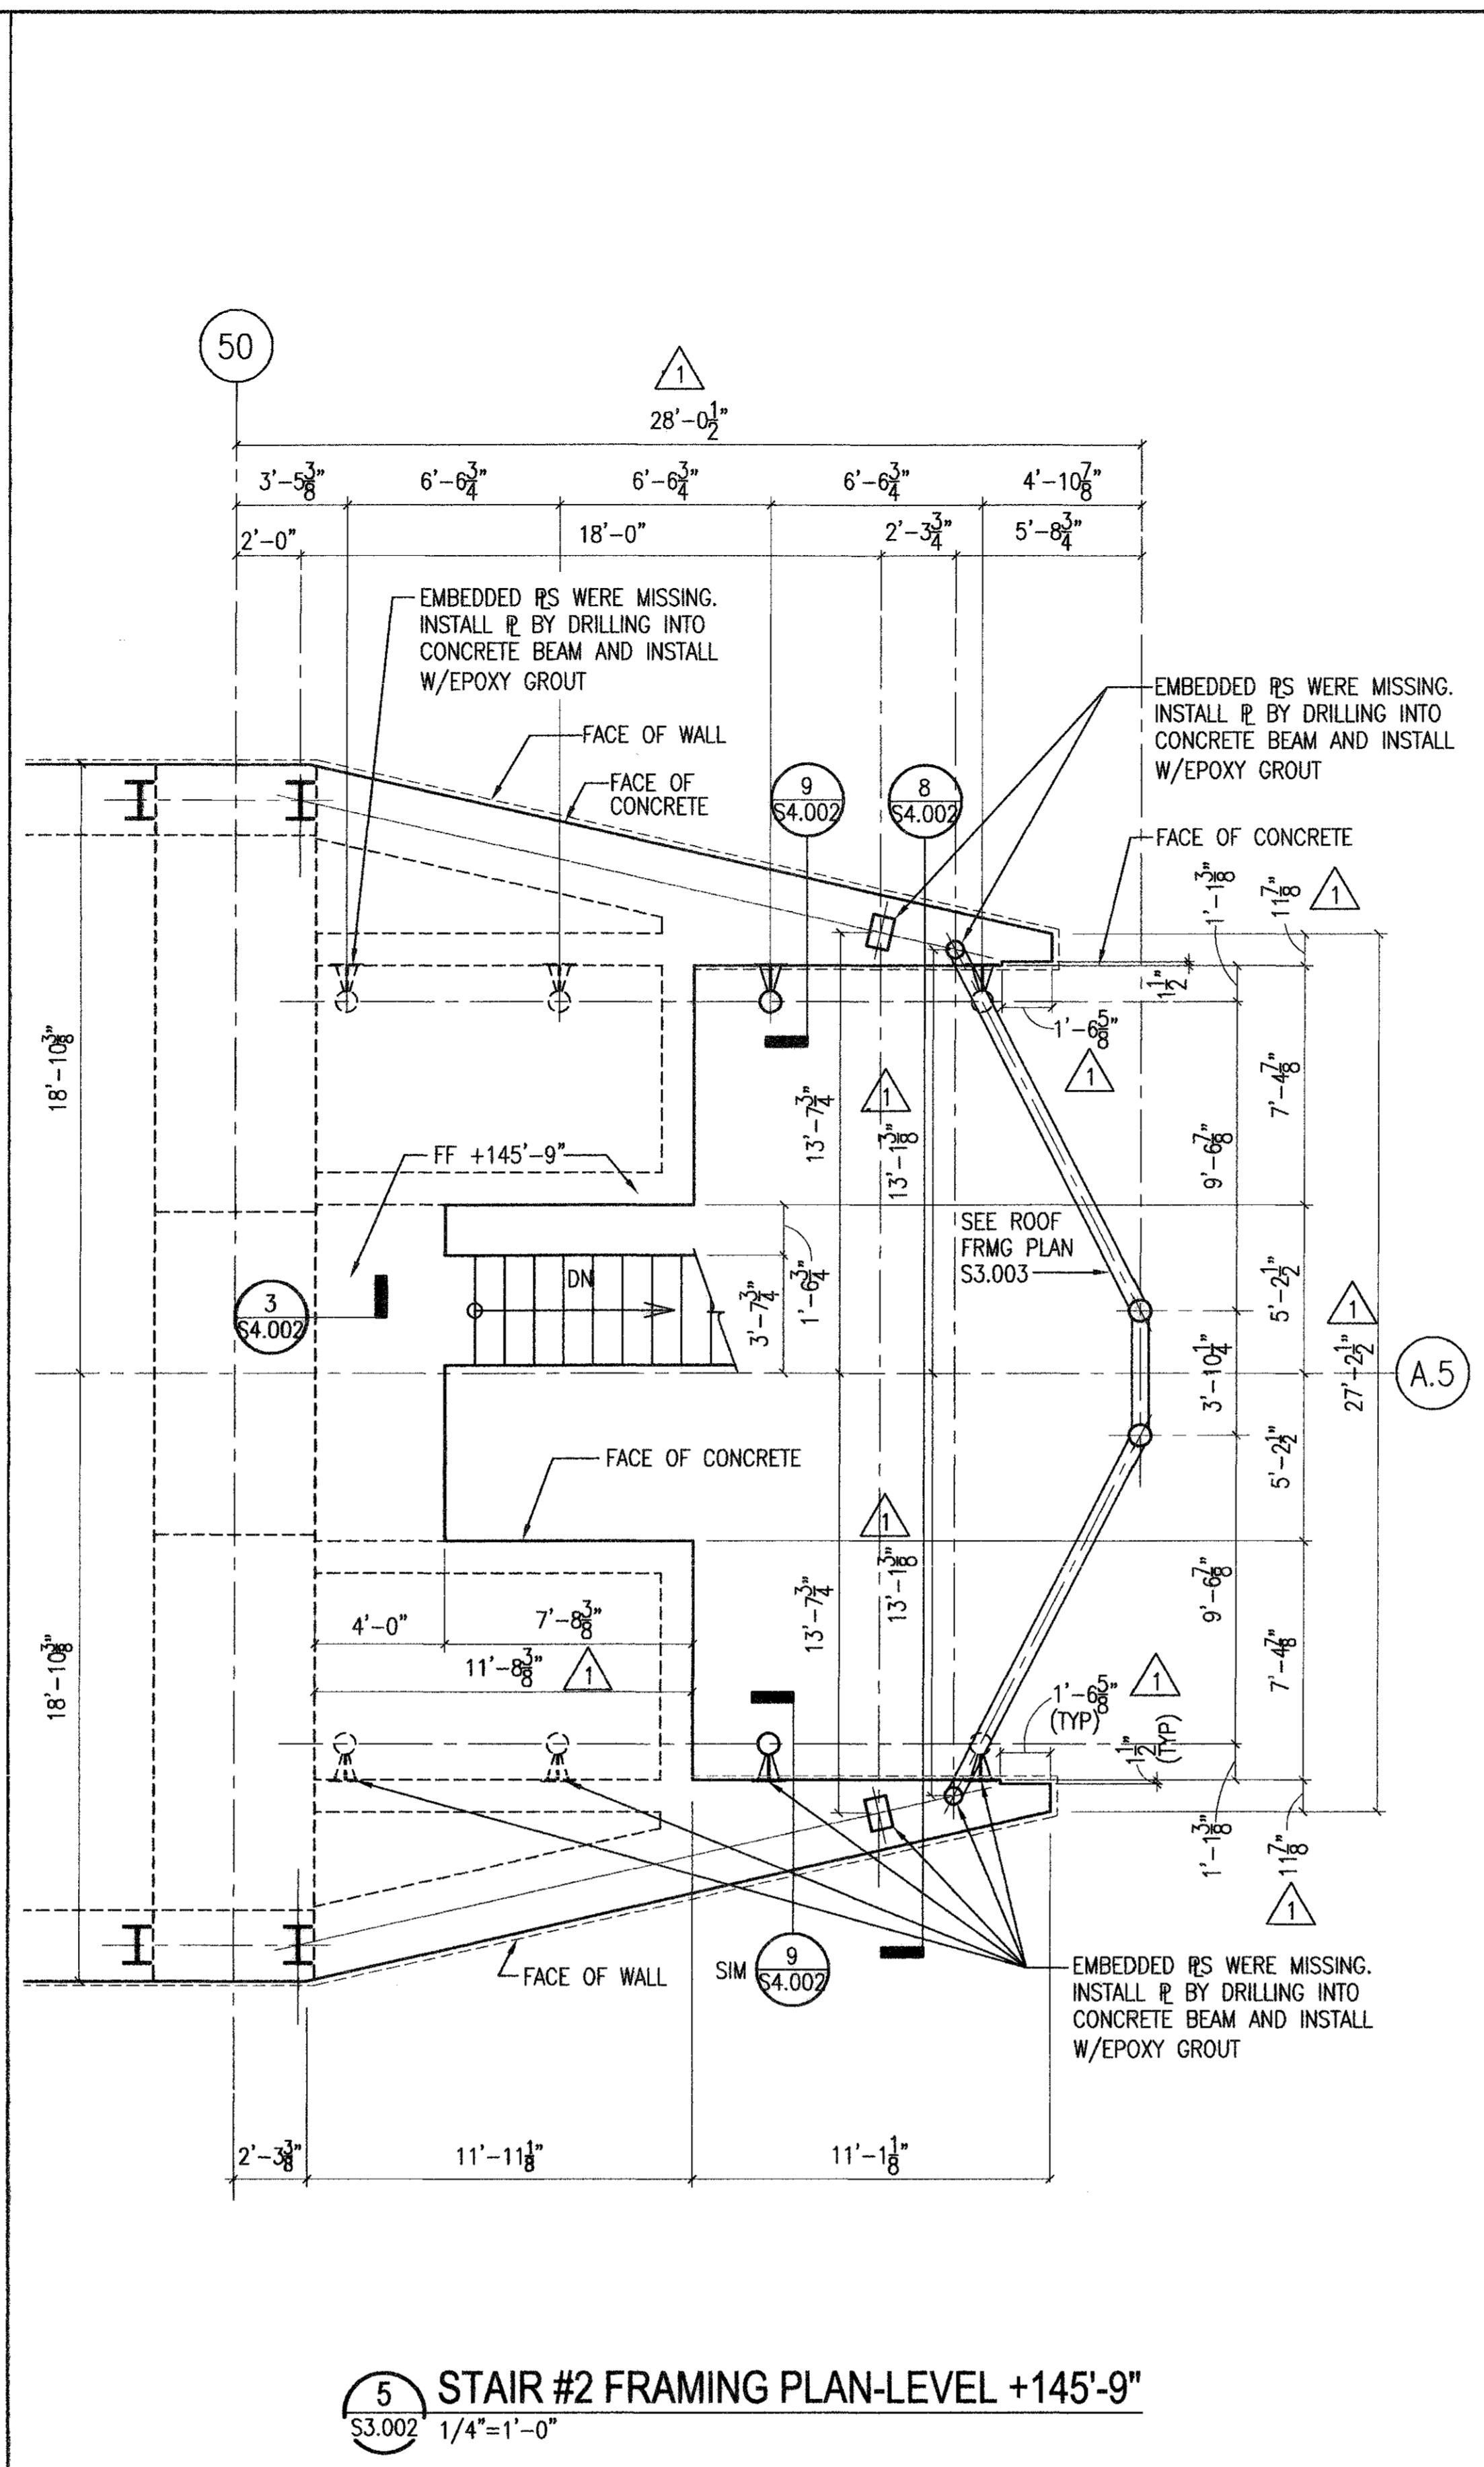


**5 STAIR #2 FRAMING PLAN-LEVEL +145'-9\"/>**

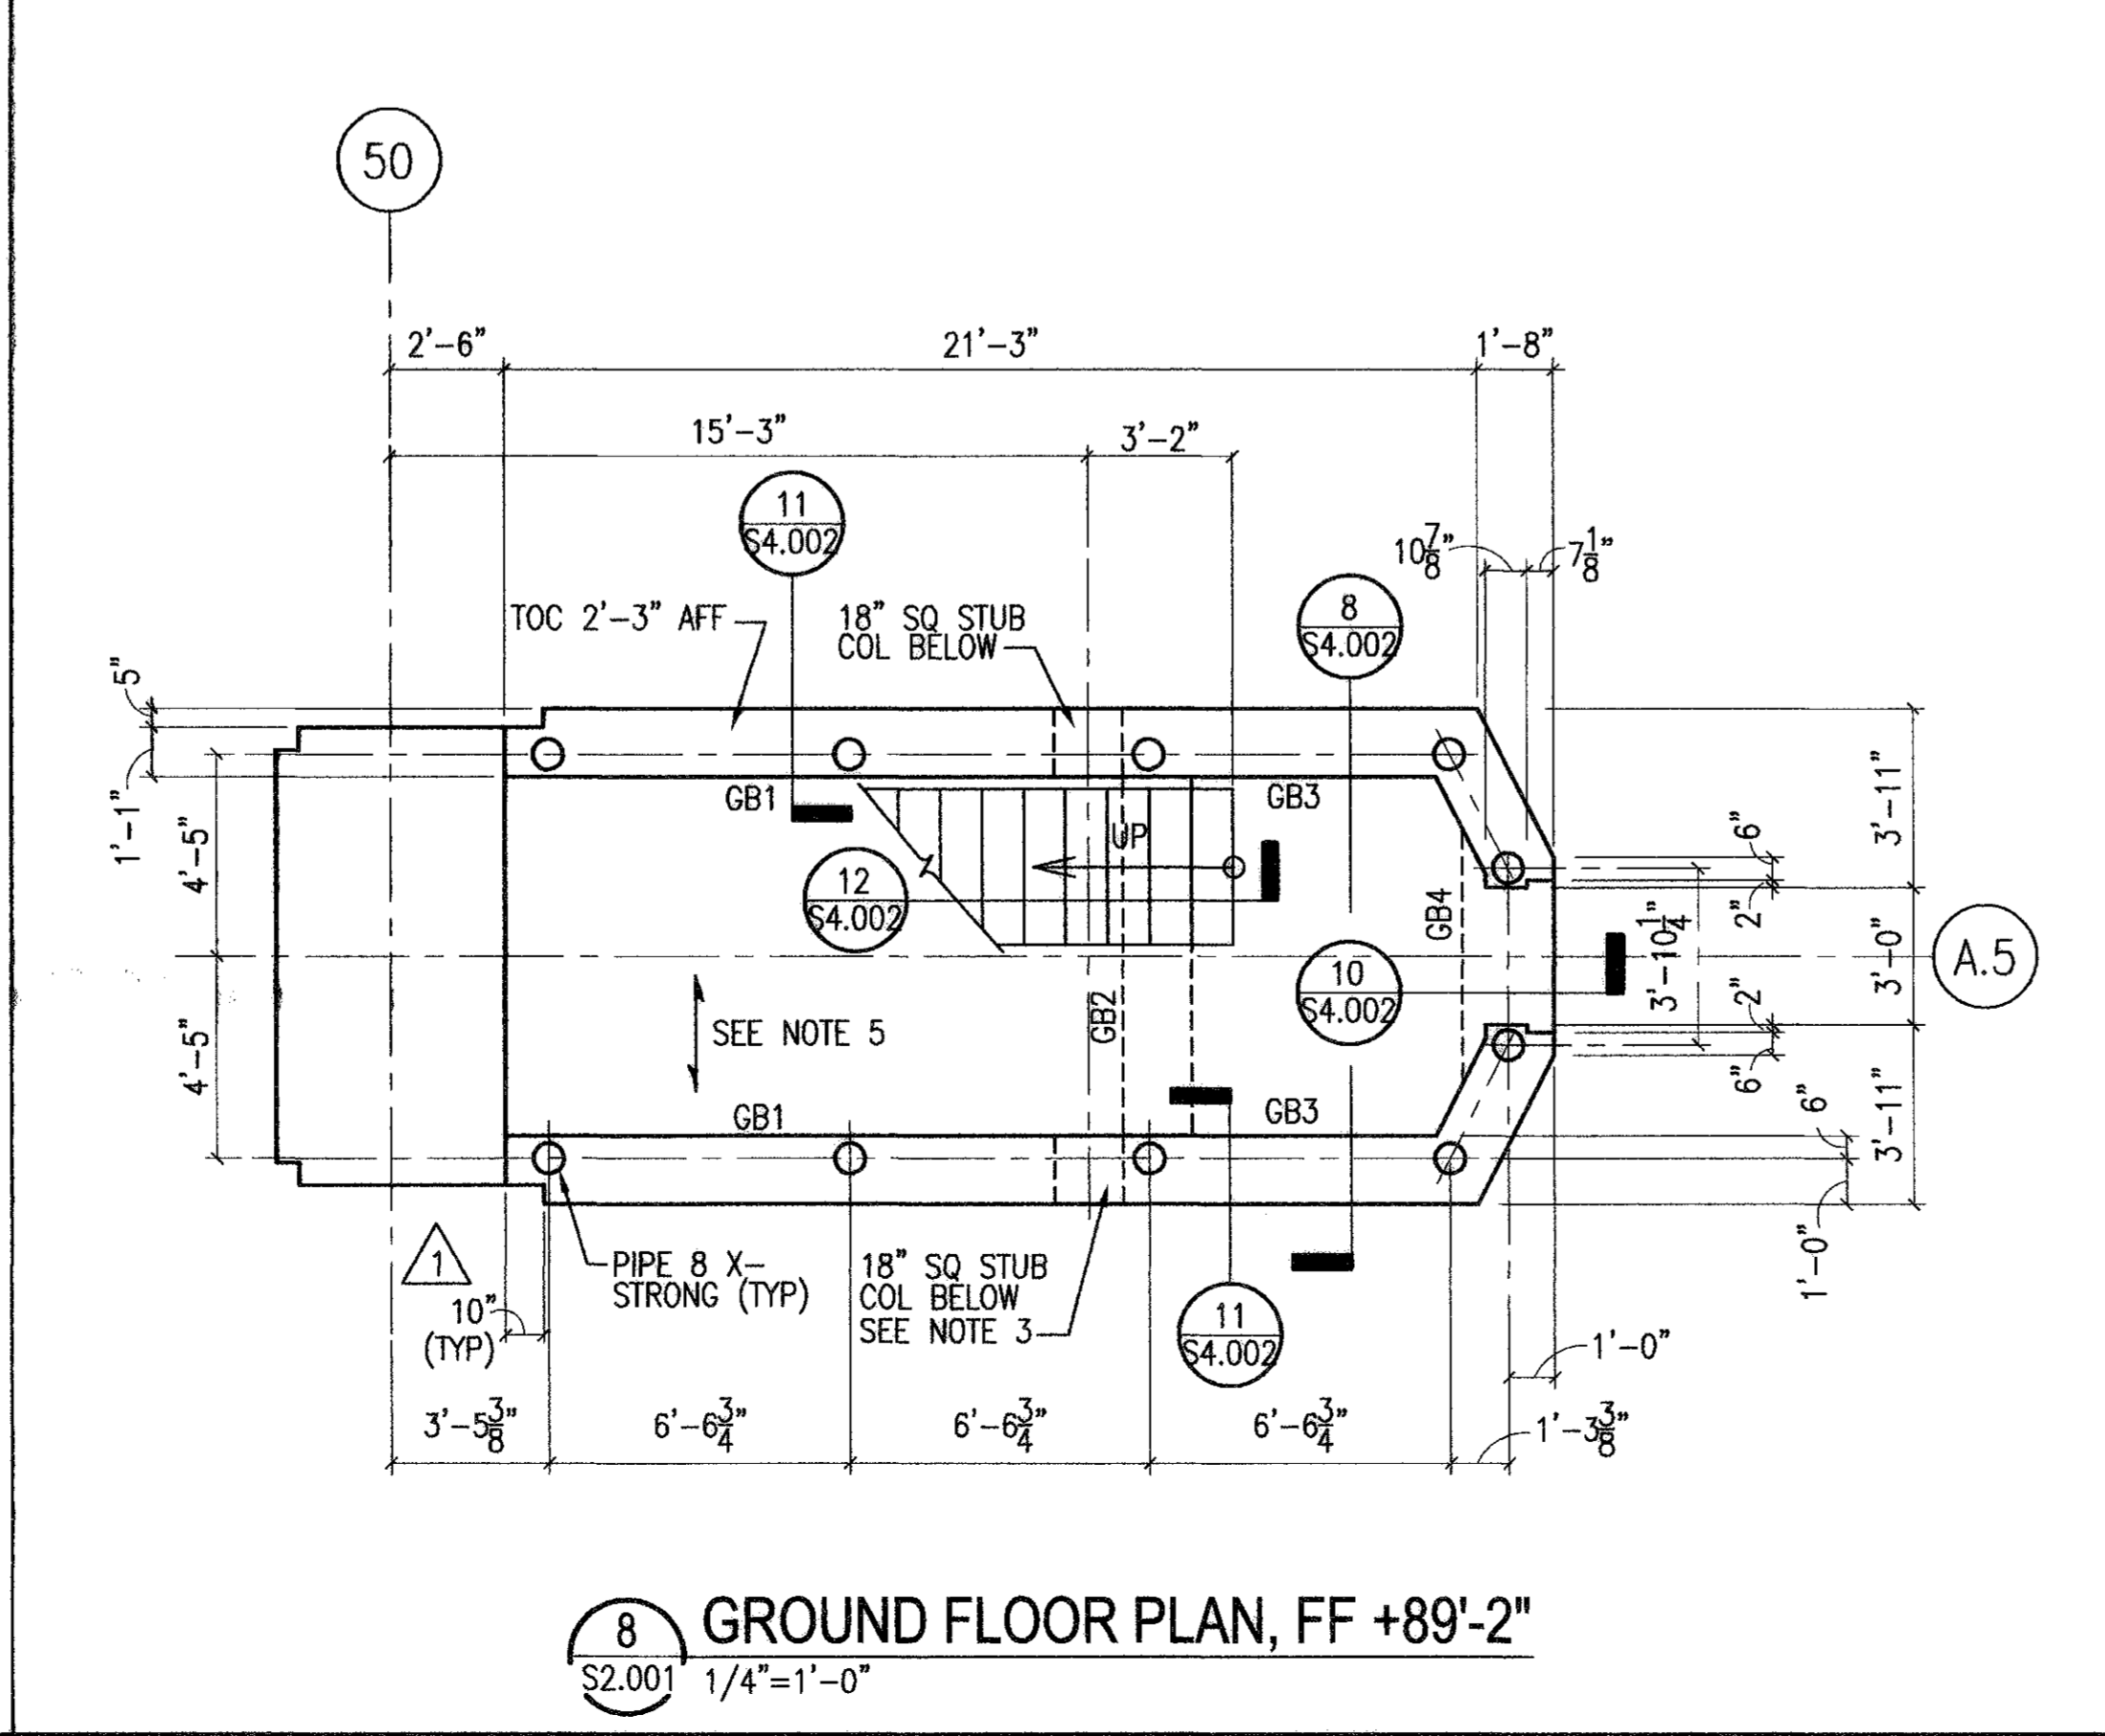


**8 GROUND FLOOR PLAN, FF +89'-2\"/>**

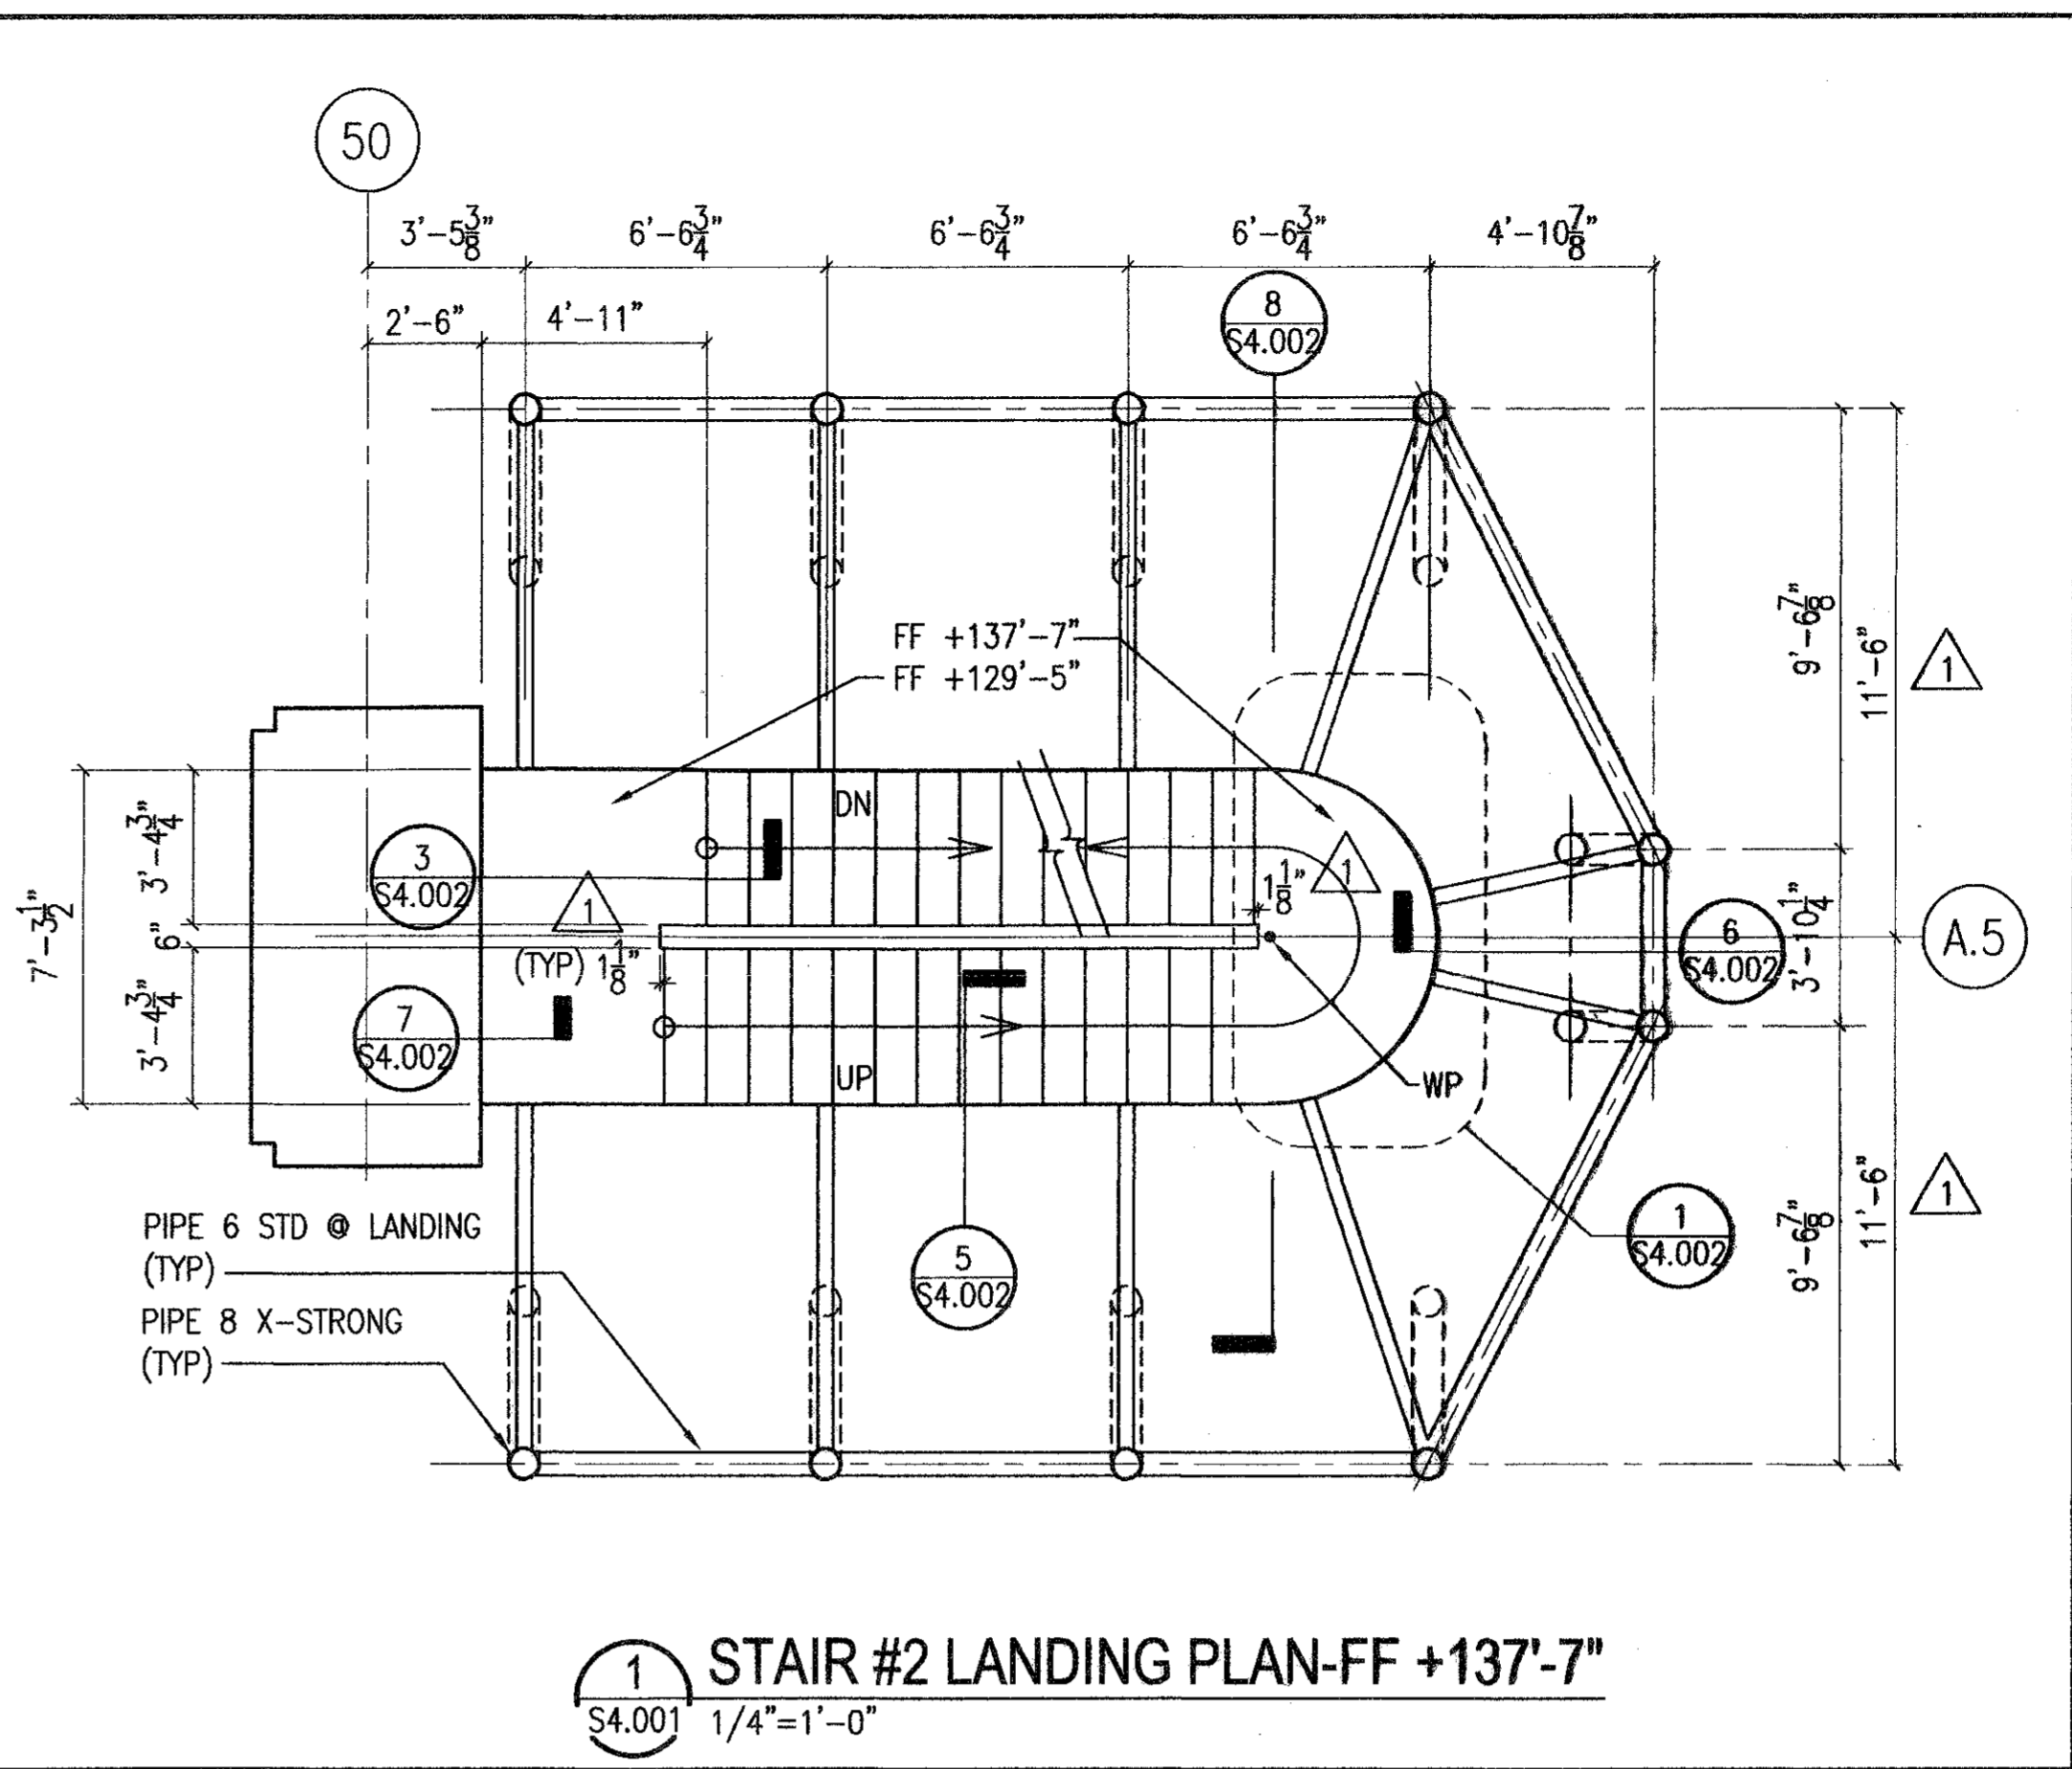

**1 STAIR #2 LANDING PLAN-FF +137'-7\"/>**

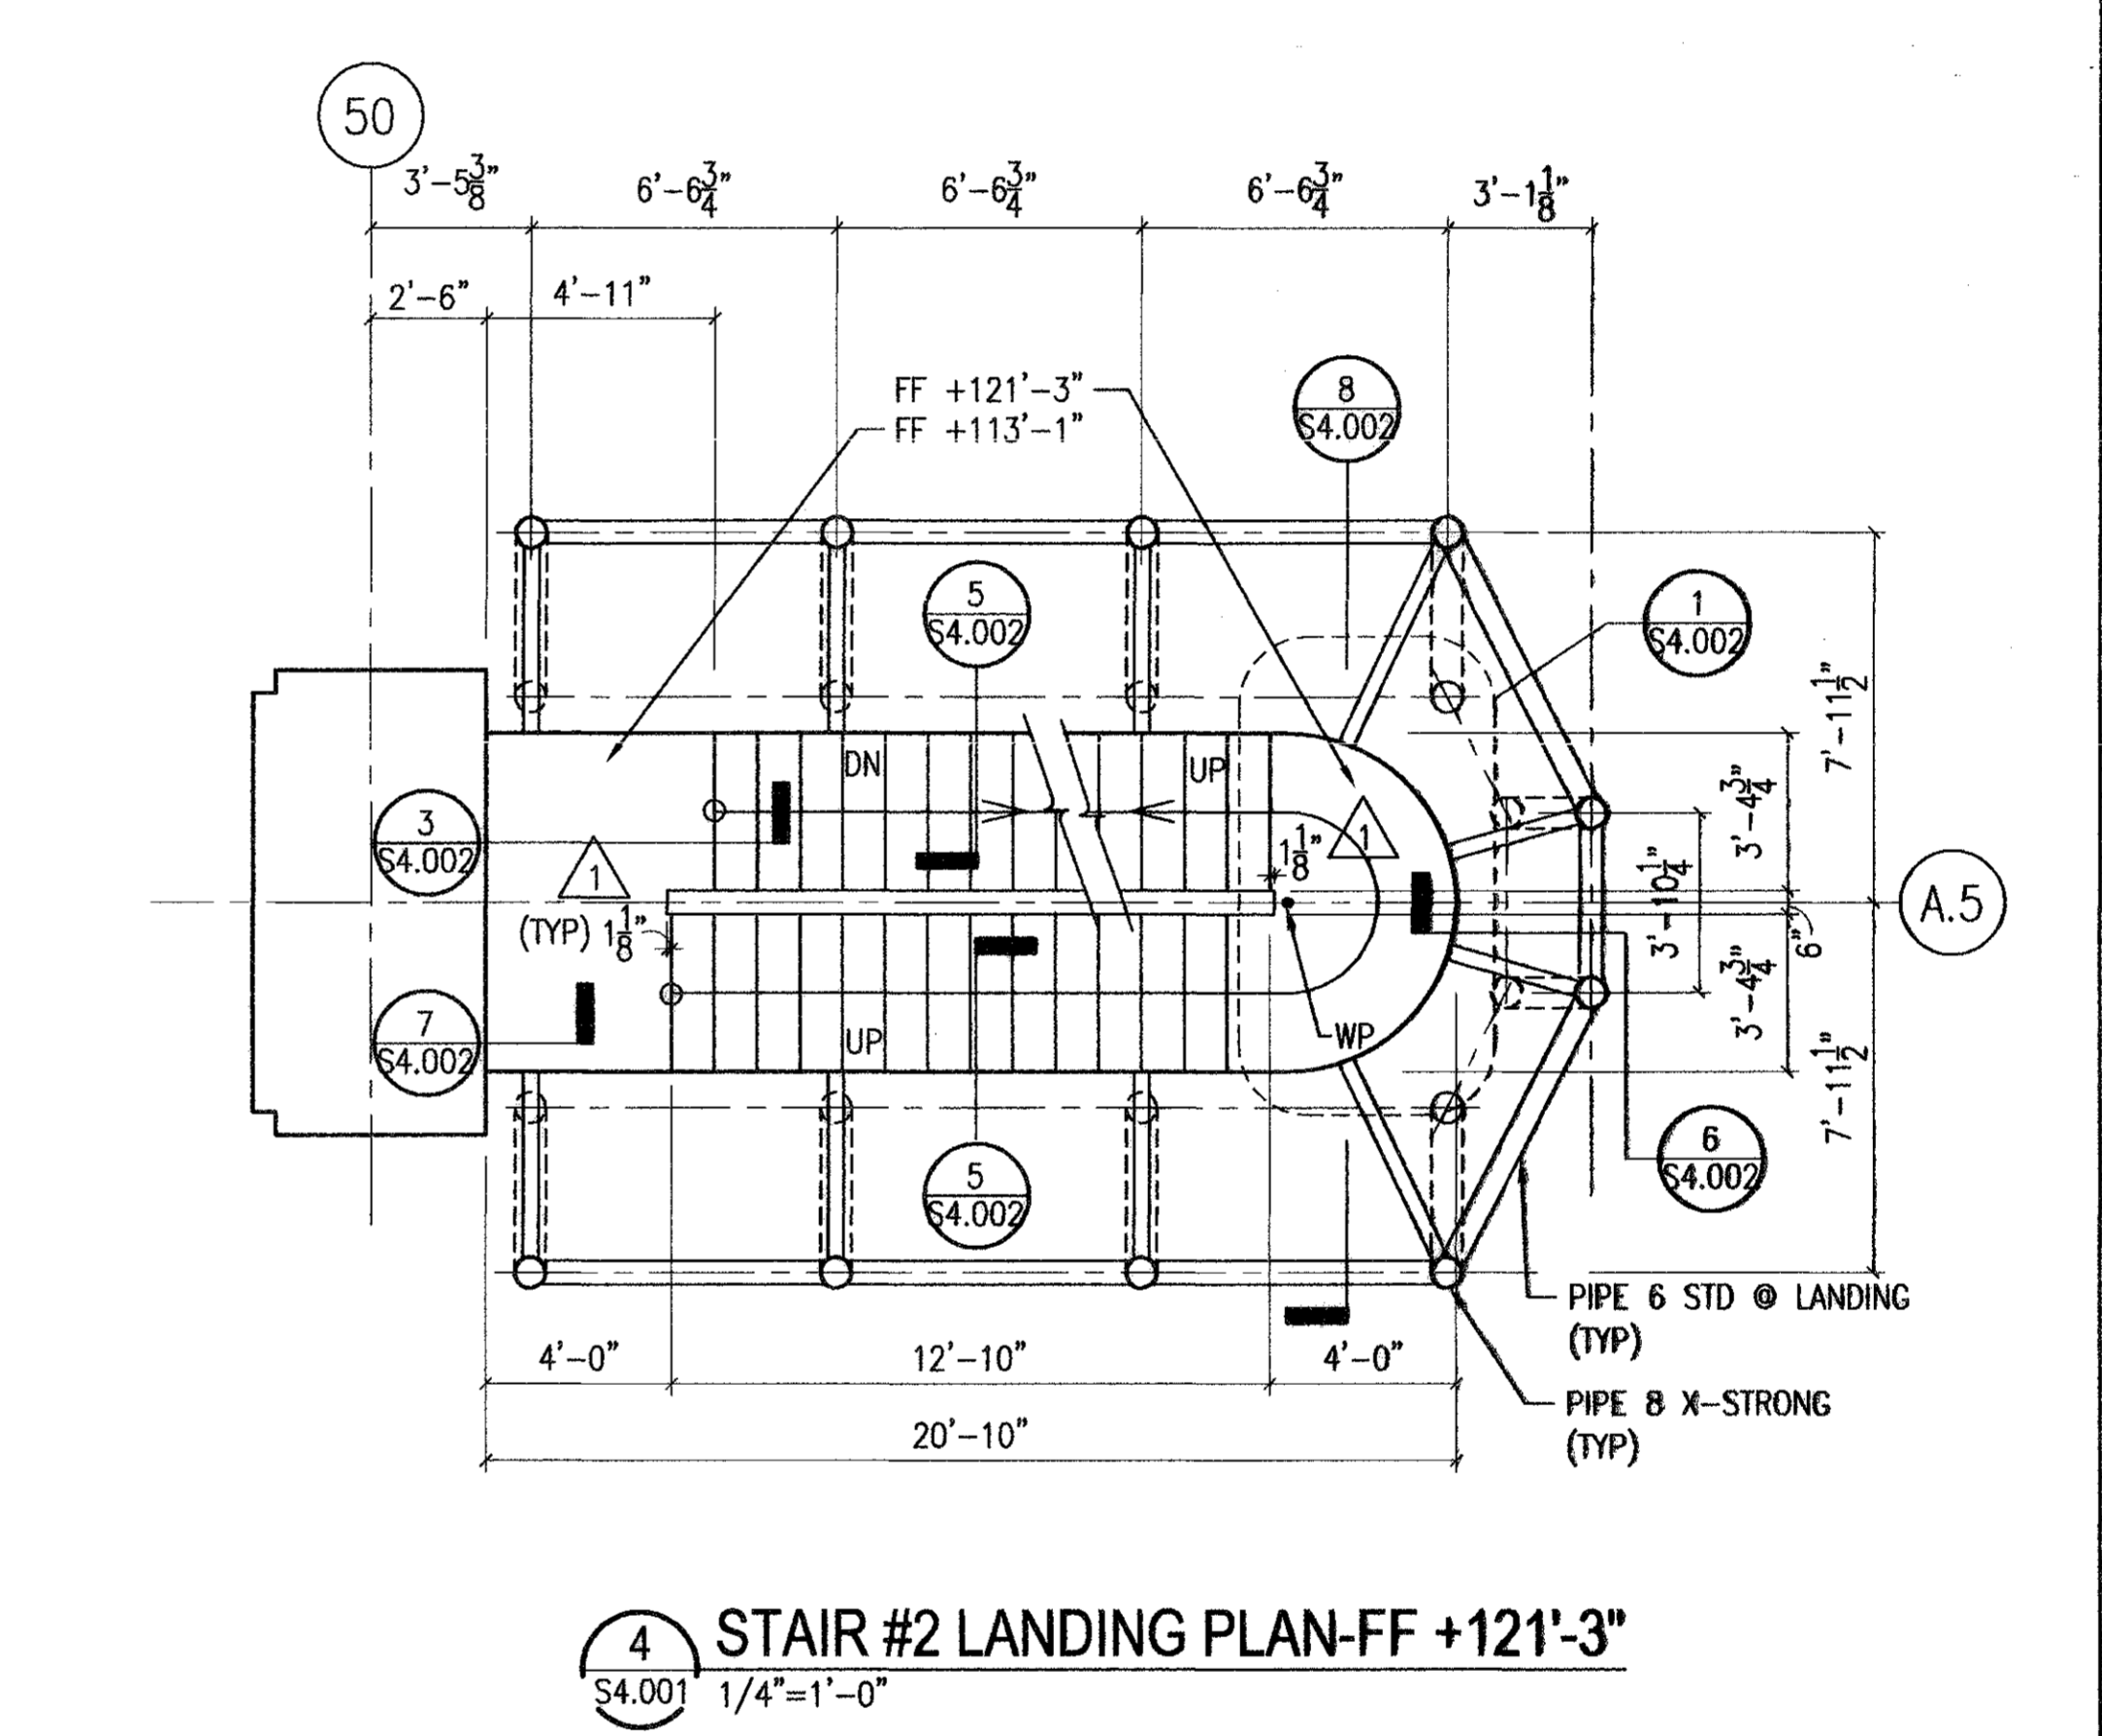

**4 STAIR #2 LANDING PLAN-FF +121'-3\"/>**

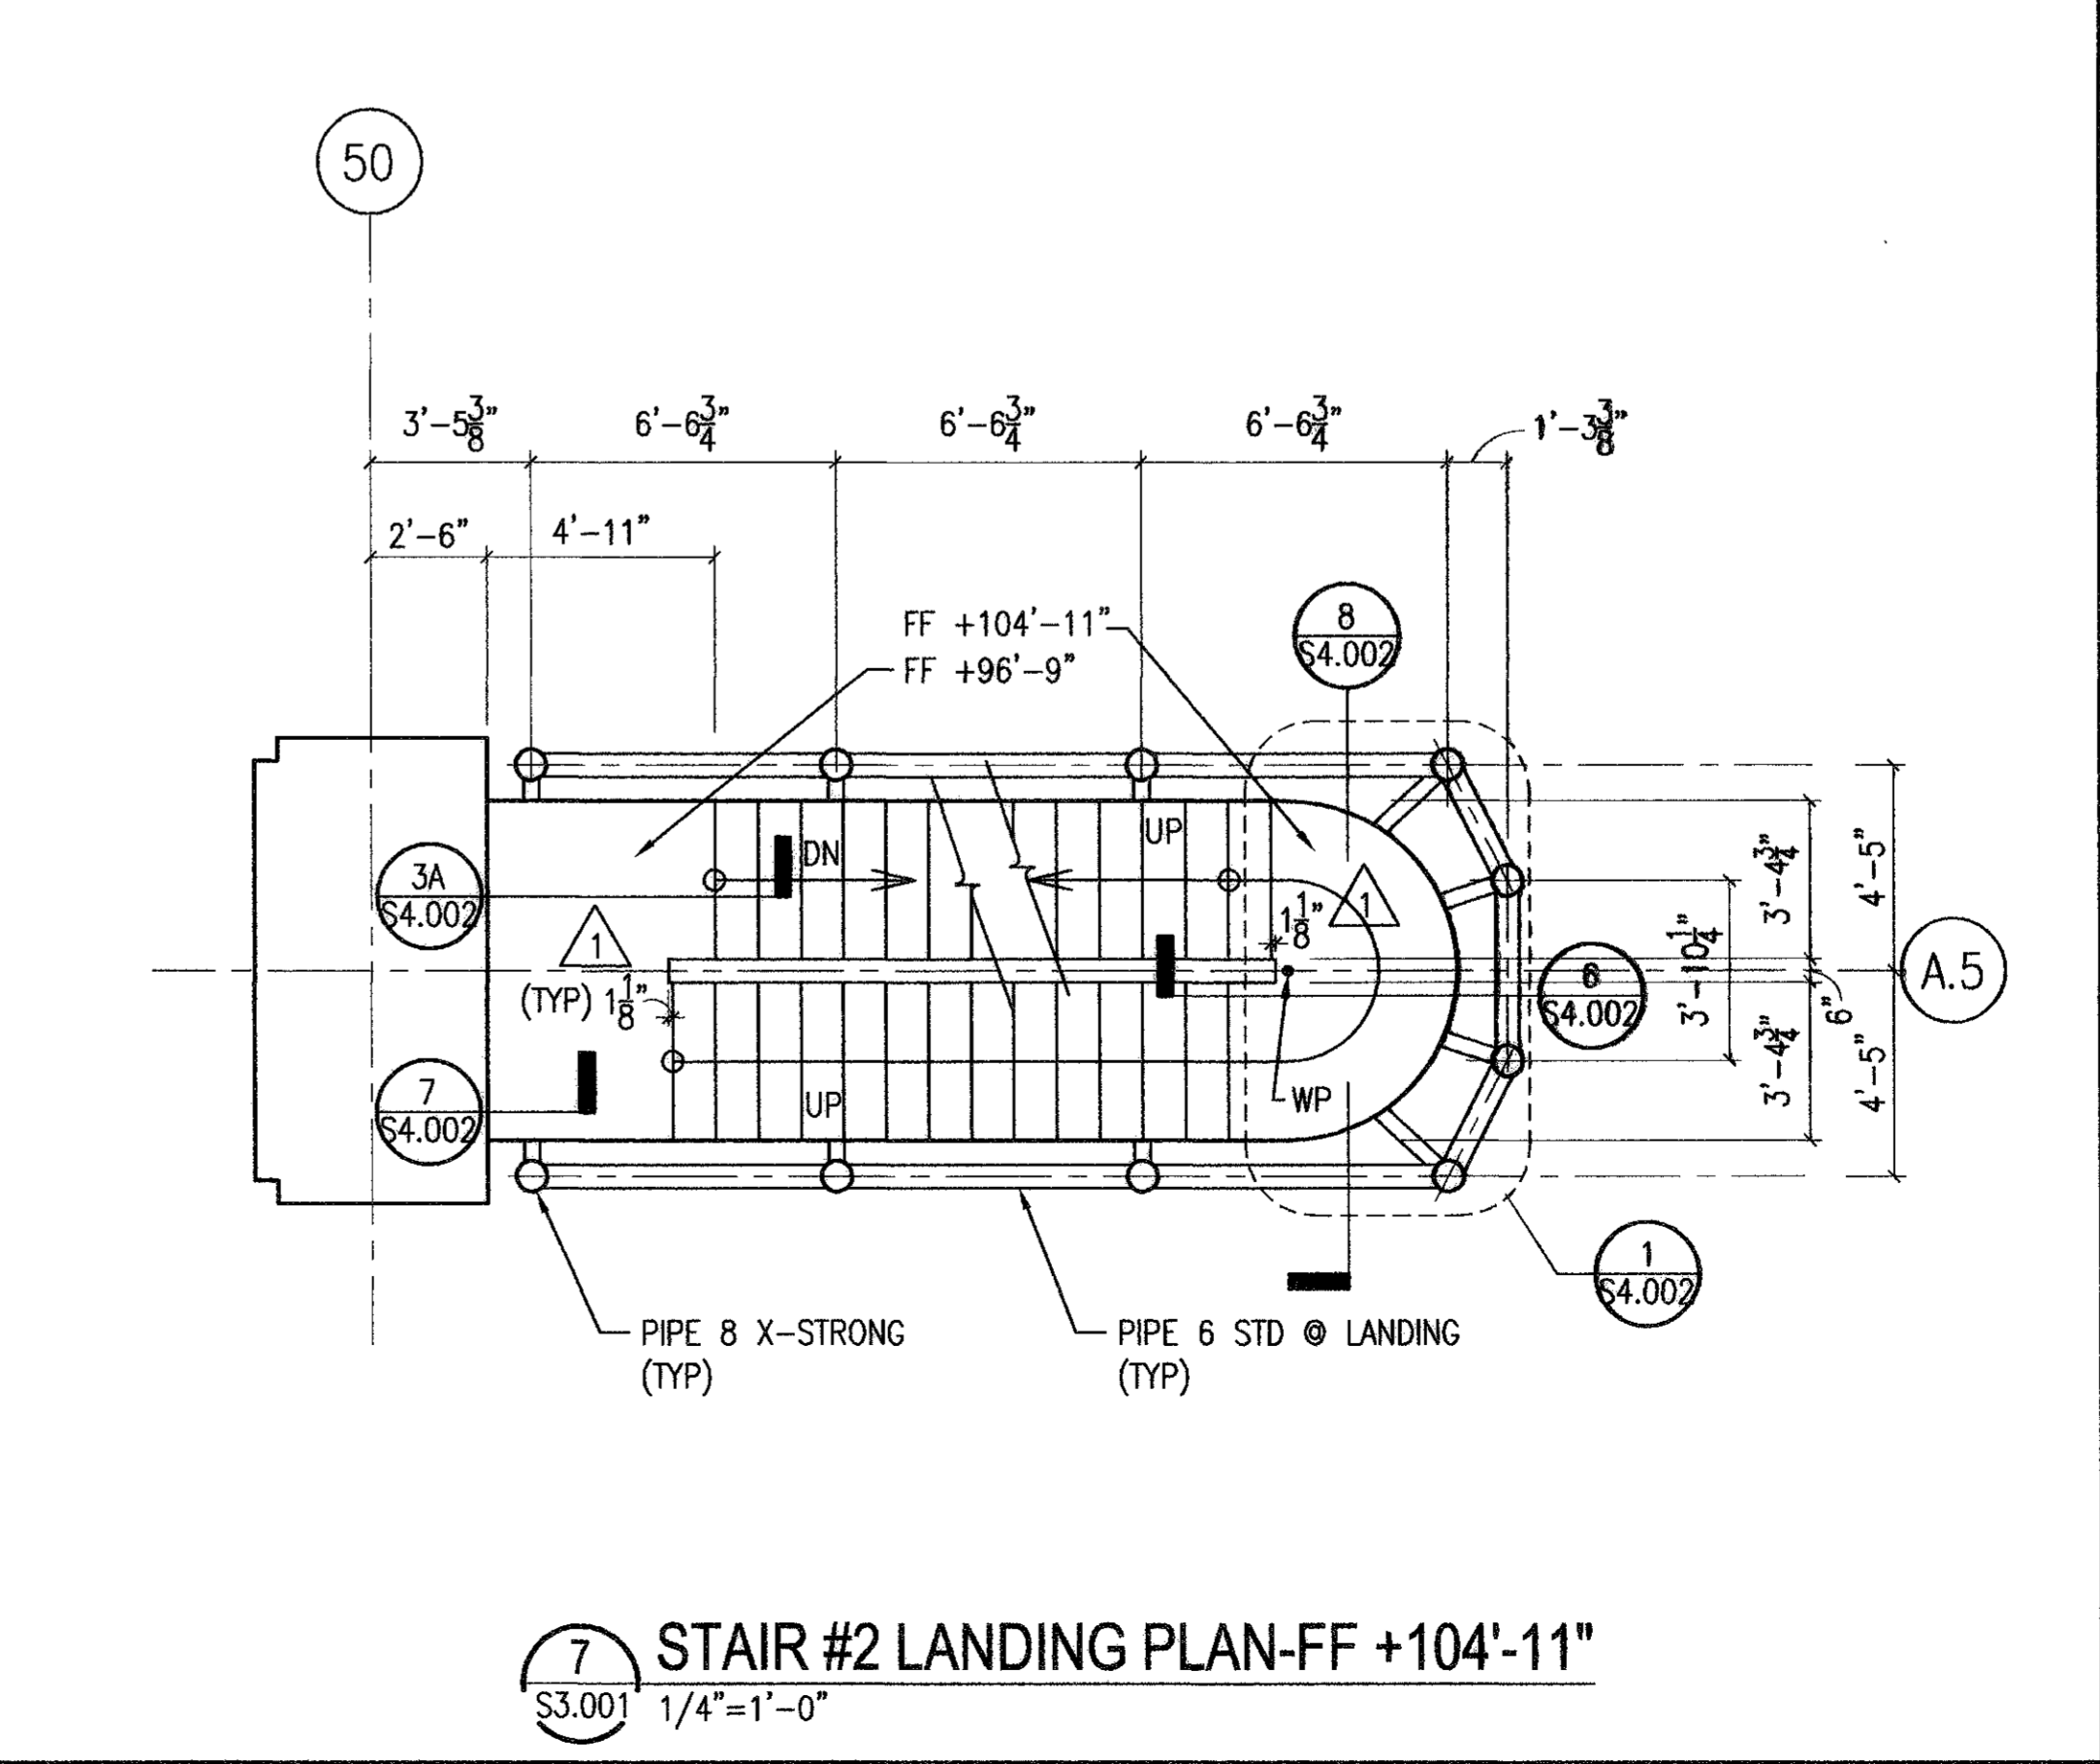

**7 STAIR #2 LANDING PLAN-FF +104'-11\"/>**

**NOTES TO SHEET**

- REFER TO SHEET S0.100 FOR STRUCTURAL GENERAL NOTES.
- REFER TO SHEET S0.301 FOR CONCRETE BEAM SCHEDULE.
- PROVIDE STUB COLUMN WITH (8) #8 VERT REINF AND #4 @ 6" OC TIES WITH SAME SIZE AND NUMBER OF DOWELS INTO PIER CAP.
- PROVIDE WELDED BEAM CONNECTION FOR RB8 TO FR1 AND FR3. SEE DETAIL 10/S6.601
- 8" THK SLAB WITH #5 @ 12" EW, T&B.

**HOUSTON AIRPORT SYSTEM**  
GEORGE BUSH  
INTERCONTINENTAL AIRPORT  
HOUSTON TEXAS

**HUITT-ZOLLARS**  
Huitt-Zollars, Inc. Engineering / Architecture  
1300 West Loop South, Suite 200, Houston, TX 77027  
Phone (281) 495-0066 Fax (281) 495-0220


**CHARLES F. YENNY, INC.**  
Consulting Engineers  
2000 West Loop South, Suite 7000  
Houston, TX 77027  
Phone (281) 495-0066 Fax (281) 495-0220

NO.	DESCRIPTION	DATE	BY
1	ISSUED FOR BID	10/19/01	
2	ADDENDUM #1	02/01/02	MR

INTERNATIONAL • SERVICES • EXPANSION • PROGRAM

**APM STATION & PLATFORM**  
STAIR FRAMING PLANS AND SECTIONS

PROJECT MGR:	GRW
DESIGNER:	JUC
DRAWN BY:	KLV
CHECKED BY:	MMR
DRAWING STANDARD:	ISEP 07.20.2000
SCALE:	AS NOTED
DATE:	09/14/01

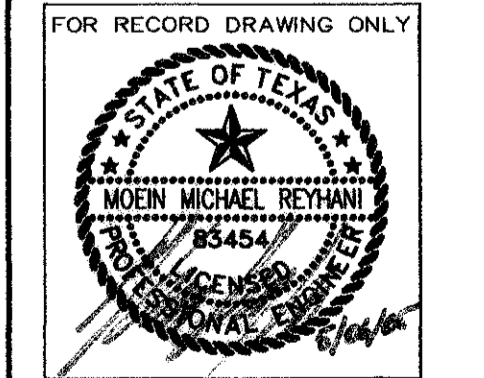

NOTE: REFER TO GRAPHIC SCALE IF ACTUAL SHEET SIZE IS OTHER THAN 30"x42".

SCALE: 1/4" = 1'-0"

**RECORD DRAWINGS**  
DO NOT MODIFY

DATE: MAY 6, 2005

HUITT-ZOLLARS, INC.


NOTE: INFORMATION USED TO DEVELOP THESE DOCUMENTS WAS TAKEN FROM RECORD OF THE WORK DRAWINGS PREPARED BY THE CONSTRUCTION CONTRACTOR, CLARK/AMISSON A JOINT VENTURE. THE INFORMATION PROVIDED BY THE CONTRACTOR WAS NOT VERIFIED BY THE DESIGN FIRM NAMED ABOVE.

APPROVED BY:	DATE:
DIRECTOR	HOUSTON AIRPORT SYSTEM
PROJECT NO.	02-2025-01
C.I.P. NO.	A-0354
H.A.S. NO.	536C
SHEET NO.	10


**S4.001**

PLOT DATE: 10/19/01 HAS FILE: AS6363400.DWG




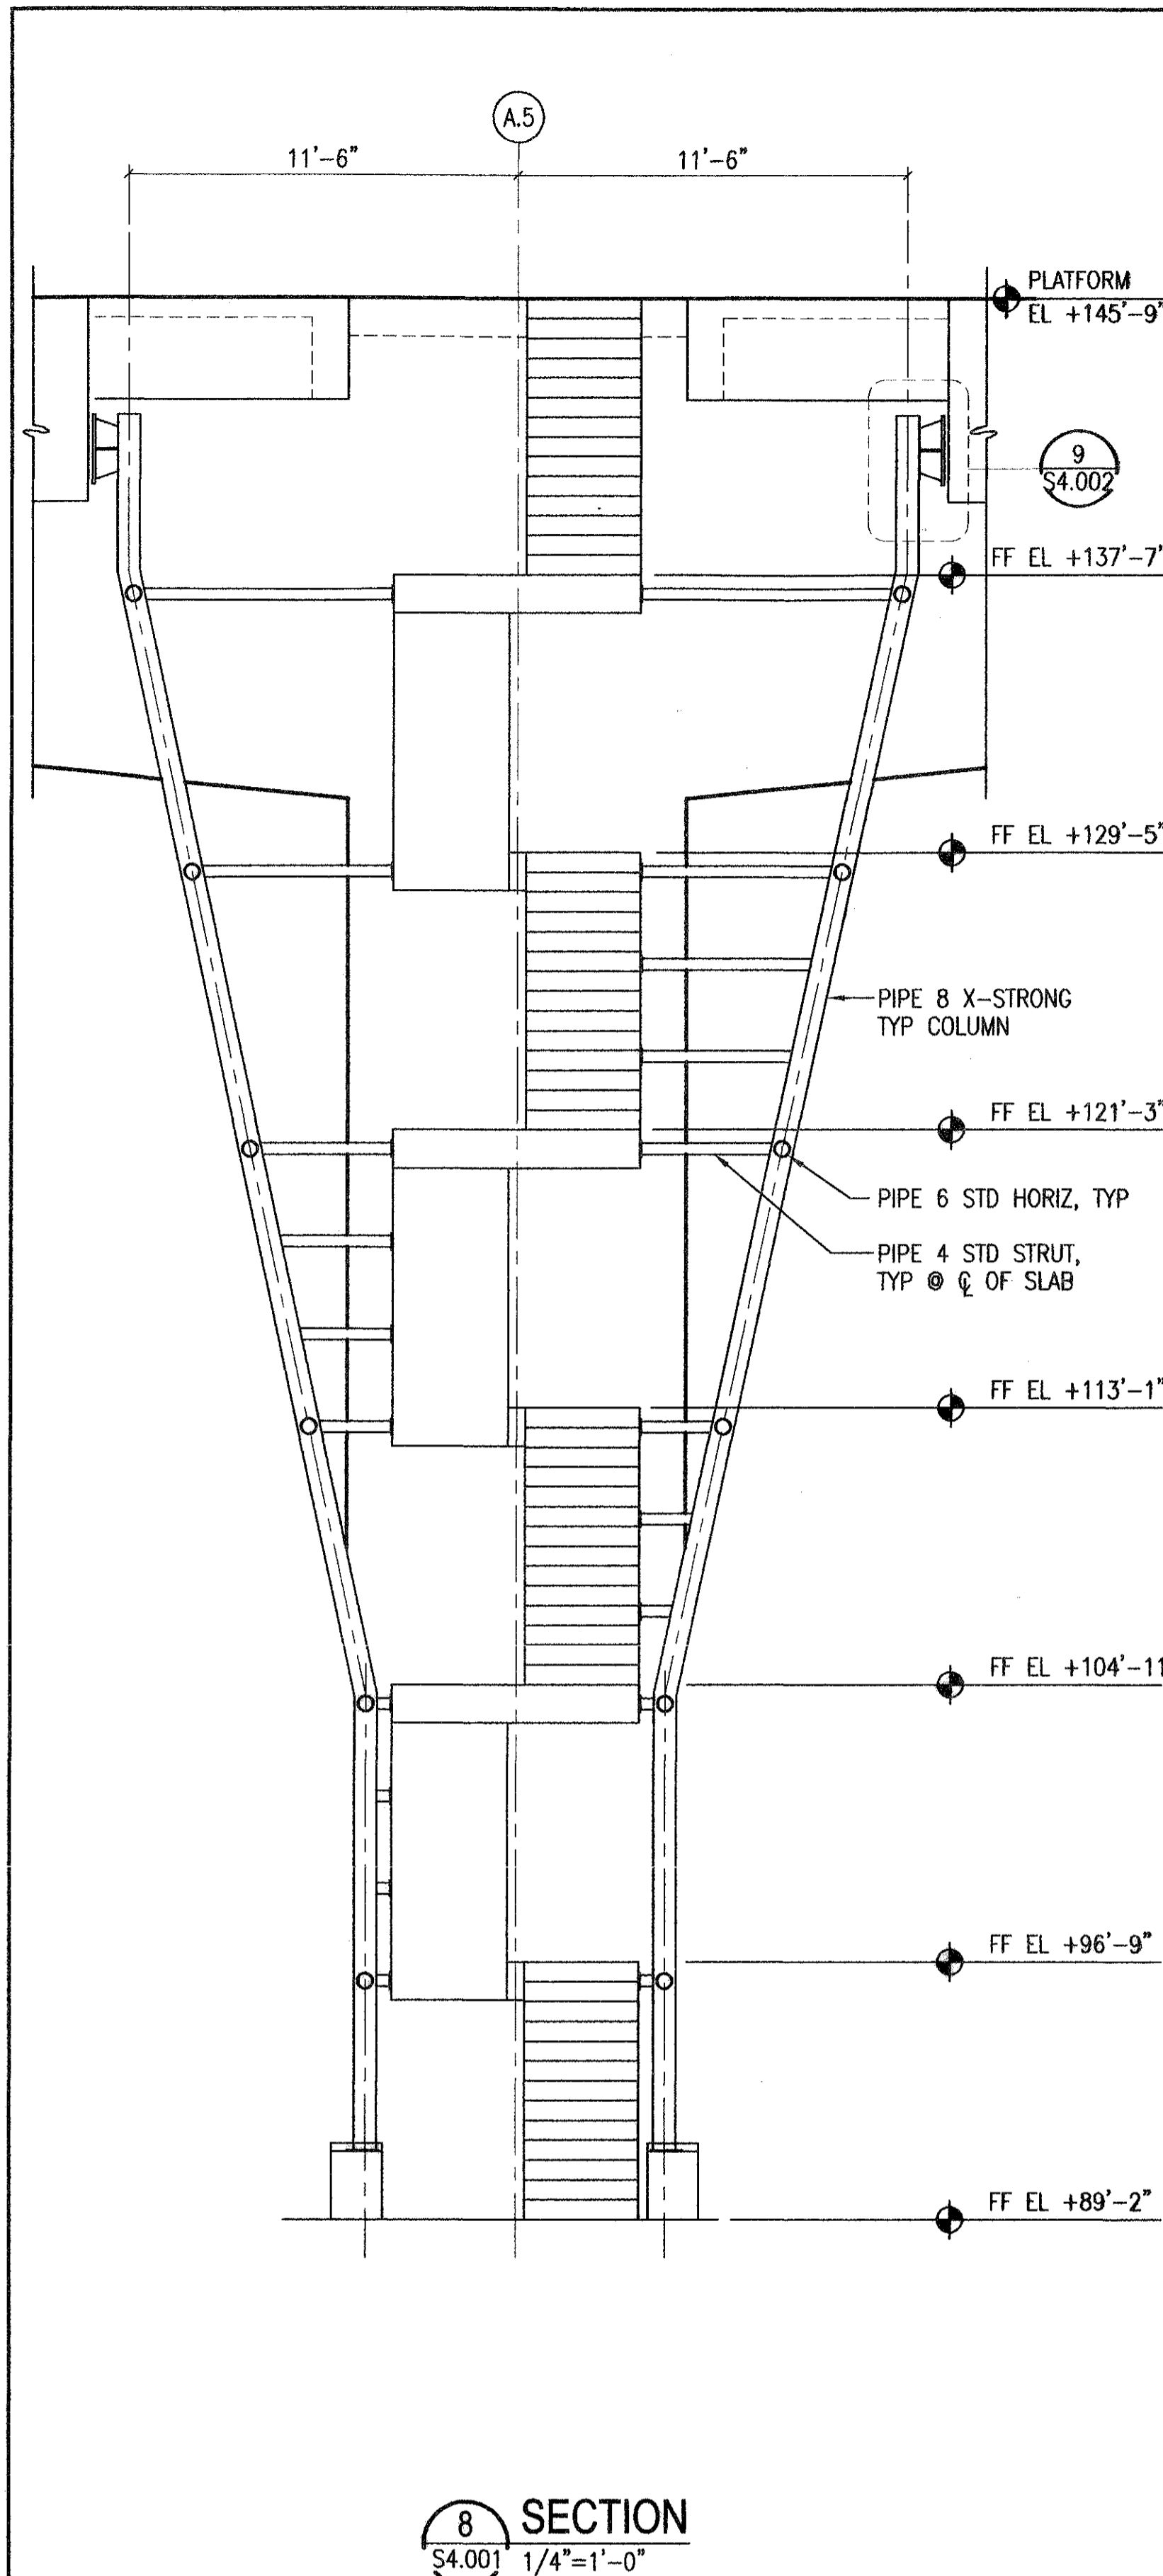


**8 SECTION**  
S4.001 1/4"=1'-0"

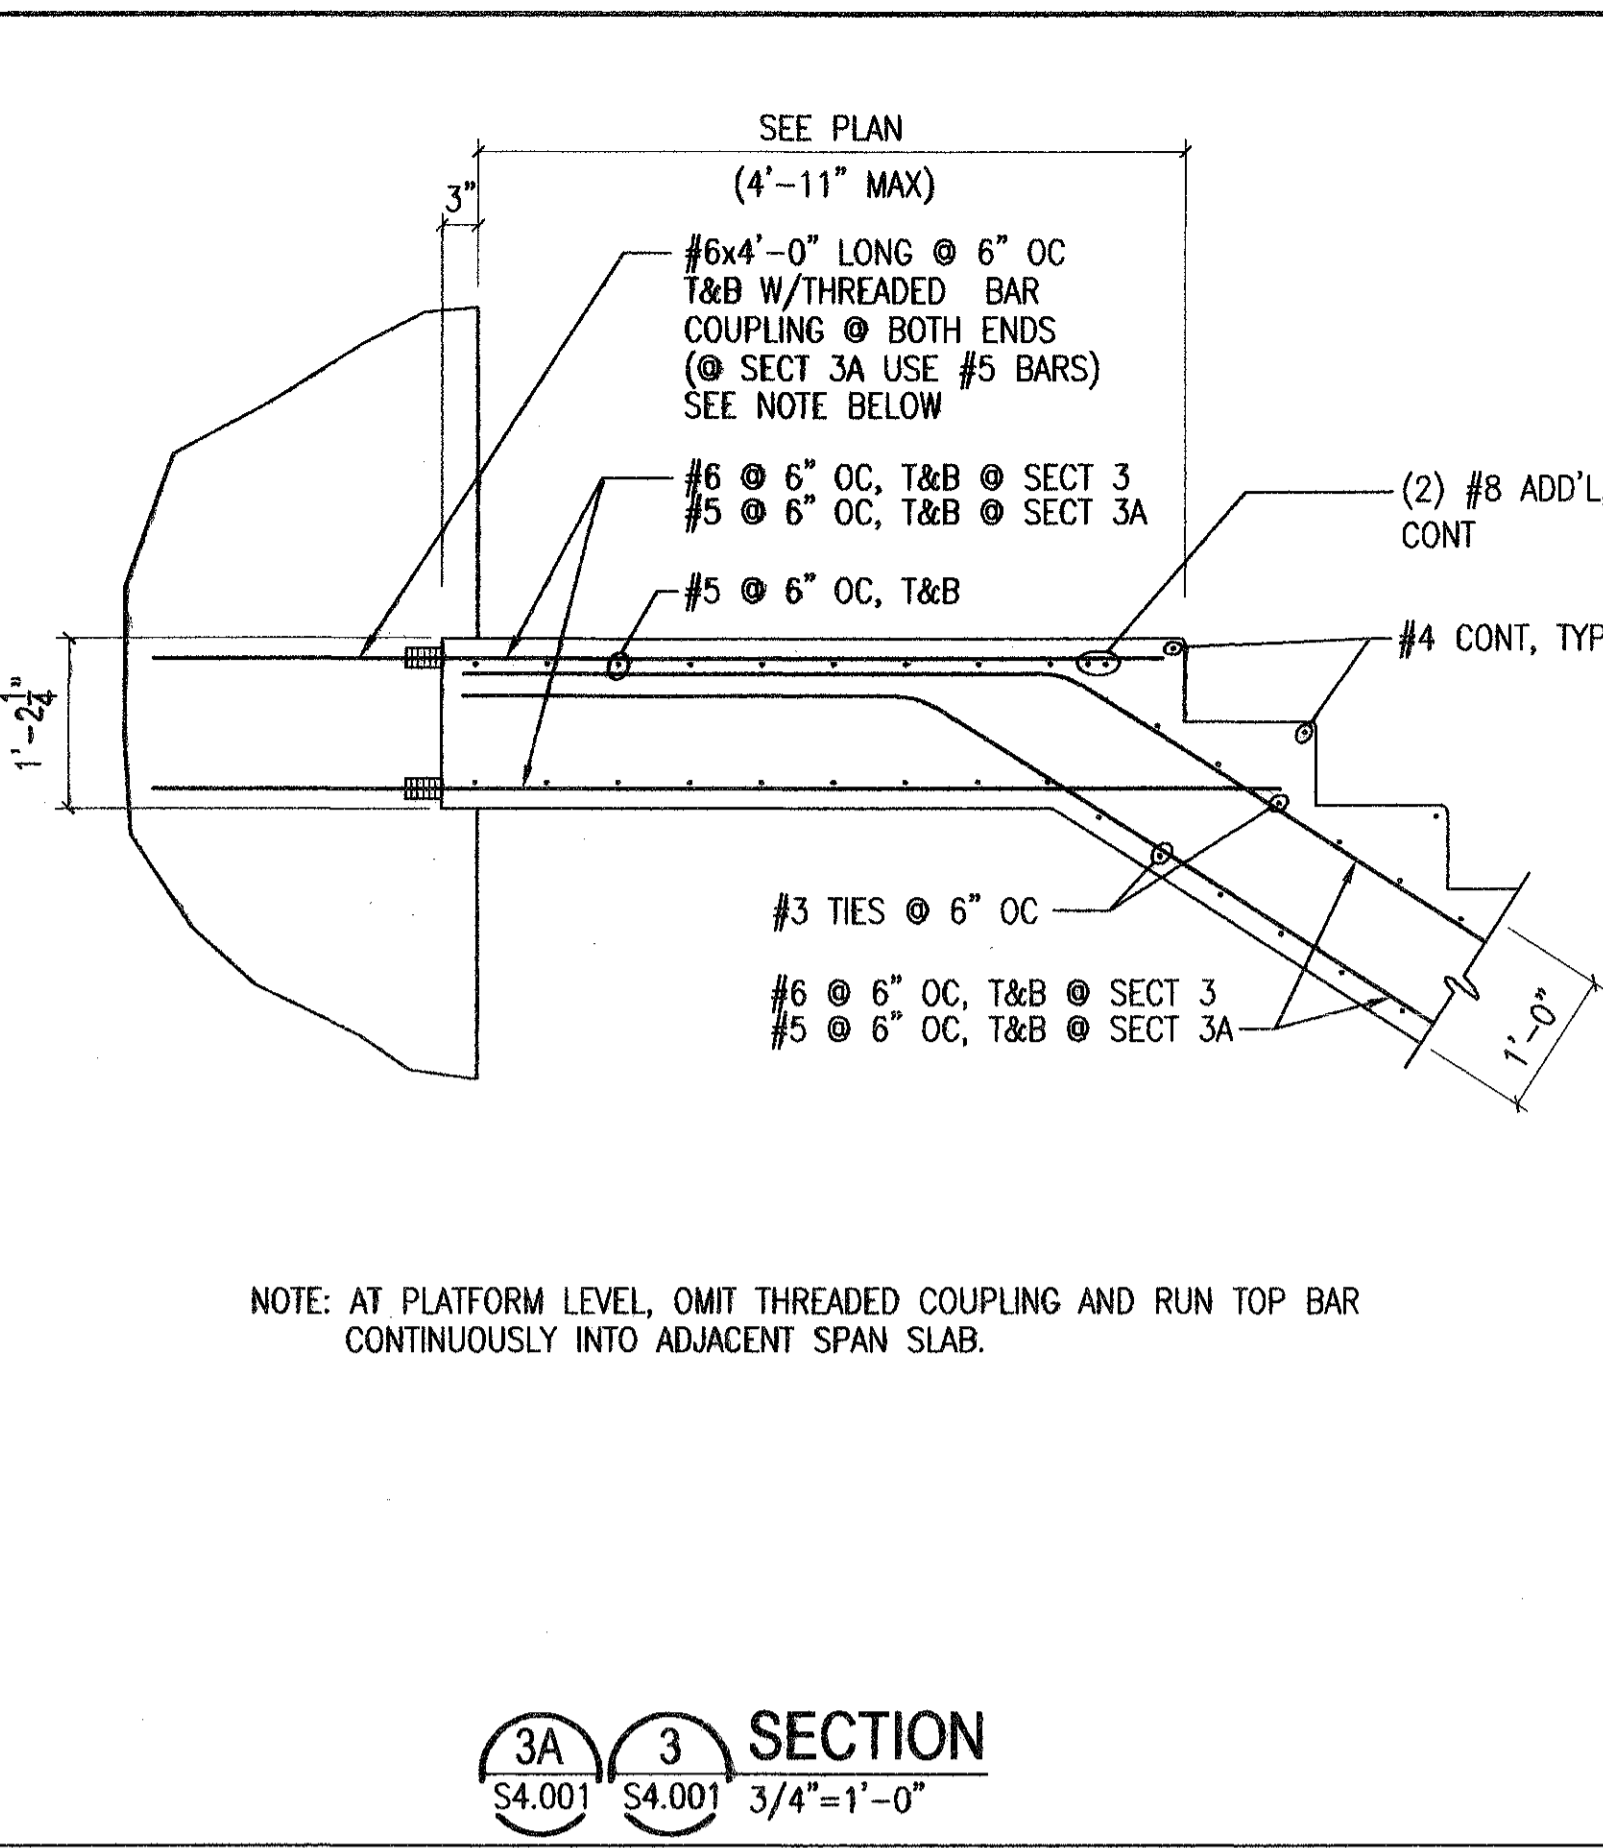


**3A SECTION**  
S4.001 3/4"=1'-0"

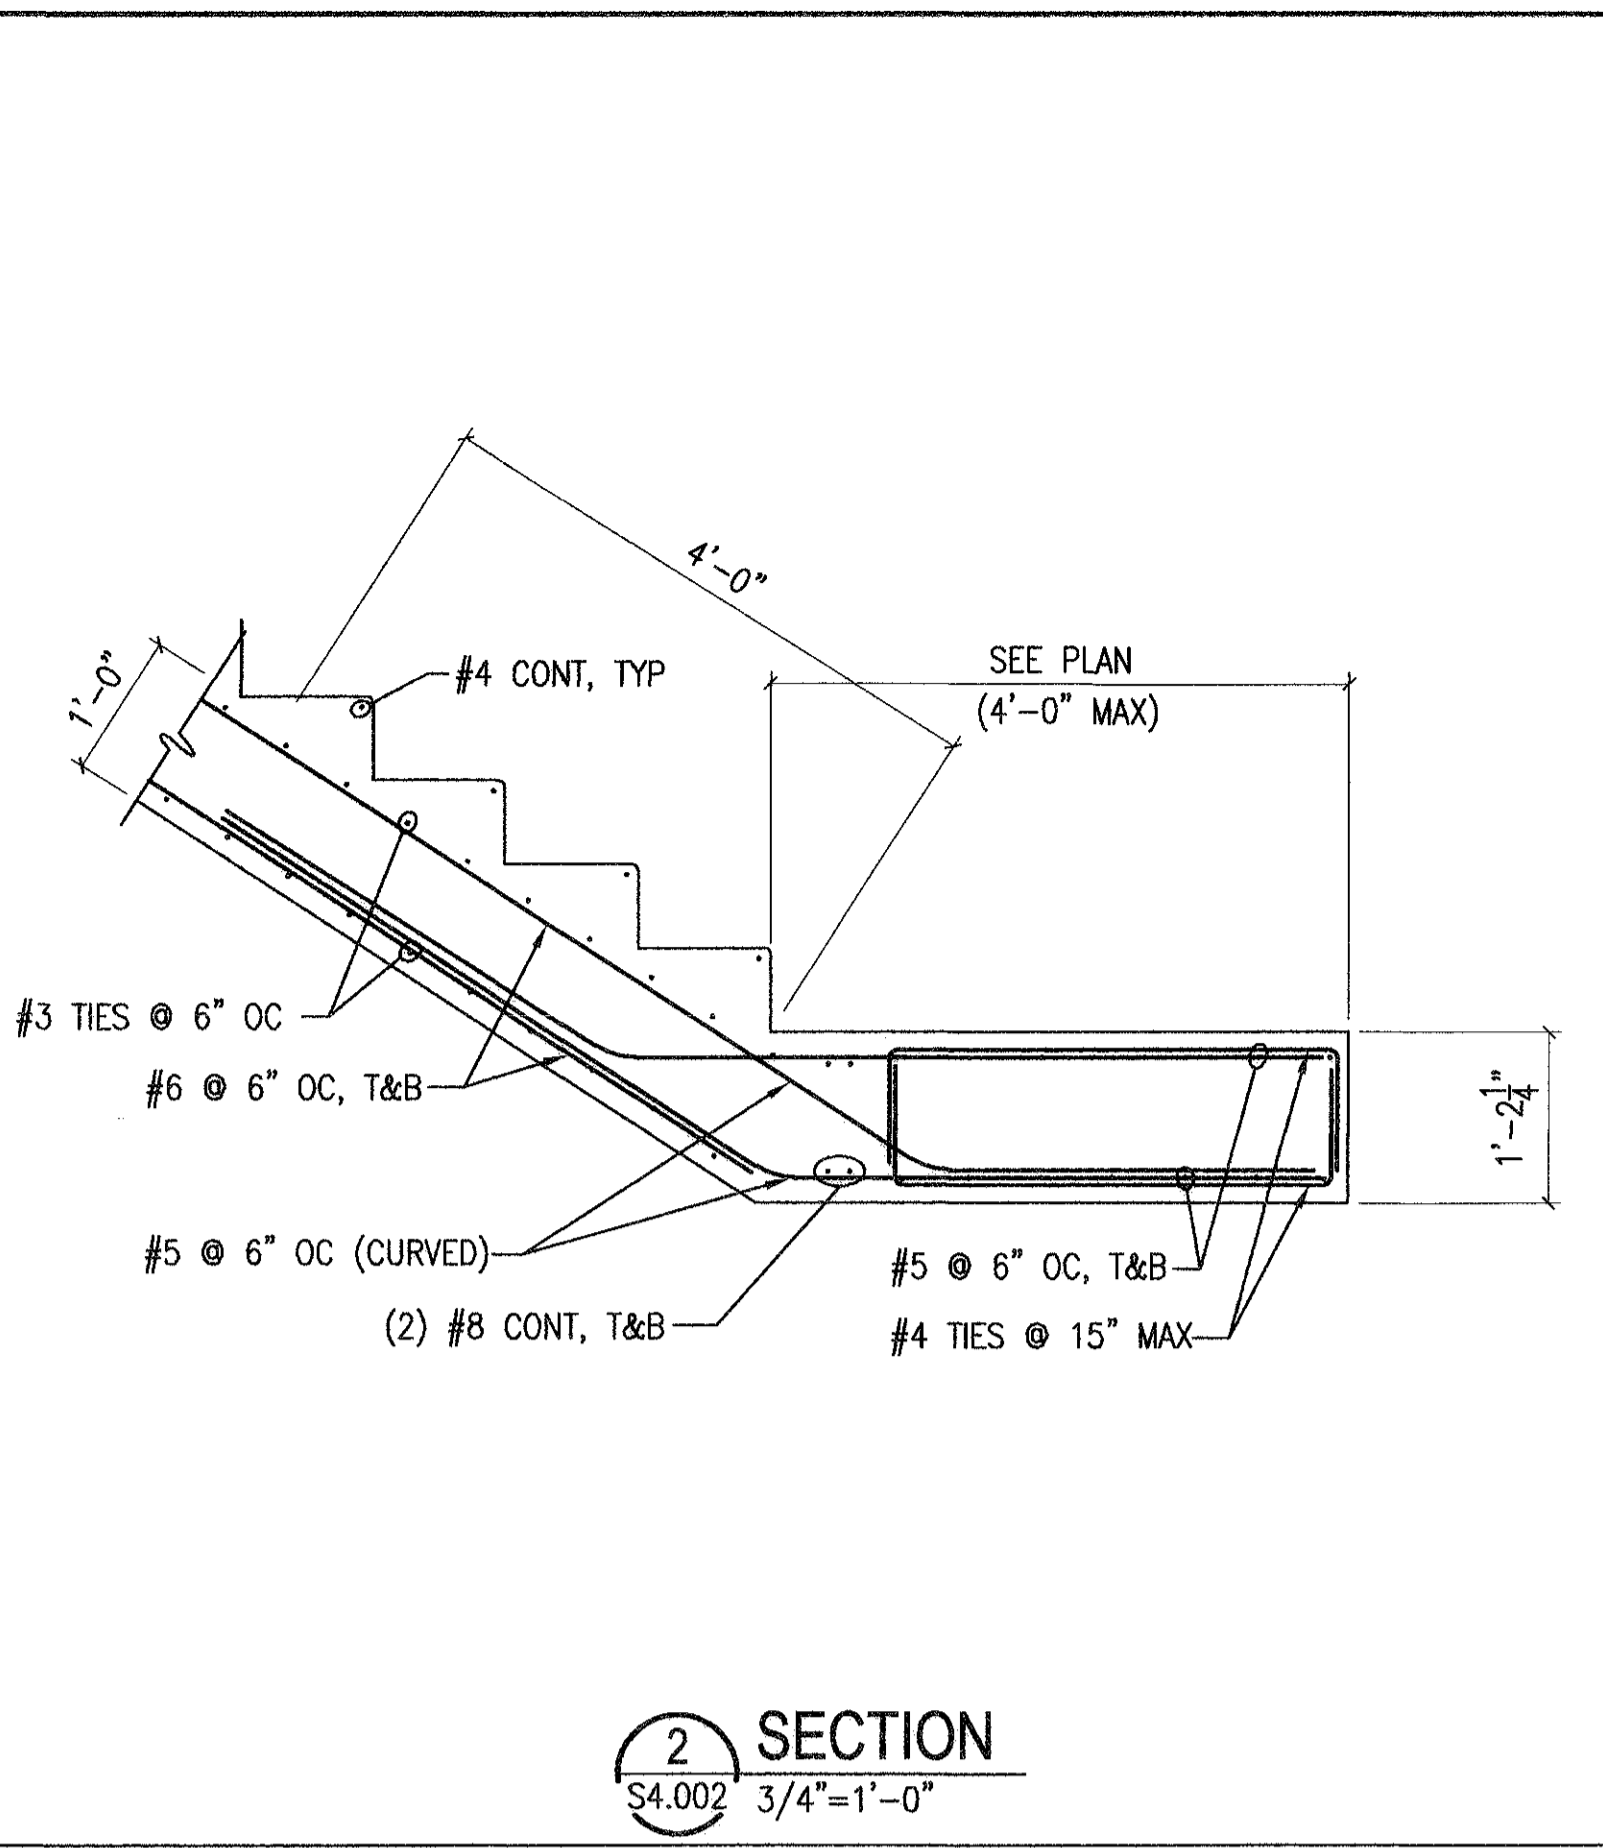


**2 SECTION**  
S4.002 3/4"=1'-0"

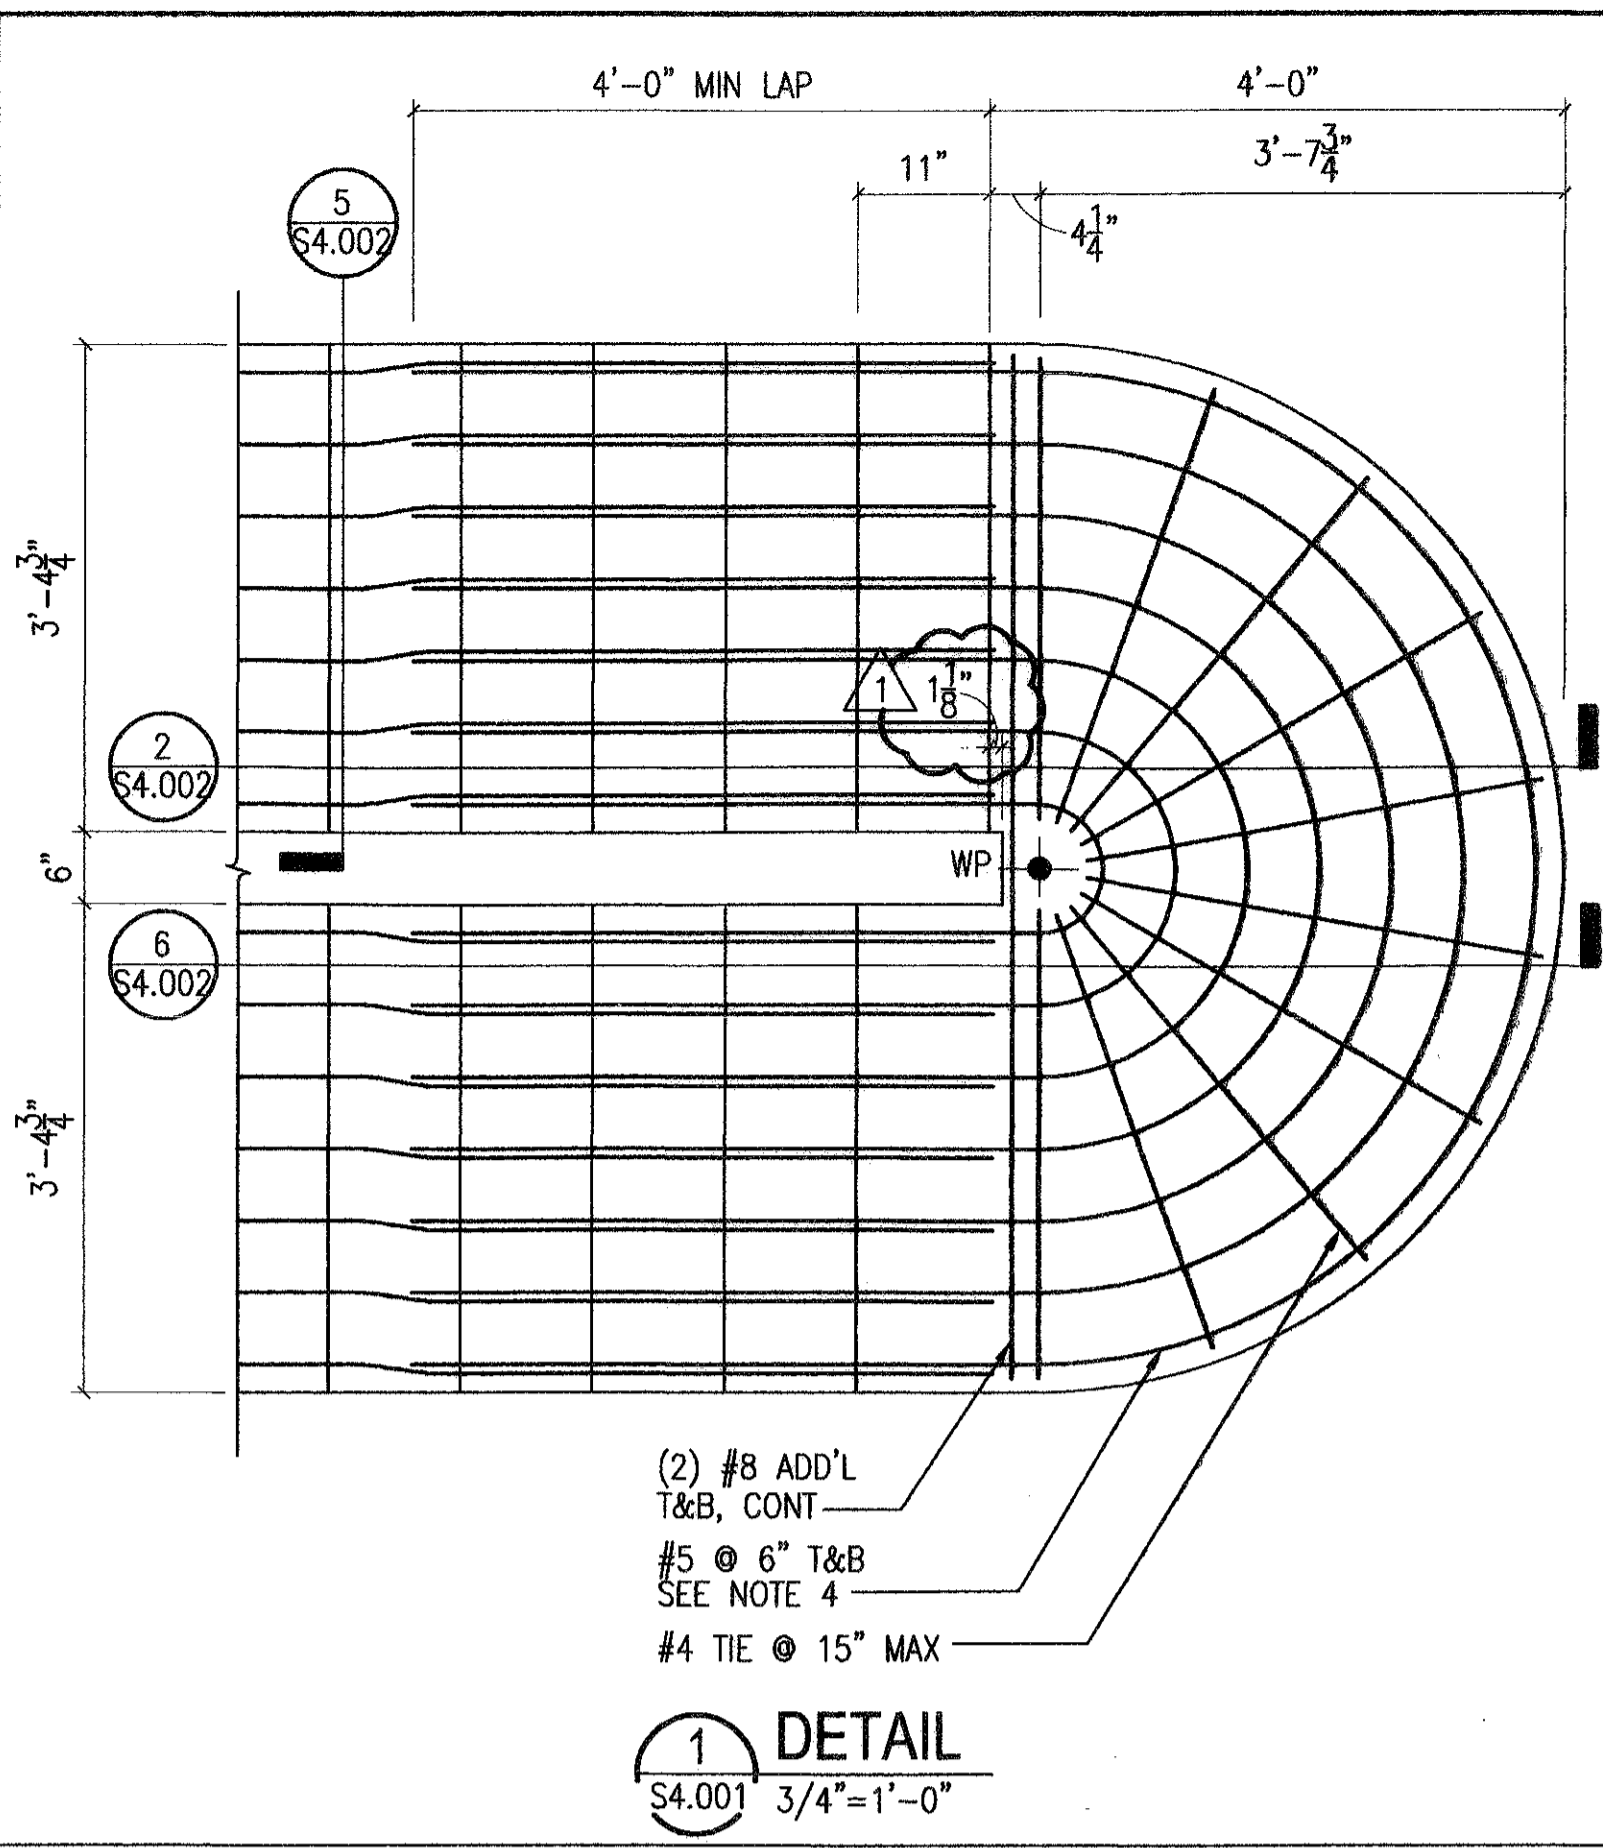


**1 DETAIL**  
S4.001 3/4"=1'-0"

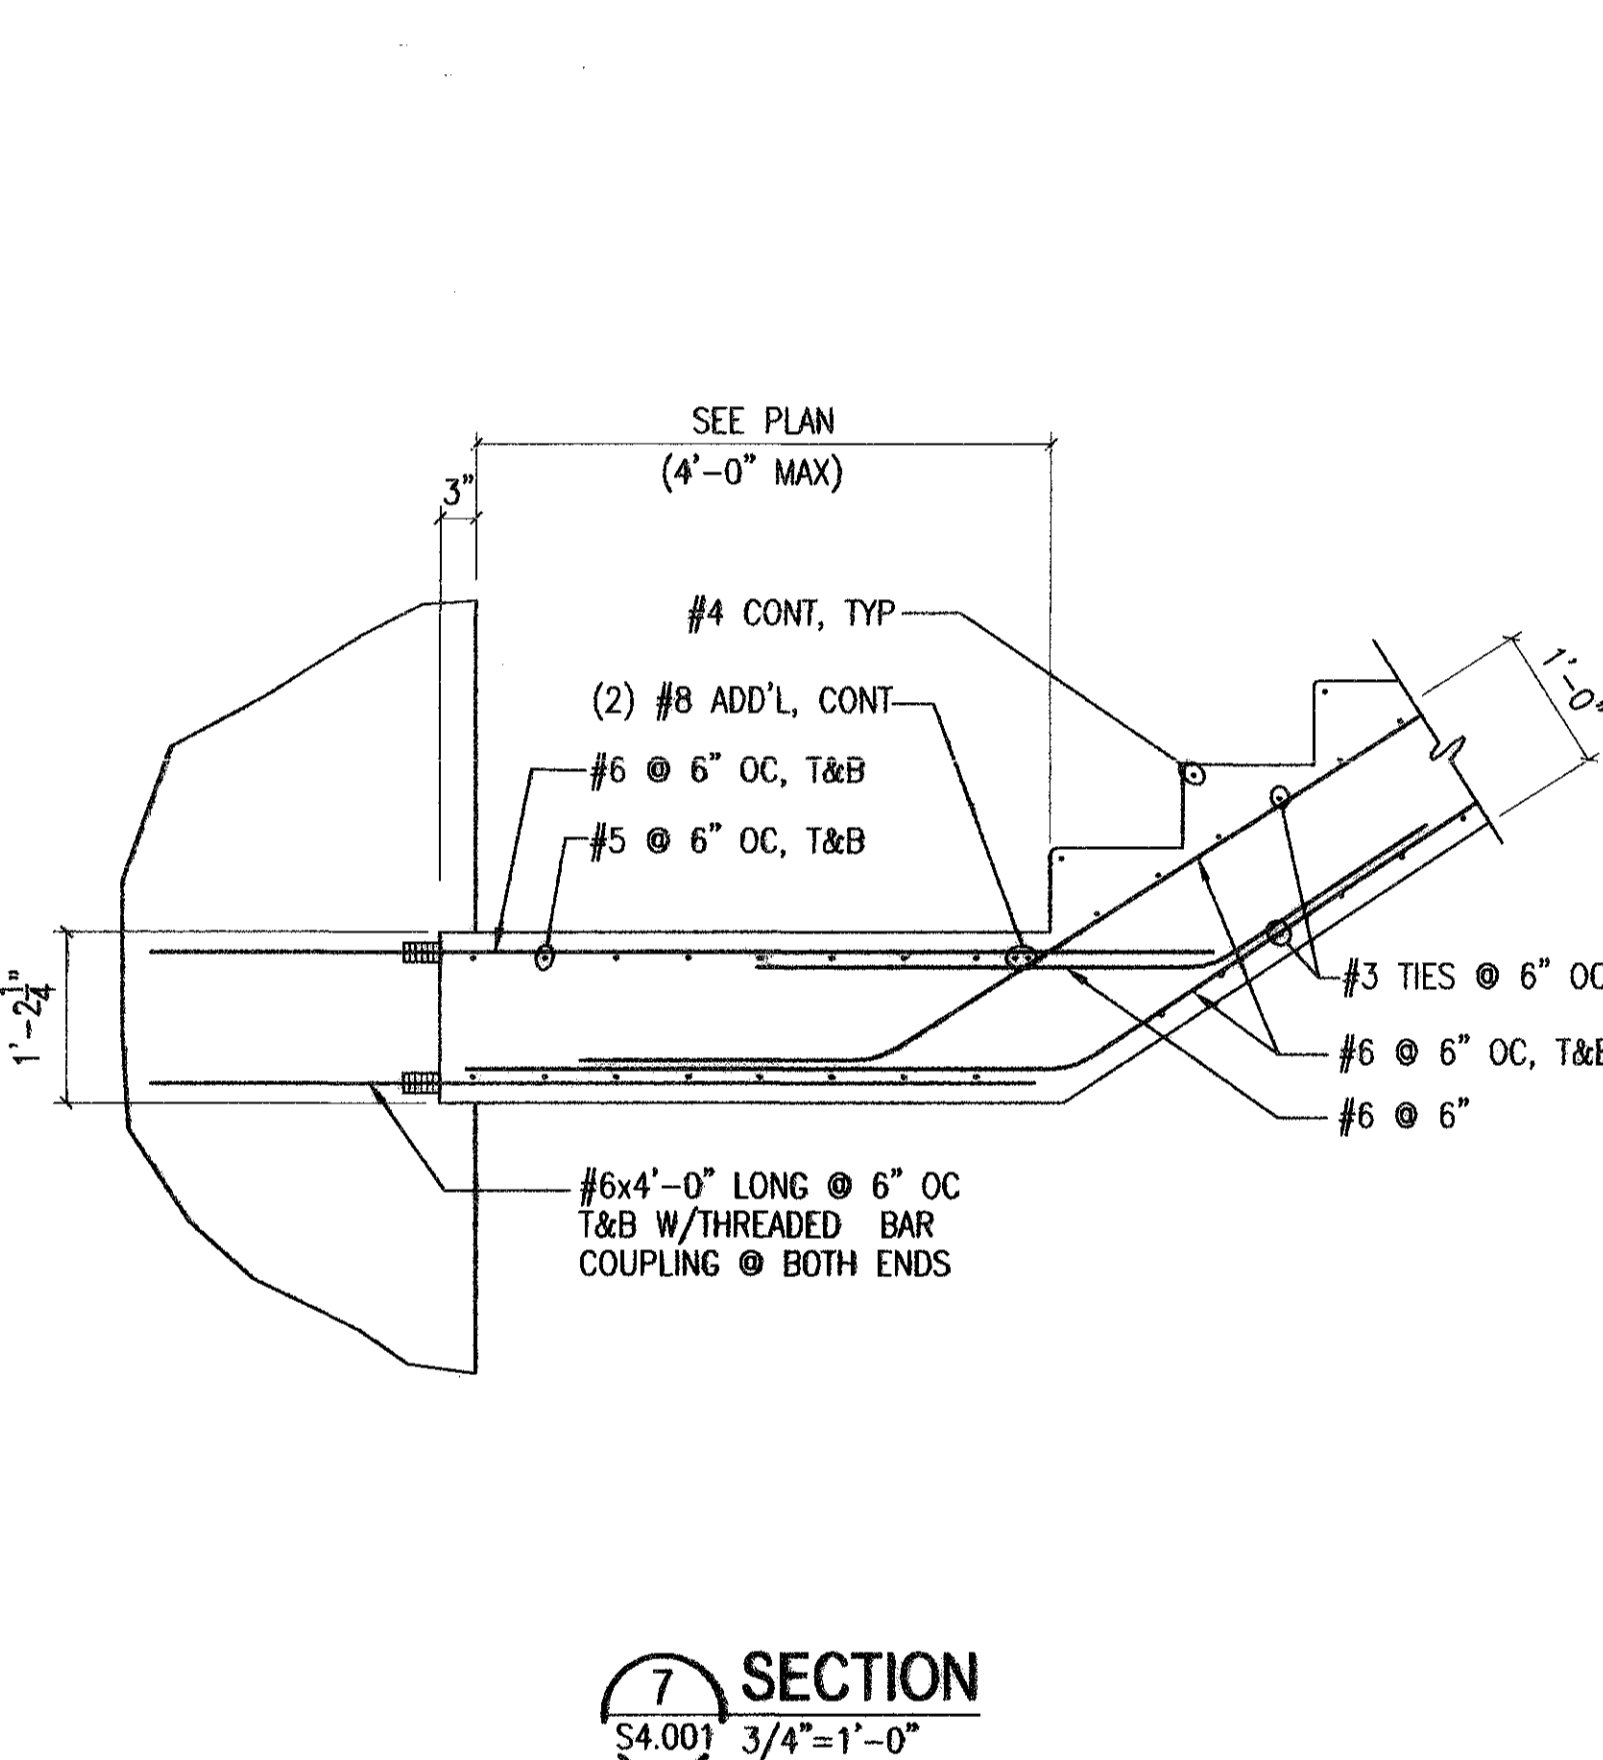


**7 SECTION**  
S4.001 3/4"=1'-0"

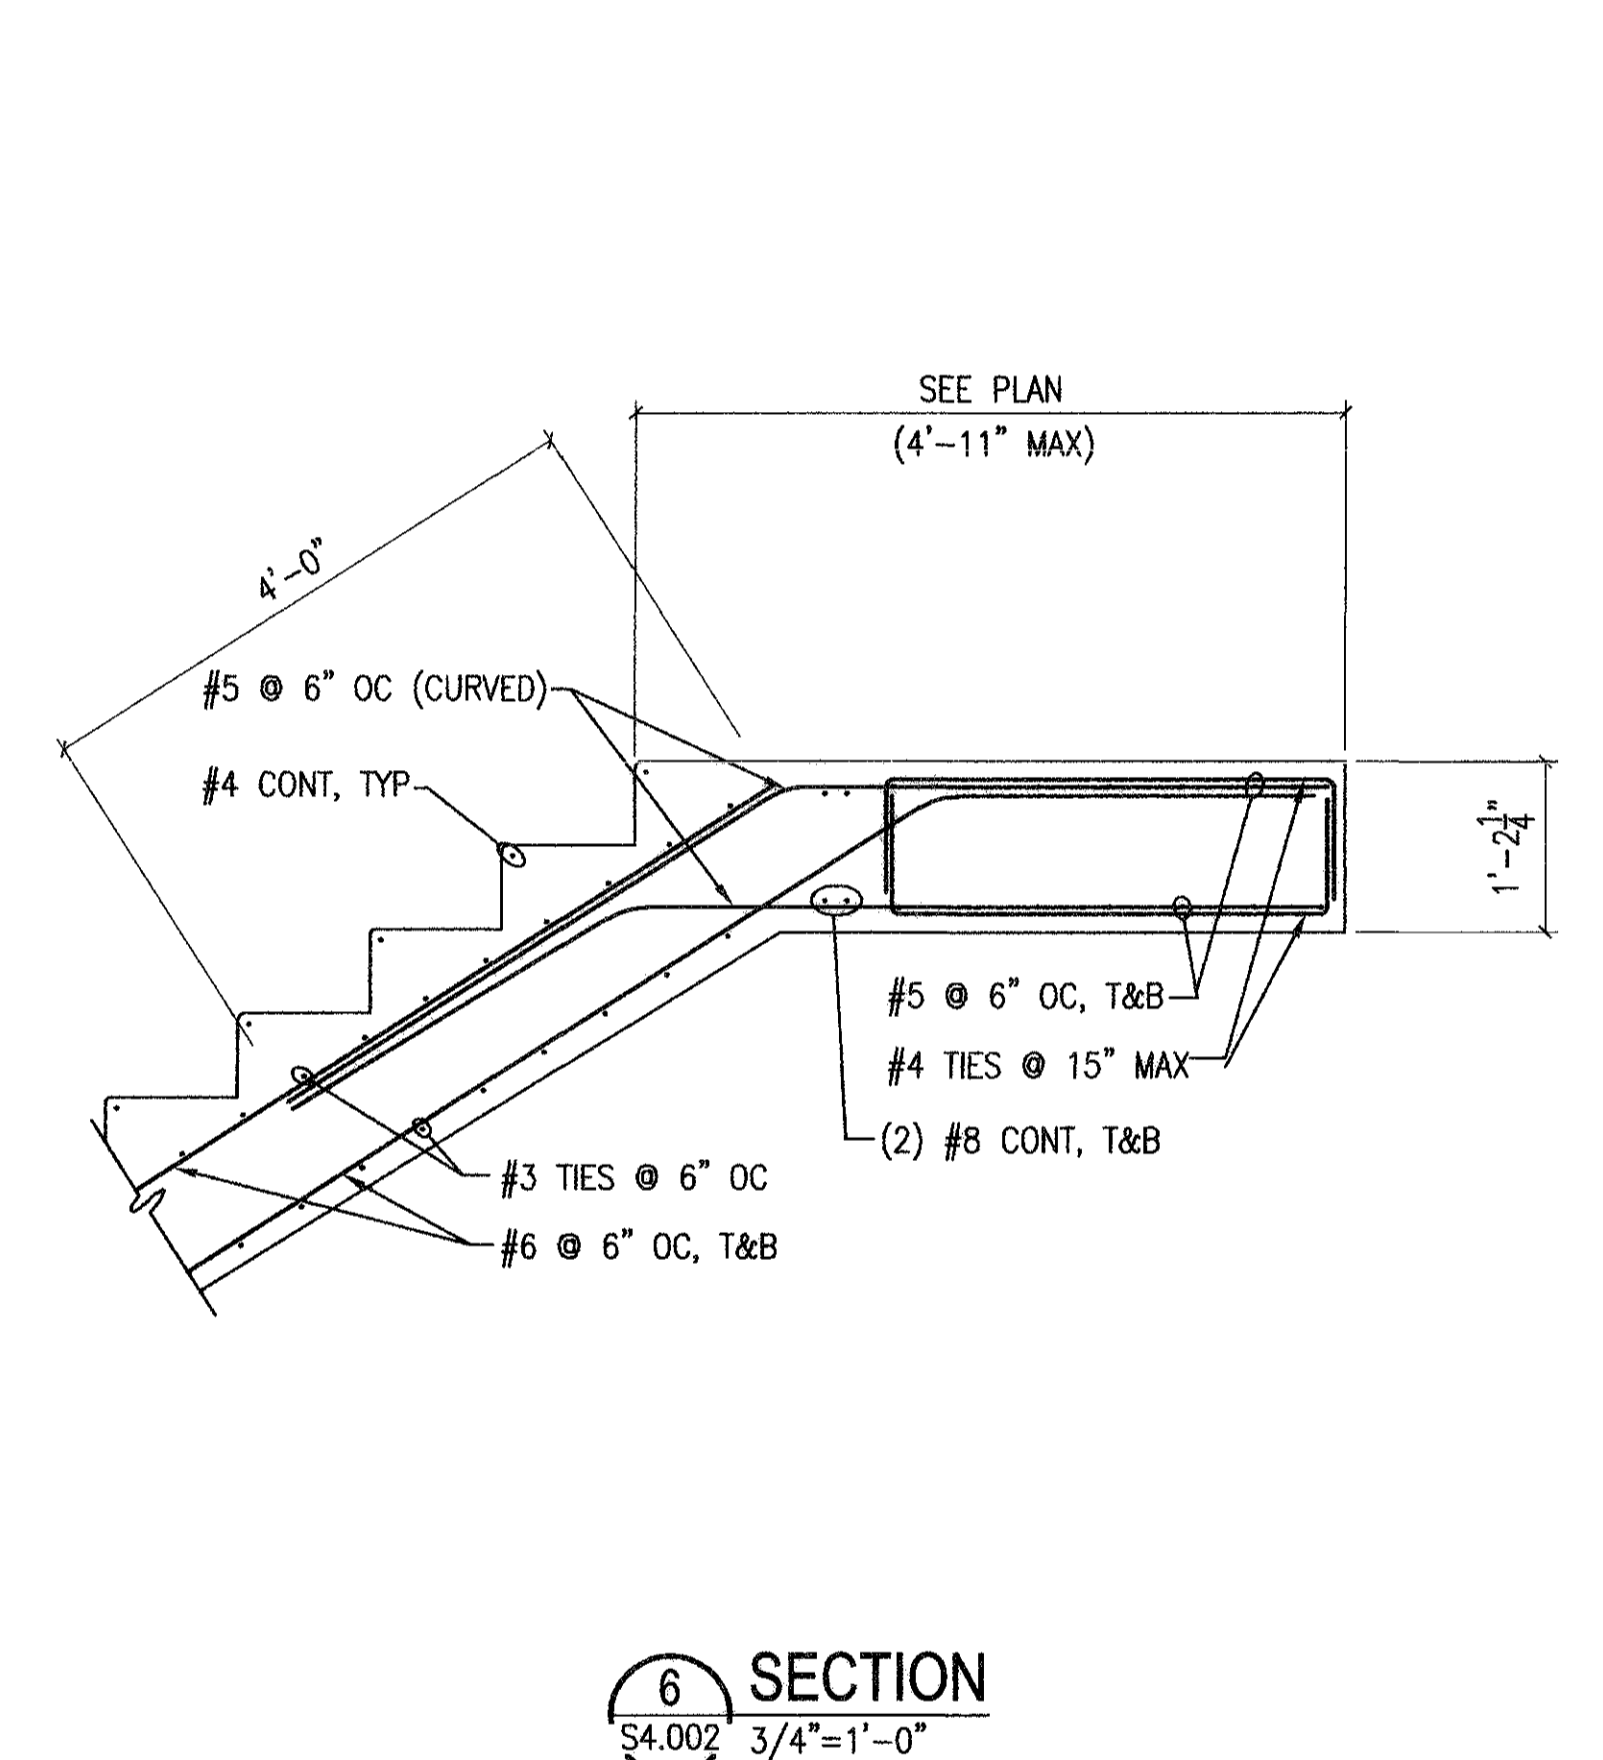


**6 SECTION**  
S4.002 3/4"=1'-0"

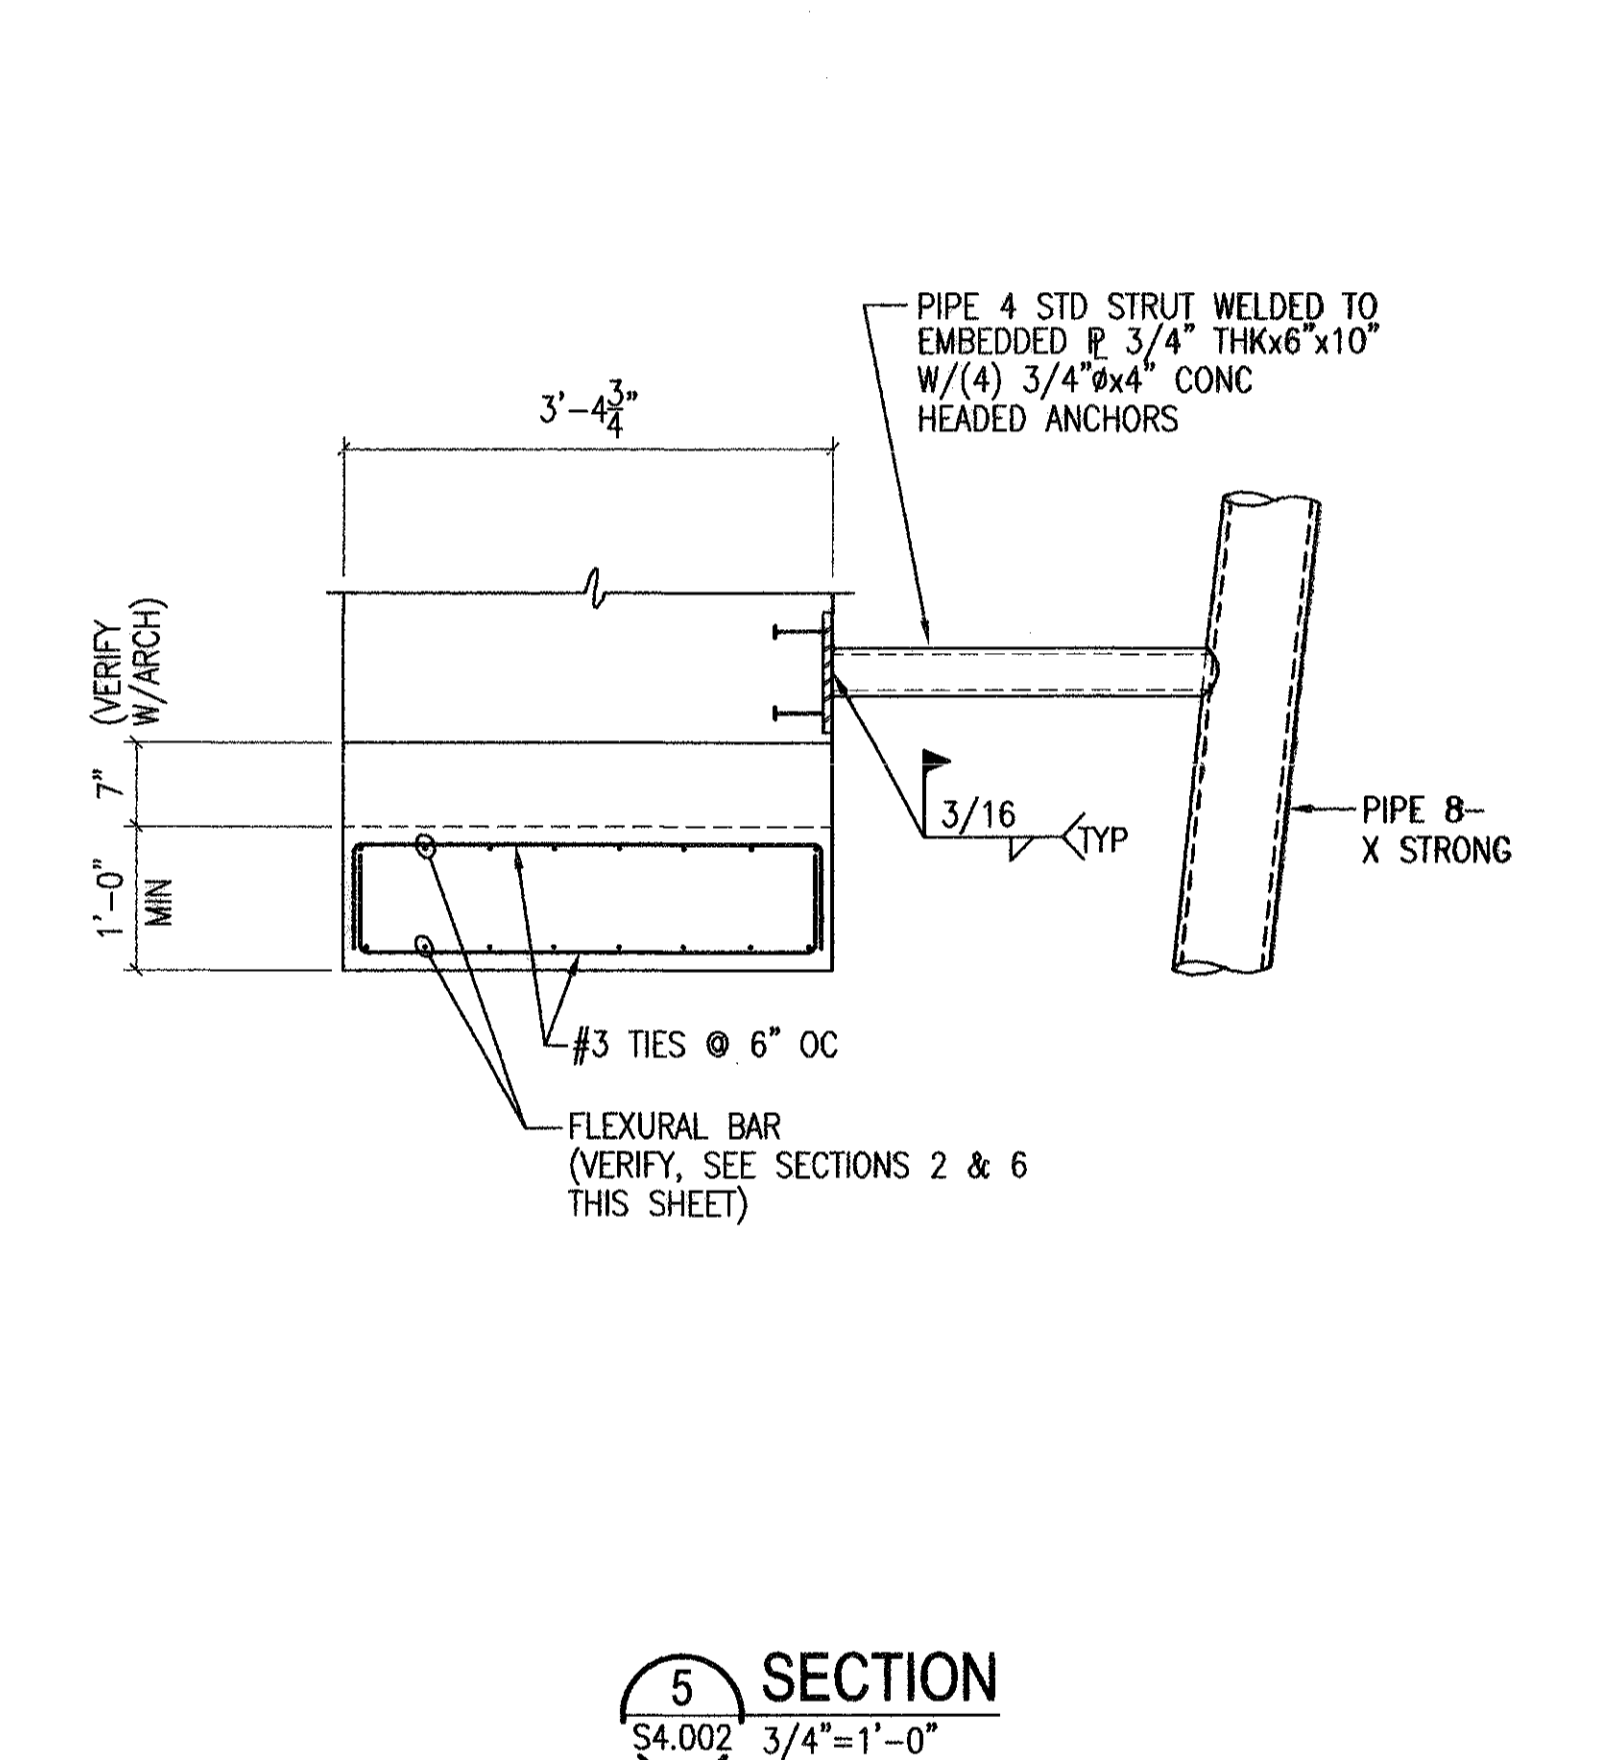


**5 SECTION**  
S4.002 3/4"=1'-0"

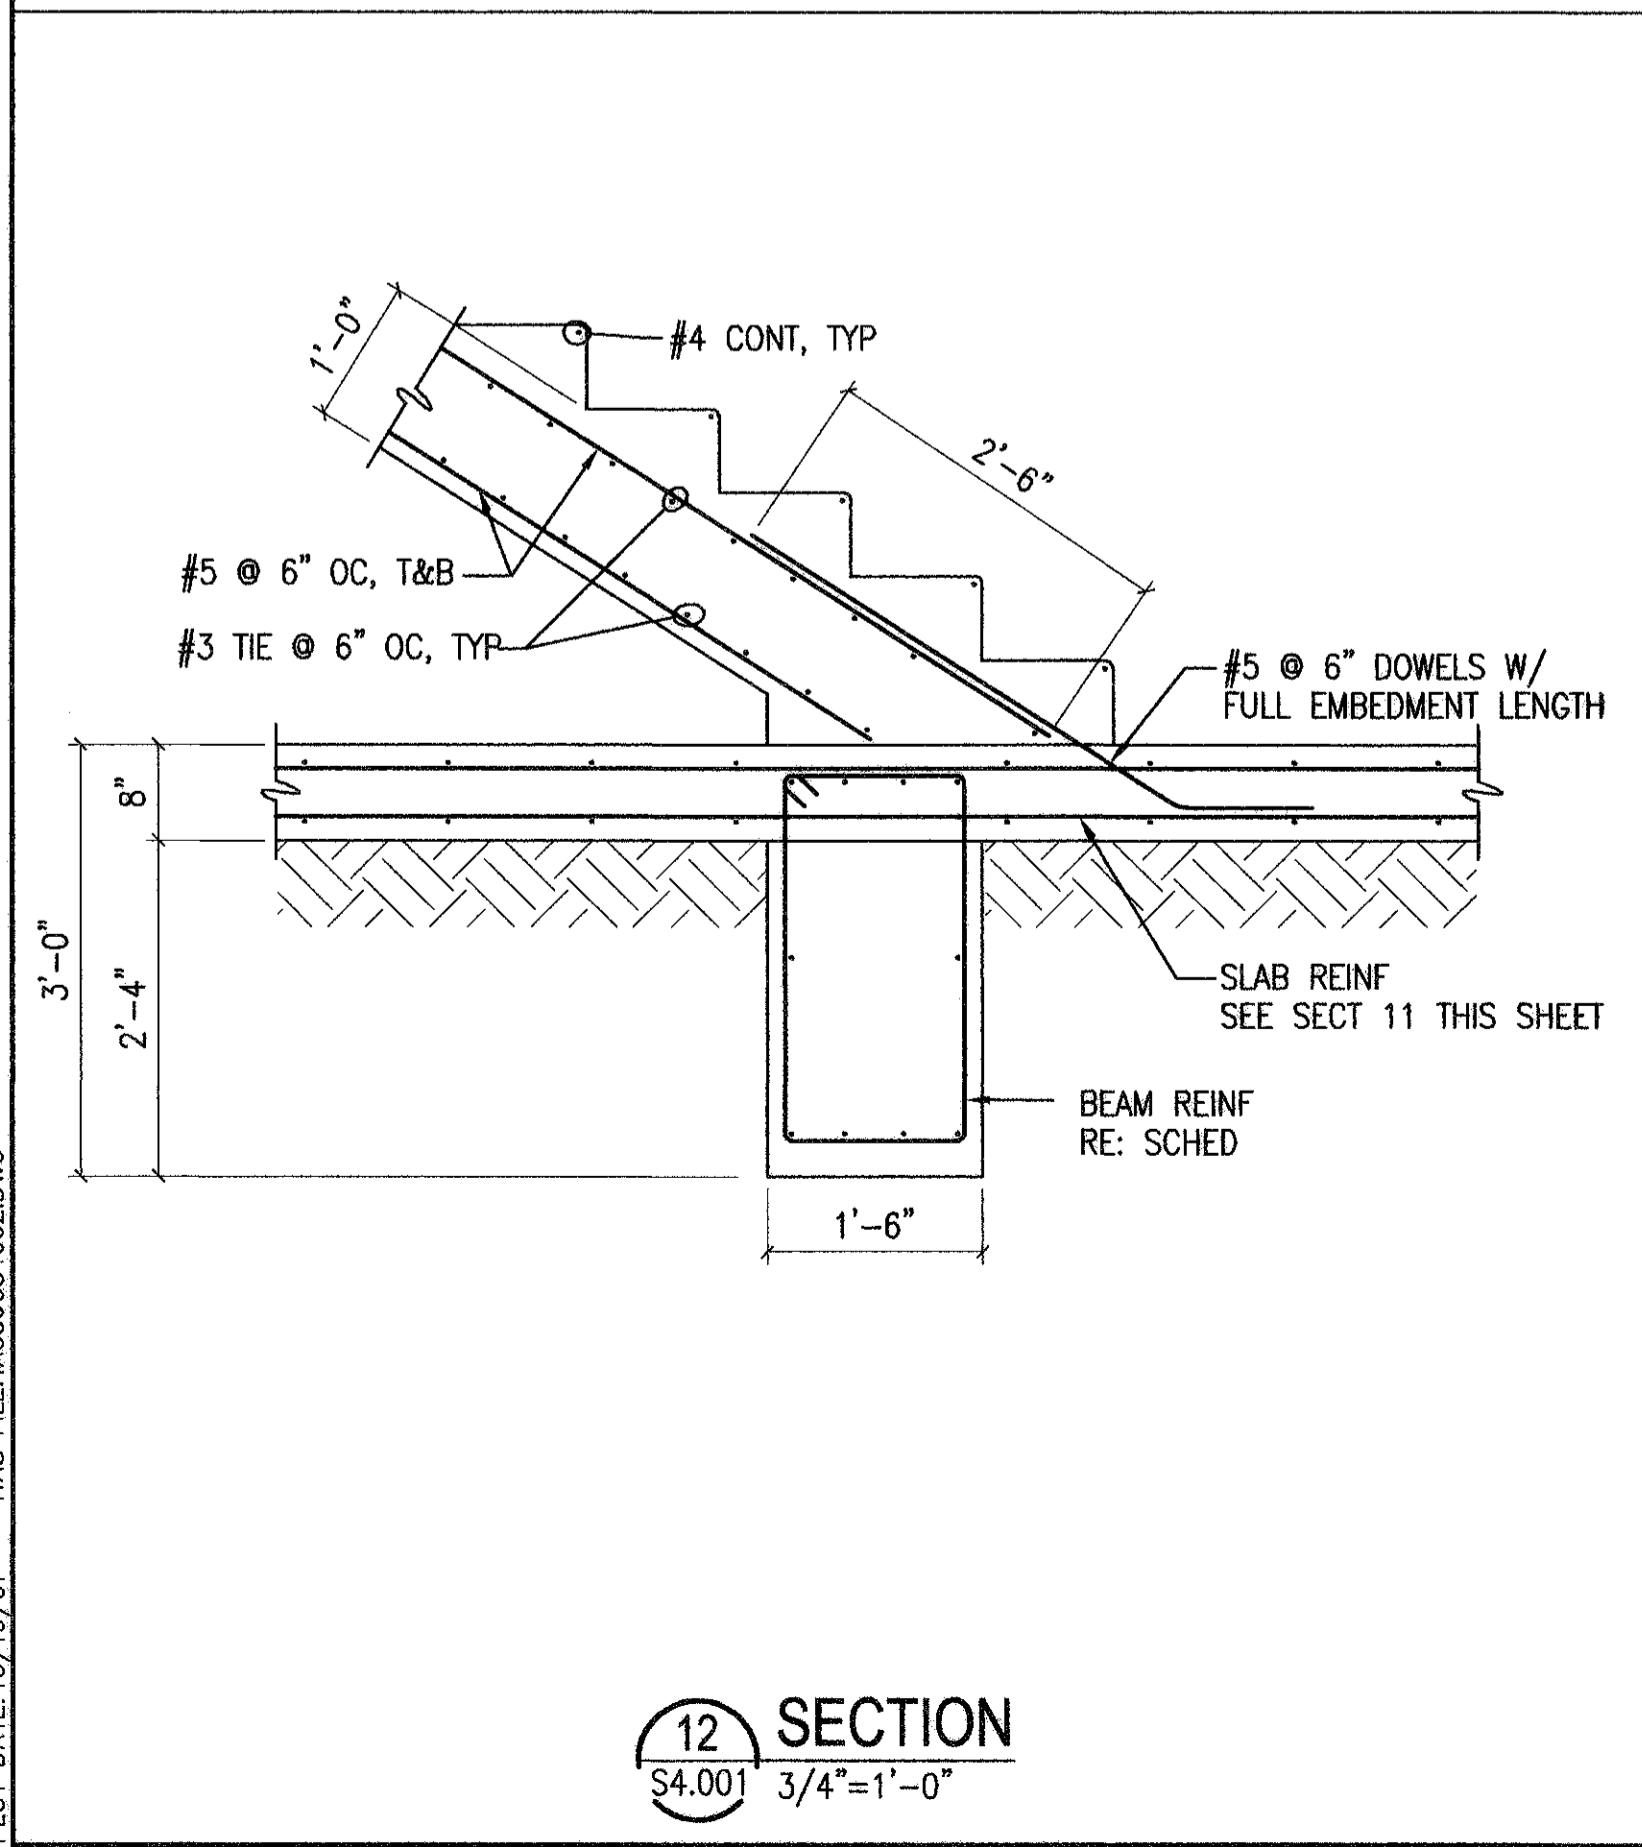


**12 SECTION**  
S4.001 3/4"=1'-0"

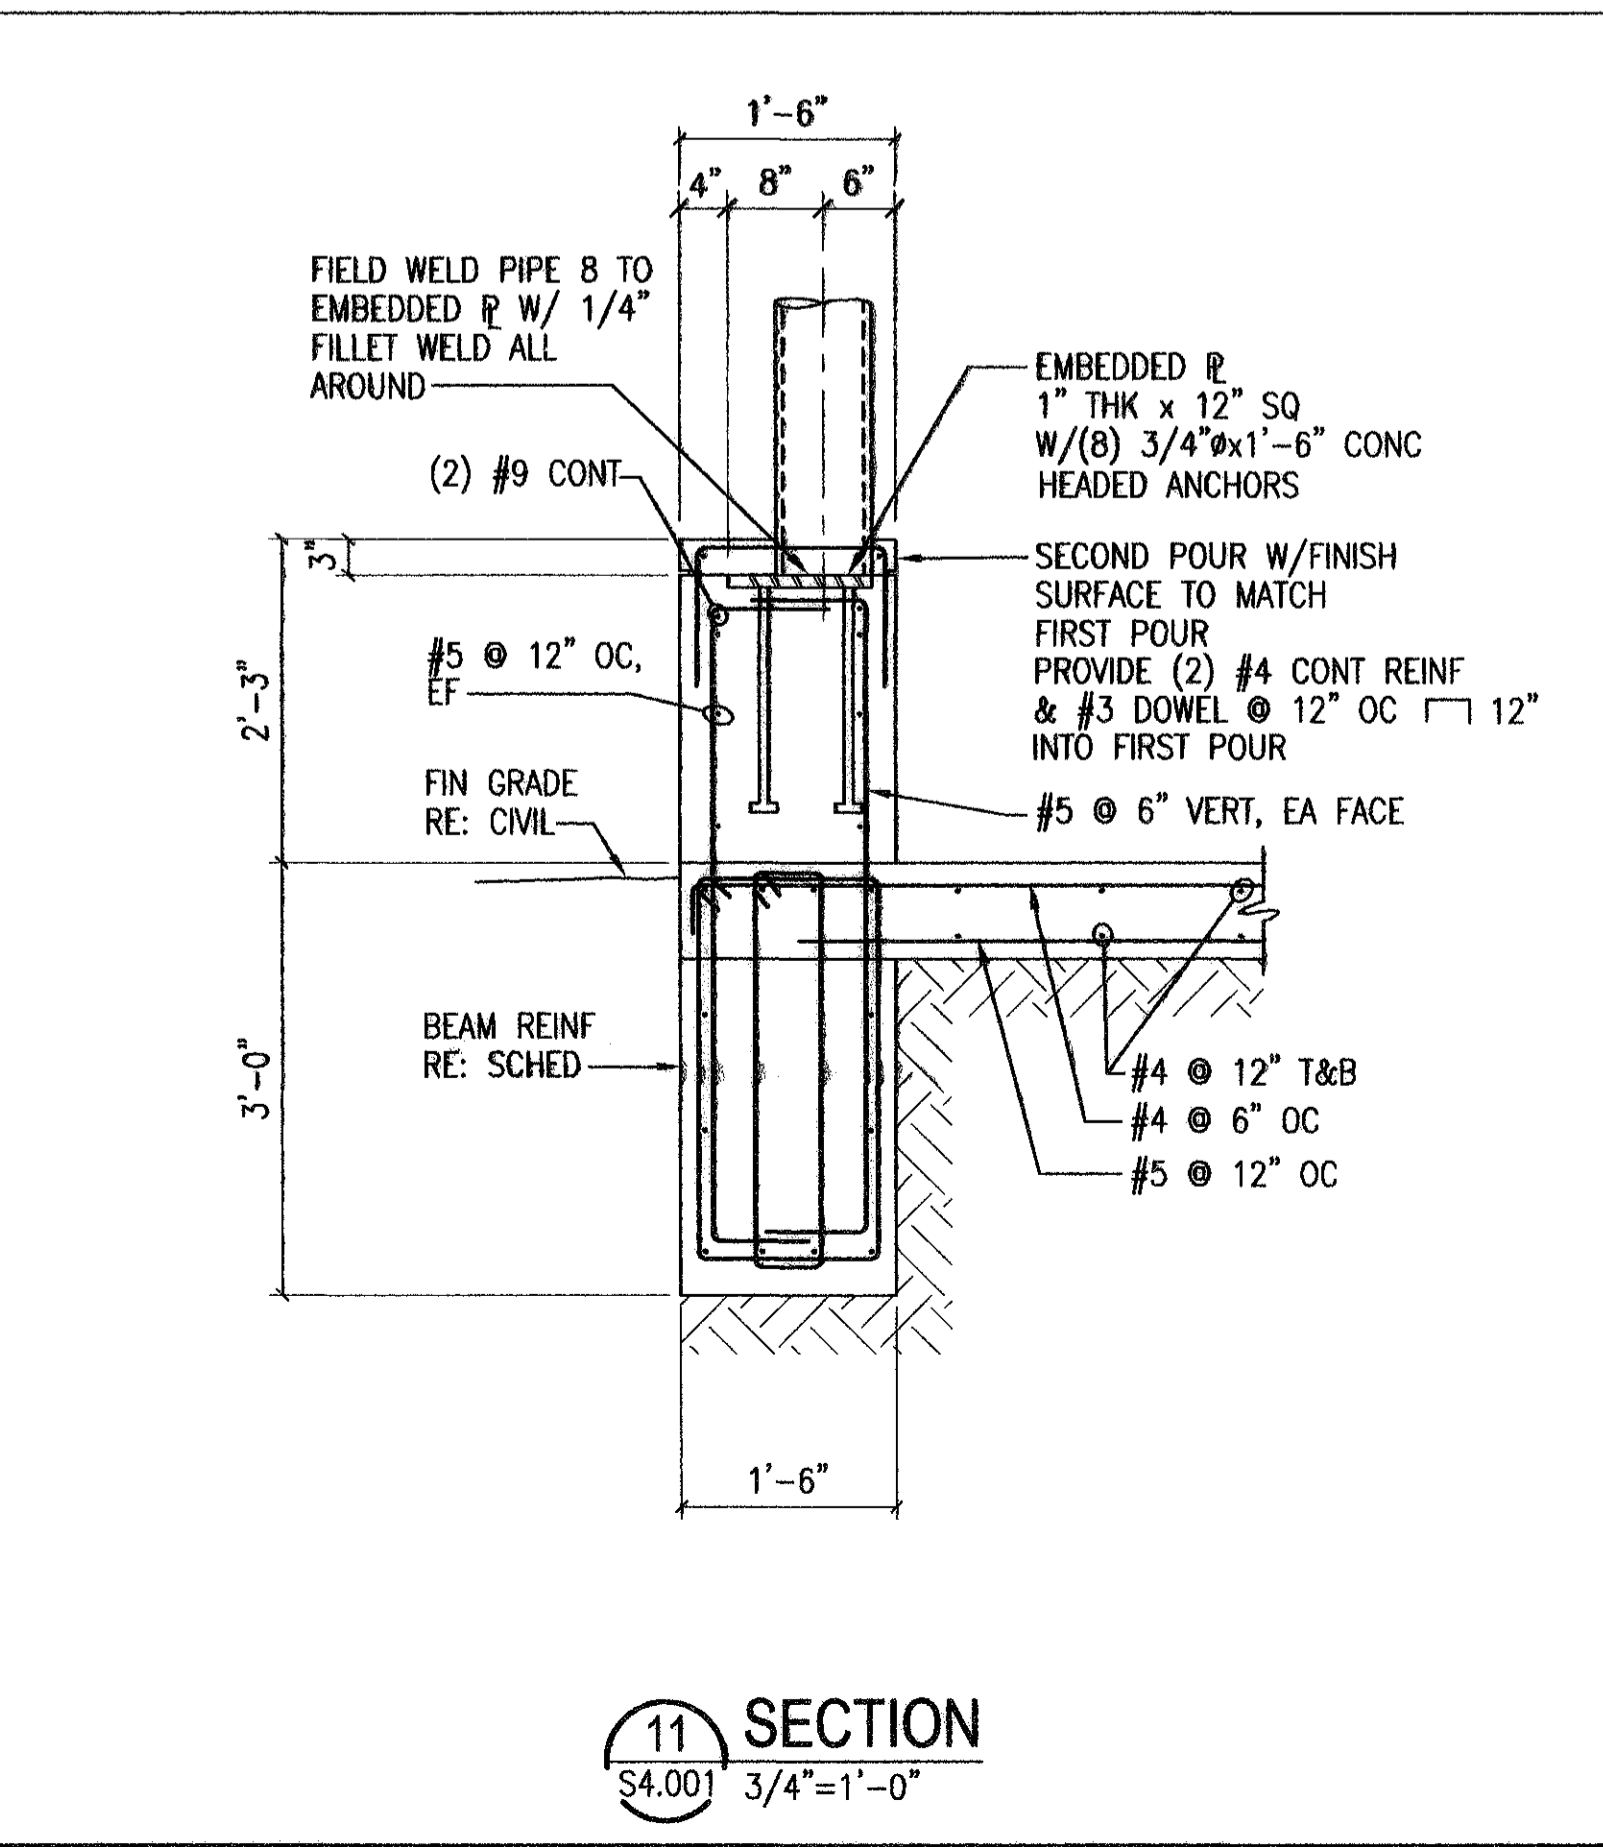

**11 SECTION**  
S4.001 3/4"=1'-0"

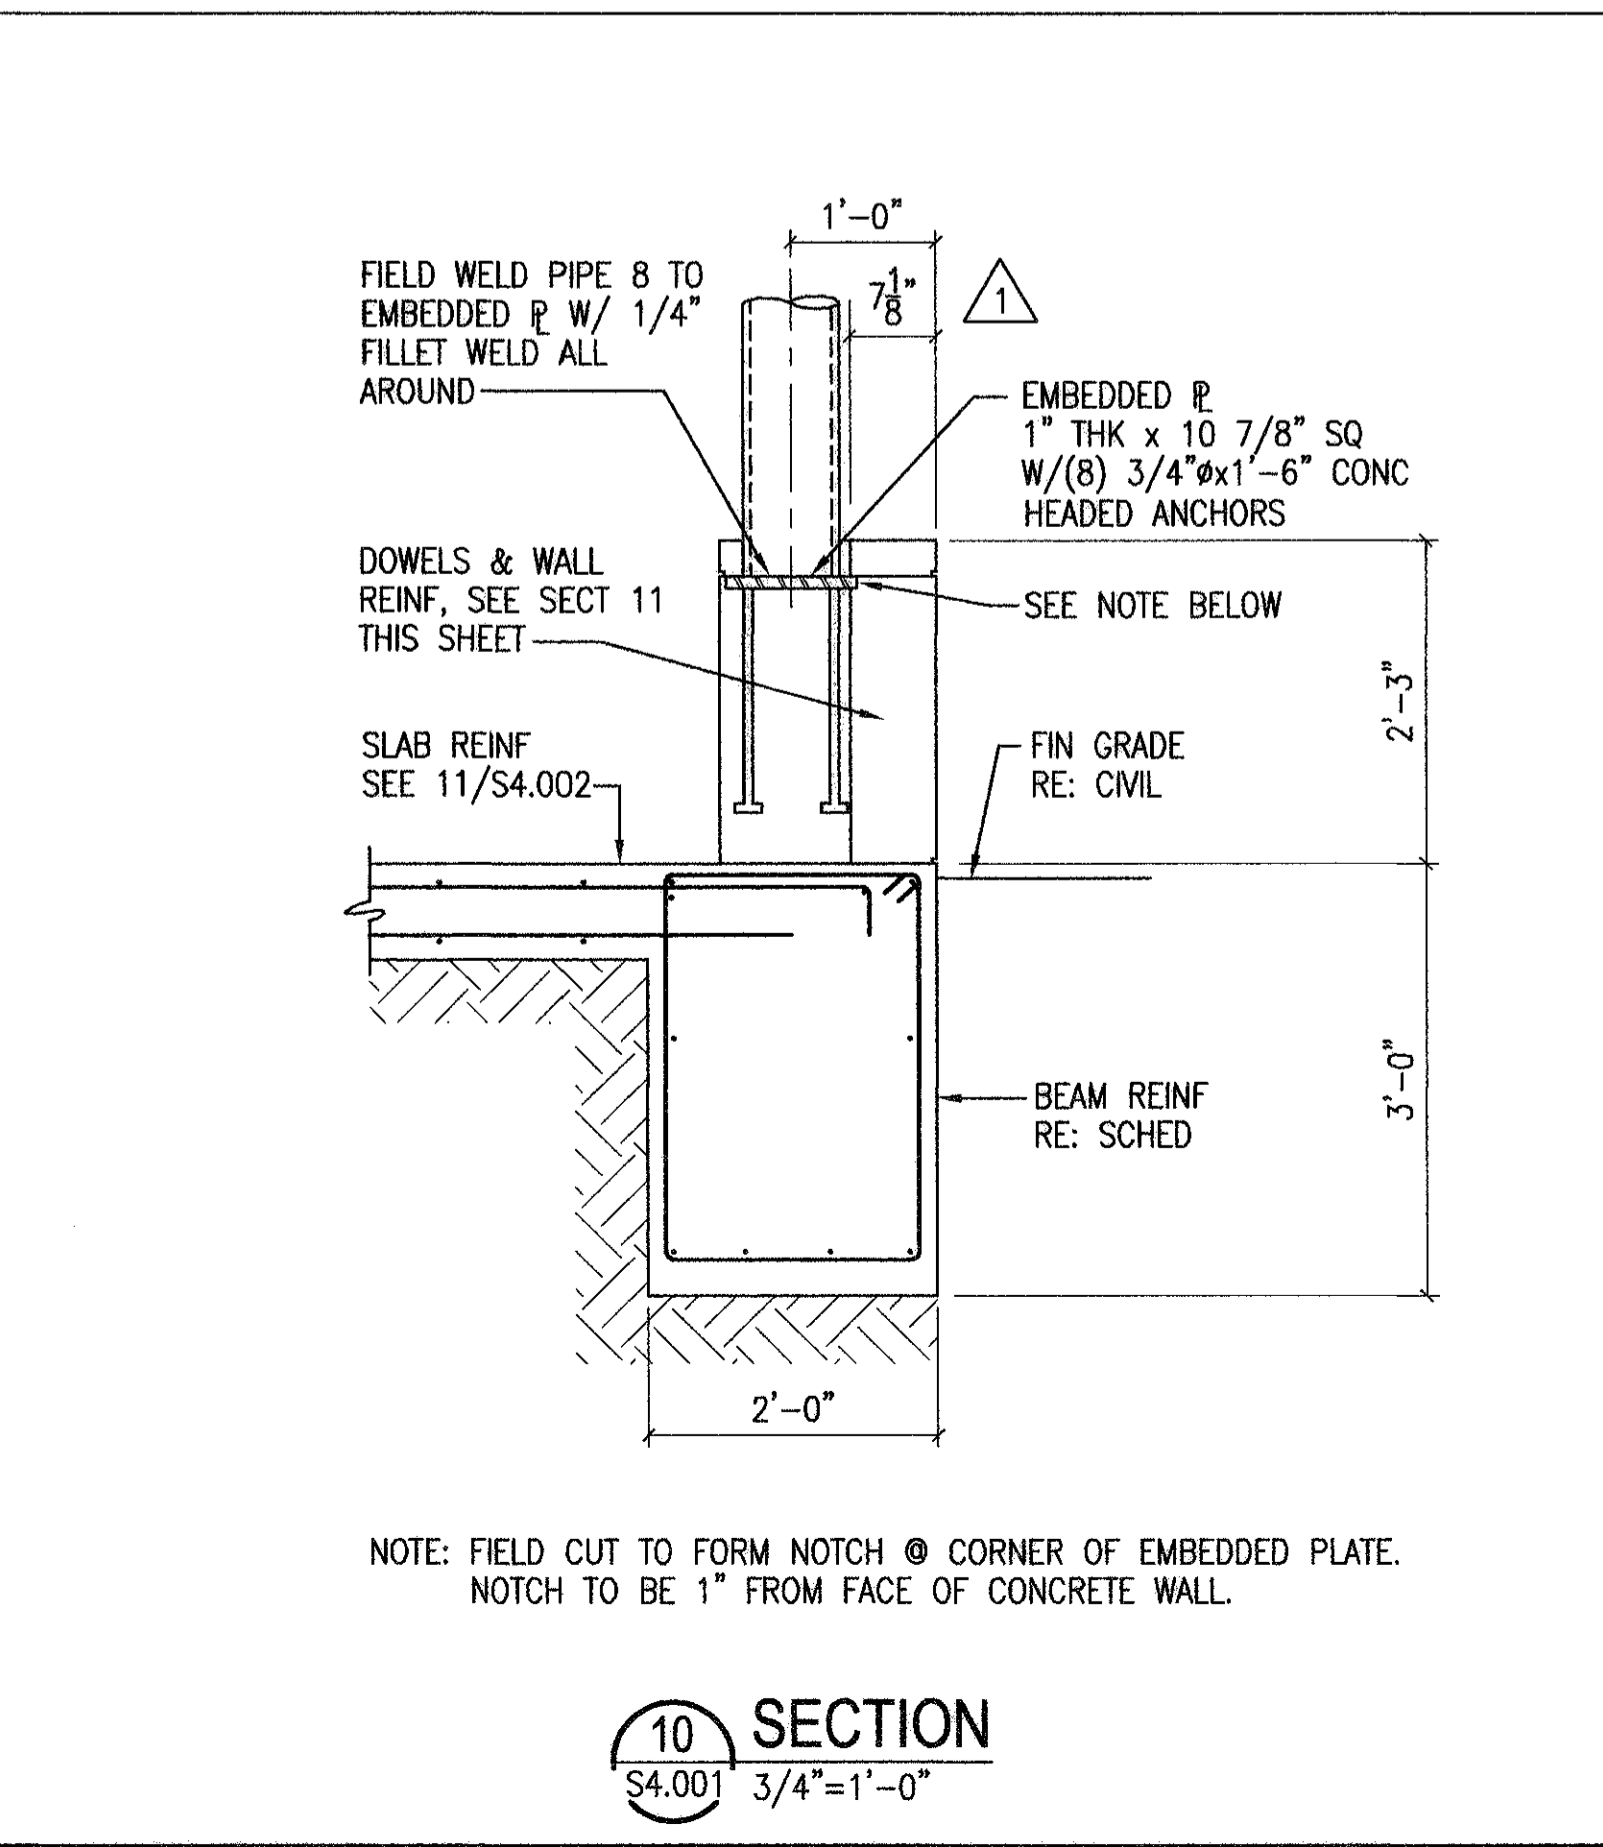

**10 SECTION**  
S4.001 3/4"=1'-0"

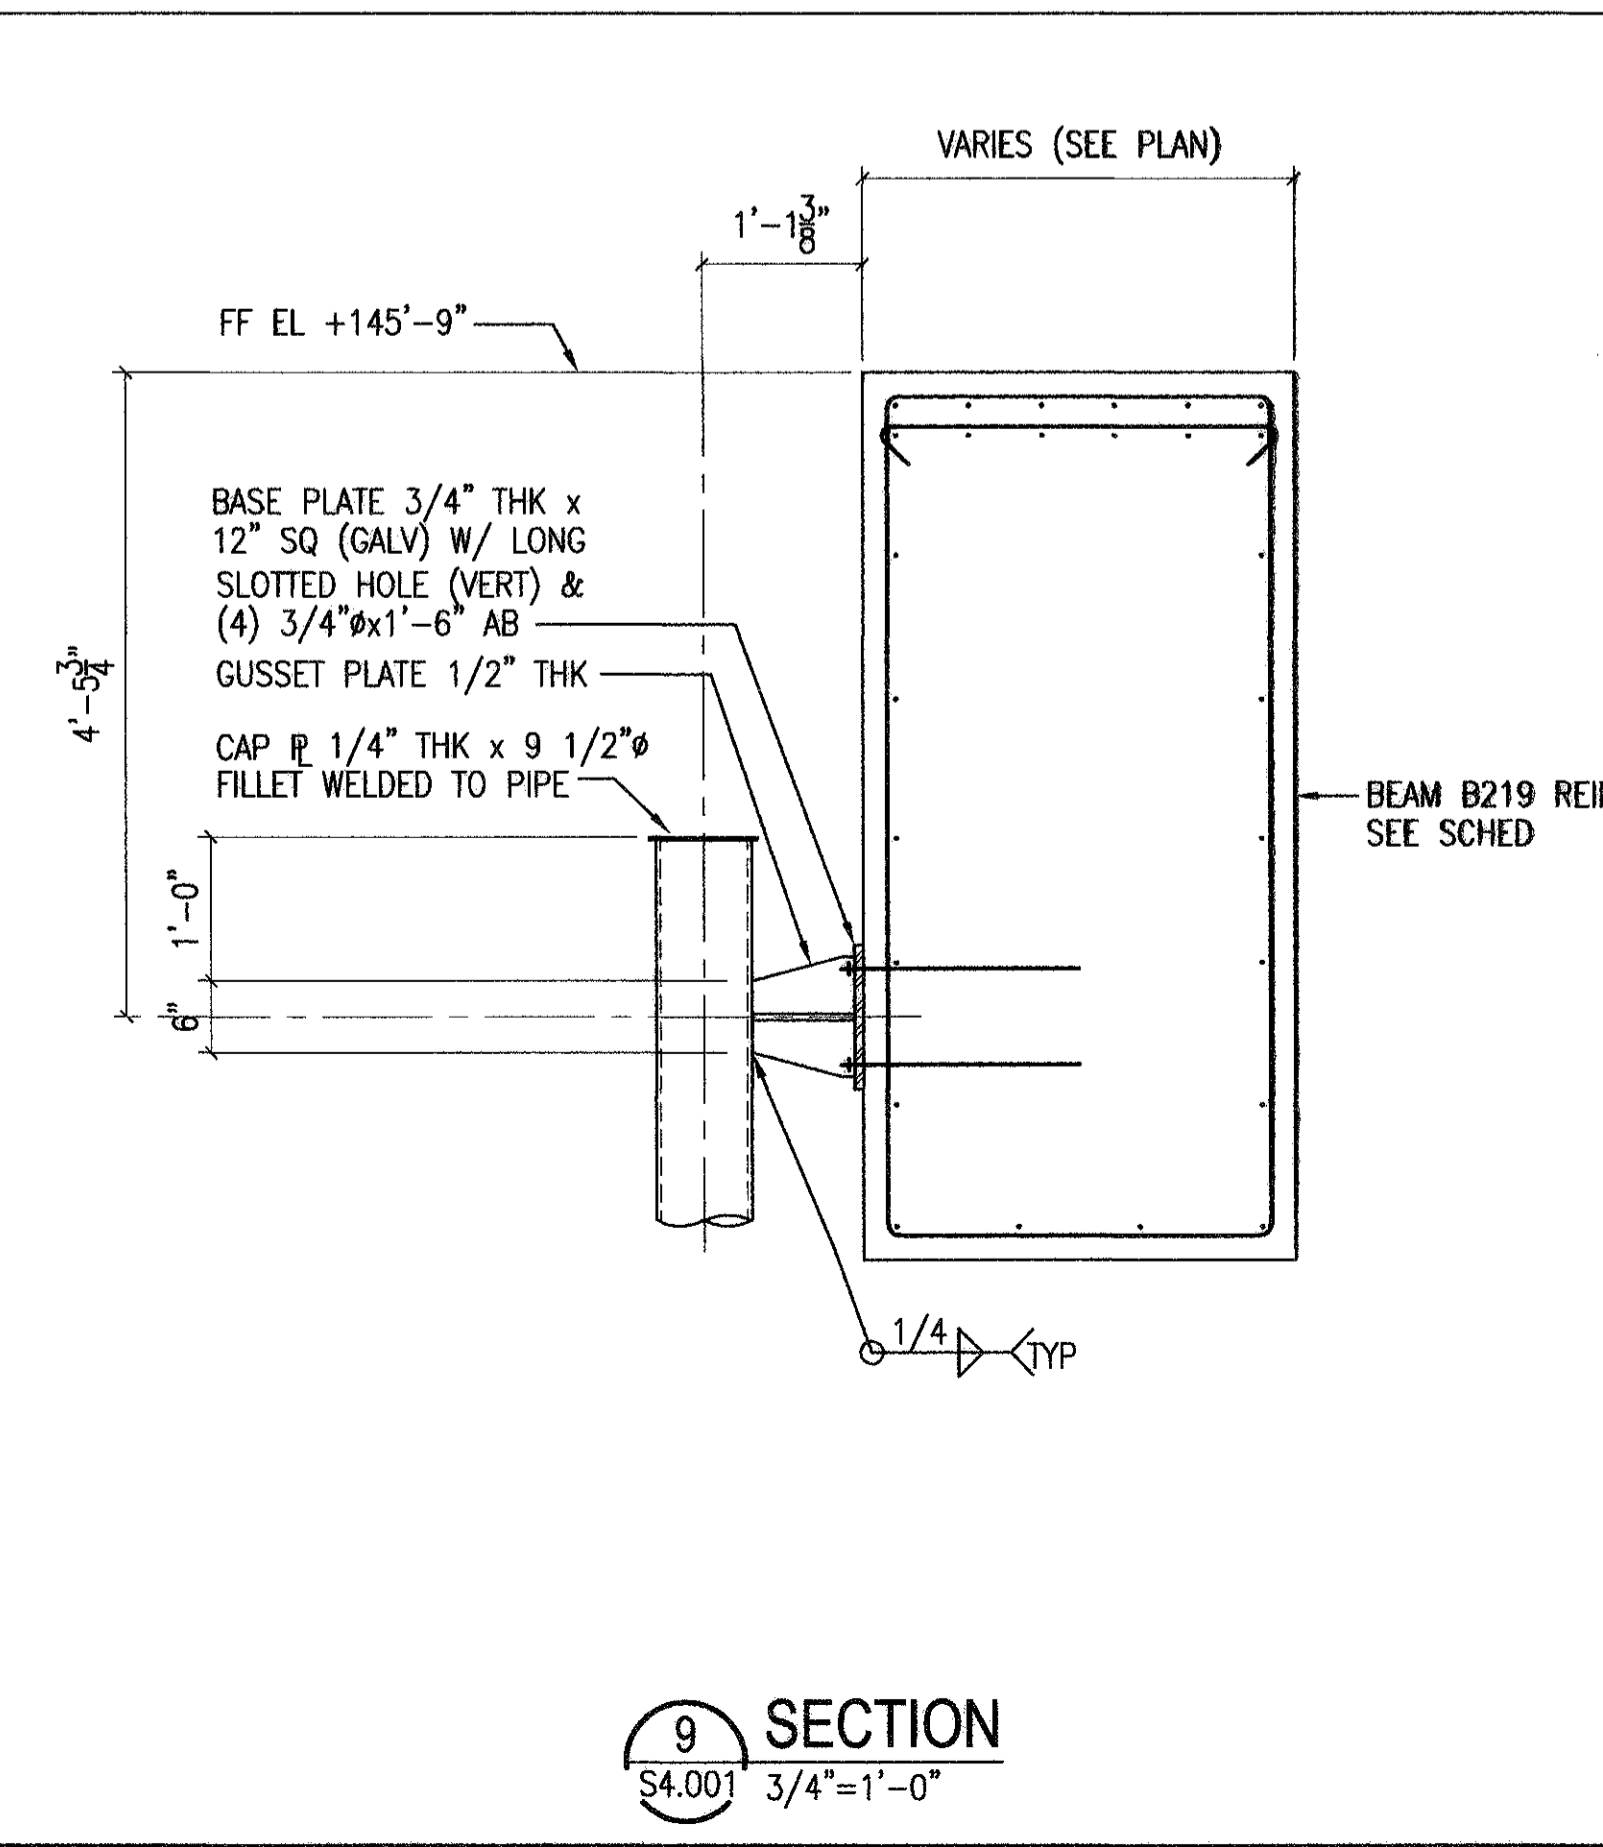

**9 SECTION**  
S4.001 3/4"=1'-0"

**NOTES TO SHEET**

- REFER TO SHEET S0.100 FOR STRUCTURAL GENERAL NOTES.
- REFER TO SHEET S0.301 FOR CONCRETE BEAM SCHEDULE.
- POSITION EMBEDDED @ FOR STRUT BRACING TO BE PARALLEL TO BOTTOM OF SLAB. COORDINATE LOCATION OF SLAB REINF WITH LOCATION OF EXPANSION BOLT PRIOR TO CONCRETING.
- LAP SPLICE MAY BE PROVIDED IN LIEU OF CONT CIRCUMFERENTIAL REINF AS SHOWN. CONTRACTOR SHALL PROPOSE SPLICE LOCATION FOR ENGINEER'S APPROVAL PRIOR TO SUBMITTING SHOP DRAWINGS.

REVISIONS

NO.	DESCRIPTION	DATE	BY
1	ISSUED FOR BID	10/19/01	
2	ADDENDUM #1	02/01/02	MR

**HOUSTON AIRPORT SYSTEM**  
GEORGE BUSH  
INTERCONTINENTAL AIRPORT  
HOUSTON TEXAS

**HUITT-ZOLLARS**  
Engineering / Architecture  
1500 West Loop South, Suite 200, Houston, TX 77027  
Phone (281) 486-0066 Fax (281) 486-0220

**CHARLES F. TERRY, INC.**  
Consulting Engineers  
2807 Madison Avenue  
Dallas, Texas 75228  
DORNBACH TEL 972-838-4444

INTERNATIONAL • SERVICES • EXPANSION • PROGRAM

**APM STATION & PLATFORM**  
STAIR SECTIONS AND DETAILS

PROJECT MGR: GRW  
DESIGNER: JUC  
DRAWN BY: KLV  
CHECKED BY: MMR  
DRAWING STANDARD: ISEP 07.20.2000  
SCALE: AS NOTED  
DATE: 09/14/01

FOR RECORD DRAWING ONLY

STATE OF TEXAS  
MOEN MICHAEL REINHART  
REGISTERED PROFESSIONAL ENGINEER  
NO. 10544  
EXPIRES 09/14/02

APPROVED BY: DATE:  
DIRECTOR  
HOUSTON AIRPORT SYSTEM

PROJECT NO. 02-2025-01  
C.I.P. NO. A-0354  
H.A.S. NO. 538C  
SHEET NO.

NOTE: REFER TO GRAPHIC SCALE IF ACTUAL SHEET SIZE IS OTHER THAN 30"x42".

SCALE: 3/4" = 1'-0"

**RECORD DRAWINGS DO NOT MODIFY**

DATE: MAY 6, 2005


HUITT-ZOLLARS, INC.

NOTE: INFORMATION USED TO DEVELOP THESE DOCUMENTS WAS TAKEN FROM RECORD OF THE WORK DRAWINGS PREPARED BY THE CONSTRUCTION CONTRACTOR. CLARK/MISSION A JOINT VENTURE. THE INFORMATION PROVIDED BY THE CONTRACTOR WAS NOT VERIFIED BY THE DESIGN FIRM NAMED ABOVE.

S4.002


PLOT DATE: 10/19/01 HAS FILE: IAS36564002.DWG



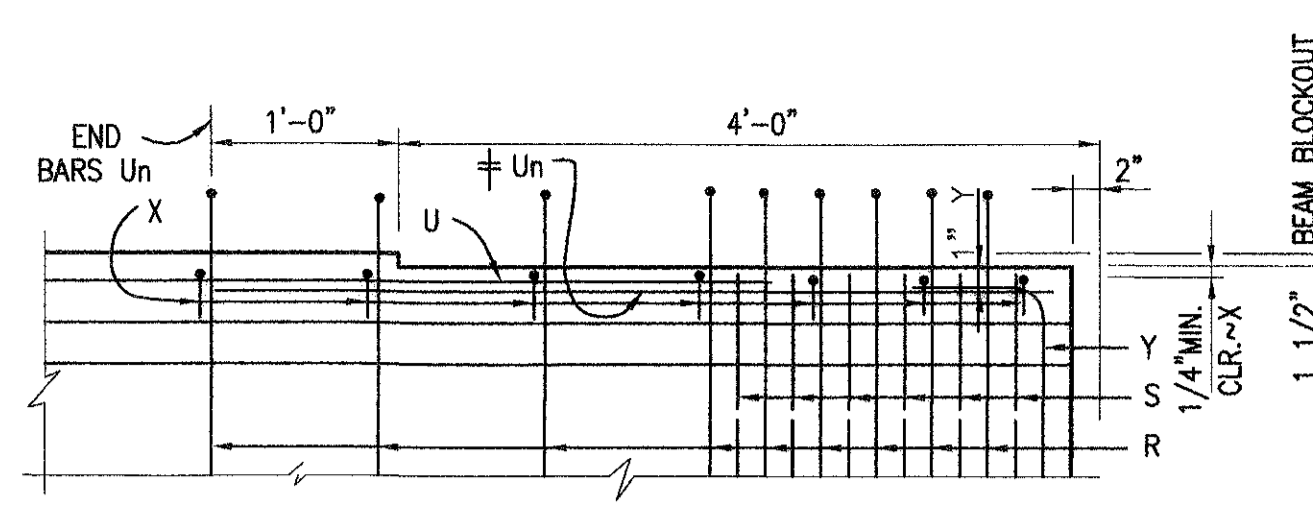

ELEVATION

ADD 2 ~ #5 BARS Un.

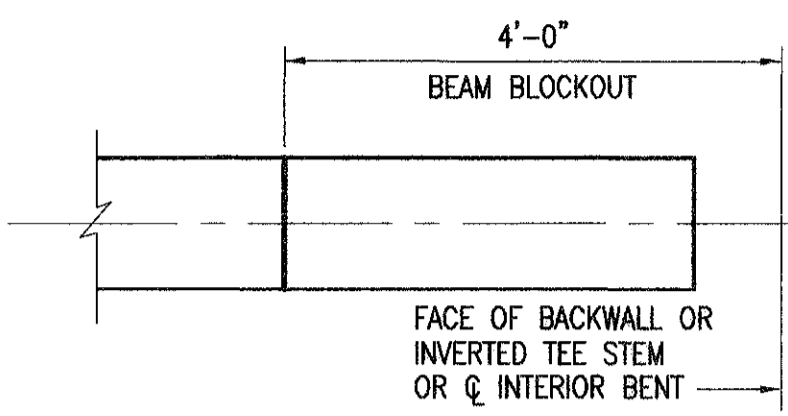


PLAN

NOTE: BEAM BLOCKOUT REQUIRED ONLY WHEN BEAM HAUNCH AT  $\bar{c}$  BRG. IS LESS THAN 2".

4 BLOCKOUT DETAIL FOR THICKENED SLAB END OPTION


55.501 NTS

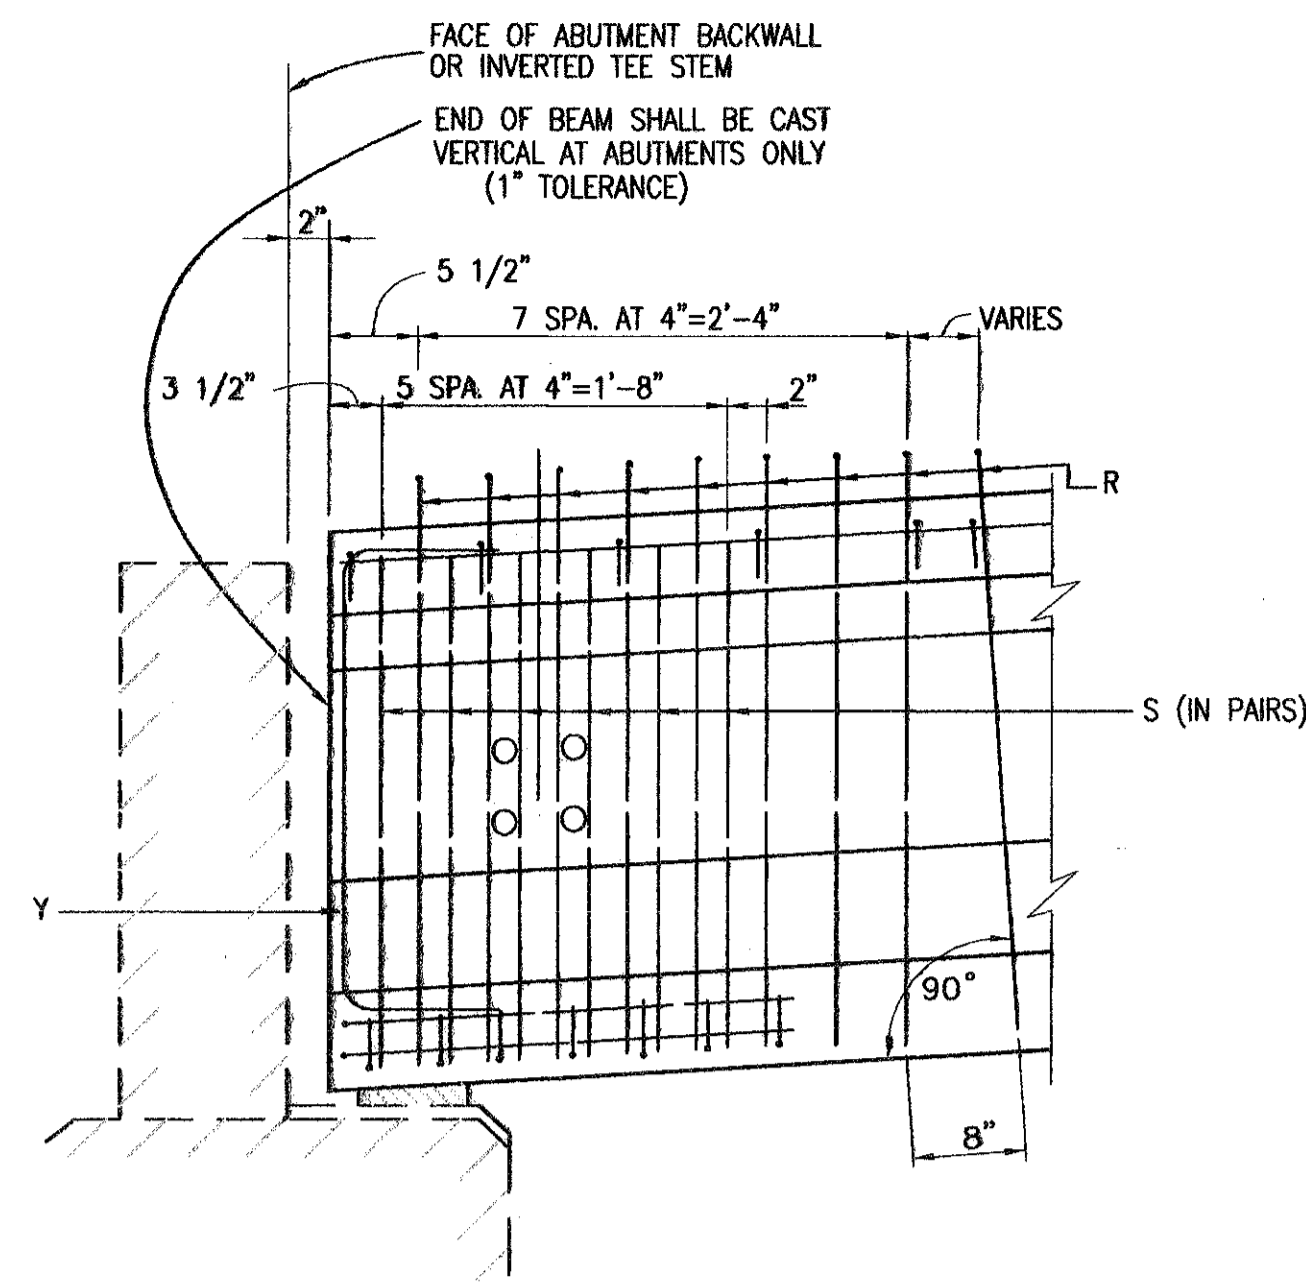


NOTE: REINFORCING PATTERNS SHOWN ABOVE ARE TO BE USED AS GUIDES IN DETERMINING THE REINFORCEMENT FOR THE ACTUAL BEAM TYPE AND SKEW ANGLE USED. IN GENERAL, THE DISTANCES BETWEEN CONSECUTIVE BARS R AND S SHALL BE 2". THIS SPACING MAY BE VARIED IN ORDER TO AVOID DIAPHRAGM HOLES, HOWEVER, A MINIMUM CROSS SECTIONAL AREA EQUIVALENT TO THAT OF BARS R AND S IN SQUARE BEAM END SHALL BE PROVIDED.

3 ELEVATION OF BEAM @ ABUTMENT OR INVERTED TEE BENT


55.501 NTS

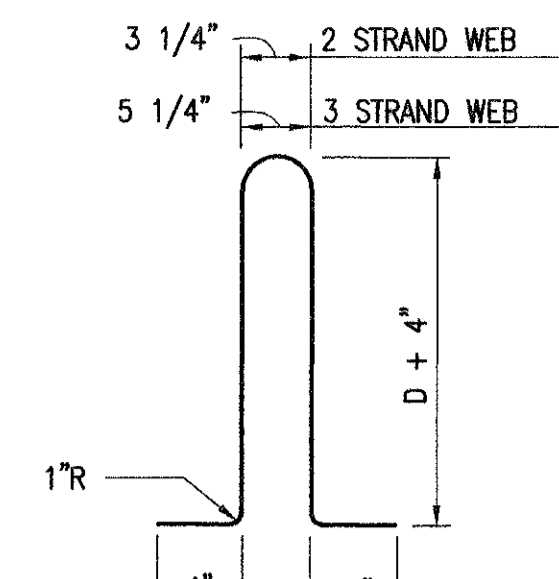


BARS R (#4)

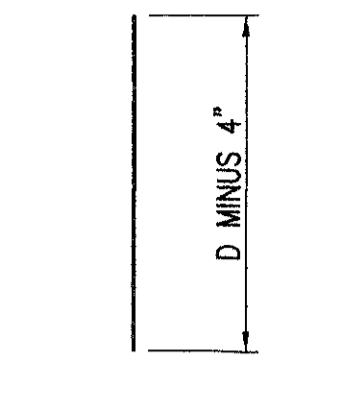


BARS S (#8)

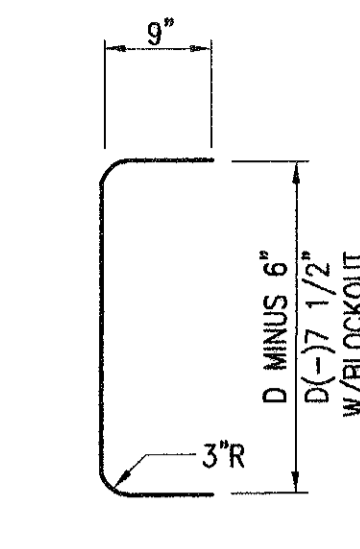

BARS Y (#6)

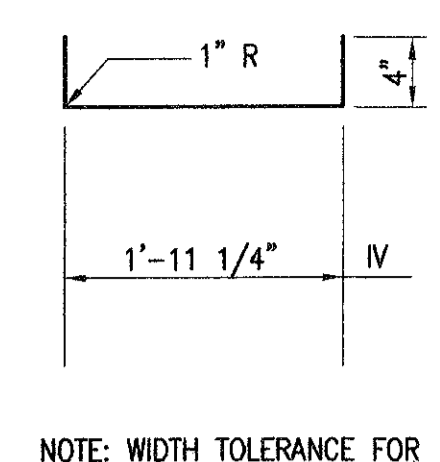


BARS V1 (#3)

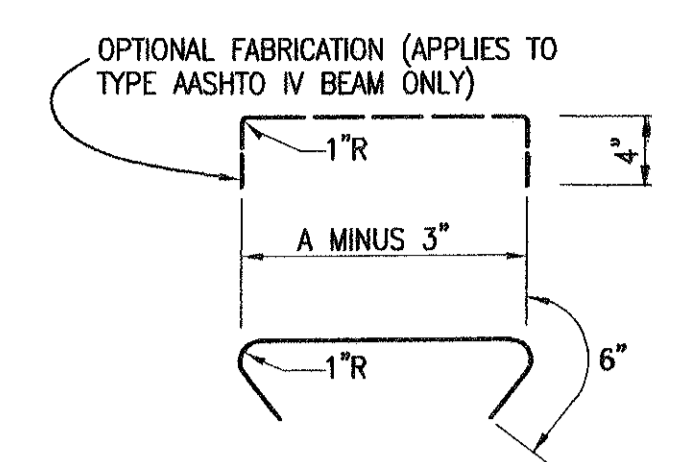


BARS X (#3)

NOTES:  
1) BARS V2 SHALL ENCLOSE SECOND STRAND LAYER FROM BOTTOM.  
2) MATCH WITH BARS V1.


BARS V2 (#4)

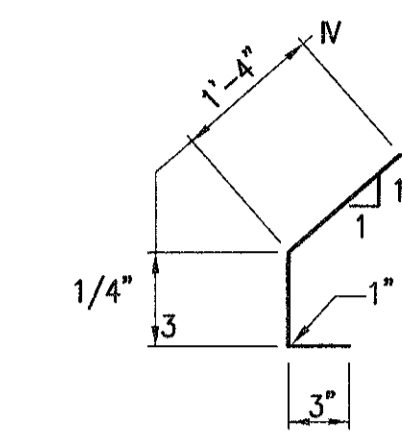

BARS U (#5)

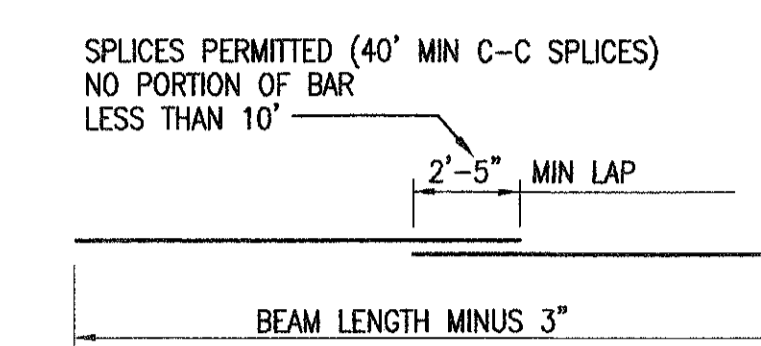


BARS W (#5)

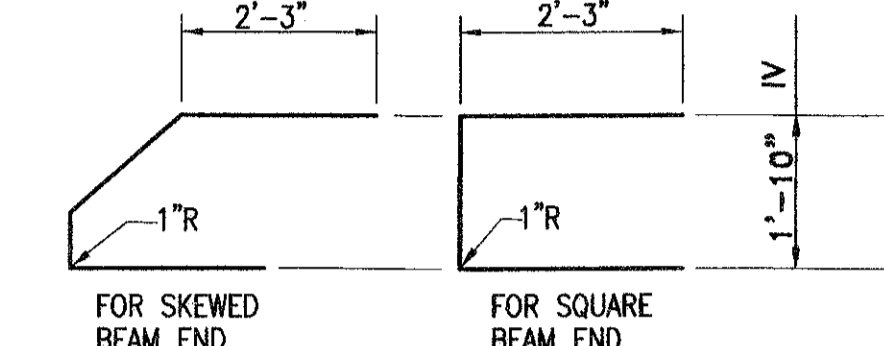

BARS W (#5)


1 ELEVATION OF BEAM @ ABUTMENT OR INVERTED TEE BENT

55.501 NTS

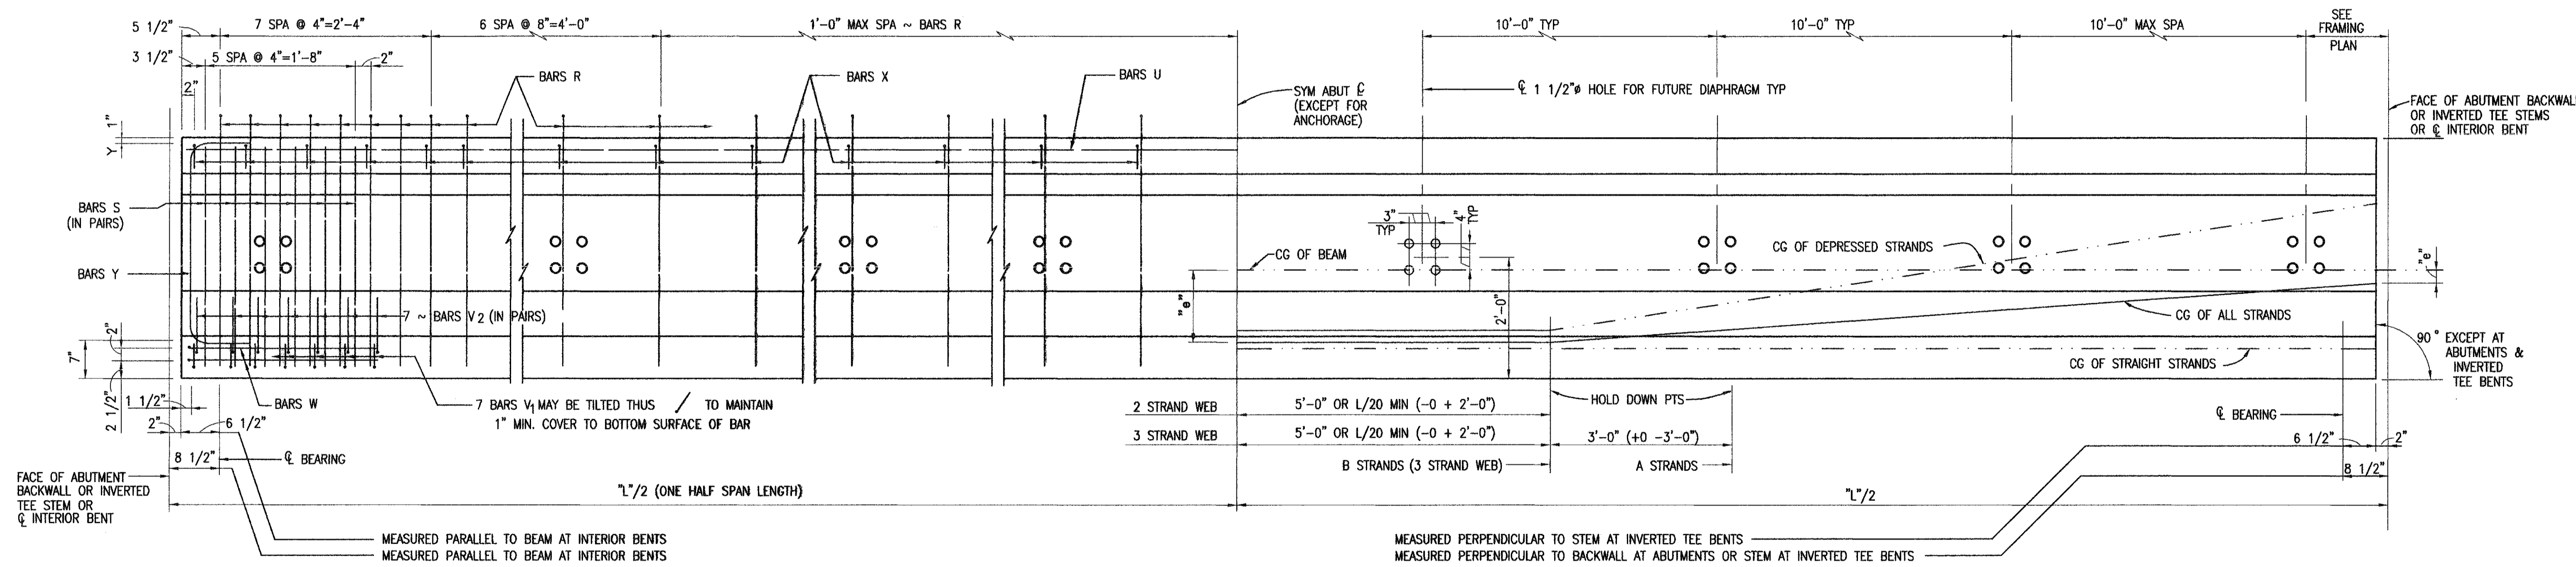

5 ELEVATION OF BEAM


55.501 NTS

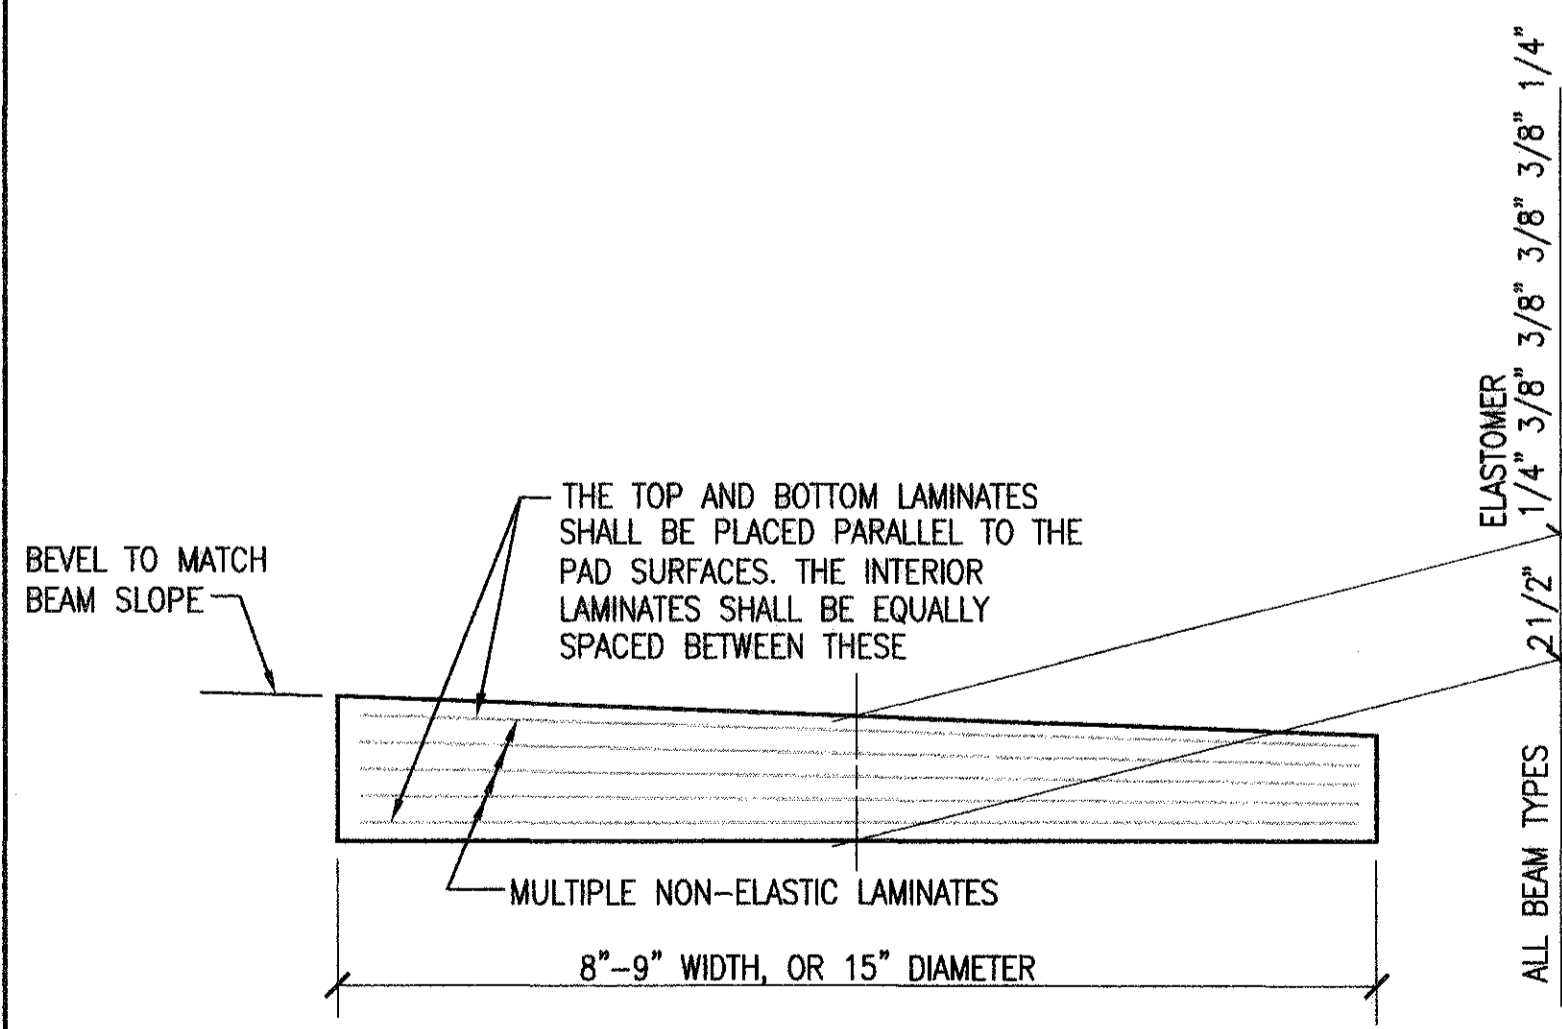

BASIC BEARINGS			
BM TYPE	SIZE, THICKNESS "T" & DESCRIPTION		
IV	9" x 22" x 2 1/2" LAMINATED		


12 LAMINATED BEARING DETAIL (50 DUROMETER)

55.501 NTS

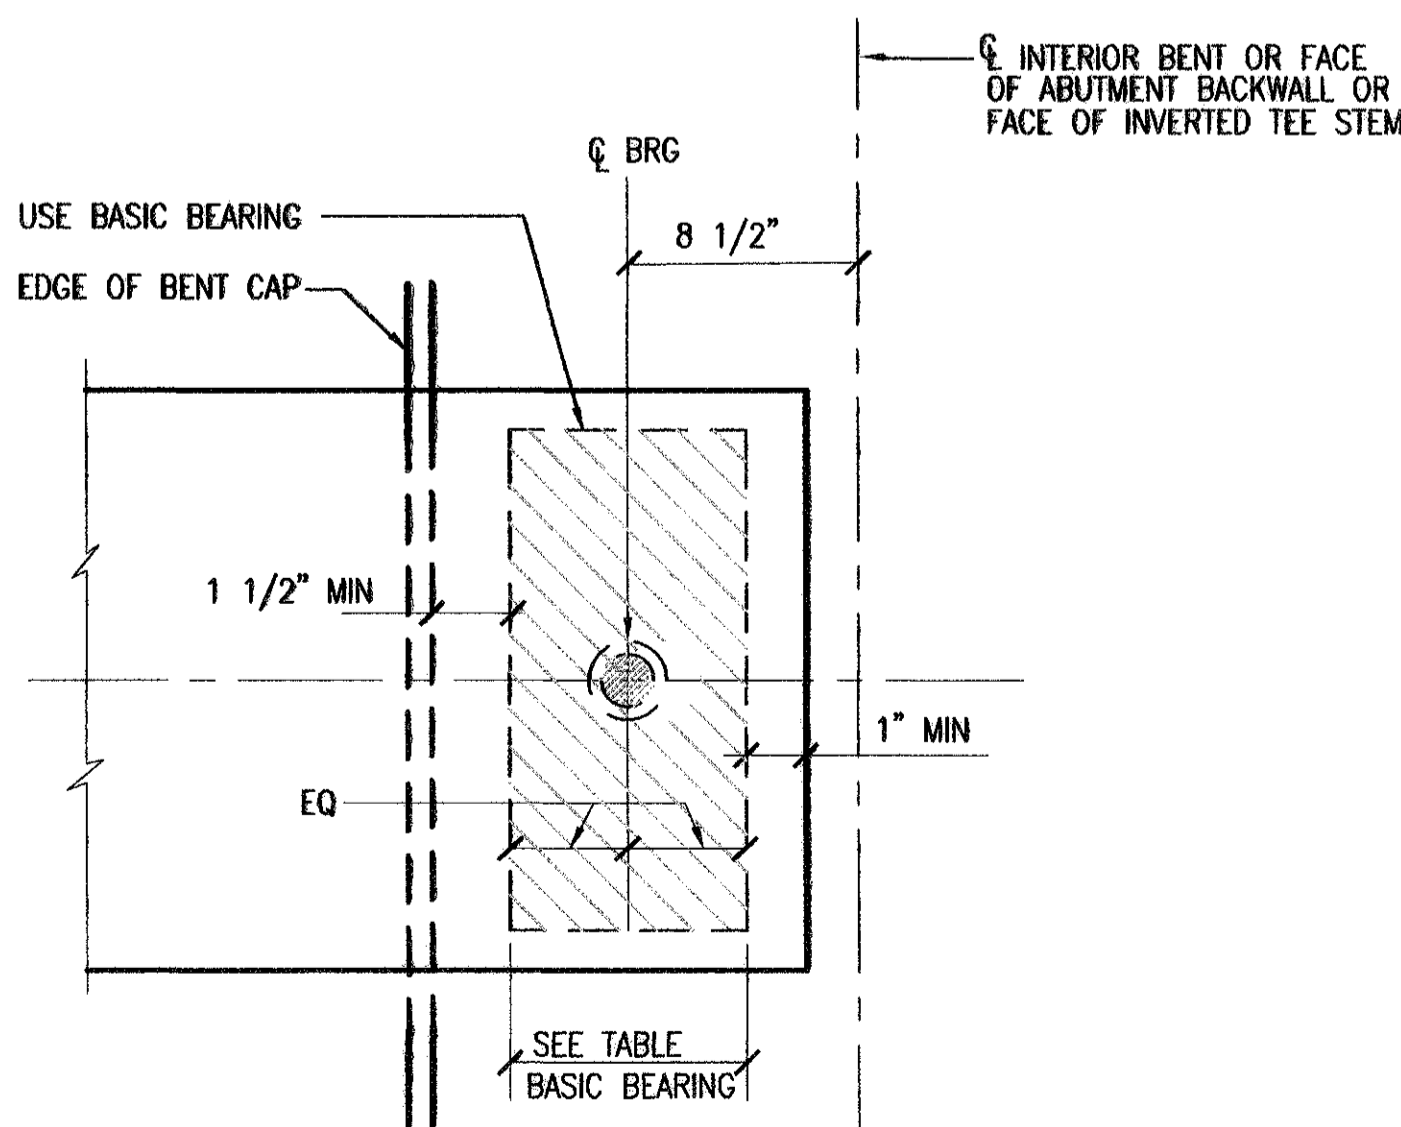


11 BASIC BEARING DETAIL

55.501 NTS

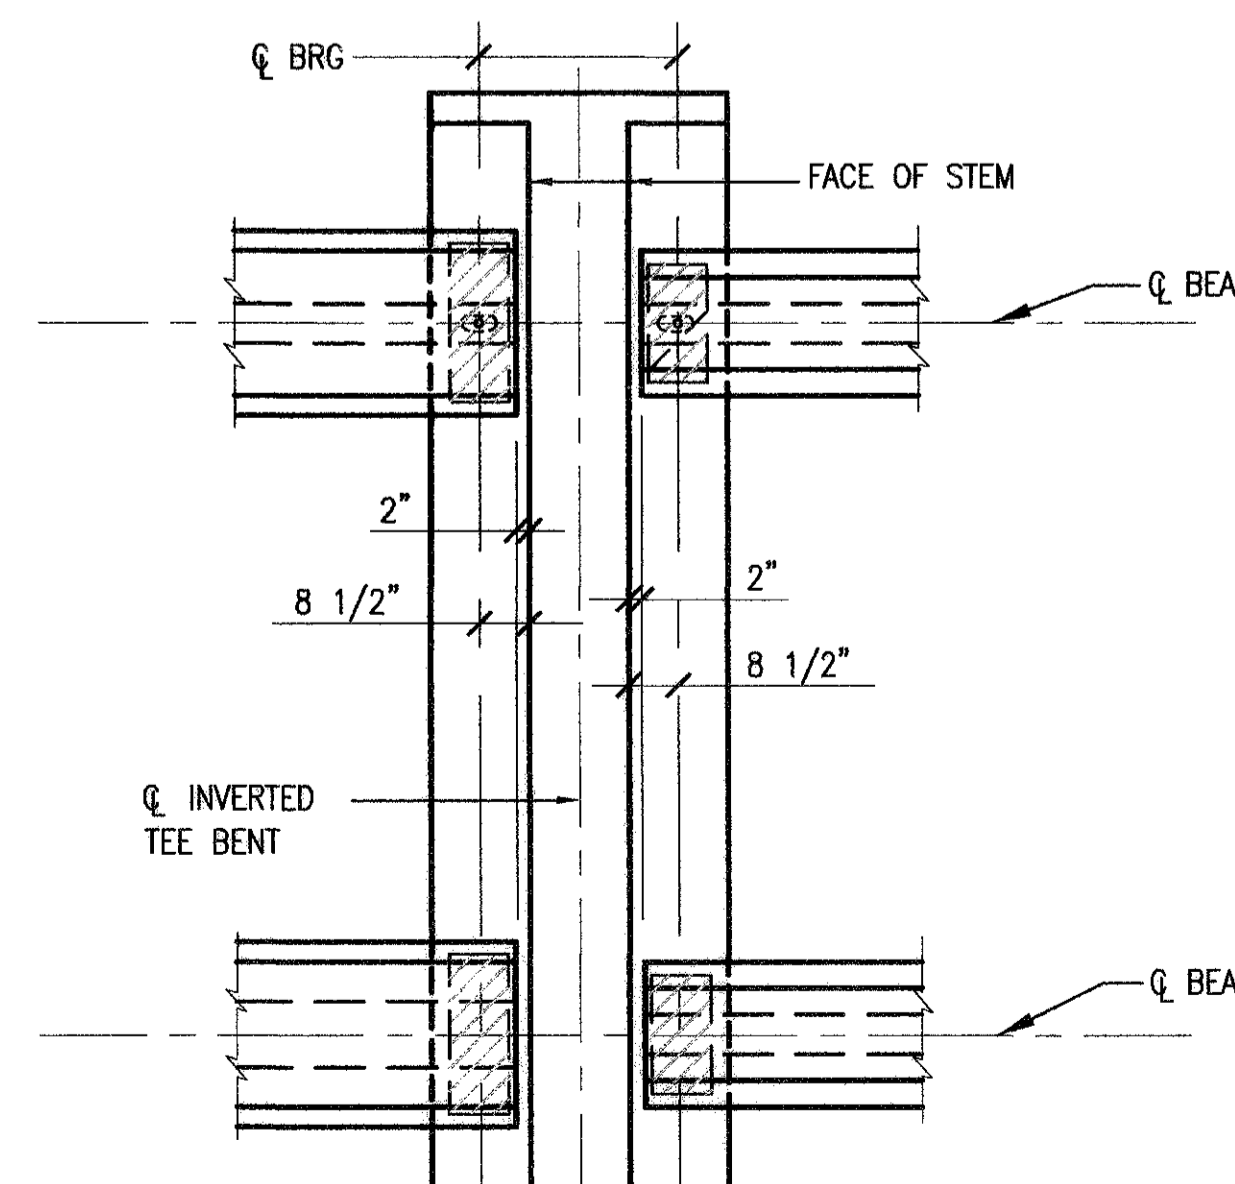

10 BEAM END DETAIL

55.501 NTS

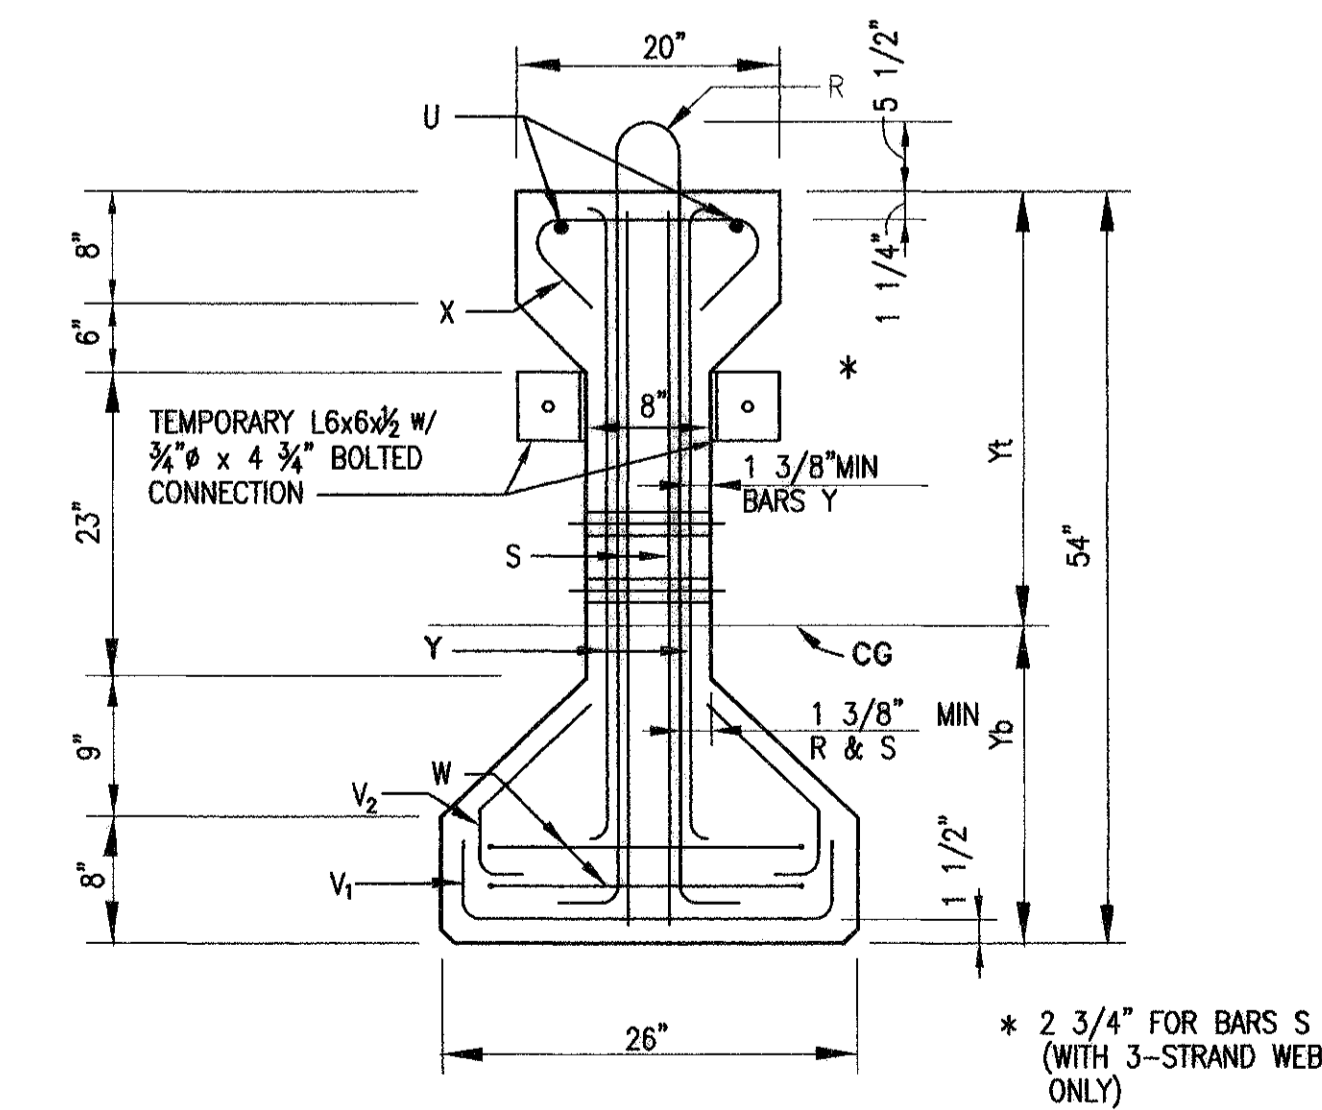

BEAM SECTION PROPERTY					
BEAM TYPE	Yt IN	Yb IN	AREA IN <sup>2</sup>	I IN <sup>4</sup>	WT P.L.F. LB
IV	29.25	24.75	788.4	260,403	821

9 AASHTO TYPE IV BEAM DETAIL

55.501 NTS

NOTES TO SHEET

- REFER TO SHEET S0.100 FOR STRUCTURAL GENERAL NOTES.
- BEAMS SHALL BE SEATED ON ELASTOMERIC BEARINGS OF THE DIMENSIONS SHOWN.
- BEARINGS SHALL BE FURNISHED WITH THEIR THICKNESS VARYING IN ONE DIRECTION DEPENDING ON THE SLOPE OF THE ERRECTED BEAM.
- CONSTANT THICKNESS BEARINGS MAY BE USED FOR MODERATE BEAM SLOPES IF THE VARIATION IS WITHIN THE ALLOWABLE DIMENSIONAL TOLERANCES GIVEN IN THE SPECIFICATIONS.
- COST OF FURNISHING AND INSTALLING ELASTOMERIC BEARING SHALL BE INCLUDED IN UNIT PRICE BID FOR "PRESTRESSED CONCRETE BEAMS".
- THE USE OF NATURAL RUBBER, FOR THE MANUFACTURE OF BEARING PADS, SHALL NOT BE PERMITTED.
- AN EQUAL AREA OF WELDED WIRE FABRIC MAY BE SUBSTITUTED FOR BARS R, V, S OR X IF APPROVED BY THE ENGINEER.
- BOTTOM CORNERS OF ALL BEAM FLANGES AND OUTSIDE CORNERS OF EXTERIOR BEAM ENDS SHALL BE CHAMFERED 3/4" OR ROUNDED TO A 3/4" RADIUS.
- THE USE OF DIAPHRAGM HOLES FOR LIFTING PURPOSES WILL NOT BE PERMITTED.
- NO ANCHOR HOLES OR SLOTTED HOLES ARE REQUIRED AT BOTH ENDS OF BEAMS.

**HOUSTON AIRPORT SYSTEM**  
GEORGE BUSH  
INTERCONTINENTAL AIRPORT  
HOUSTON TEXAS

**HUIT-ZOLLARS**  
Engineering / Architecture  
1500 Katy Avenue, Suite 200, Houston, TX 77077  
Phone (281) 468-0000 Fax (281) 468-0020


**CHARLES E. TERRY, INC.**  
Consulting Engineers  
2801 Oaktree Avenue  
Houston, Texas 77058  
(281) 240-2400 Fax (281) 240-2404

REVISIONS			
NO.	DESCRIPTION	DATE	BY
1	ISSUED FOR BID	10/19/01	

INTERNATIONAL • SERVICES • EXPANSION • PROGRAM

**APM STATION & PLATFORM**  
PRESTRESSED CONCRETE BEAM  
STANDARD DETAILS

PROJECT MGR: GRW  
DESIGNER: JUC  
DRAWN BY: KLV  
CHECKED BY: MMR  
DRAWING STANDARD:  
ISEP 07.20.2000  
SCALE: AS NOTED  
DATE: 09/14/01

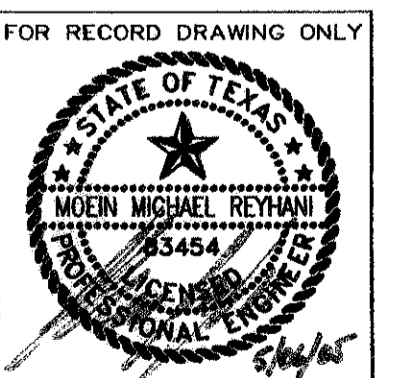

APPROVED BY: DATE:  
DIRECTOR  
HOUSTON AIRPORT SYSTEM


PROJECT NO. 02-2025-01  
C.I.P. NO. A-0354  
H.A.S. NO. 536C  
SHEET NO.

**RECORD DRAWINGS DO NOT MODIFY**


DATE: MAY 6, 2005  
HUITZ-ZOLLARS, INC.

NOTE: INFORMATION USED TO DEVELOP THESE DOCUMENTS WAS TAKEN FROM RECORD OF THE WORK DRAWINGS PREPARED BY THE CONSTRUCTION CONTRACTOR. CLARK/MISSION A JOINT VENTURE. THE INFORMATION PROVIDED BY THE CONTRACTOR WAS NOT VERIFIED BY THE DESIGN FIRM NAMED ABOVE.




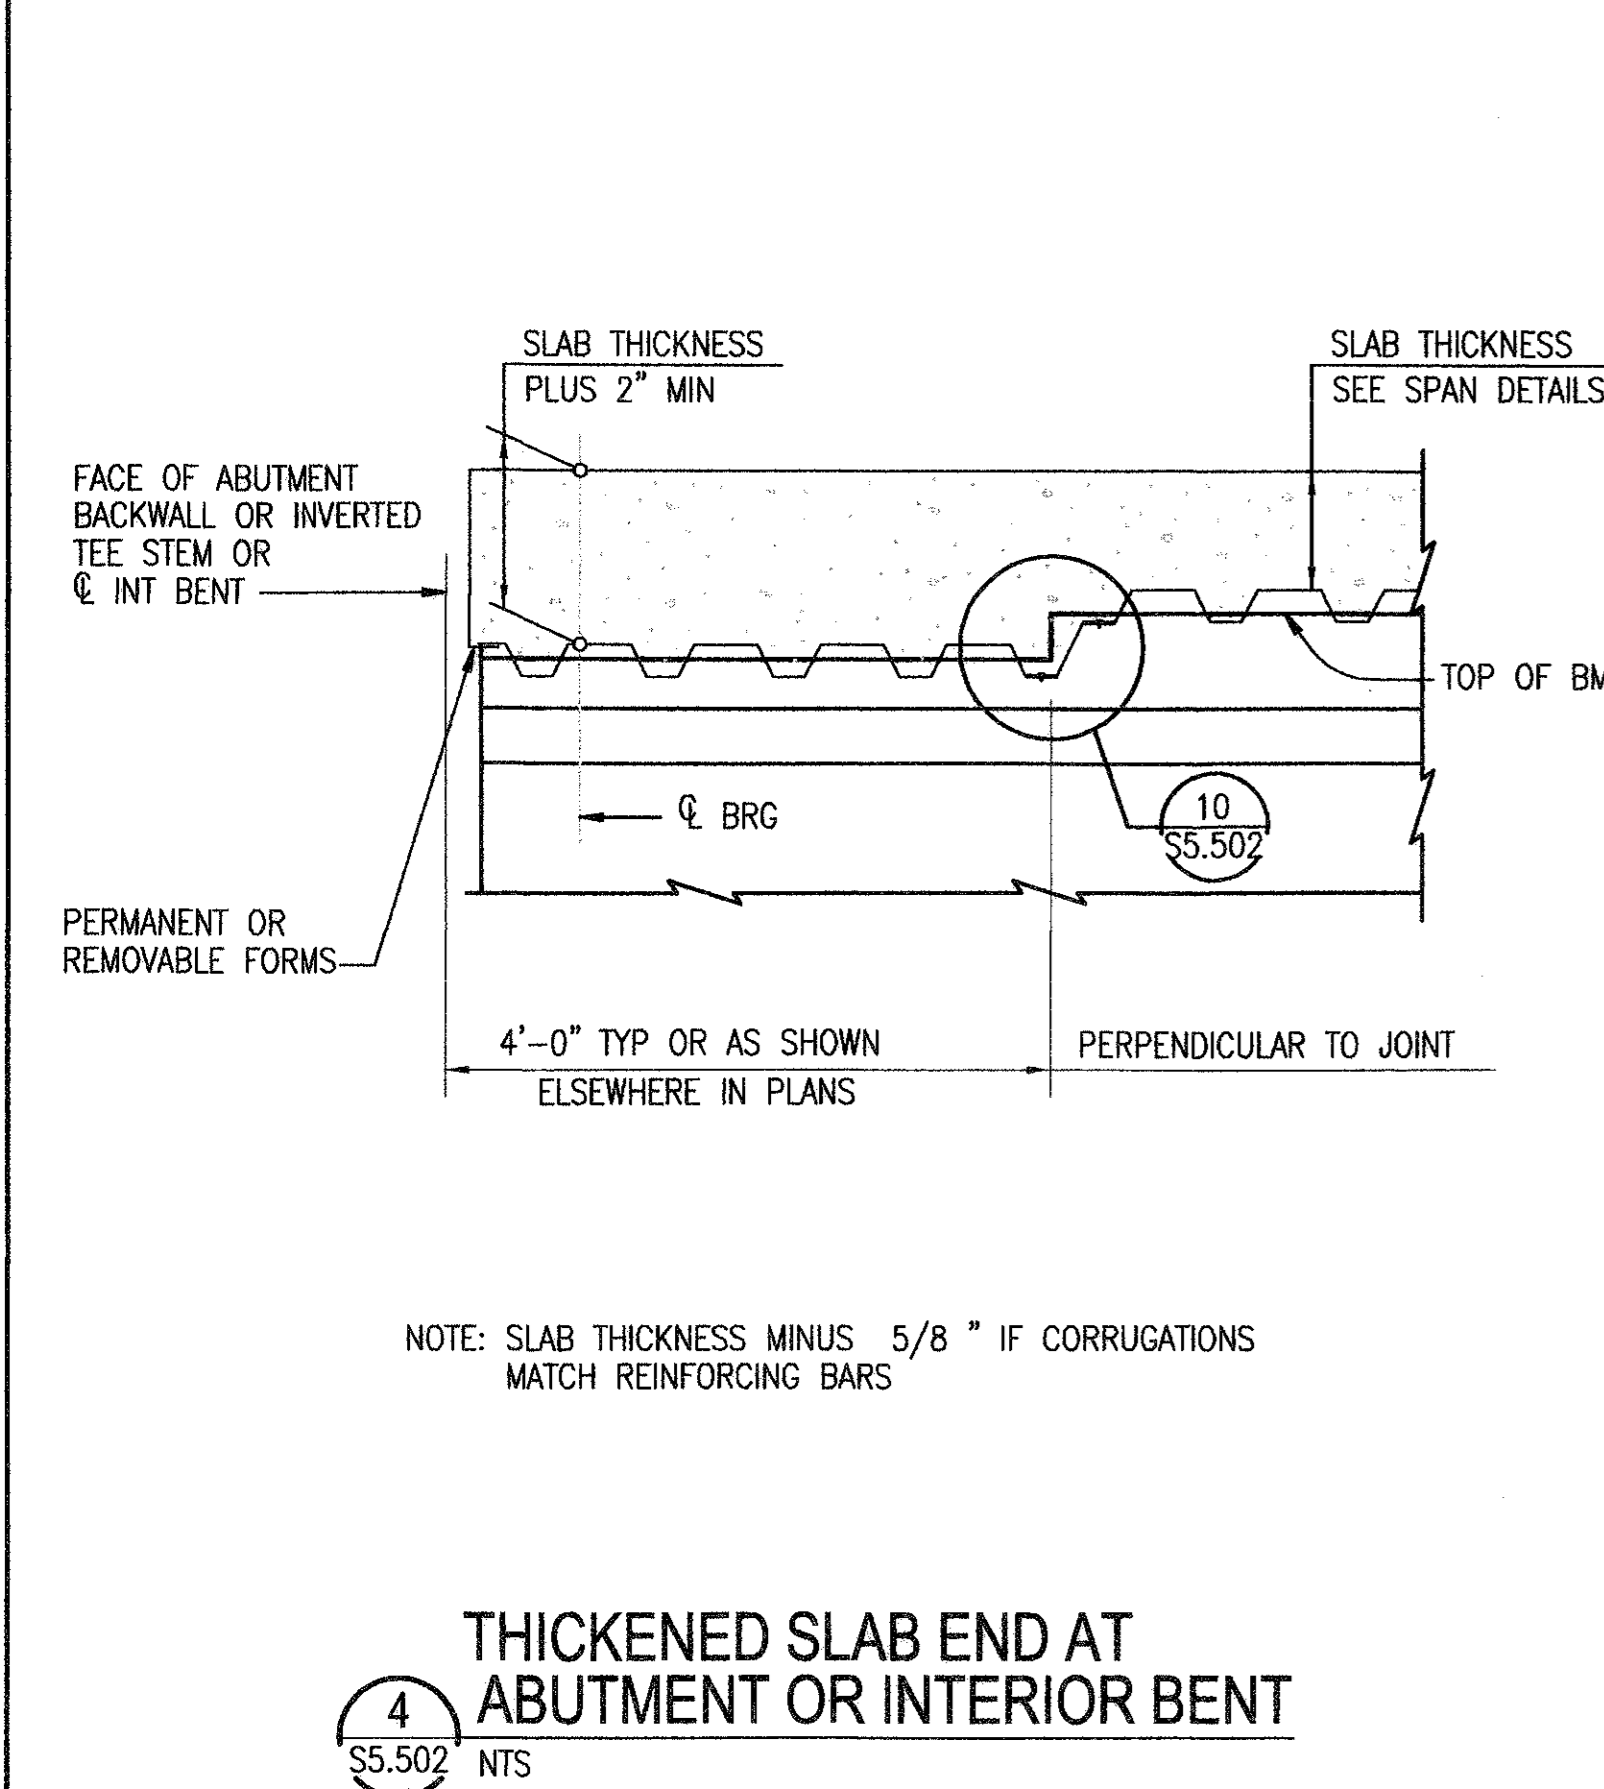


**4** THICKENED SLAB END AT ABUTMENT OR INTERIOR BENT  
S5.502 NTS

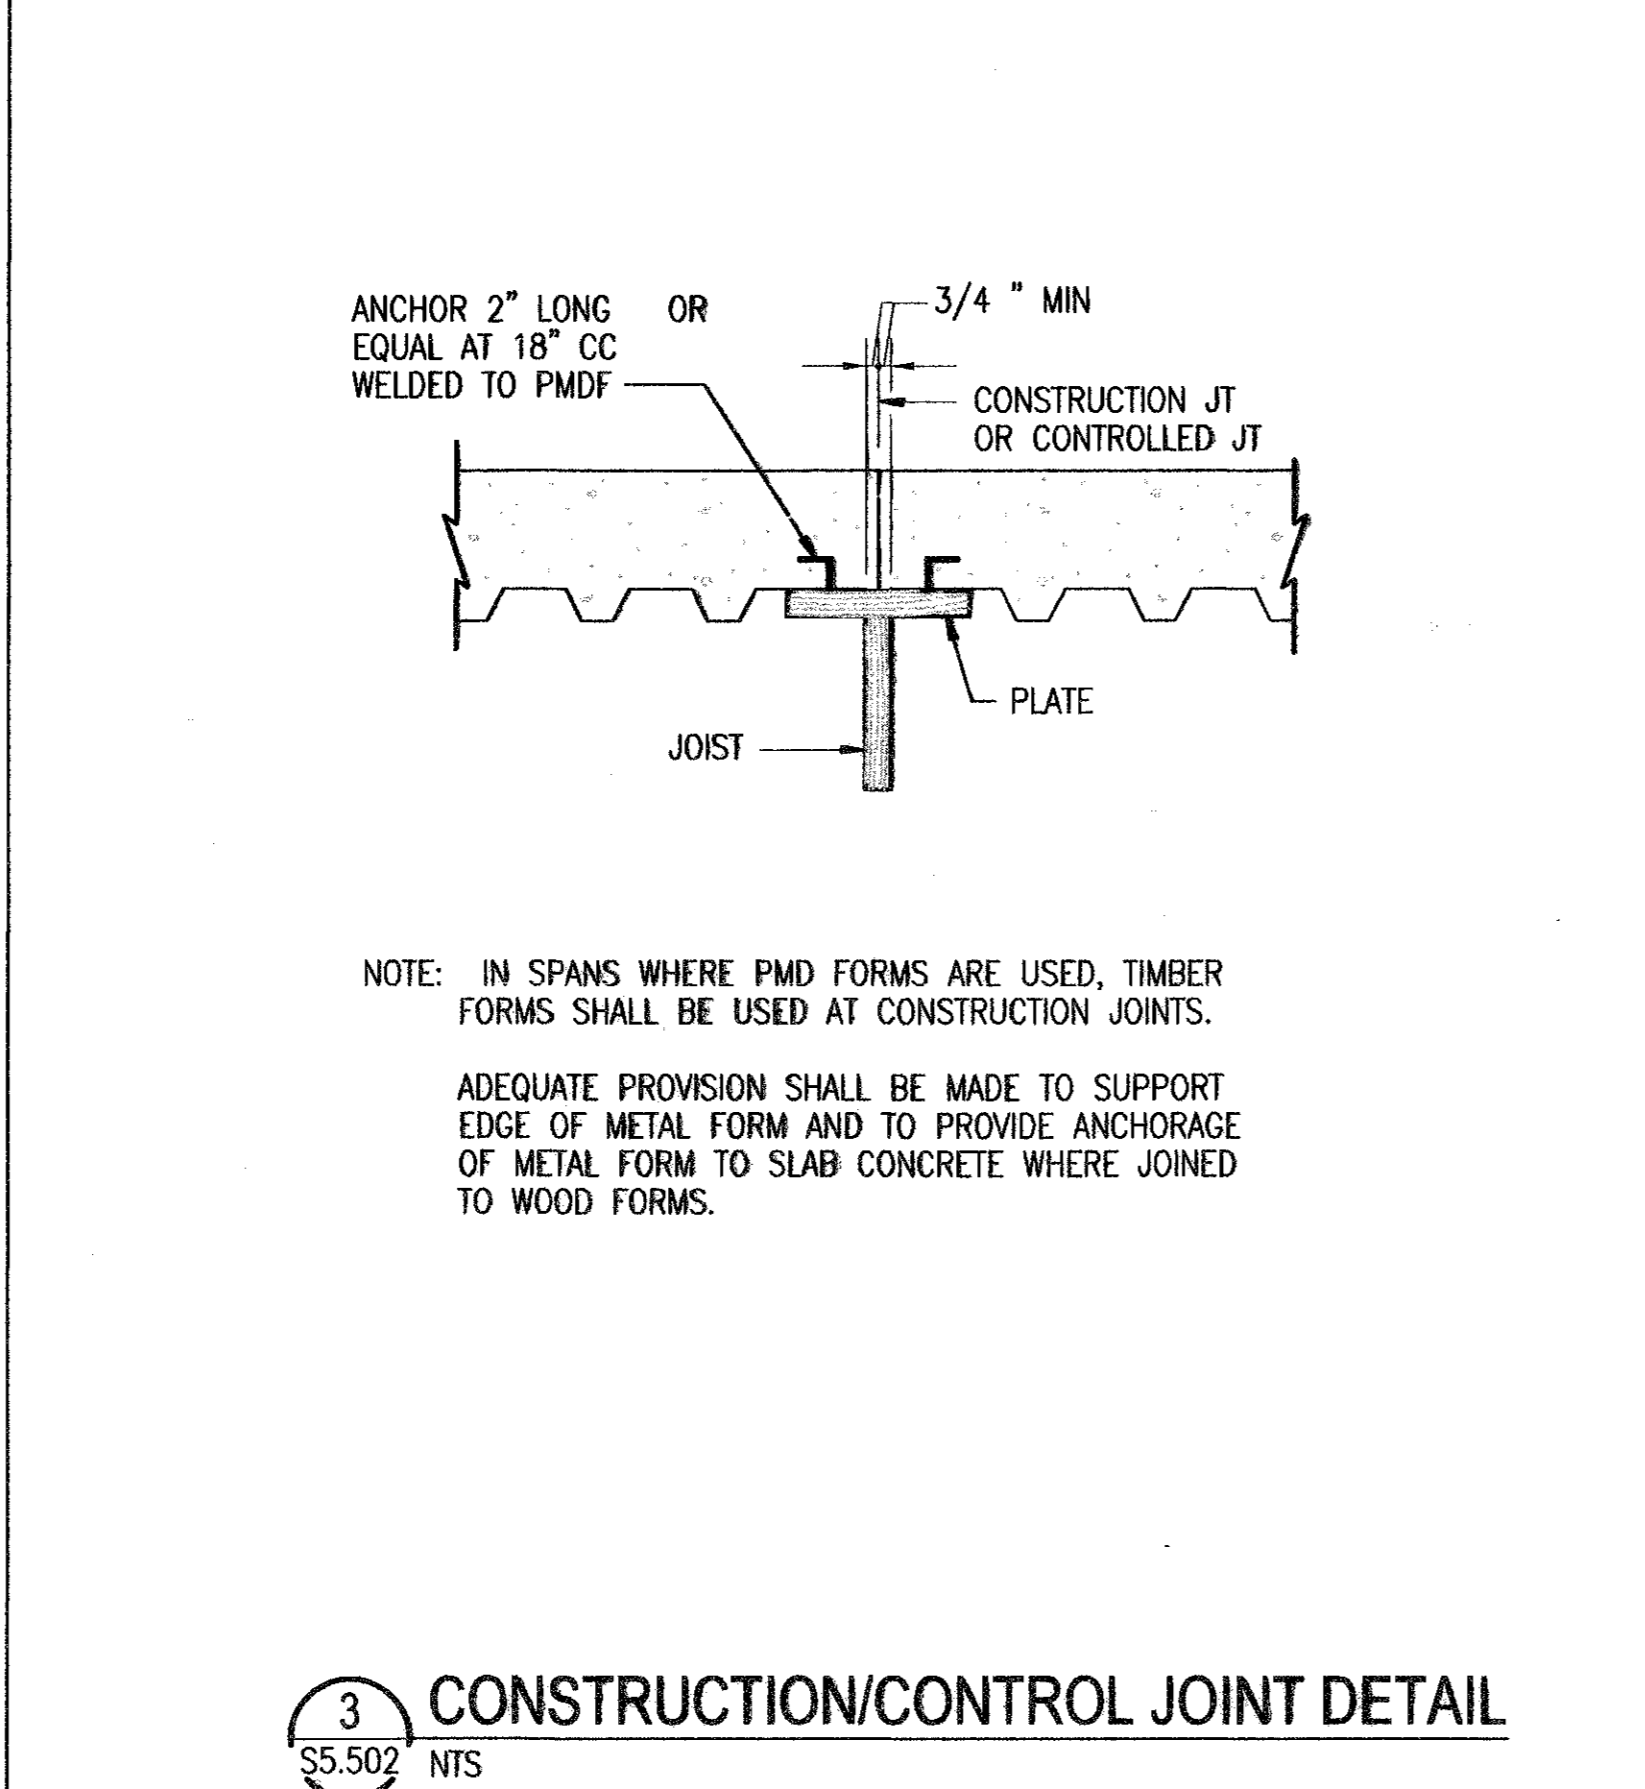


**3** CONSTRUCTION/CONTROL JOINT DETAIL  
S5.502 NTS

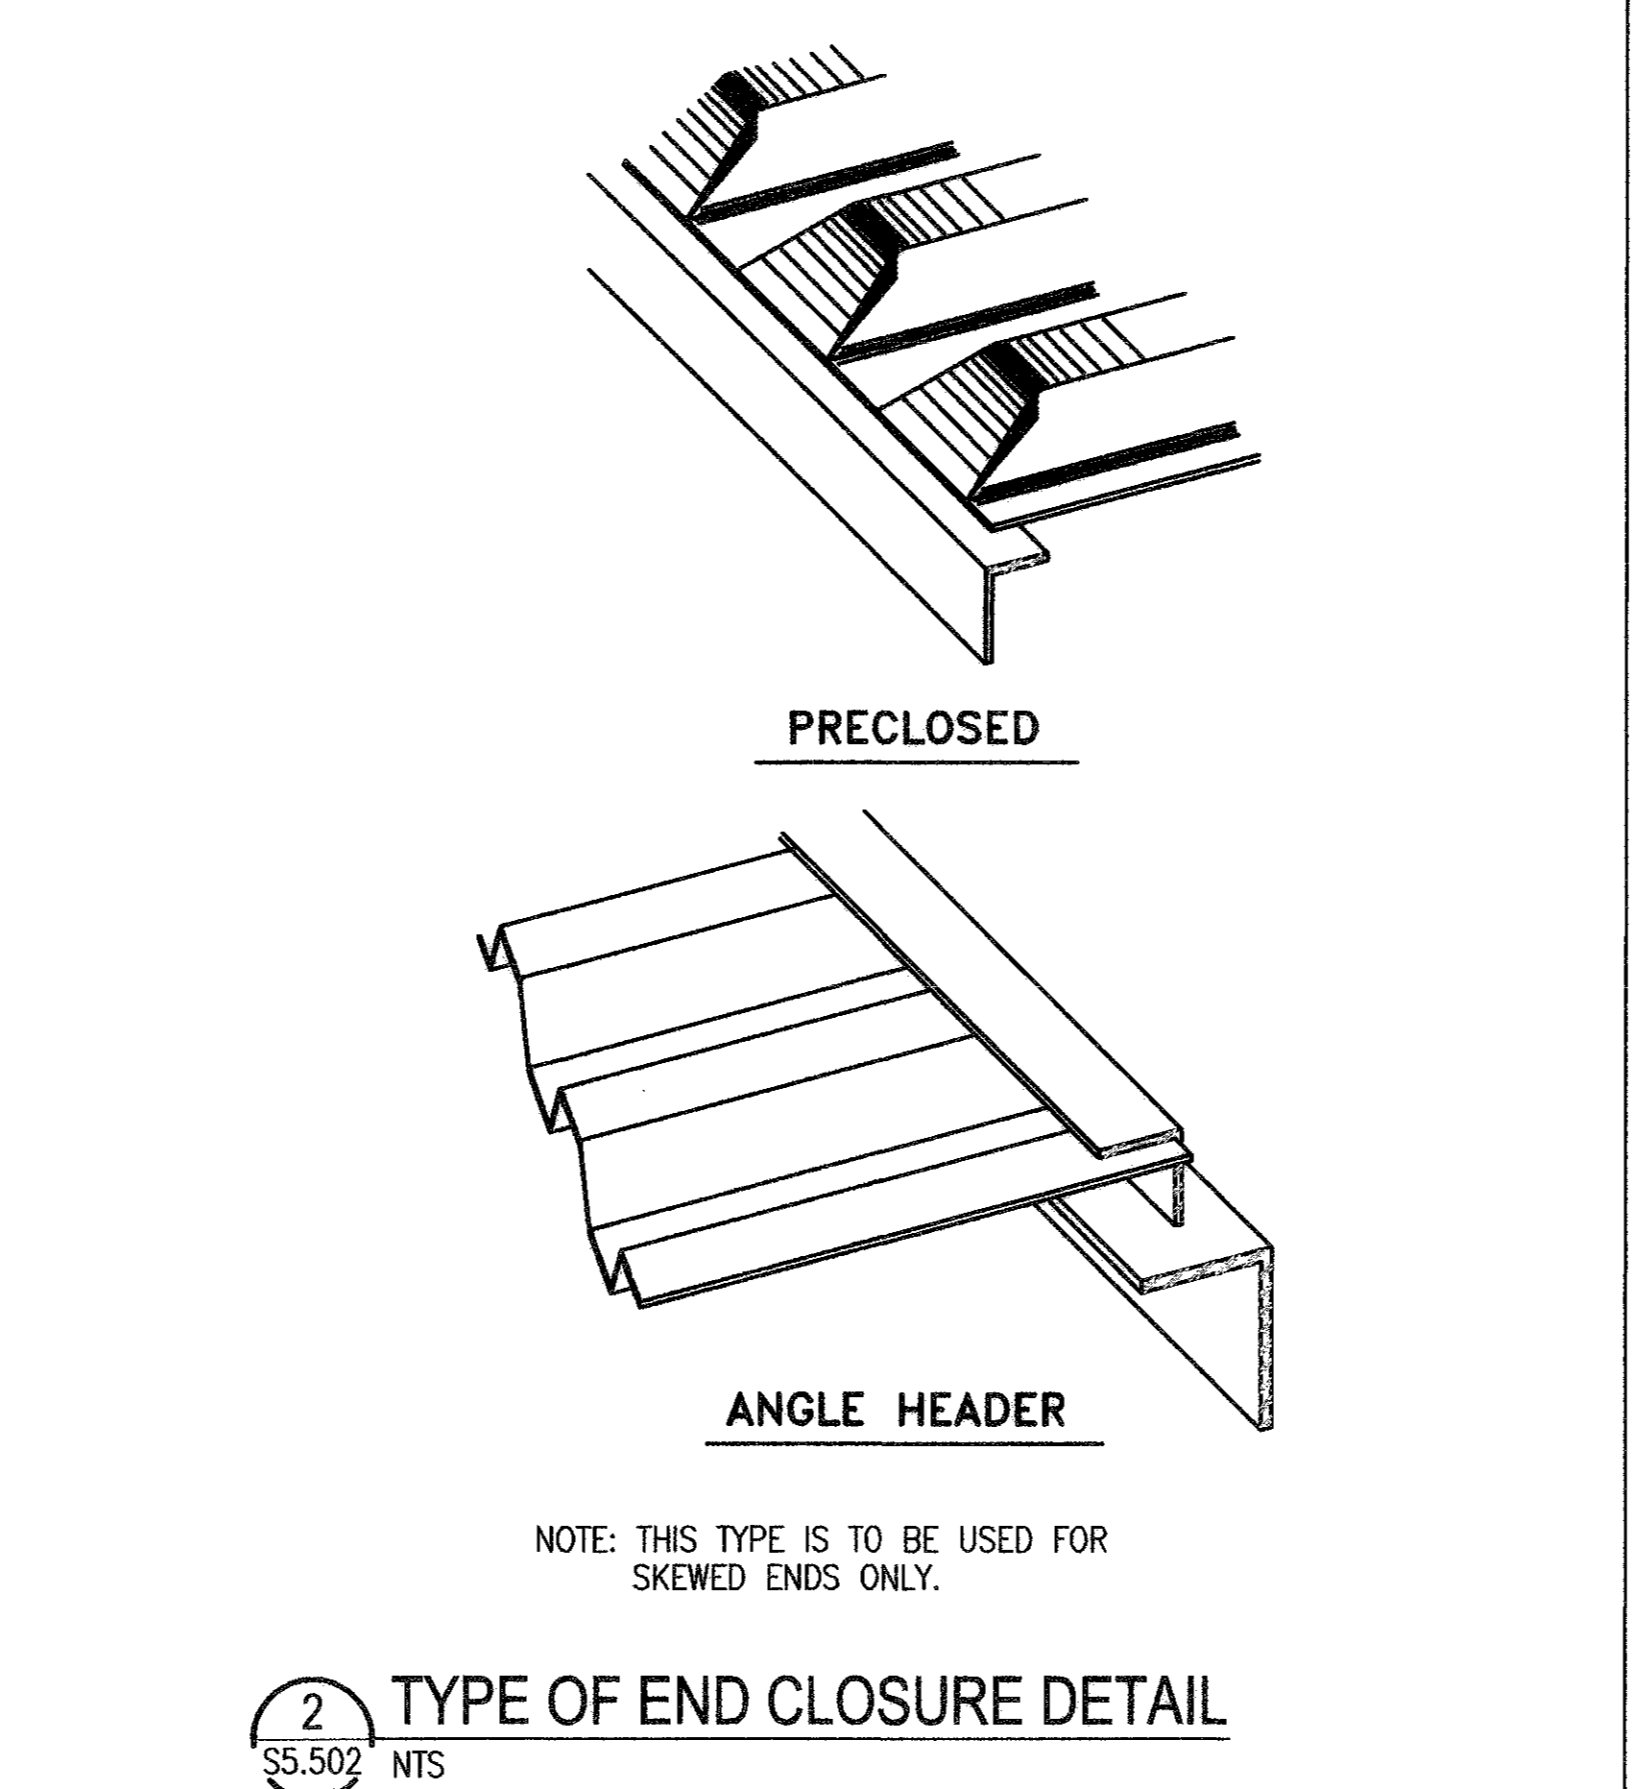


**2** TYPE OF END CLOSURE DETAIL  
S5.502 NTS

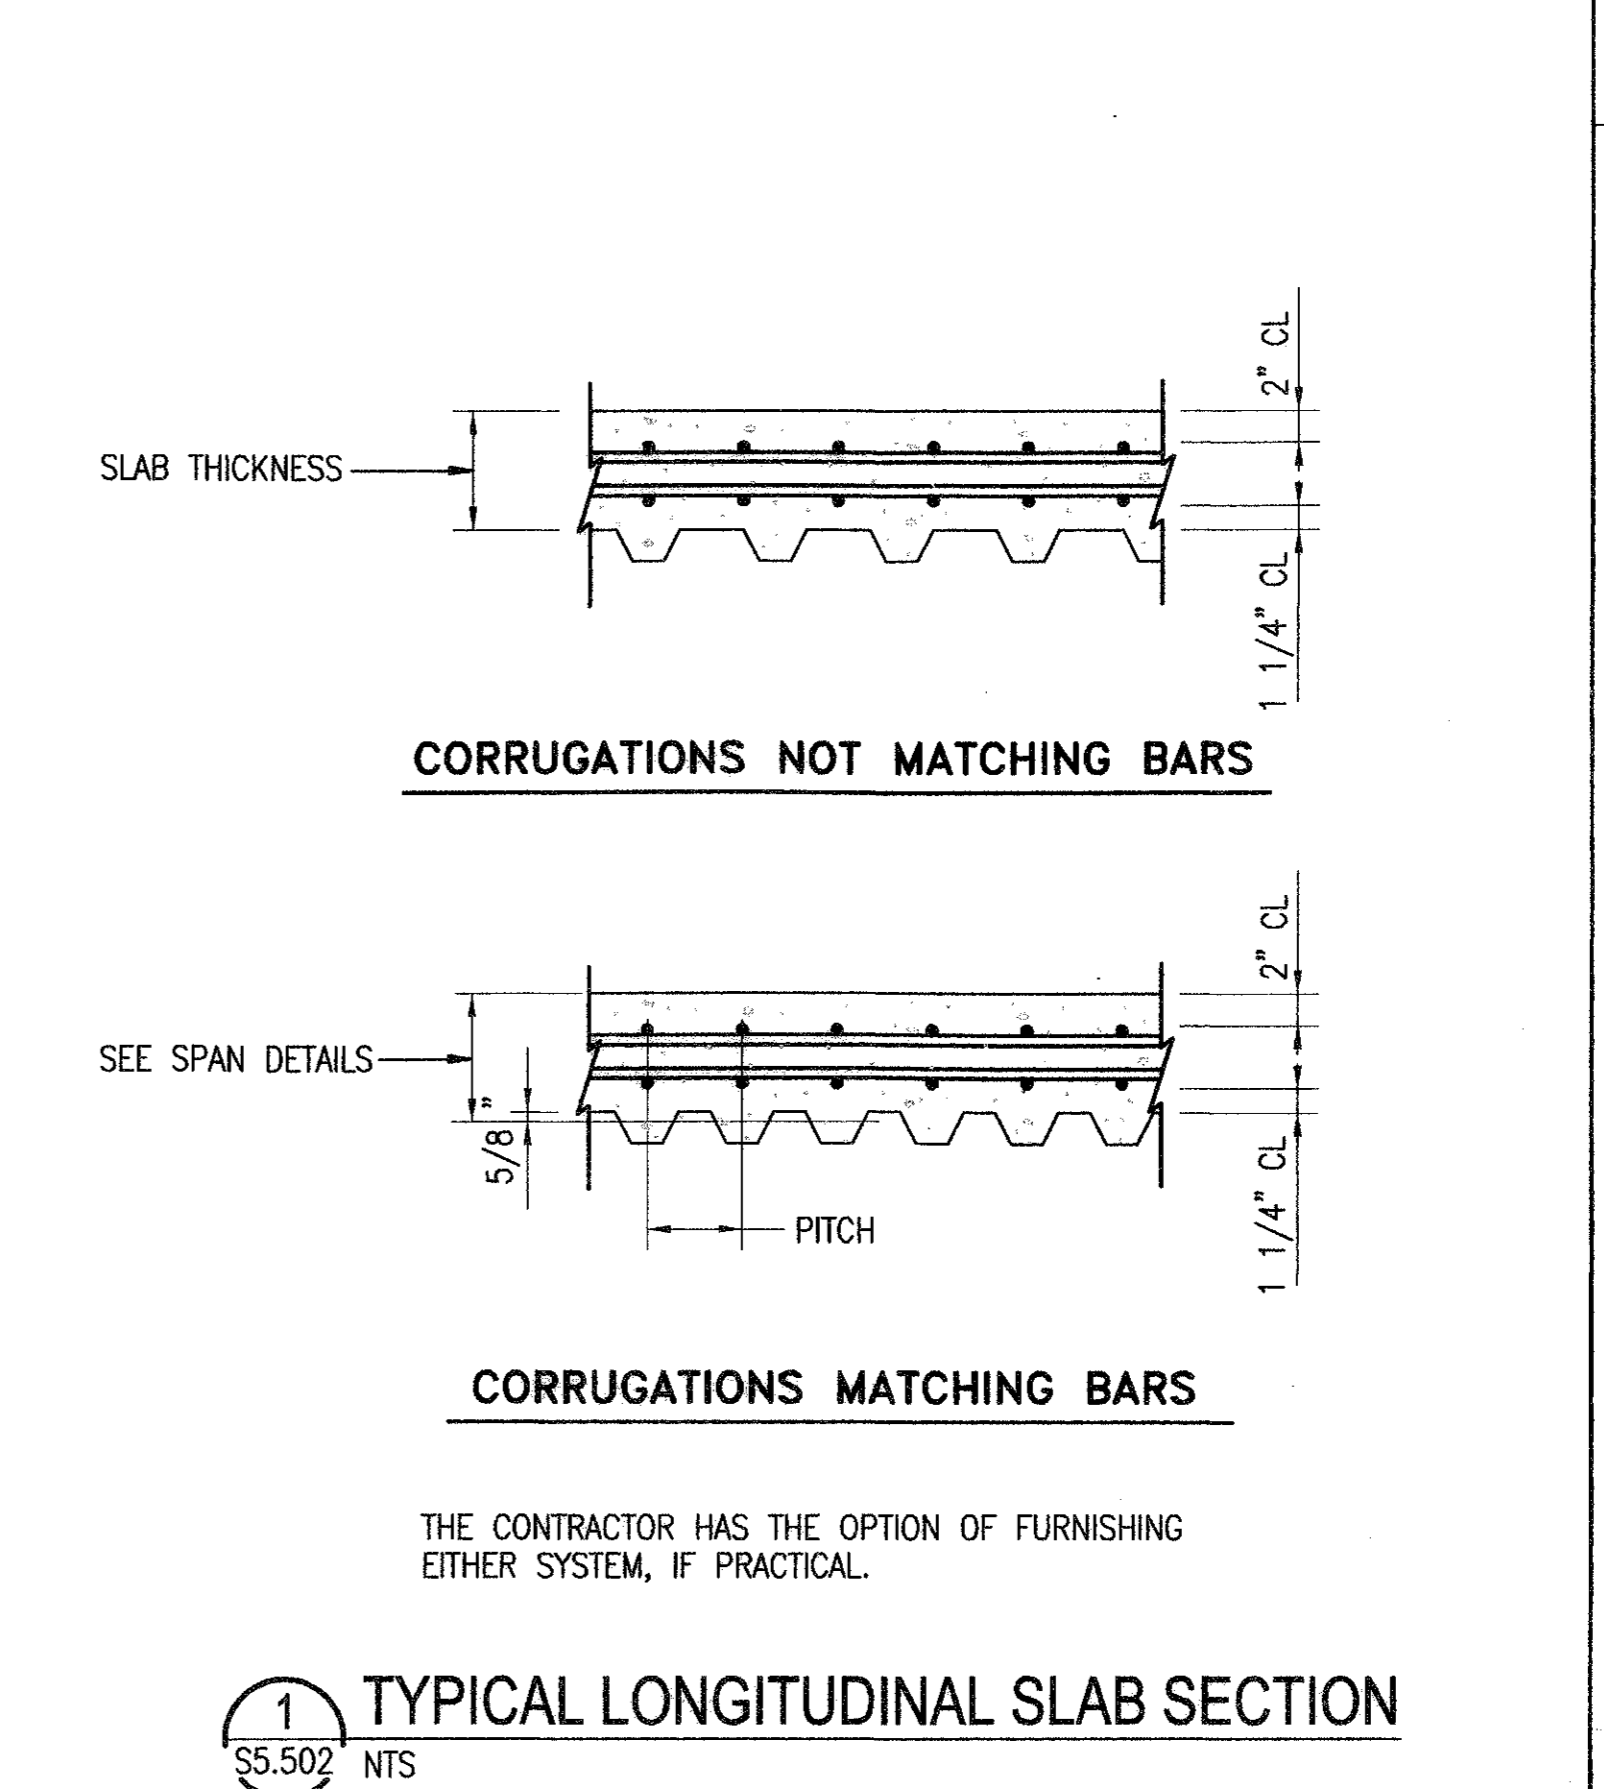


**1** TYPICAL LONGITUDINAL SLAB SECTION  
S5.502 NTS

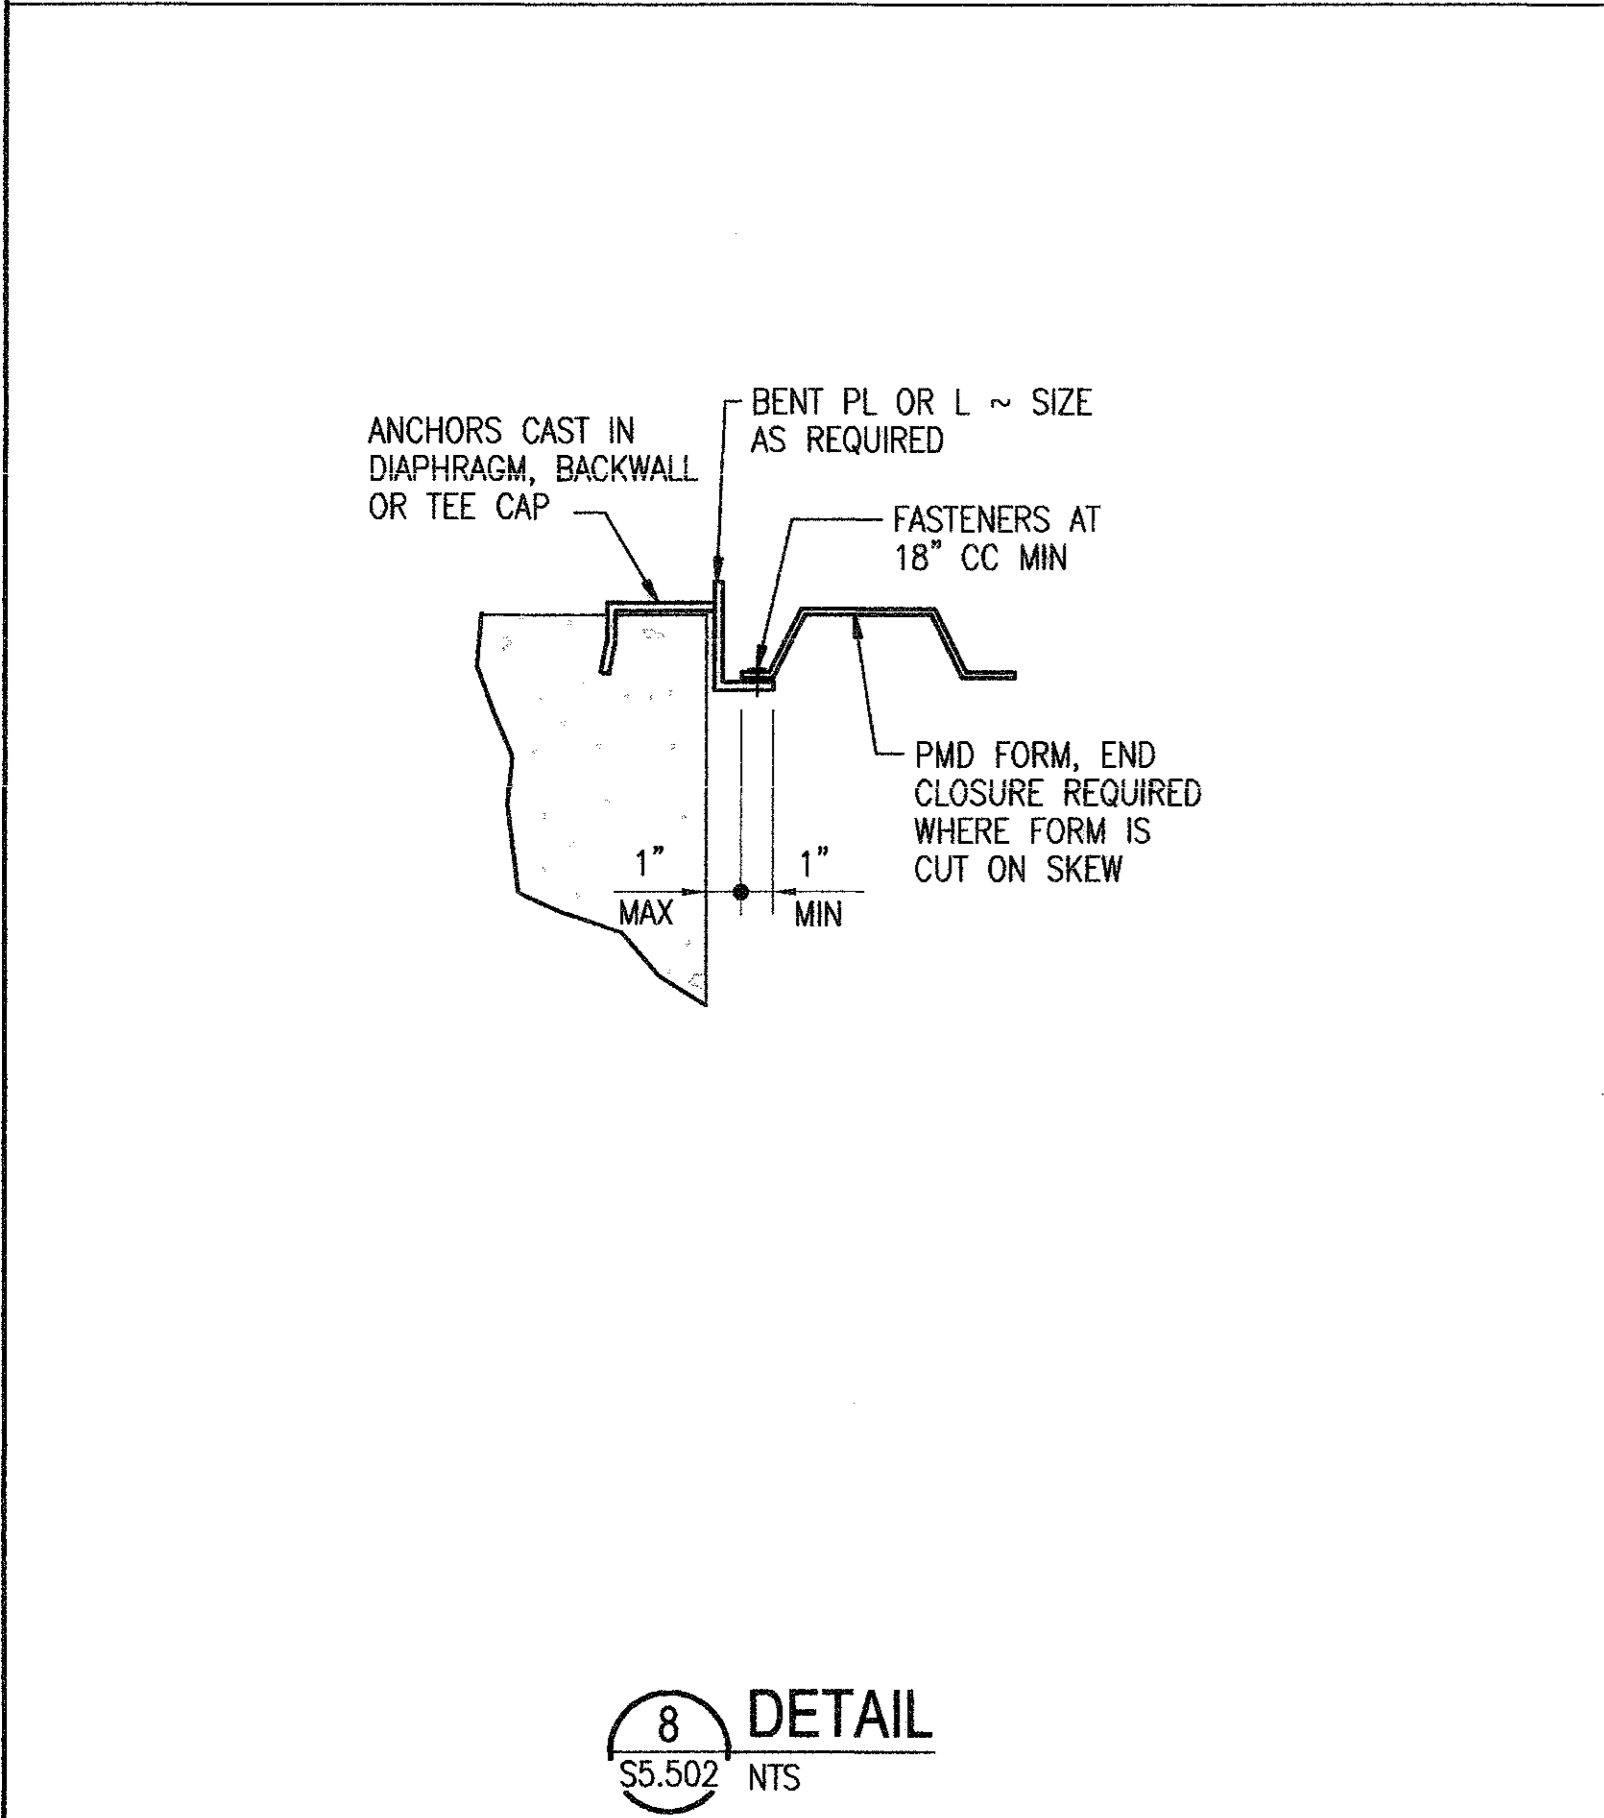


**8** DETAIL  
S5.502 NTS

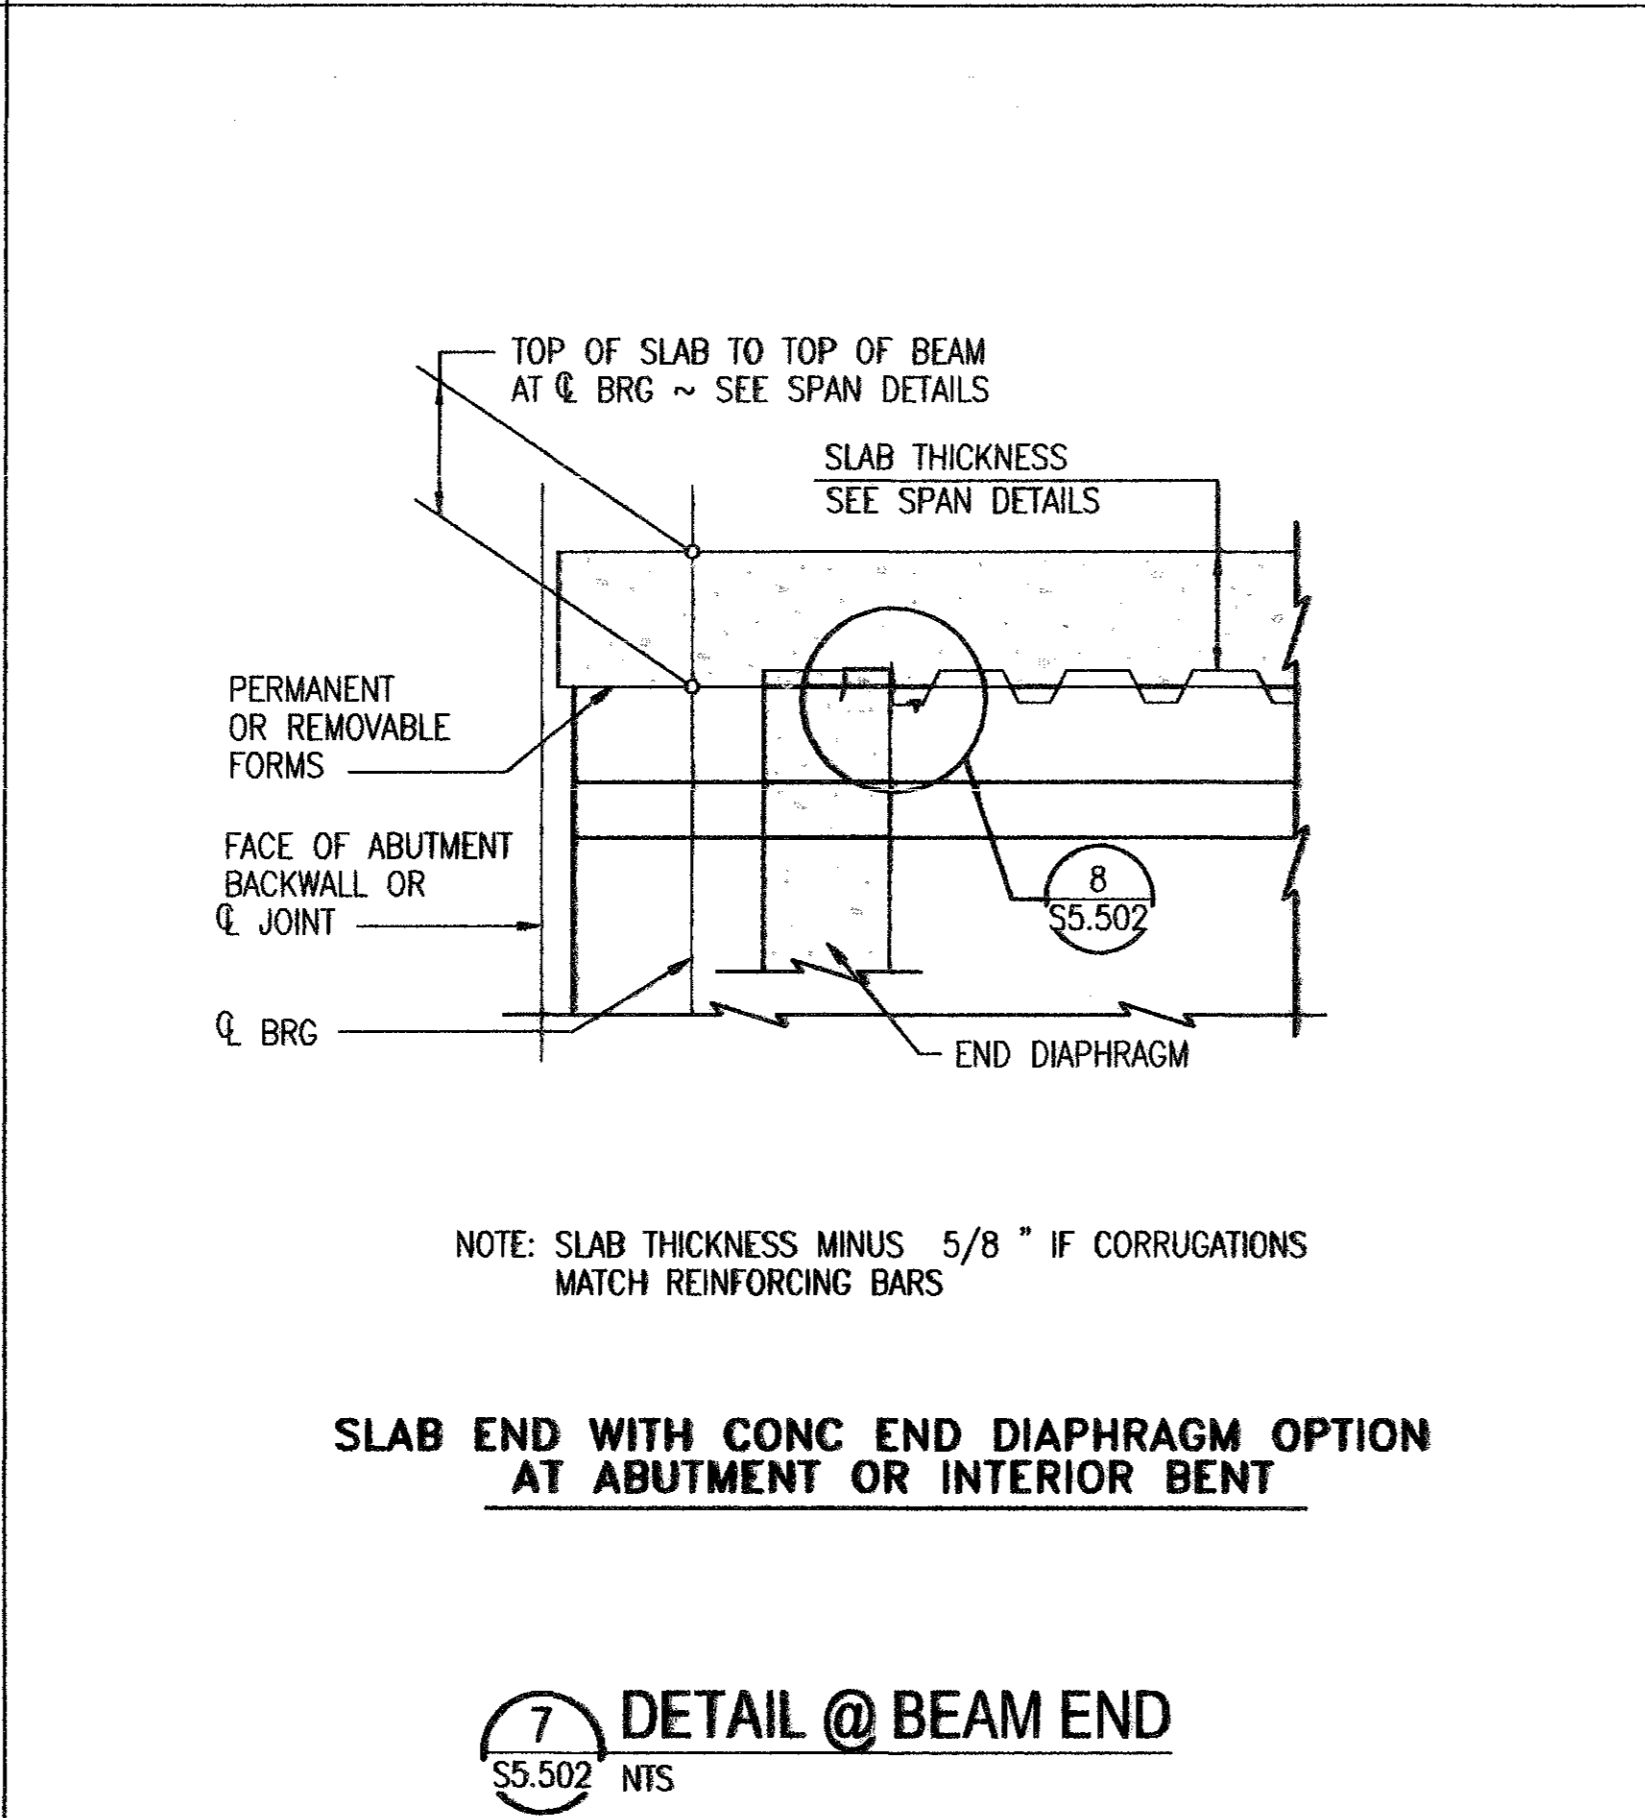


**7** DETAIL @ BEAM END  
S5.502 NTS

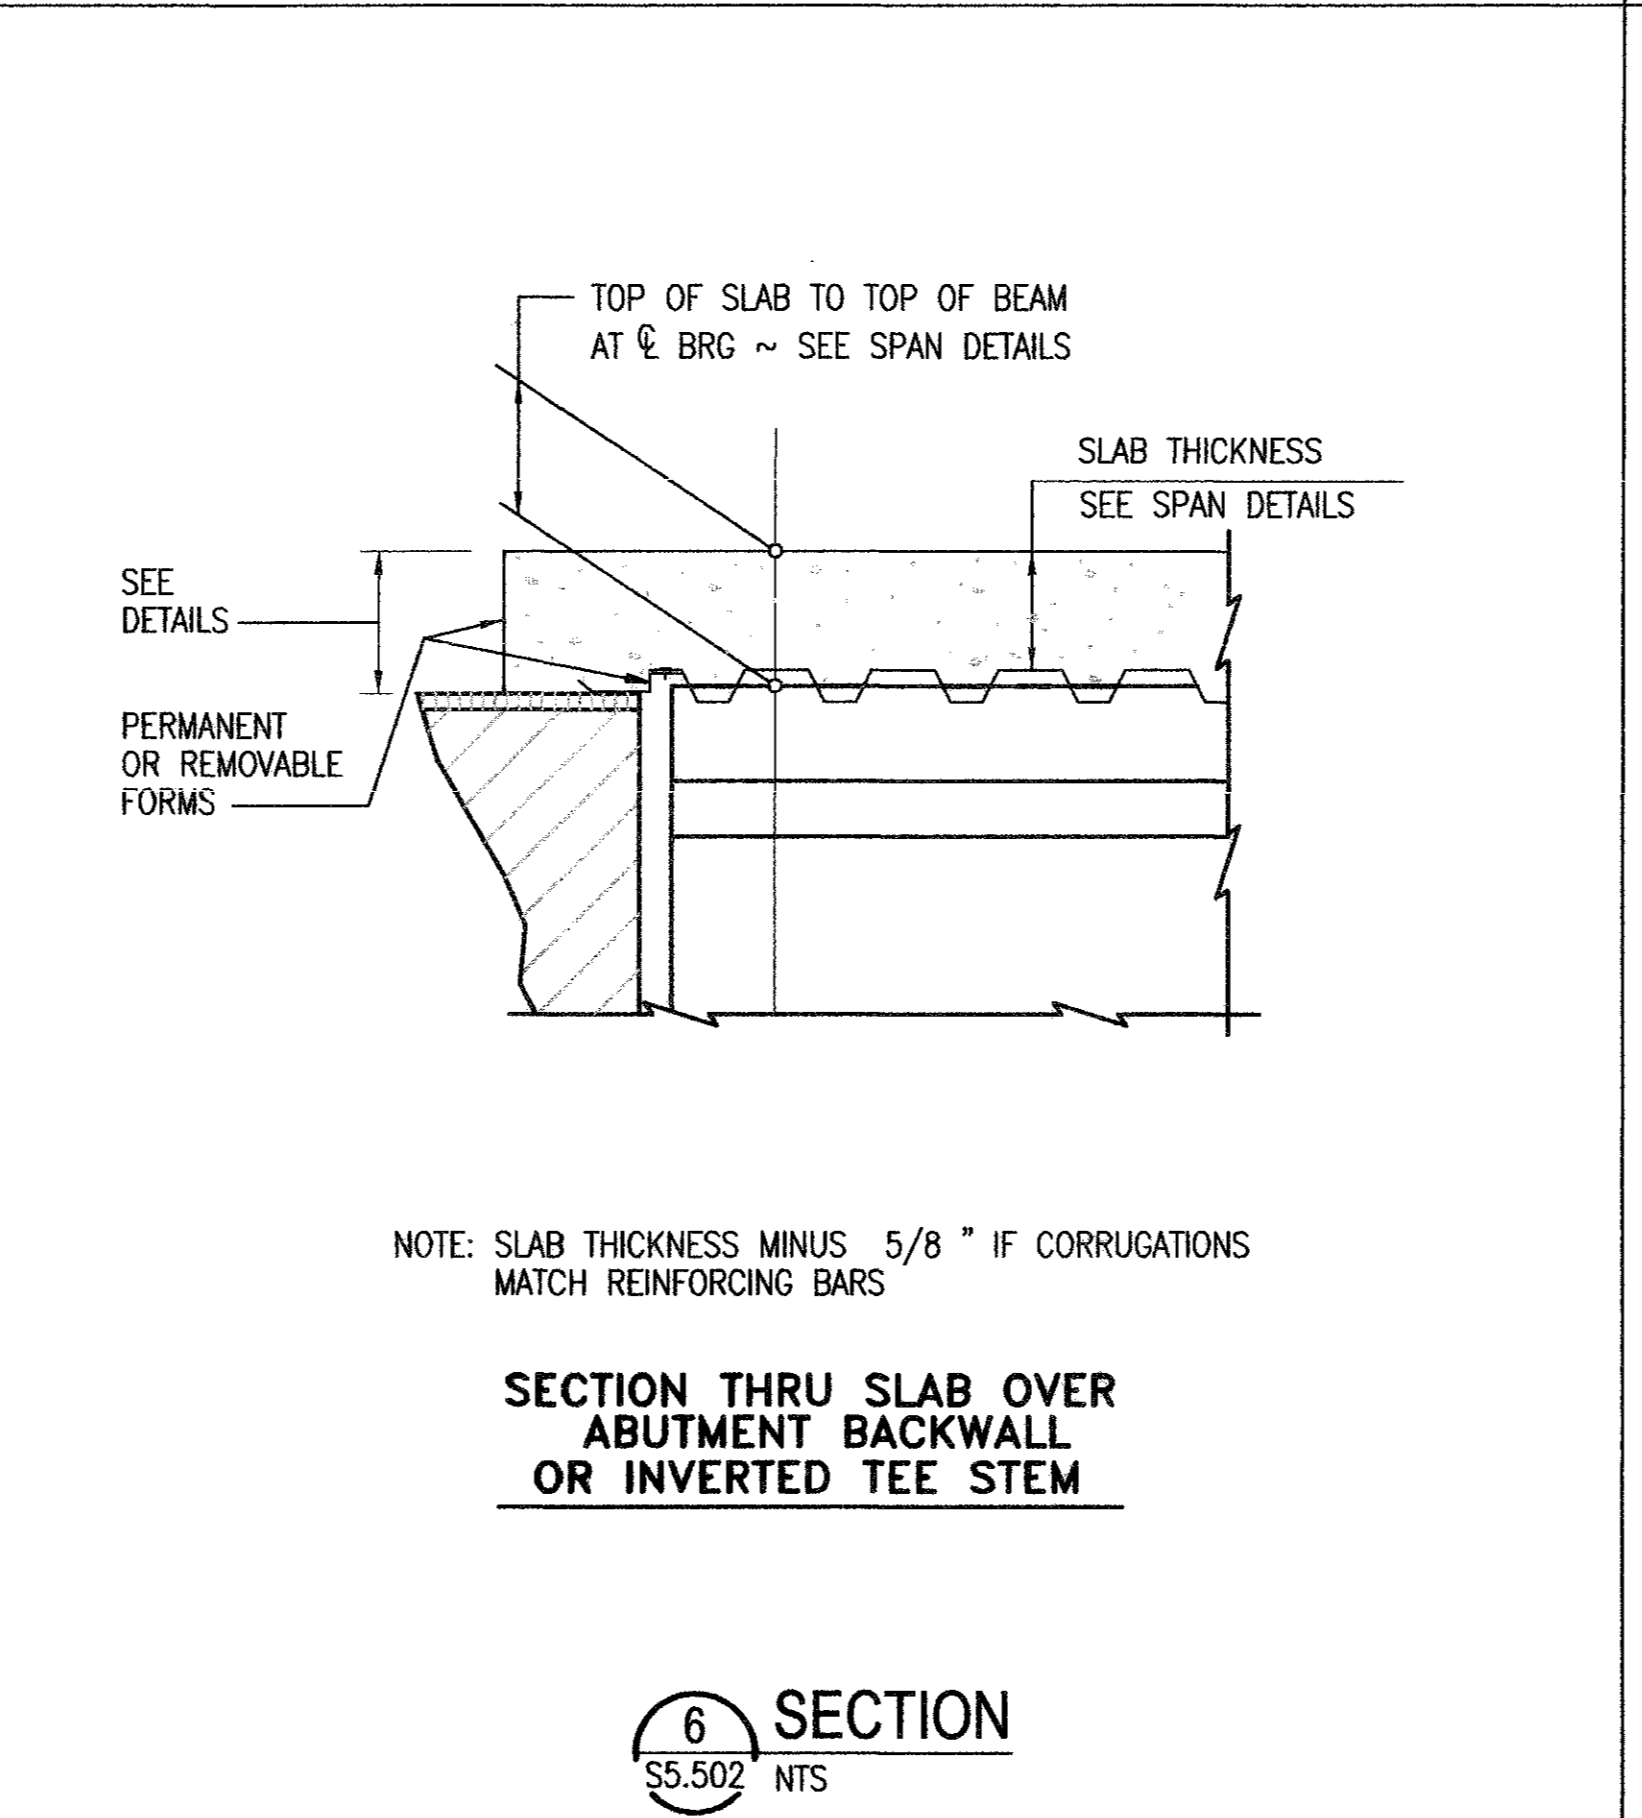


**6** SECTION  
S5.502 NTS

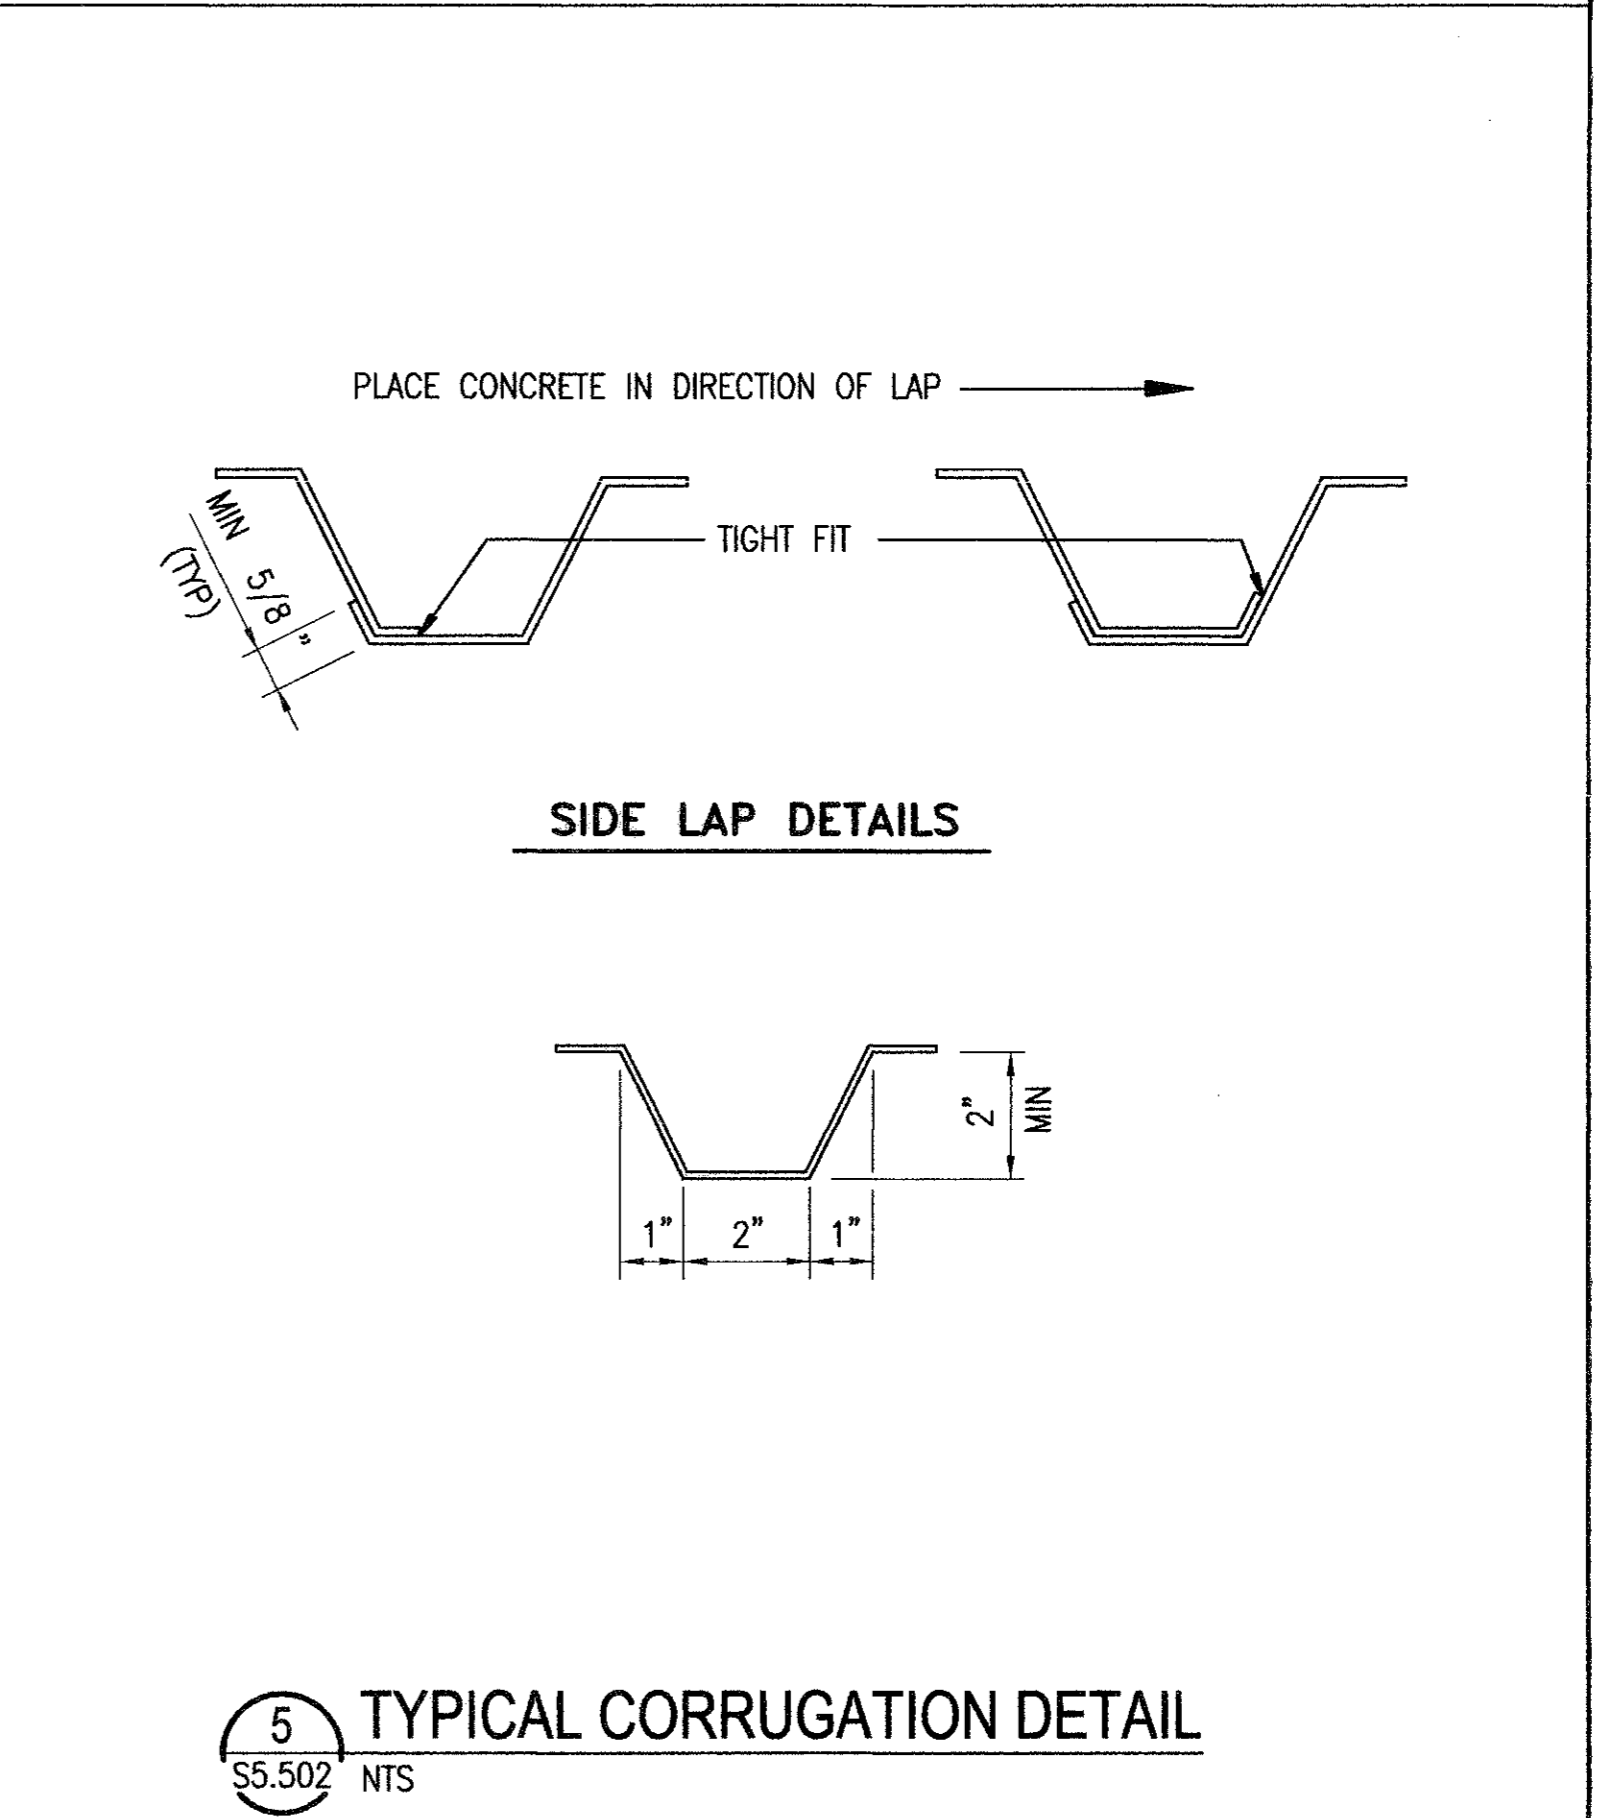


**5** TYPICAL CORRUGATION DETAIL  
S5.502 NTS

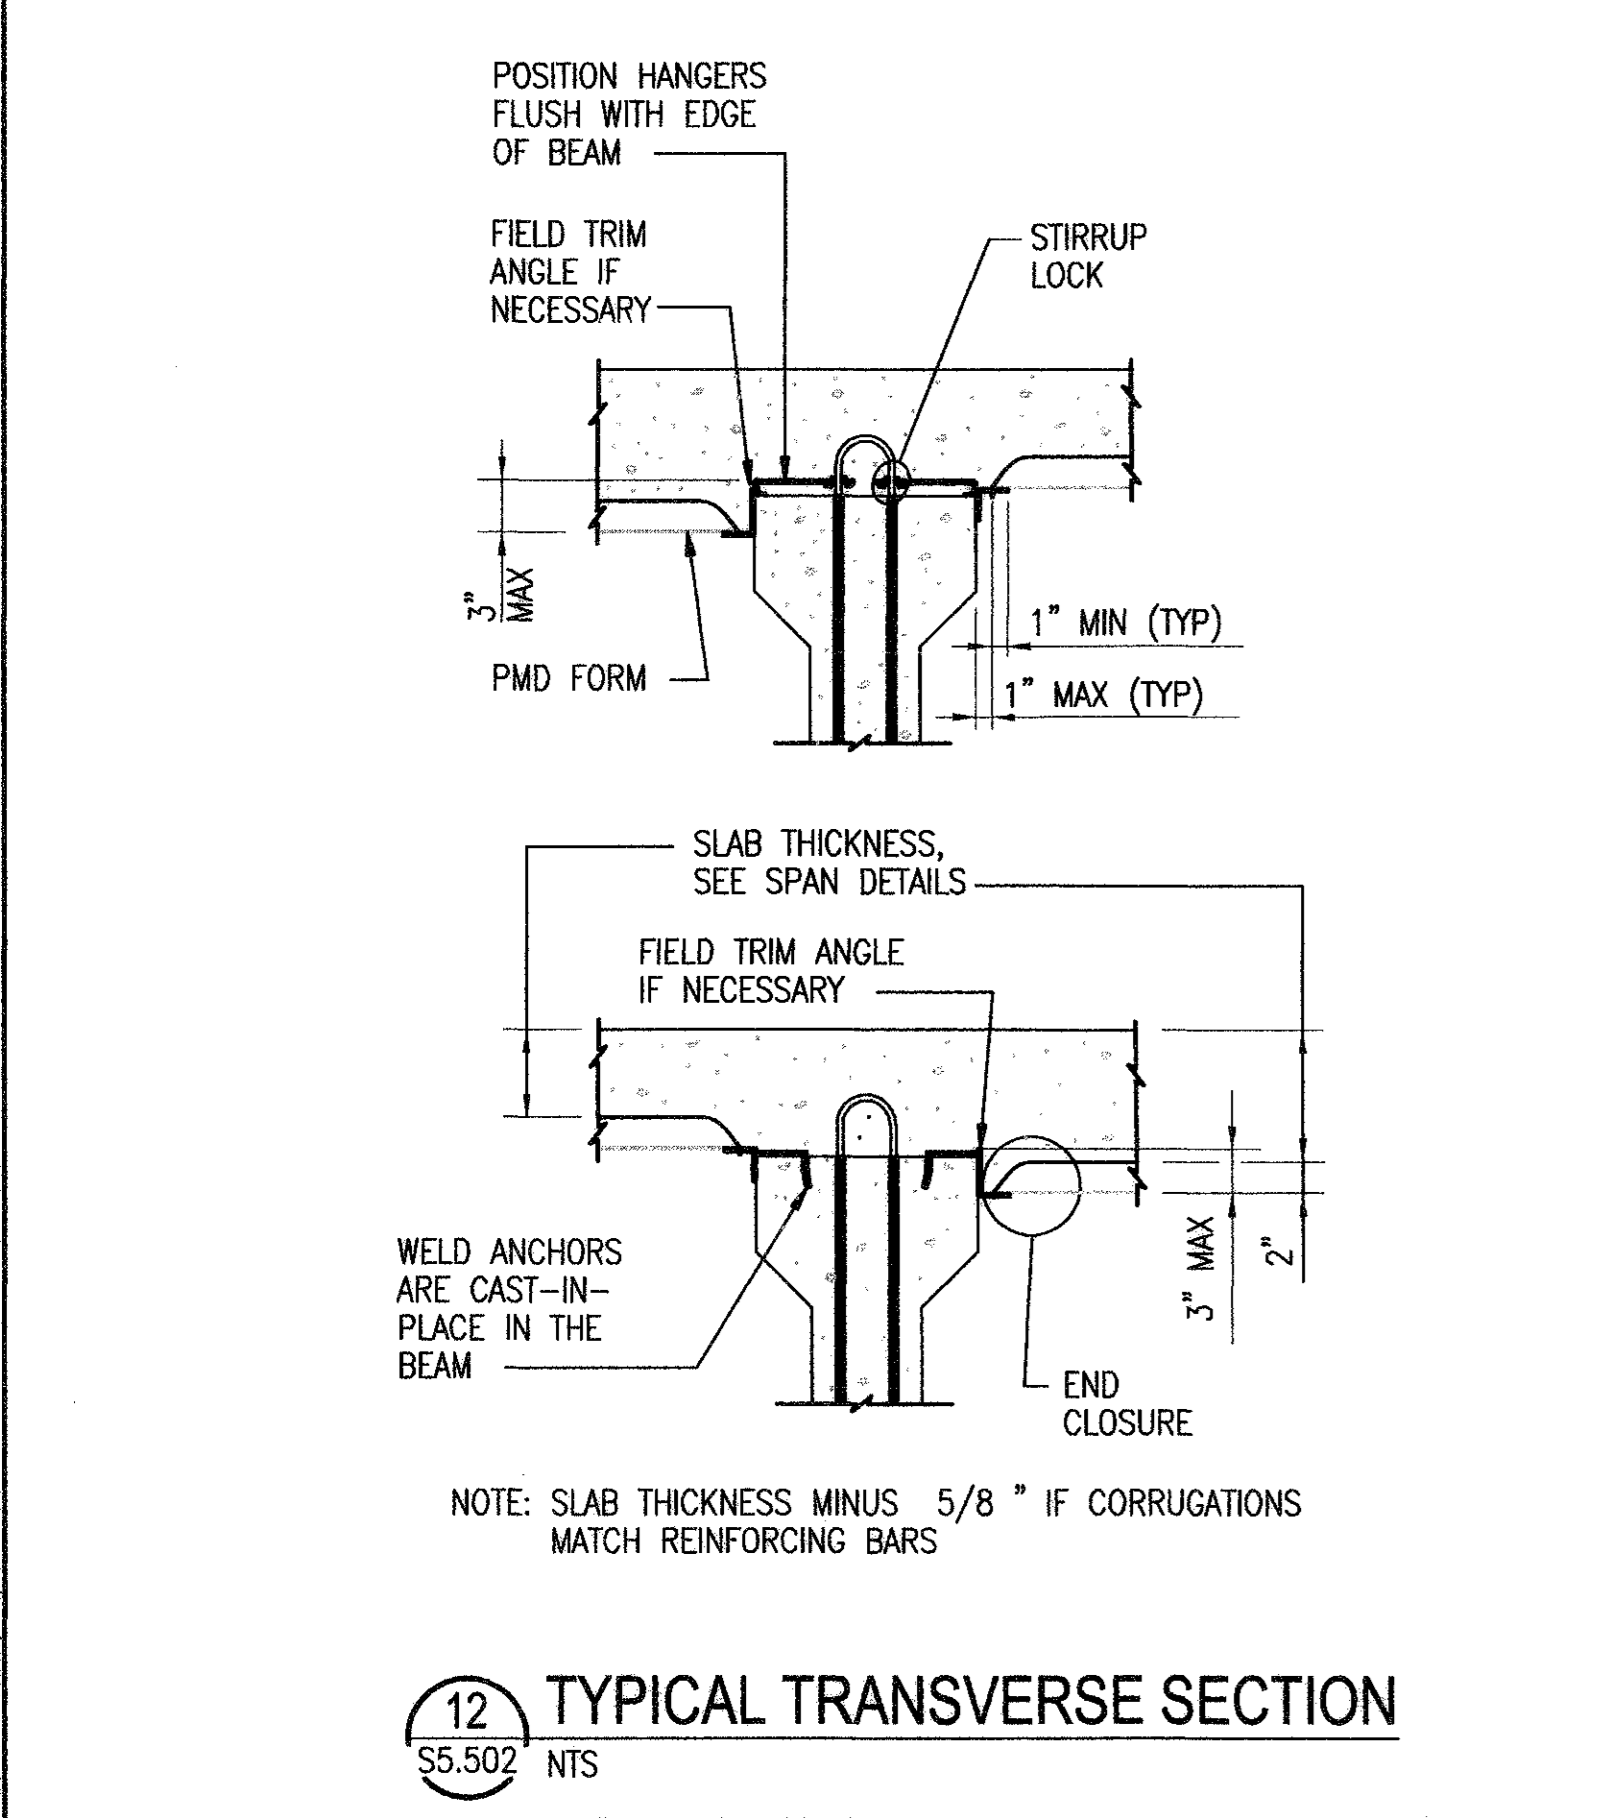

**12** TYPICAL TRANSVERSE SECTION  
S5.502 NTS

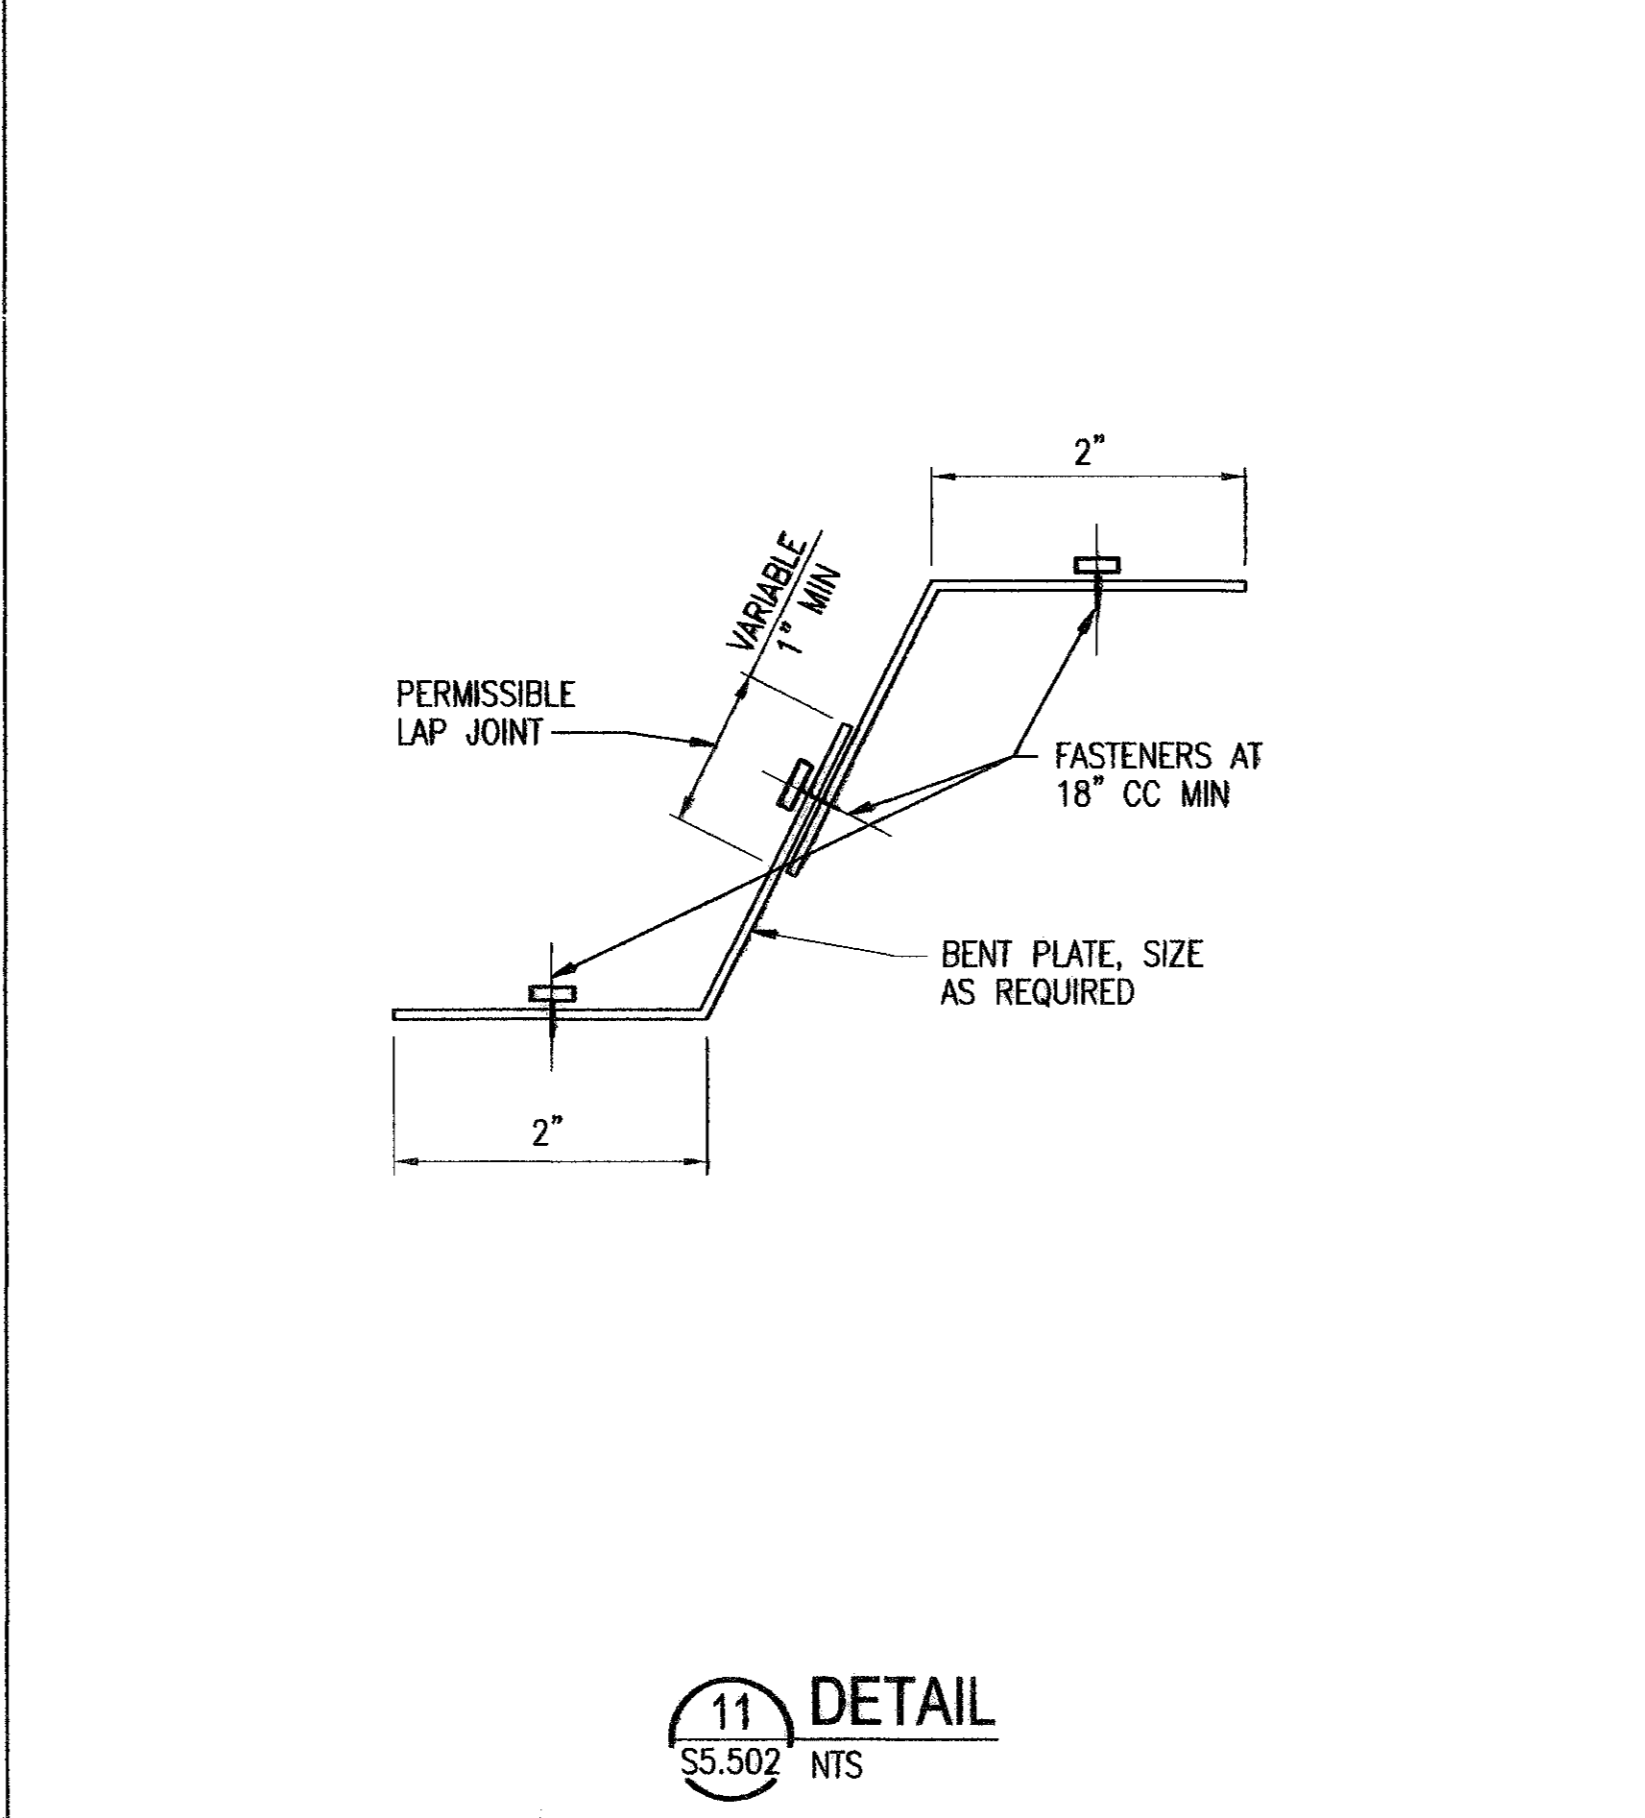

**11** DETAIL  
S5.502 NTS

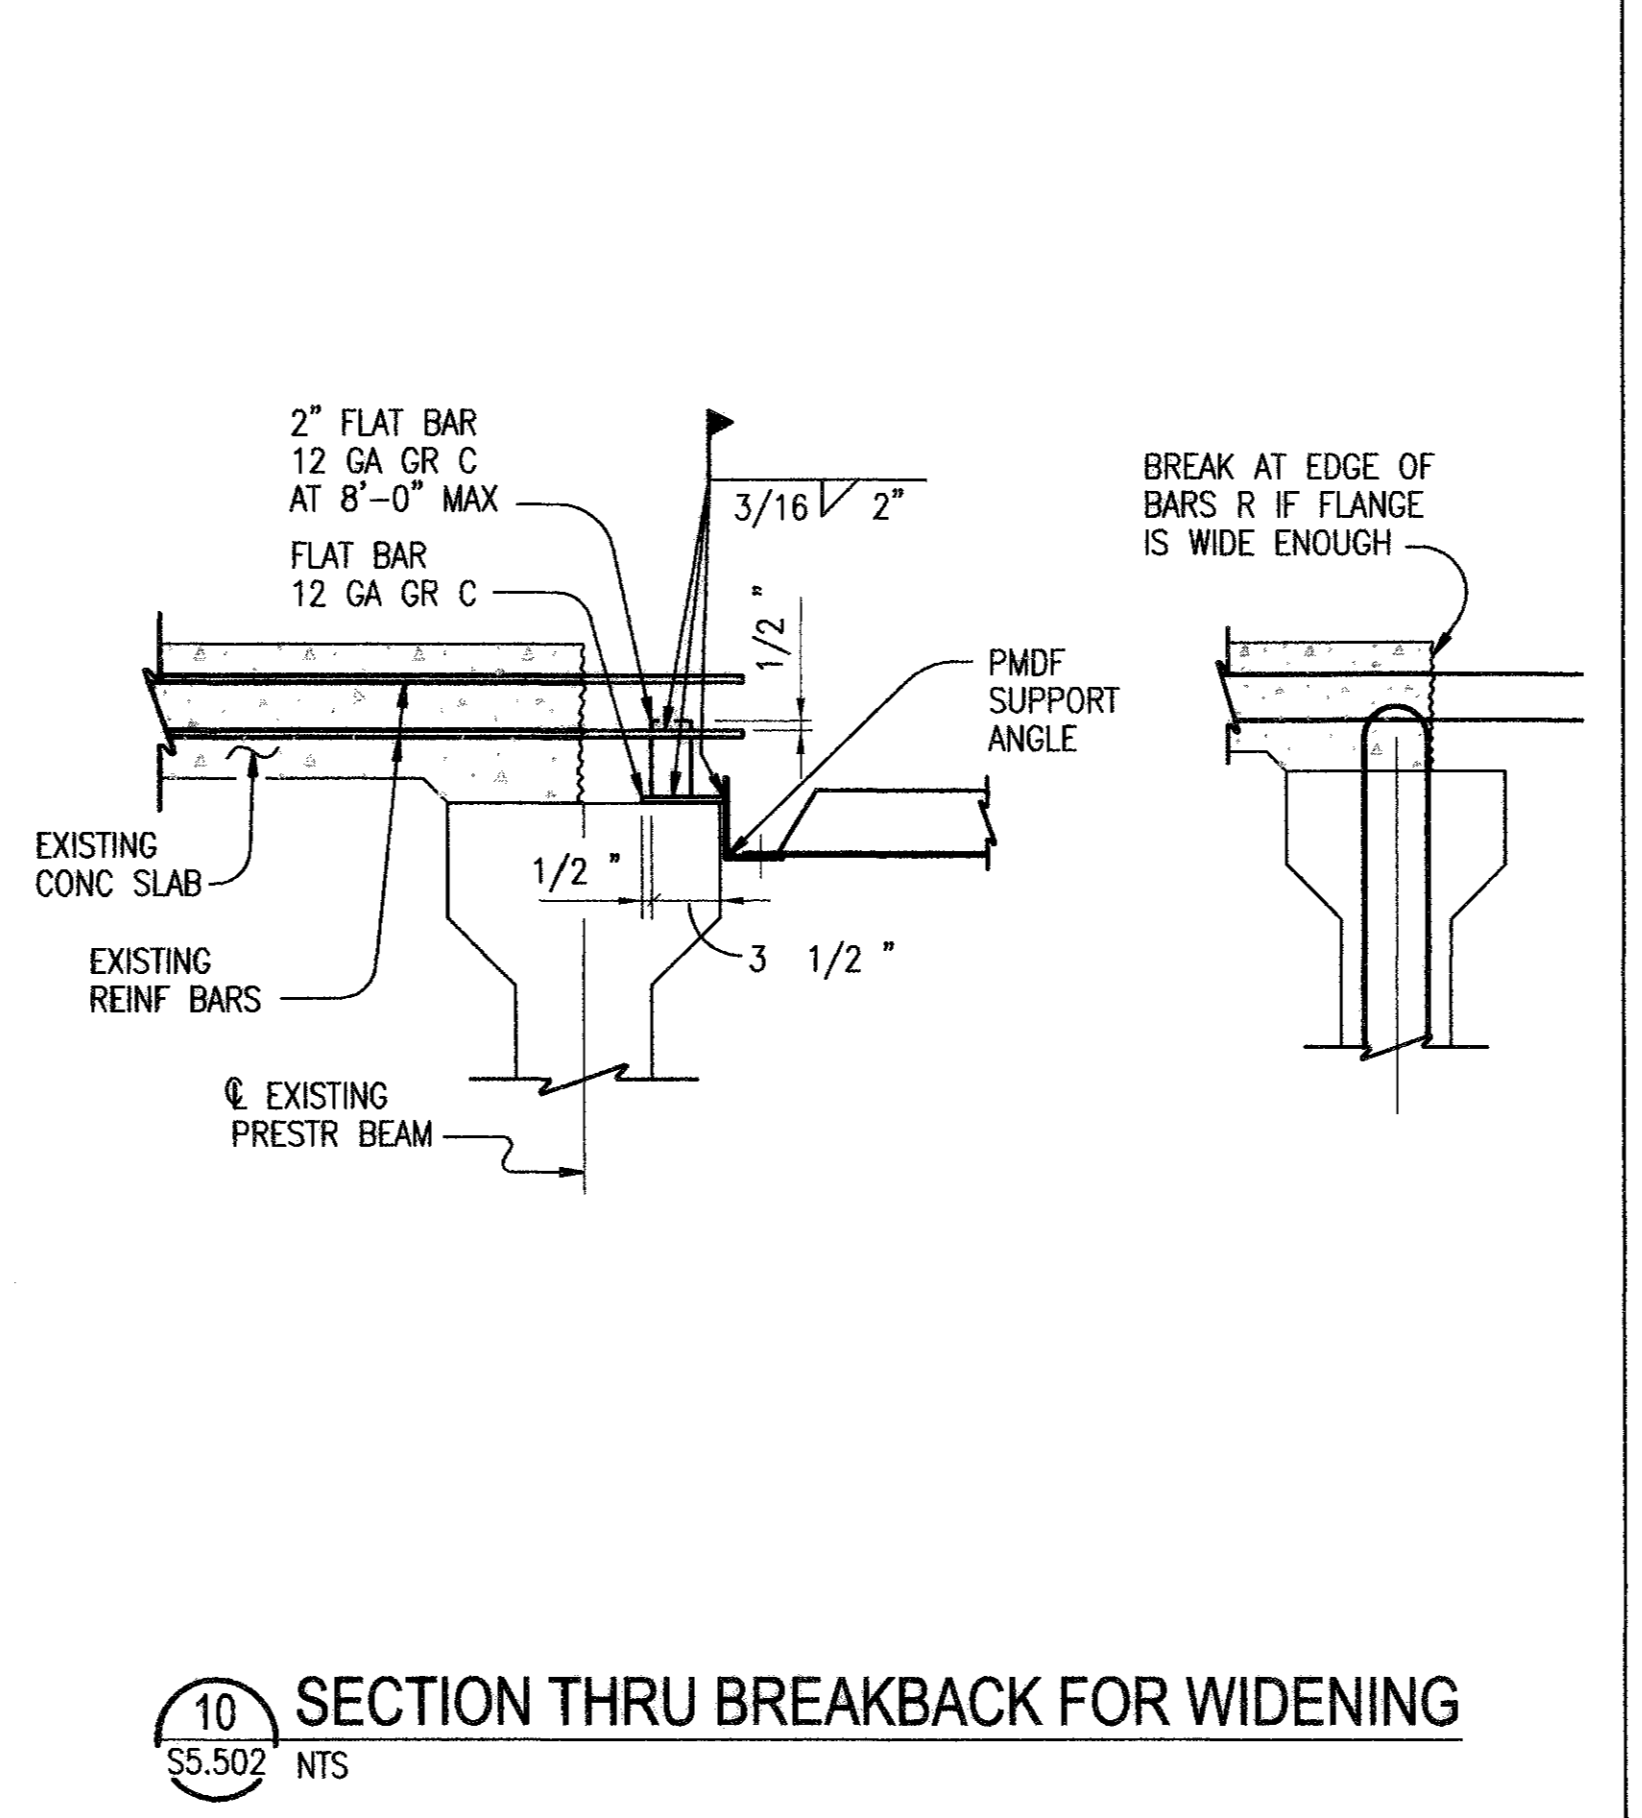

**10** SECTION THRU BREAKBACK FOR WIDENING  
S5.502 NTS

**GENERAL NOTES:**  
PERMANENT METAL DECK FORMS (PMDF) SHALL BE DESIGNED FOR THE DEAD LOAD OF FORM, REINFORCEMENT AND CONCRETE PLUS 50 POUNDS PER SQUARE FOOT FOR CONSTRUCTION LOADS. THE FOLLOWING ALLOWABLE STRESSES SHALL BE USED IN THE DESIGN:

ASTM A446, GRADE	YIELD (PSI)	ALLOWABLE STRESS (PSI)
A	33,000	23,900
B	37,000	26,800
C	40,000	29,000
D	50,000	36,000
E	80,000	36,000

WELD METAL  
12,400

MAXIMUM DEFLECTION UNDER THE WEIGHT OF FORMS, REINFORCEMENT AND CONCRETE, OR A MINIMUM OF 120 POUNDS PER SQUARE FOOT SHALL NOT EXCEED 1/180 OF THE FORM SPAN OR 1/2 INCH, WHICHEVER IS LESS. THE DESIGN SPAN FOR FORMS SHALL BE CLEAR DISTANCE BETWEEN BEAM FLANGES MEASURED PARALLEL TO THE FORM FLUTES MINUS 2 INCHES. THE MINIMUM THICKNESS OF THE FORMS SHALL BE 20 GAUGE AND THAT OF THE SUPPORT ANGLES SHALL BE 14 GAUGE. ALL FORMS SHALL BE SECURELY FASTENED TO SUPPORTS.

THIS STANDARD SHALL BE USED AS A GUIDE IN THE PREPARATION OF SHOP DETAIL DRAWINGS.

**NOTES TO SHEET**

1. REFER TO SHEET S0.100 FOR STRUCTURAL GENERAL NOTES.

**RECORD DRAWINGS DO NOT MODIFY**

DATE: MAY 6, 2005  
HUITT-ZOLLARS, INC.

NOTE: INFORMATION USED TO DEVELOP THESE DOCUMENTS WAS TAKEN FROM RECORD OF THE WORK DRAWINGS PREPARED BY THE CONSTRUCTION CONTRACTOR. CLARK/MISSION A JOINT VENTURE. THE INFORMATION PROVIDED BY THE CONTRACTOR WAS NOT VERIFIED BY THE DESIGN FIRM NAMED ABOVE.

**Houston Airport System**  
GEORGE BUSH INTERCONTINENTAL AIRPORT  
HOUSTON TEXAS

**HUITT-ZOLLARS**  
Engineering / Architecture  
1800 Bay Area Blvd., Suite 200, Houston, TX 77057  
Phone (813) 455-0066 Fax (813) 455-0066

**CHARLES F. TERRY, INC.**  
Consulting Engineers  
2801 Gessner Avenue  
Houston, Texas 77050  
HOUSTON TX 77050

REVISIONS  
NO. DESCRIPTION DATE BY  
ISSUED FOR BID 10/18/01

INTERNATIONAL • SERVICES • EXPANSION • PROGRAM

**APM STATION & PLATFORM PERMANENT METAL DECK FORMS**

PROJECT MGR: GRW  
DESIGNER: JUC  
DRAWN BY: KLV  
CHECKED BY: MMR  
DRAWING STANDARD: ISEP 07.20.2000  
SCALE: AS NOTED  
DATE: 09/14/01

FOR RECORD DRAWING ONLY  
STATE OF TEXAS  
MICHAEL RETHMAN  
REGISTERED PROFESSIONAL ENGINEER  
NO. 12544

APPROVED BY: DATE:  
DIRECTOR  
HOUSTON AIRPORT SYSTEM

PROJECT NO. 02-2025-01  
C.I.P. NO. A-0354  
H.A.S. NO. 536C  
SHEET NO.

**S5.502**




NOTES TO SHEET

1. ERECTION BRACING:  
ERECTION BRACING DETAILS ARE CONSIDERED MINIMUM FOR FULFILLING THE REQUIREMENTS OF SPECIFICATIONS FOR BRACING TYPE IV PRESTRESSED CONCRETE BEAMS ERECTED IN THE SPAN OVER A TRAVELED WAY OR RAILROAD, AND IN THOSE SPANS GENERALLY PARALLEL TO A TRAVELED WAY OR RAILROAD AND WITHIN A DISTANCE EQUAL TO THE DIFFERENCE IN ELEVATION BETWEEN THE TOP OF CAP UPON WHICH THE BEAMS ARE BEING ERECTED AND THE TRAVELED WAY, OR 30 FT, WHICHEVER IS GREATER.  
REQUIRED ERECTION BRACING SHALL BE PLACED IMMEDIATELY AFTER ERECTION OF EACH BEAM AND REMAIN IN PLACE UNTIL DIAPHRAGM BARS ON ARE TIGHTENED OR ADDITIONAL BRACING AS REQUIRED FOR SLAB PLACEMENT IS IN PLACE.



2. SLAB PLACEMENT BRACING:  
THE DETAILS FOR SLAB PLACEMENT BRACING ARE CONSIDERED MINIMUM FOR FULFILLING THE REQUIREMENTS OF SPECIFICATIONS.  
REQUIRED SLAB PLACEMENT BRACING SHALL REMAIN IN PLACE UNTIL SLAB CONCRETE HAS ATTAINED A FLEXURAL STRENGTH OF 500 PSI.

3. GENERAL:  
THE CONTRACTOR SHALL SUBMIT HIS PROPOSED BRACING DETAILS. THE ENGINEER FOR APPROVAL PRIOR TO ERECTION.  
SYSTEMS EQUAL TO OR BETTER THAN THOSE SHOWN MAY BE USED PROVIDED DETAILS OF SUCH SYSTEMS ARE SUBMITTED TO AND APPROVED BY THE ENGINEER PRIOR TO ERECTION.

USE OF THESE SYSTEMS AND/OR DETAILS DOES NOT RELIEVE THE CONTRACTOR OF THE RESPONSIBILITY FOR THE ADEQUACY OF THE BRACING AND THE SAFETY OF THE STRUCTURE.  
REMOVAL OF BRACING FOR SHORT PERIODS OF TIME TO ALIGN BEAMS IS PERMISSIBLE. BOTTOM FLANGE BRACING AT BEAM ENDS MAY BE OMITTED WHEN ALL BEAMS ARE FIXED WITH DOWEL BARS OR WHEN ERECTION IS ON STEEL CAPS OR FLOOR BEAMS CONTAINING BEARING SEATS WHICH RESTRICT LATERAL MOVEMENT.  
ALL TURN-BUCKLES, COME-ALONGS AND OTHER CONNECTIONS SHALL BE CAPABLE OF DEVELOPING THE FULL STRENGTH OF THE CABLE SHOWN HEREON.

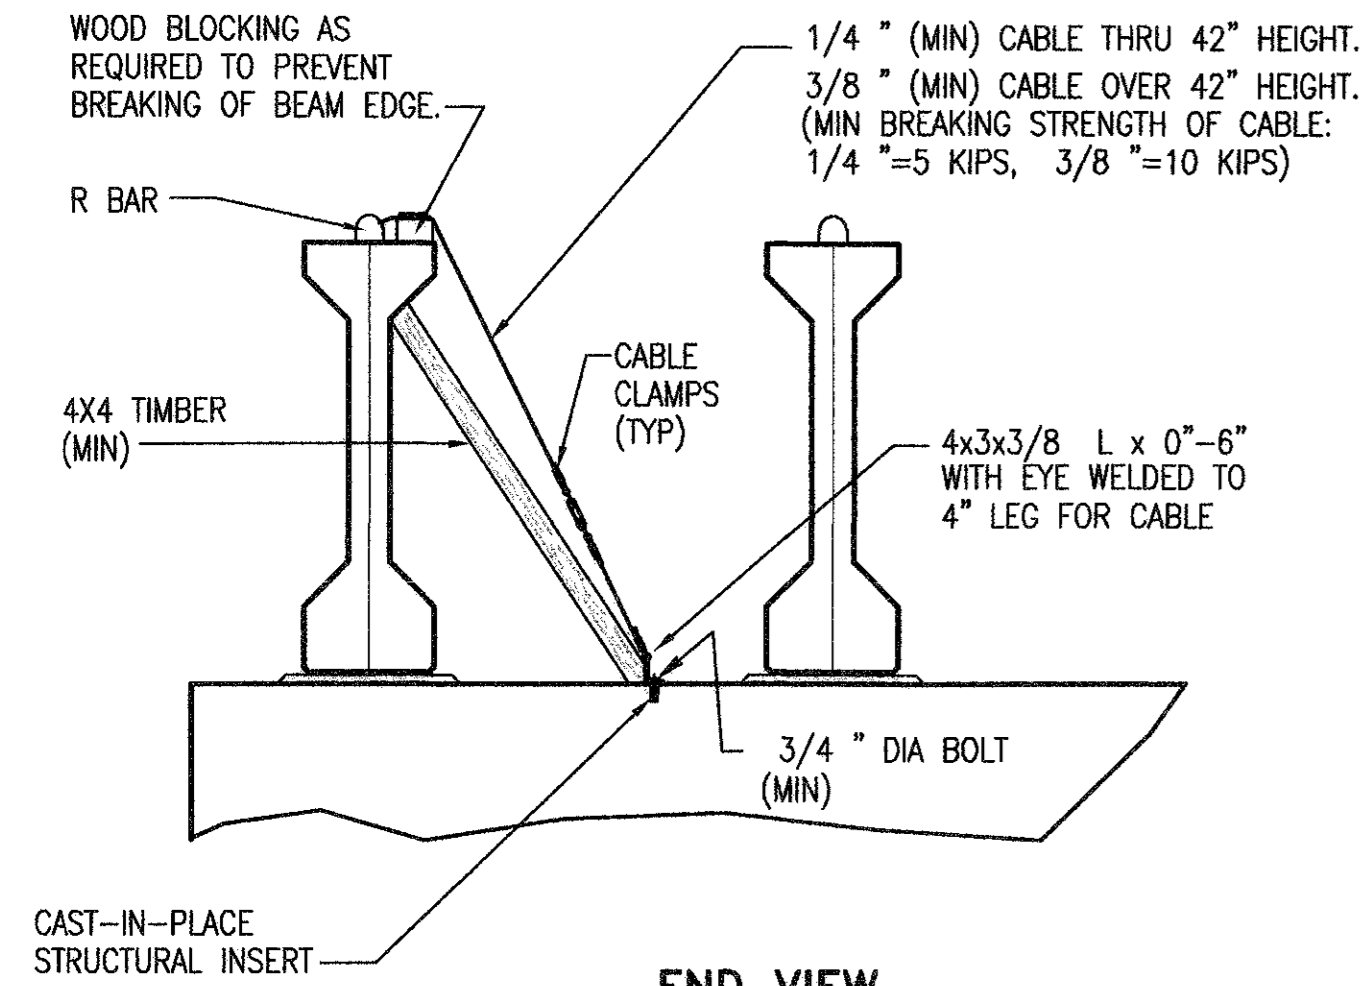


INDICATES DIAGONAL BRACING ①  
INDICATES BOTTOM BRACING ② WITH TEMPORARY TOP BRACING ④ OR "X" BRACING ③ WITH PERMANENT TOP BRACING ⑤  
INDICATES PERMANENT TOP BRACING ⑤  
INDICATES BOTTOM BRACING ② OR "X" BRACING ③, EITHER ONE WITH PERMANENT TOP BRACING ⑤ OR AN IN-PLACE DIAPHRAGM ONLY.  
INDICATES "X" BRACING ③ & PERMANENT TOP BRACING ⑤ OR AN IN-PLACE DIAPHRAGM ONLY.

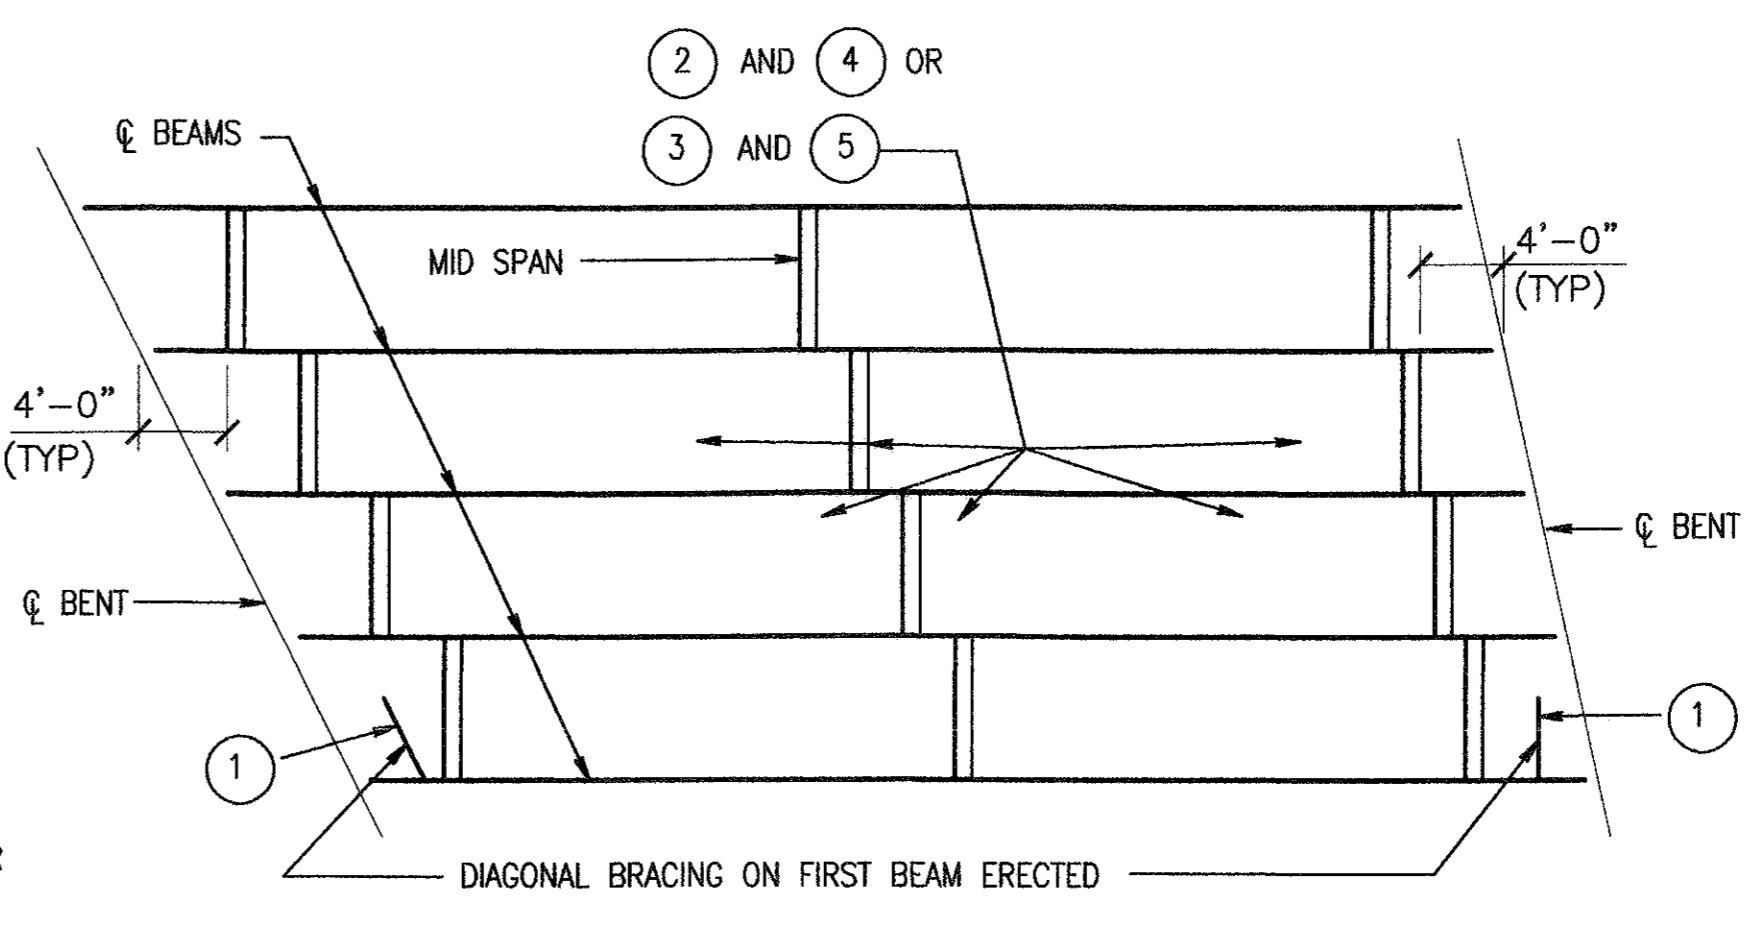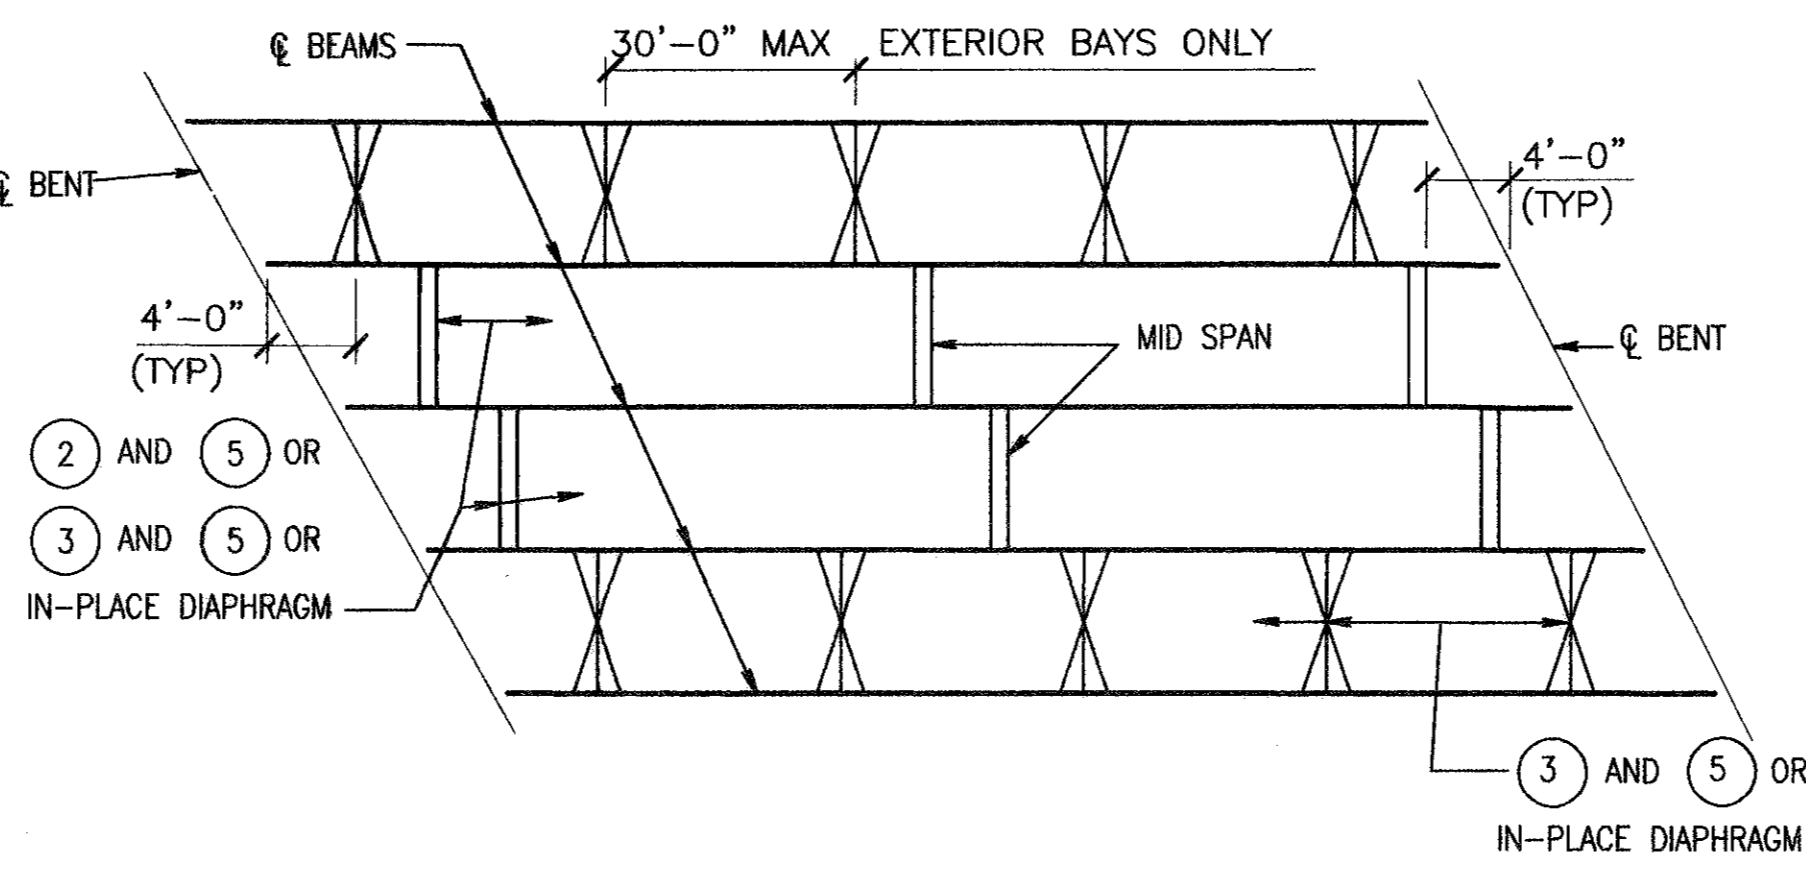


④ DIAGONAL BRACING DETAILS  
S5.503 NTS (TO BE USED ON BOTH ENDS OF THE FIRST BEAM ERECTED IN THE SPAN.)

② SLAB PLACEMENT BRACING  
S5.503 NTS (NORMAL SPANS AND ALL SKEWS)


① ERECTION BRACING  
S5.503 NTS (NORMAL SPANS AND ALL SKEWS)

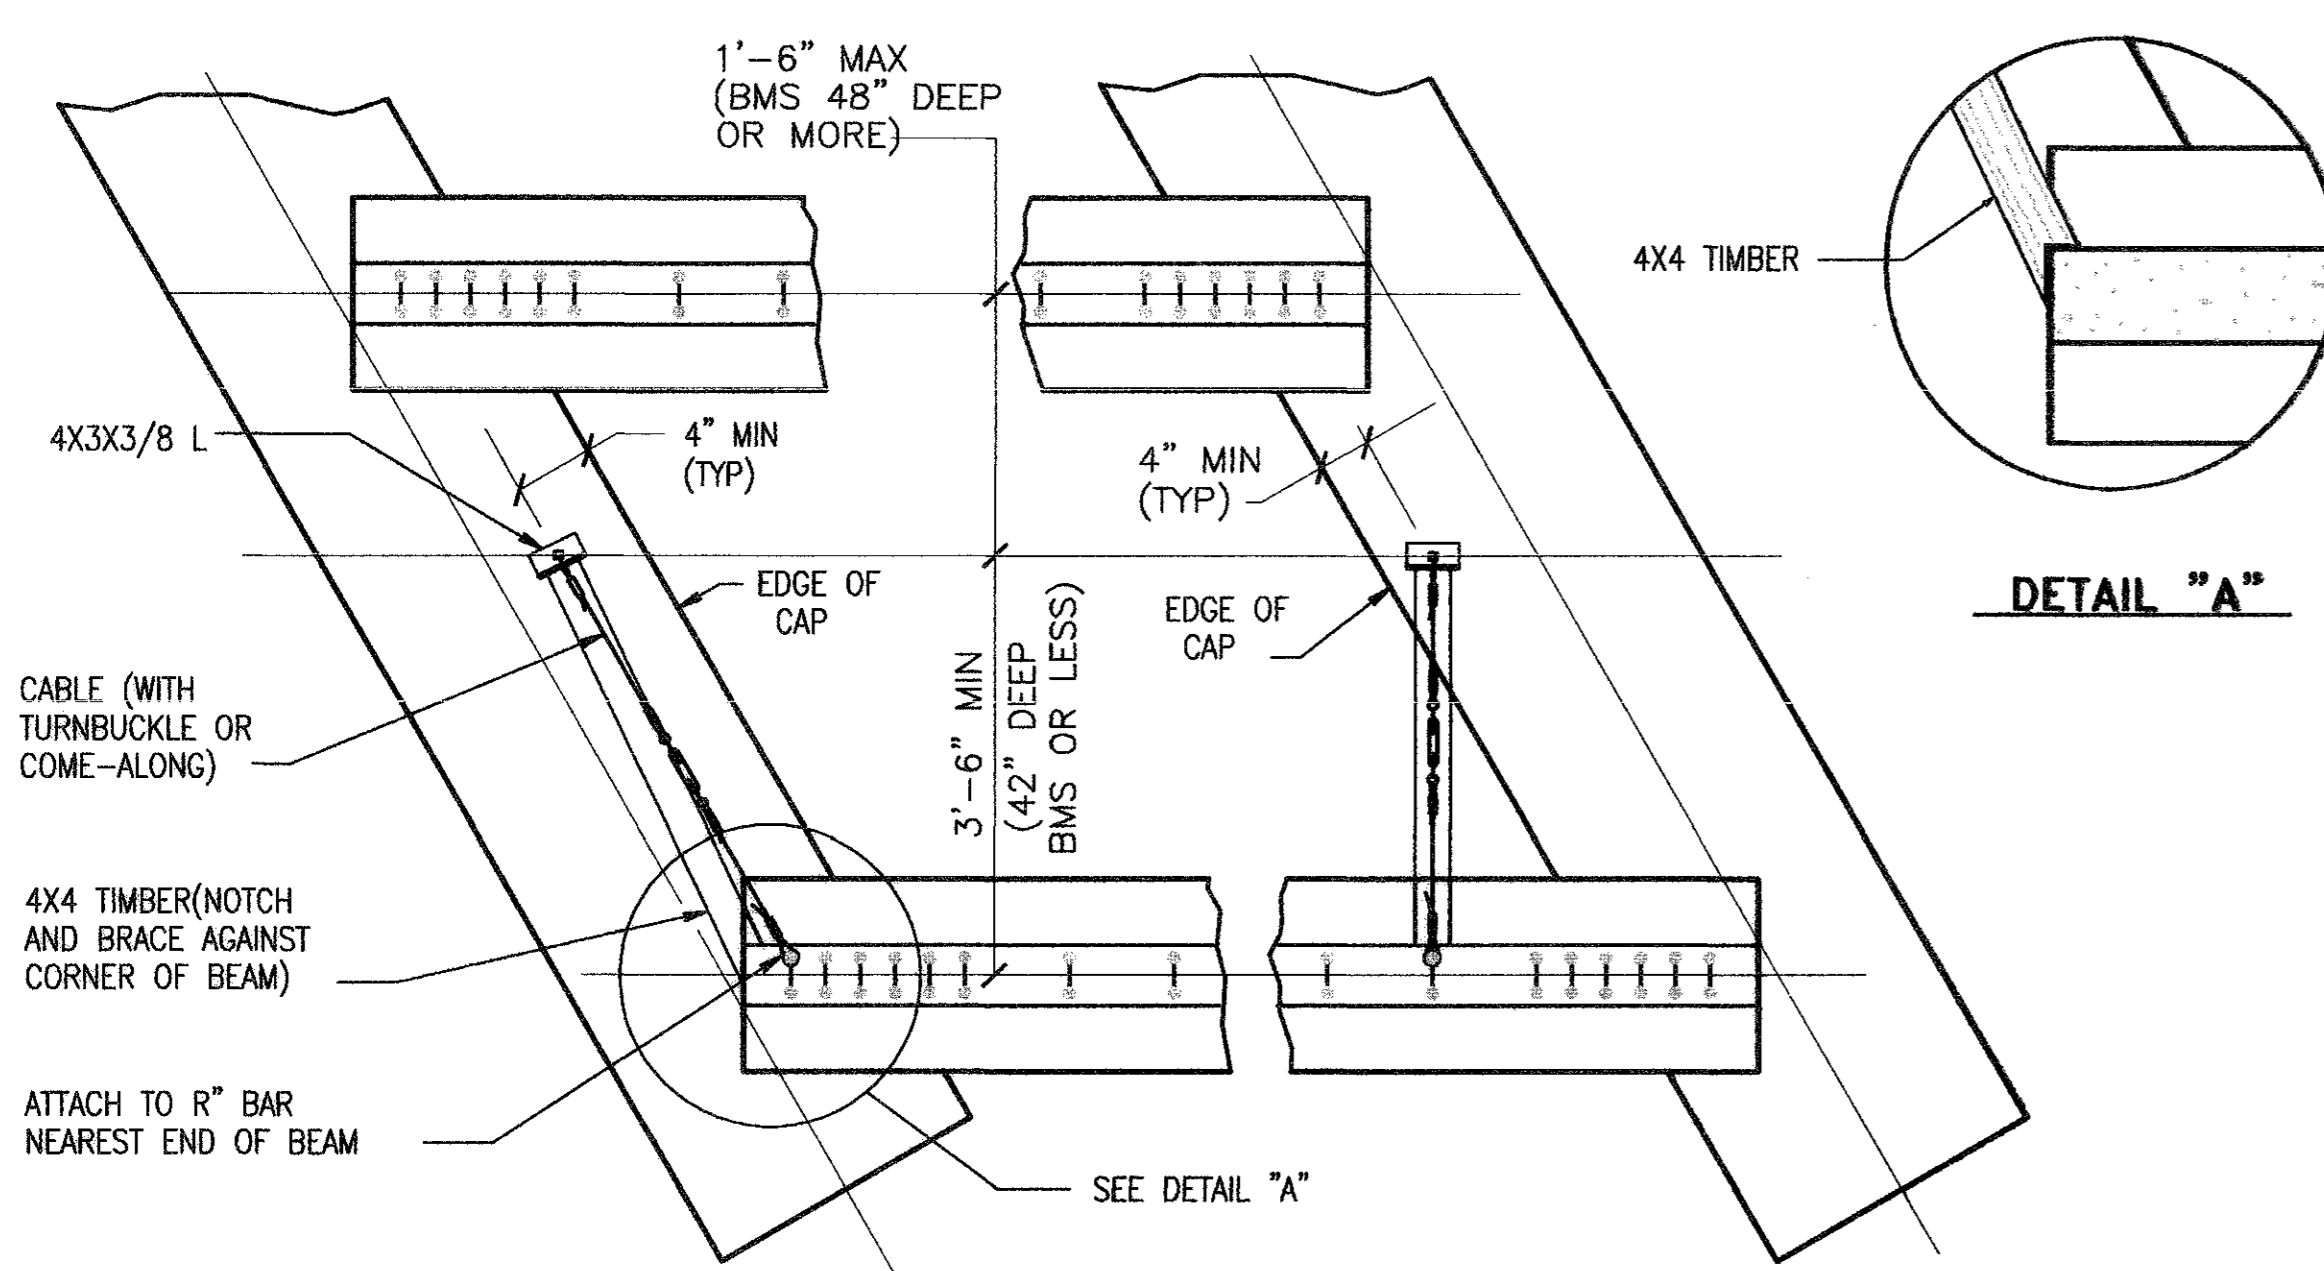


⑦ DIAGONAL BRACING DETAILS  
S5.503 NTS

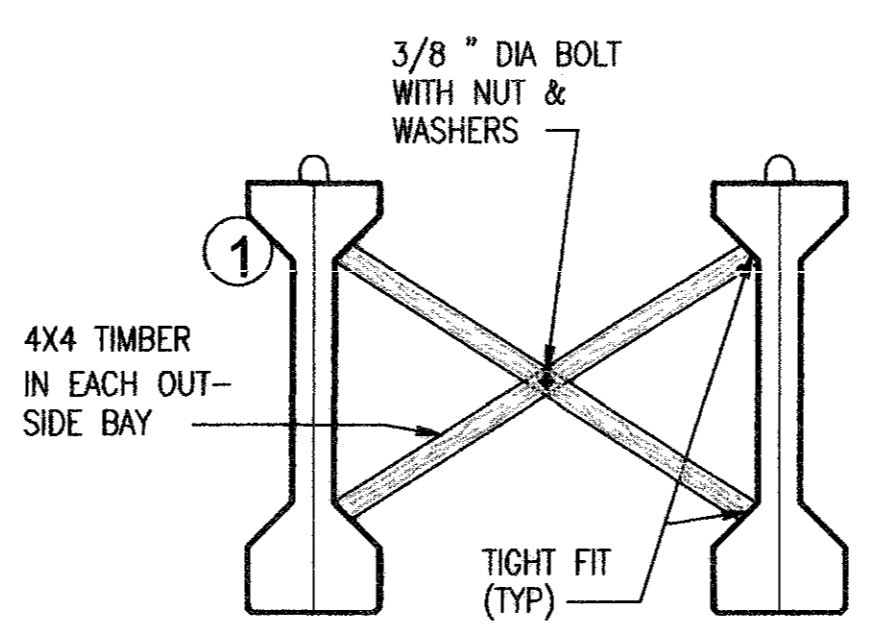


⑥ "X" BRACING ③  
S5.503 NTS

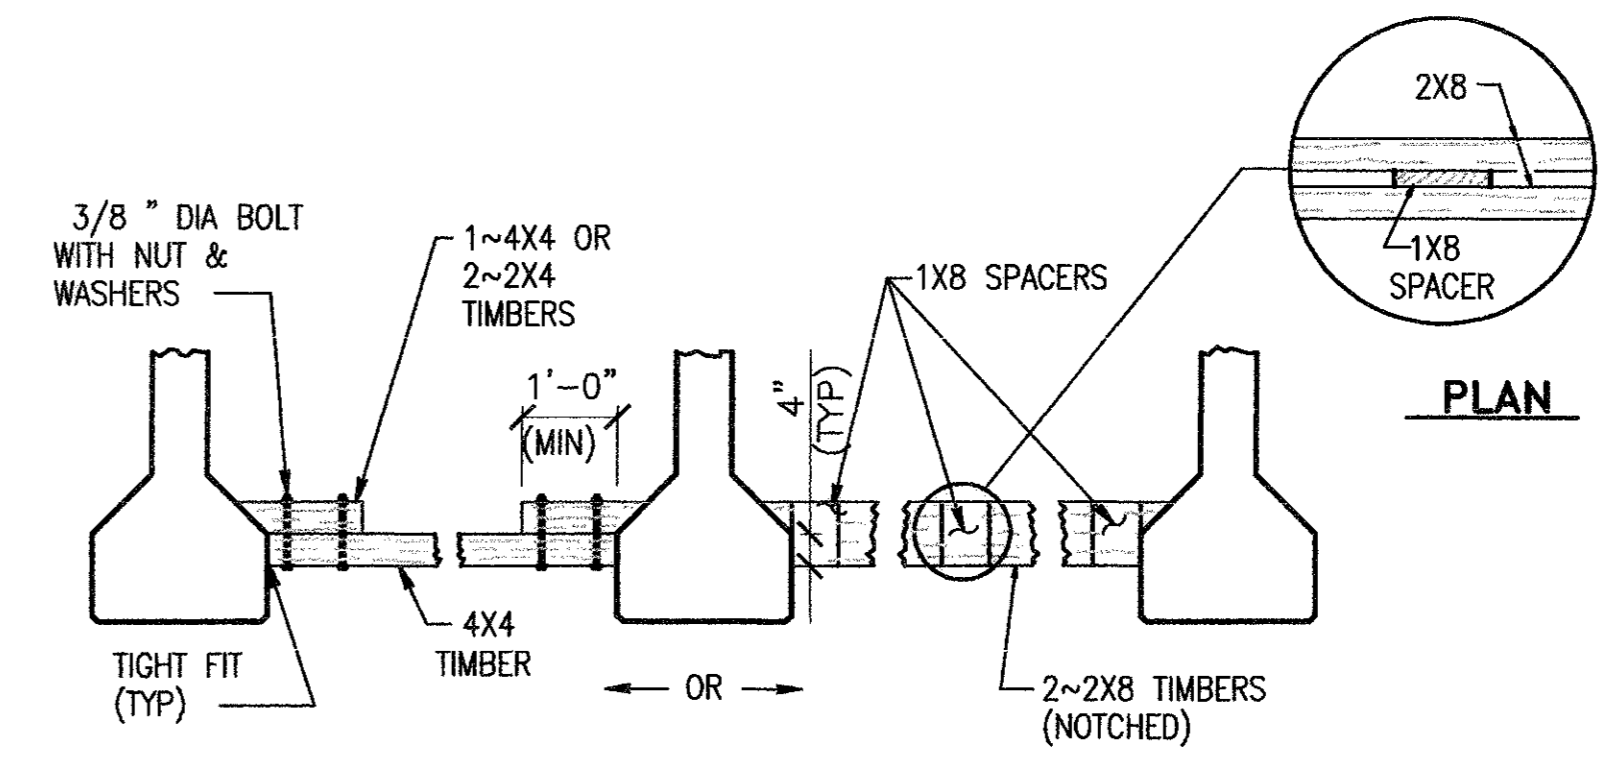

⑤ BOTTOM FLANGE BRACING DETAILS ②  
S5.503 NTS

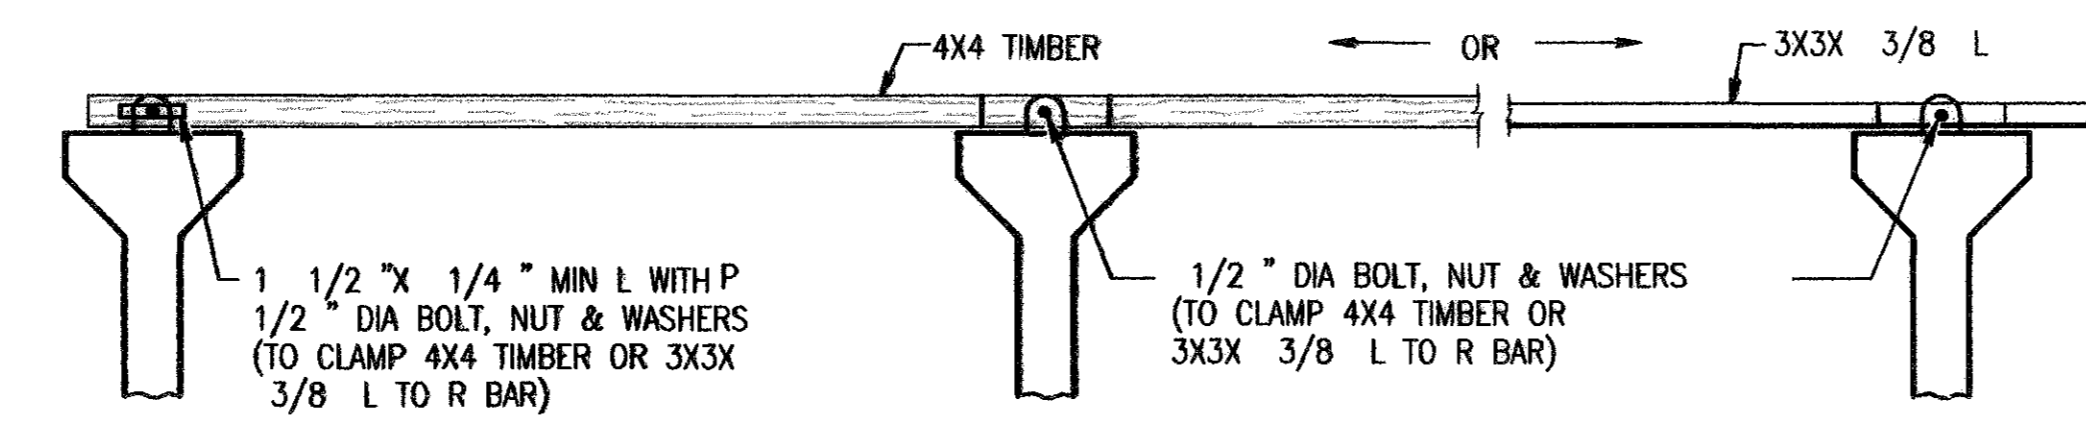

⑩ TEMPORARY TOP BRACING ④  
S5.503 NTS

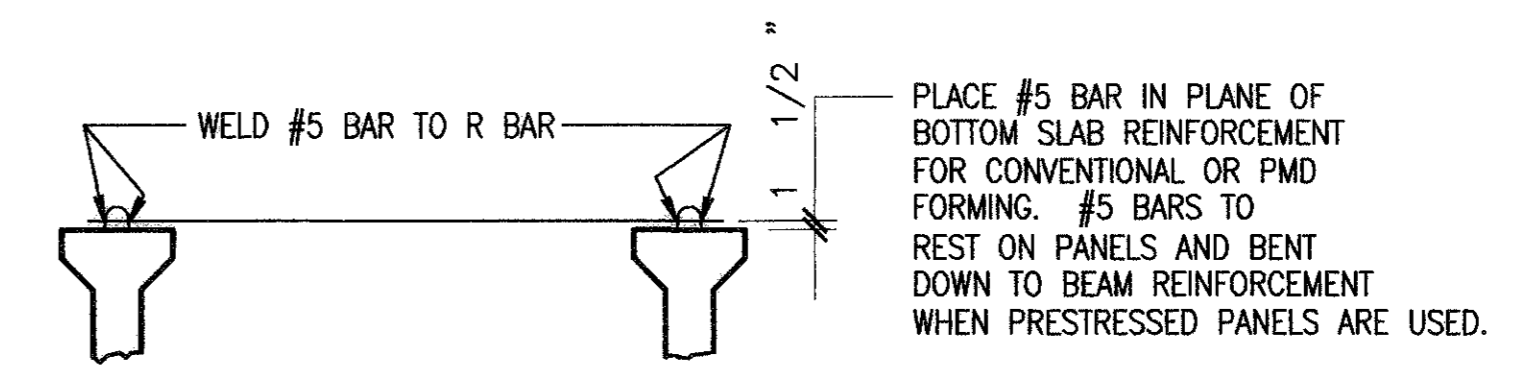

⑨ PERMANENT TOP BRACING ⑤  
S5.503 NTS

RECORD DRAWINGS  
DO NOT MODIFY  
DATE: MAY 6, 2005  
HUITT-ZOLLARS, INC.  
NOTE: INFORMATION USED TO DEVELOP THESE DOCUMENTS WAS TAKEN FROM RECORD OF THE WORK DRAWINGS PREPARED BY THE CONSTRUCTION CONTRACTOR, CLARK/MISSION A JOINT VENTURE. THE INFORMATION PROVIDED BY THE CONTRACTOR WAS NOT VERIFIED BY THE DESIGN FIRM NAMED ABOVE.








REVISIONS			
NO.	DESCRIPTION	DATE	BY
1	ISSUED FOR BID	10/19/01	

INTERNATIONAL • SERVICES • EXPANSION • PROGRAM

**APM STATION & PLATFORM**

**DRILLED SHAFT AND FOOTING DETAILS**


PROJECT MGR:	DRW:
DESIGNER:	JUE
DRAWN BY:	NSA
CHECKED BY:	MHR
DRAWING STANDARD:	
DATE:	09/14/01

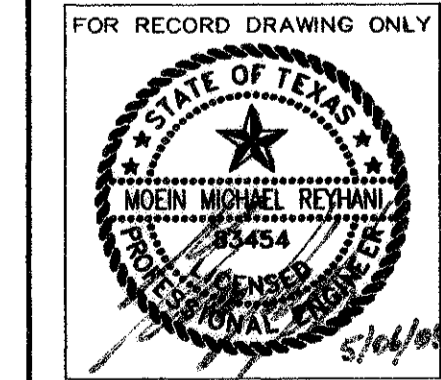


APPROVED BY:	DATE:
DIRECTOR	HOUSTON AIRPORT SYSTEM
PROJECT NO.:	02-2025-01
C.I.P. NO.:	A-0354
H.A.S. NO.:	536C
SHEET NO.:	

**NOTES TO SHEET**


- REFER TO SHEET S0.100 FOR STRUCTURAL GENERAL NOTES.
- VERTICAL BARS MAY BE SUPPORTED ON BOTTOM OF DRILLED HOLE IF MATERIAL IS FIRM ENOUGH TO DO SO WHEN CONCRETE IS PLACED.
- SEE "FOUNDATION PLAN" FOR FOUNDATION LOCATION & ORIENTATION. (SHEET S2.001)
- DRILLED SHAFT REINFORCING STEEL, INCLUDING STEEL BANDS SHALL BE INCLUDED IN THE BID FOR DRILLED SHAFTS.
- A 30 DIAMETER LAP SPLICE WILL BE REQUIRED FOR EACH BAR. THE LAP SPLICE SHALL BE POSITIONED AT THE LOWER END OF THE CAGE.

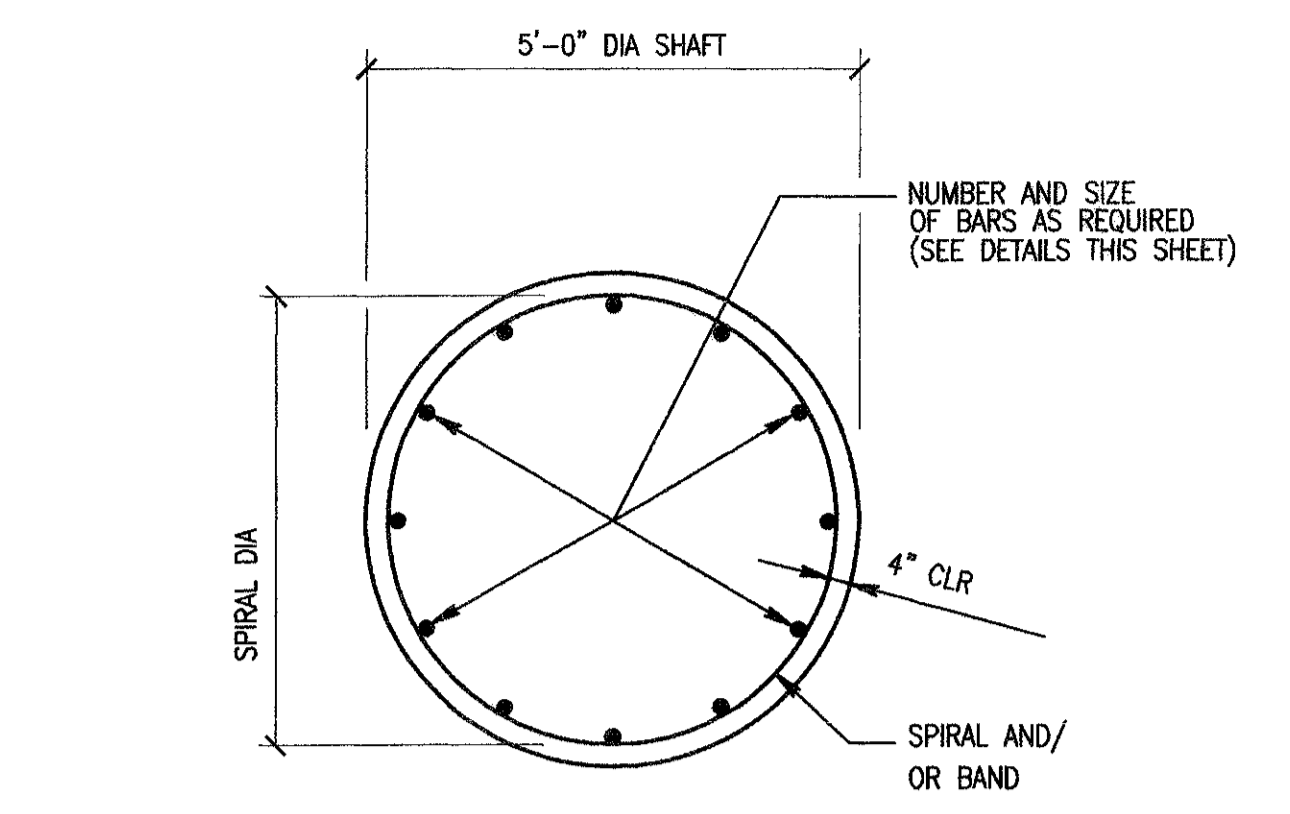


**1 SECTION THRU SHAFT**  
 S6.001 NTS

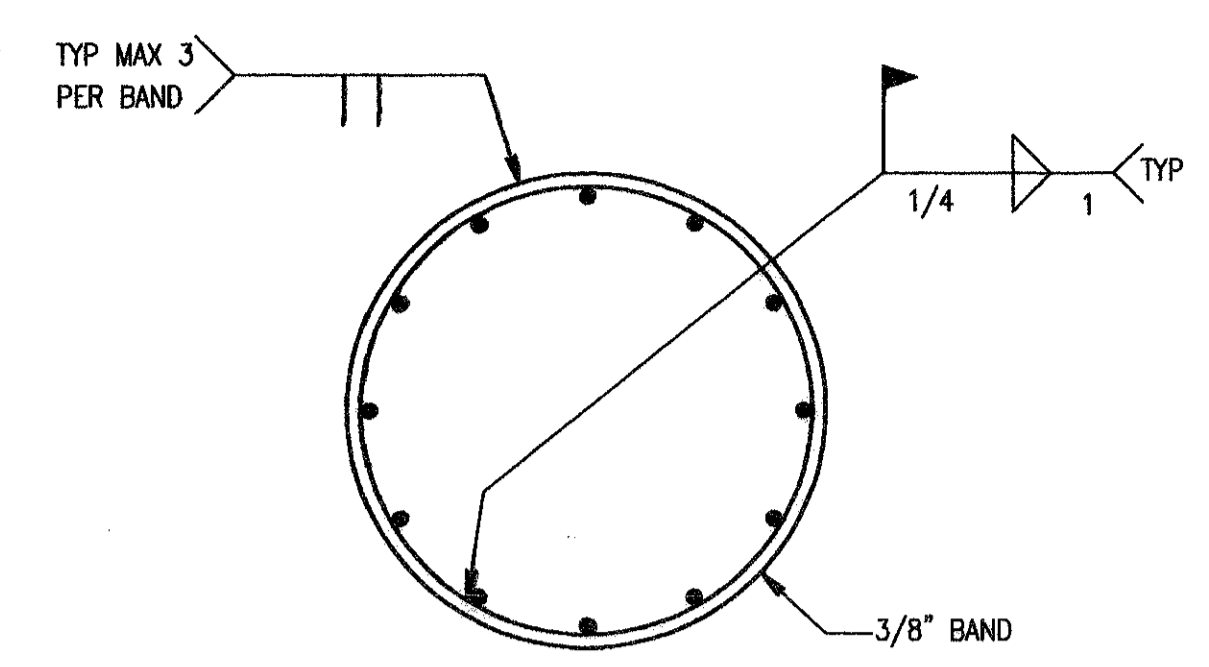


**2 TOP BAND DETAIL**  
 S6.001 NTS

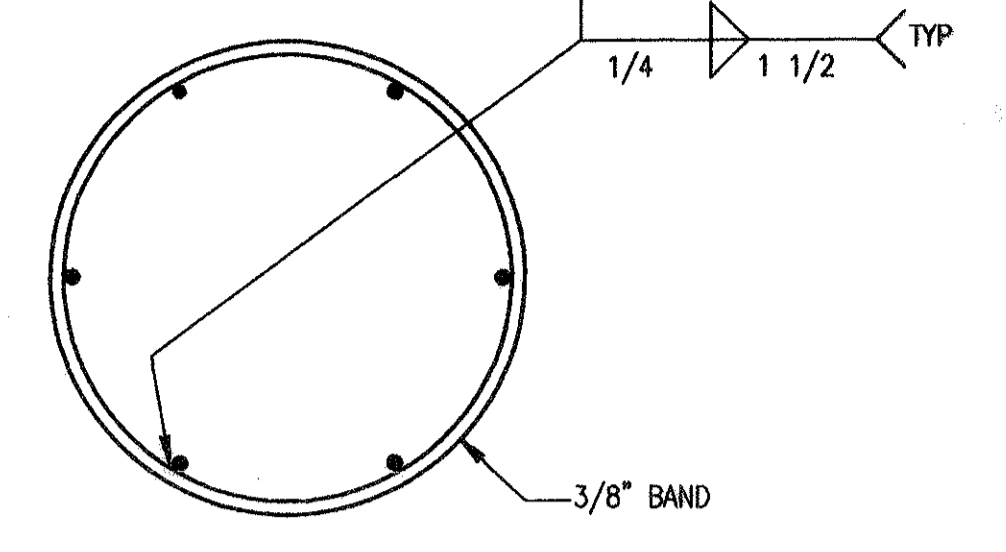


**3 INTERIOR BAND DETAIL**  
 S6.001 NTS

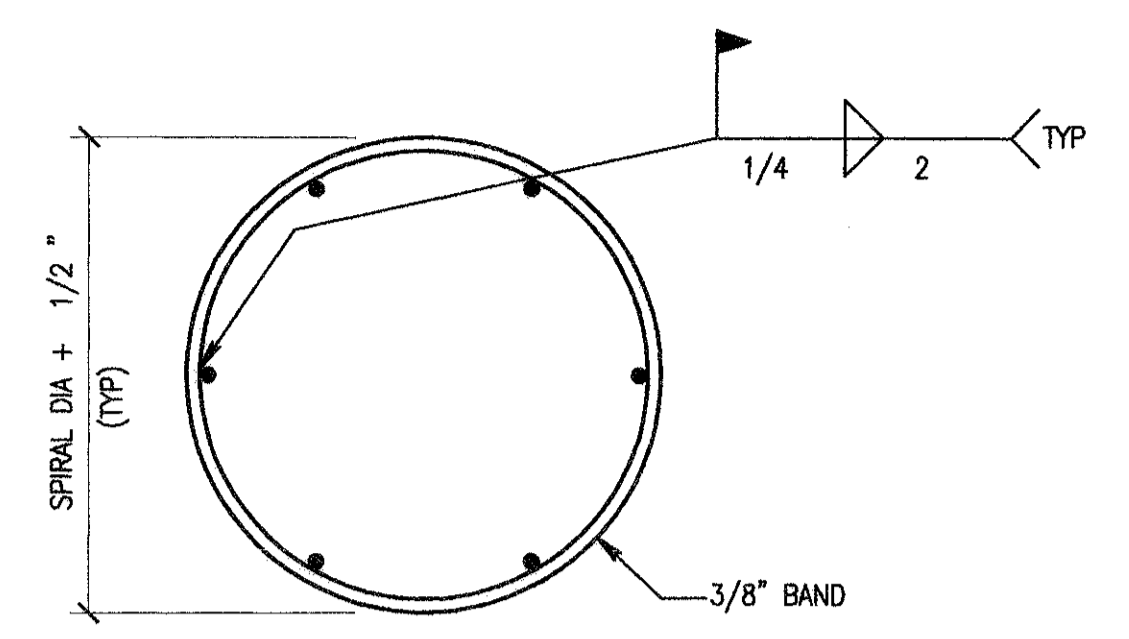


**4 BOTTOM BAND DETAIL**  
 S6.001 NTS

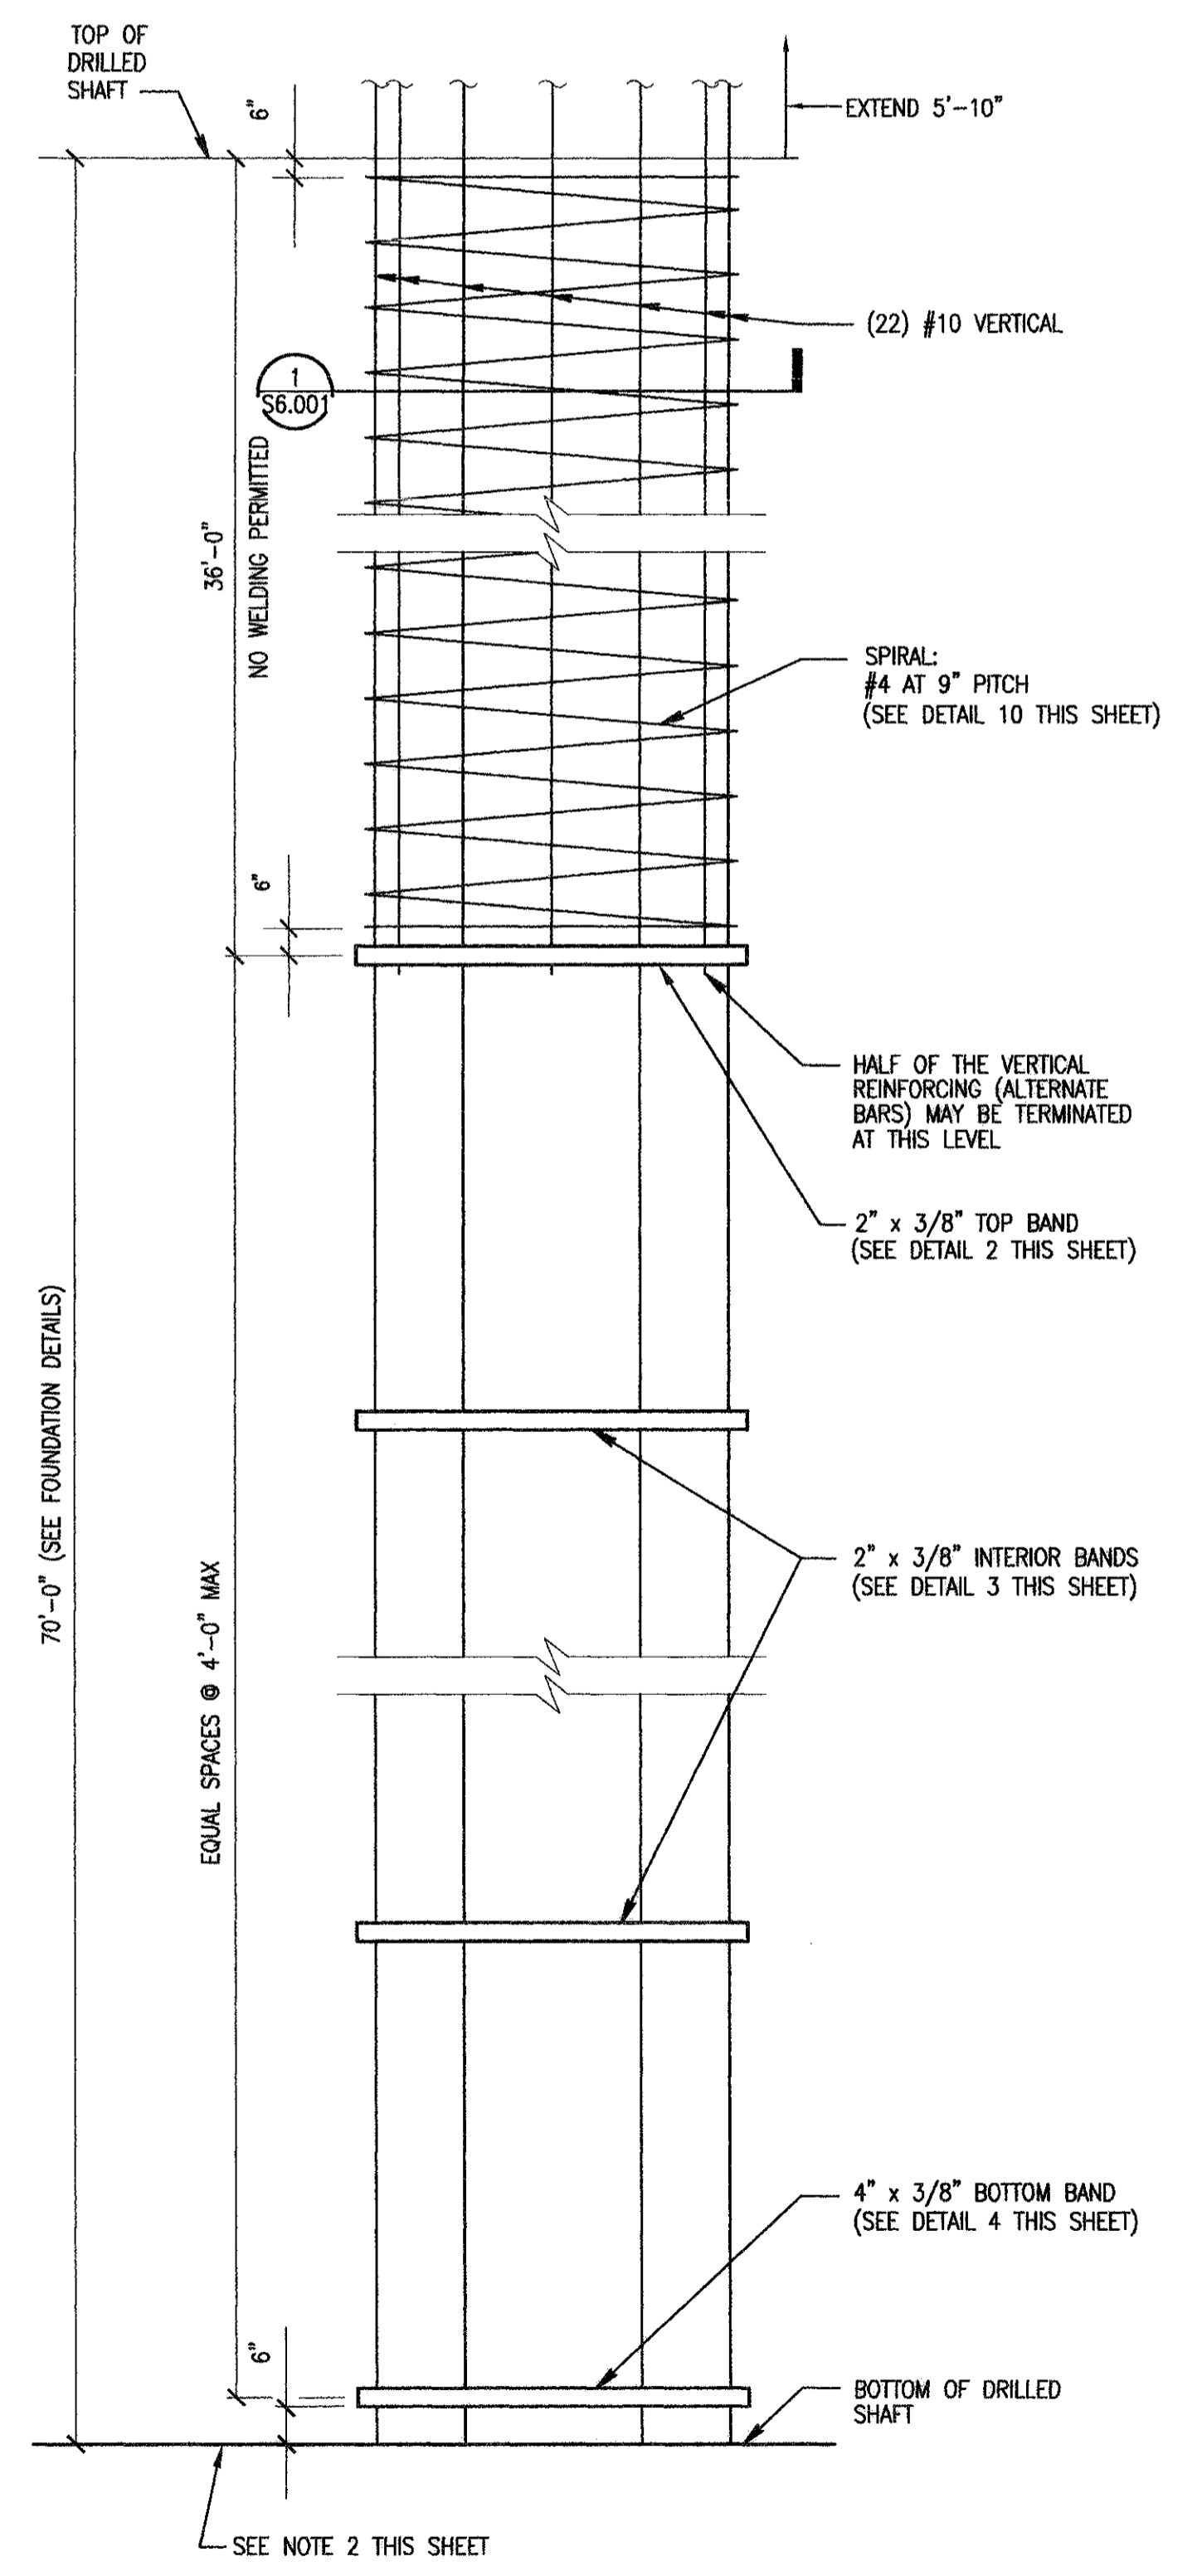


**9 DRILLED SHAFT REINFORCEMENT DETAIL**  
 S6.001 NTS

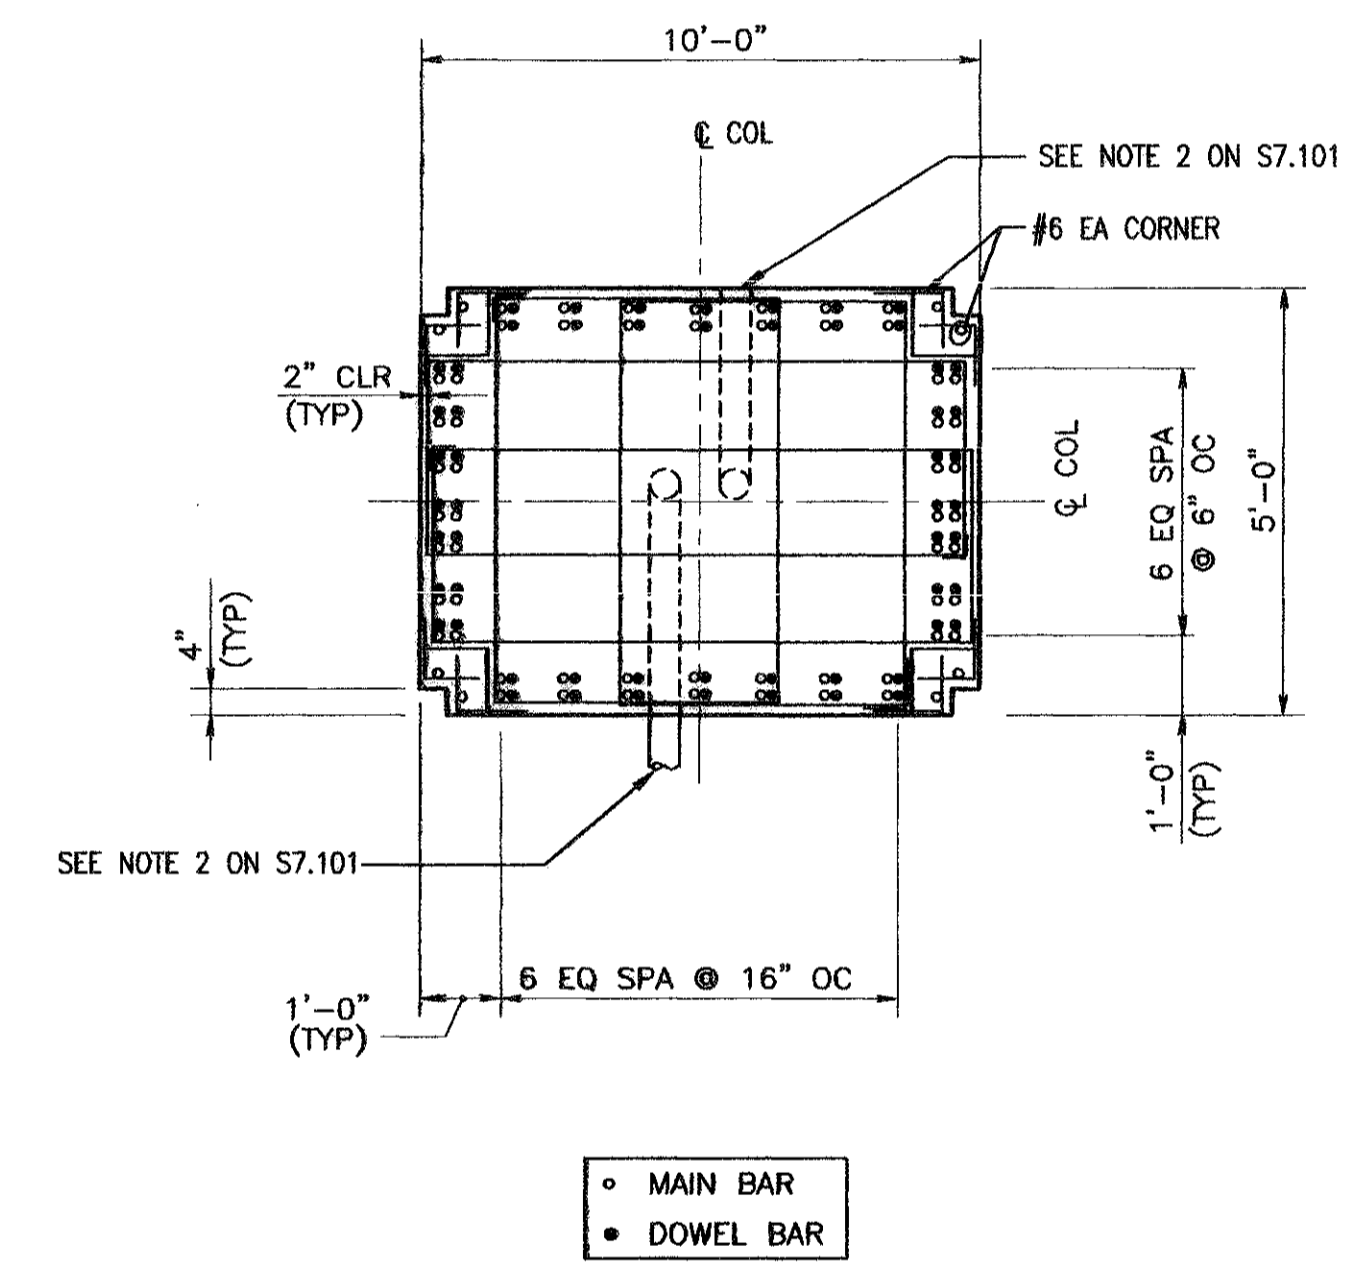

**6 DOWEL ARRANGEMENT DETAIL**  
 S6.001 NTS

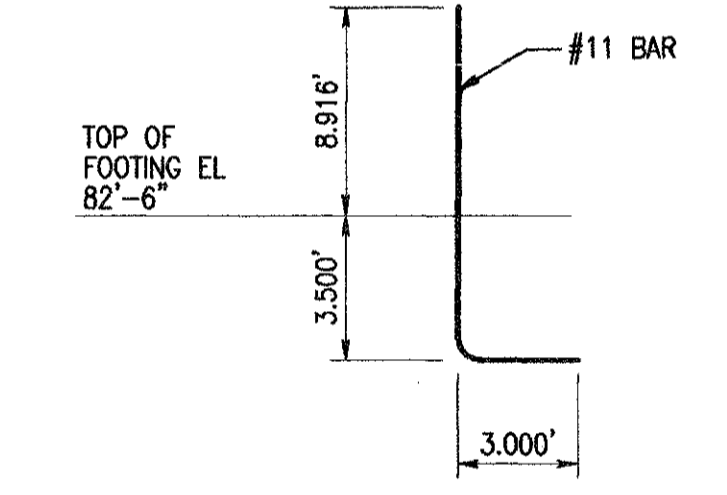


**7 REINFORCING DOWEL DETAIL**  
 S6.001 NTS

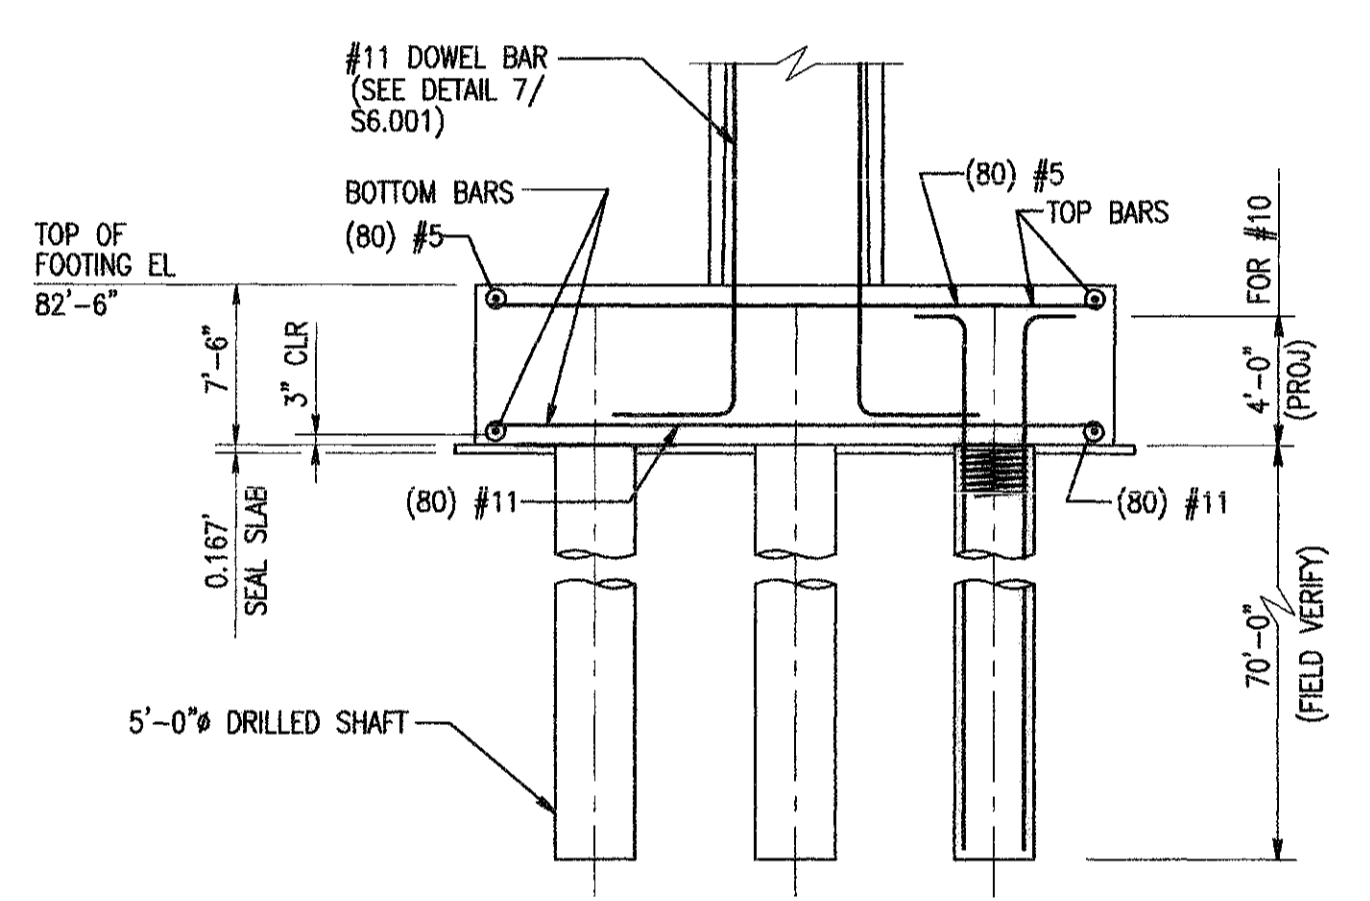


- NOTES:
- REFER TO DWGS S2.001, S6.001 AND SECTIONS 11A/S2 & 12A/S3 FOR ADDITIONAL INFORMATION.
  - AFTER CONCRETING ANY DRILLED PIER ALLOW A SEVEN DAY PERIOD BEFORE DRILLING ADJACENT PIERS.


**8 SECTION**  
 S6.001 NTS

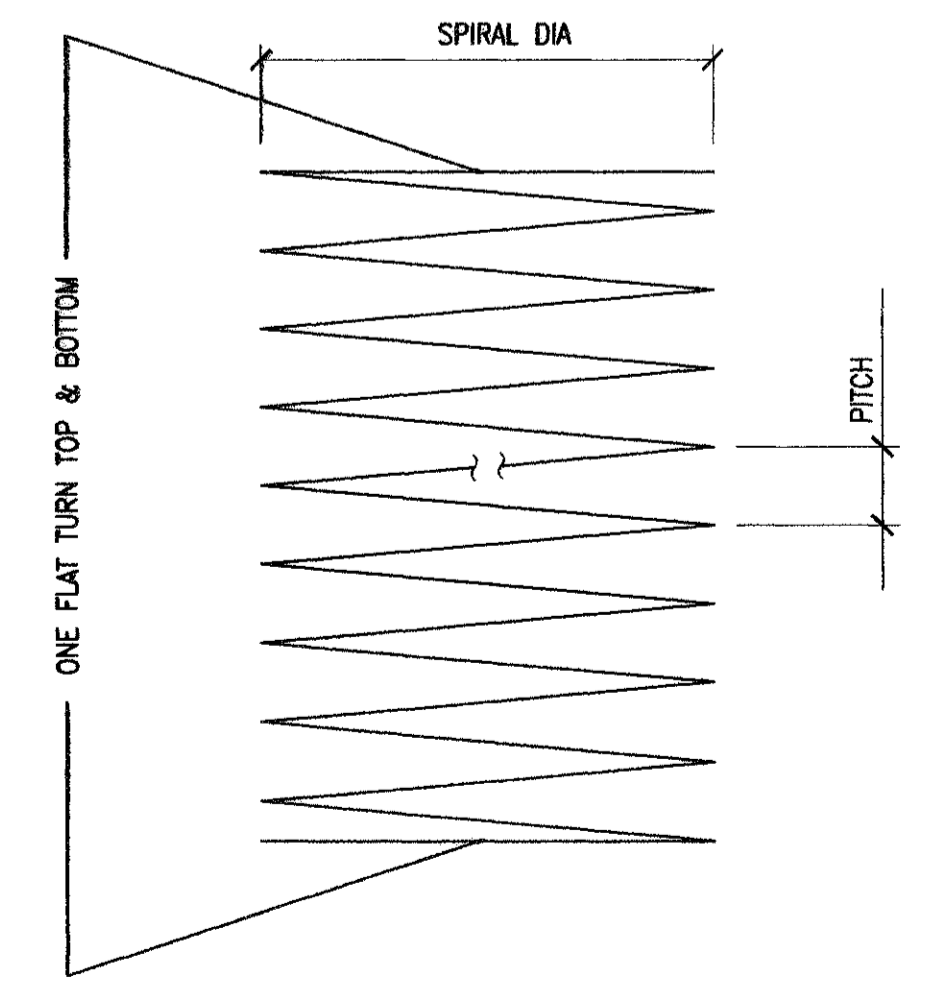

**10 SPIRAL DETAILS**  
 S6.001 NTS

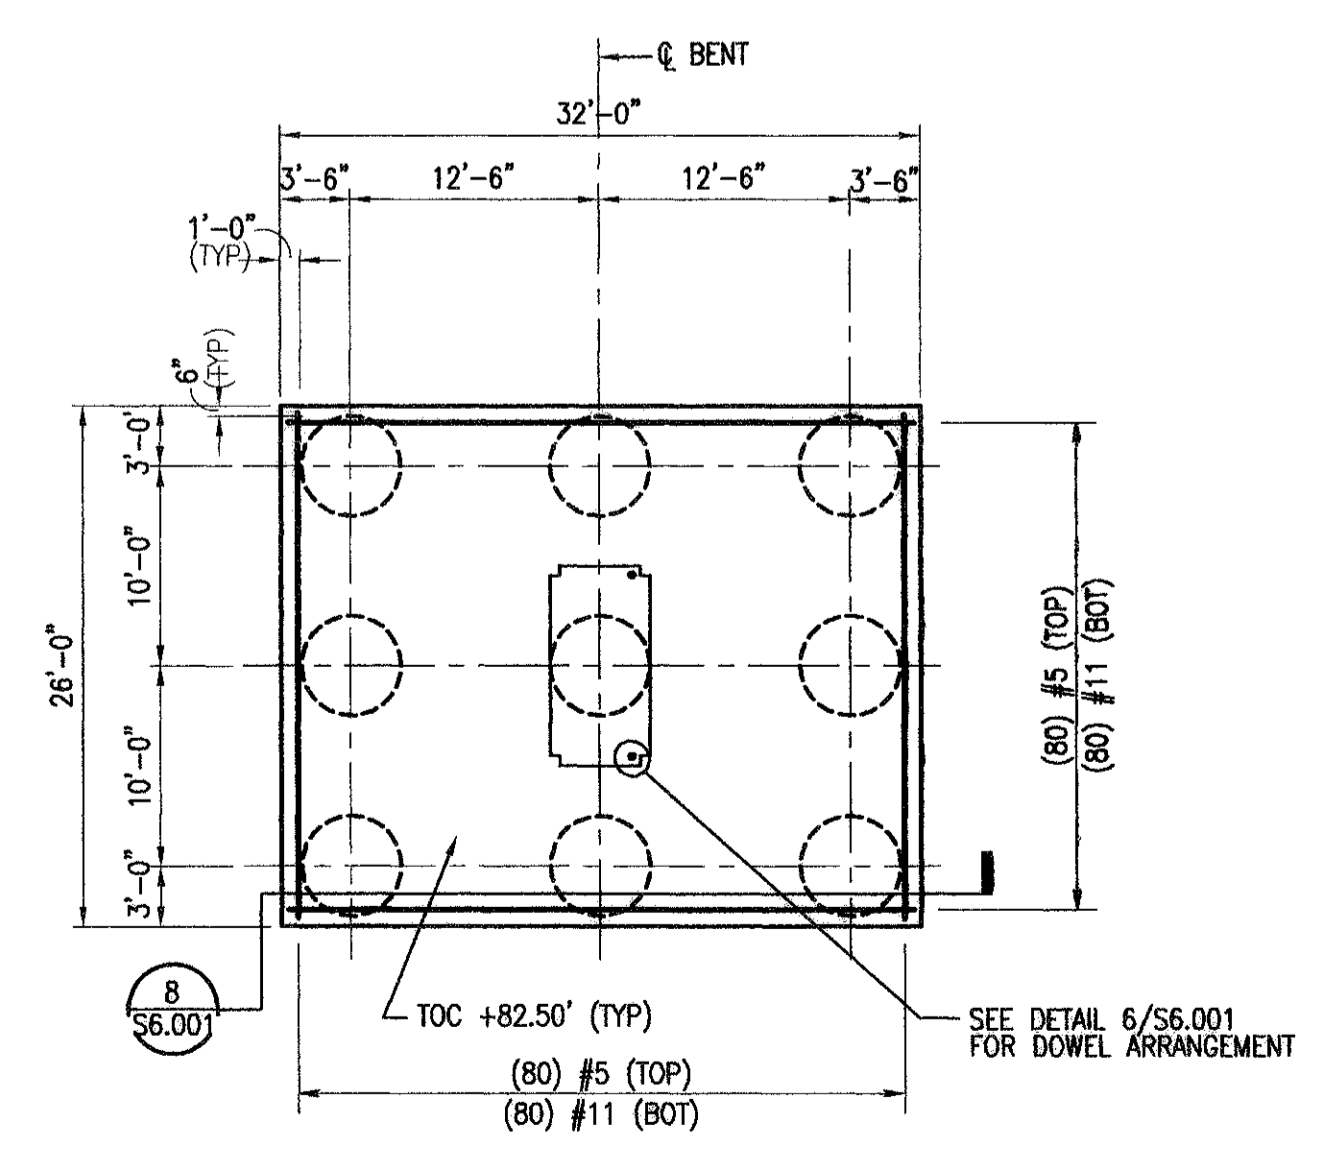


**11 FOOTING PLAN FOR BENT #47, #48 & #50**  
 S6.001 NTS

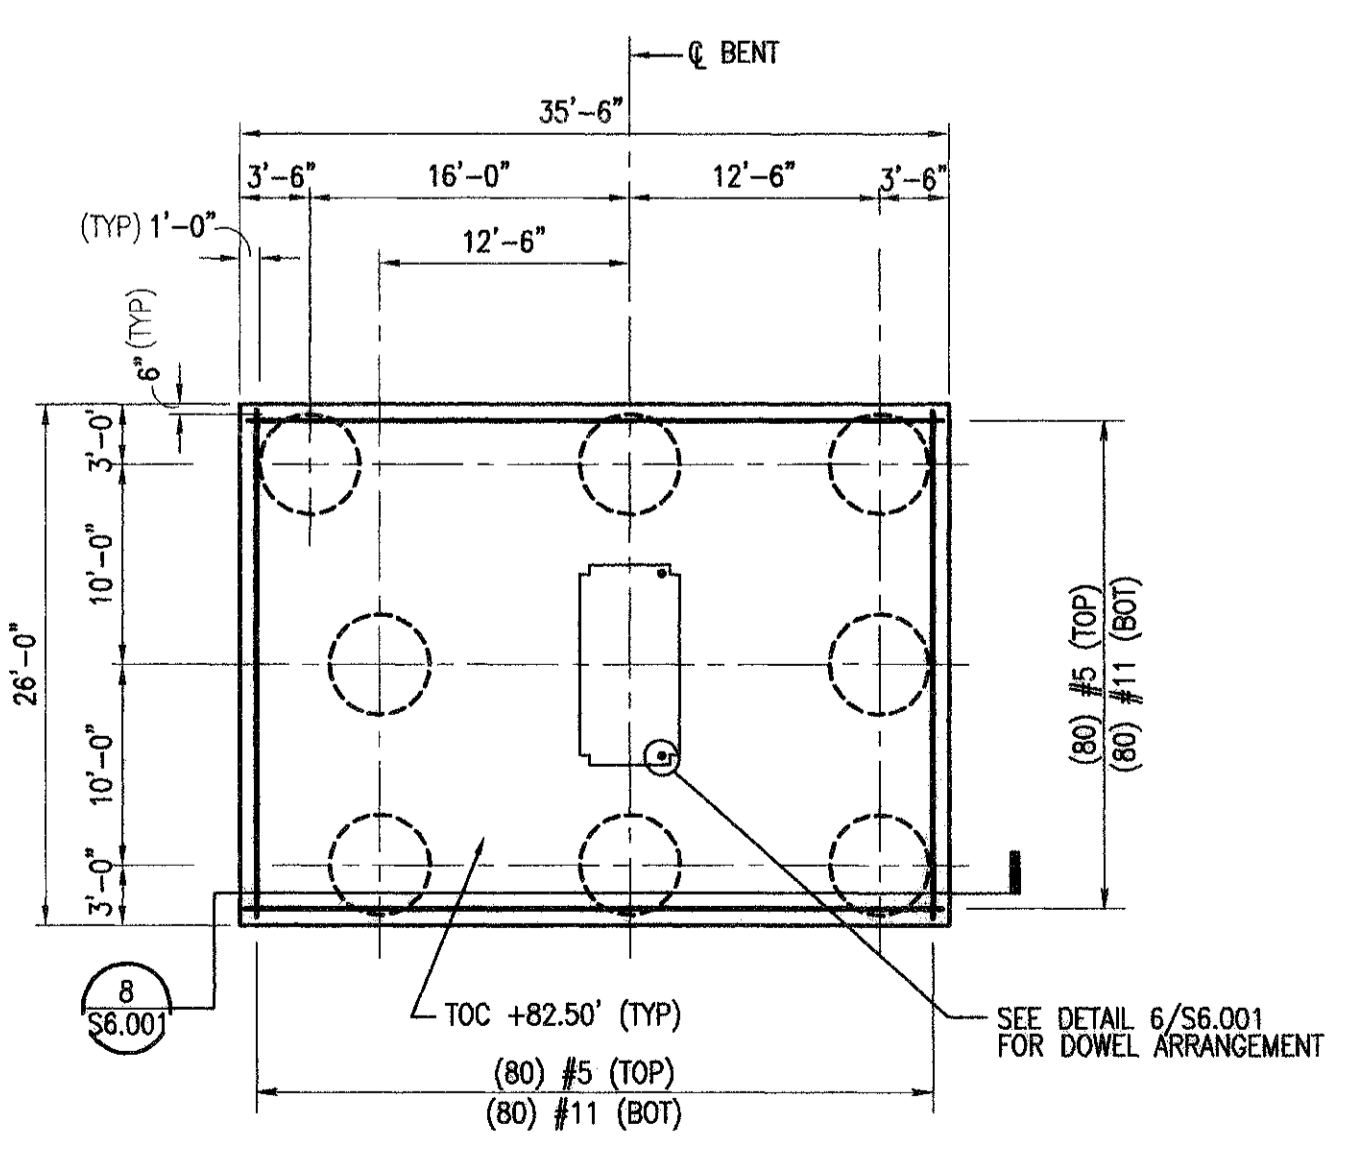


**12 FOOTING PLAN FOR BENT #49**  
 S6.001 NTS

PLOT DATE: 10/19/01 HAS RELEASES/REVISIONS




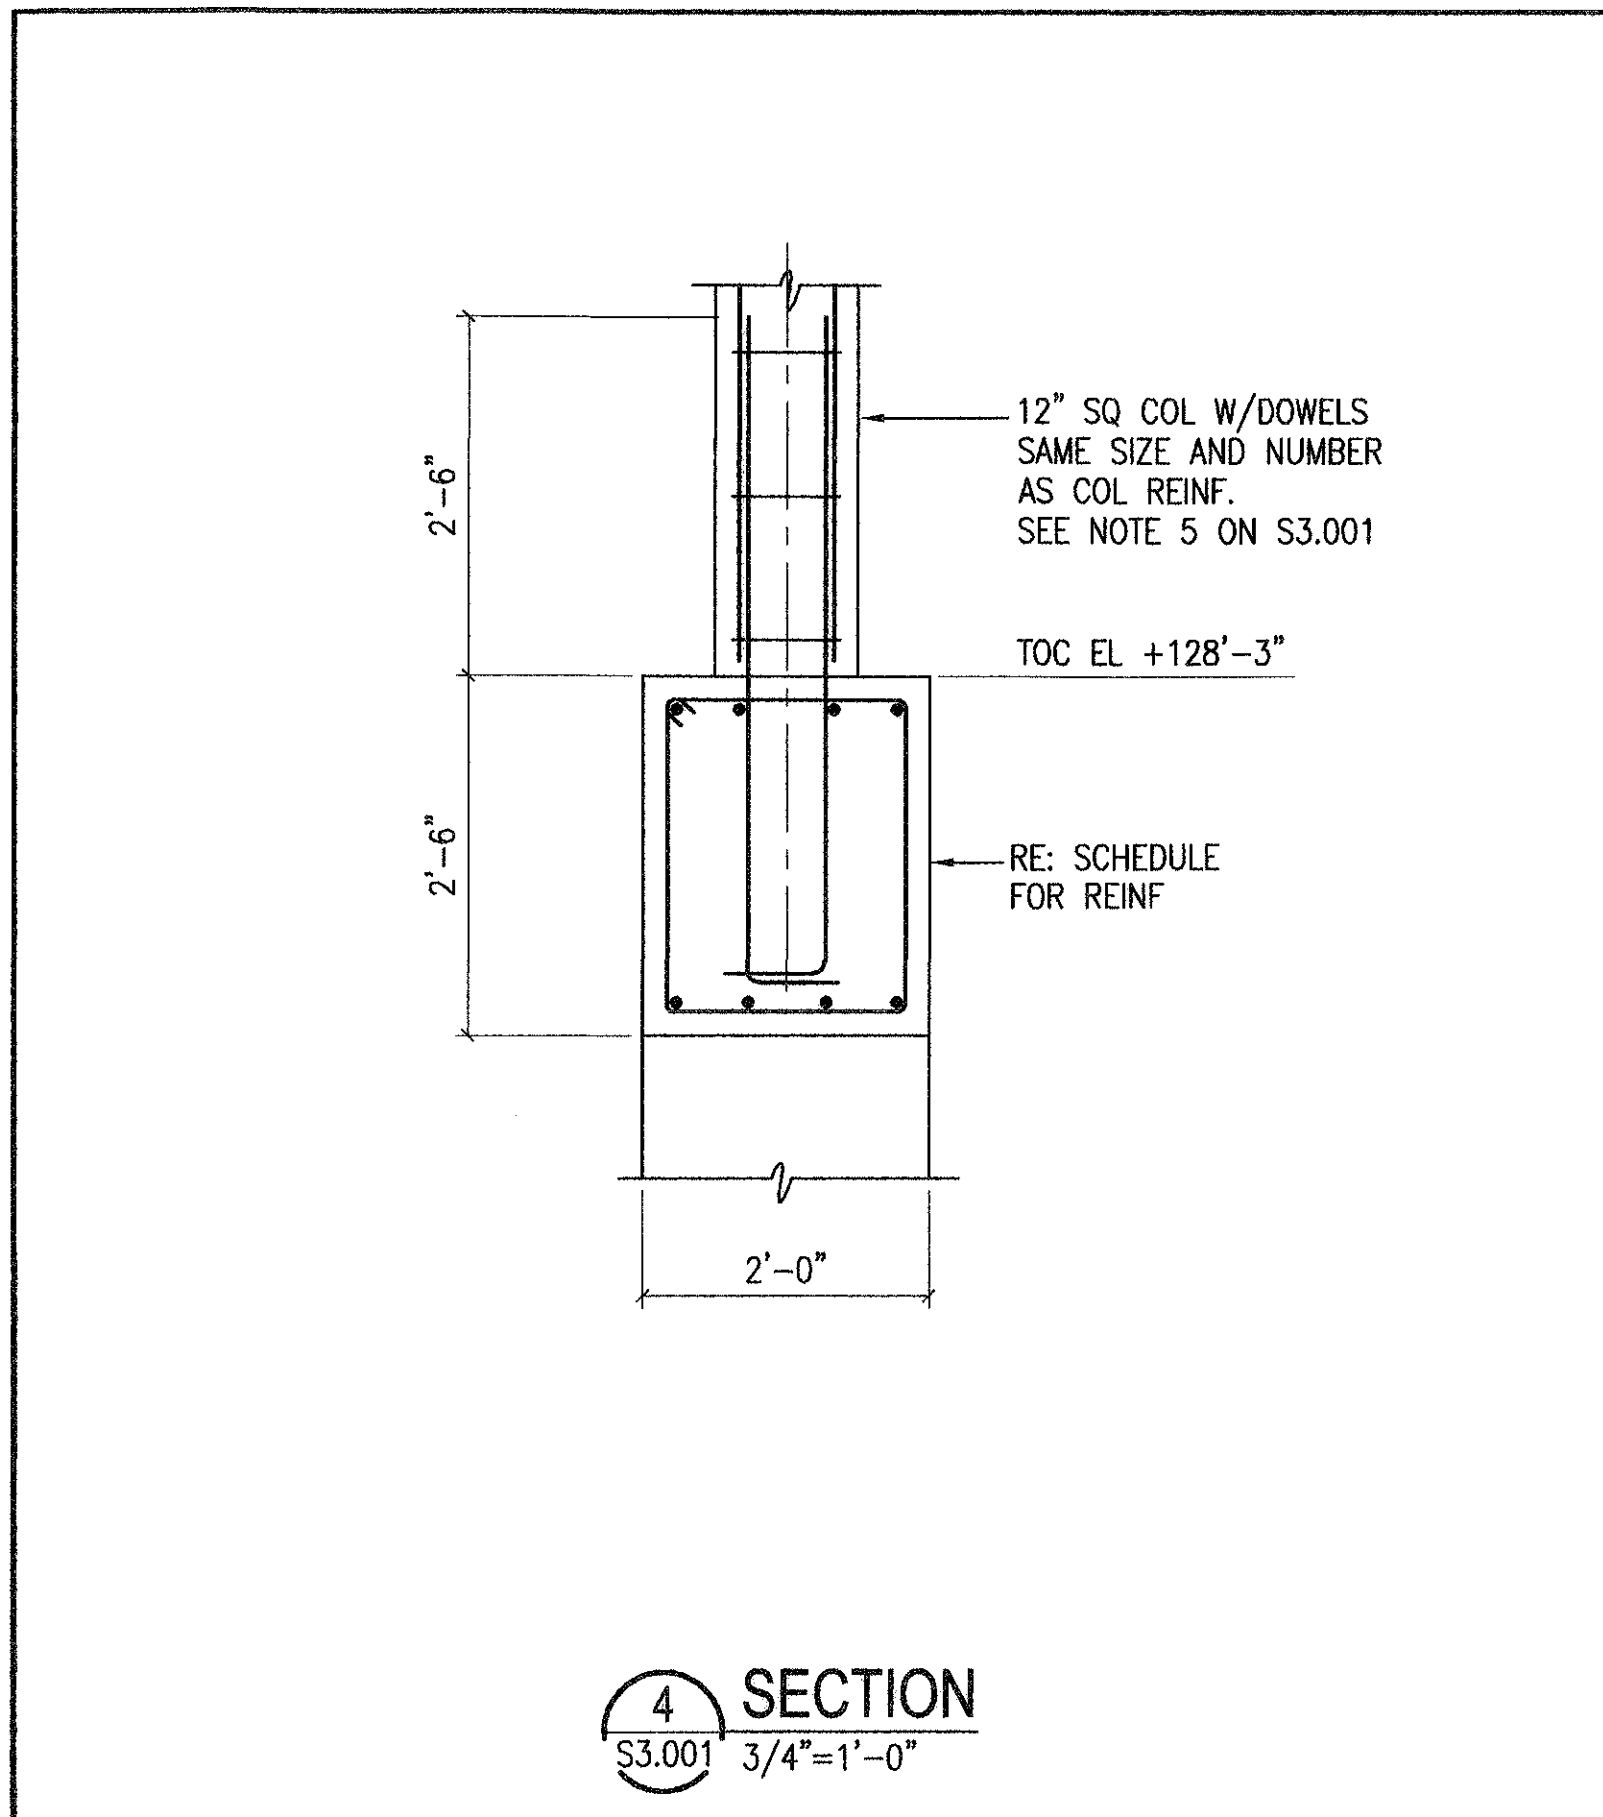


SECTION 4  
S3.001 3/4"=1'-0"

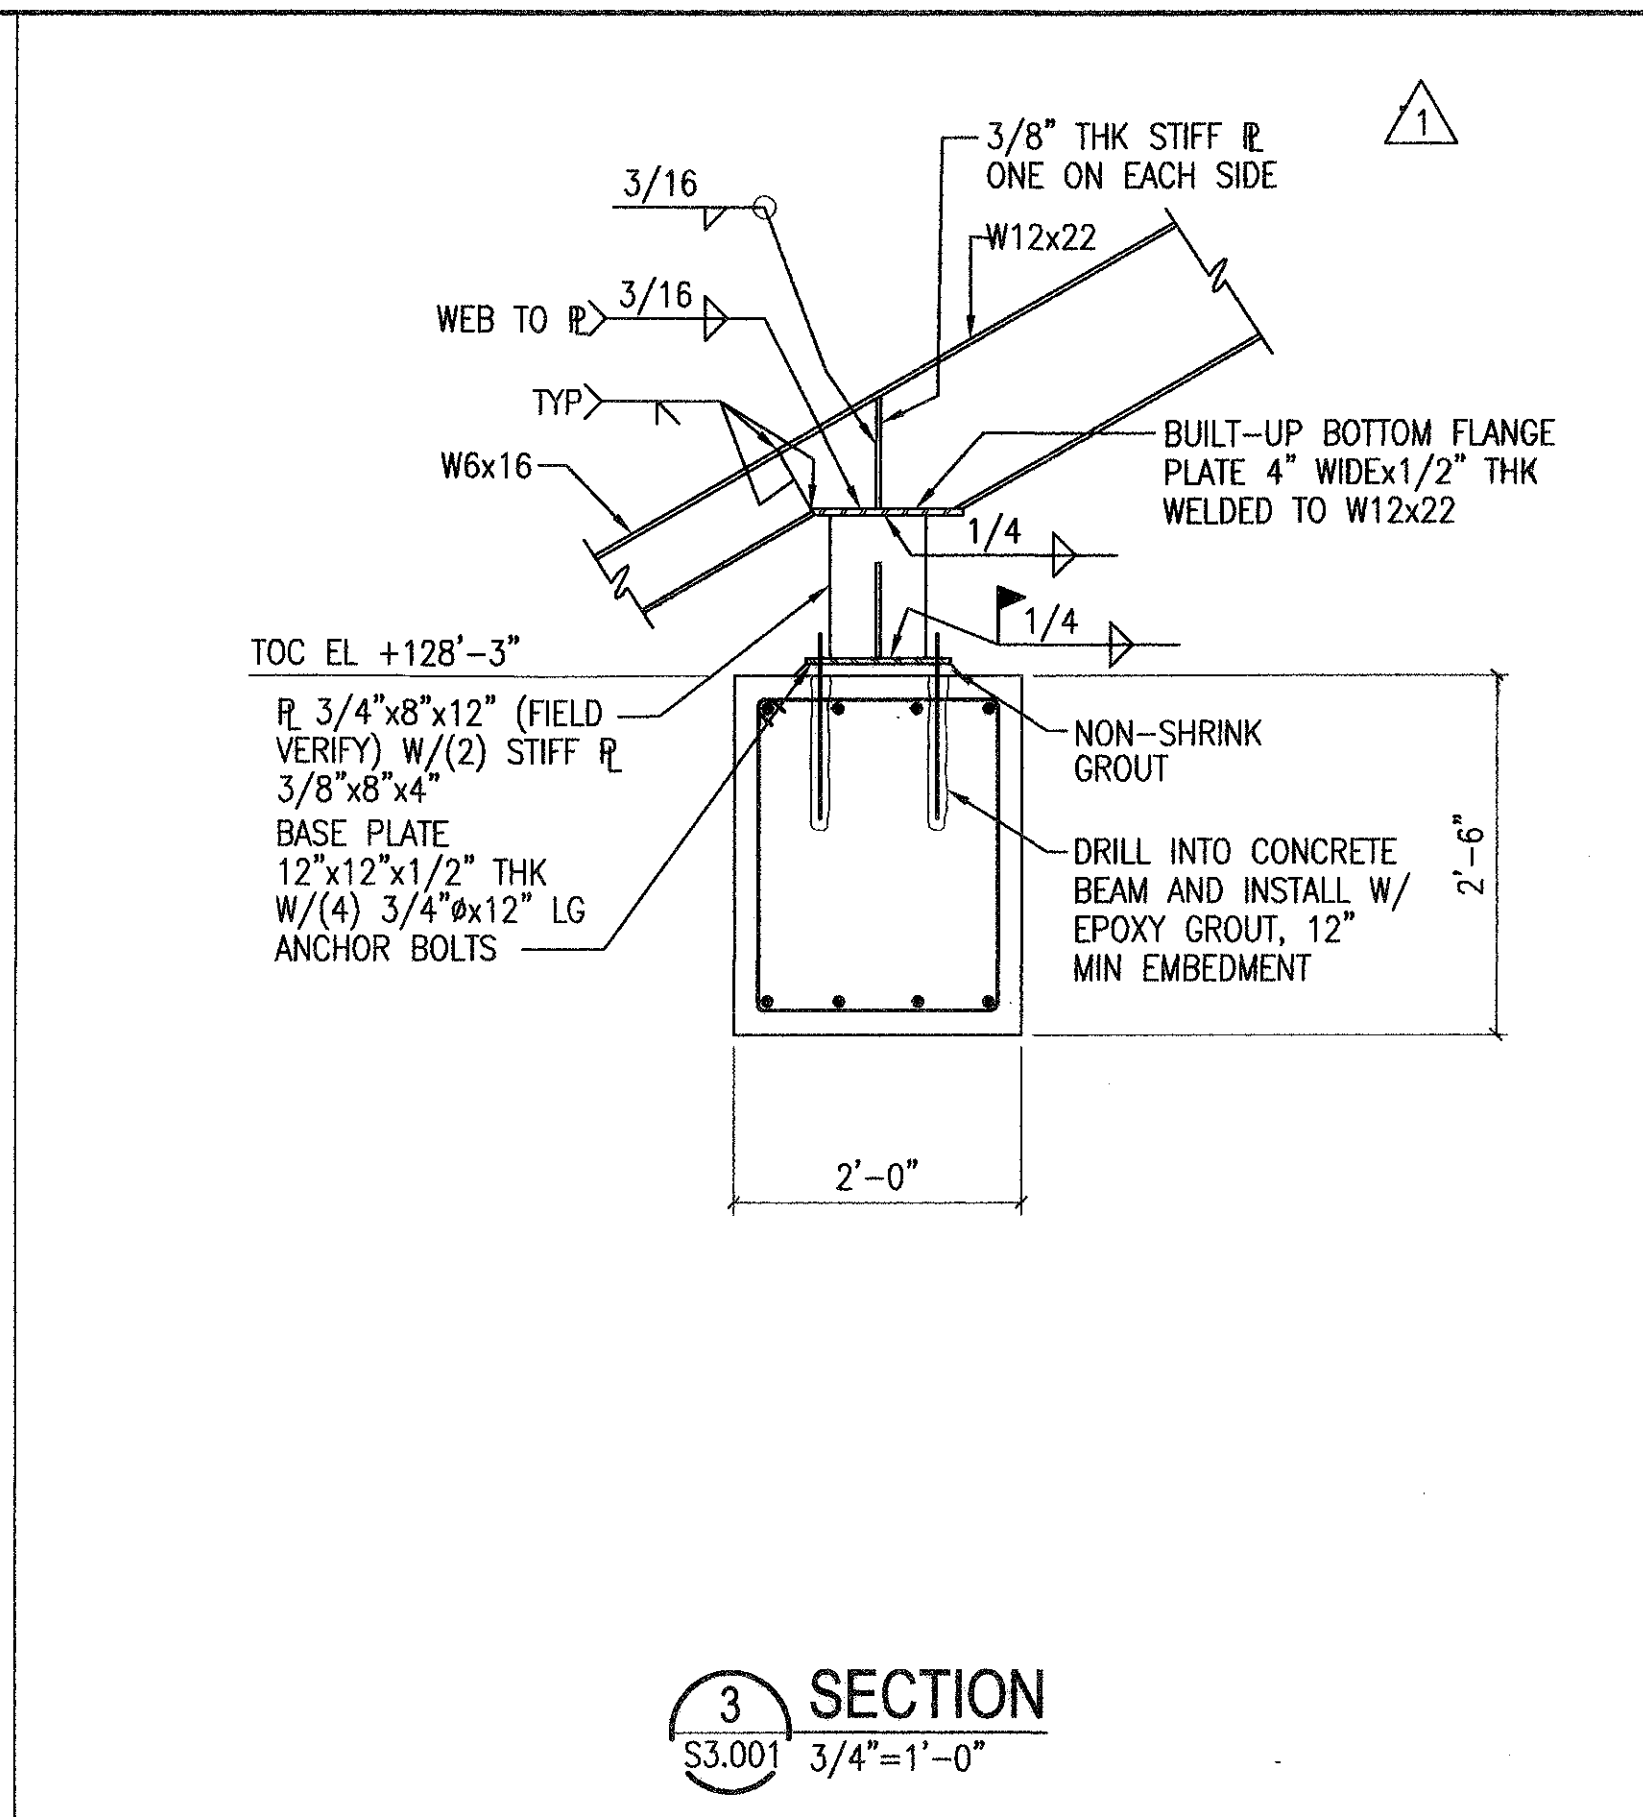


SECTION 3  
S3.001 3/4"=1'-0"

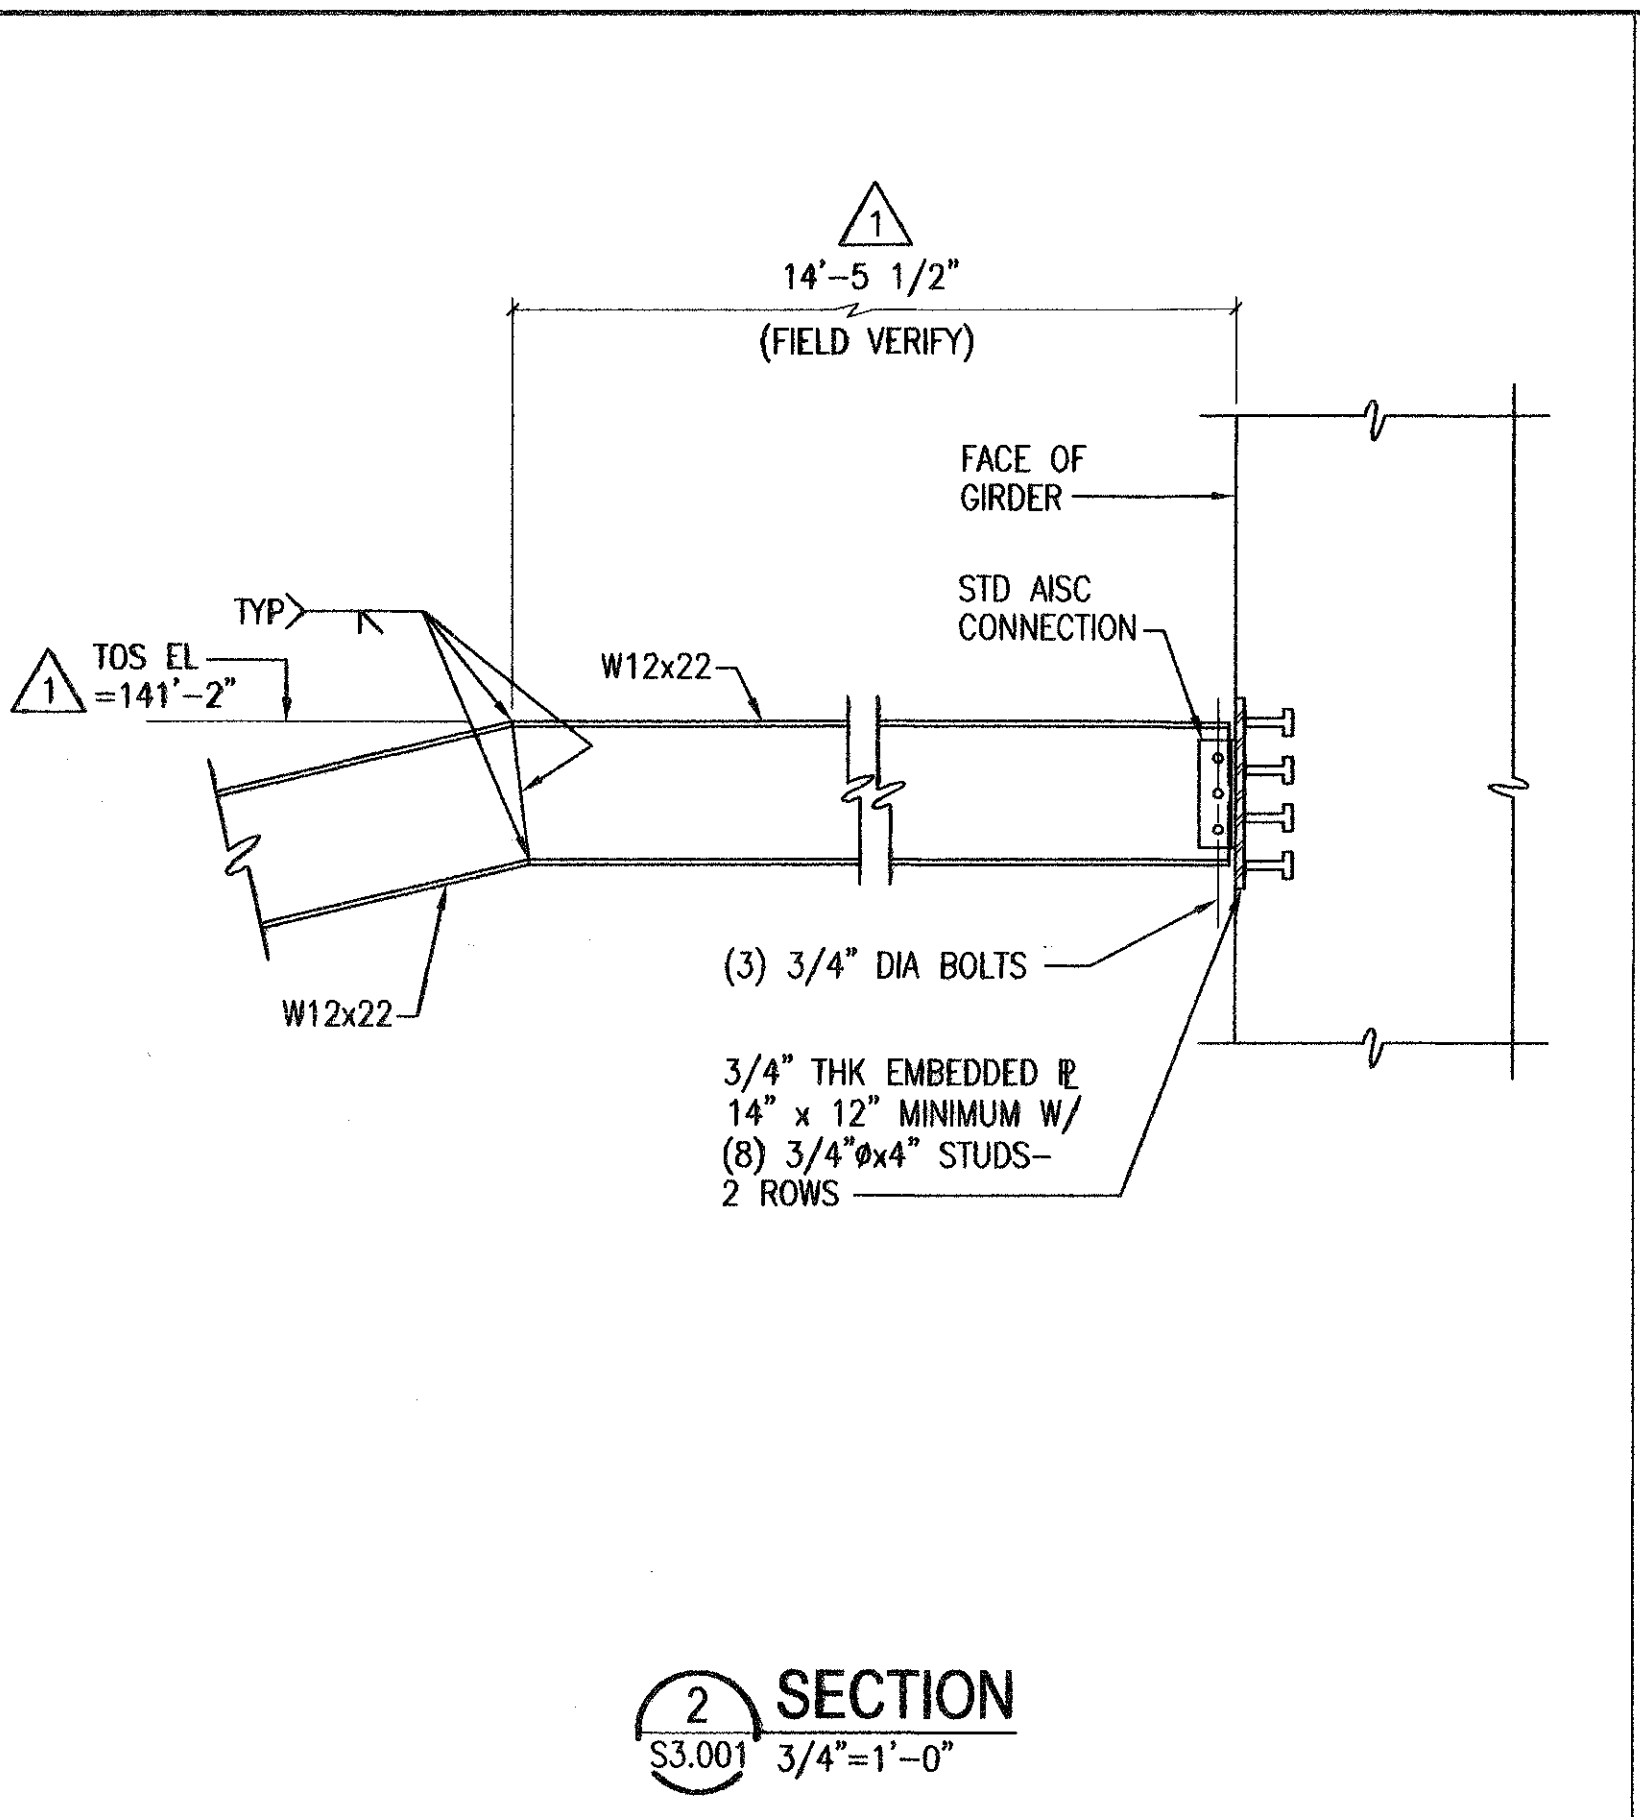


SECTION 2  
S3.001 3/4"=1'-0"

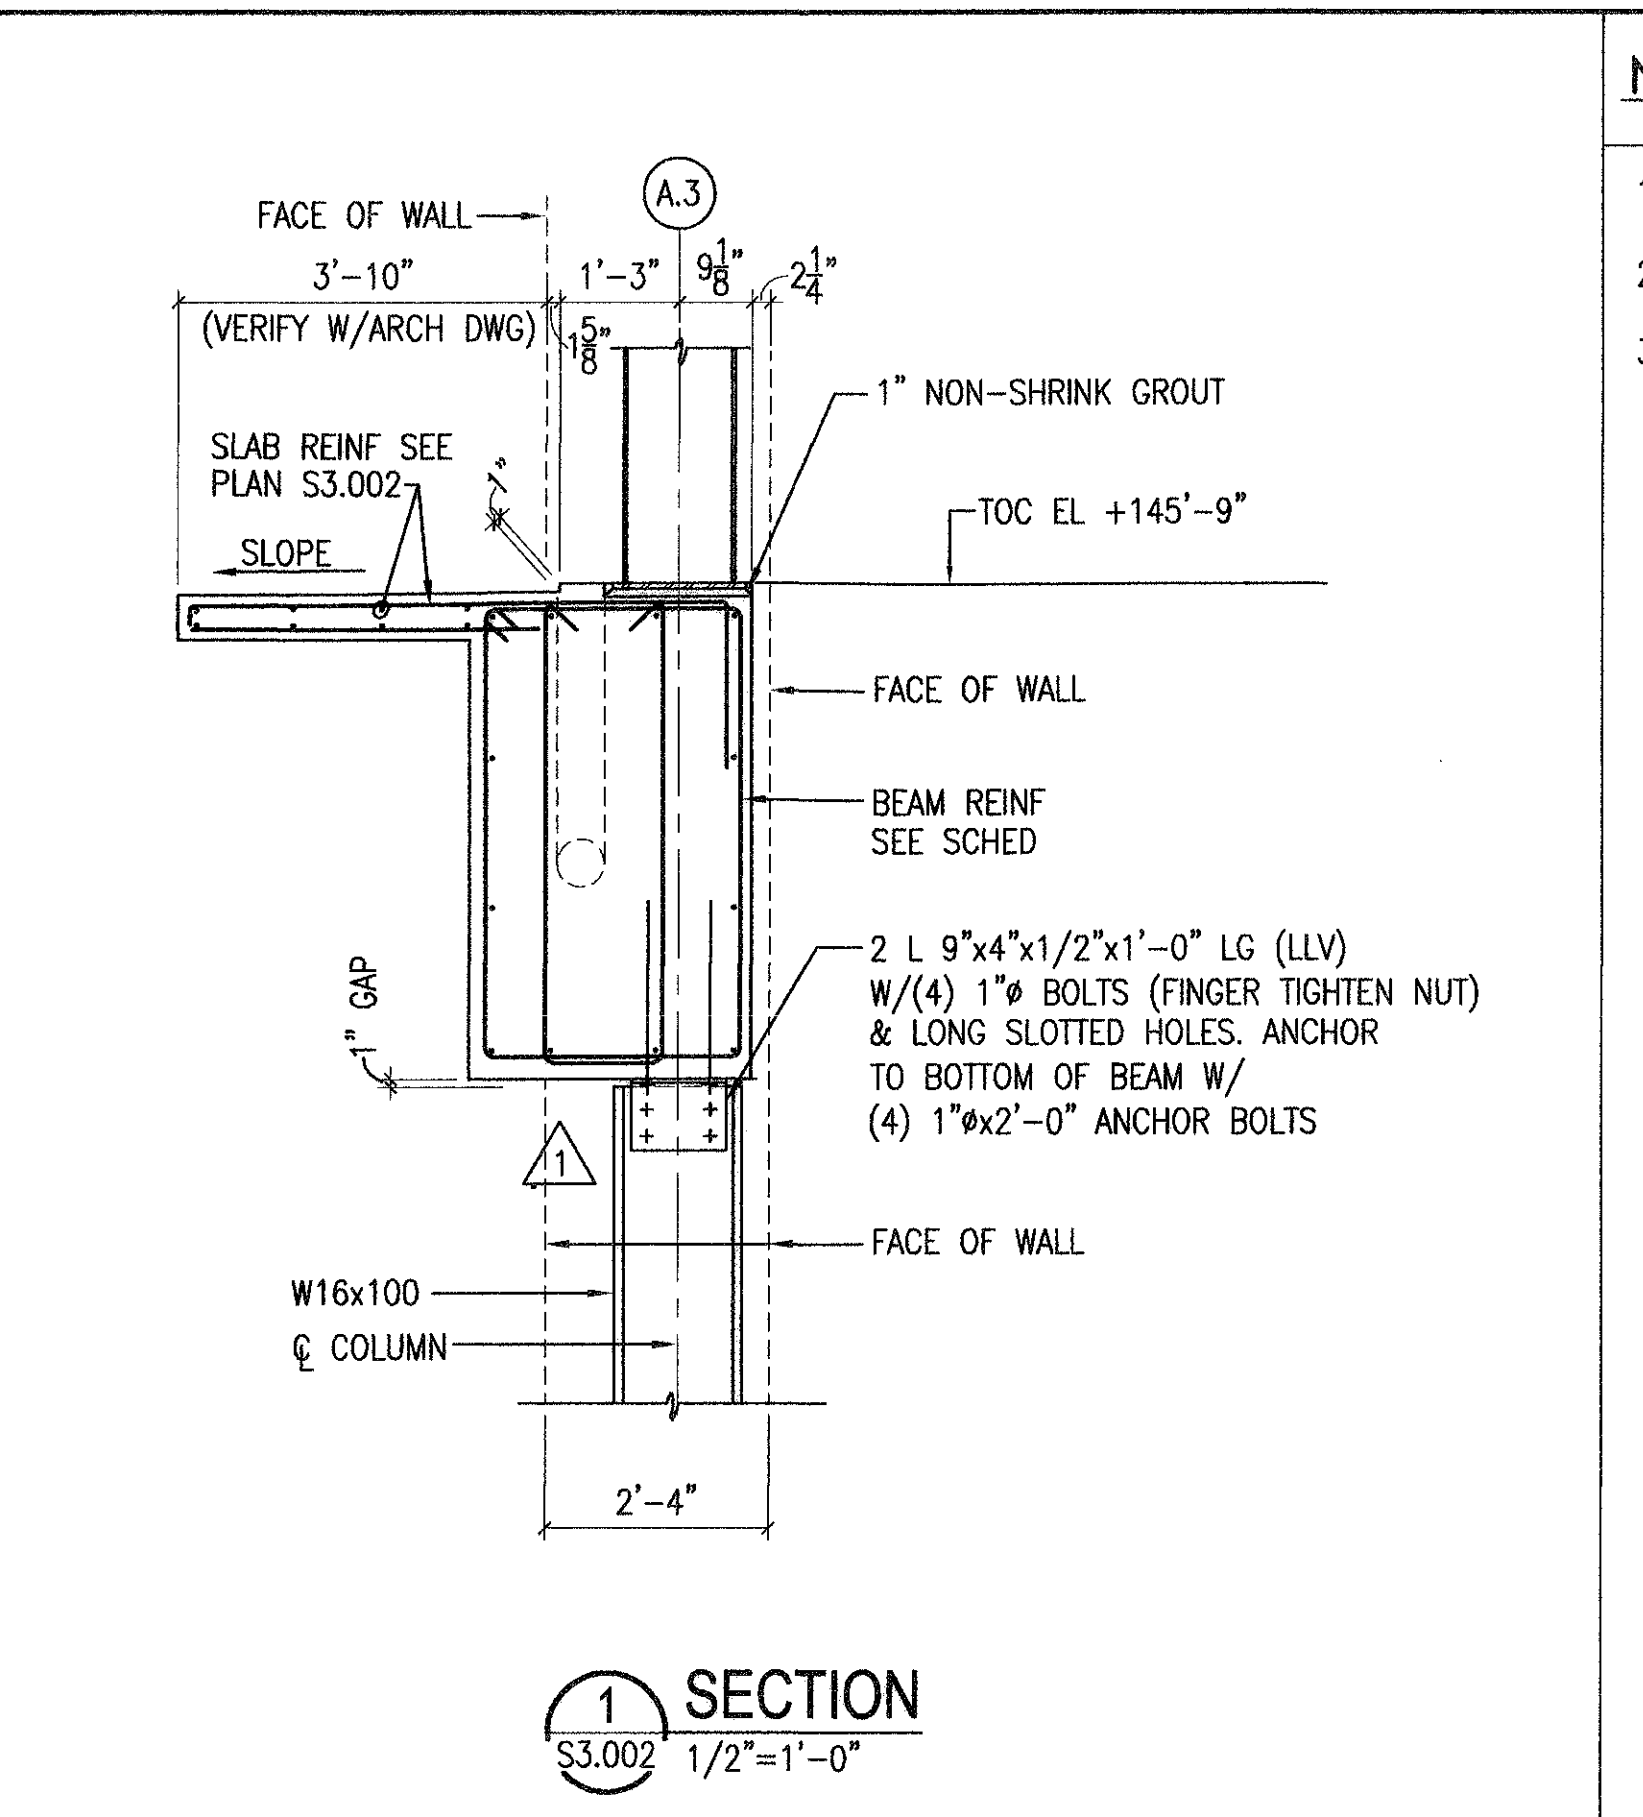


SECTION 1  
S3.002 1/2"=1'-0"

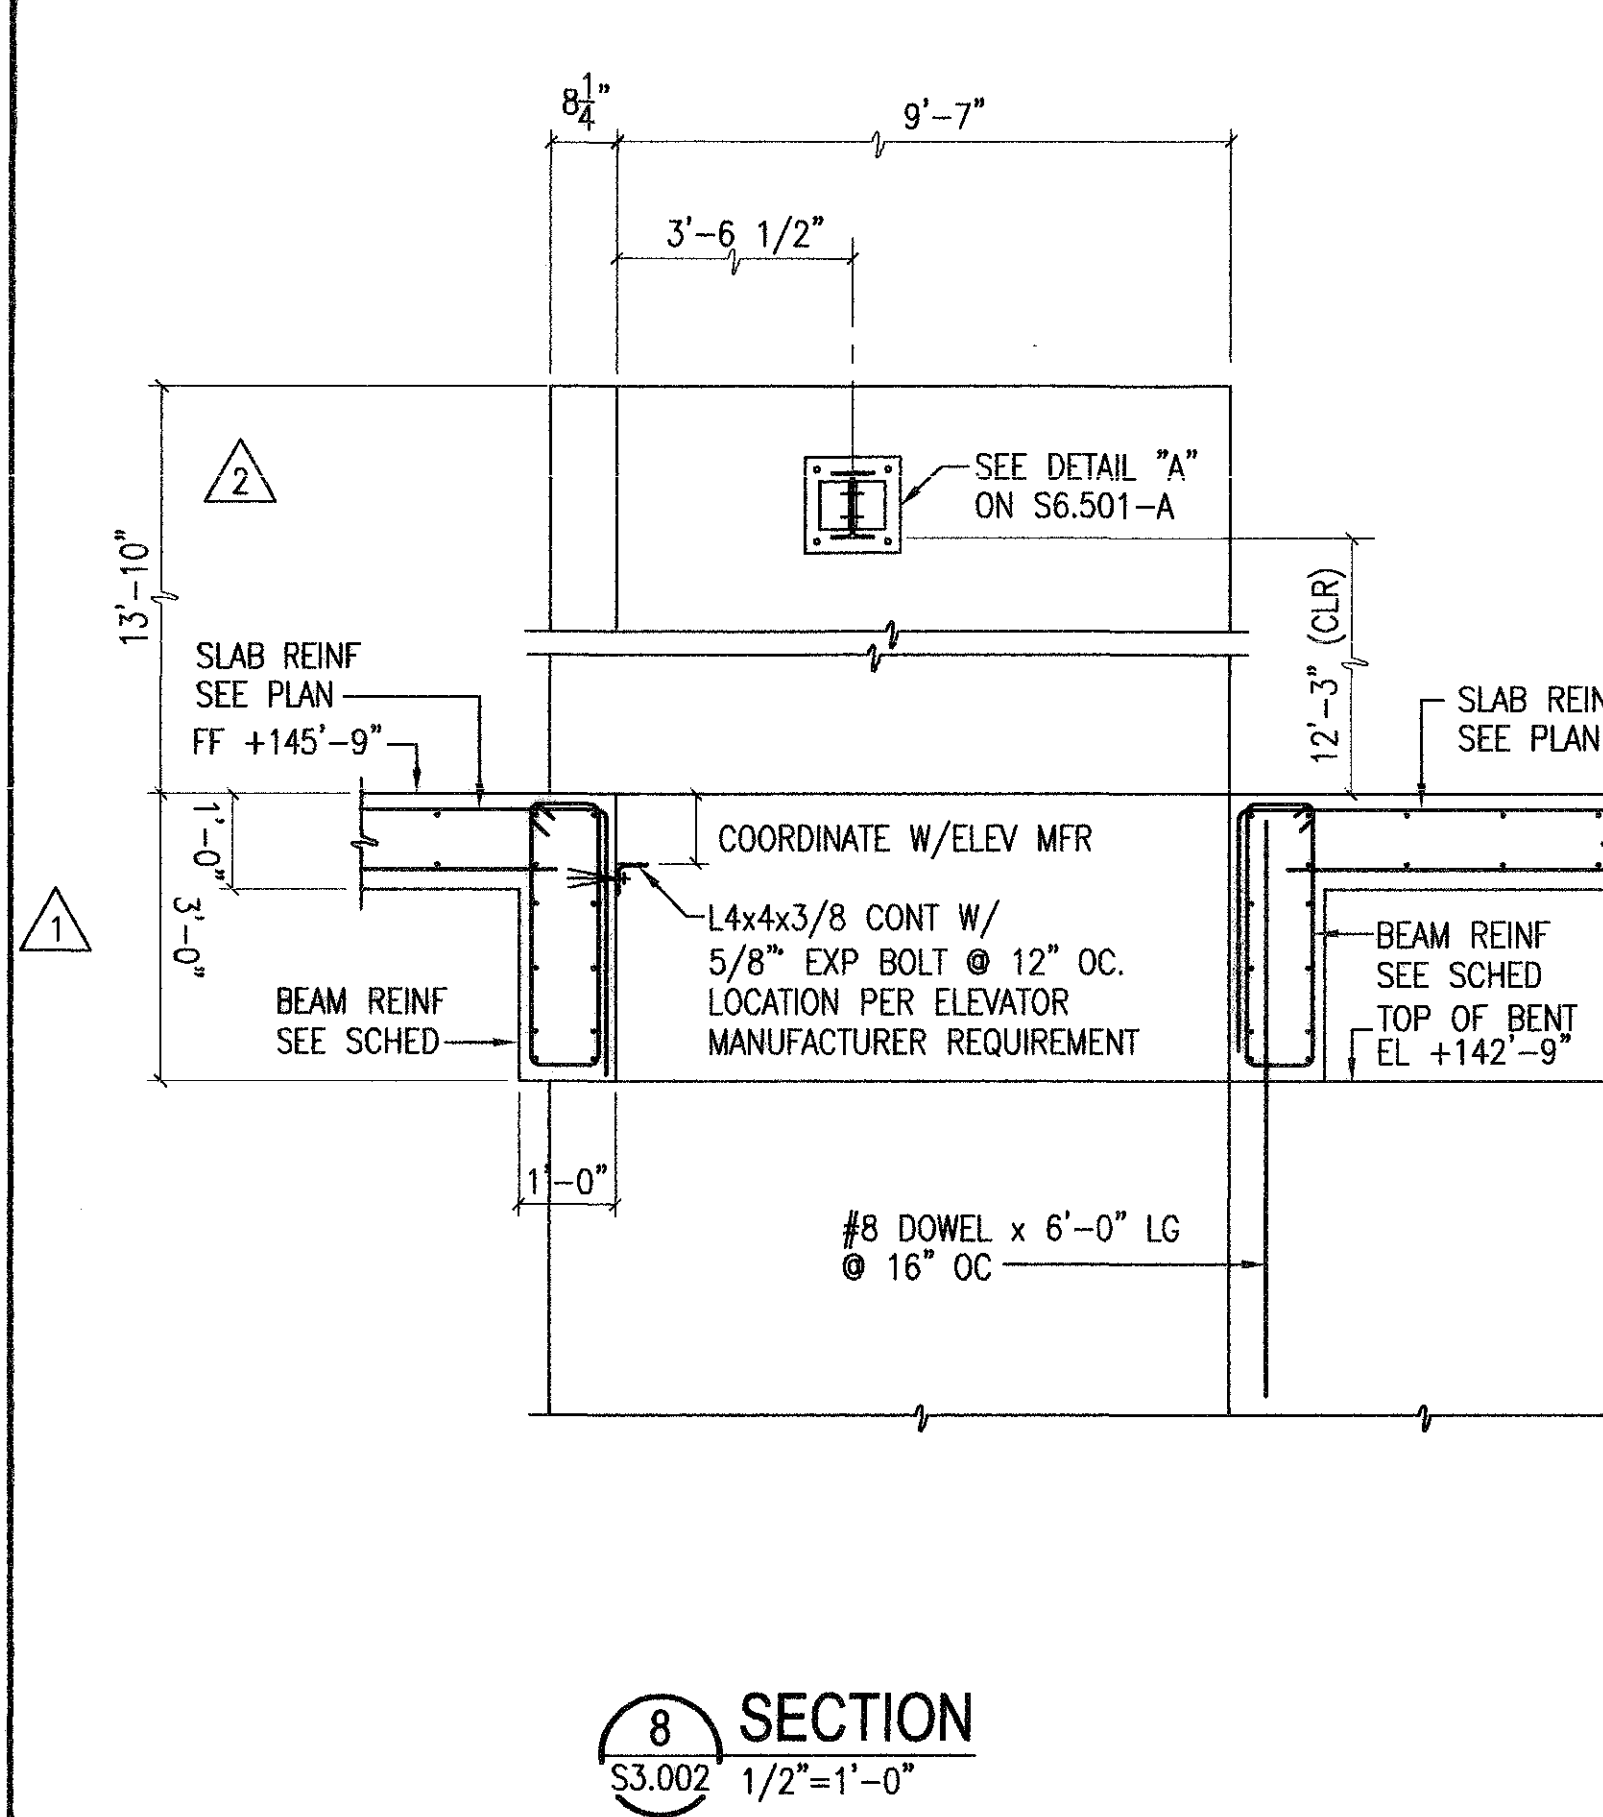


SECTION 8  
S3.002 1/2"=1'-0"

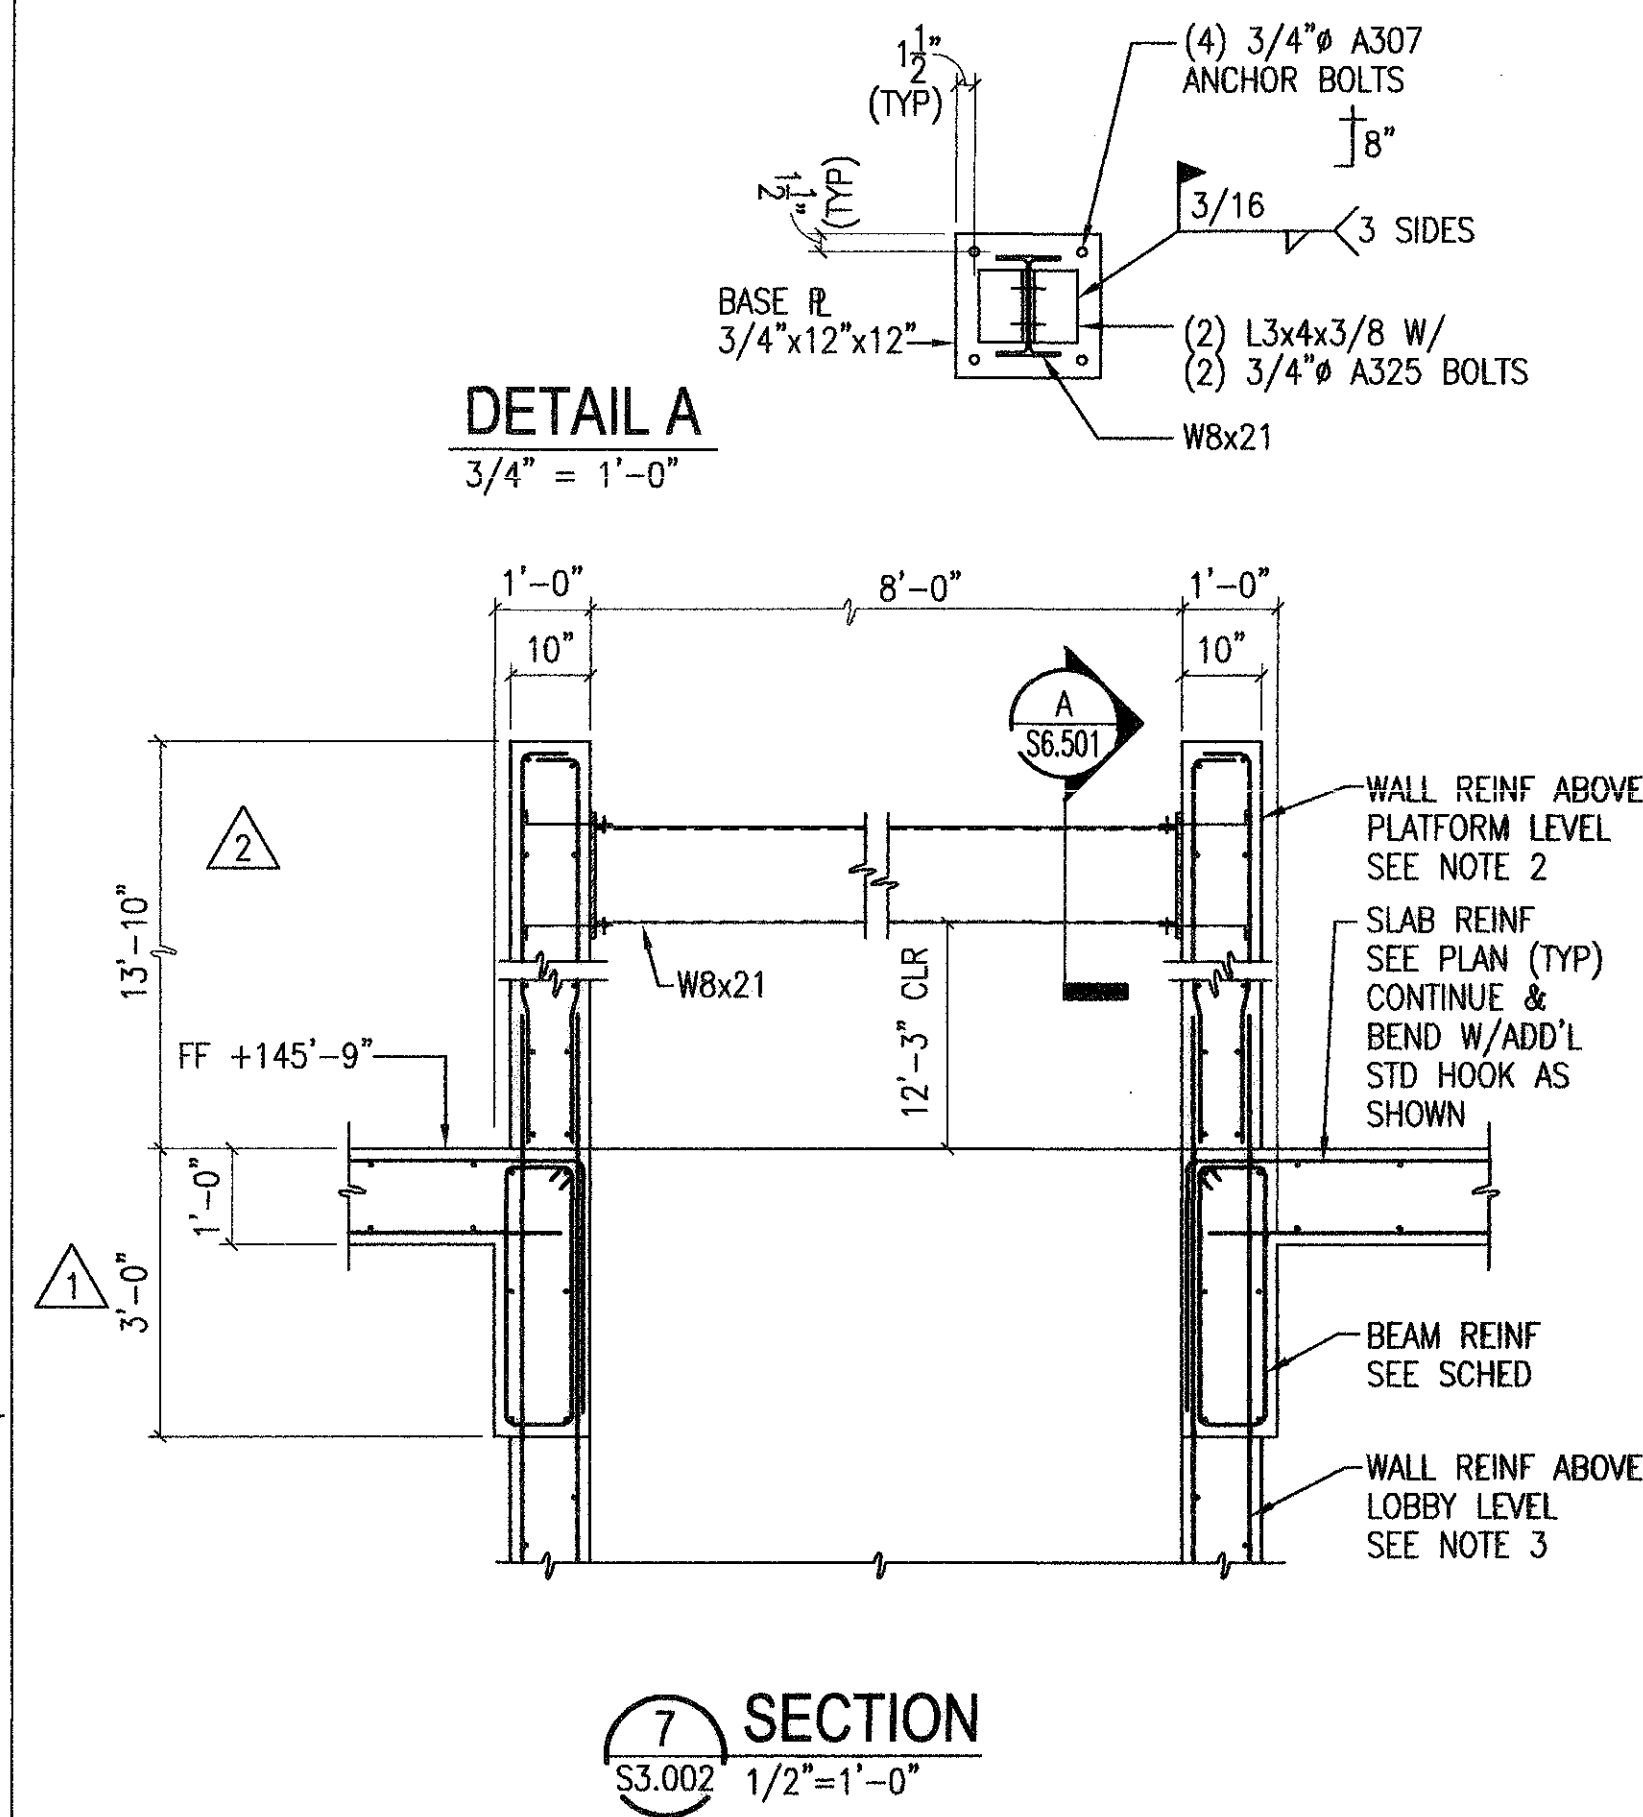


SECTION 7  
S3.002 1/2"=1'-0"

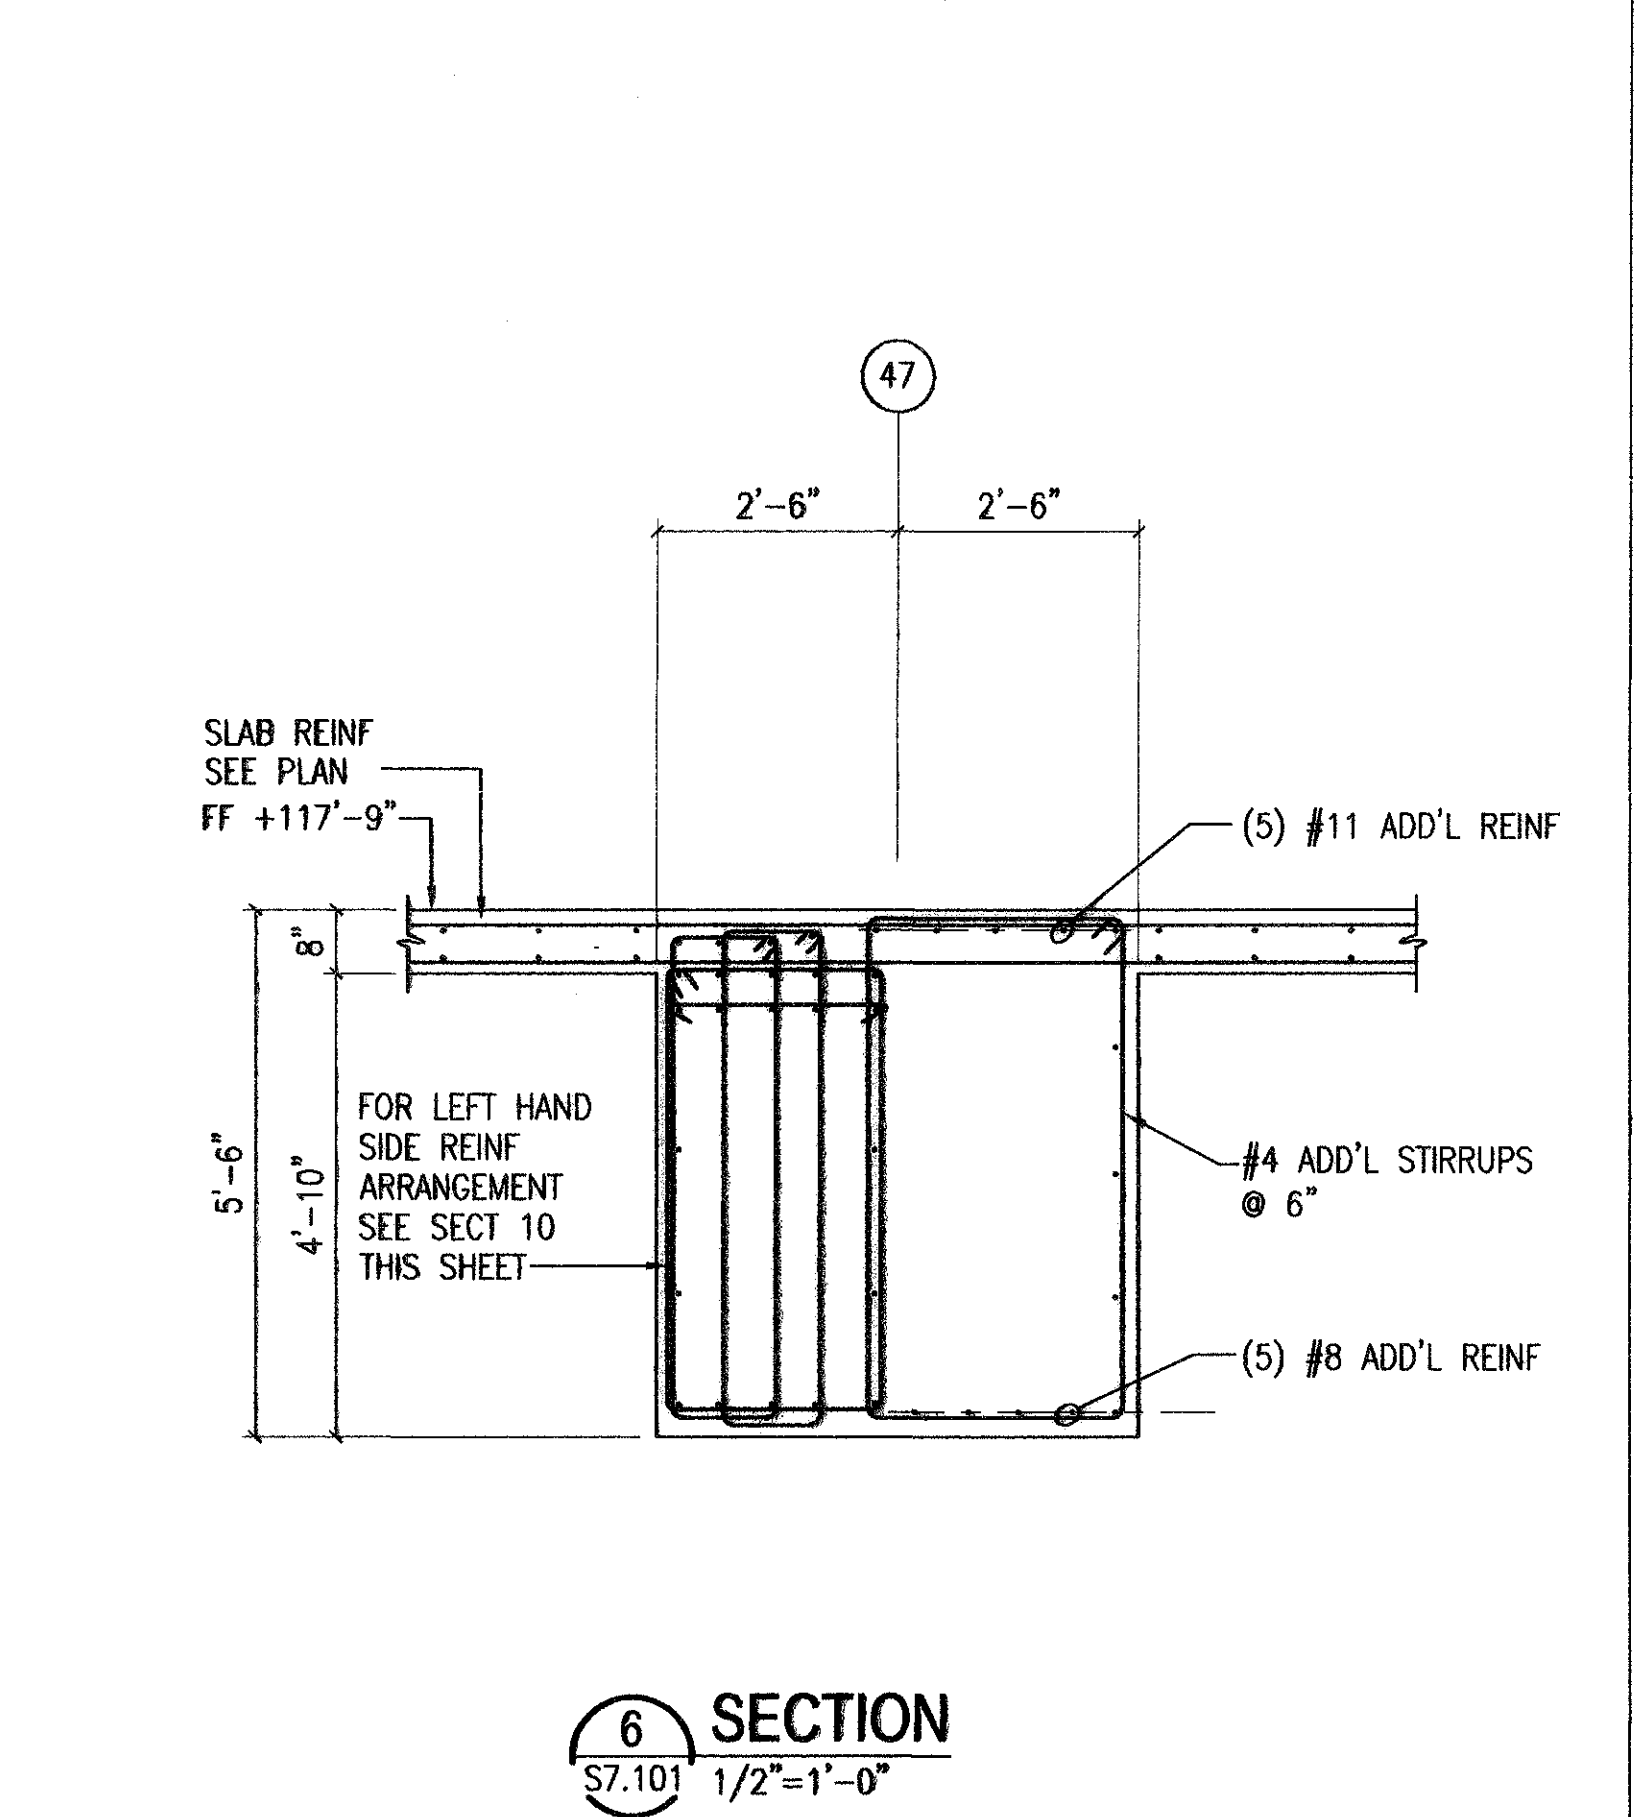


SECTION 6  
S7.101 1/2"=1'-0"

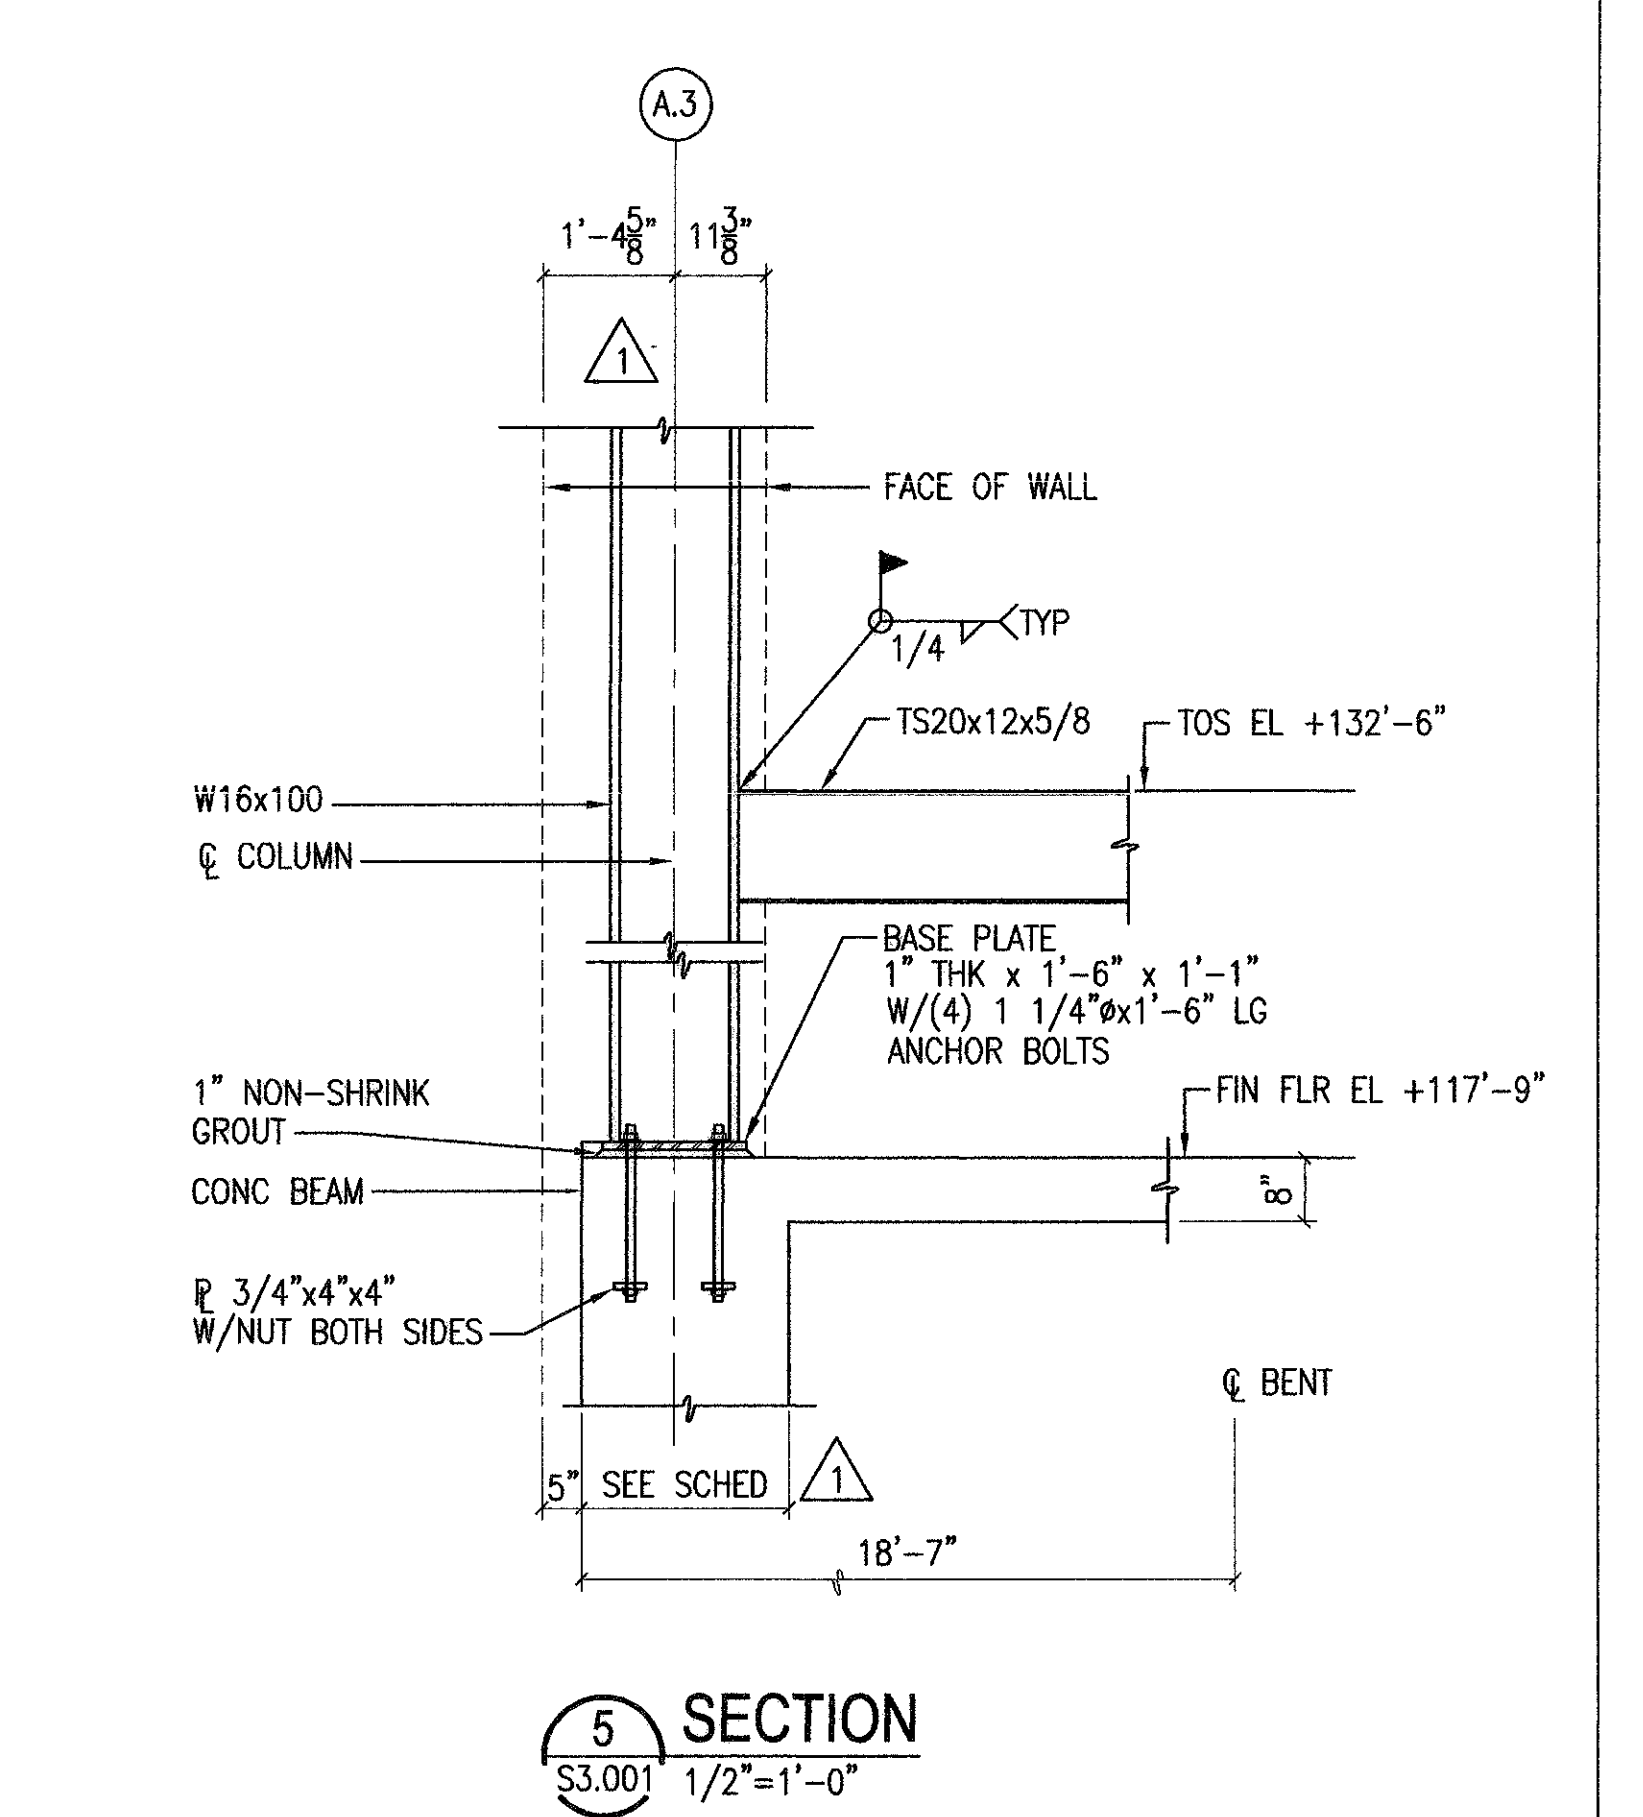


SECTION 5  
S3.001 1/2"=1'-0"

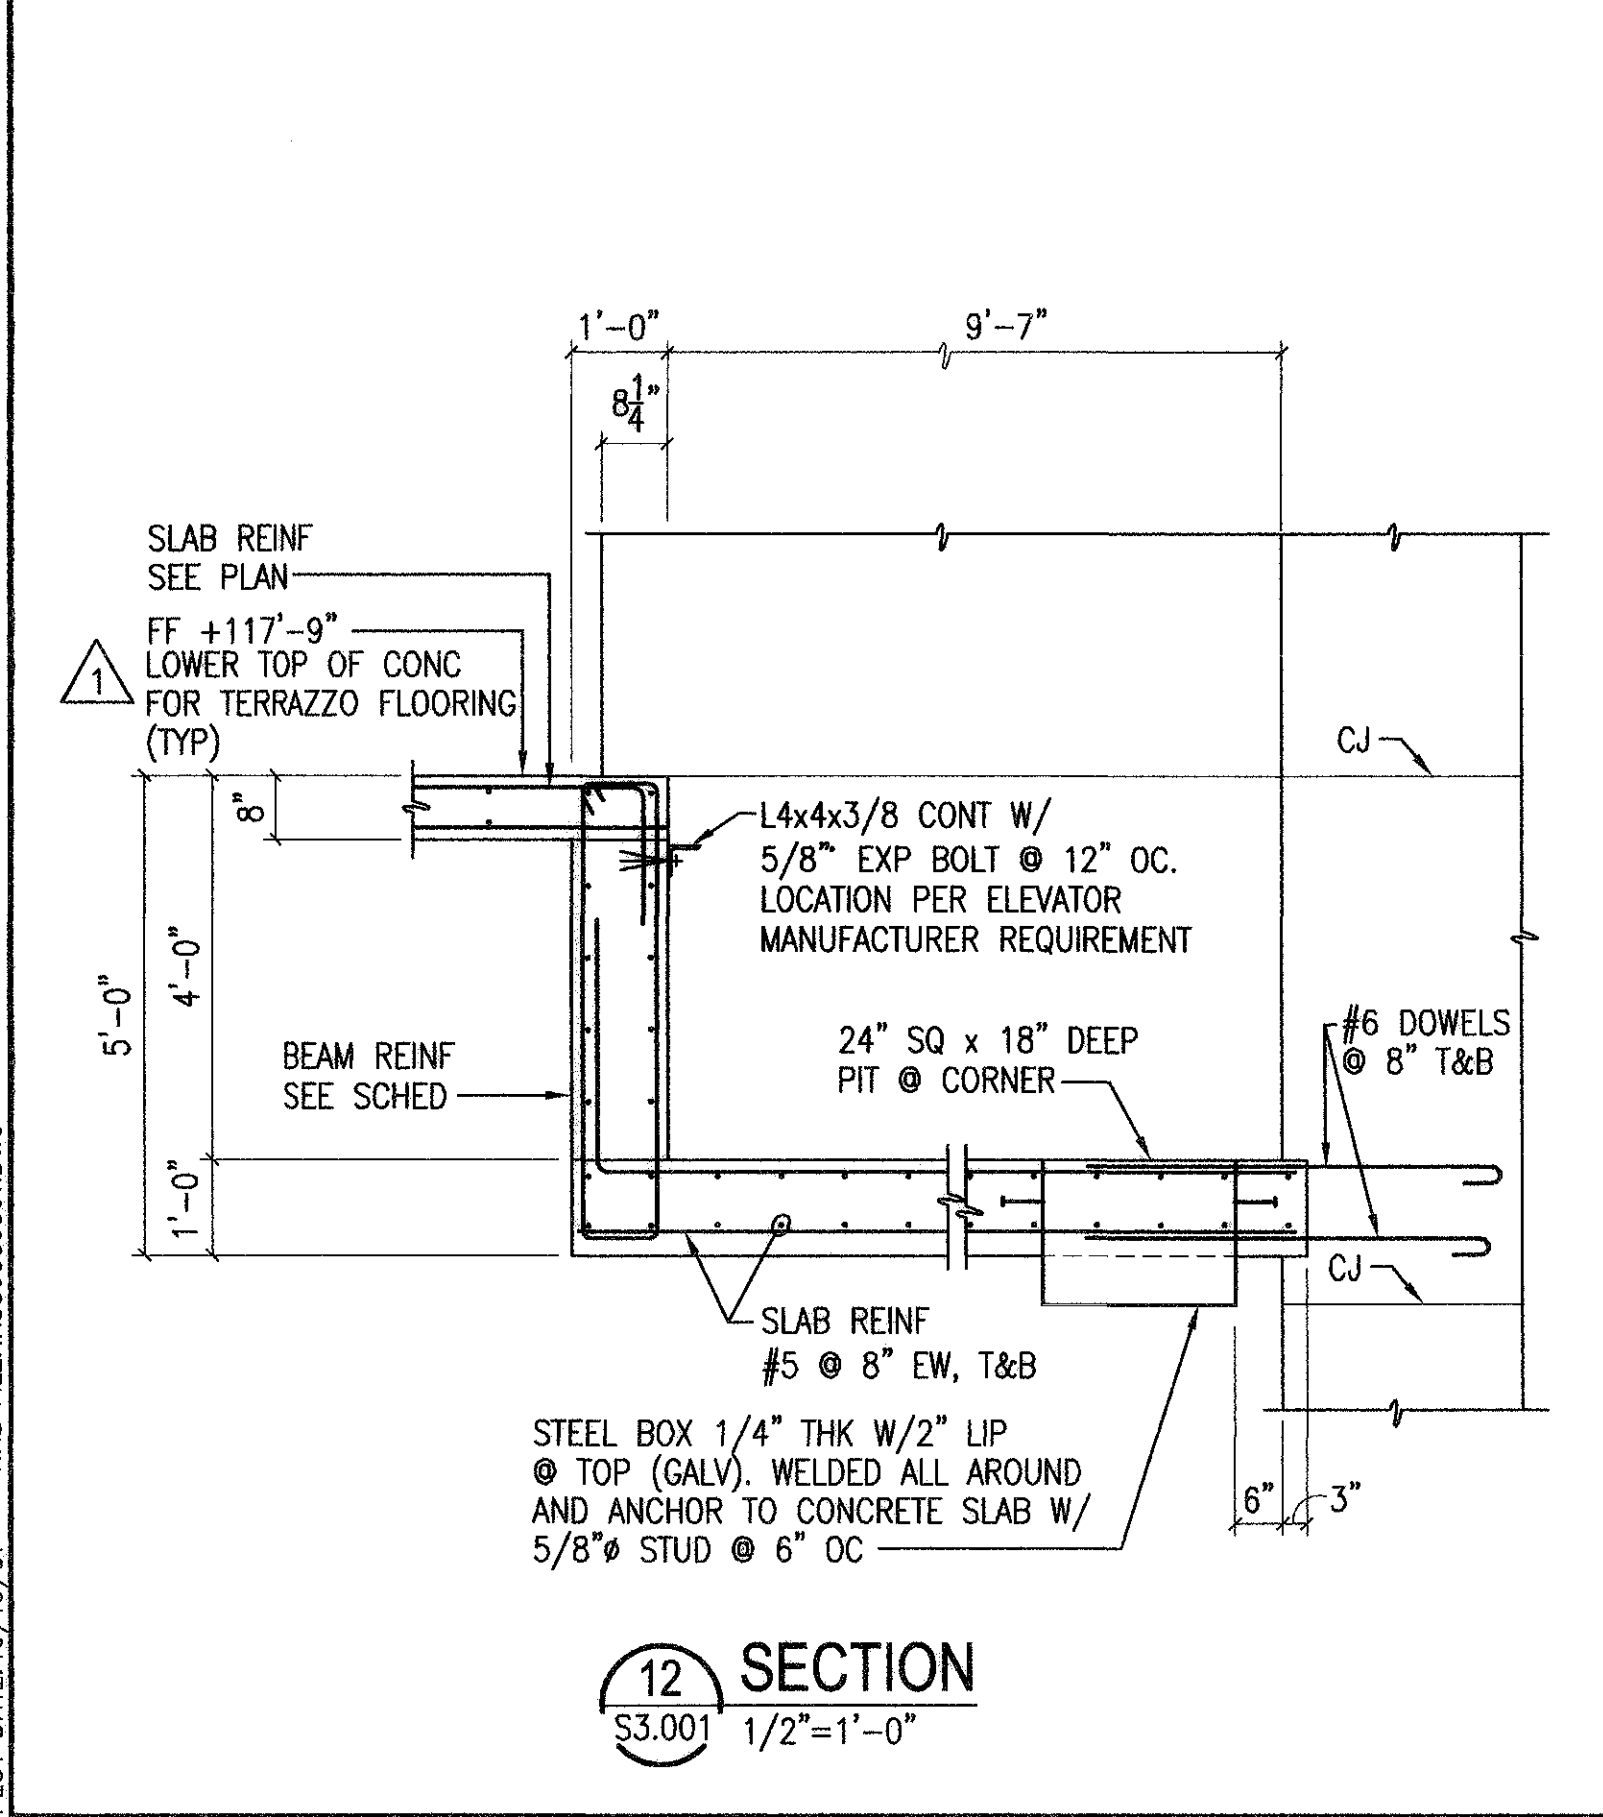


SECTION 12  
S3.001 1/2"=1'-0"

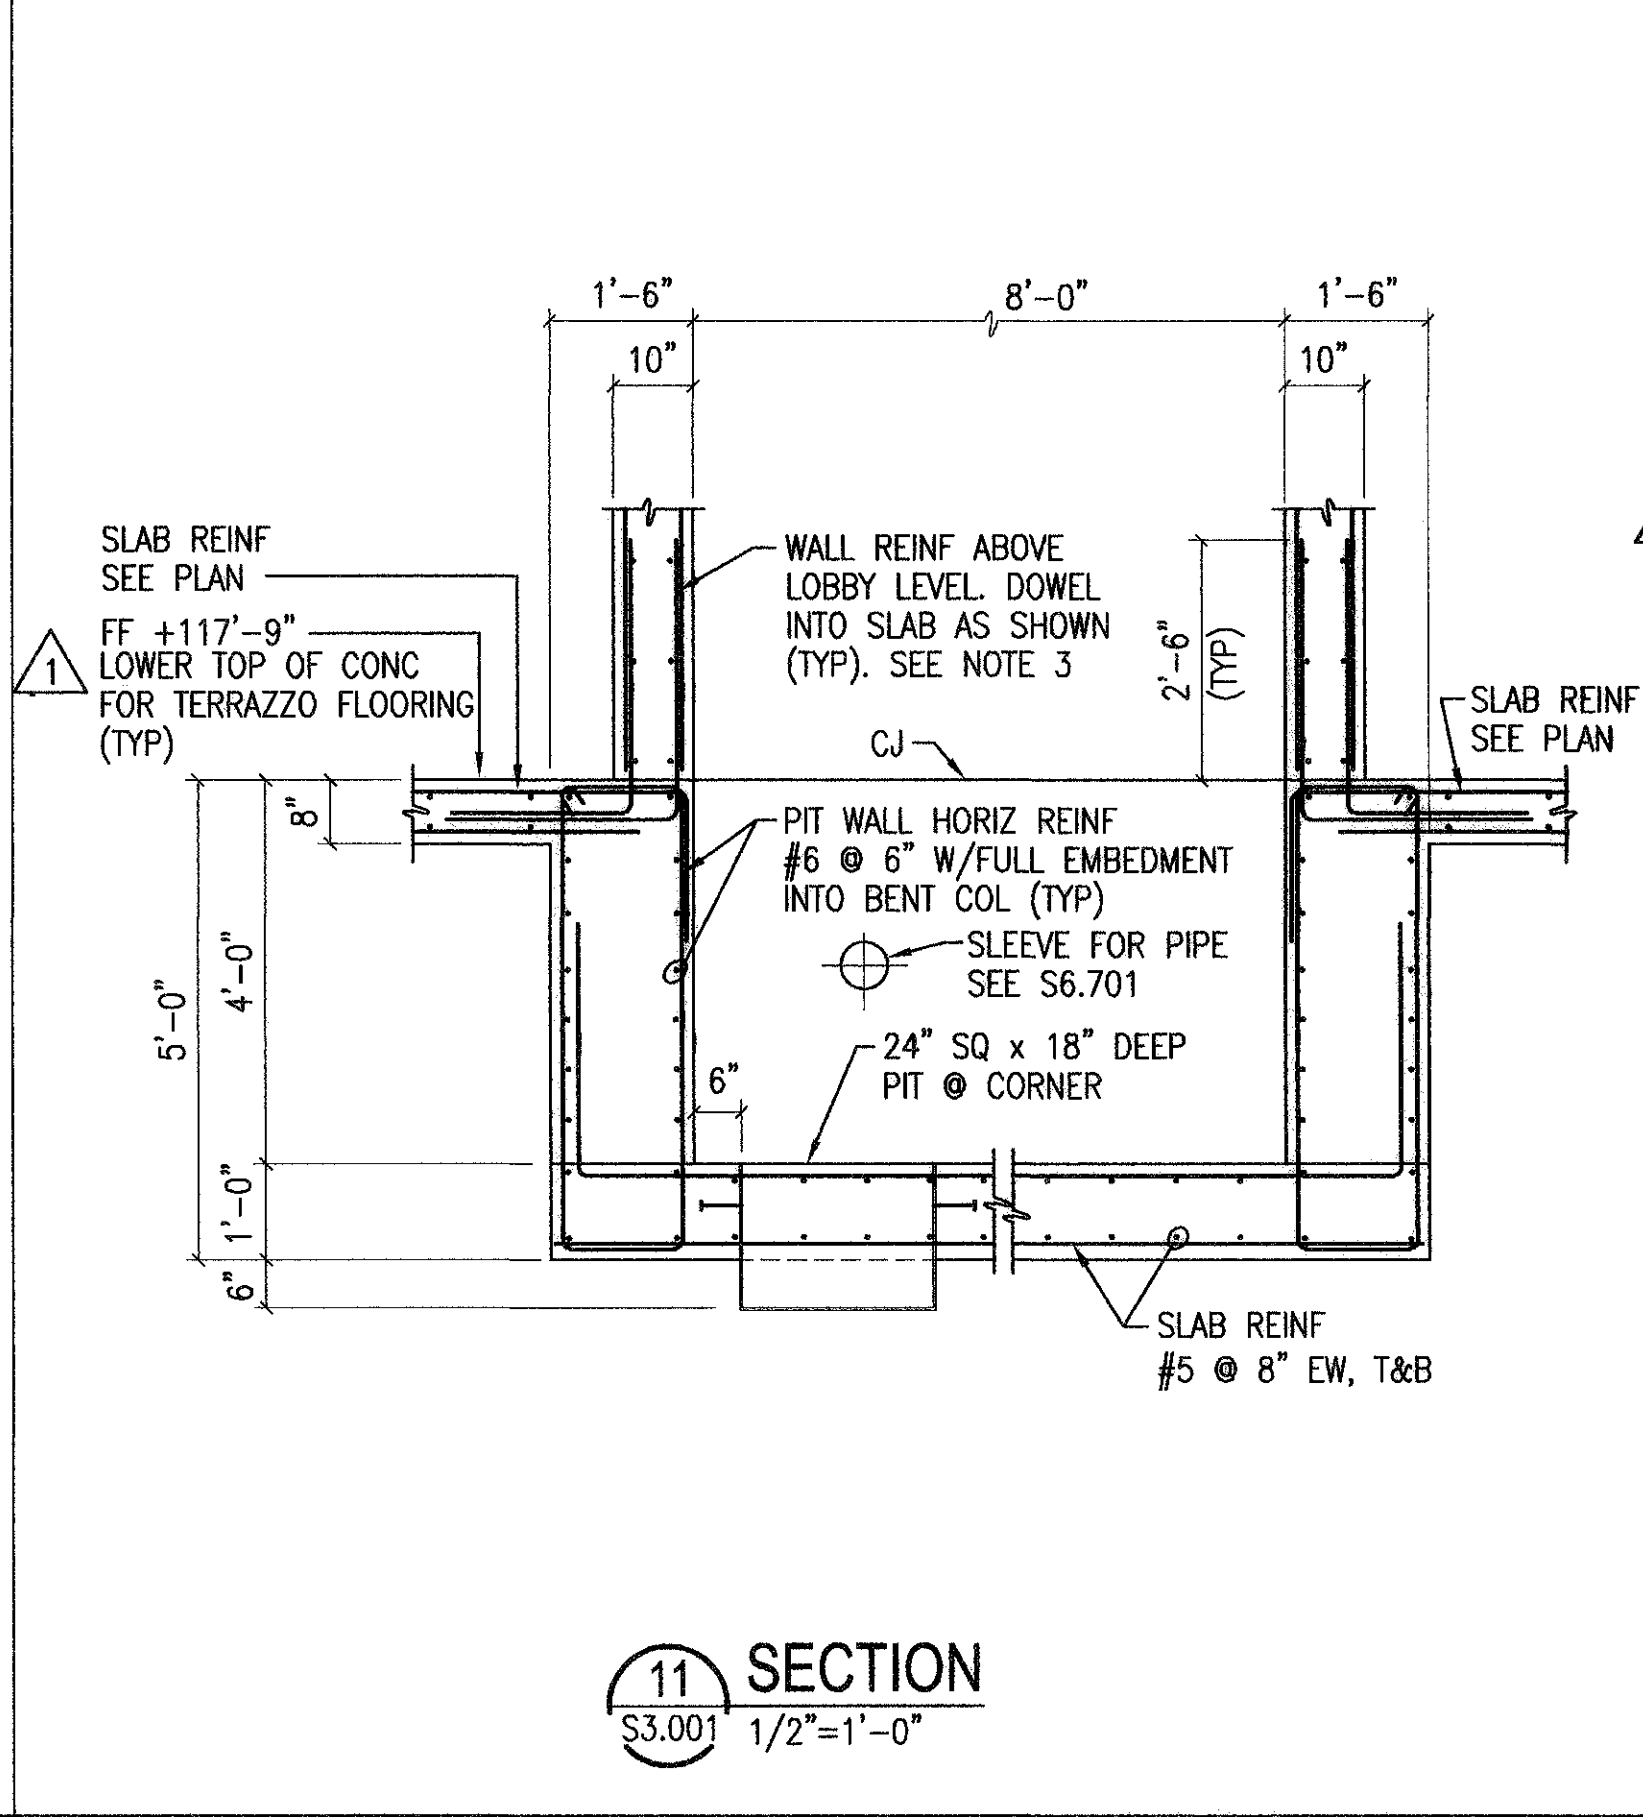

SECTION 11  
S3.001 1/2"=1'-0"

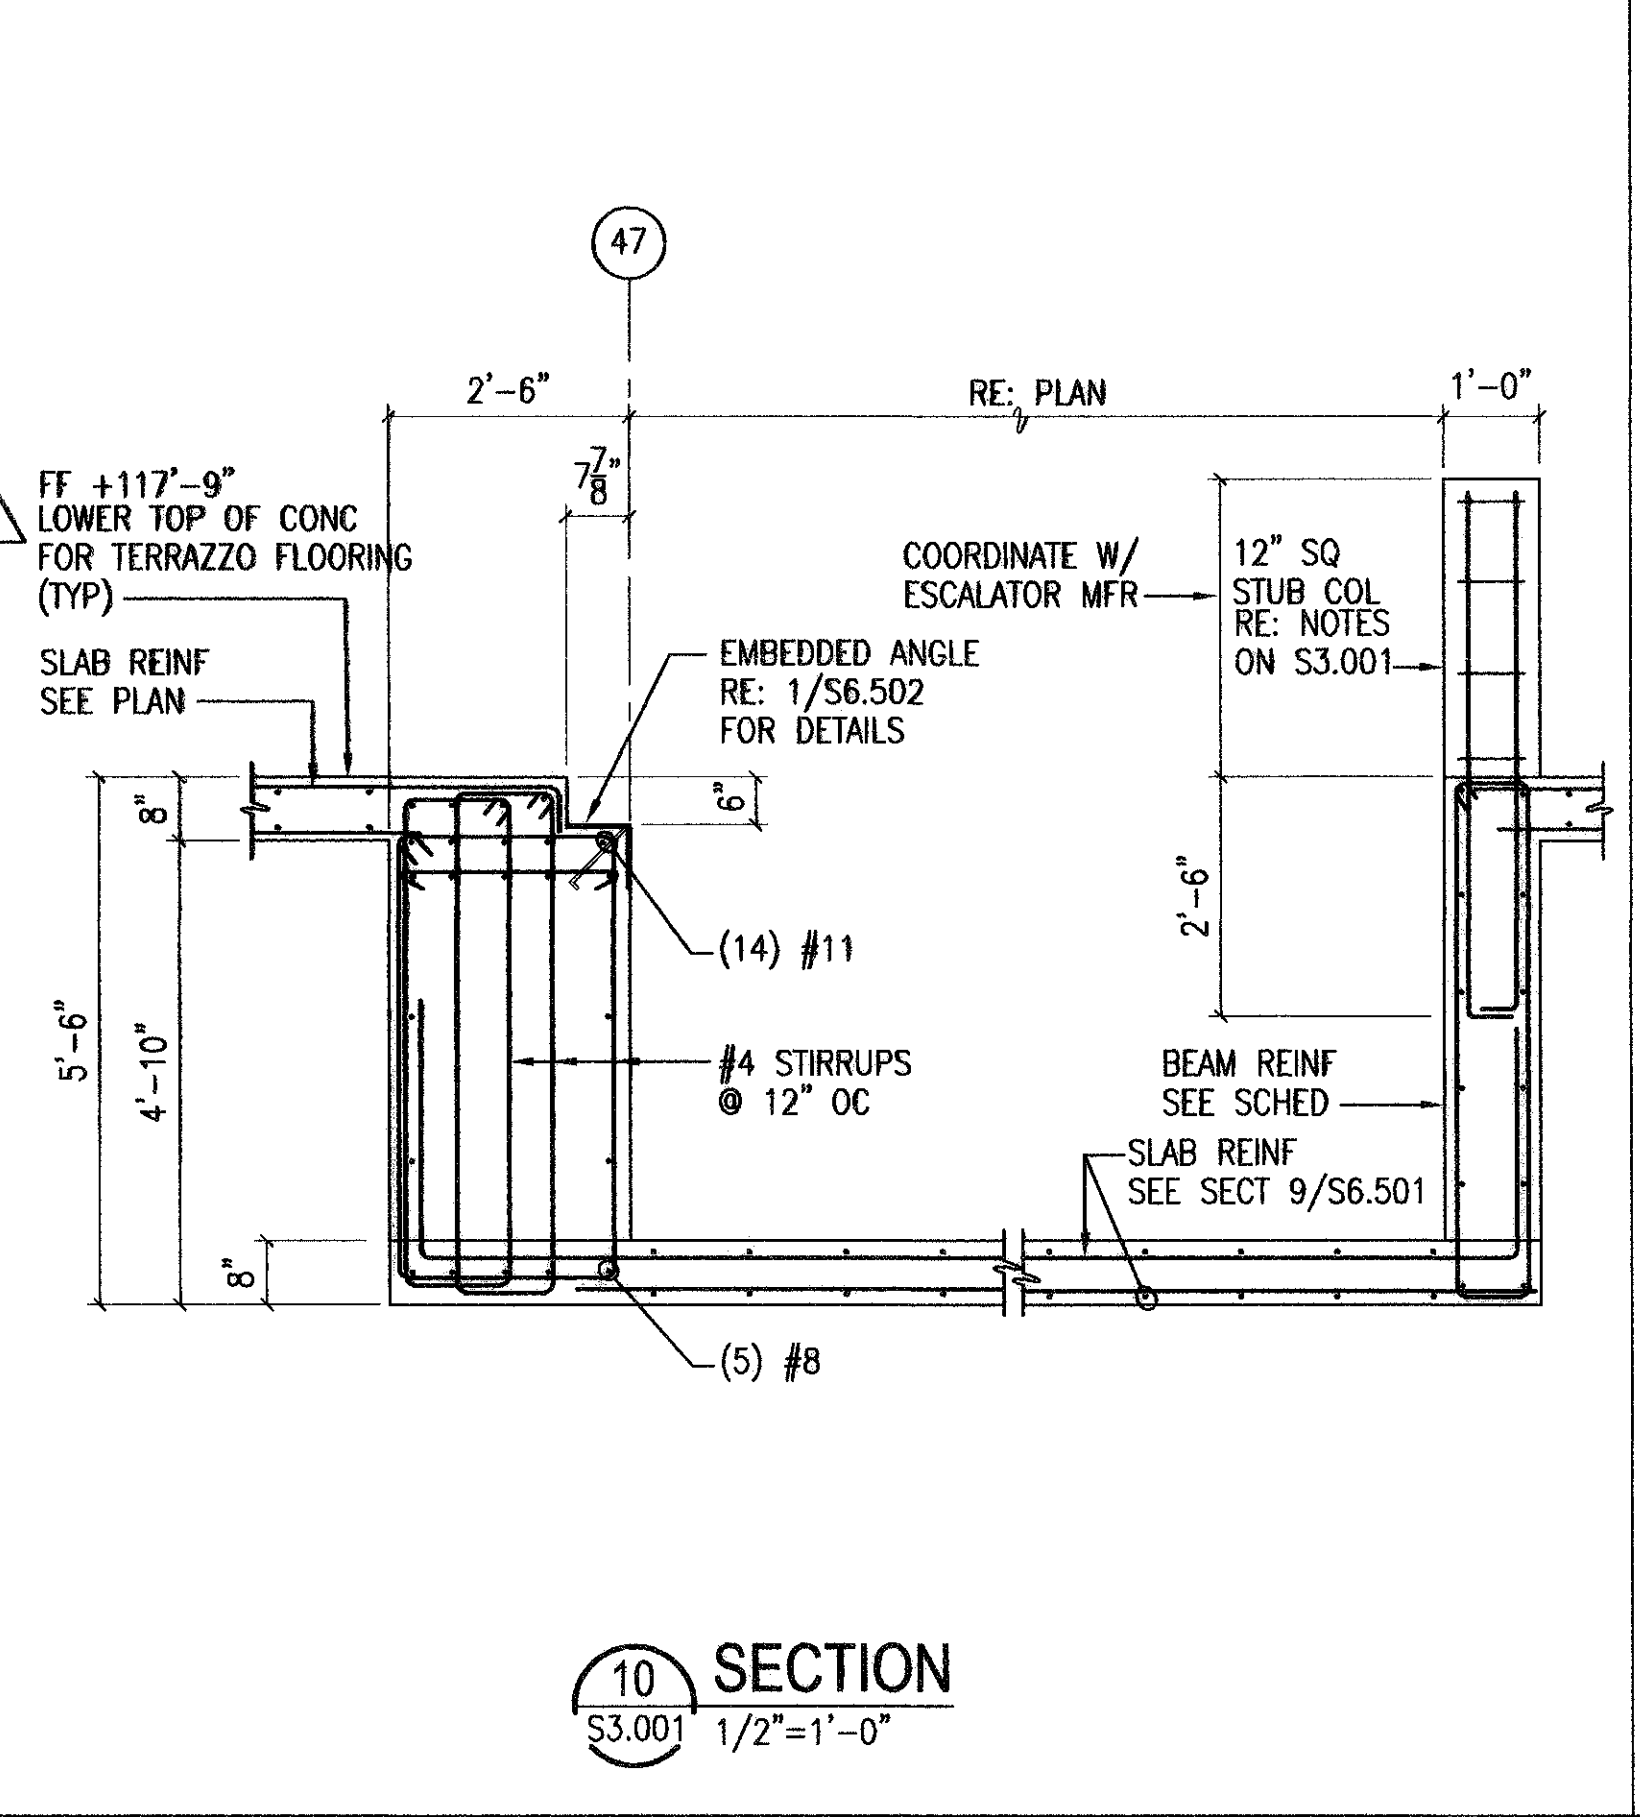

SECTION 10  
S3.001 1/2"=1'-0"

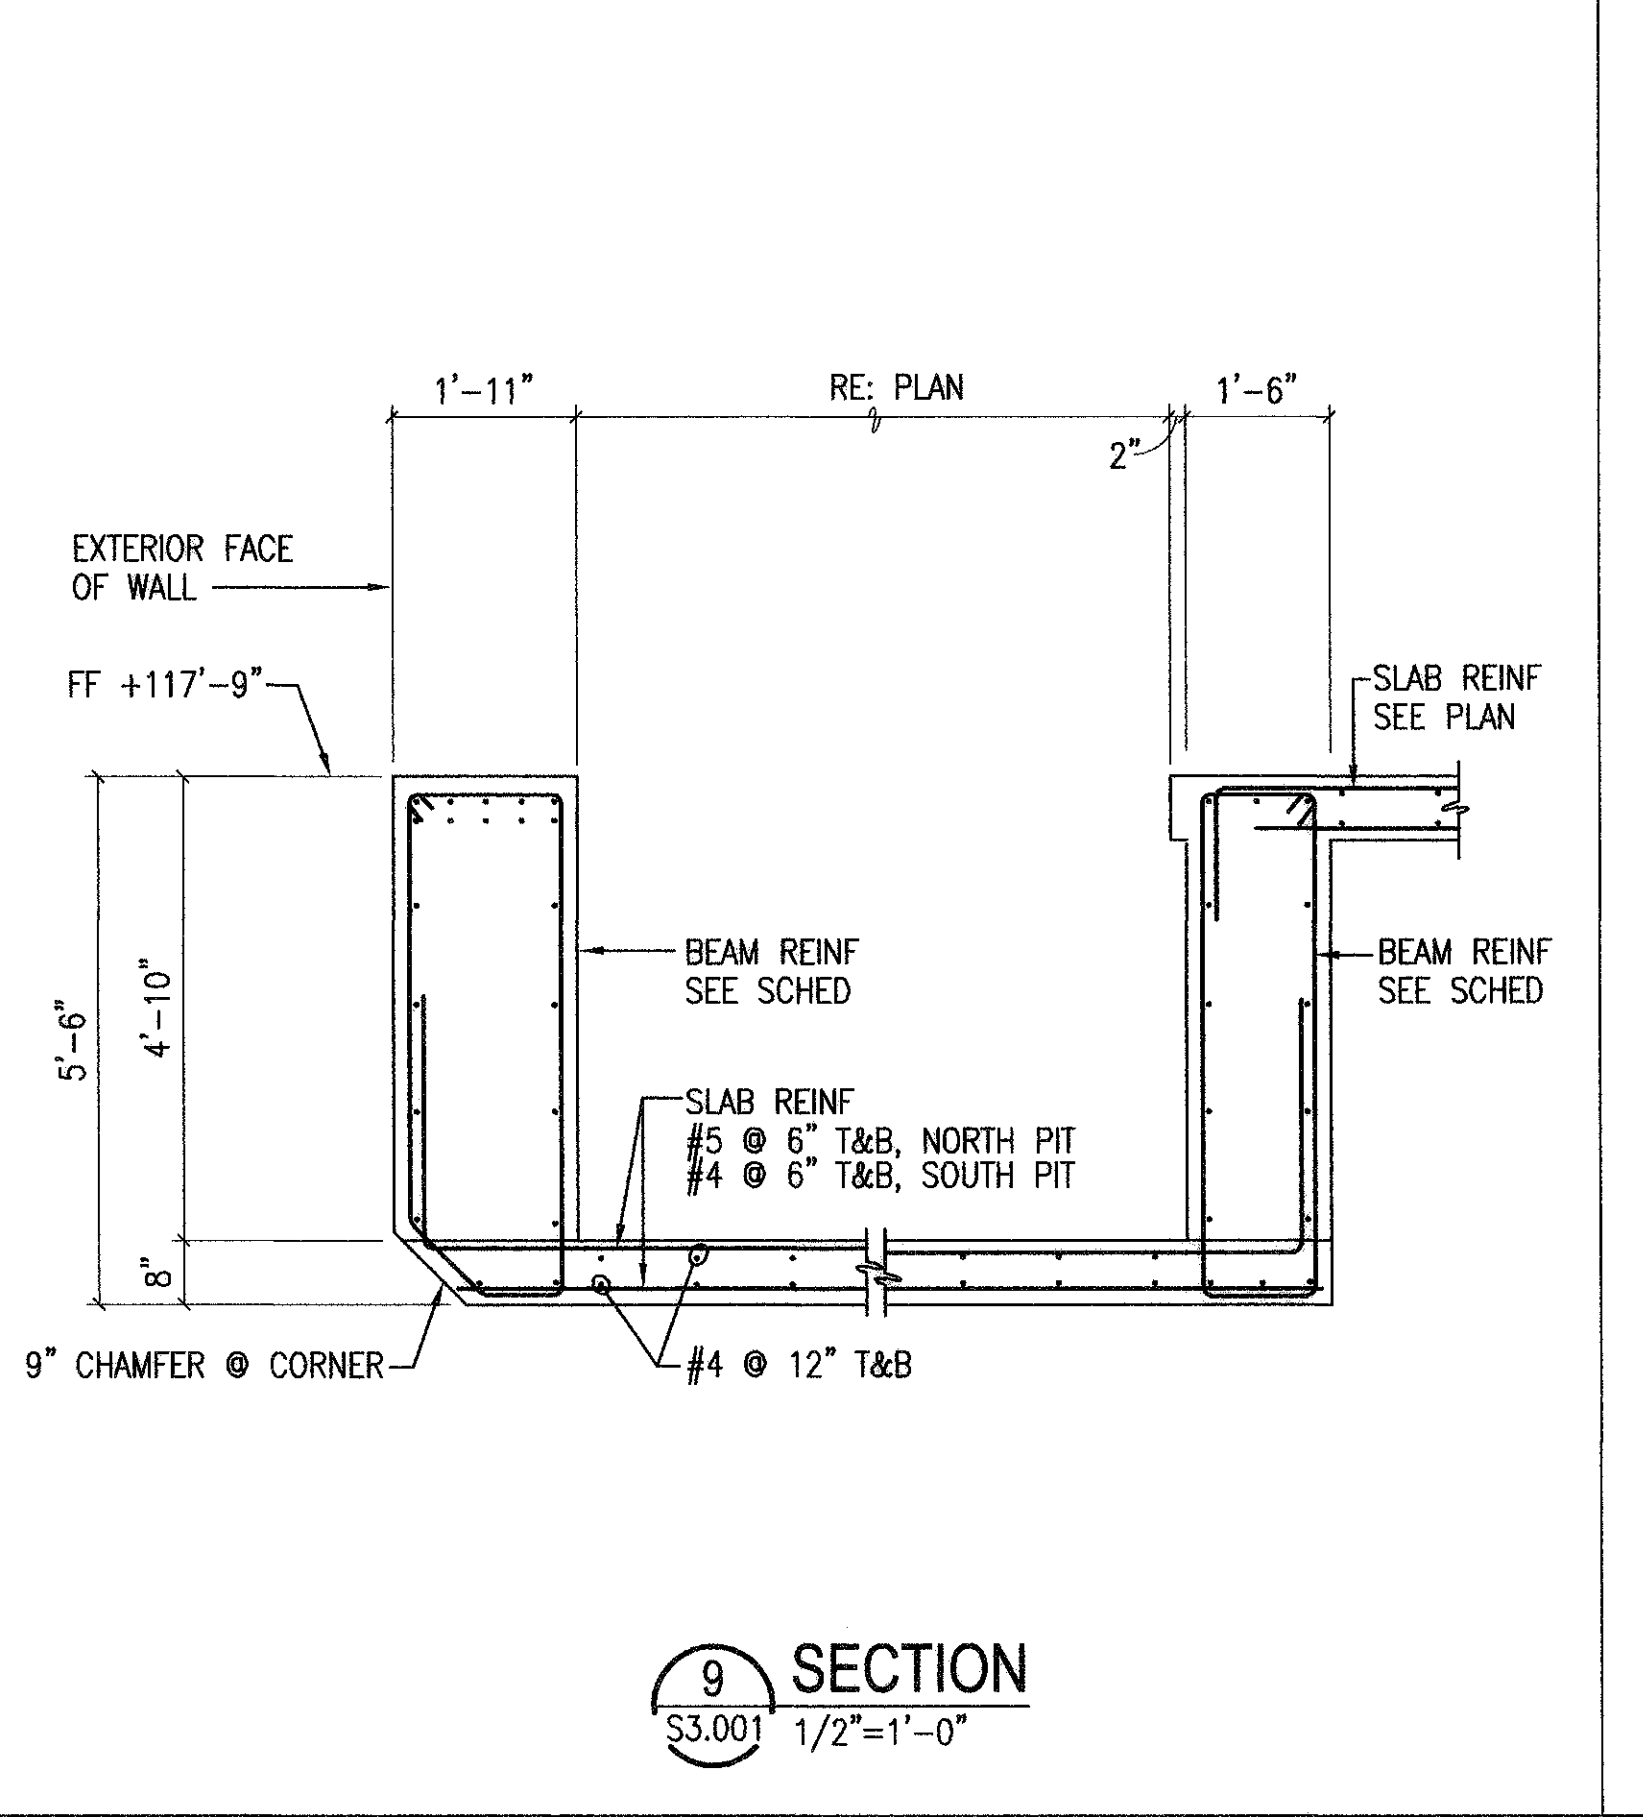

SECTION 9  
S3.001 1/2"=1'-0"

NOTES TO SHEET

- REFER TO SHEET S0.100 FOR STRUCTURAL GENERAL NOTES.
- PROVIDE #5 @ 12" OC (VERT) AND #4 @ 12" OC (HORIZ) EA FACE FOR WALL REINF.
- PROVIDE #5 @ 9" OC (VERT) AND #5 @ 6" OC (HORIZ, ANCHORED INTO BENT COL WITH FULL EMBEDMENT LENGTH), EACH FACE (TYP).

**HOUSTON AIRPORT SYSTEM**  
GEORGE BUSH  
INTERCONTINENTAL AIRPORT  
HOUSTON TEXAS

**HUITT-ZOLLARS**  
Engineering / Architecture  
1300 Galey Road, Suite 200, Houston, TX 77077  
Phone (281) 498-0066 Fax (281) 498-0220

**CHARLES F. VERRY, INC.**  
Consulting Engineers  
1000 Gessner Road, Suite 200, Houston, TX 77060  
Phone (281) 498-0066 Fax (281) 498-0220


NO.	DESCRIPTION	DATE	BY
1	ISSUED FOR BID	10/19/01	
2	ADDENDUM #1	02/01/02	MR

INTERNATIONAL • SERVICES • EXPANSION • PROGRAM

**APM STATION & PLATFORM**  
SECTIONS AND DETAILS

PROJECT MGR:	GRW
DESIGNER:	JUC
DRAWN BY:	KIV
CHECKED BY:	MMR
DRAWING STANDARD:	ISEP 07.20.2000
SCALE:	AS NOTED
DATE:	09/14/01

APPROVED BY:	DATE:
DIRECTOR	HOUSTON AIRPORT SYSTEM
PROJECT NO.:	02-2025-01
C.I.P. NO.:	A-0354
H.A.S. NO.:	536C
SHEET NO.:	

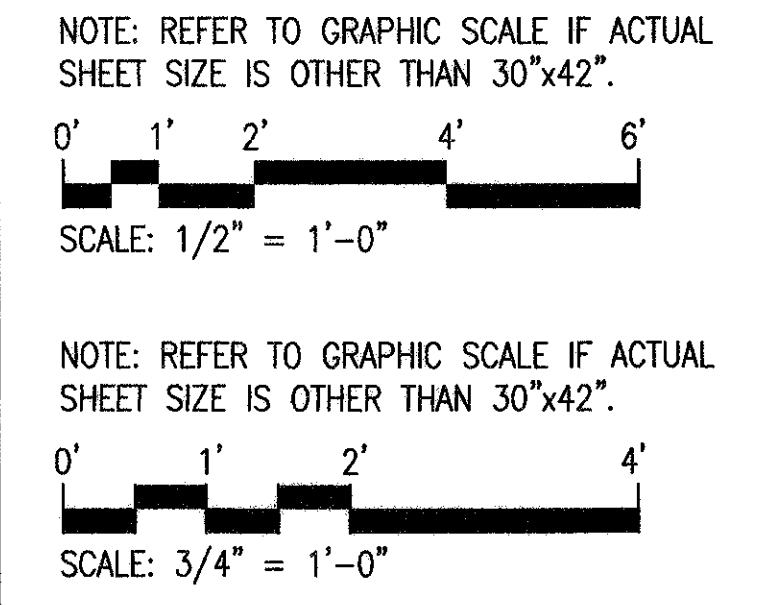


**RECORD DRAWINGS**  
DO NOT MODIFY

DATE: MAY 6, 2005


HUITT-ZOLLARS, INC.

NOTE: INFORMATION USED TO DEVELOP THESE DOCUMENTS WAS TAKEN FROM RECORD OF THE WORK DRAWINGS PREPARED BY THE CONSTRUCTION CONTRACTOR. CLARK/MISSON A JOINT VENTURE. THE INFORMATION PROVIDED BY THE CONTRACTOR WAS NOT VERIFIED BY THE DESIGN FIRM NAMED ABOVE.




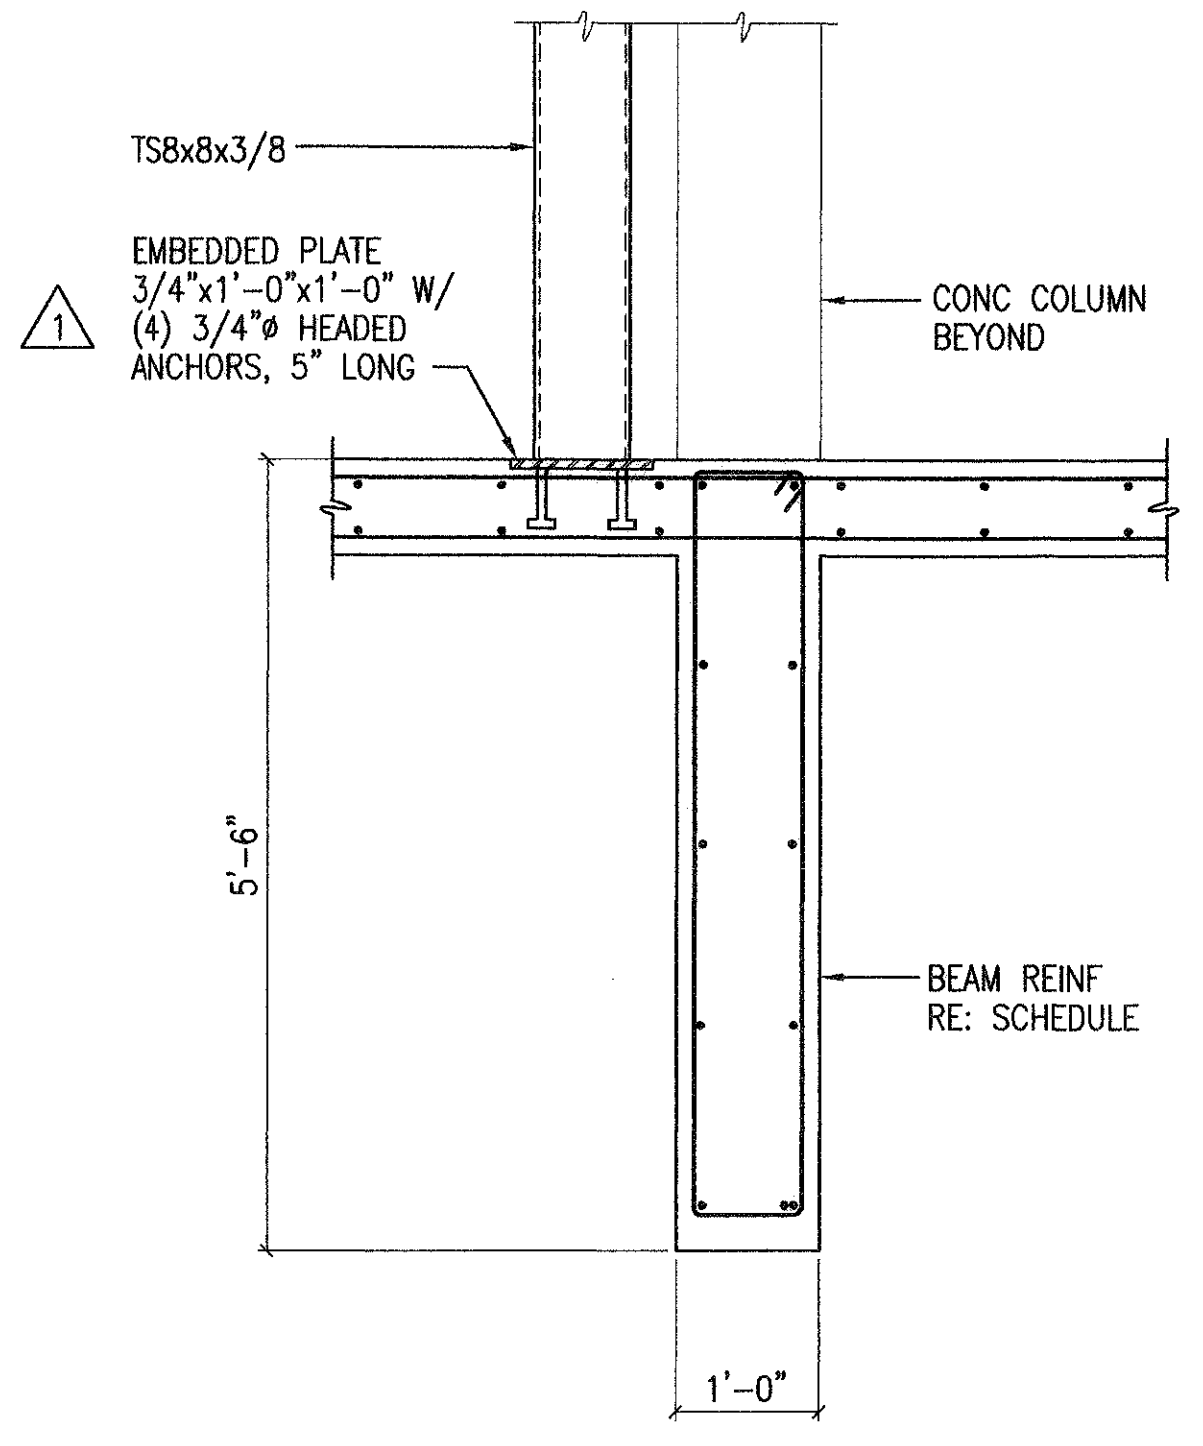

4 SECTION  
S3.001 3/4"=1'-0"

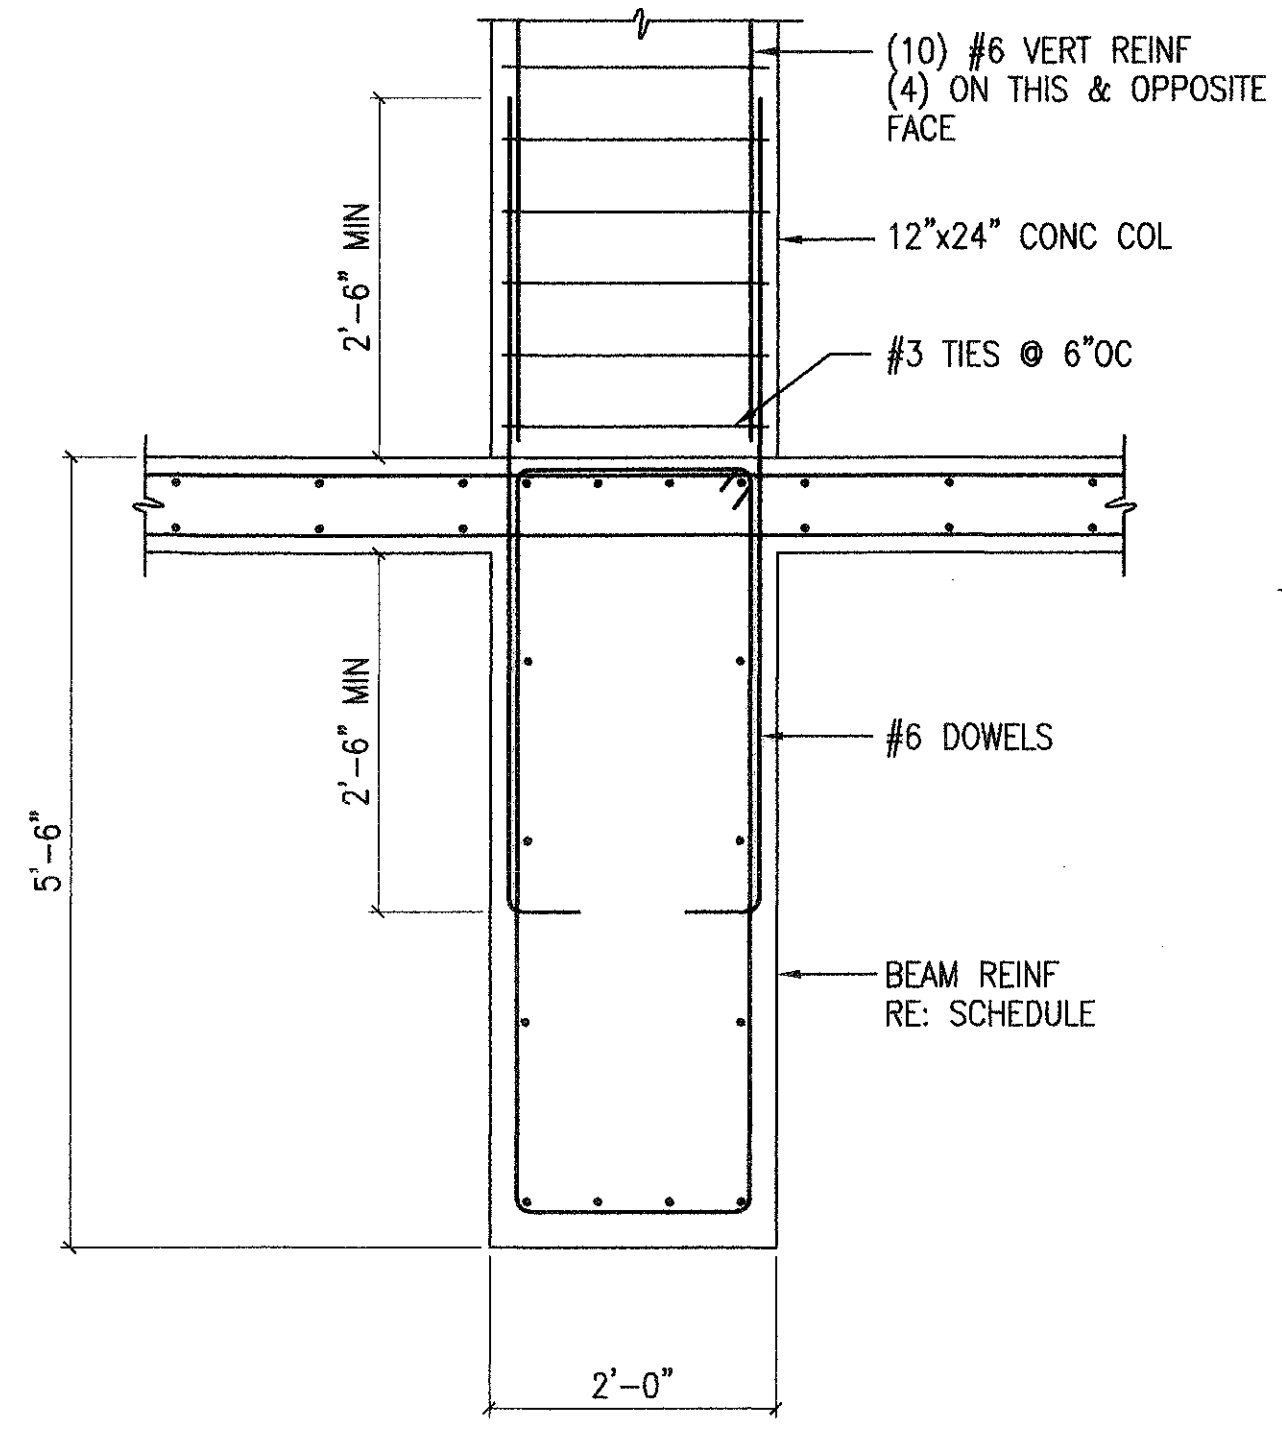


3 SECTION  
S3.001 3/4"=1'-0"

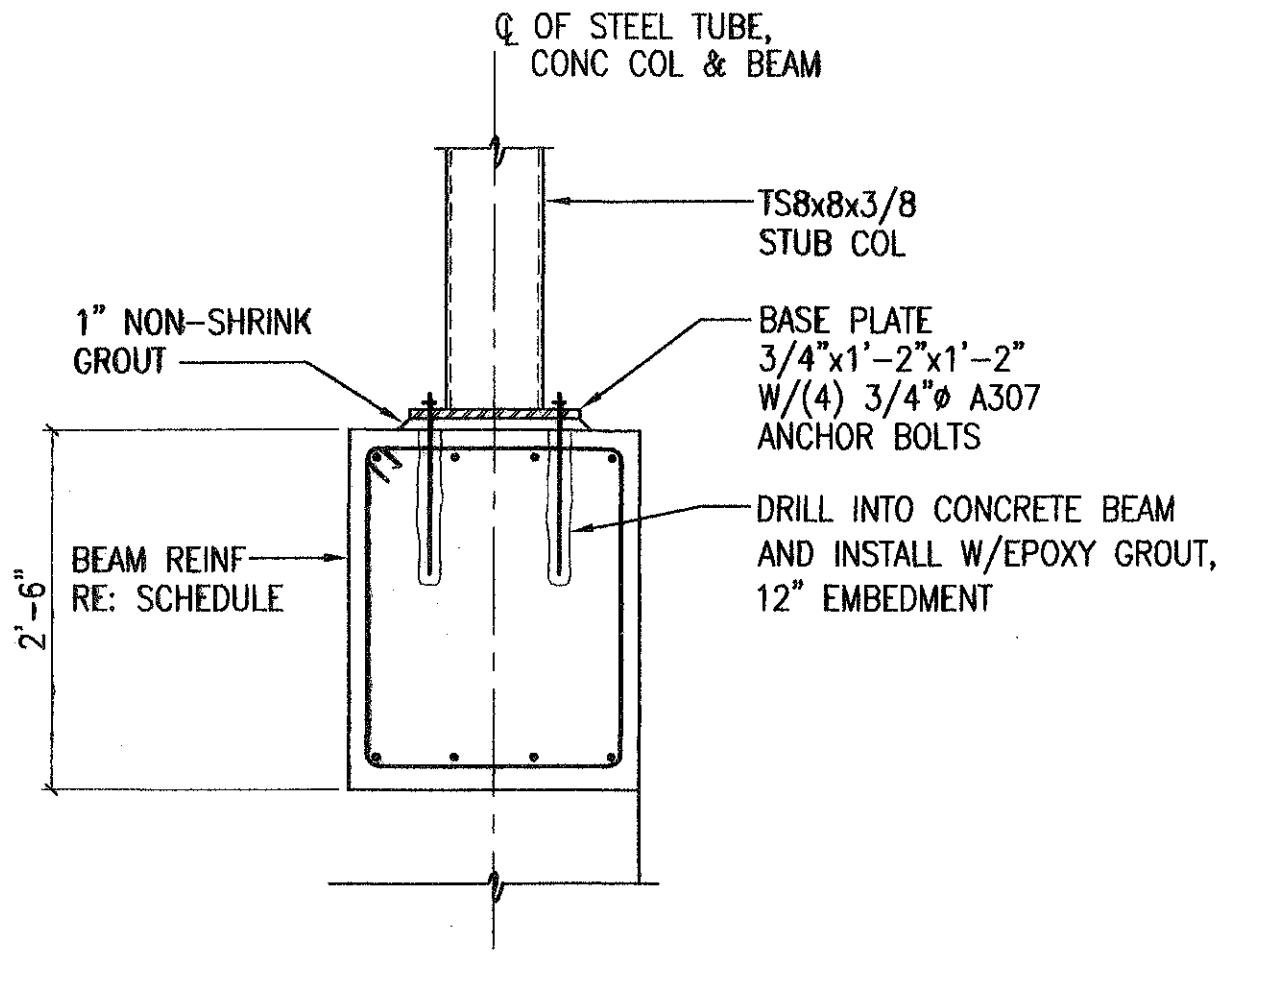


2 SECTION  
S3.001 3/4"=1'-0"


NOTE: LOCATION OF STEEL TUBE CENTERLINE IS NOT ON BEAM CENTERLINE IN SIM CONDITION.

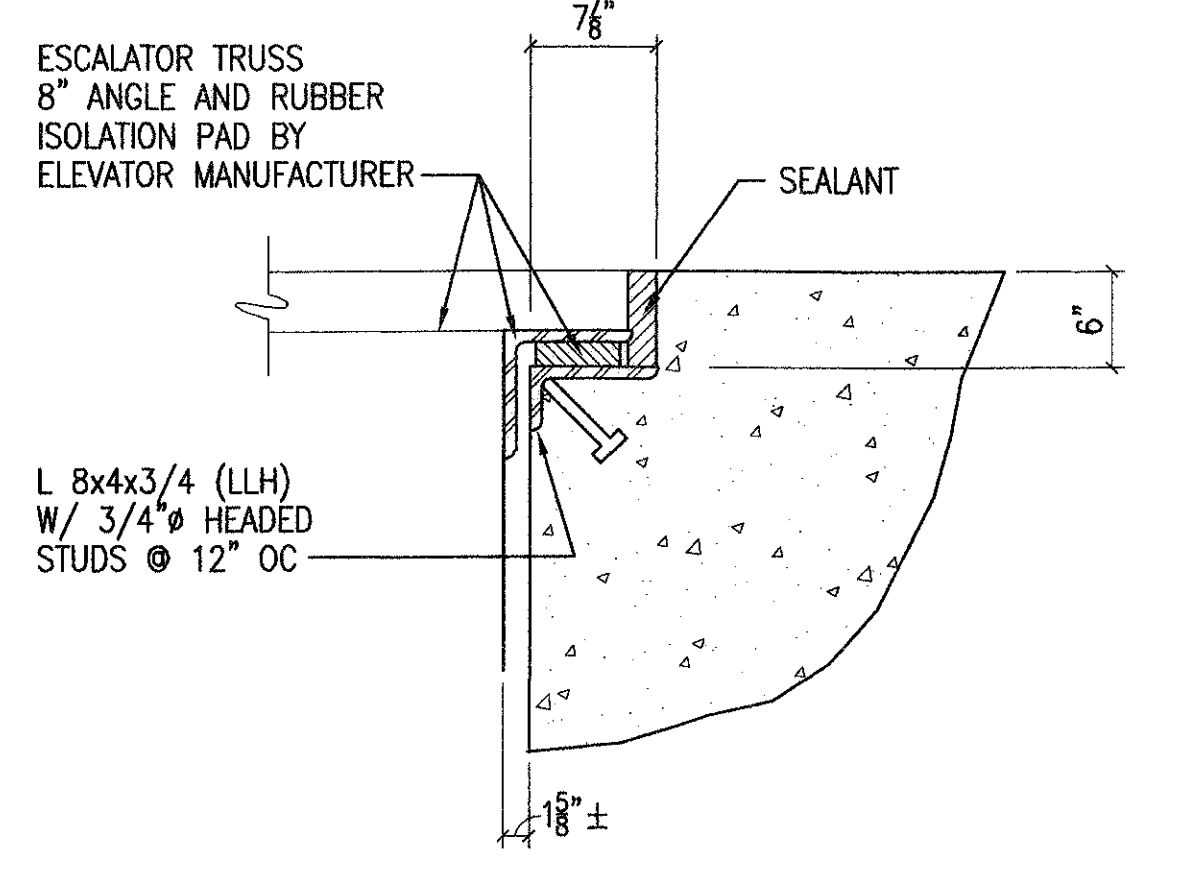


1 TYPICAL SECTION  
S3.002 1"=1'-0" ESCALATOR CONNECTION TO STRUCTURE @ TOP & BOTTOM

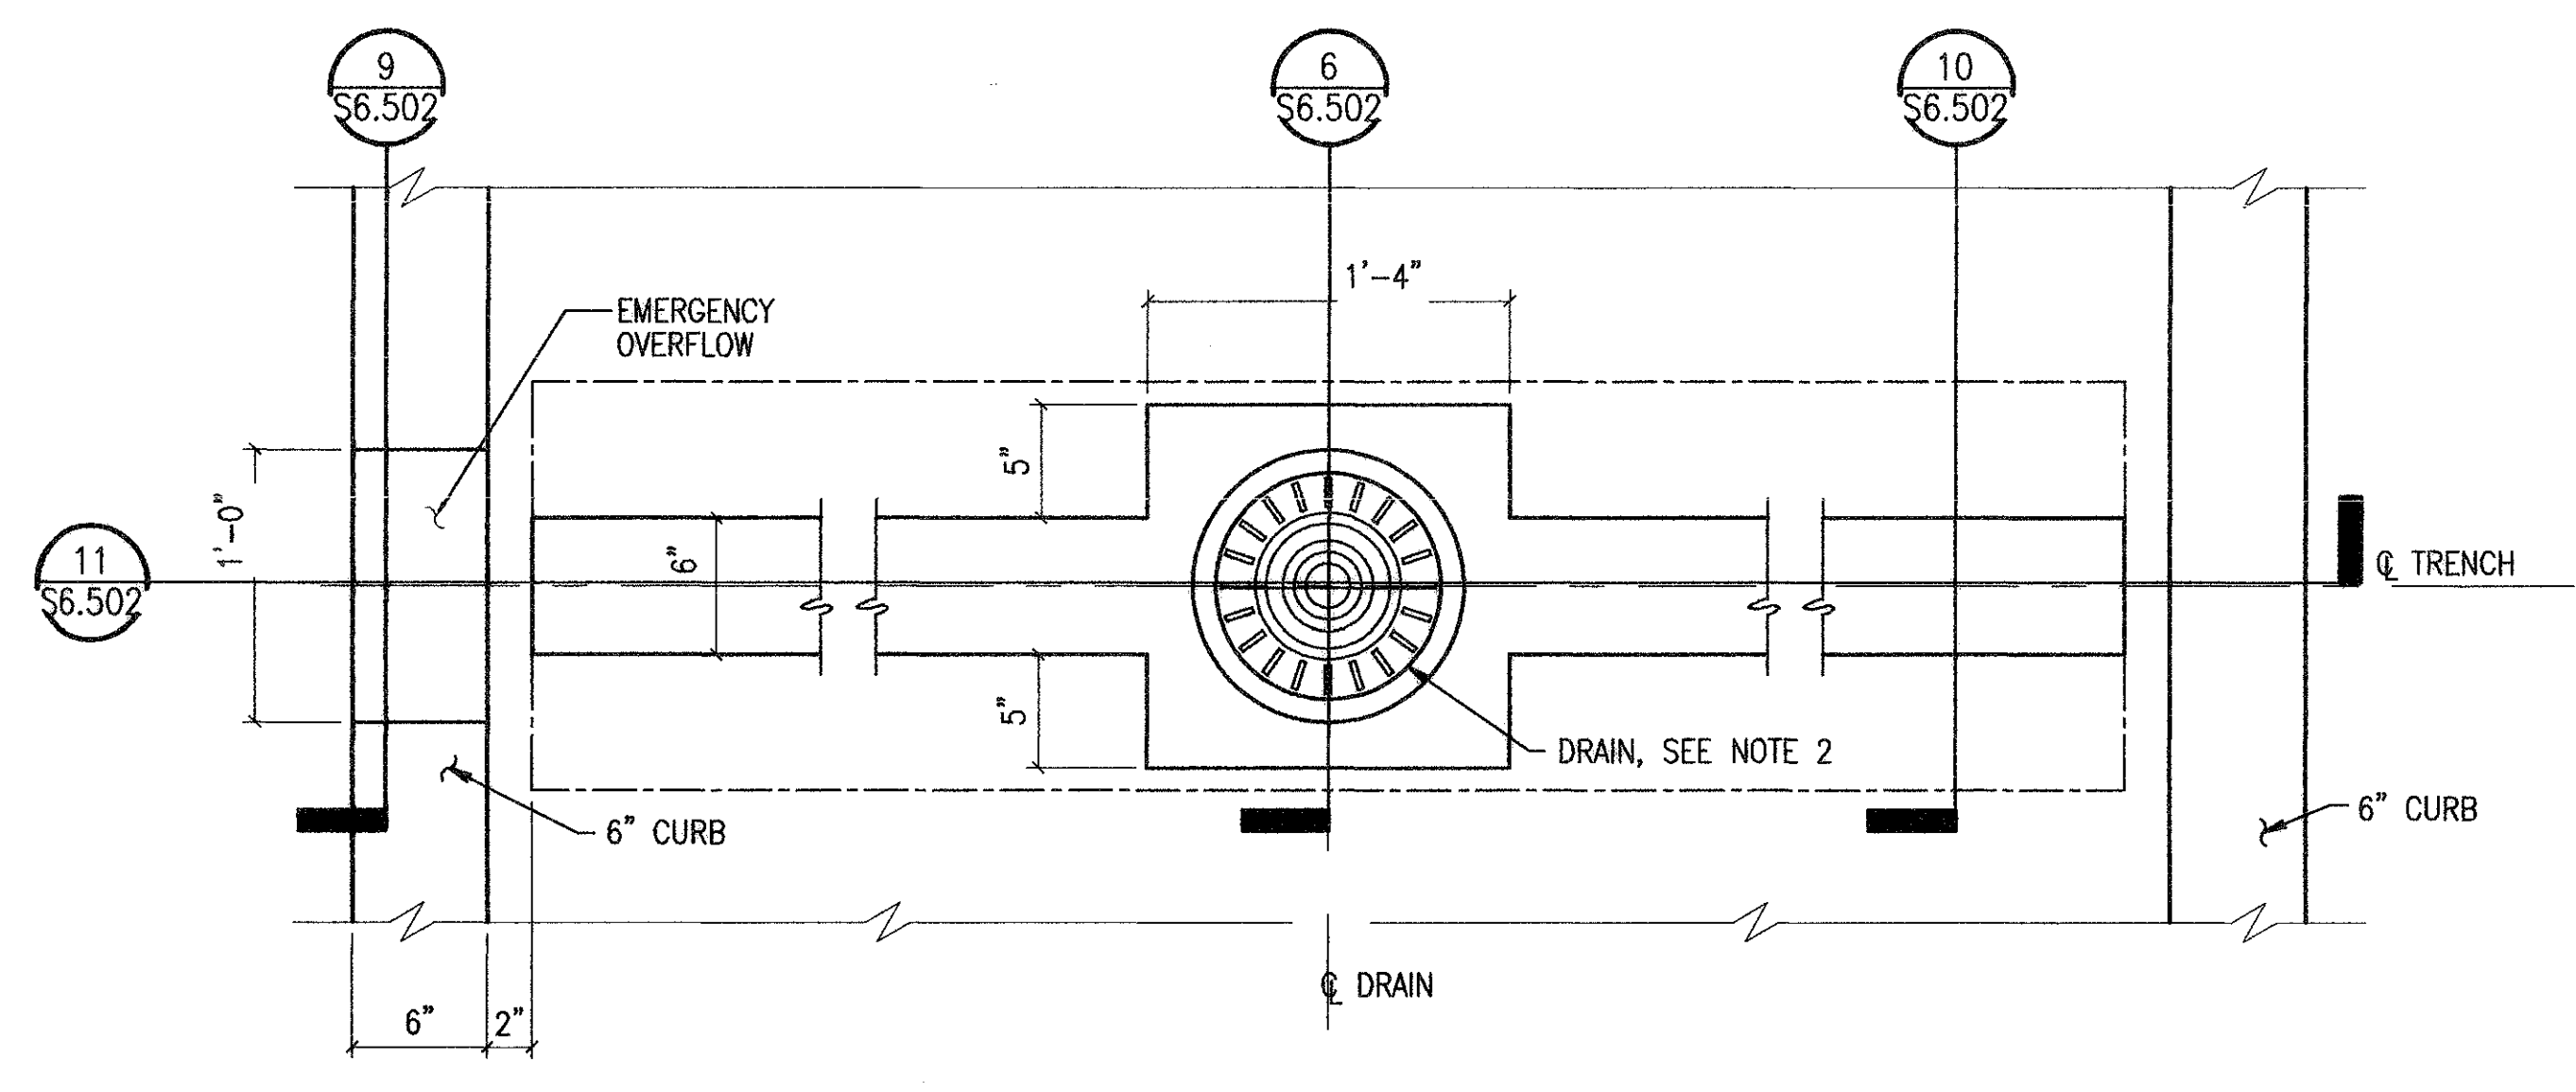


7 TRENCH DRAIN PLAN  
S3.002 1 1/2"=1'-0"

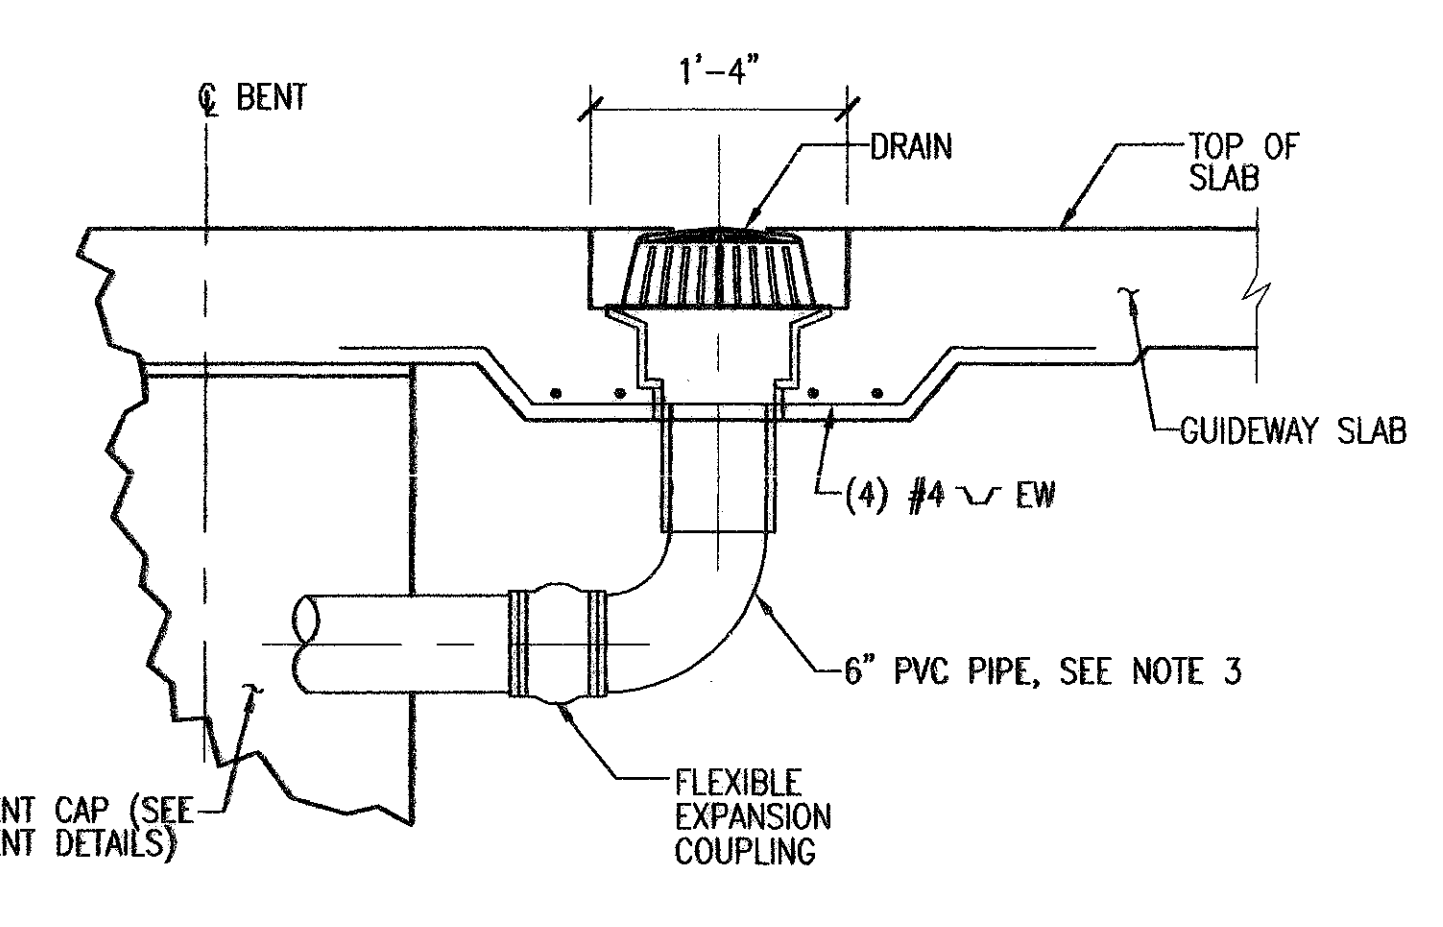


6 SECTION  
S6.502 1"=1'-0"

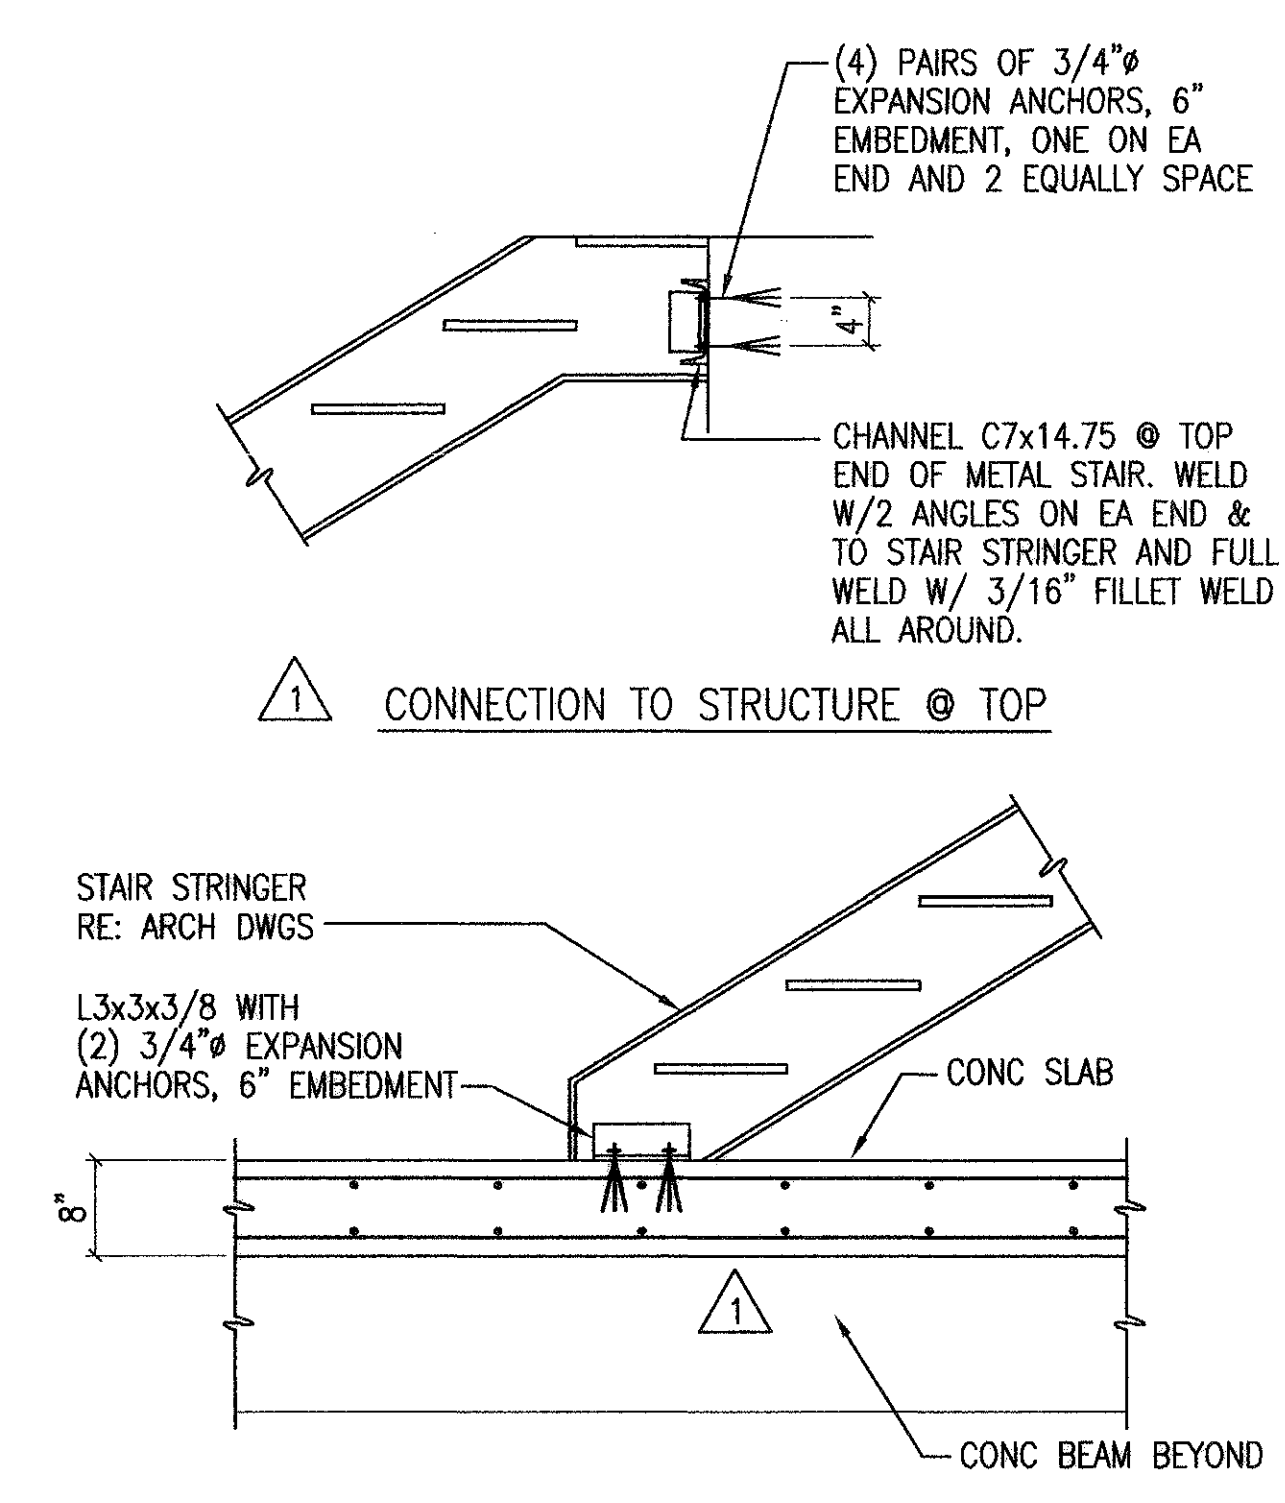


5 SECTION  
S3.001 3/4"=1'-0"

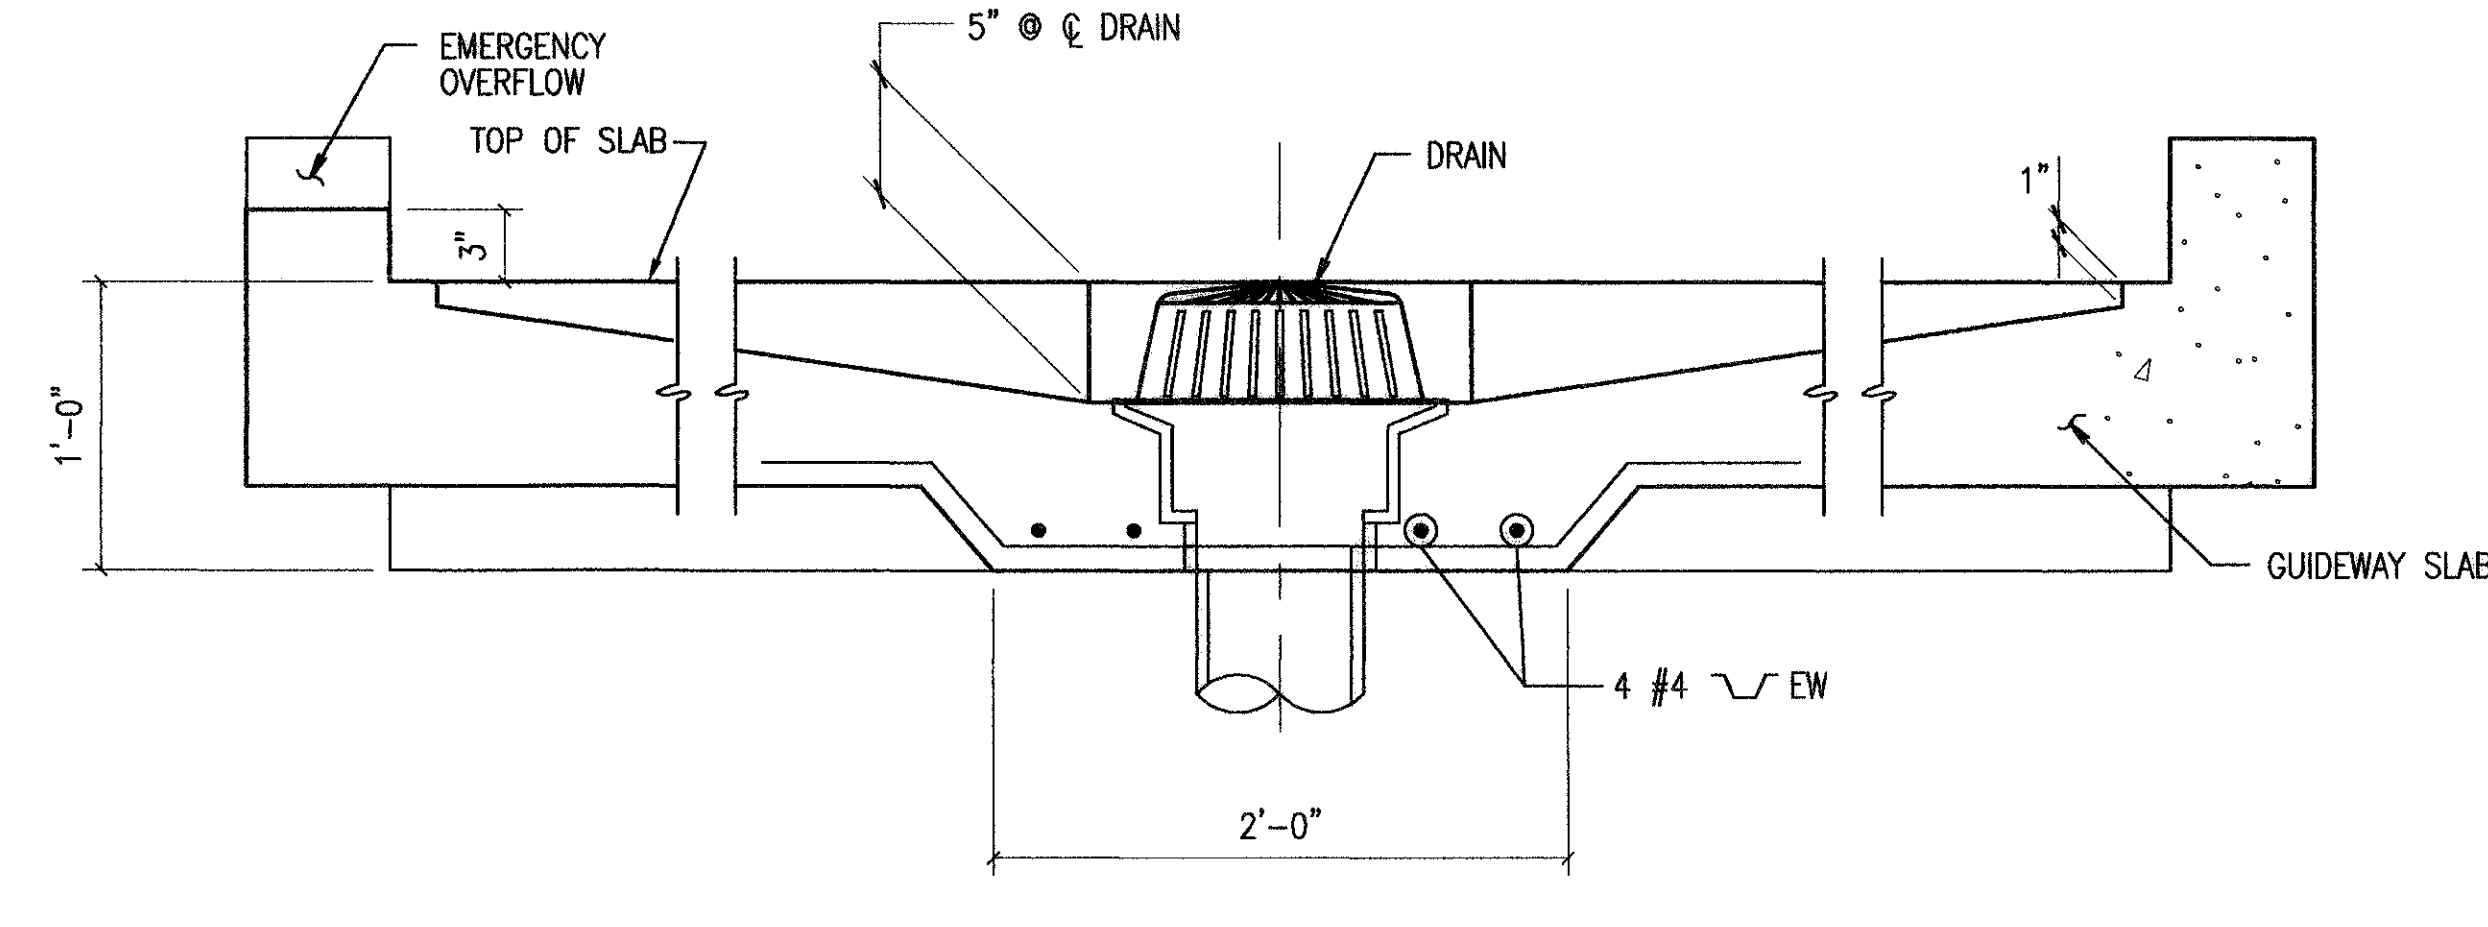

11 TRENCH DRAIN SECTION  
S6.502 1 1/2"=1'-0"

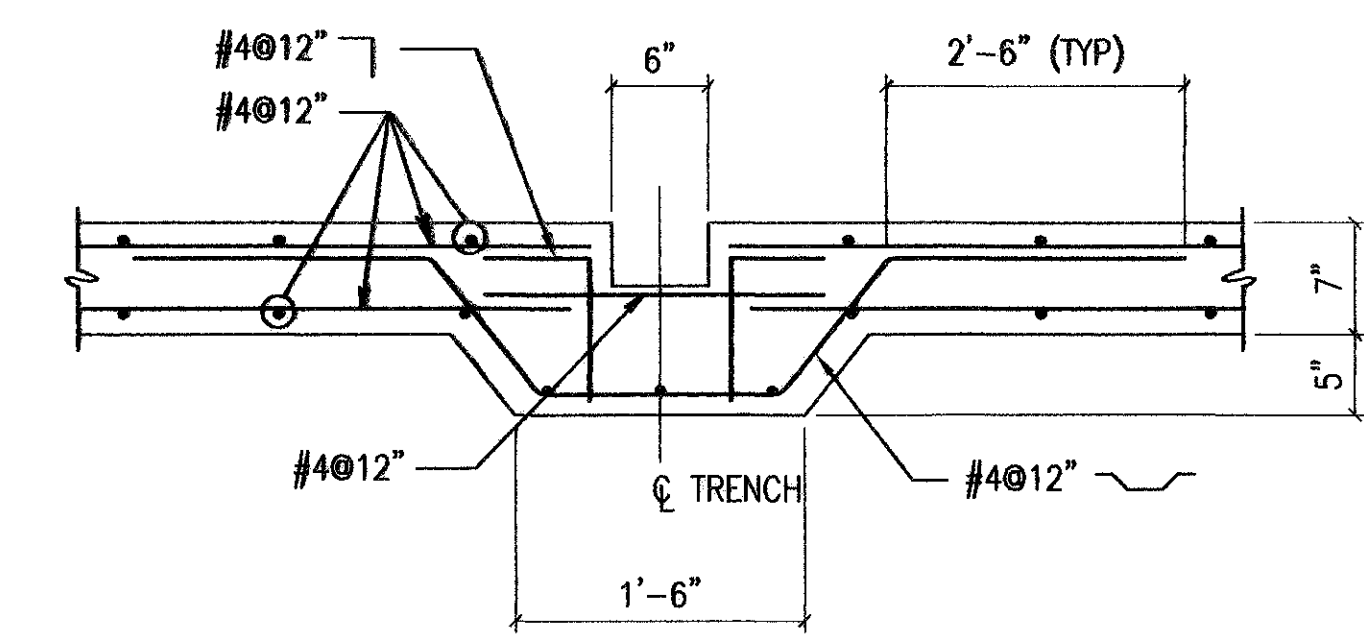

10 SECTION  
S6.502 1"=1'-0"

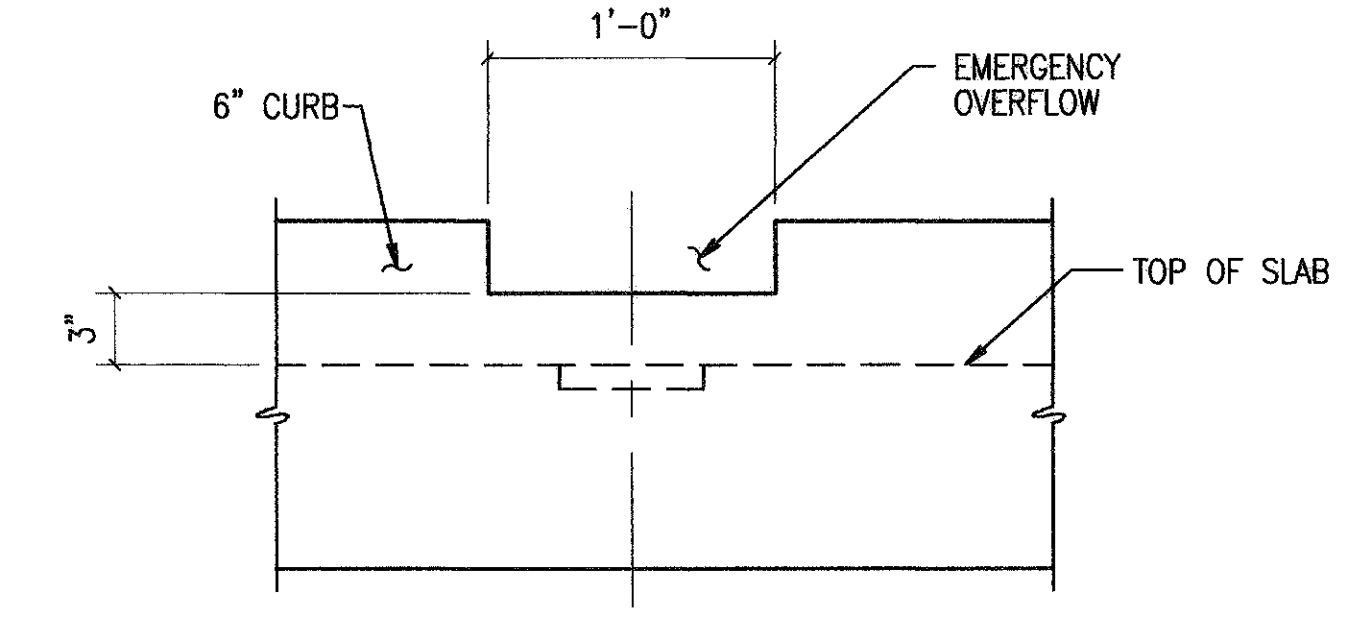

9 SECTION  
S6.502 1 1/2"=1'-0"

NOTES TO SHEET

- REFER TO SHEET S0.100 FOR STRUCTURAL GENERAL NOTES.
- DRAINS SHALL BE "MARATHON ROOFING PRODUCTS BIG BODY PVC BB-6" OR APPROVED EQUAL.
- PVC PIPE SHALL HAVE A MINIMUM SLOPE OF 2%.

**HOUSTON AIRPORT SYSTEM**  
GEORGE BUSH INTERCONTINENTAL AIRPORT  
HOUSTON TEXAS

**HUITT-ZOLLARS**  
Huitt-Zollars, Inc. Engineering / Architecture  
1400 West Loop South, Suite 200, Houston, TX 77027  
Phone (281) 466-5066 Fax (281) 466-5029

**CHARLES F. TERRY, INC.**  
Consulting Engineers  
2801 Gessner Avenue  
Houston, Texas 77050  
Phone (281) 754-2000

REVISIONS

NO.	DESCRIPTION	DATE	BY
ISSUED FOR BID		10/19/01	
ADDENDUM #1		02/01/02	MR

INTERNATIONAL SERVICES • EXPANSION • PROGRAM  
**APM STATION & PLATFORM**  
SECTIONS AND DETAILS

NOTE: REFER TO GRAPHIC SCALE IF ACTUAL SHEET SIZE IS OTHER THAN 30"x42".

0' 6" 1' 2'

SCALE: 1-1/2" = 1'-0"

NOTE: REFER TO GRAPHIC SCALE IF ACTUAL SHEET SIZE IS OTHER THAN 30"x42".

0' 1' 2' 3'

SCALE: 1" = 1'-0"

NOTE: REFER TO GRAPHIC SCALE IF ACTUAL SHEET SIZE IS OTHER THAN 30"x42".

0' 1' 2' 4'

SCALE: 3/4" = 1'-0"

**RECORD DRAWINGS**  
DO NOT MODIFY

DATE: MAY 6, 2005

HUITT-ZOLLARS, INC.

NOTE: INFORMATION USED TO DEVELOP THESE DOCUMENTS WAS TAKEN FROM RECORD OF THE WORK DRAWINGS PREPARED BY THE CONSTRUCTION CONTRACTOR. CLARK/MISSION A JOINT VENTURE. THE INFORMATION PROVIDED BY THE CONTRACTOR WAS NOT VERIFIED BY THE DESIGN FIRM NAMED ABOVE.

PROJECT MGR: GRW  
DESIGNER: JUC  
DRAWN BY: KLV  
CHECKED BY: MMR  
DRAWING STANDARD: SEP 07.20.2000  
SCALE: AS NOTED  
DATE: 09/14/01


FOR RECORD DRAWING ONLY

STATE OF TEXAS  
MORIN MICHAEL REITHMAN  
65454  
SEAL


APPROVED BY: DATE:  
DIRECTOR  
HOUSTON AIRPORT SYSTEM

PROJECT NO. 02-2025-01  
C.I.P. NO. A-0354  
H.A.S. NO. 536C  
SHEET NO.




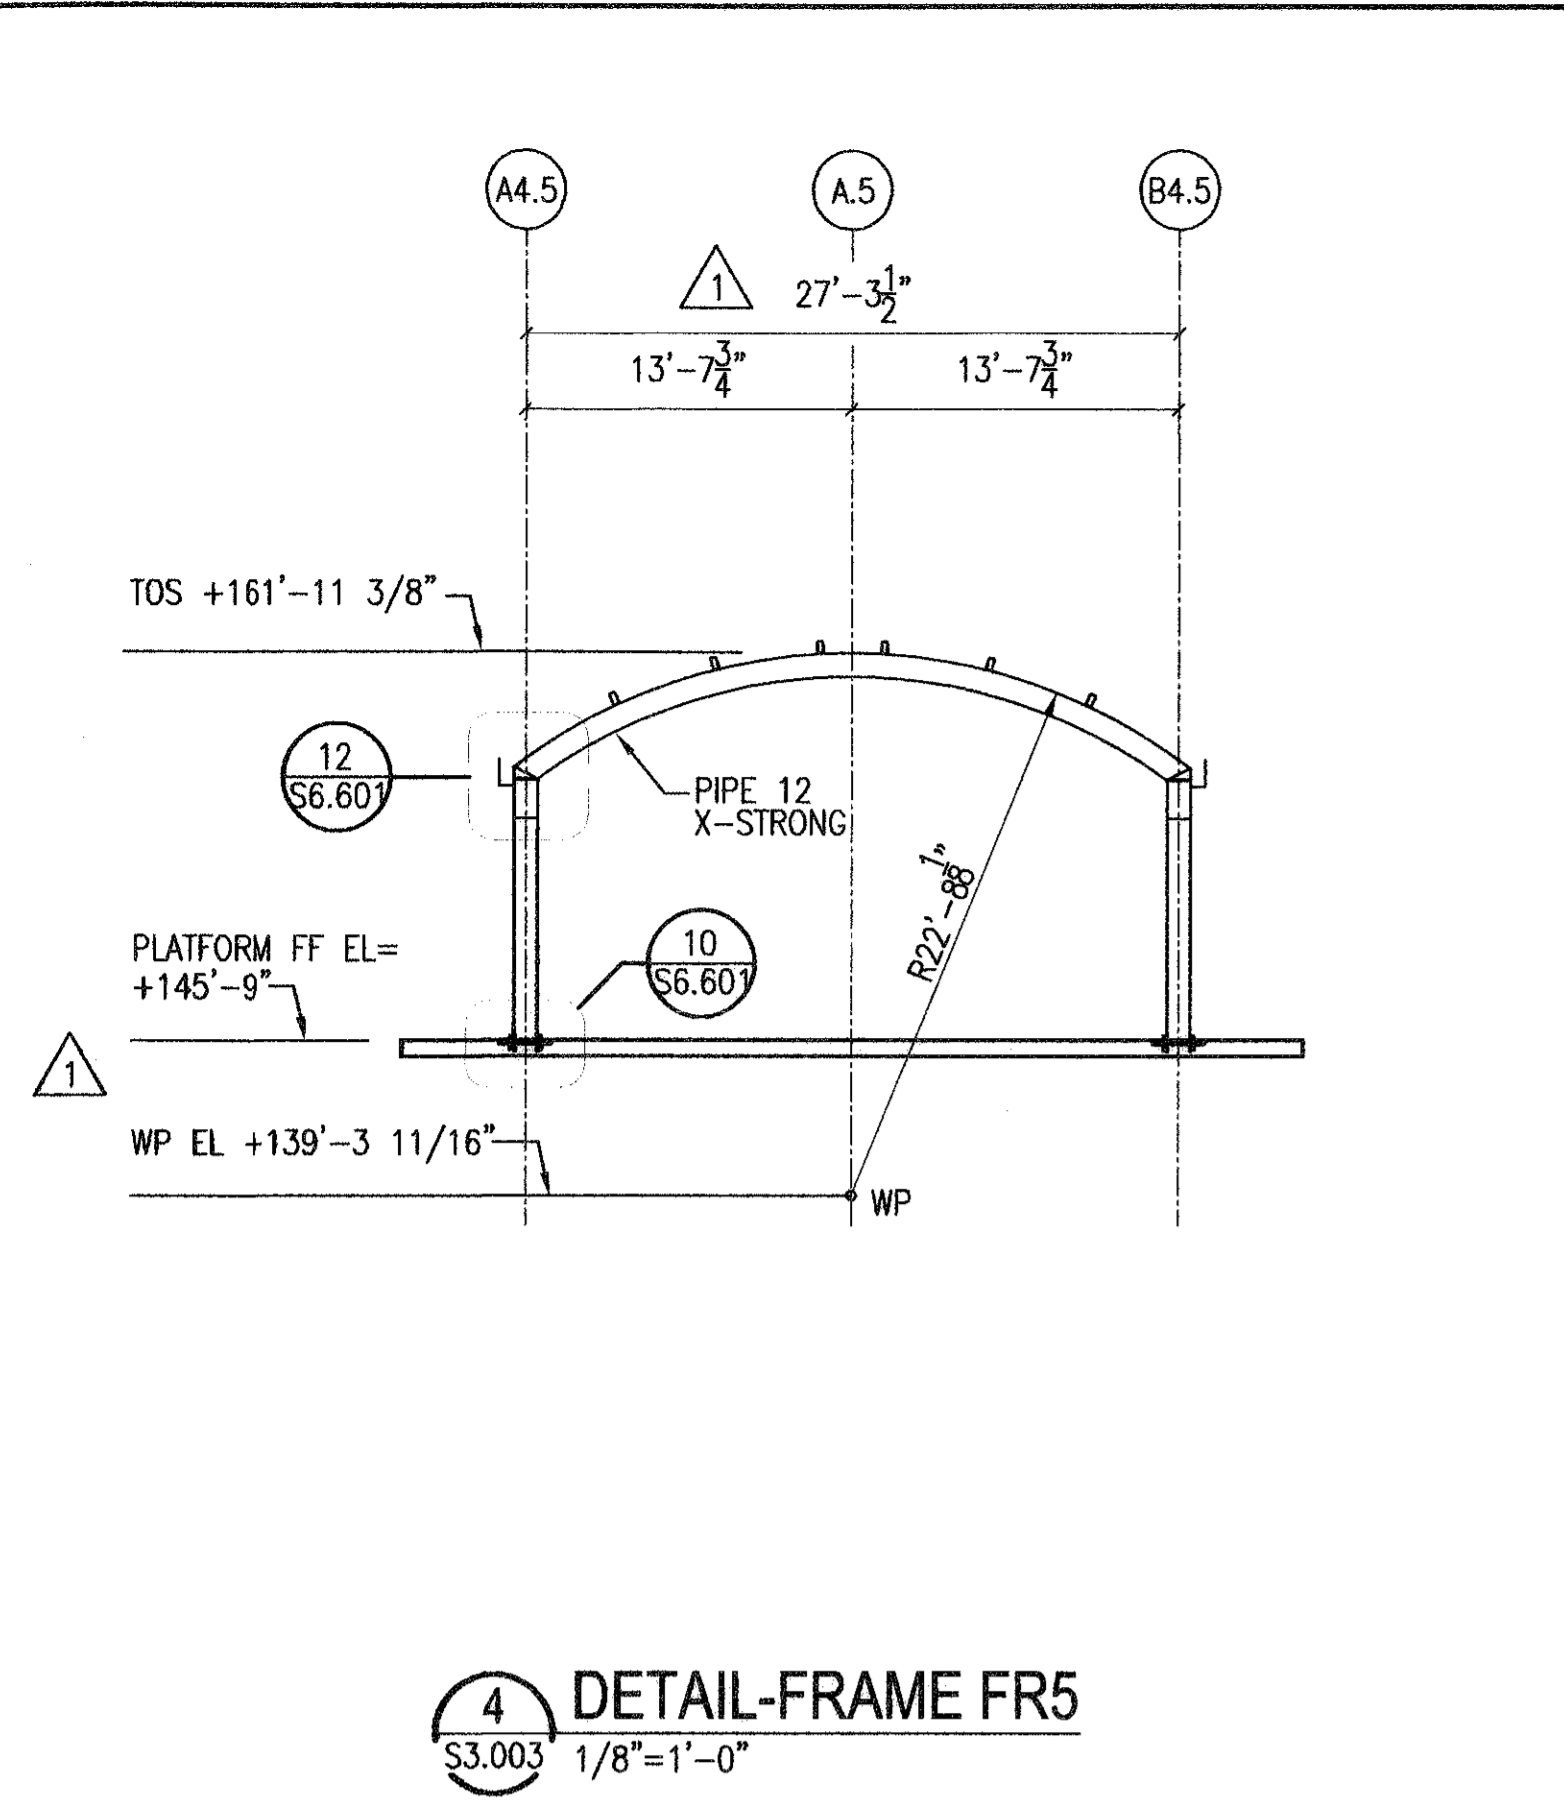


4 DETAIL-FRAME FR5  
S3.003 1/8"=1'-0"

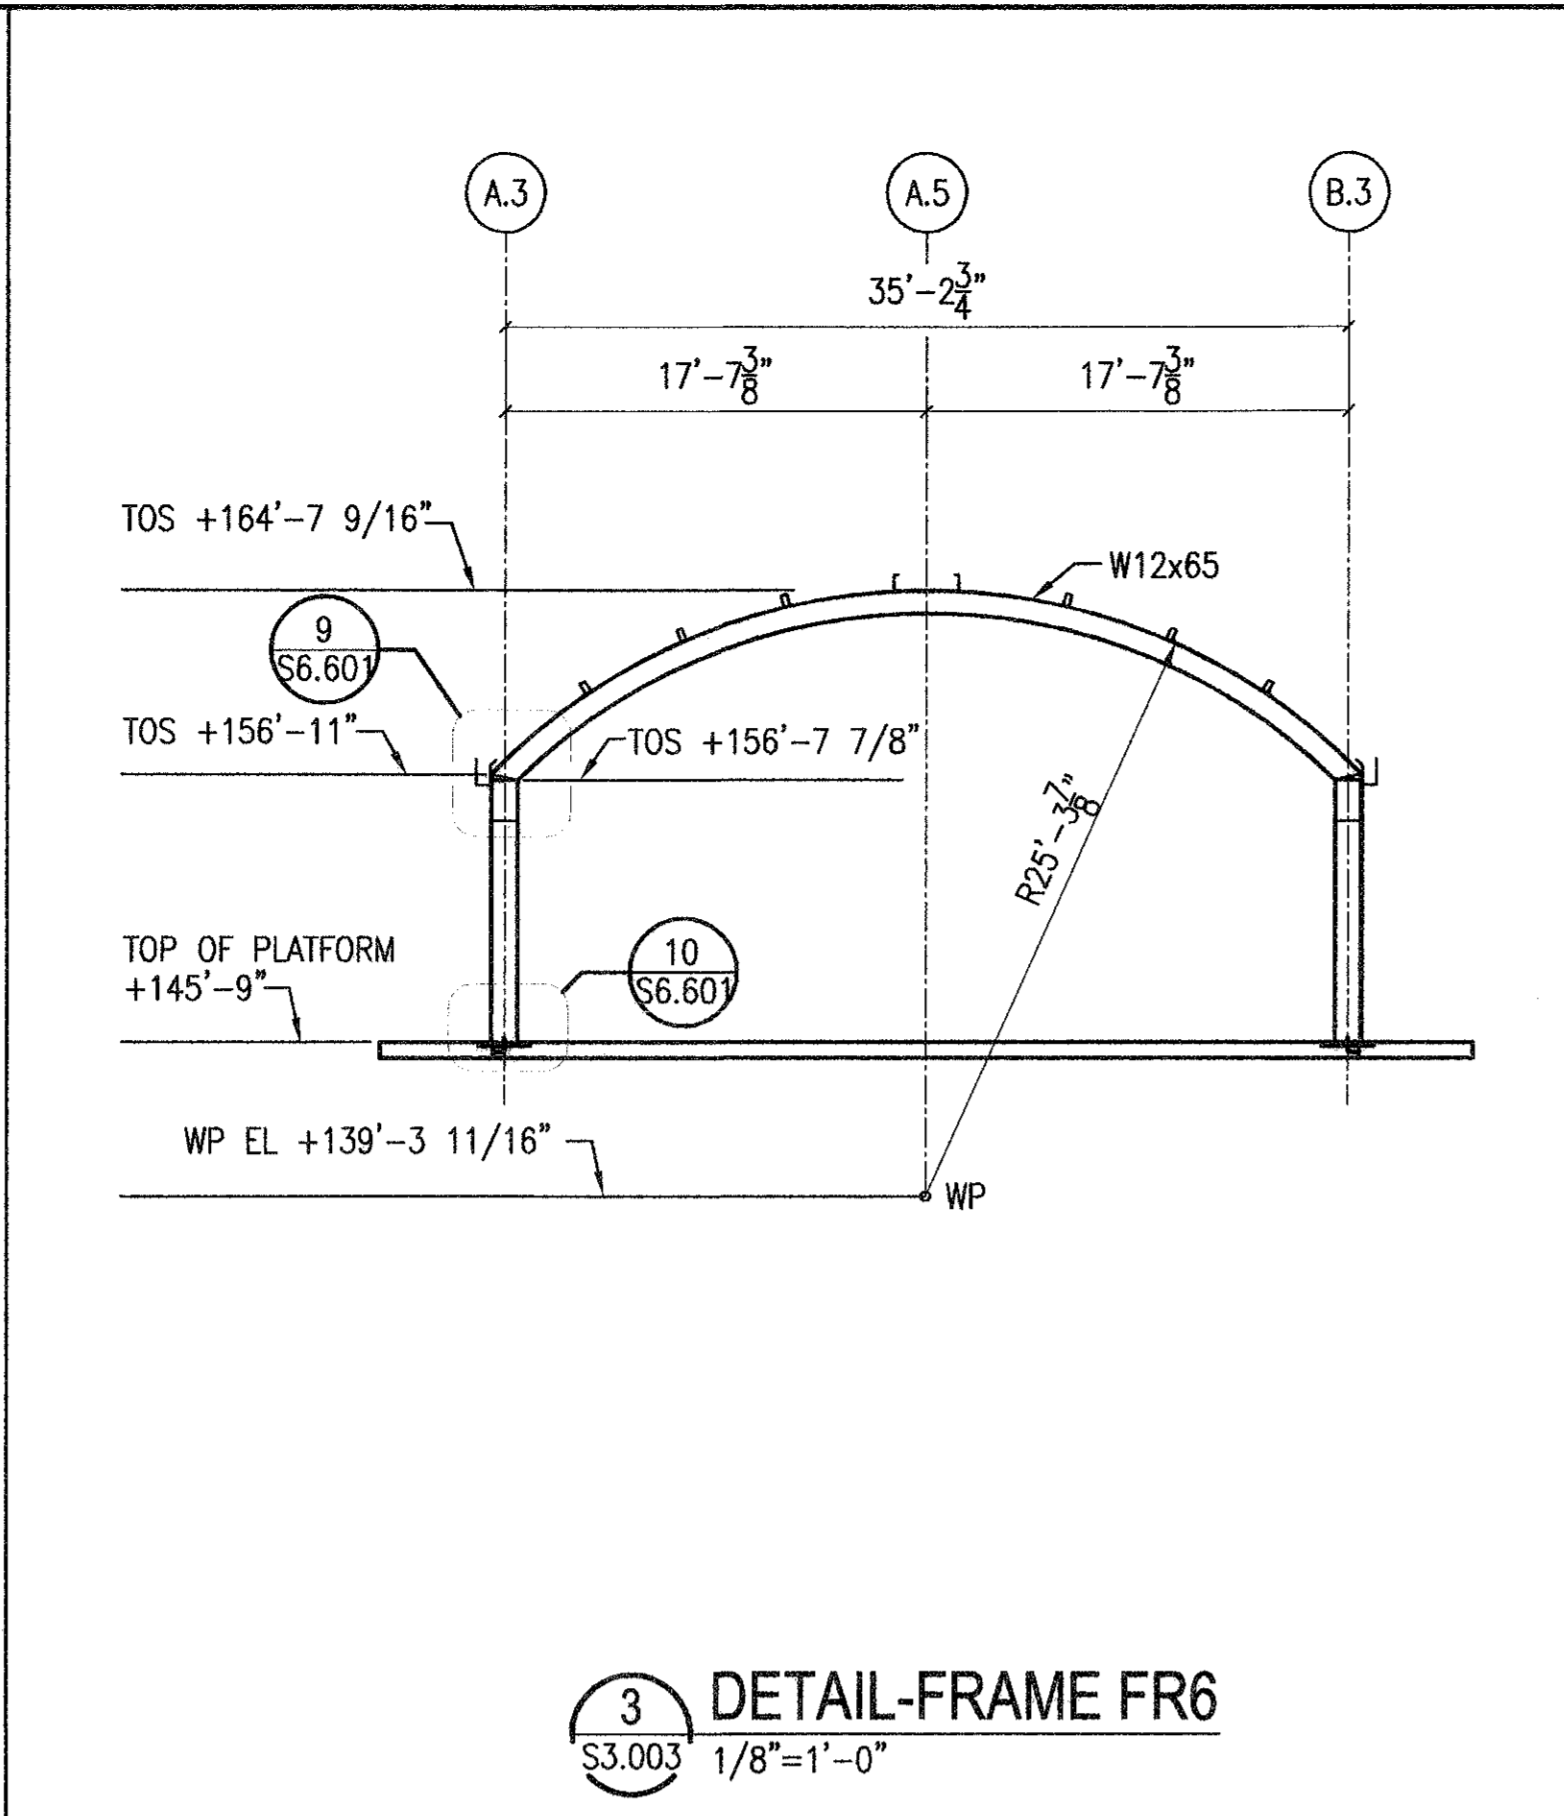


3 DETAIL-FRAME FR6  
S3.003 1/8"=1'-0"

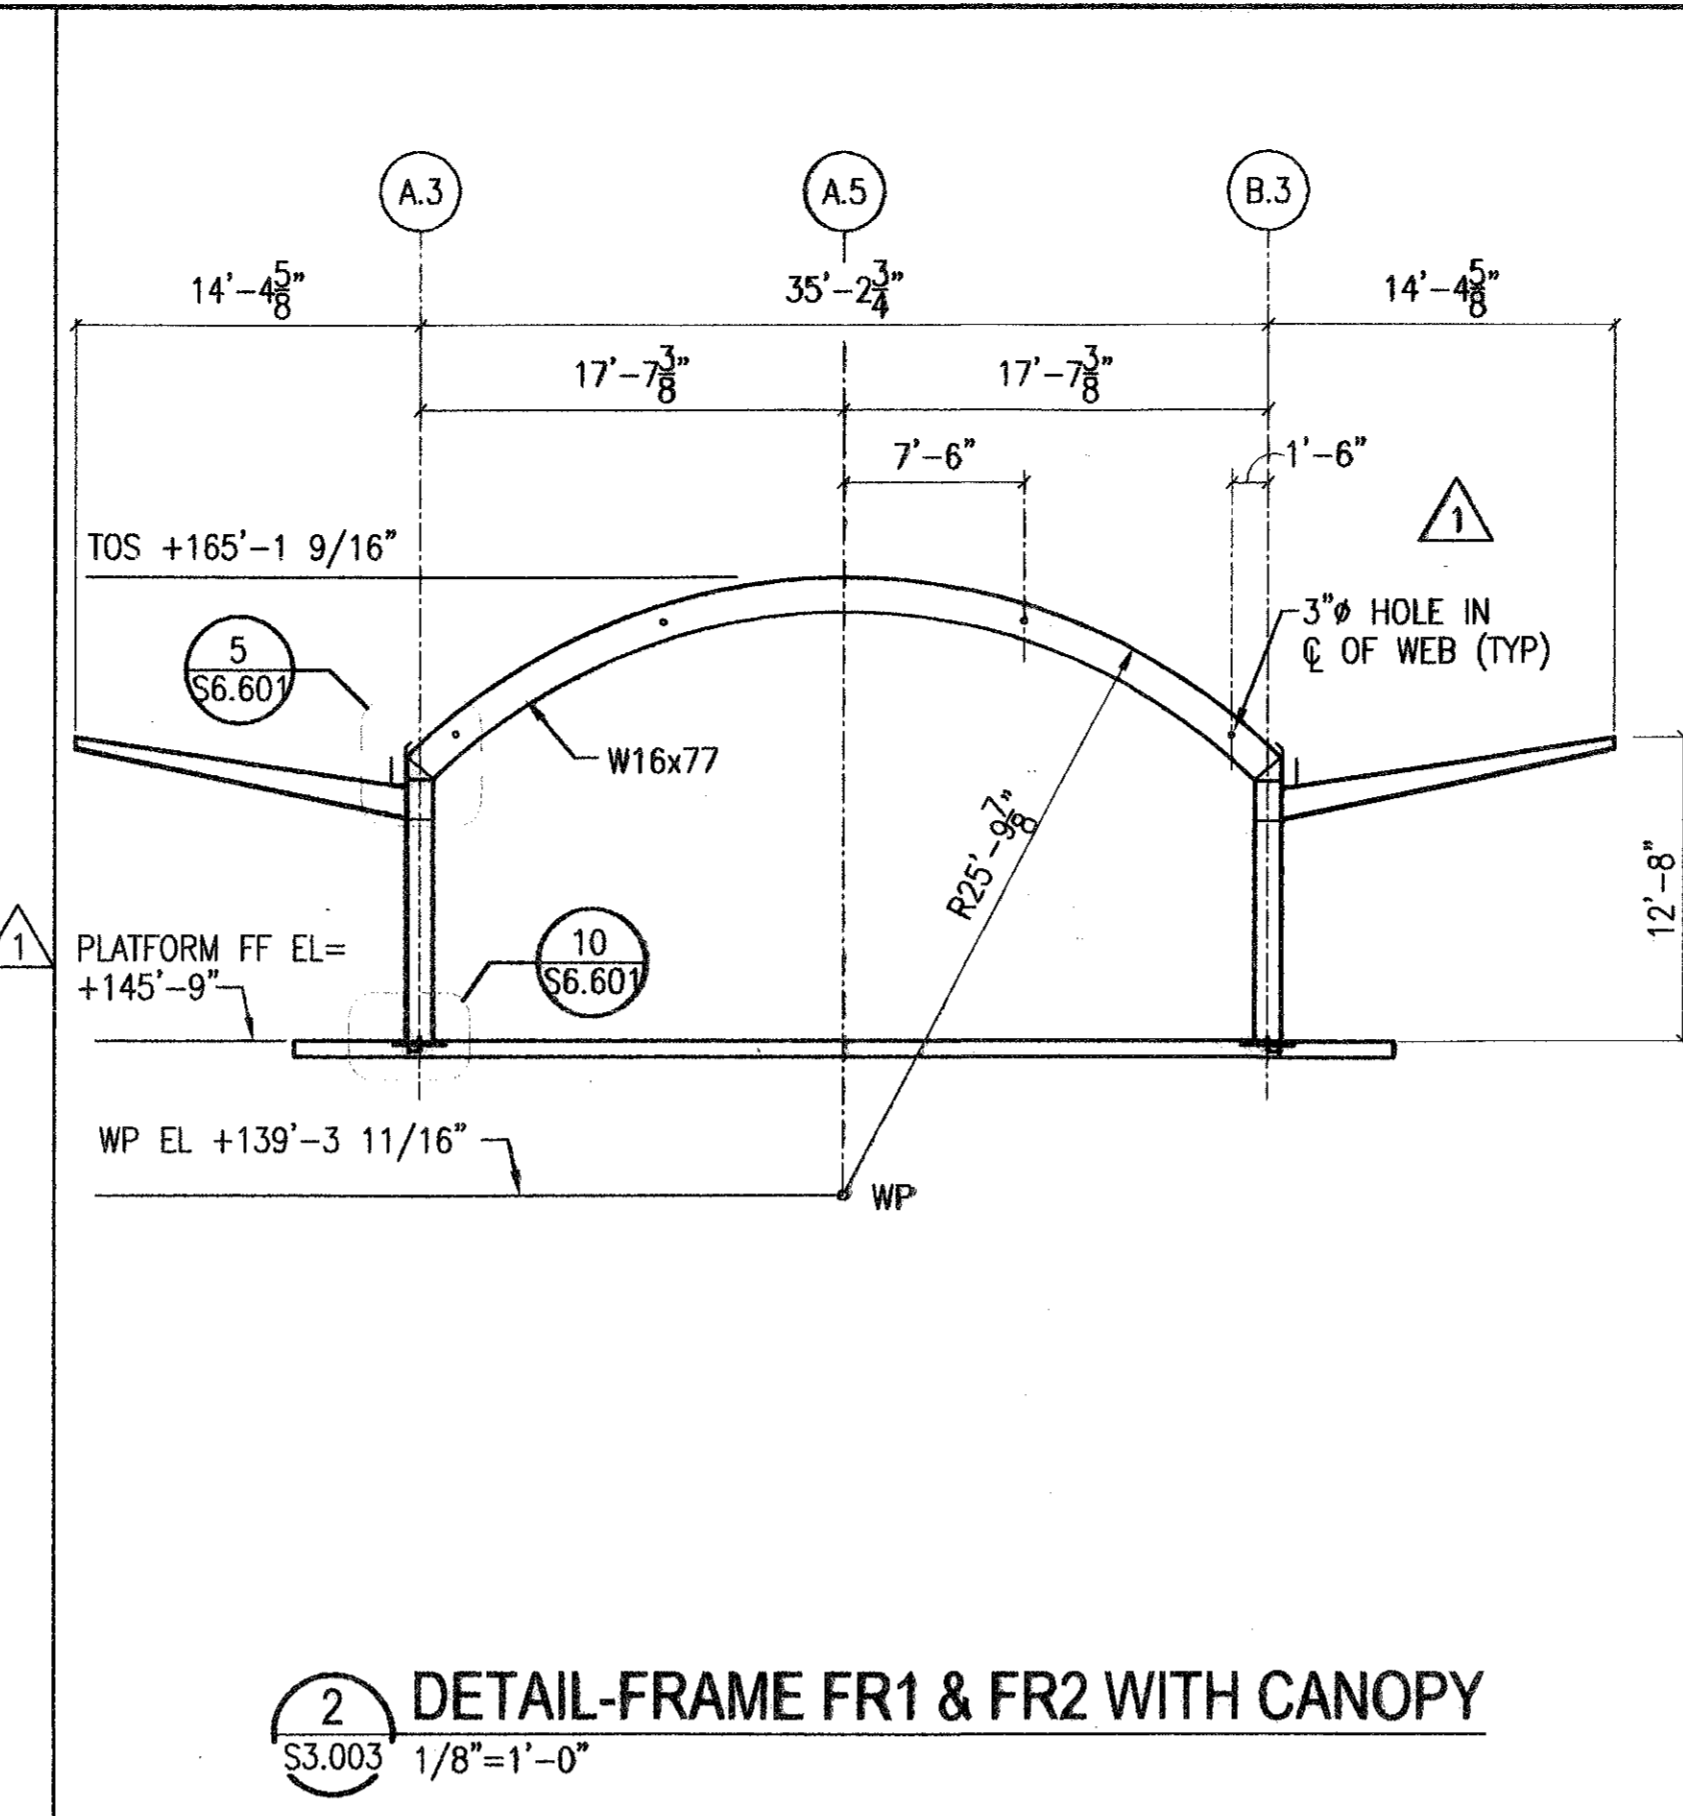


2 DETAIL-FRAME FR1 & FR2 WITH CANOPY  
S3.003 1/8"=1'-0"

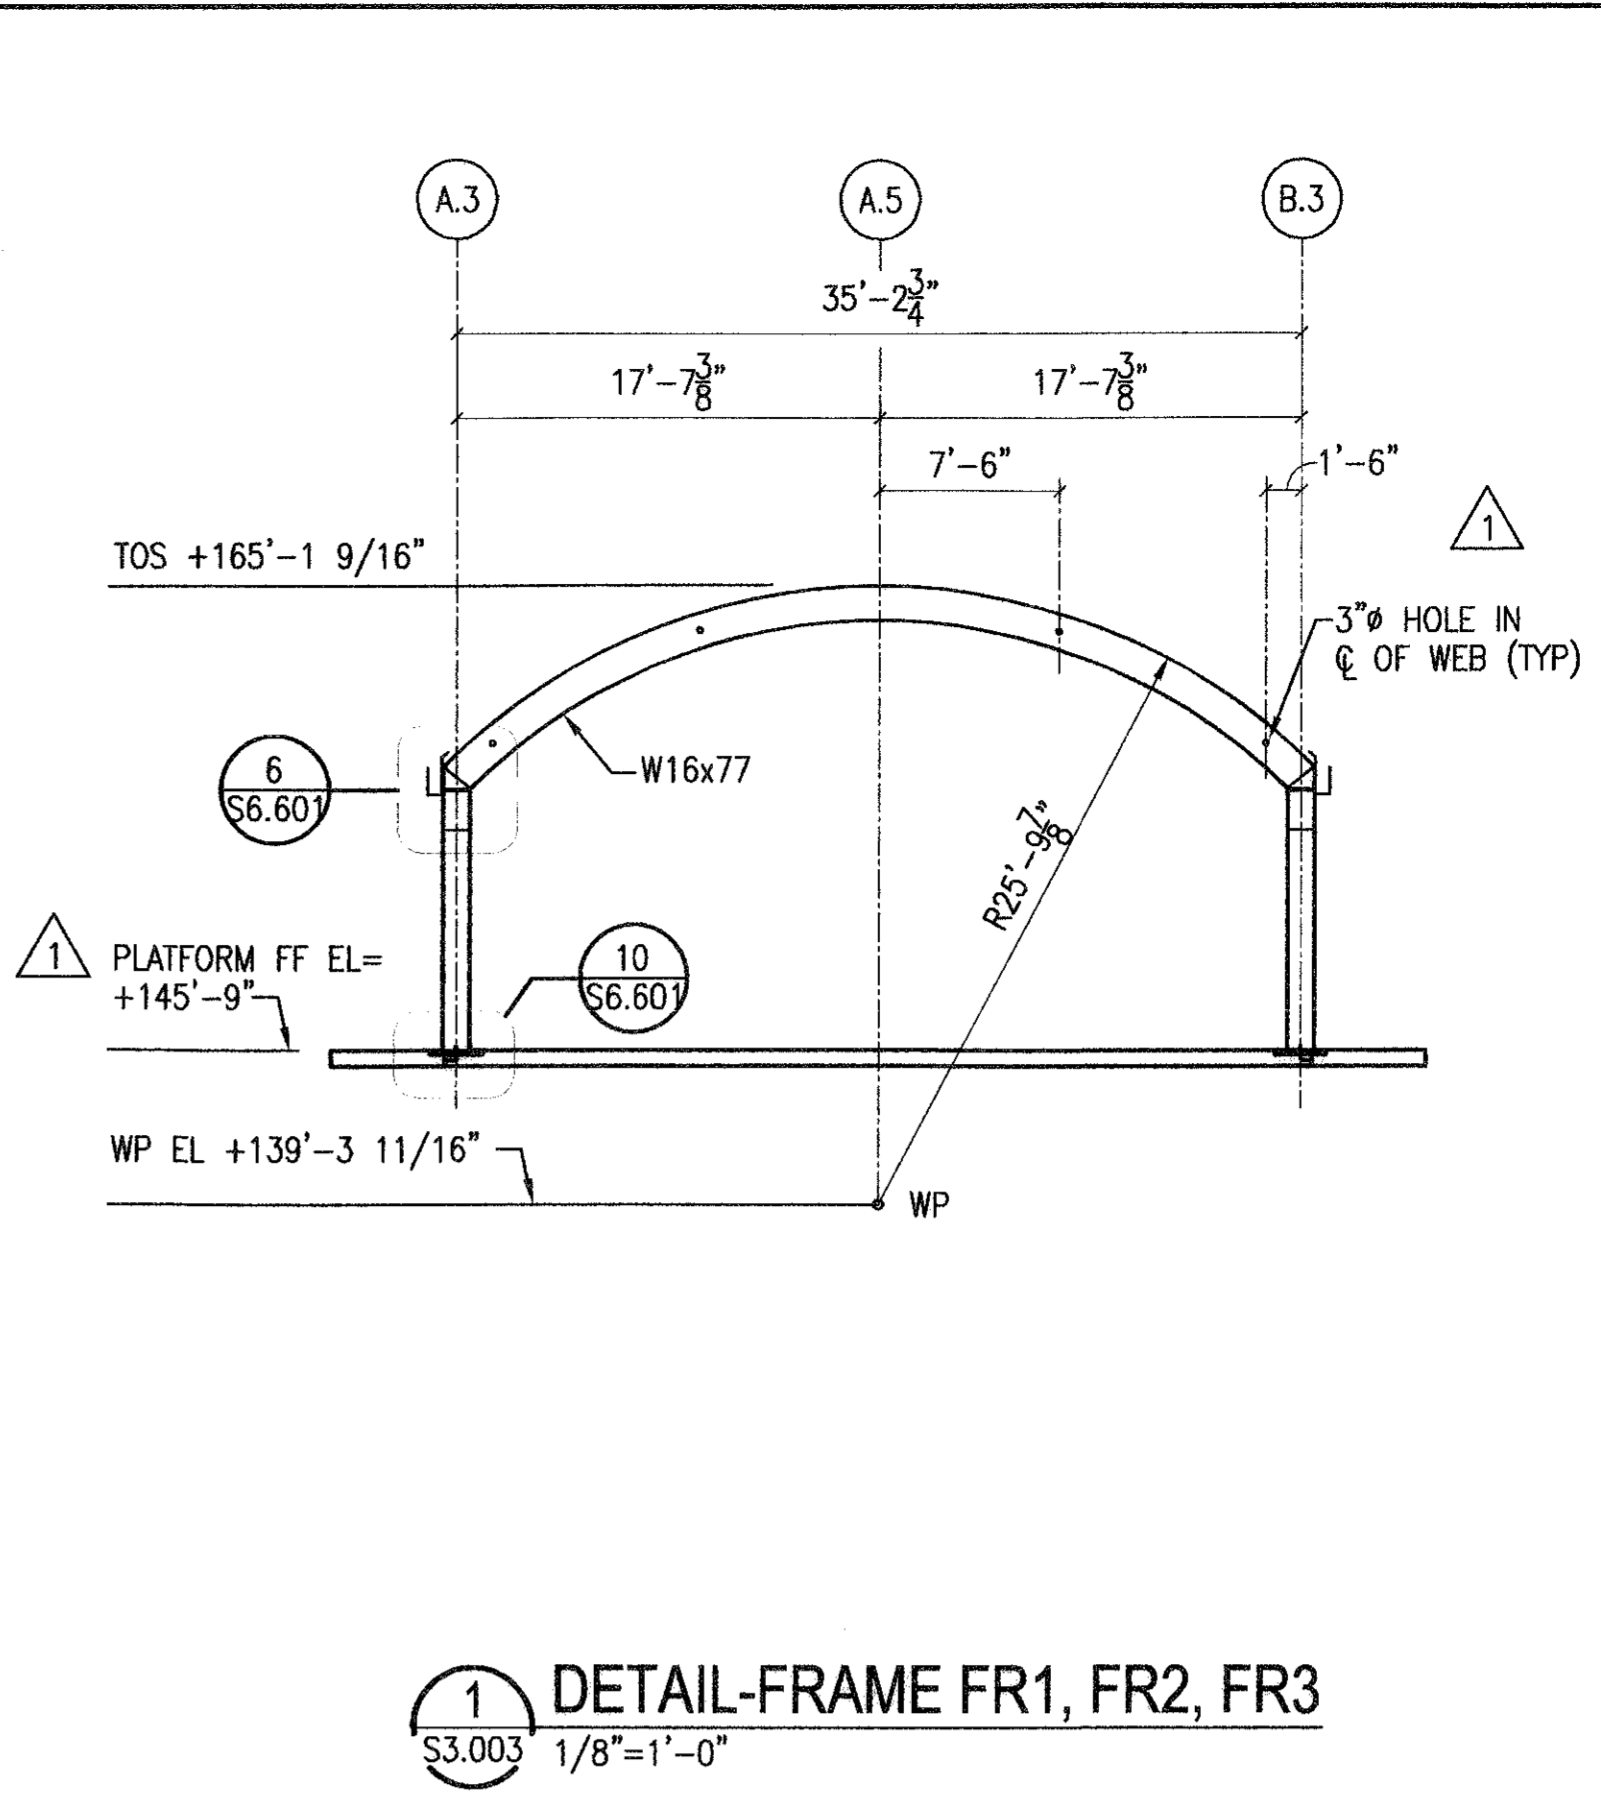


1 DETAIL-FRAME FR1, FR2, FR3  
S3.003 1/8"=1'-0"

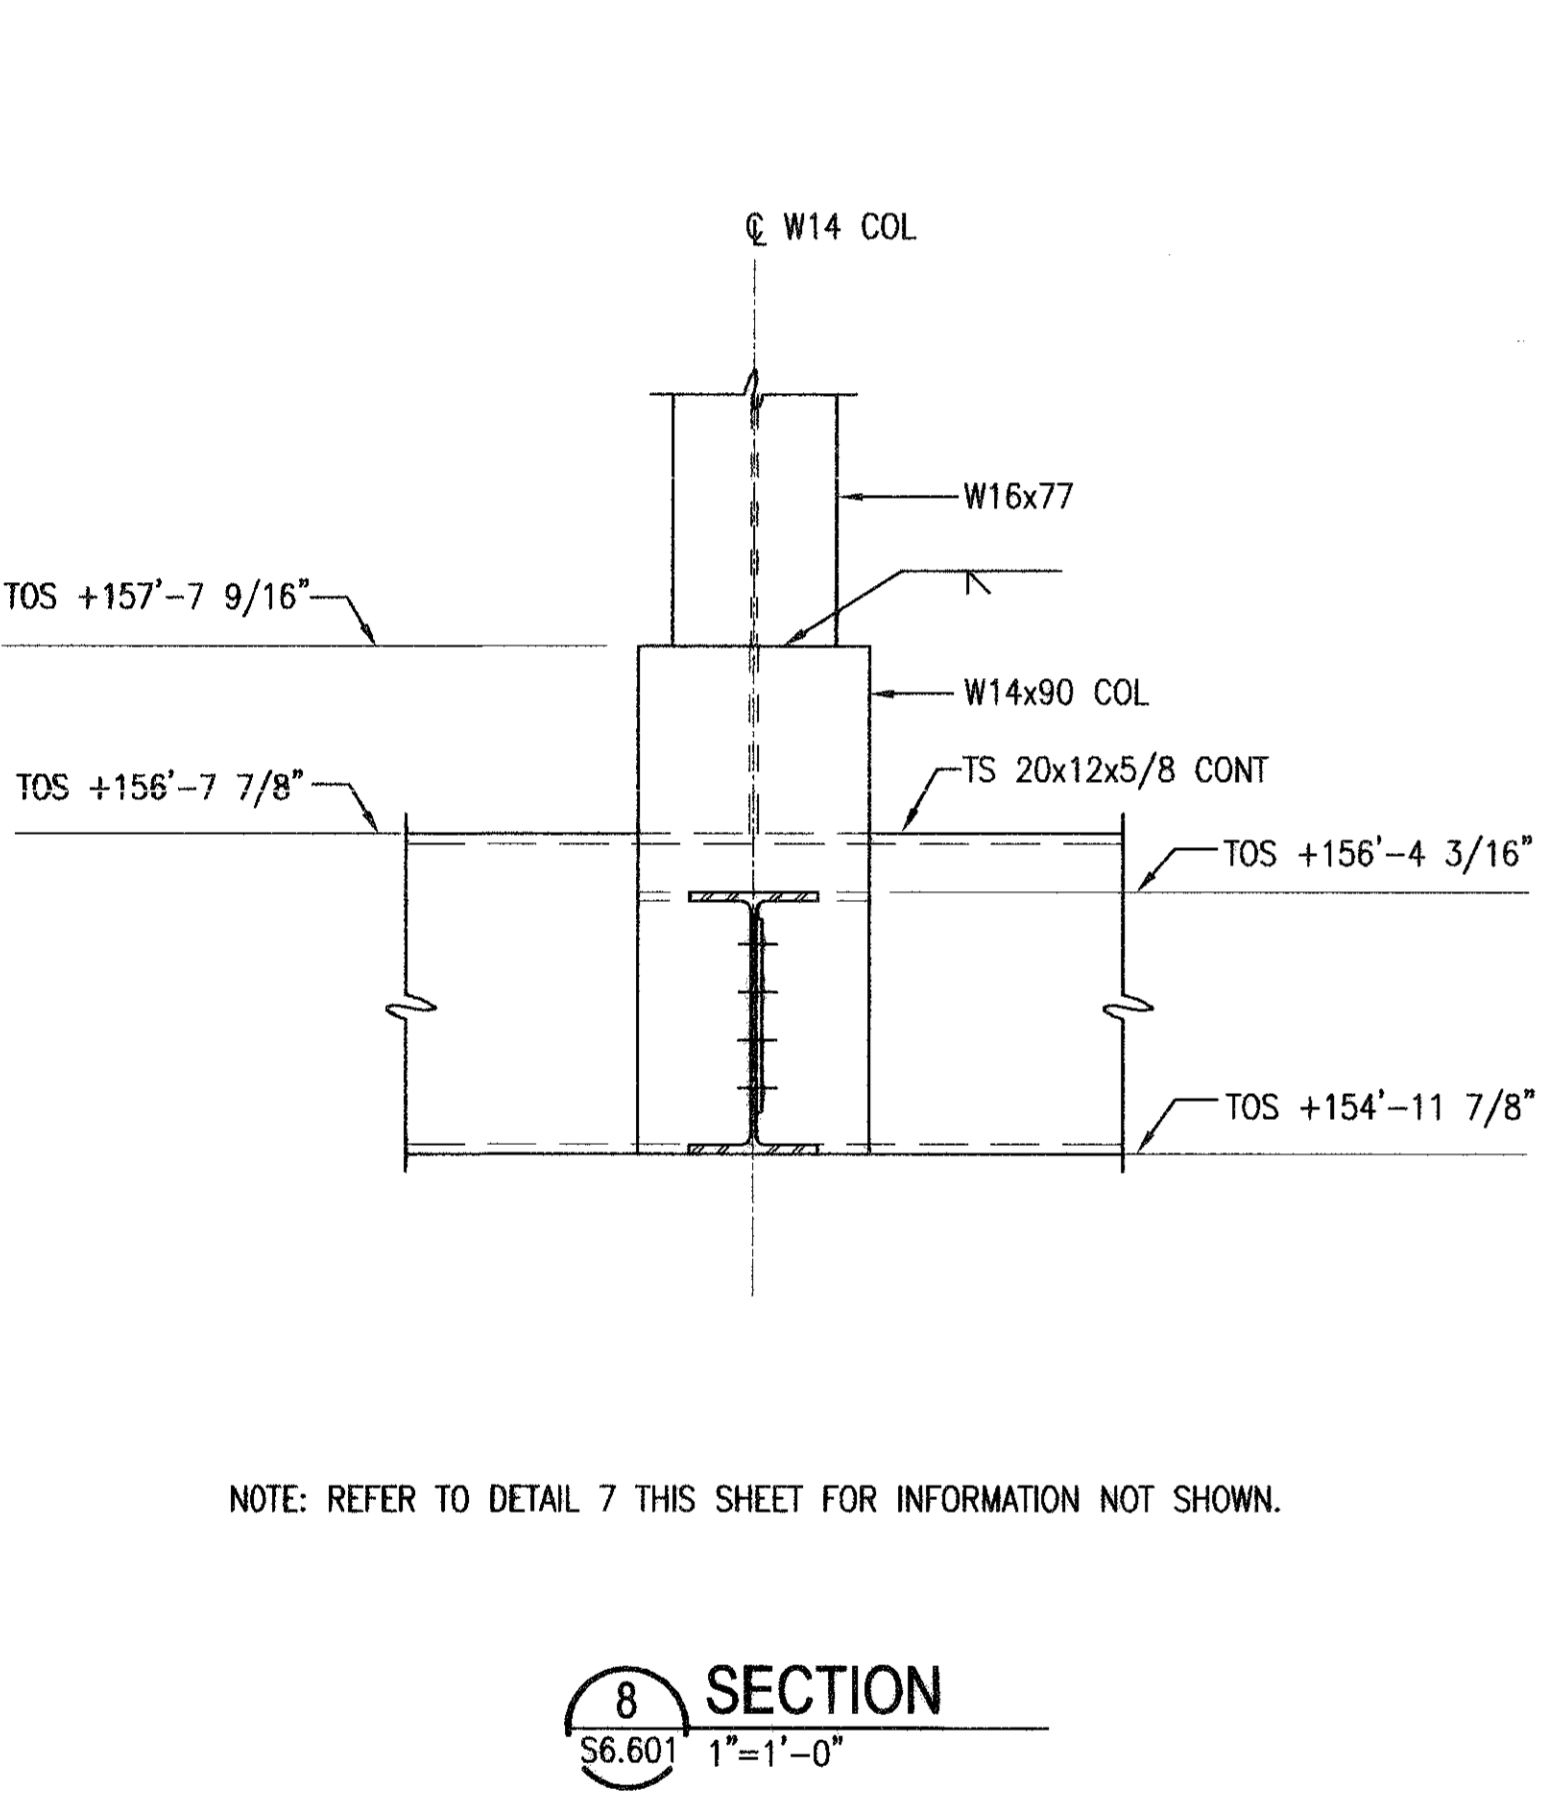


8 SECTION  
S6.601 1"=1'-0"

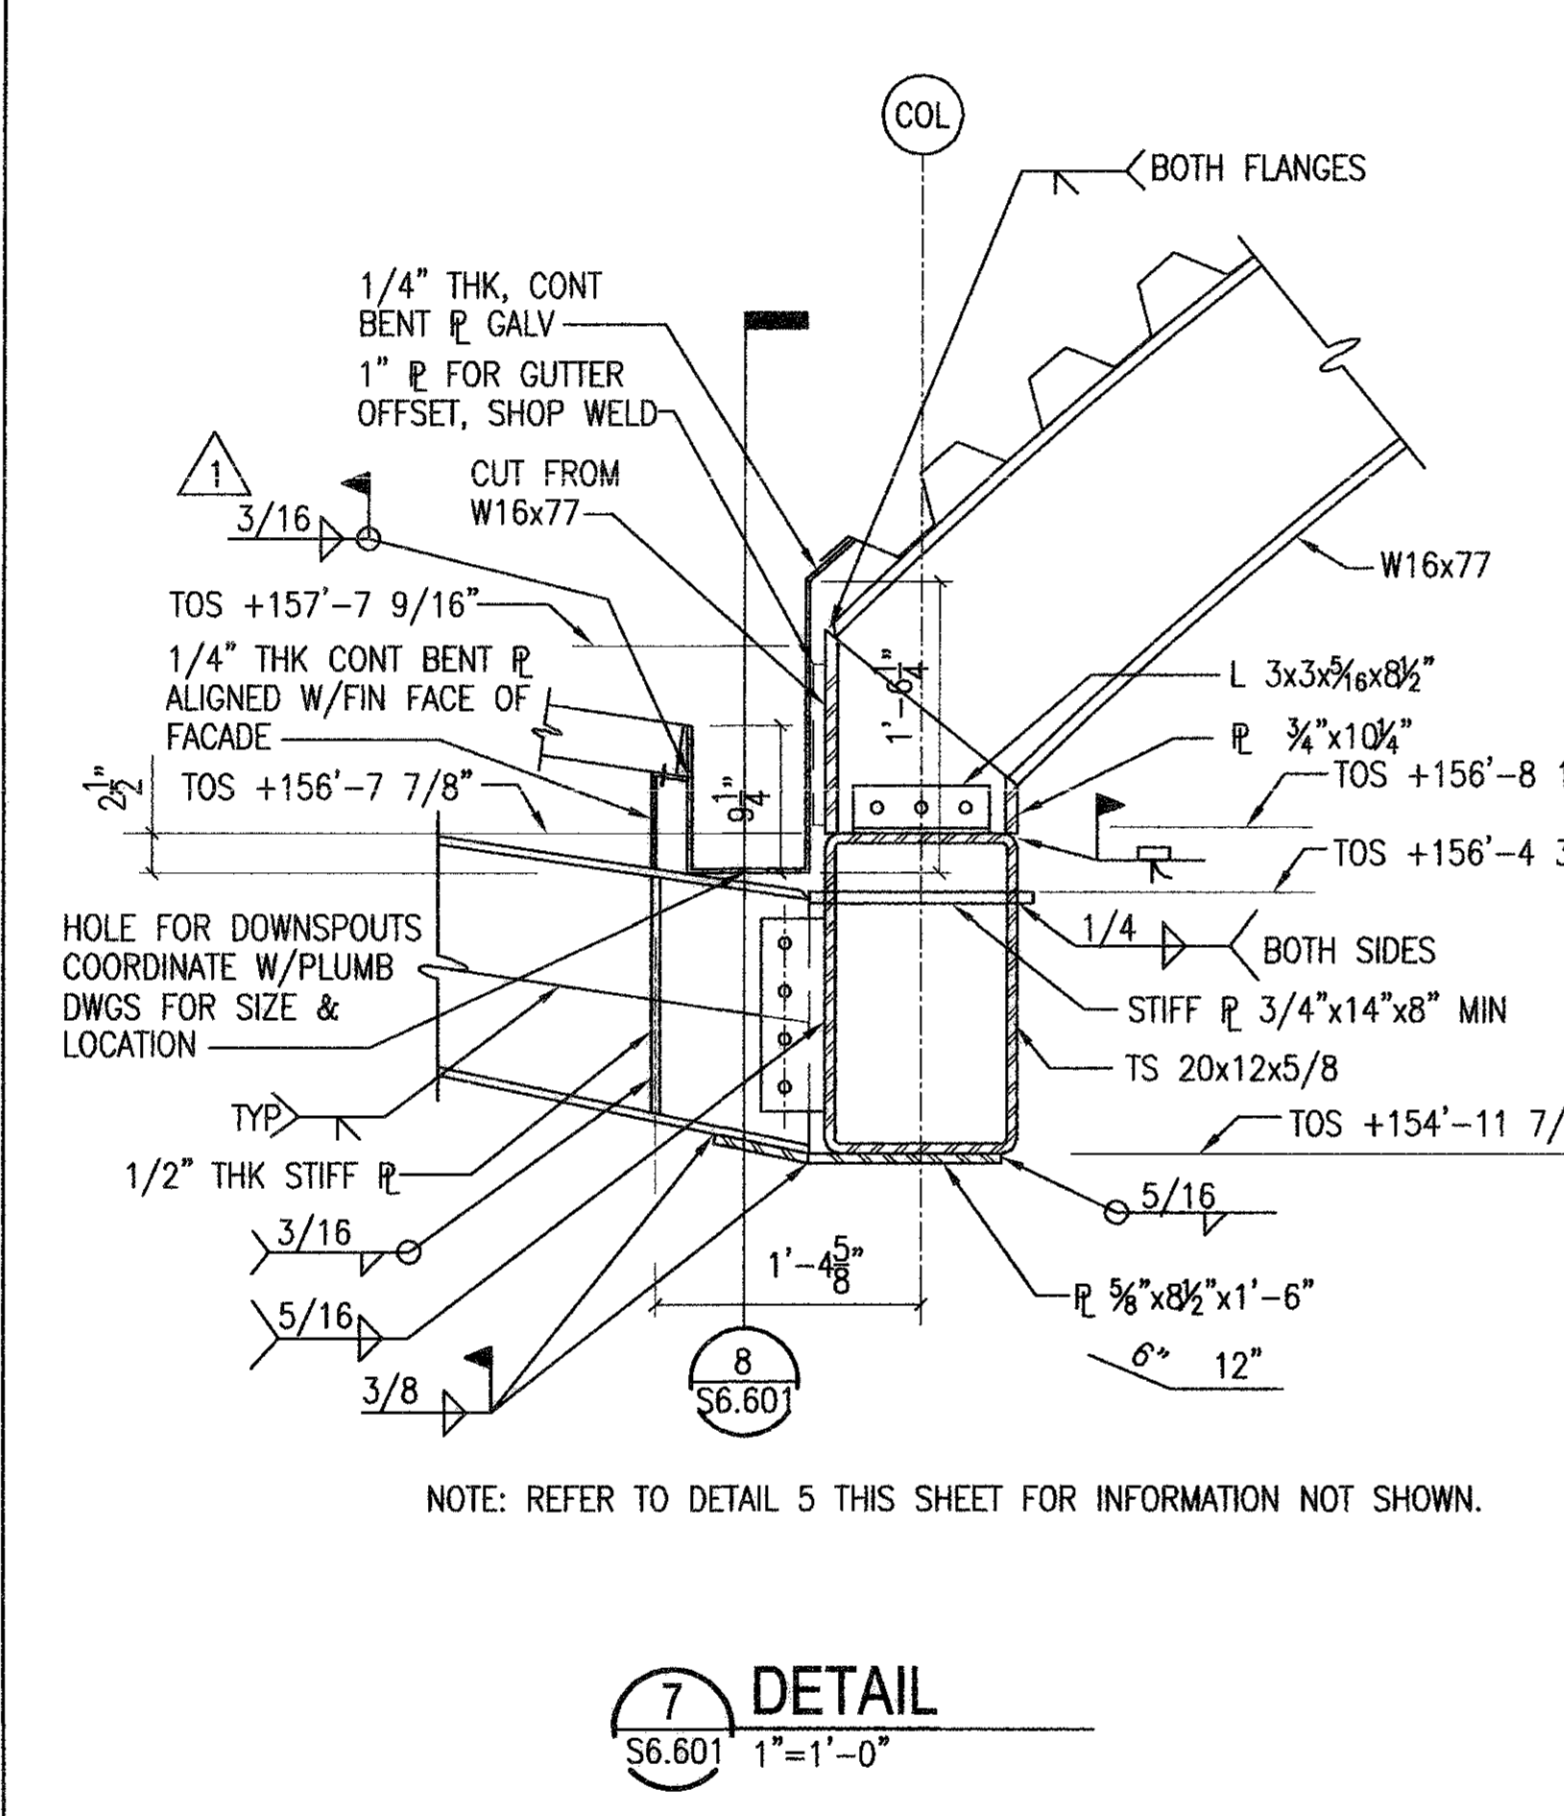


7 DETAIL  
S6.601 1"=1'-0"

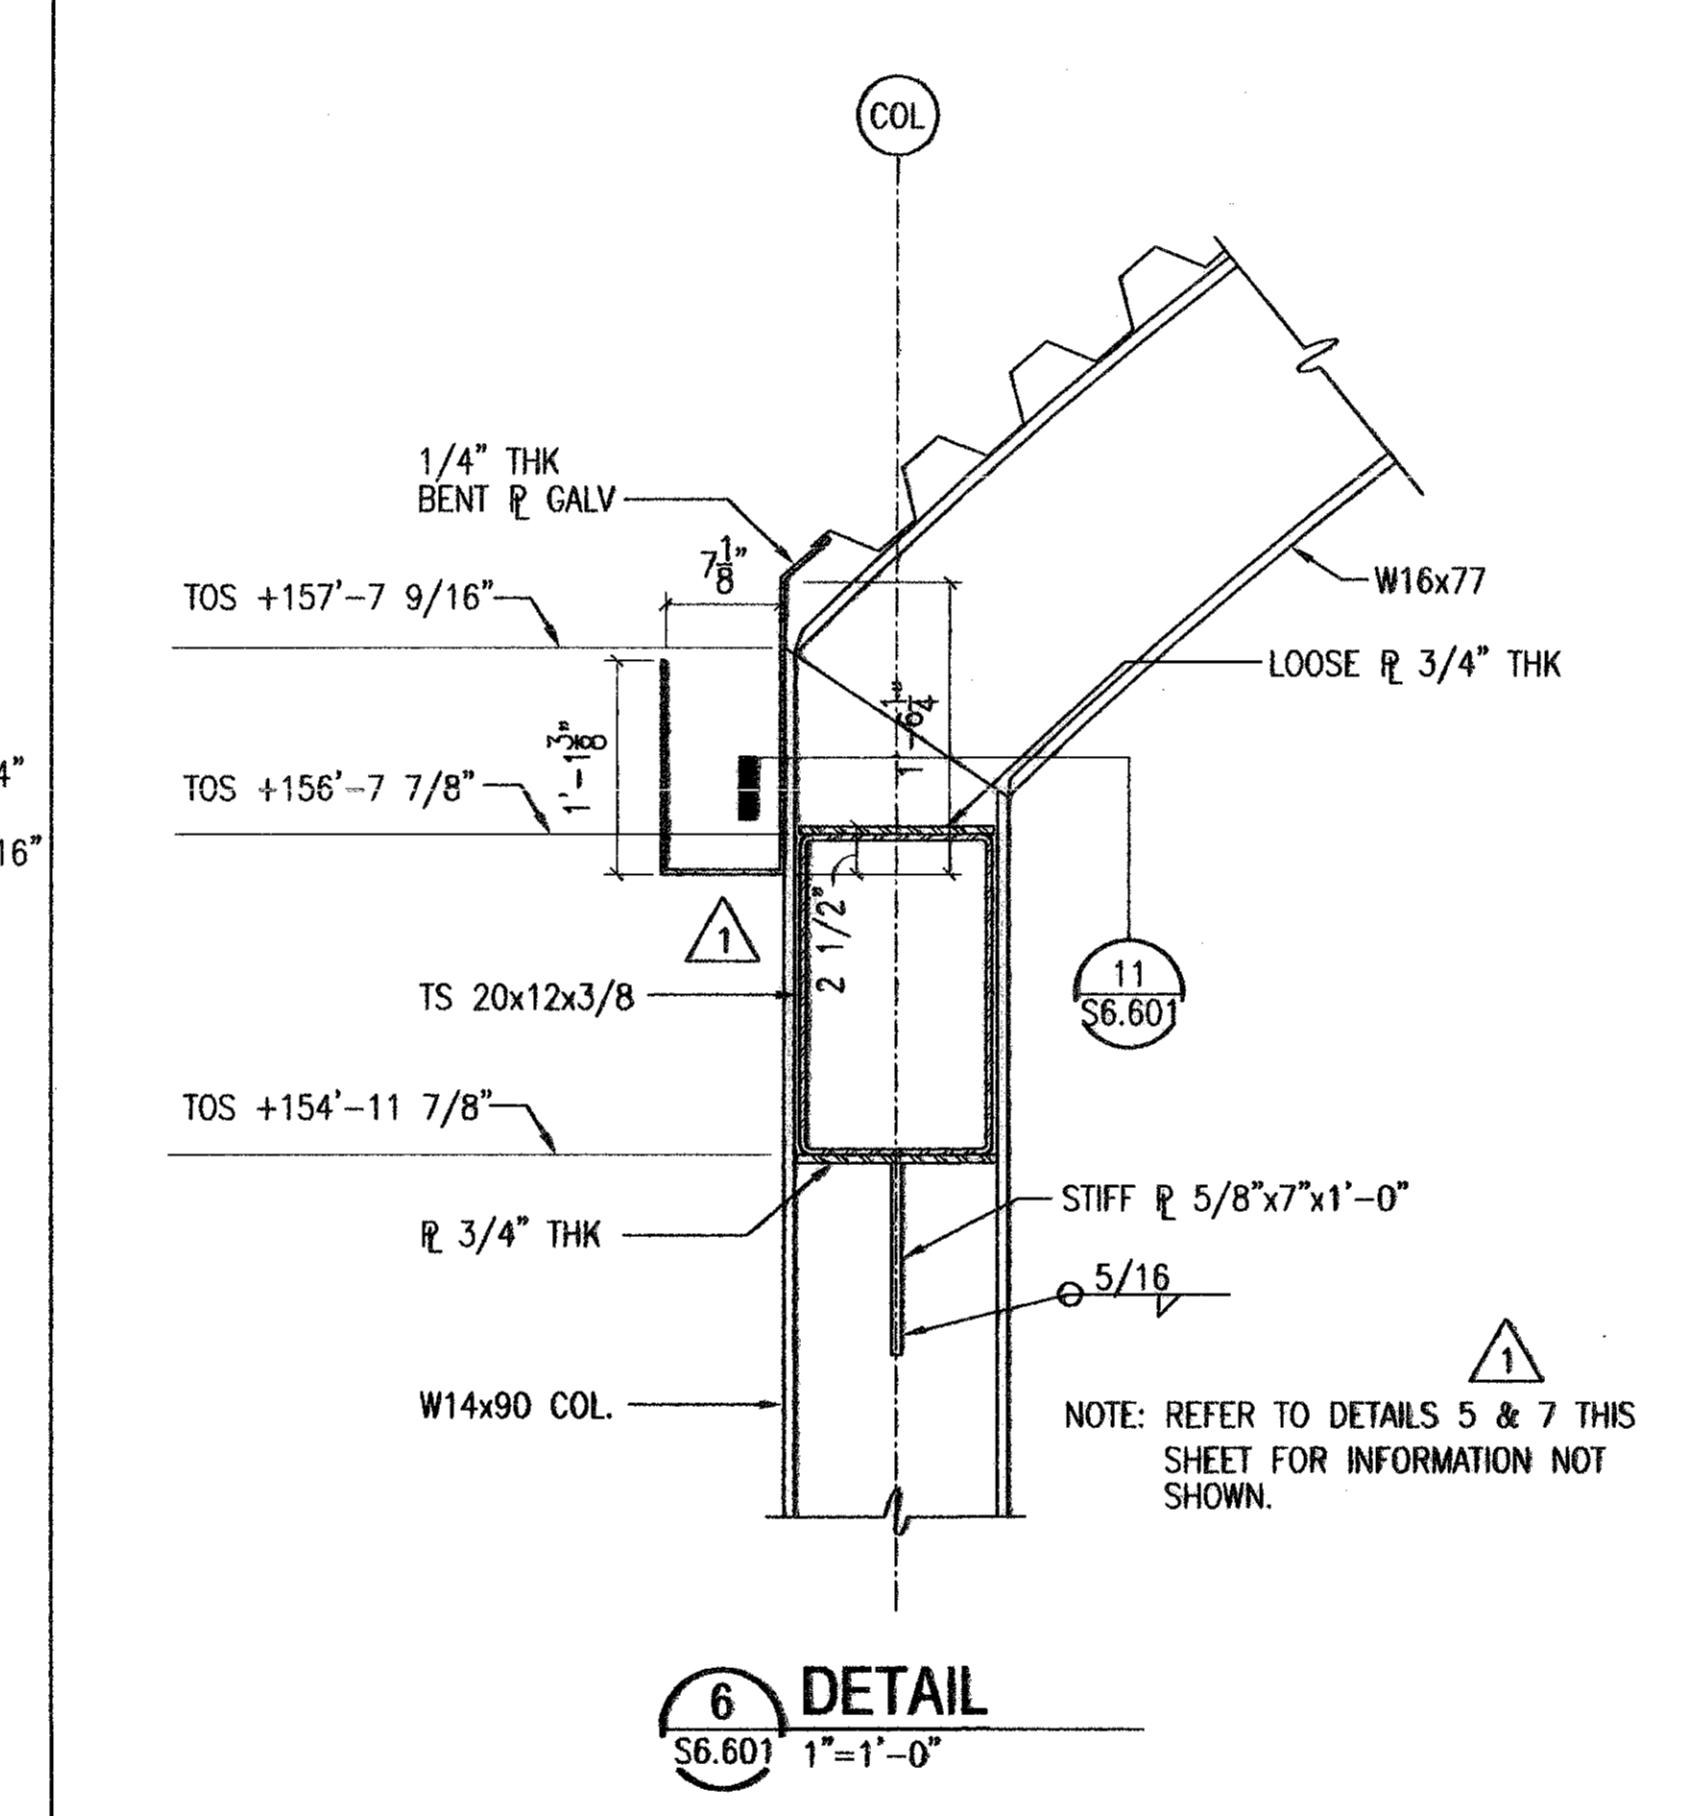


6 DETAIL  
S6.601 1"=1'-0"

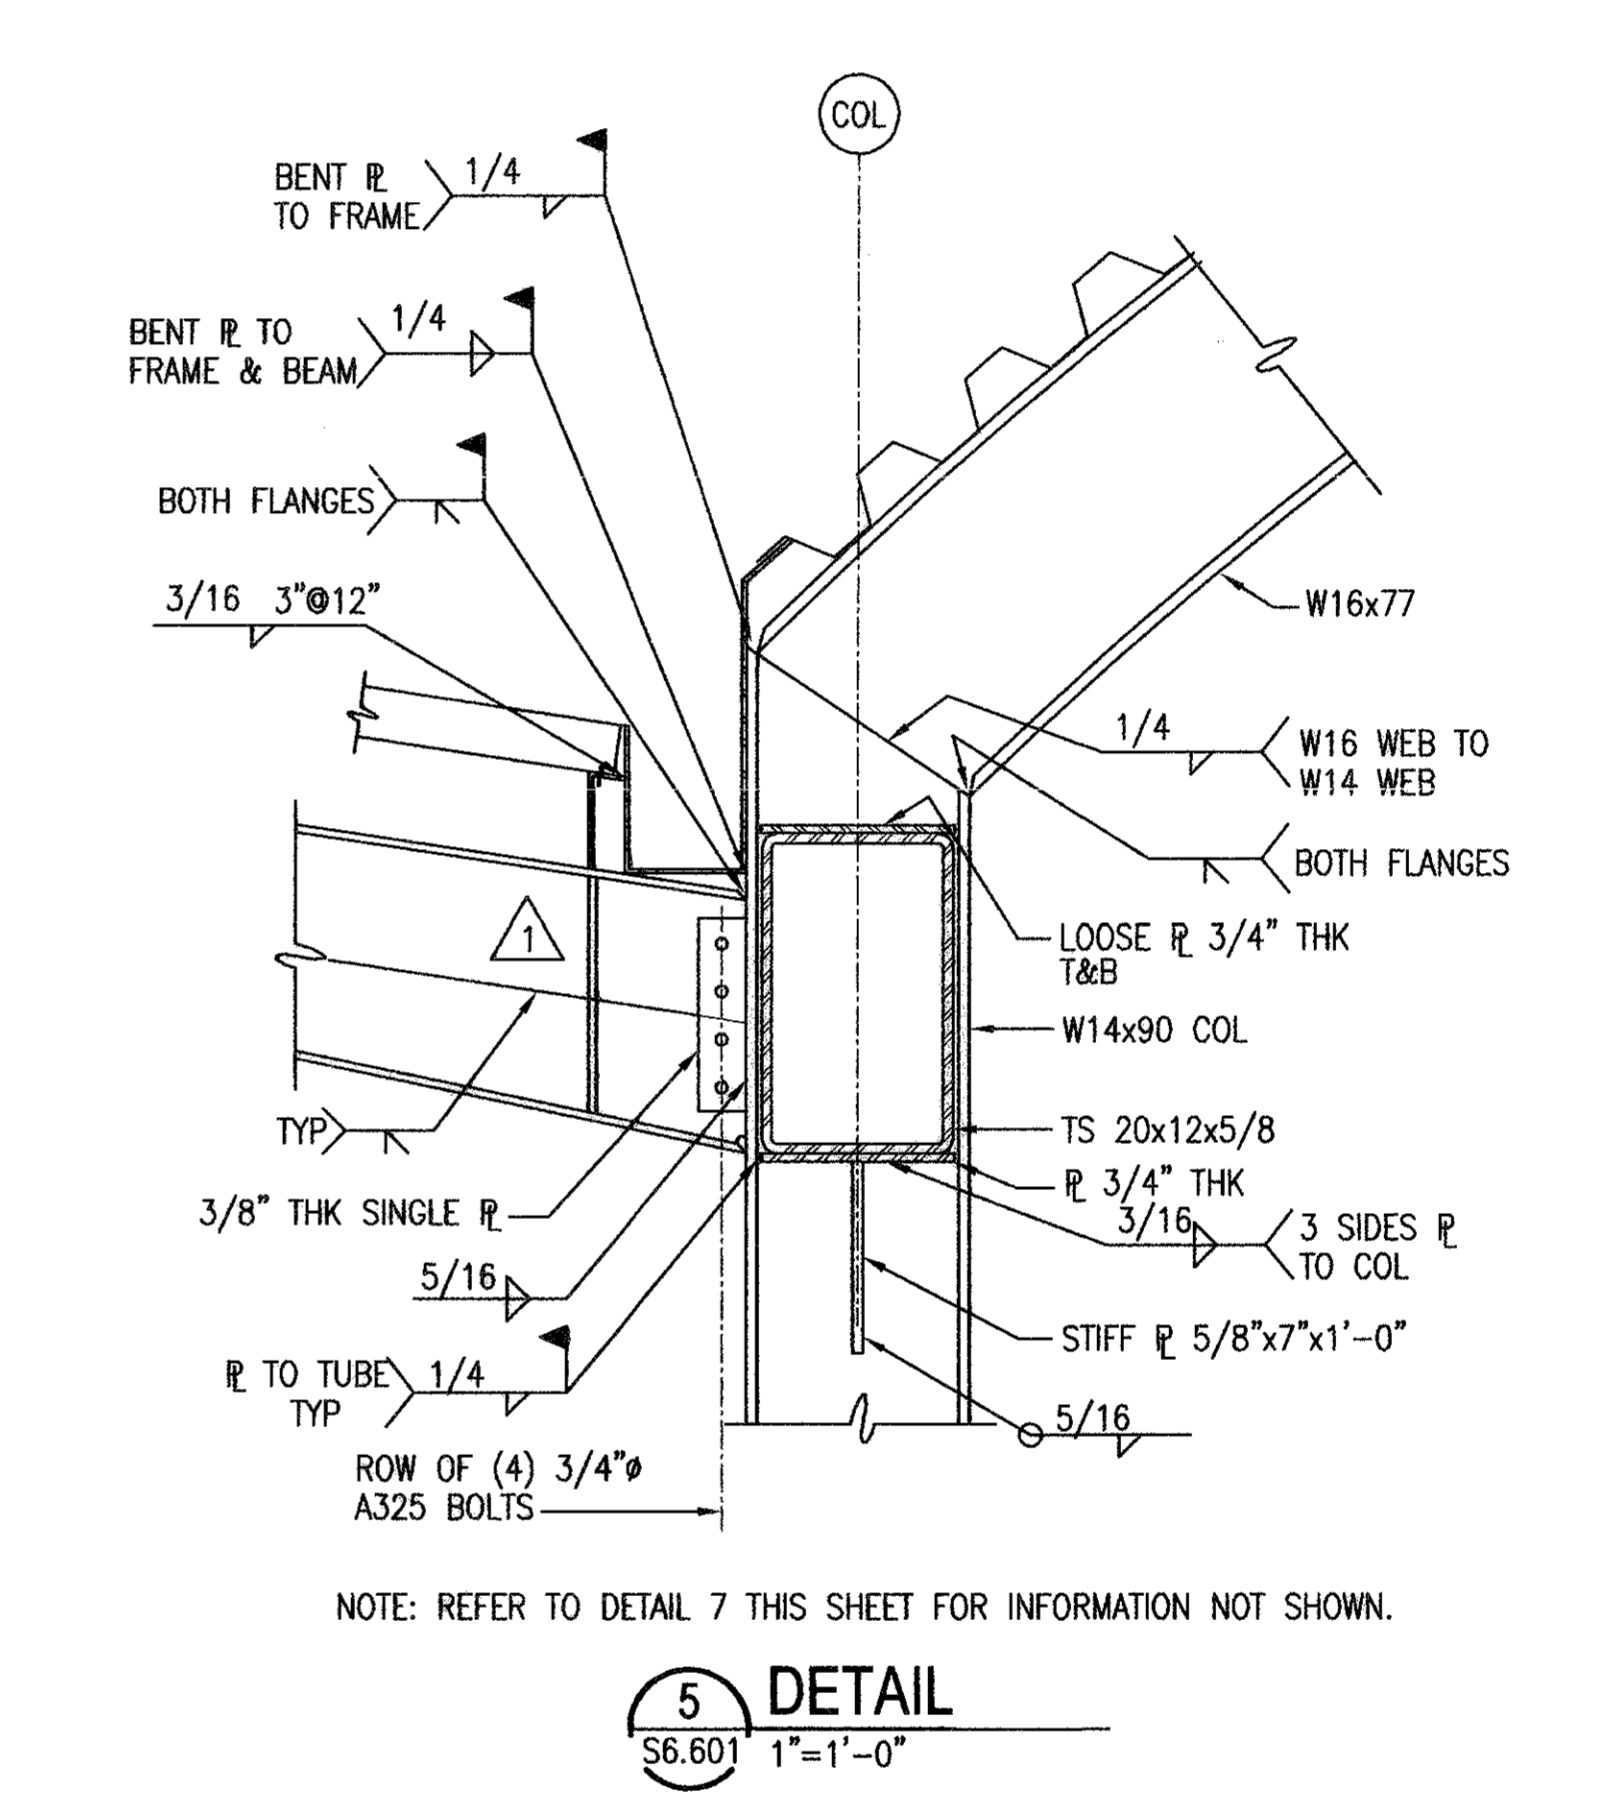


5 DETAIL  
S6.601 1"=1'-0"

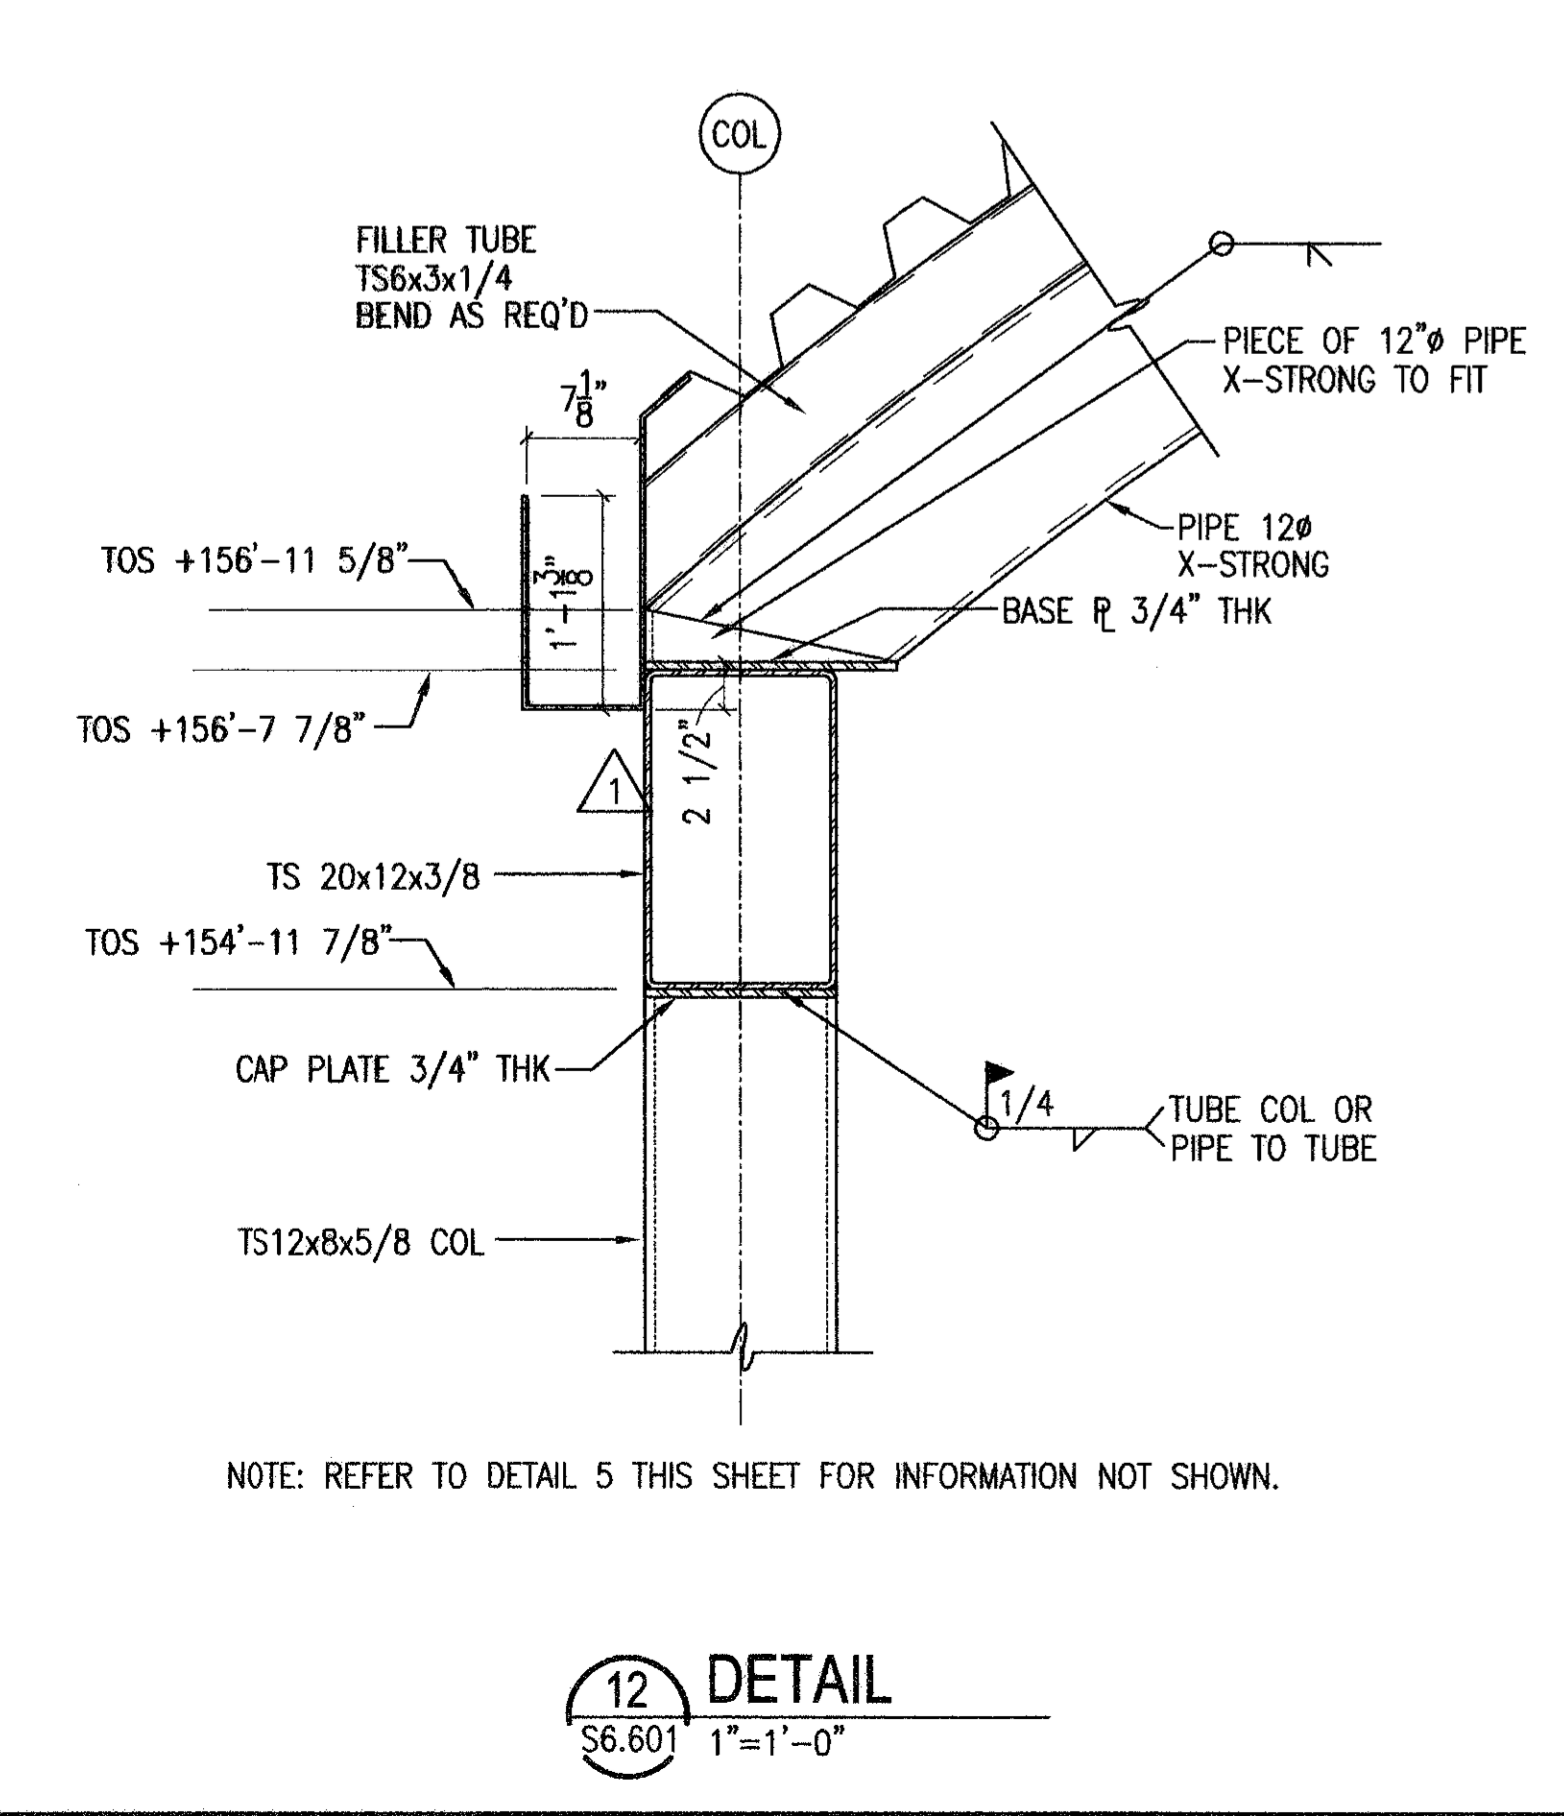


12 DETAIL  
S6.601 1"=1'-0"

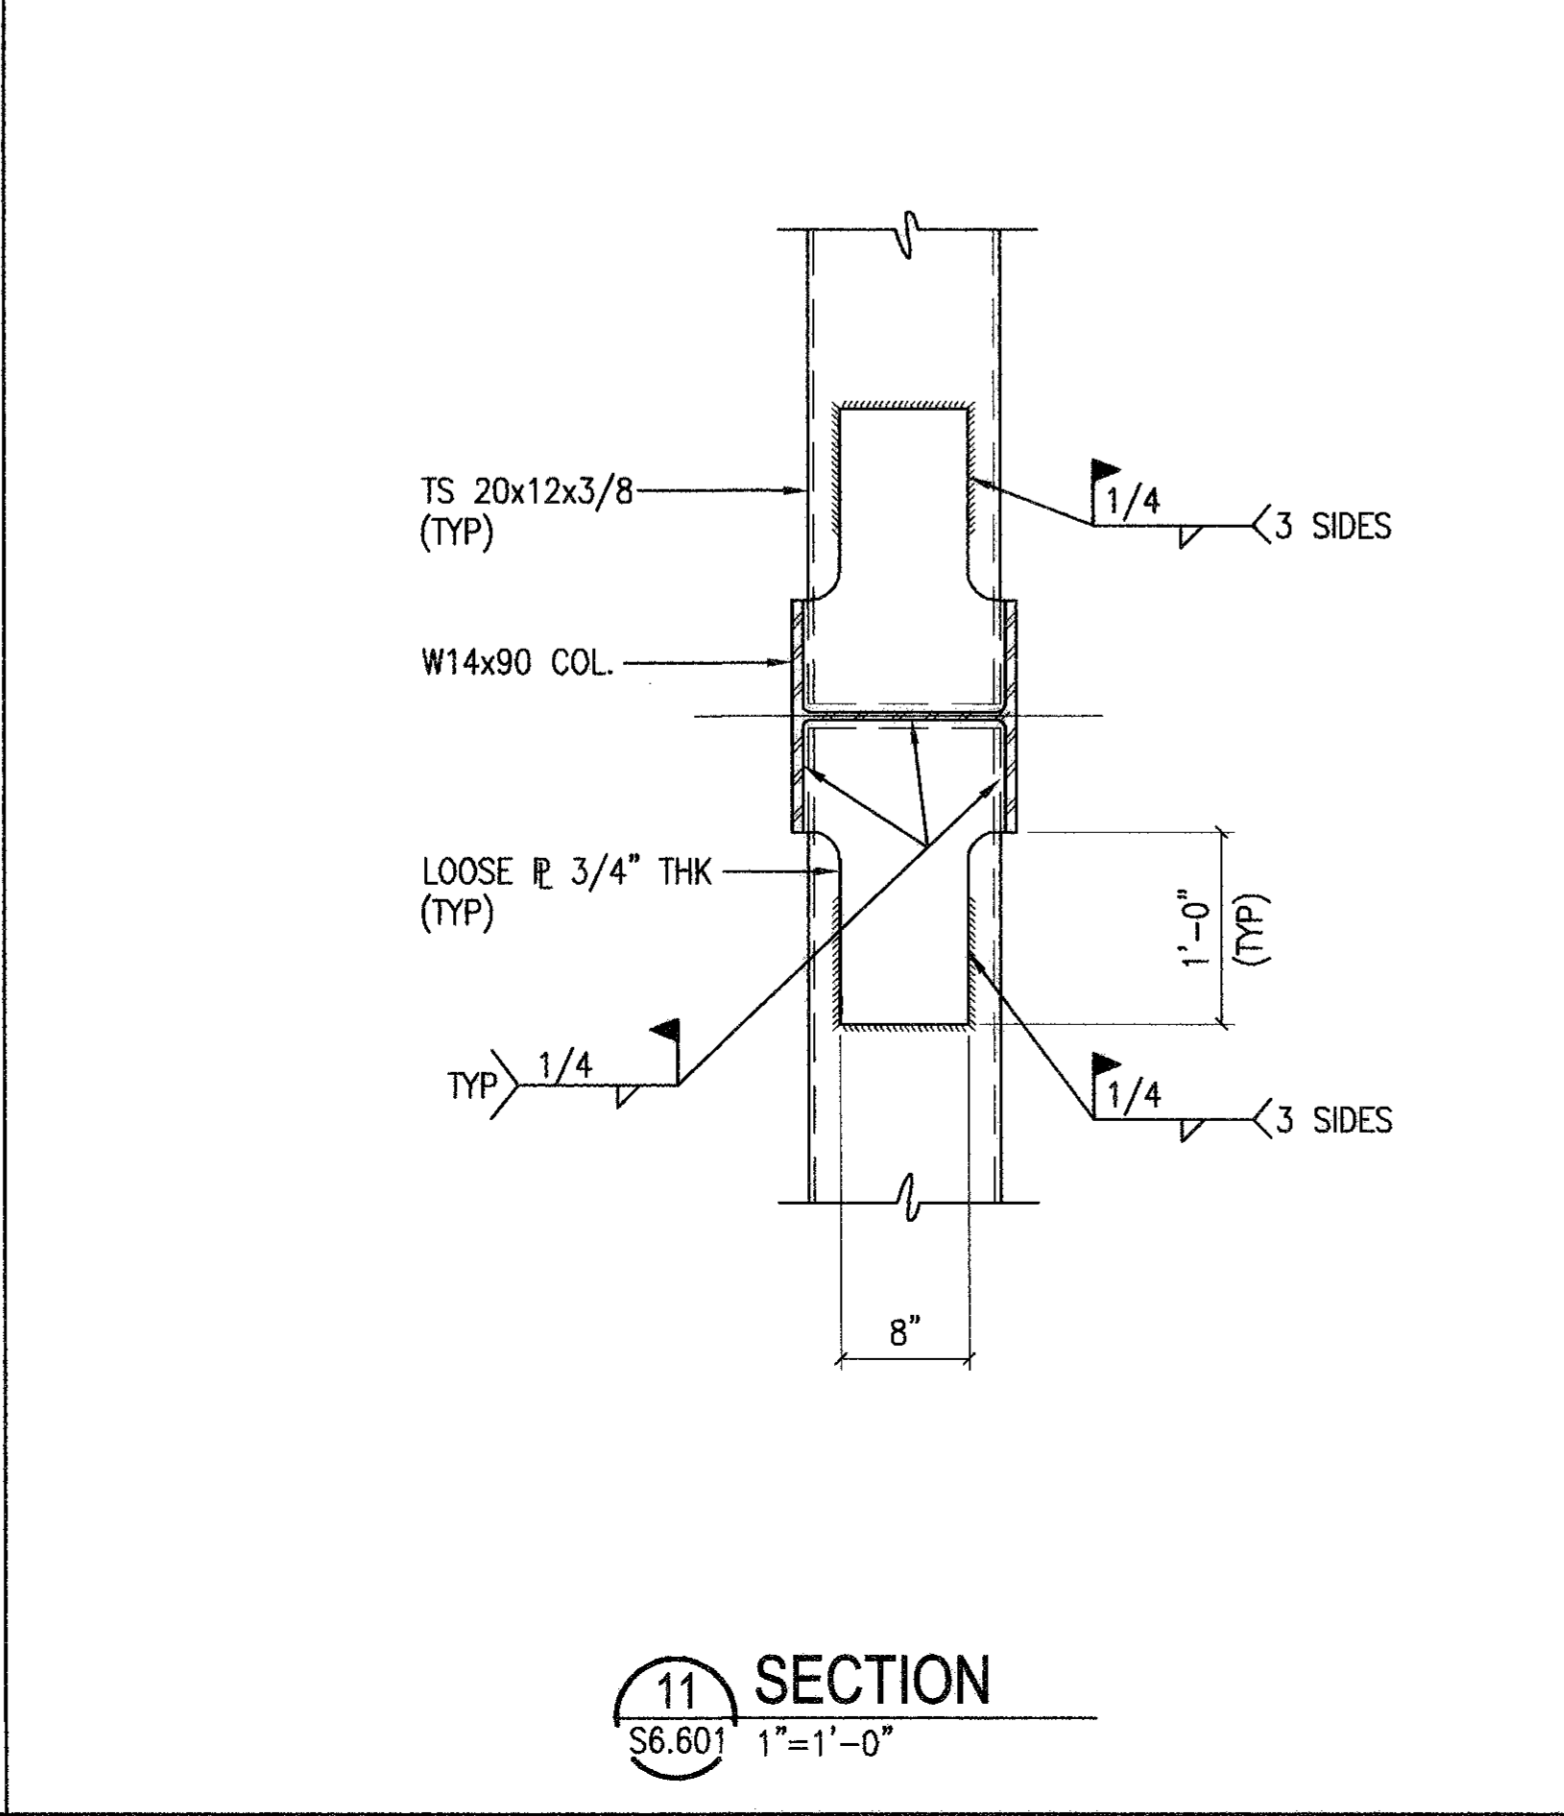

11 SECTION  
S6.601 1"=1'-0"

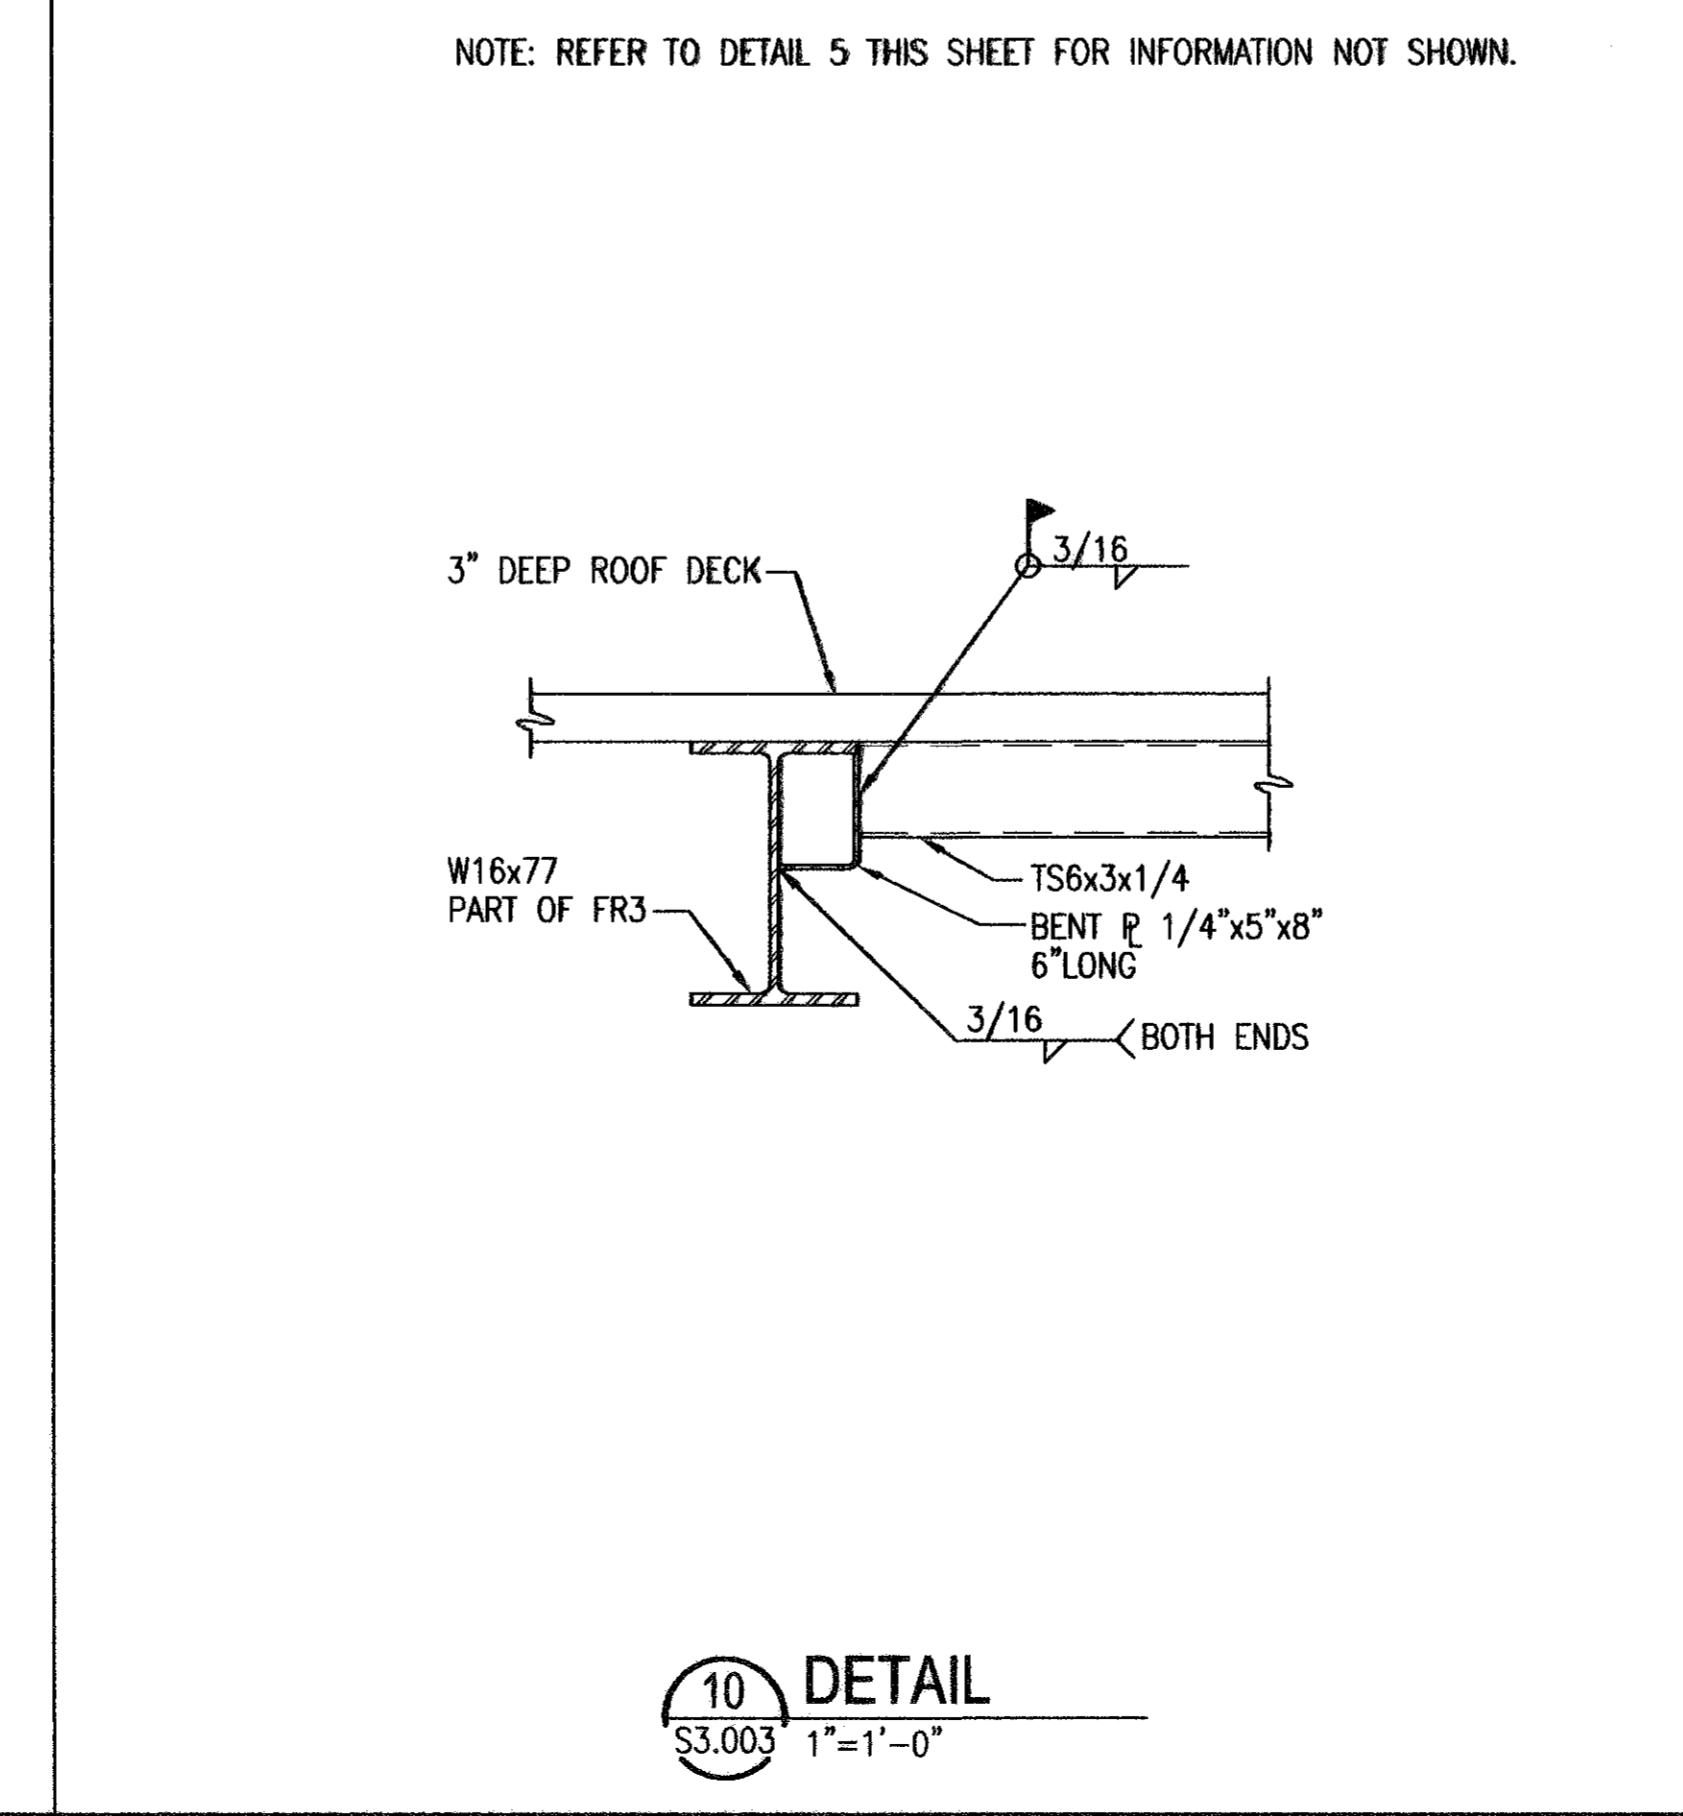


10 DETAIL  
S3.003 1"=1'-0"

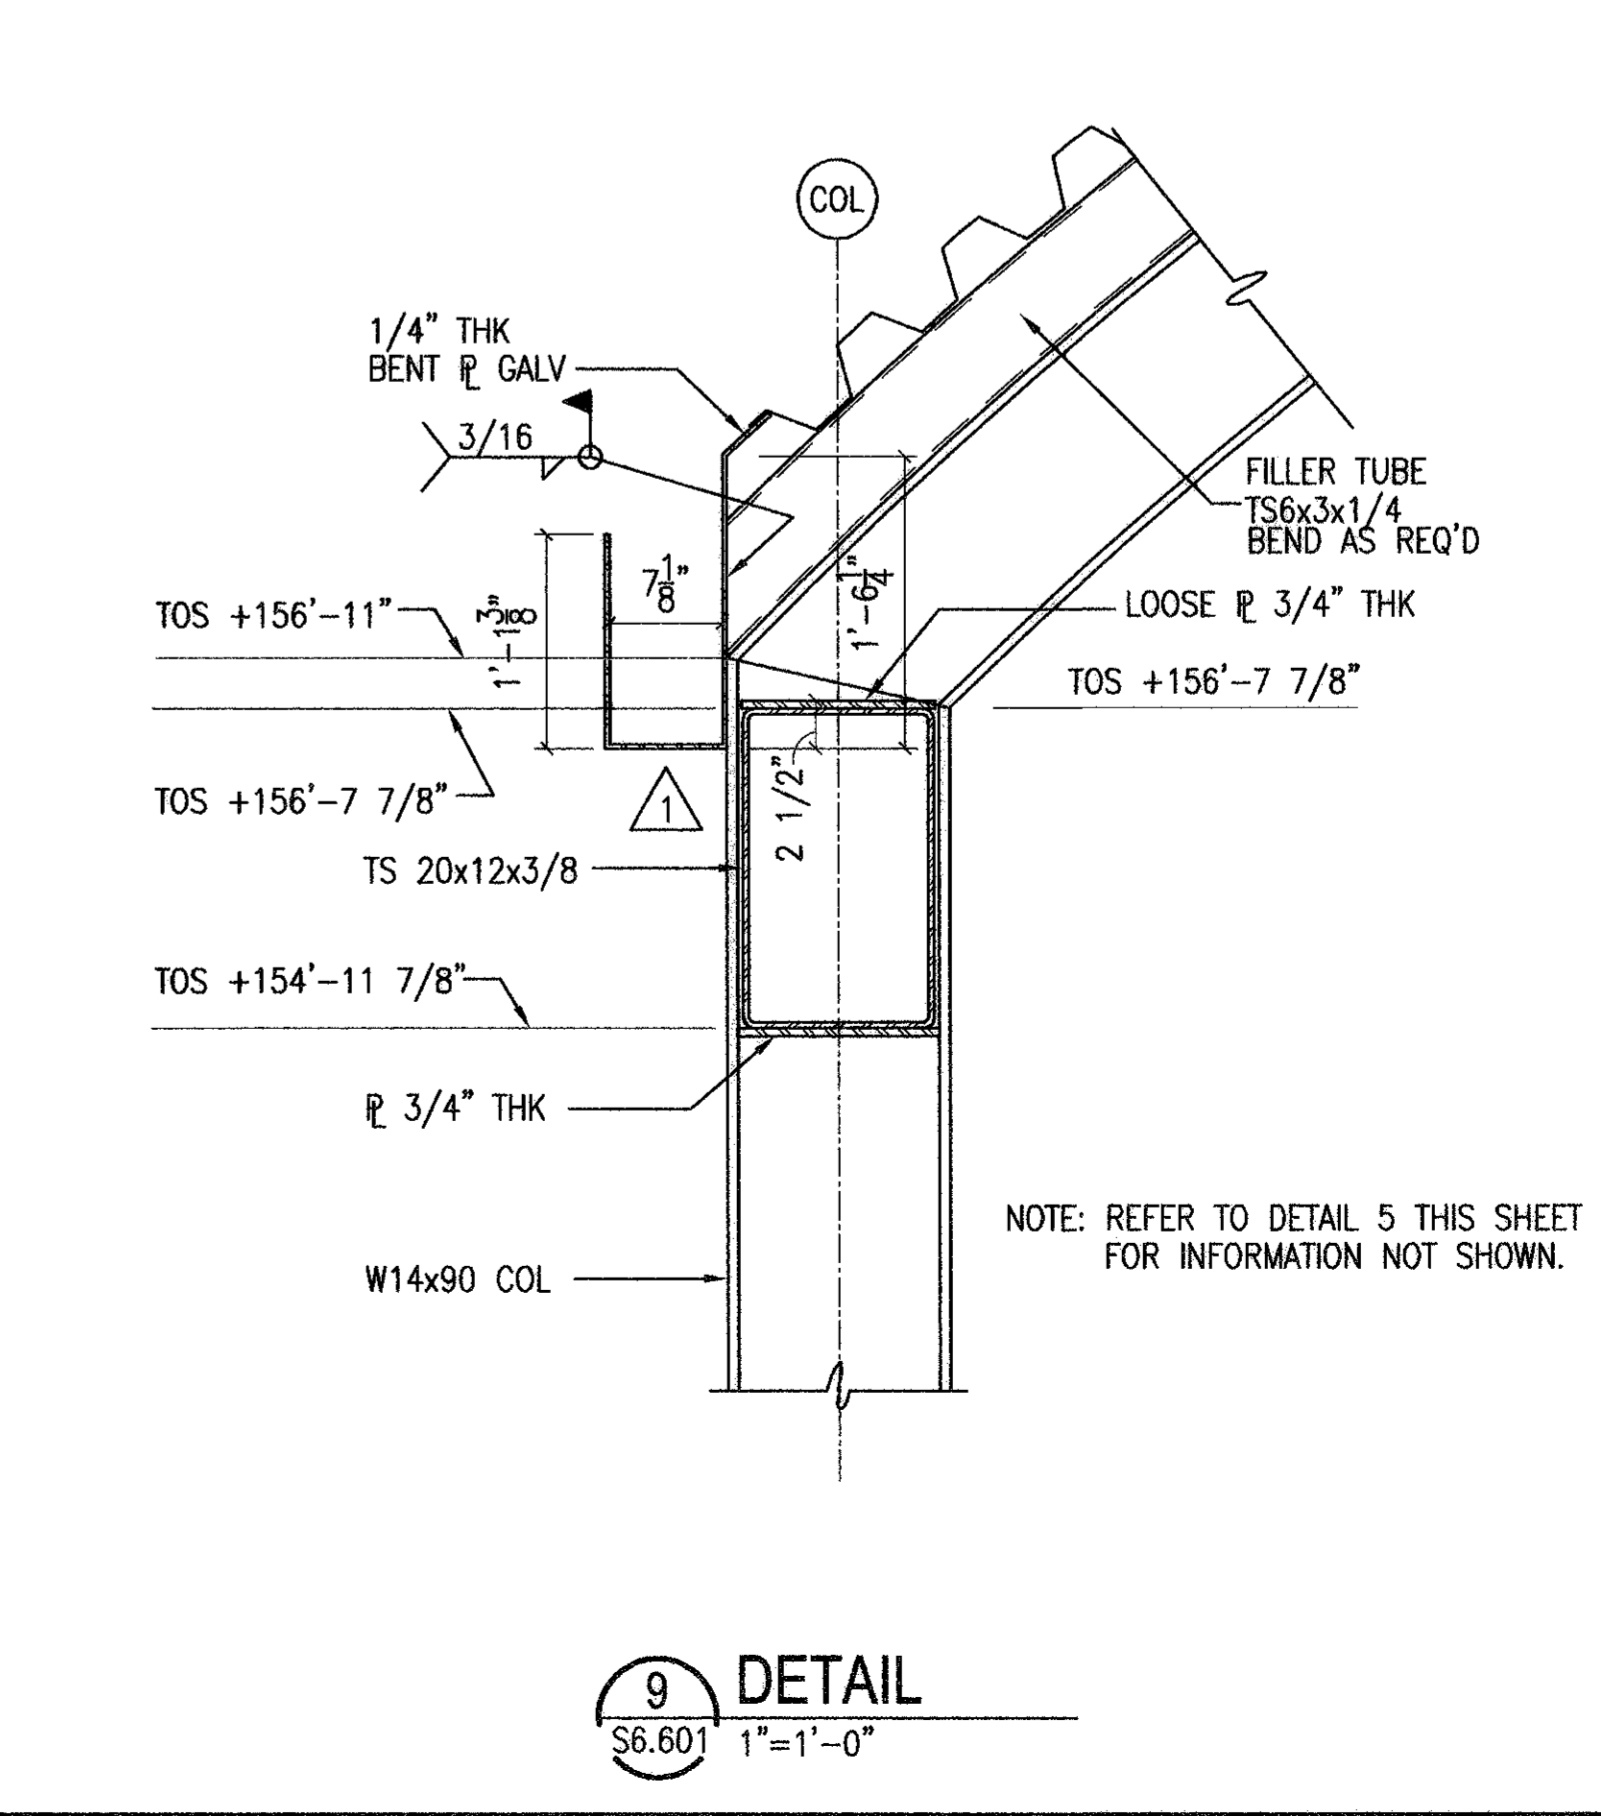

9 DETAIL  
S6.601 1"=1'-0"

NOTES TO SHEET

1. REFER TO SHEET S0.100 FOR STRUCTURAL GENERAL NOTES.

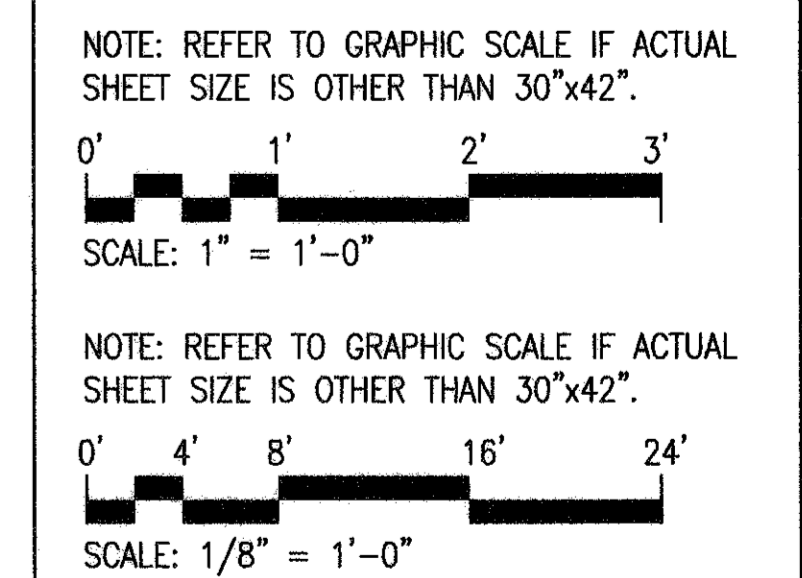

RECORD DRAWINGS  
DO NOT MODIFY

DATE: MAY 6, 2005

HUTTI-ZOLLARS, INC.

NOTE: INFORMATION USED TO DEVELOP THESE DOCUMENTS WAS TAKEN FROM RECORDS OF THE WORK DRAWINGS PREPARED BY THE CONSTRUCTION CONTRACTOR, CLARK/MISSION A JOINT VENTURE. THE INFORMATION PROVIDED BY THE CONTRACTOR WAS NOT VERIFIED BY THE DESIGN FIRM NAMED ABOVE.

**HOUSTON AIRPORT SYSTEM**  
GEORGE BUSH  
INTERCONTINENTAL AIRPORT  
HOUSTON TEXAS

**HUTTI-ZOLLARS**  
Engineering / Architecture  
1500 Katy Avenue, Suite 200, Houston, TX 77077  
Phone (281) 488-0068 Fax (281) 488-0220

**CHARLES F. TERRY, INC.**  
Consulting Engineers  
1500 Katy Avenue, Suite 200, Houston, TX 77077  
Phone (281) 488-0068 Fax (281) 488-0220

REVISIONS  
NO. DESCRIPTION DATE BY  
ISSUED FOR BID 10/19/01  
ADDENDUM #1 02/01/02 MR

PROJECT MGR: GRW  
DESIGNER: JUC  
DRAWN BY: KLV  
CHECKED BY: MMR  
DRAWING STANDARD: ISEP 07.20.2000  
SCALE: AS NOTED  
DATE: 09/14/01

FOR RECORD DRAWING ONLY  
STATE OF TEXAS  
MOEN MICHAEL REYNOLDS  
5454  
REGISTERED PROFESSIONAL ENGINEER  
CIVIL

APPROVED BY: DATE:  
DIRECTOR  
HOUSTON AIRPORT SYSTEM

PROJECT NO. 02-2025-01  
C.I.P. NO. A-0354  
H.A.S. NO. 536C  
SHEET NO.

INTERNATIONAL SERVICES EXPANSION PROGRAM  
APM STATION & PLATFORM  
STEEL SECTIONS AND DETAILS


S6.601



NO.	DESCRIPTION	DATE	BY
1	ISSUED FOR BID	10/19/01	
2	ADDENDUM #1	02/01/02	MR

INTERNATIONAL • SERVICES • EXPANSION • PROGRAM  
**APM STATION & PLATFORM**  
 STEEL SECTIONS AND DETAILS

PROJECT MGR:	GRW
DESIGNER:	JUC
DRAWN BY:	KLV
CHECKED BY:	MMR
DRAWING STANDARD:	ISEP 07.20.2000
SCALE:	AS NOTED
DATE:	09/14/01

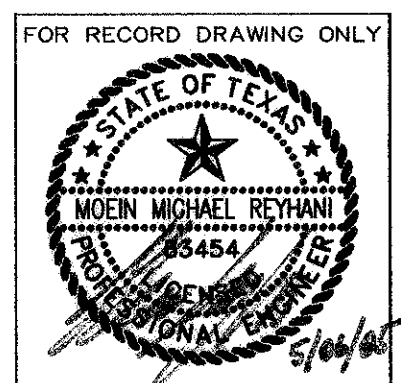

APPROVED BY:	DATE:
INSTRUCTOR	HOUSTON AIRPORT SYSTEM
PROJECT NO.	02-2025-01
C.I.P. NO.	A-0254
H.A.S. NO.	536C
SHEET NO.	


NOTES TO SHEET

1. REFER TO SHEET S0.100 FOR STRUCTURAL GENERAL NOTES.


NOTE: REFER TO GRAPHIC SCALE IF ACTUAL SHEET SIZE IS OTHER THAN 30"x42".  
 0' 4' 8' 16' 24'  
 SCALE: 1/8" = 1'-0"

NOTE: REFER TO GRAPHIC SCALE IF ACTUAL SHEET SIZE IS OTHER THAN 30"x42".  
 0' 1' 2' 3'  
 SCALE: 1" = 1'-0"


**RECORD DRAWINGS DO NOT MODIFY**  
 DATE: MAY 6, 2005  
 HUTT-ZOLLARS, INC.  
 NOTE: INFORMATION USED TO DEVELOP THESE DOCUMENTS WAS TAKEN FROM RECORD OF THE WORK DRAWINGS PREPARED BY THE CONSTRUCTION CONTRACTOR, CLARK/MISSION A JOINT VENTURE. THE INFORMATION PROVIDED BY THE CONTRACTOR WAS NOT VERIFIED BY THE DESIGN FIRM NAMED ABOVE.

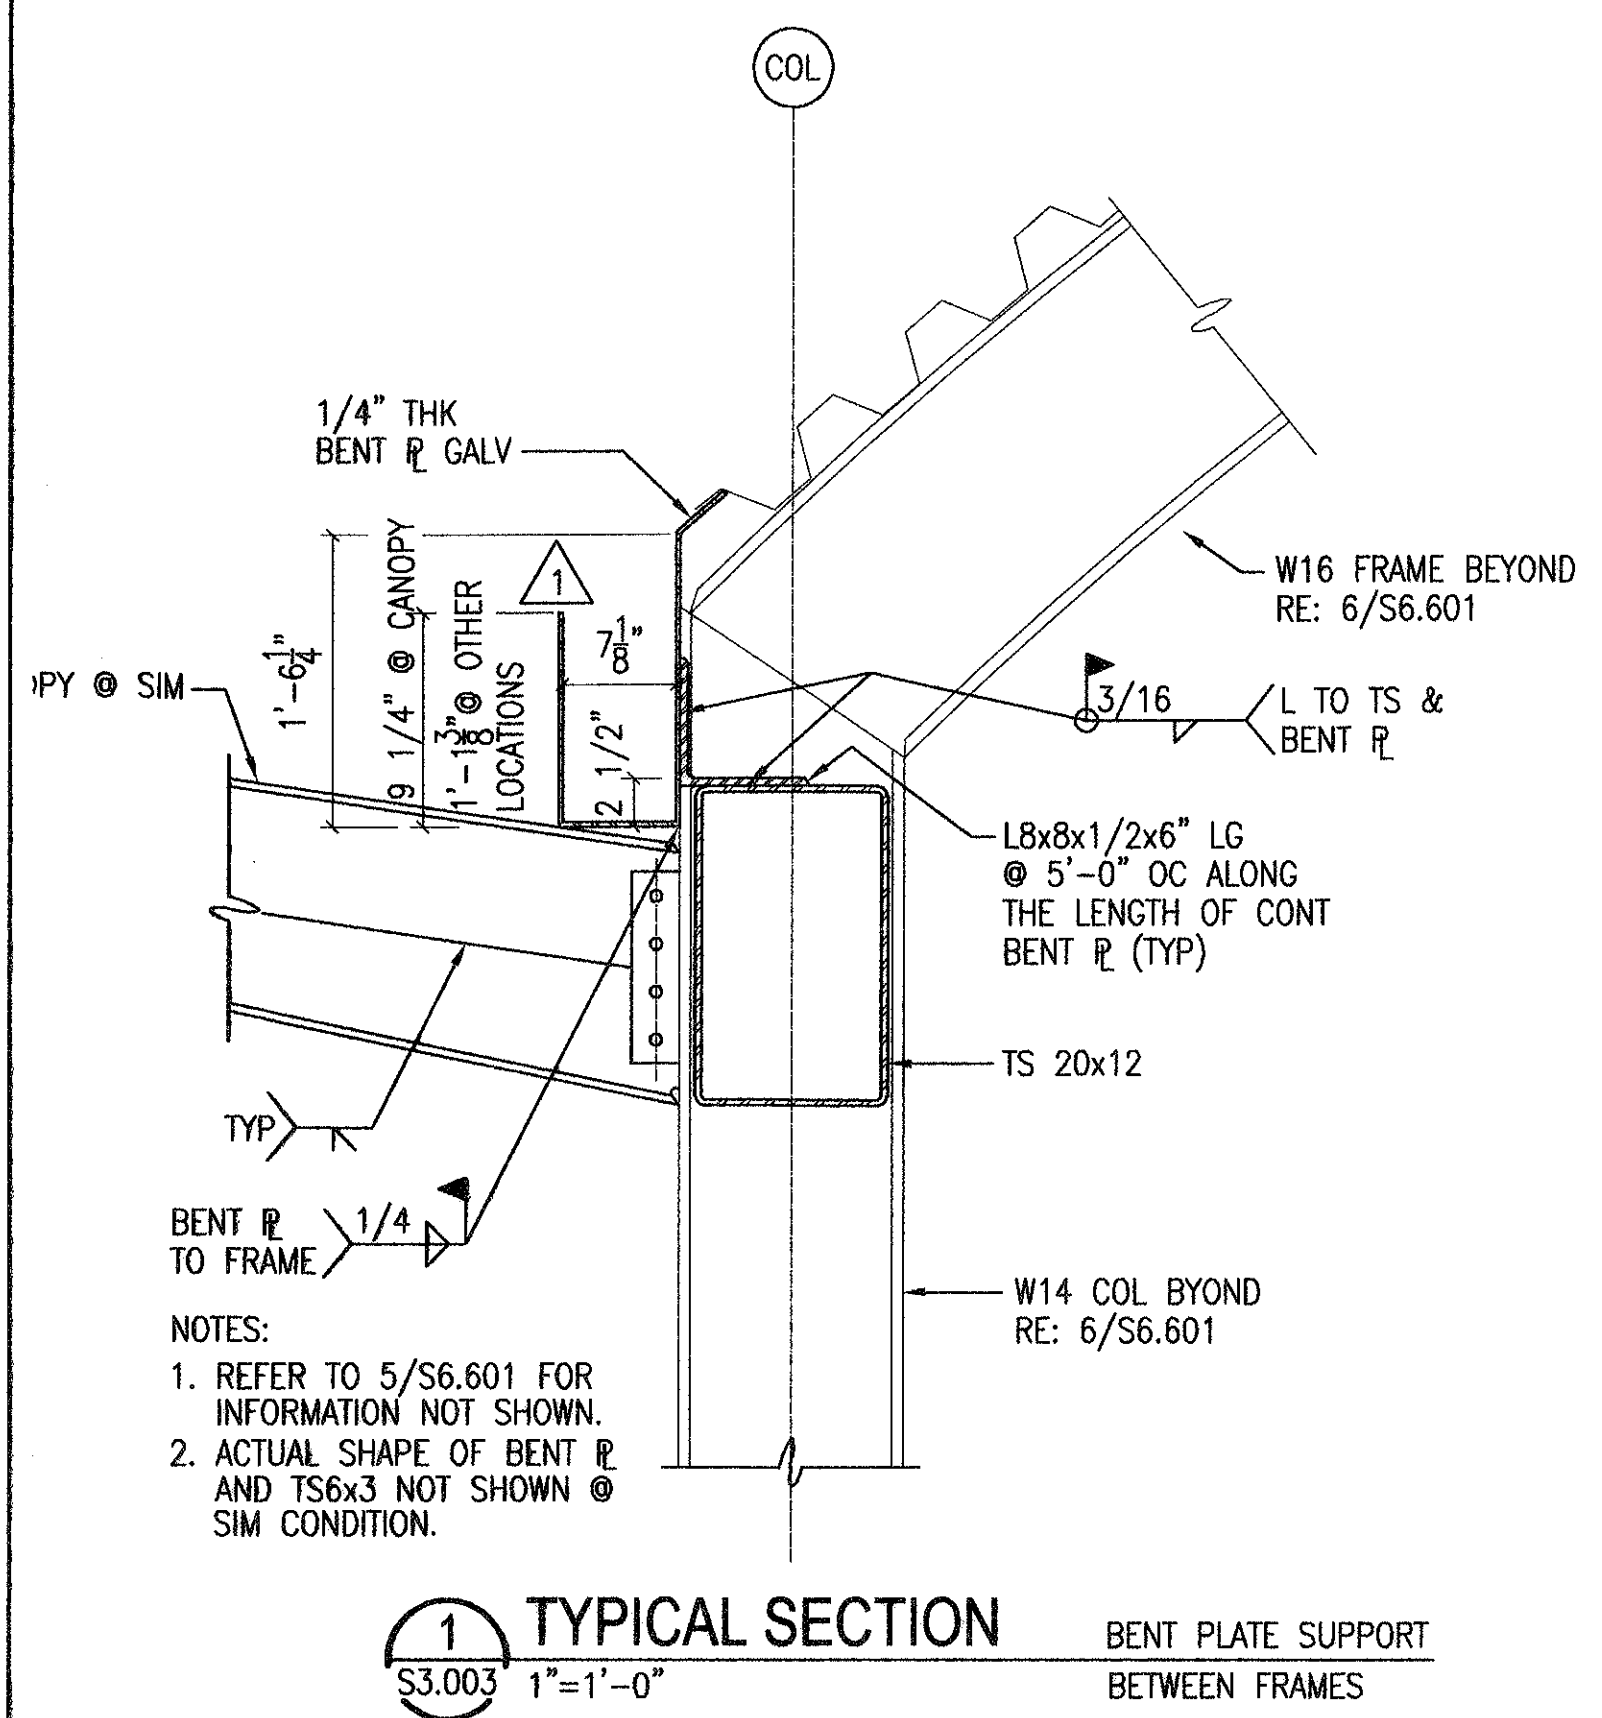


1 TYPICAL SECTION BENT PLATE SUPPORT BETWEEN FRAMES  
 S3.003 1"=1'-0"

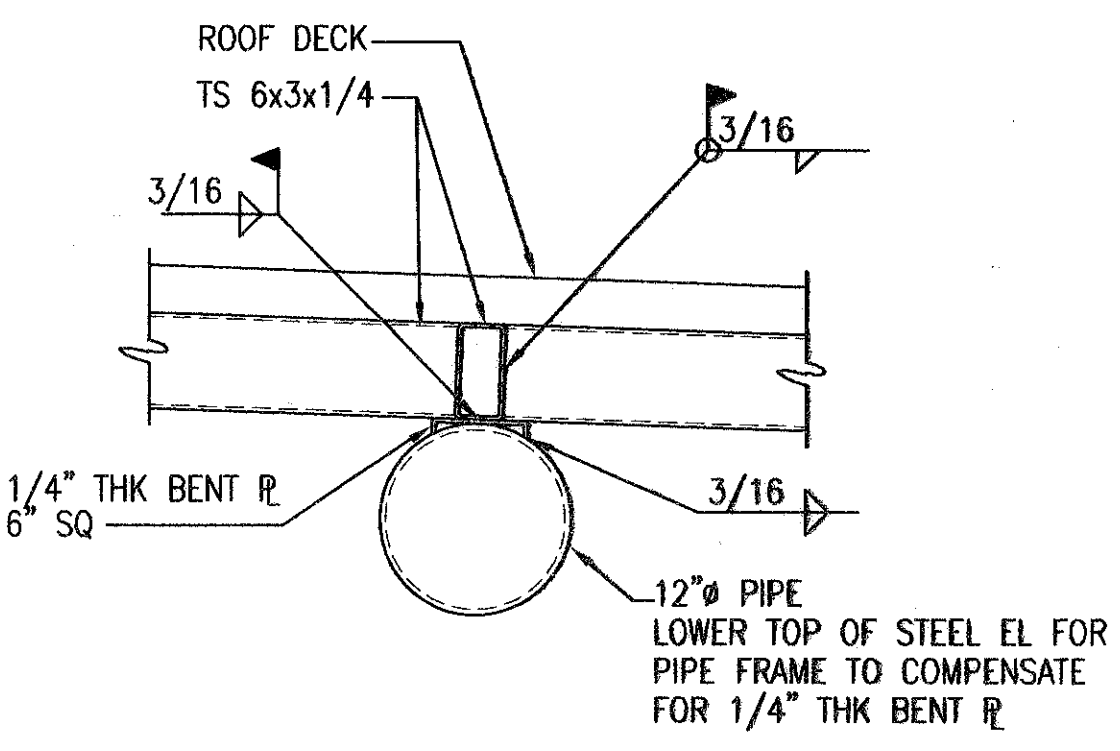


2 SECTION  
 S3.003 1"=1'-0"

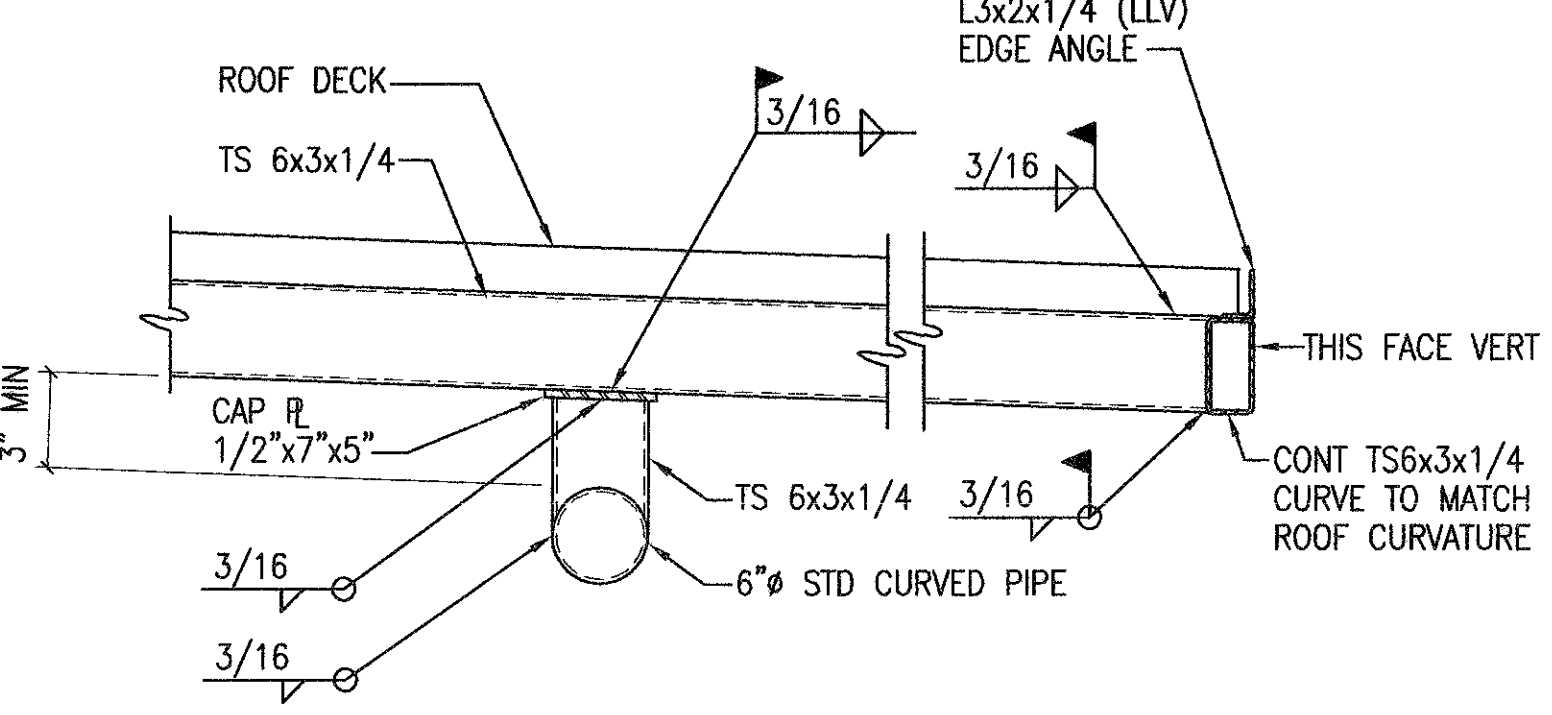


3 SECTION  
 S3.003 1"=1'-0"

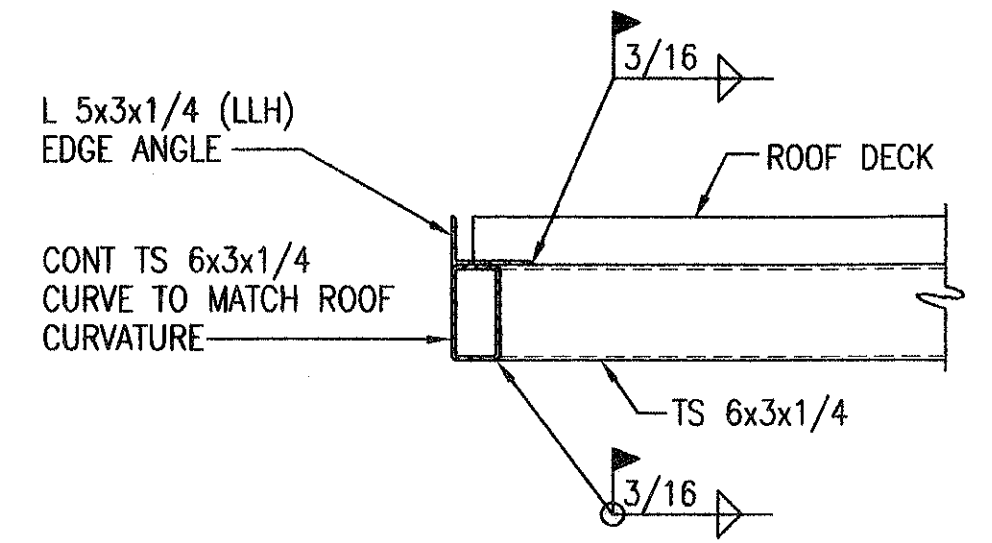


4 SECTION  
 S3.003 1"=1'-0"

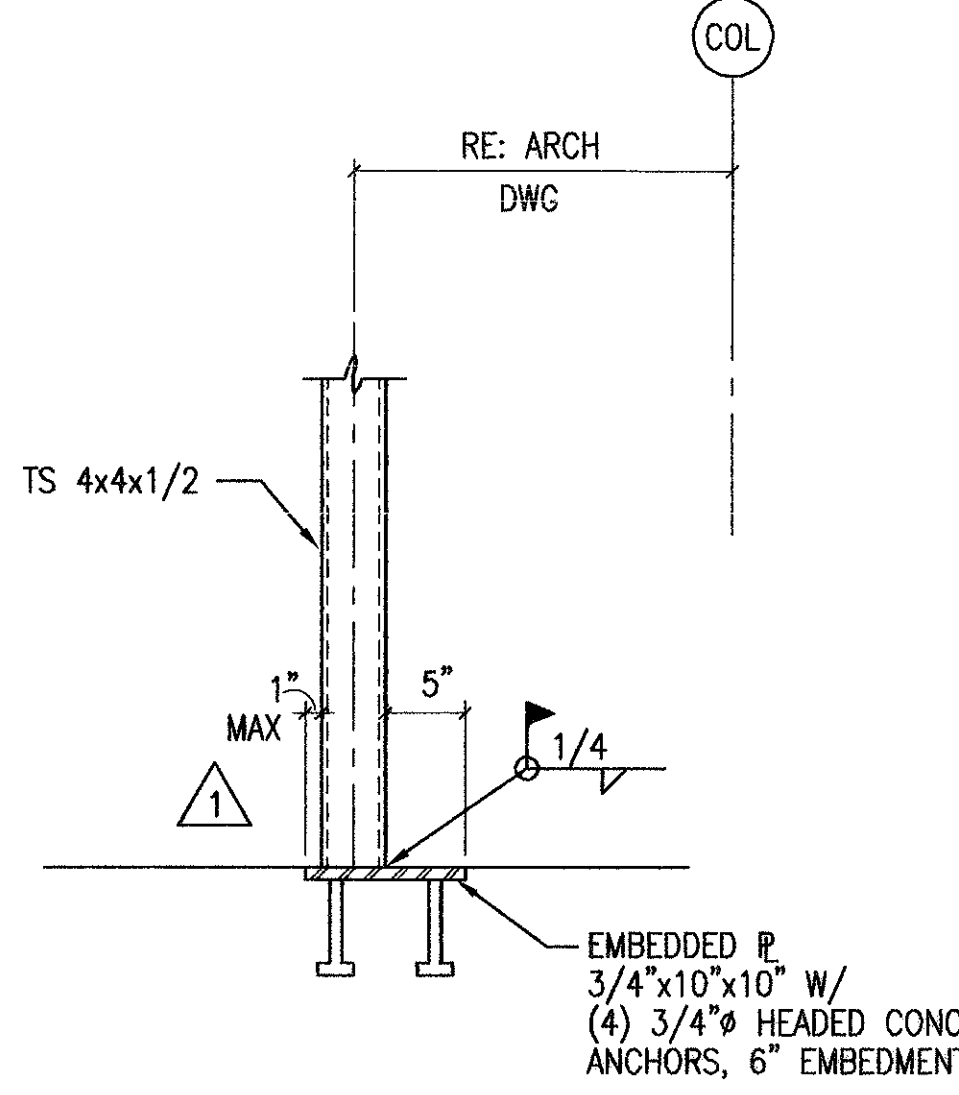


5 SECTION  
 S3.001 1"=1'-0"

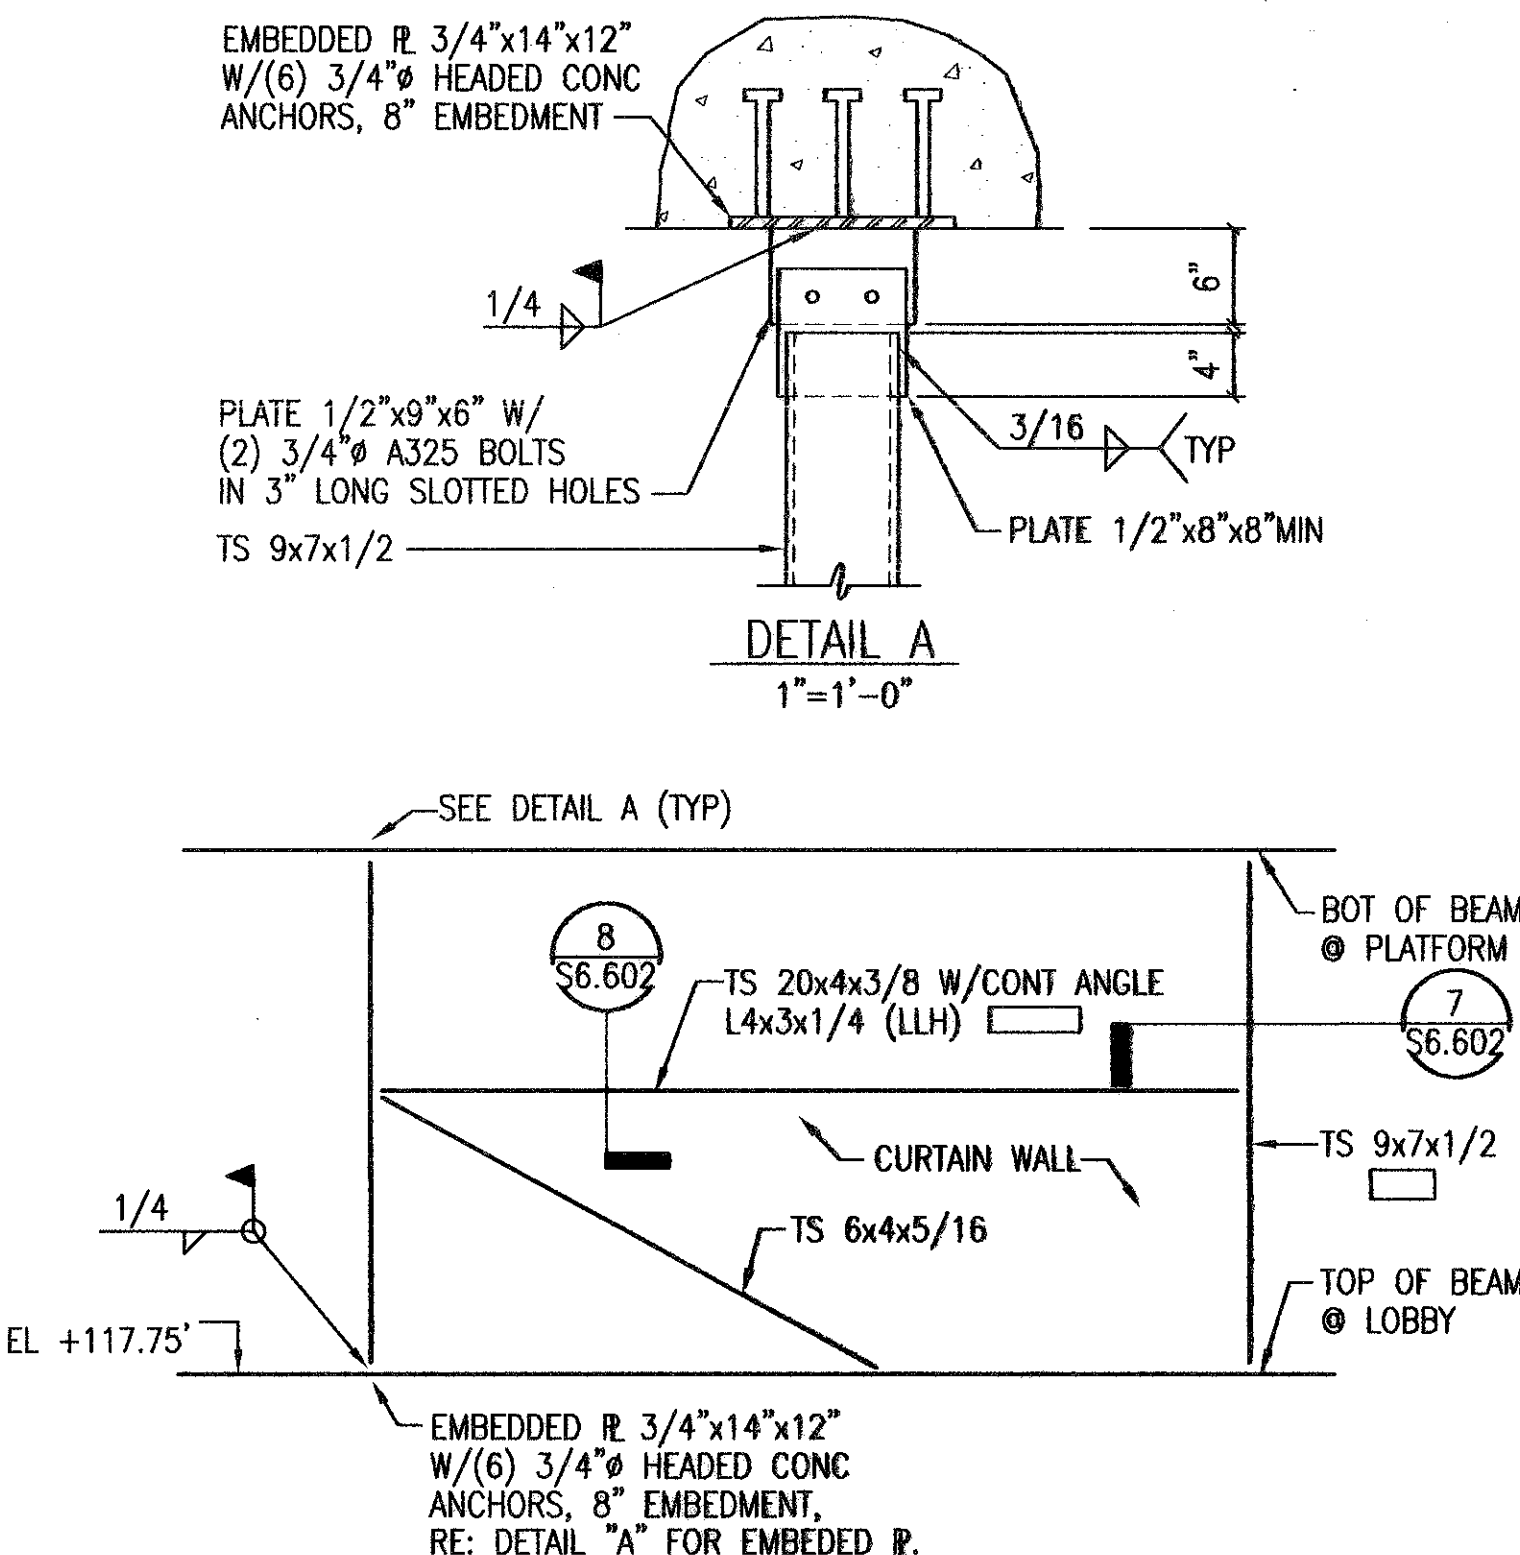


6 SECTION CURTAIN WALL @ NORTH & SOUTH  
 S6.602 1/8"=1'-0"

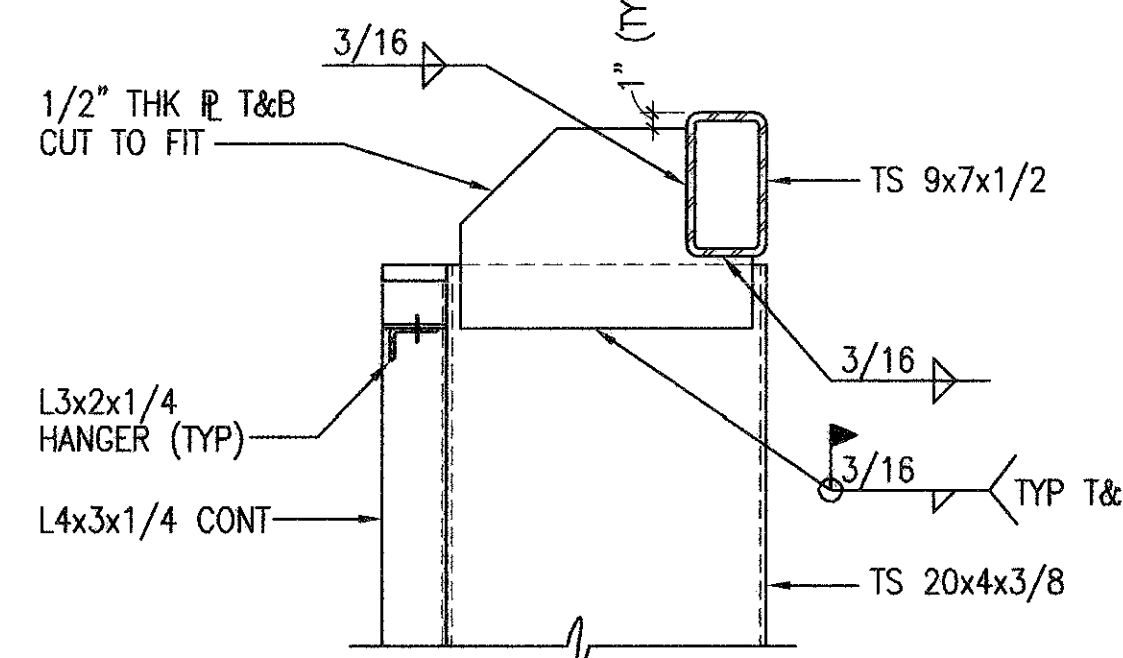


7 PLAN DETAIL  
 S6.602 1"=1'-0"

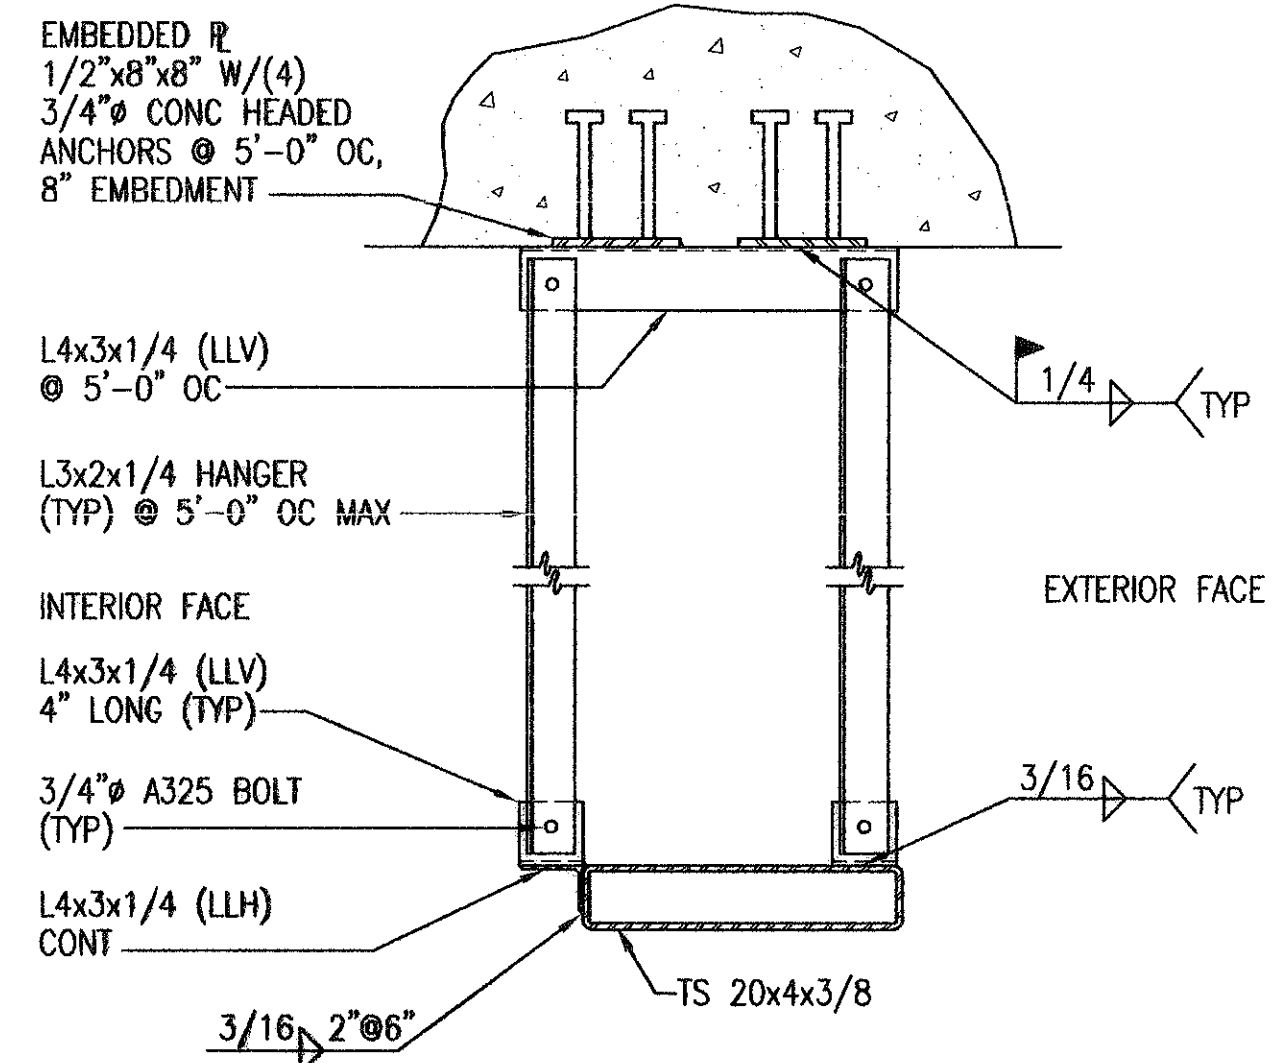


8 SECTION HEADER BEAM HANGER  
 S6.602 1"=1'-0"

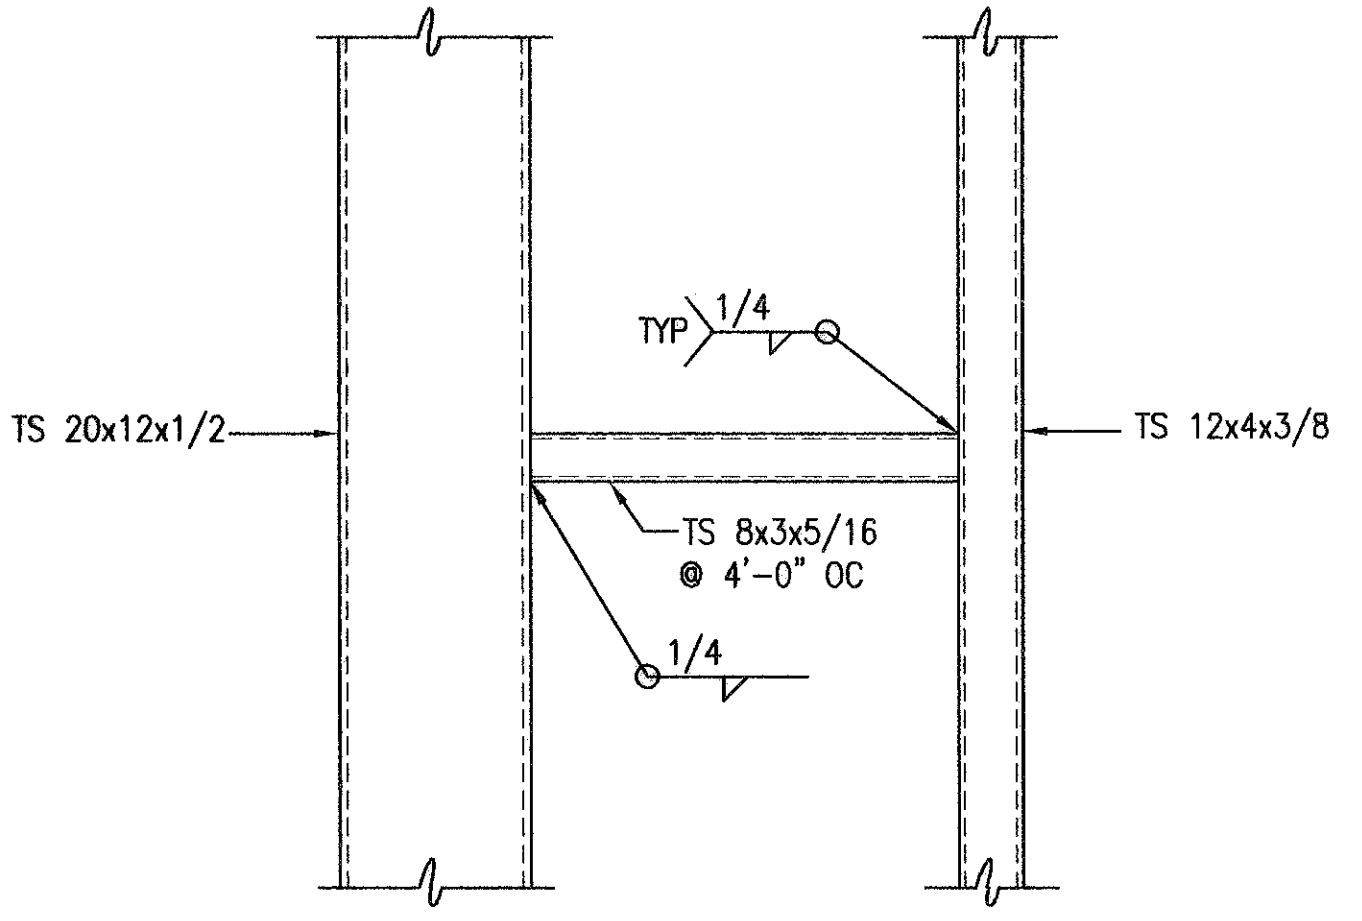


9 PLAN DETAIL  
 S3.001 1"=1'-0"

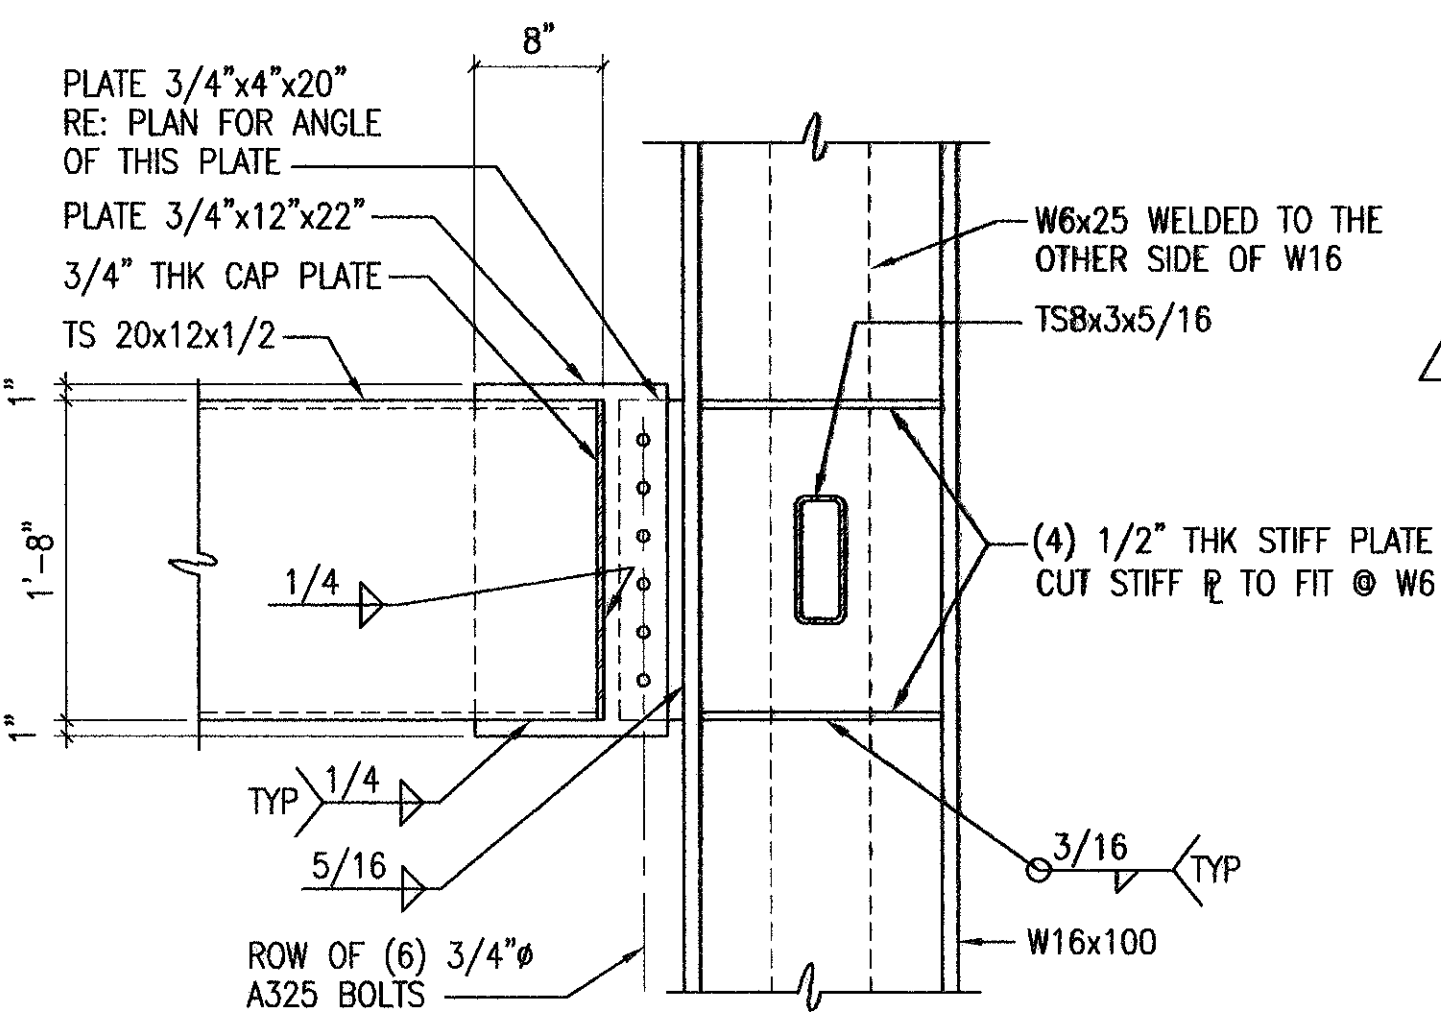

10 SECTION  
 S3.001 1"=1'-0"

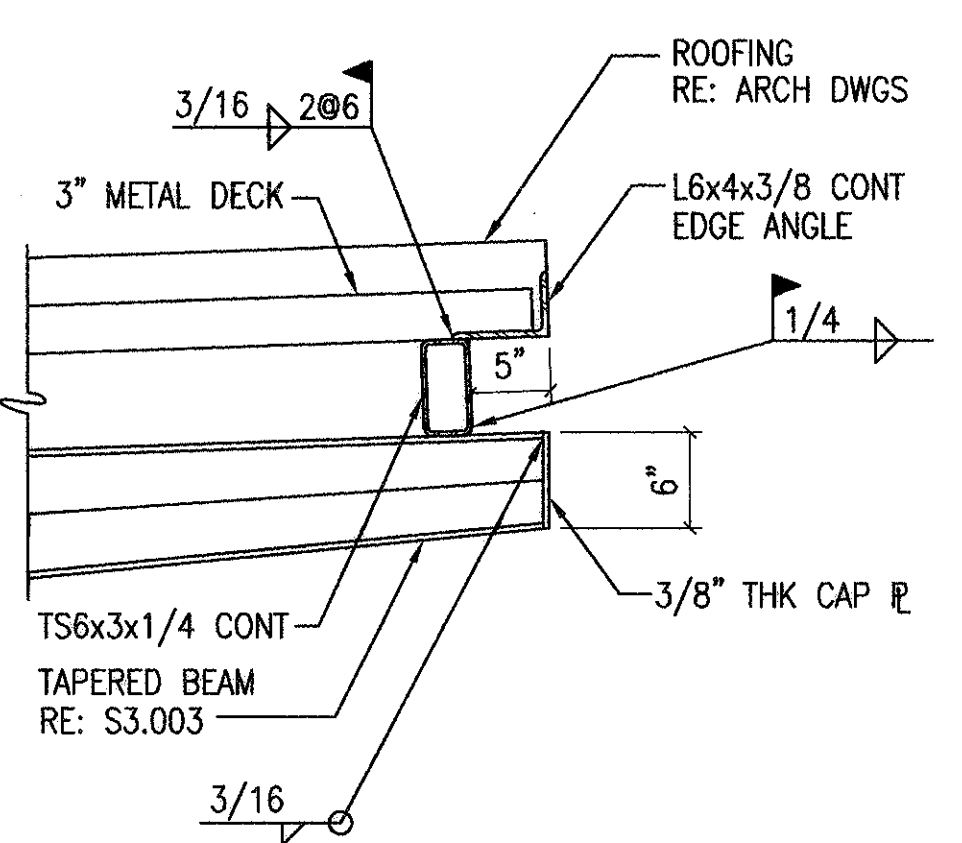


11 SECTION  
 S3.003 1"=1'-0"

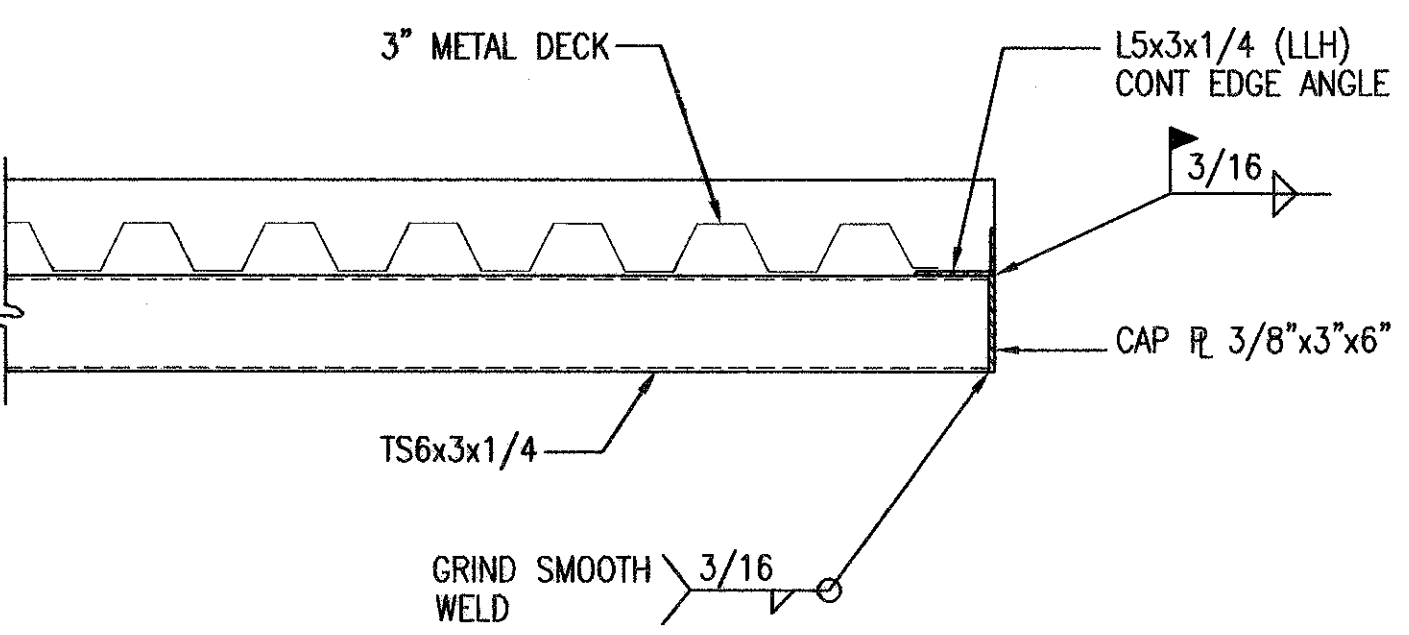


12 SECTION  
 S3.003 1"=1'-0"

PLOT DATE: 10/19/01 HAS FILE: IAS365662.DWG




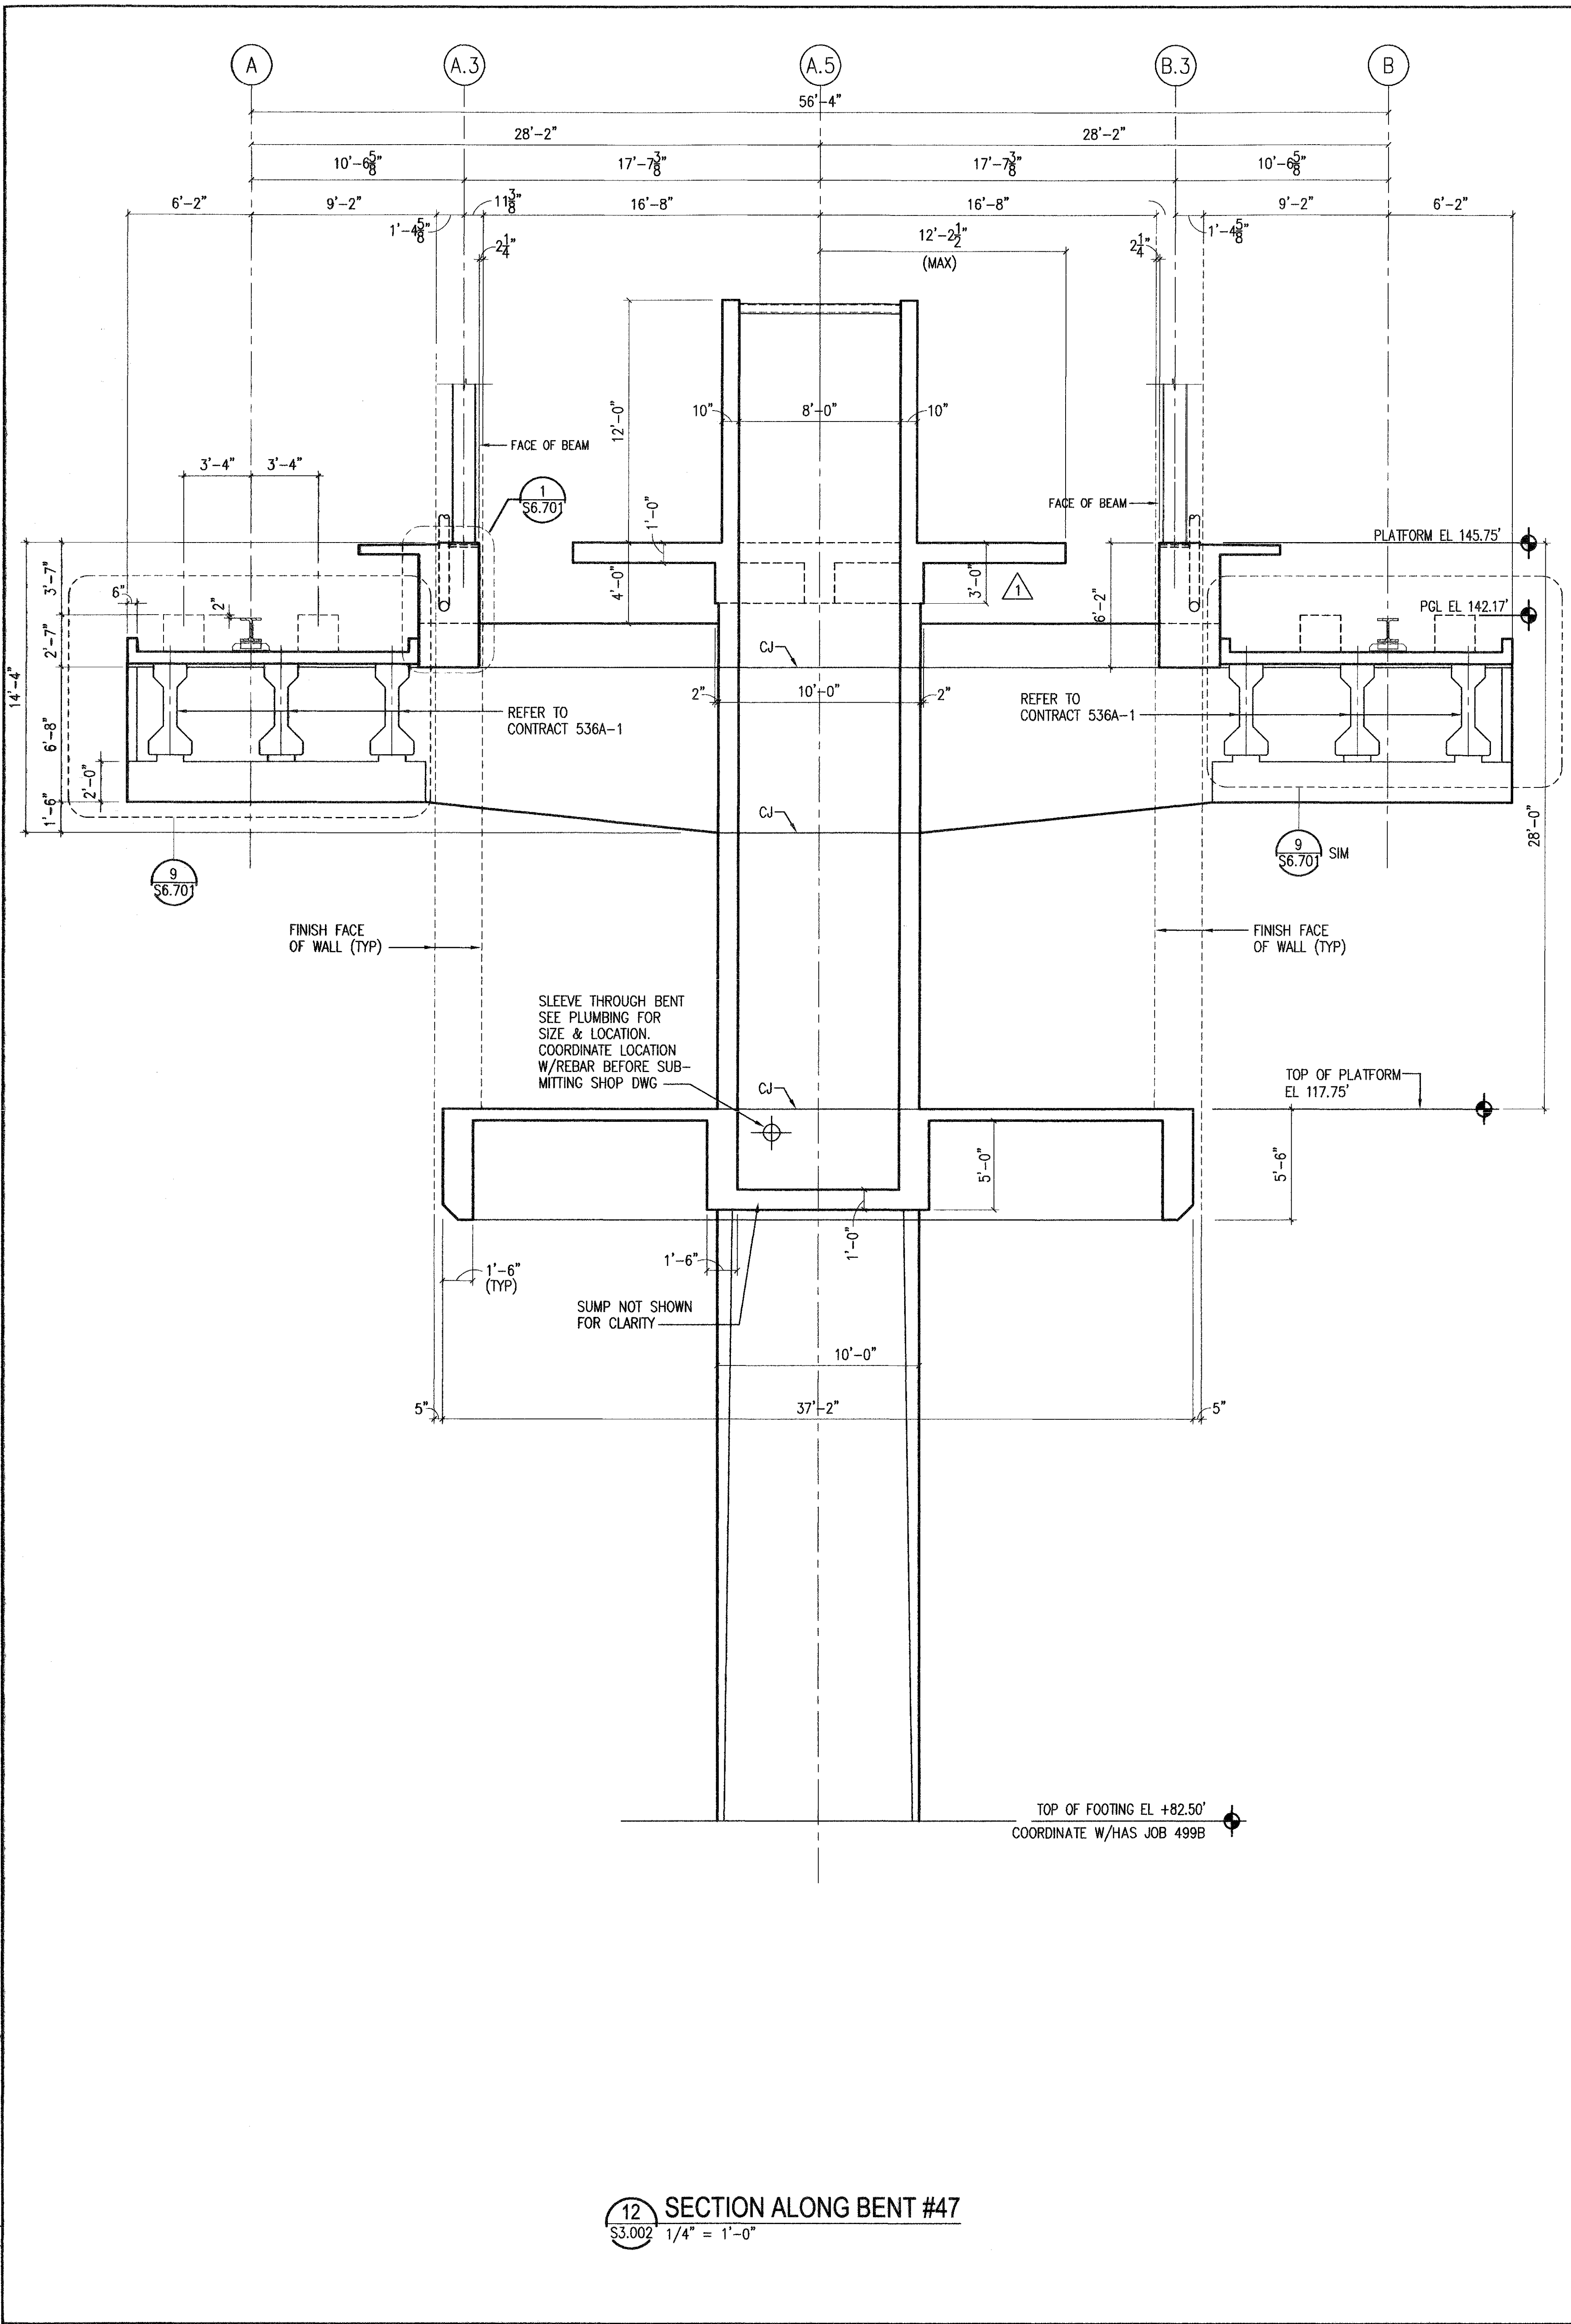


12 SECTION ALONG BENT #47  
S3.002 1/4" = 1'-0"

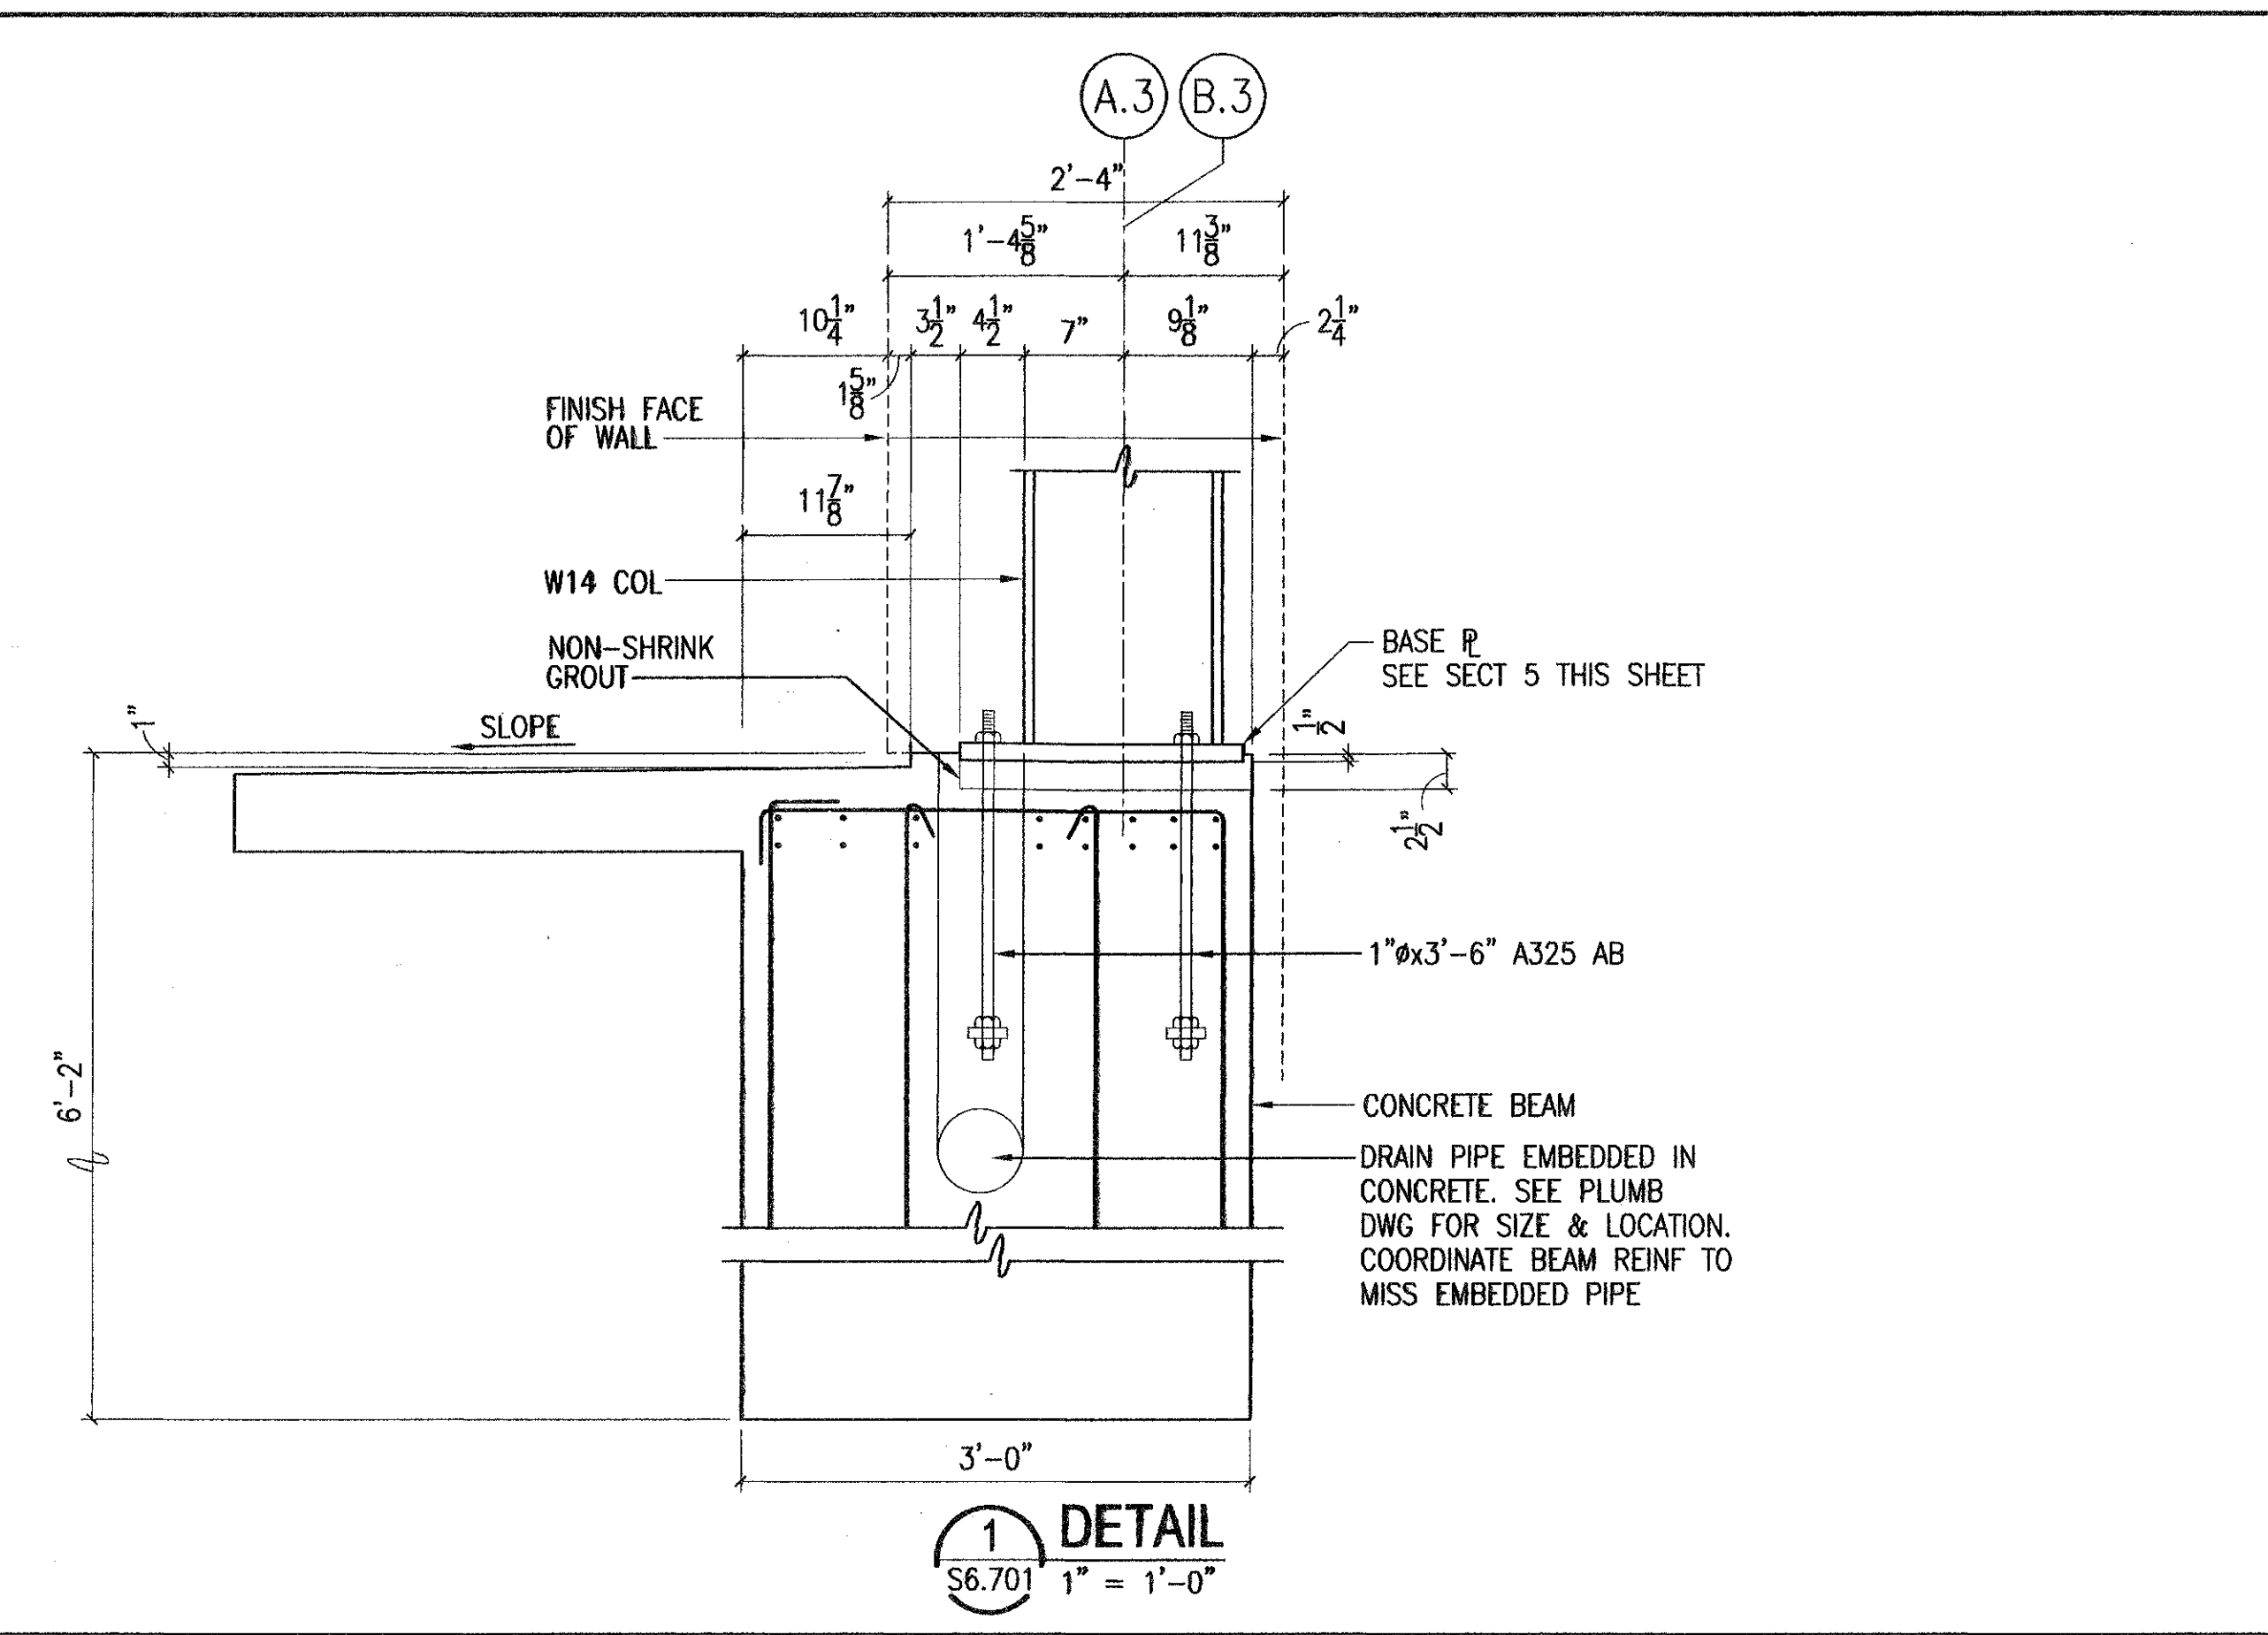

1 DETAIL  
S6.701 1" = 1'-0"

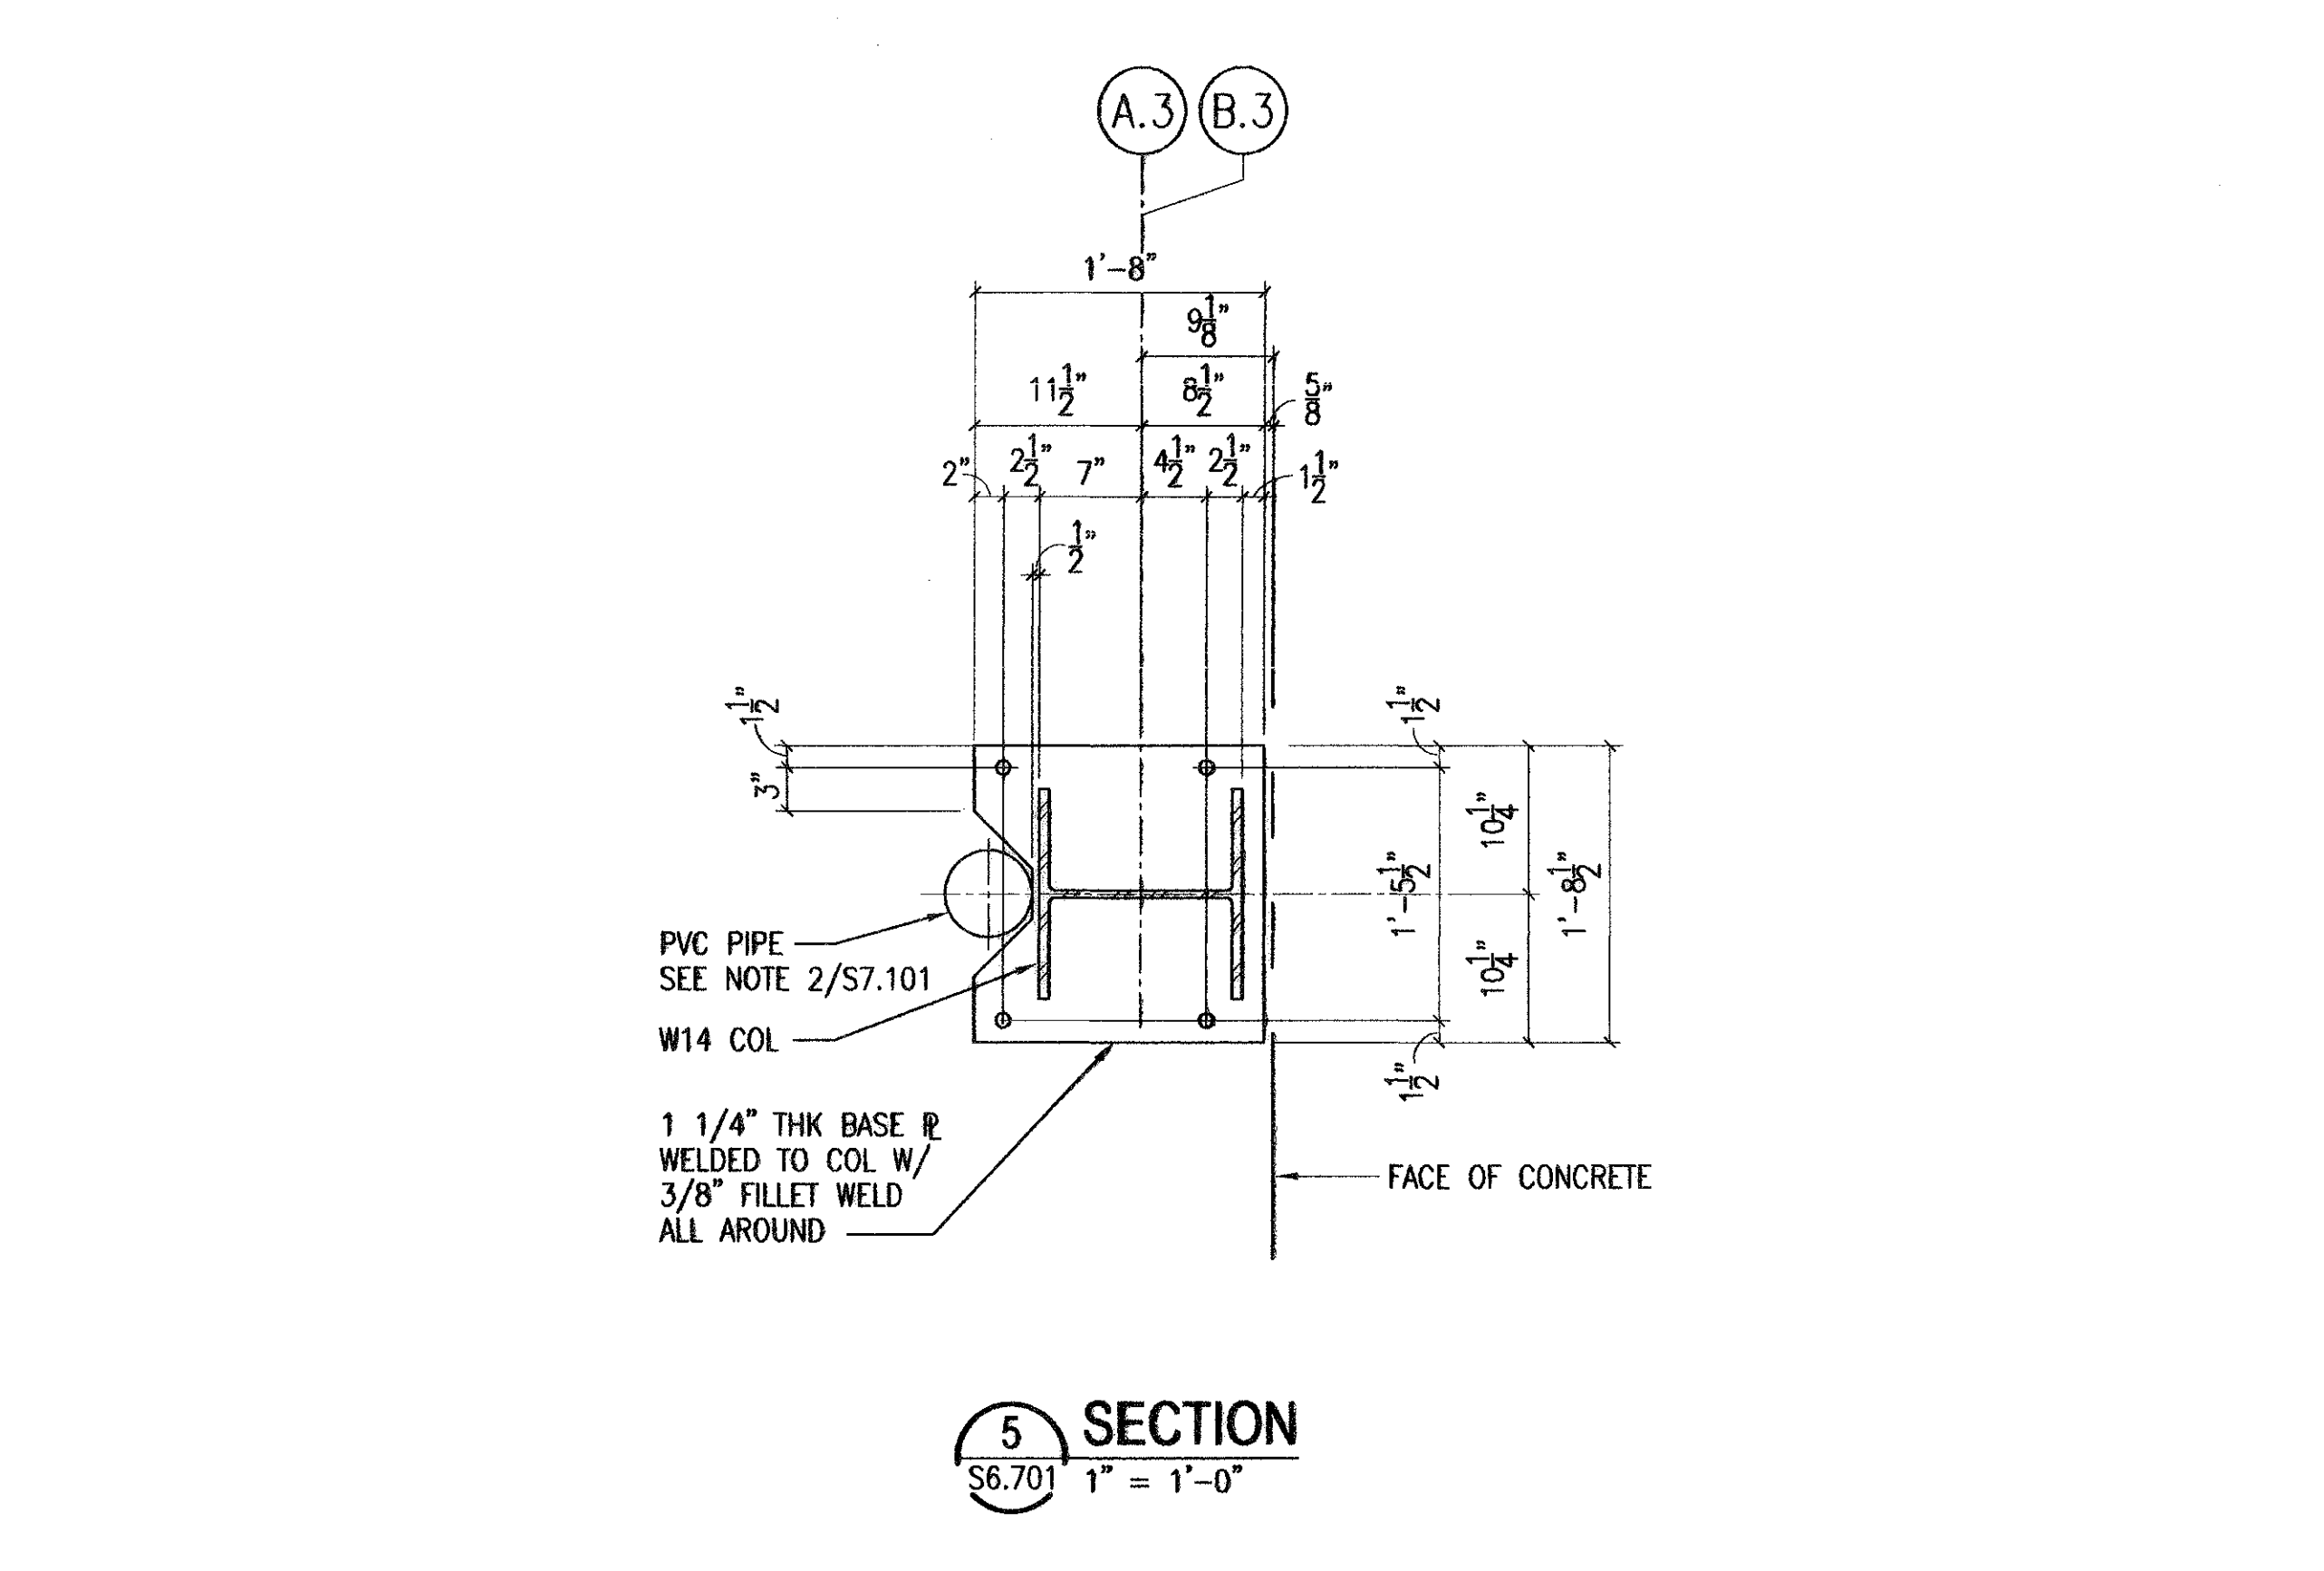

5 SECTION  
S6.701 1" = 1'-0"

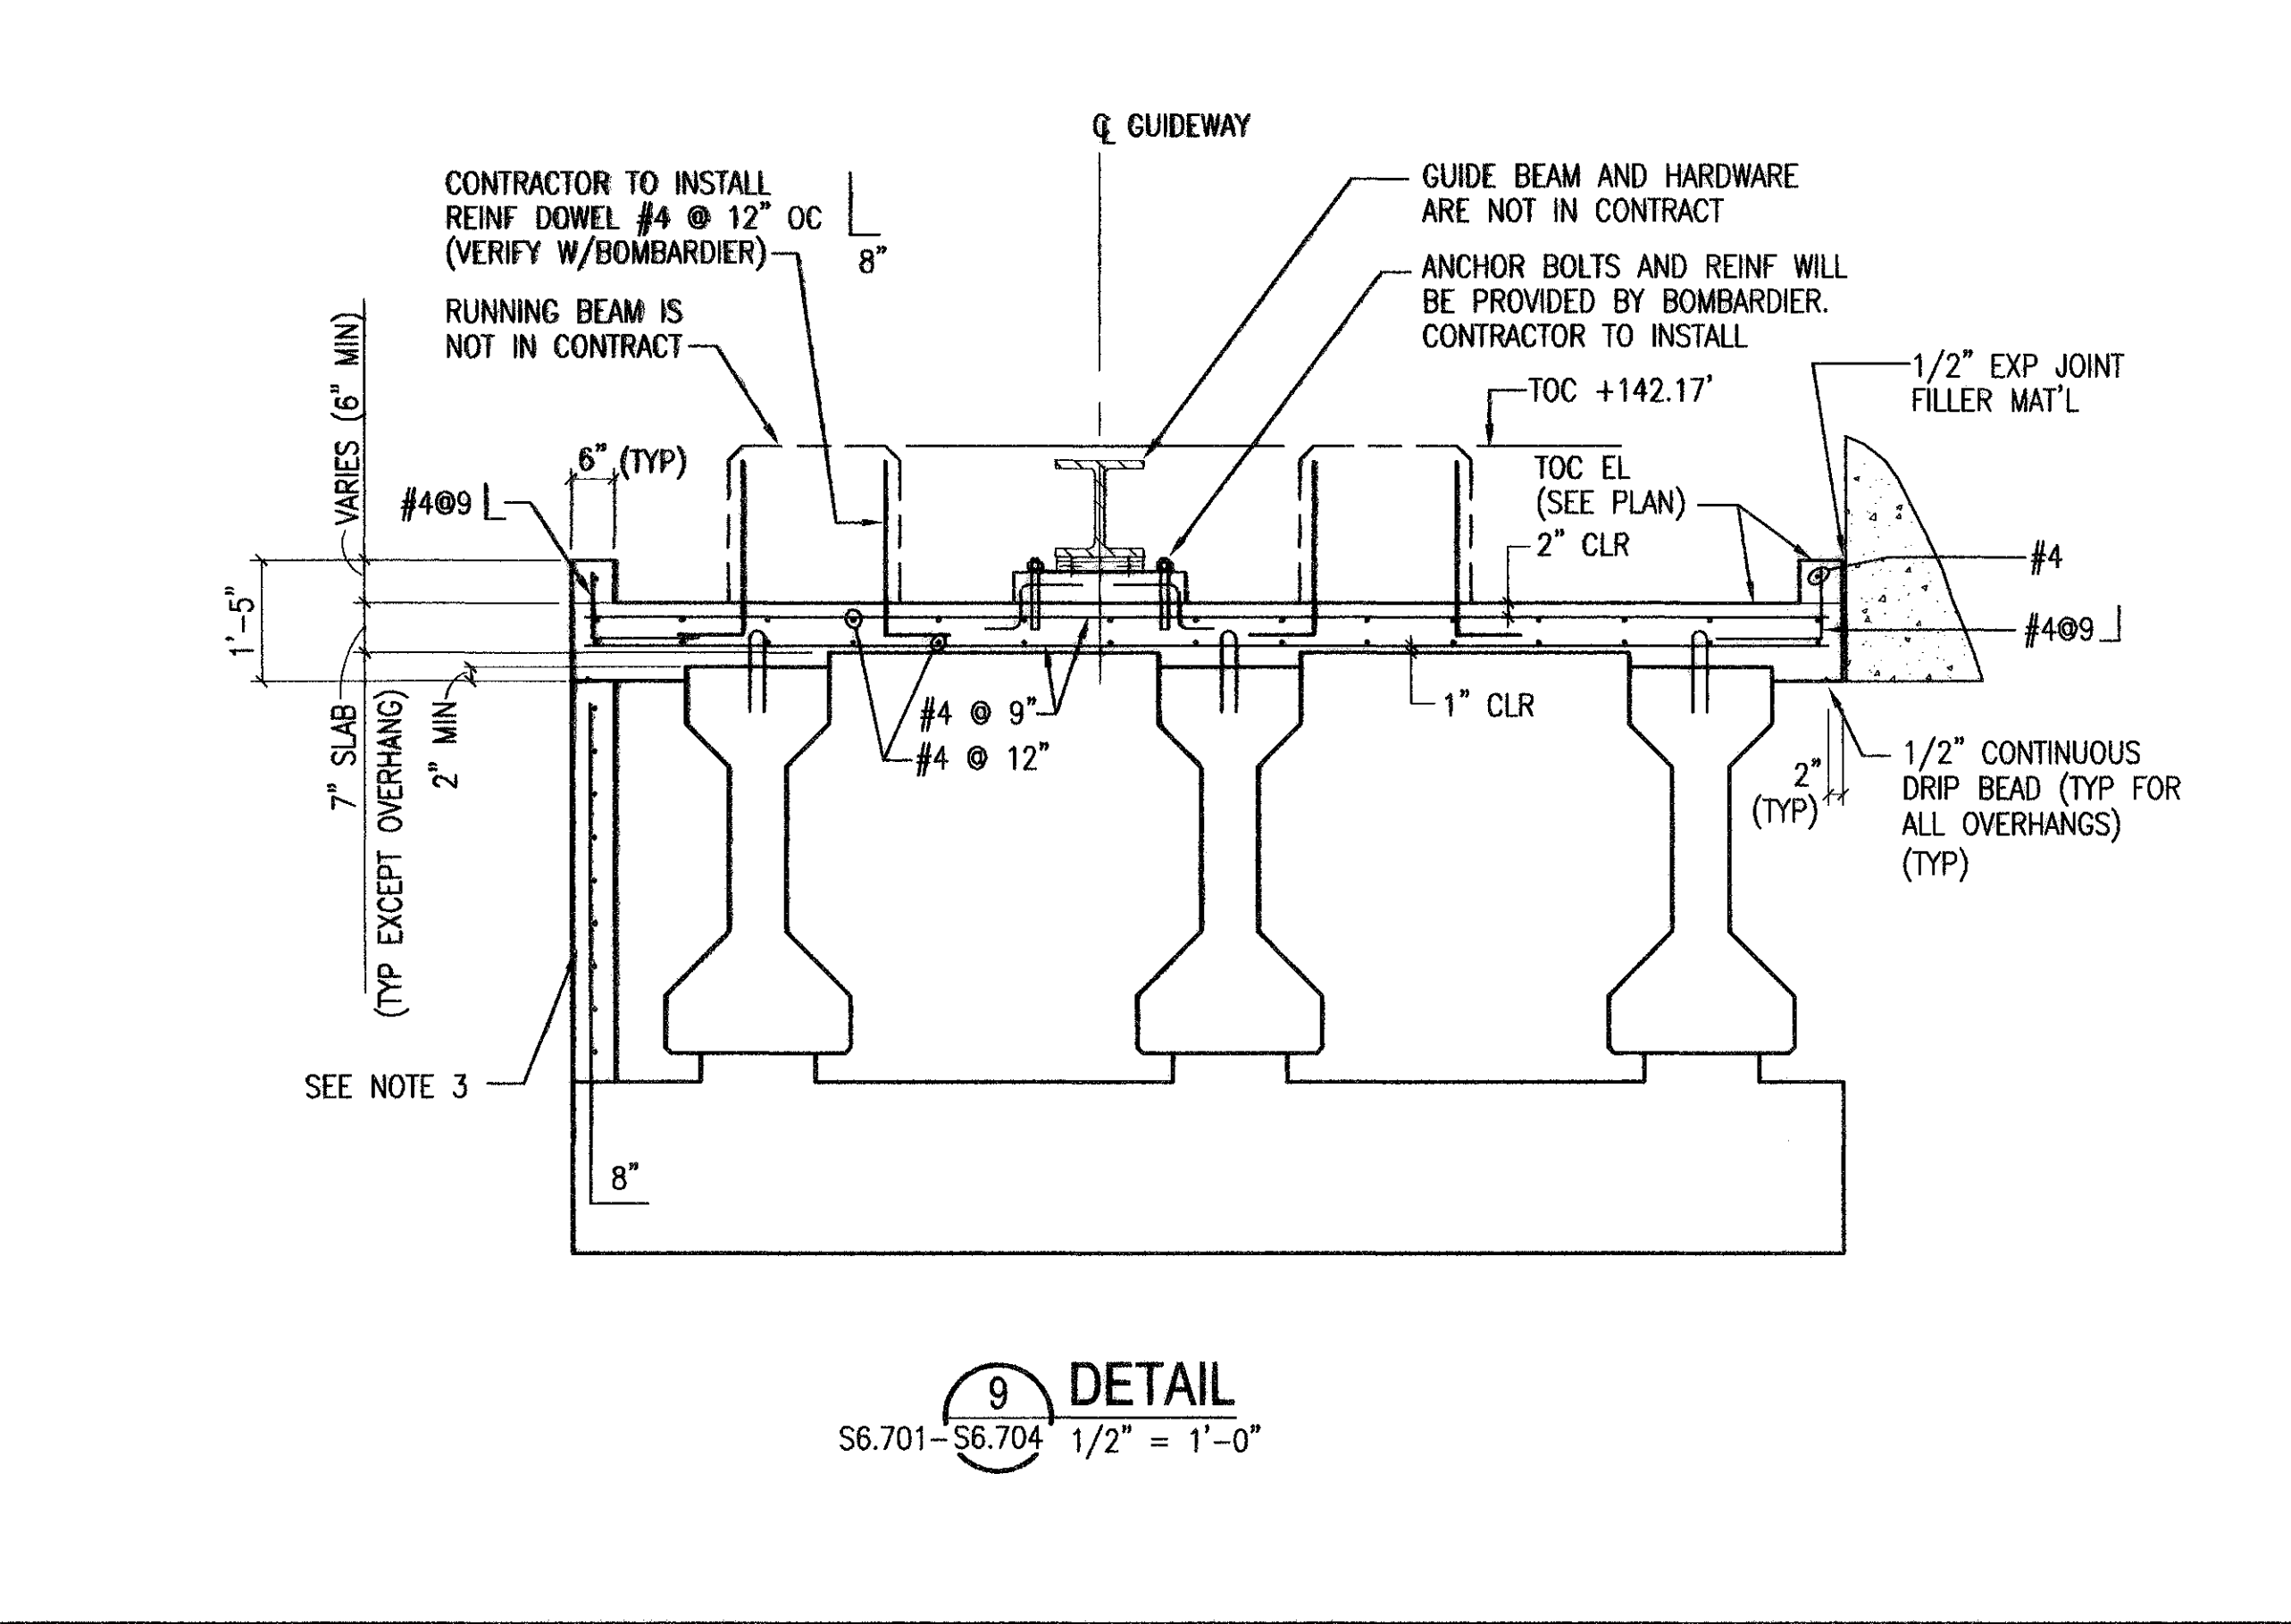

9 DETAIL  
S6.701-S6.704 1/2" = 1'-0"

NOTES TO SHEET

- REFER TO SHEET S0.100 FOR STRUCTURAL GENERAL NOTES.
- REFER TO SHEET S0.201 FOR CONCRETE BEAM SCHEDULE.
- PROVIDE 6" THK CLOSURE CONCRETE WALL REINF W/#6 @ 6" OC, VERTICAL AND #4 @ 6" OC, HORIZONTAL, TYP. SIZE OF CLOSURE IS 1'-8" WIDE AND HEIGHT IS HEIGHT OF INVERTED TEE AT BENT.

**HOUSTON AIRPORT SYSTEM**  
GEORGE BUSH  
INTERCONTINENTAL AIRPORT  
HOUSTON TEXAS

**HUTT-ZOLLARS**  
Hutt-Zollars, Inc. Engineers / Architects  
1201 Rolly Anderson, Suite 200, Houston, TX 77077  
Phone (281) 488-2066 Fax (281) 488-0220

**CHARLES F. TERRY, INC.**  
Consulting Engineers  
4001 West Loop West  
Suite 1000, Houston, Texas 77027  
Phone (281) 488-2066 Fax (281) 488-0220

NO.	DESCRIPTION	DATE	BY
ISSUED FOR BID		10/19/01	
ADDENDUM #1		02/01/02	MR

INTERNATIONAL • SERVICES • EXPANSION • PROGRAM

**APM STATION & PLATFORM**  
SECTION ALONG BENT #47

NOTE: REFER TO GRAPHIC SCALE IF ACTUAL SHEET SIZE IS OTHER THAN 30"x42".

0' 1' 2' 3'

SCALE: 1" = 1'-0"

NOTE: REFER TO GRAPHIC SCALE IF ACTUAL SHEET SIZE IS OTHER THAN 30"x42".

0' 2' 4' 8' 12'

SCALE: 1/4" = 1'-0"

NOTE: REFER TO GRAPHIC SCALE IF ACTUAL SHEET SIZE IS OTHER THAN 30"x42".

0' 1' 2' 4' 6'

SCALE: 1/2" = 1'-0"

RECORD DRAWINGS  
DO NOT MODIFY

DATE: MAY 6, 2005

HUTT-ZOLLARS, INC.

NOTE: INFORMATION USED TO DEVELOP THESE DOCUMENTS WAS TAKEN FROM RECORD OF THE WORK DRAWINGS PREPARED BY THE CONSTRUCTION CONTRACTOR, CLARK/MISSISSON A JOINT VENTURE. THE INFORMATION PROVIDED BY THE CONTRACTOR WAS NOT VERIFIED BY THE DESIGN FIRM NAMED ABOVE.

PROJECT MGR: GRW  
DESIGNER: JUC  
DRAWN BY: KLV  
CHECKED BY: MMR  
DRAWING STANDARD: ISEP 07.20.2000  
SCALE: AS NOTED  
DATE: 09/14/01

FOR RECORD DRAWING ONLY


STATE OF TEXAS  
MORAN MICHAEL REYNOLDS  
25454  
Professional Engineer  
09/04/01

APPROVED BY: DATE:


DIRECTOR  
HOUSTON AIRPORT SYSTEM

PROJECT NO. 02-2025-01  
C.I.P. NO. A-0354  
H.A.S. NO. 536C  
SHEET NO.




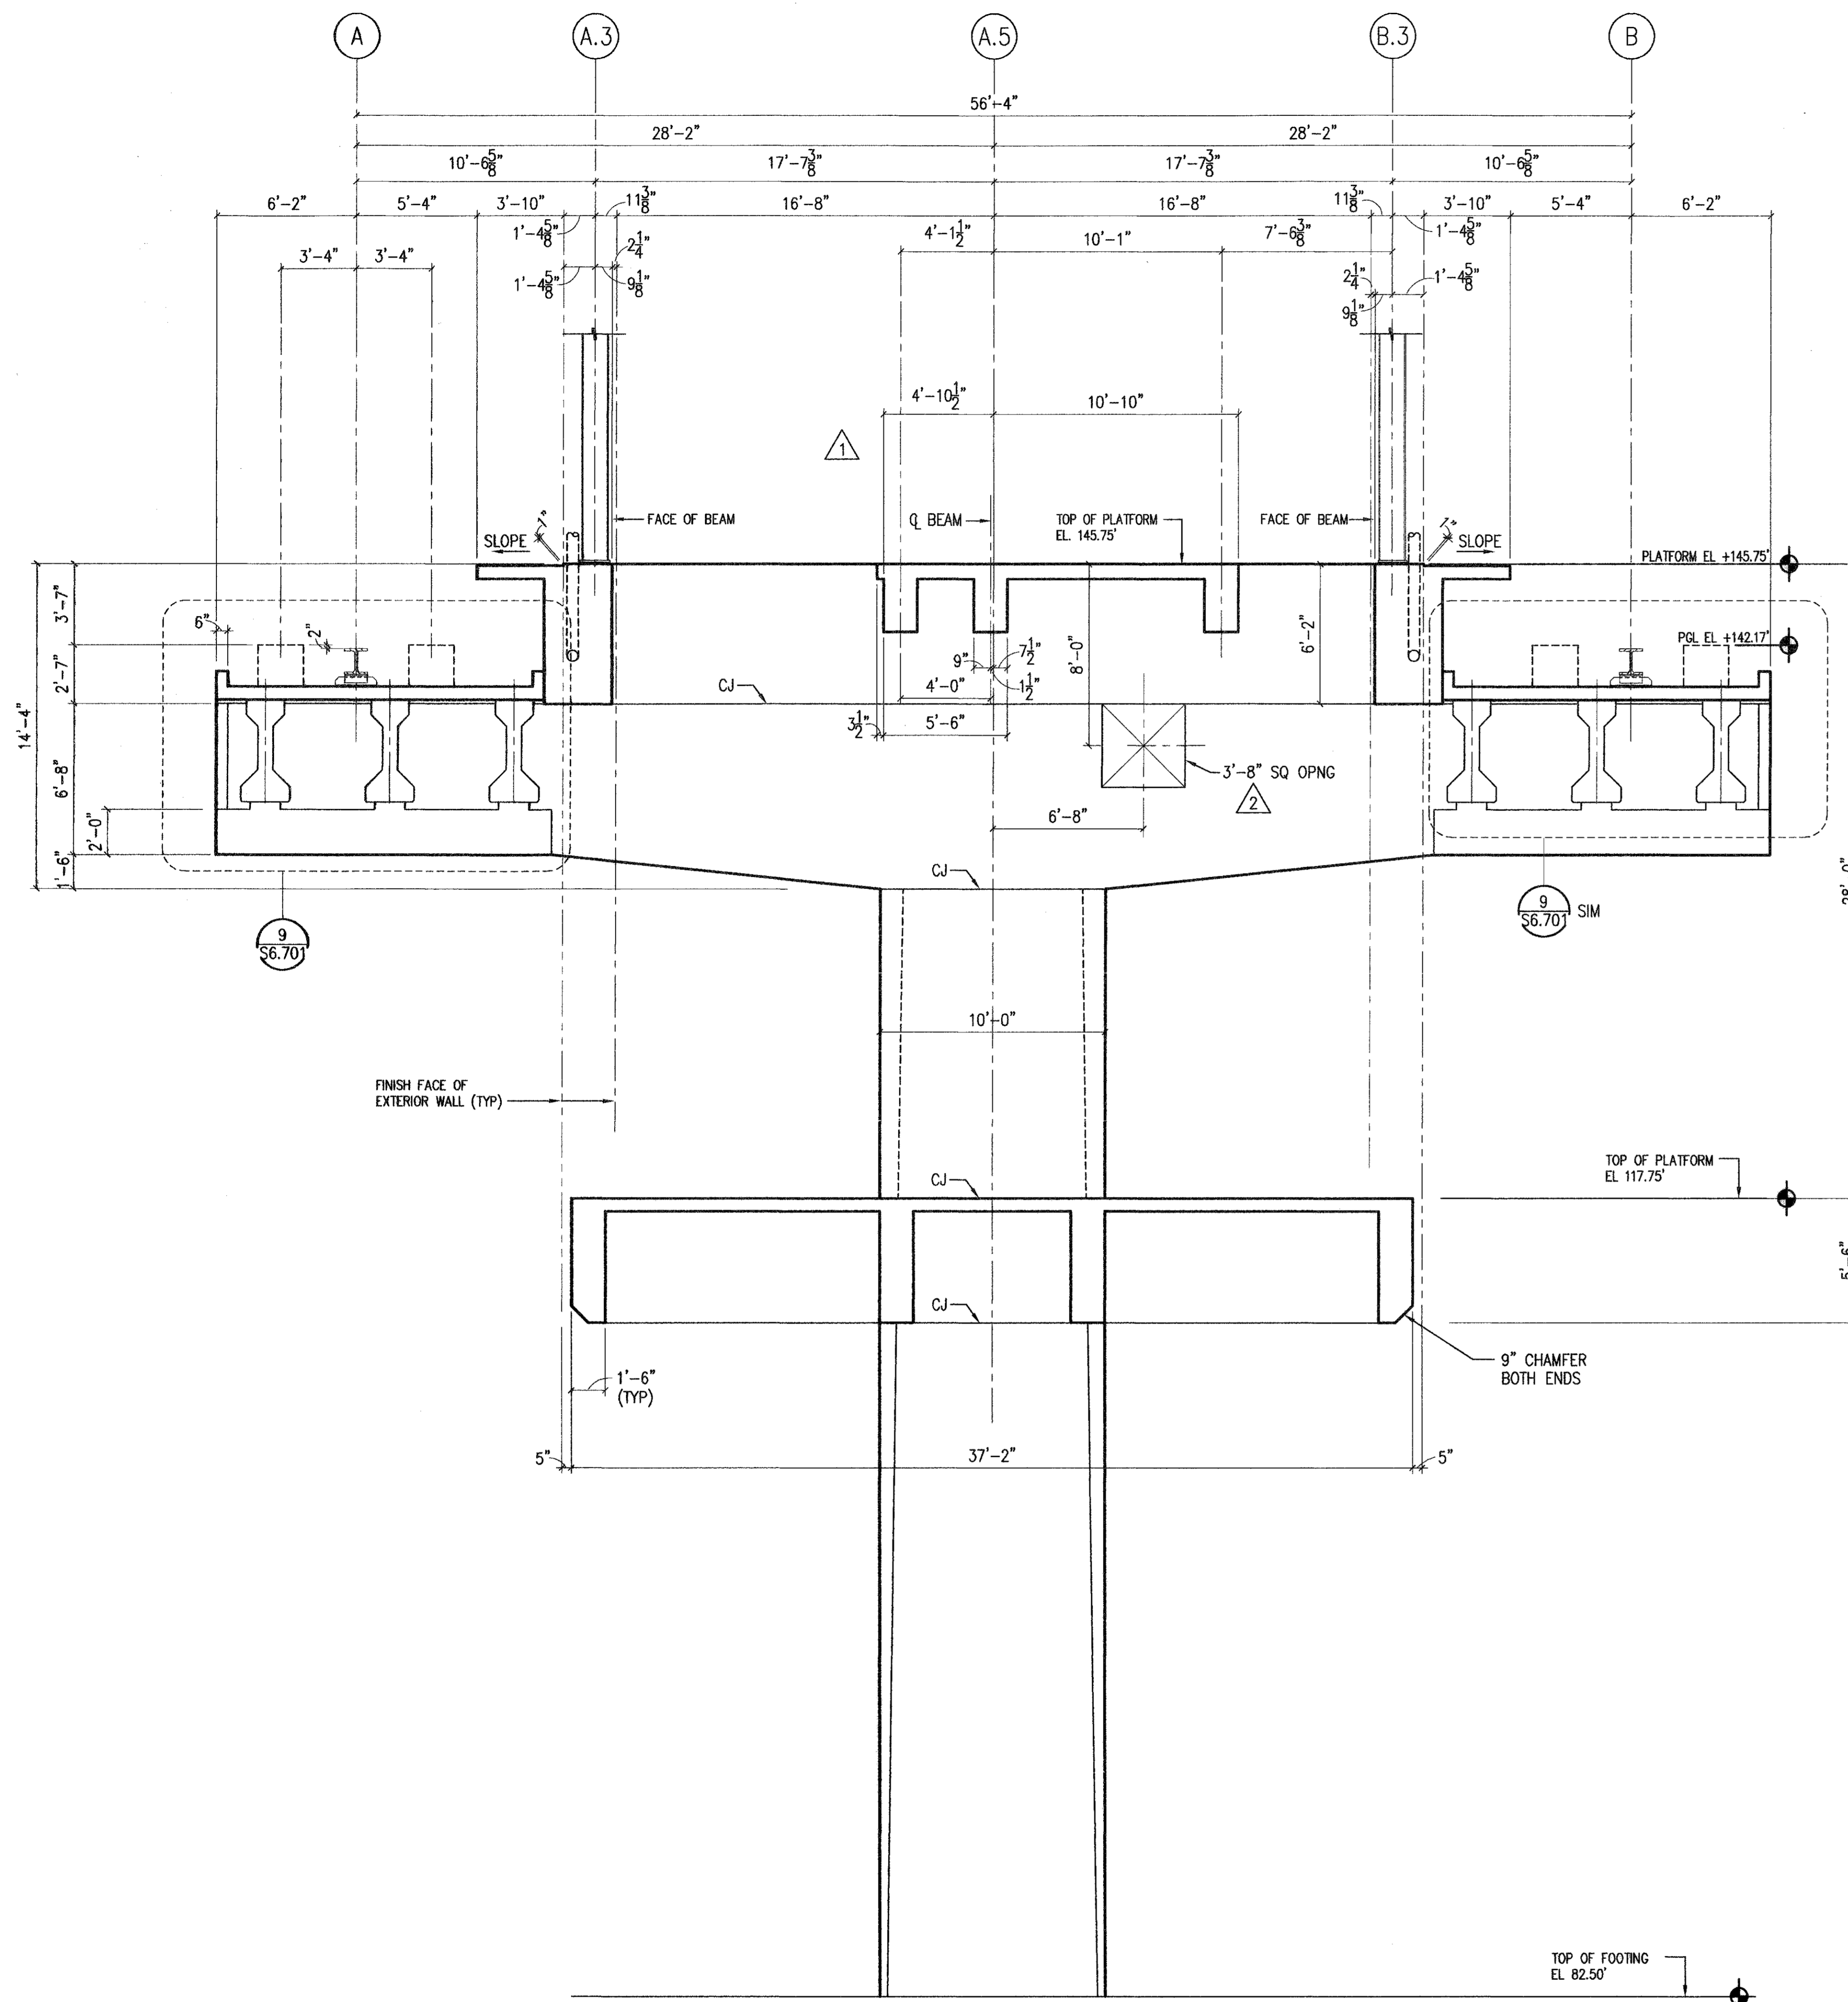

**12 SECTION ALONG BENT #48**  
 S3.002 1/4" = 1'-0"

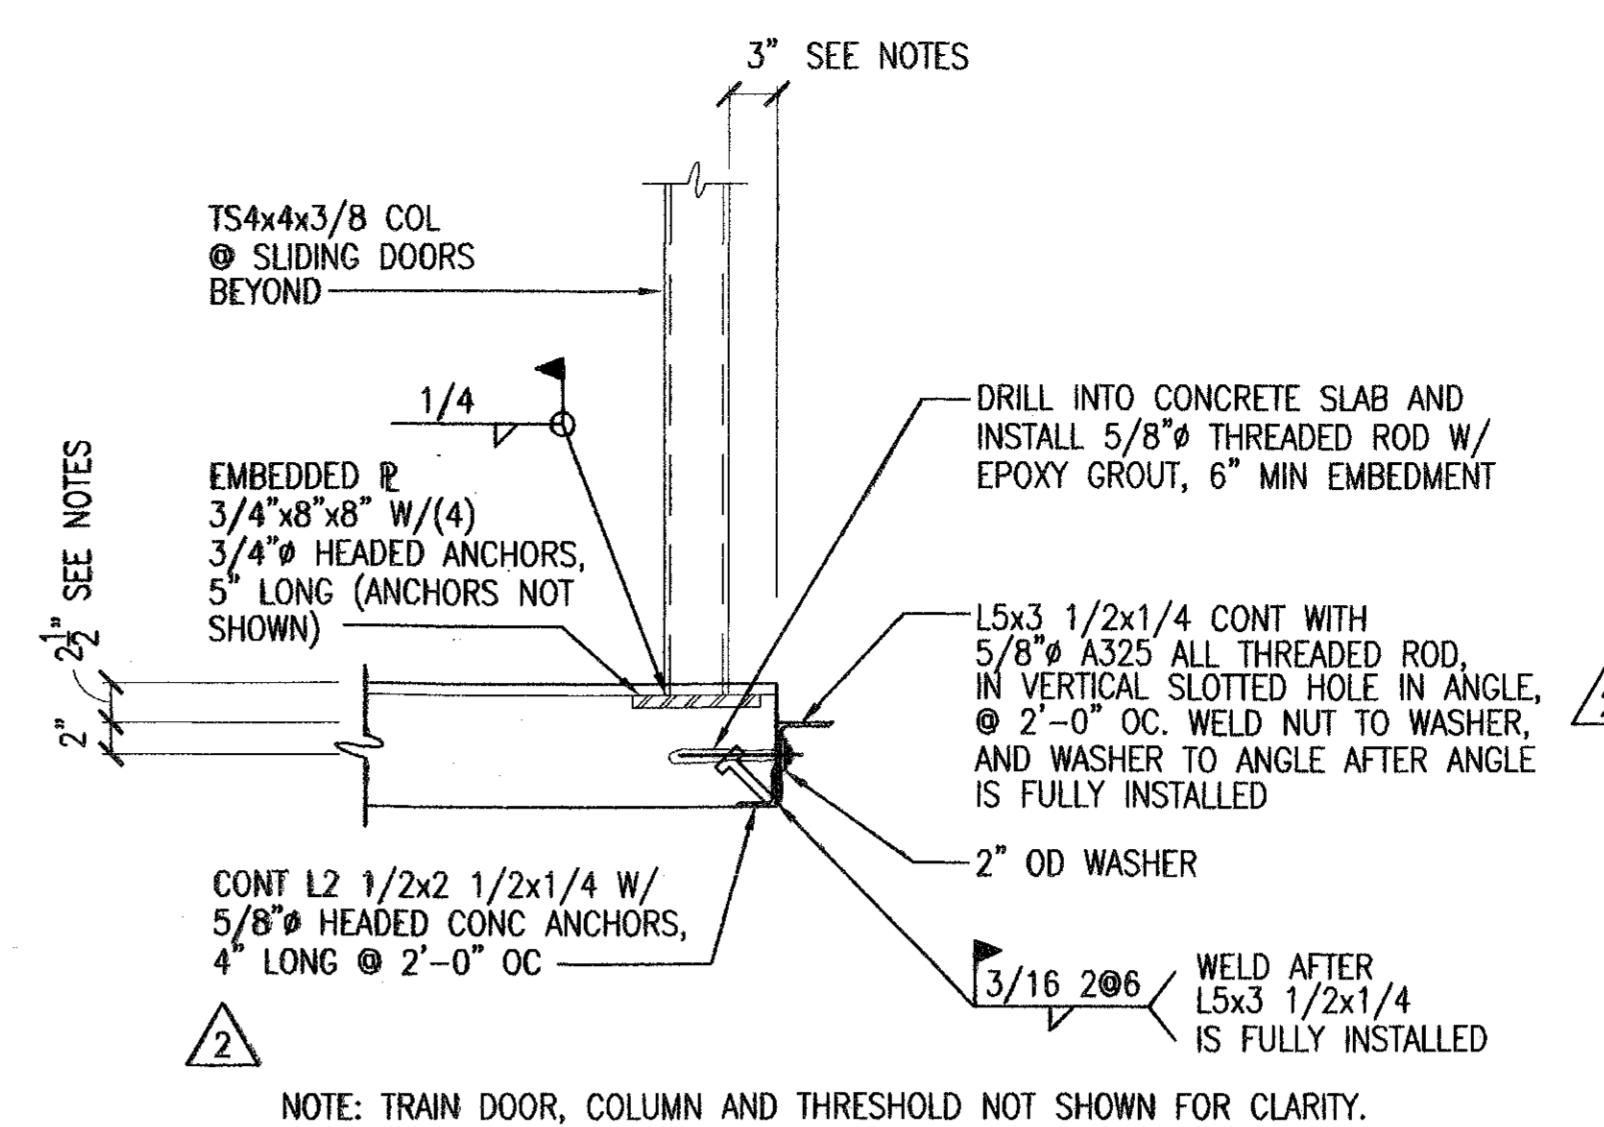

**1 SECTION**  
 S3.002 1" = 1'-0" EDGE OF SLAB @ SLIDING DOORS

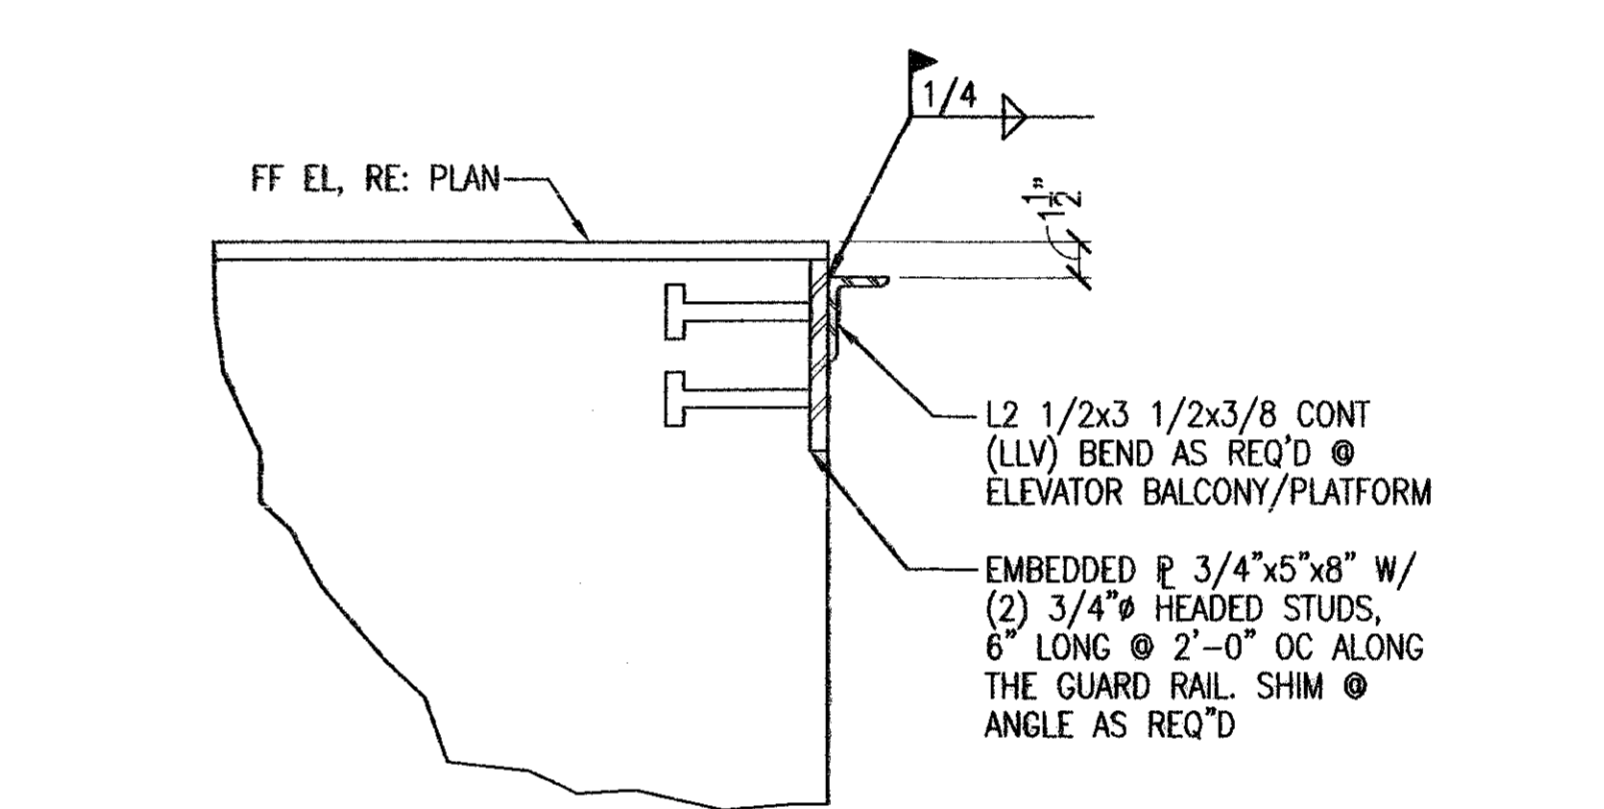

**5 SECTION**  
 S3.002 1 1/2" = 1'-0" SUPPORT FOR GUARDRAIL @ CATWALK AND ELEVATOR PLATFORM/BALCONY

**NOTES TO SHEET**

1. REFER TO SHEET S0.100 FOR STRUCTURAL GENERAL NOTES.
2. REFER TO SHEET S0.201 FOR CONCRETE BEAM SCHEDULE.

**HOUSTON AIRPORT SYSTEM**  
 GEORGE BUSH  
 INTERCONTINENTAL AIRPORT  
 HOUSTON TEXAS

**HUITT-ZOLLARS**  
 Huitt-Zollars, Inc. Engineering / Architecture  
 1500 Bay Area Blvd., Suite 200, Houston, TX 77057  
 Phone (281) 498-0066 Fax (281) 498-0220


**CHARLES F. YERBY, INC.**  
 Consulting Engineers  
 2001 North Loop West, Suite 200  
 Dallas, Texas 75202  
 Phone (214) 742-1111 Fax (214) 742-1111

NO.	DESCRIPTION	DATE	BY
ISSUED FOR BID		10/19/01	
ADDENDUM #1		02/01/02	MMR
REVISION #1		01/27/03	MMR

INTERNATIONAL • SERVICES • EXPANSION • PROGRAM

**APM STATION & PLATFORM SECTION ALONG BENT #48**

PROJECT MGR:	GRW
DESIGNER:	JJC
DRAWN BY:	KLV
CHECKED BY:	MMR
DRAWING STANDARD:	ISEP 07.20.2000
SCALE:	AS NOTED
DATE:	09/14/01

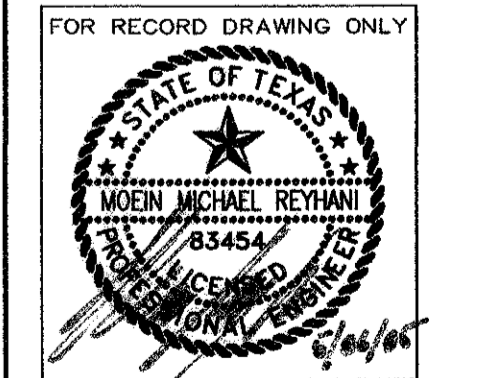

APPROVED BY:	DATE:
DIRECTOR	HOUSTON AIRPORT SYSTEM
PROJECT NO.	02-2025-01
C.I.P. NO.	A-0354
H.A.S. NO.	536C
SHEET NO.	

NOTE: REFER TO GRAPHIC SCALE IF ACTUAL SHEET SIZE IS OTHER THAN 30"x42".

SCALE: 1/4" = 1'-0"


**RECORD DRAWINGS DO NOT MODIFY**

DATE: MAY 6, 2005



HUITT-ZOLLARS, INC.

NOTE: INFORMATION USED TO DEVELOP THESE DOCUMENTS WAS TAKEN FROM RECORD OF THE WORK DRAWINGS PREPARED BY THE CONSTRUCTION CONTRACTOR, CLARK/MISSION A JOINT VENTURE. THE INFORMATION PROVIDED BY THE CONTRACTOR WAS NOT VERIFIED BY THE DESIGN FIRM NAMED ABOVE.




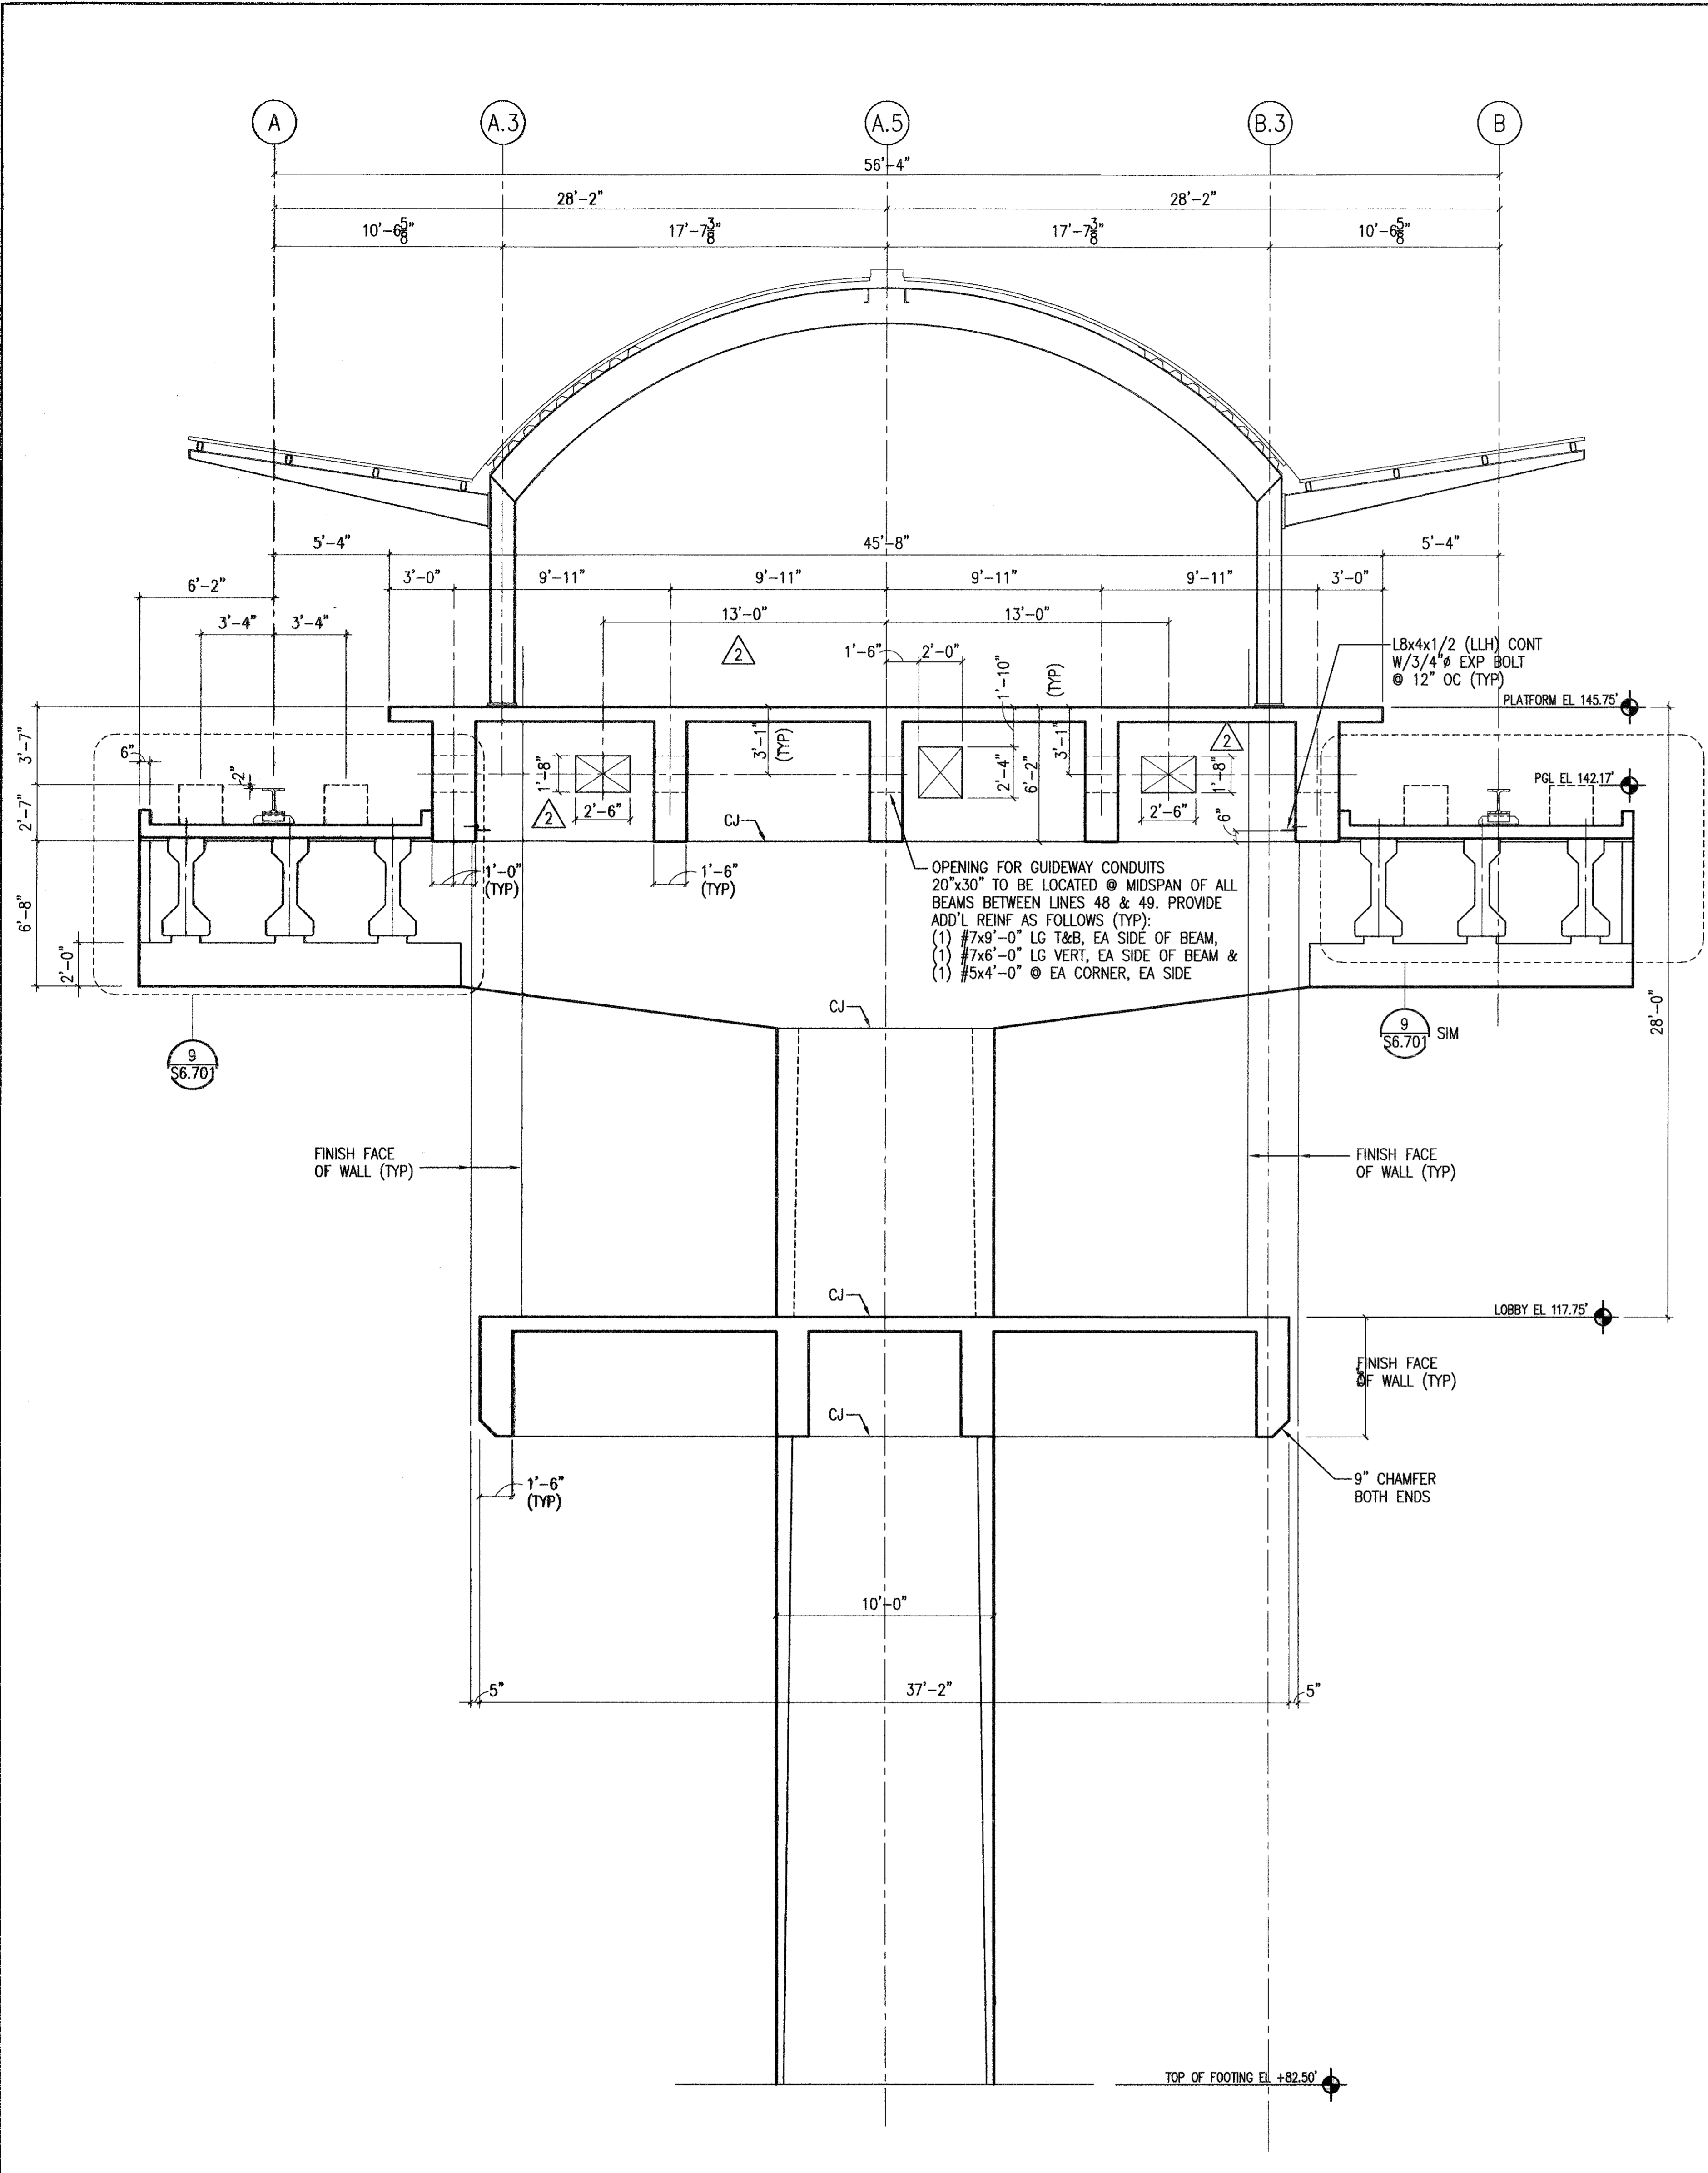

12 SECTION ALONG BENT #49  
S3.002 1/4" = 1'-0"

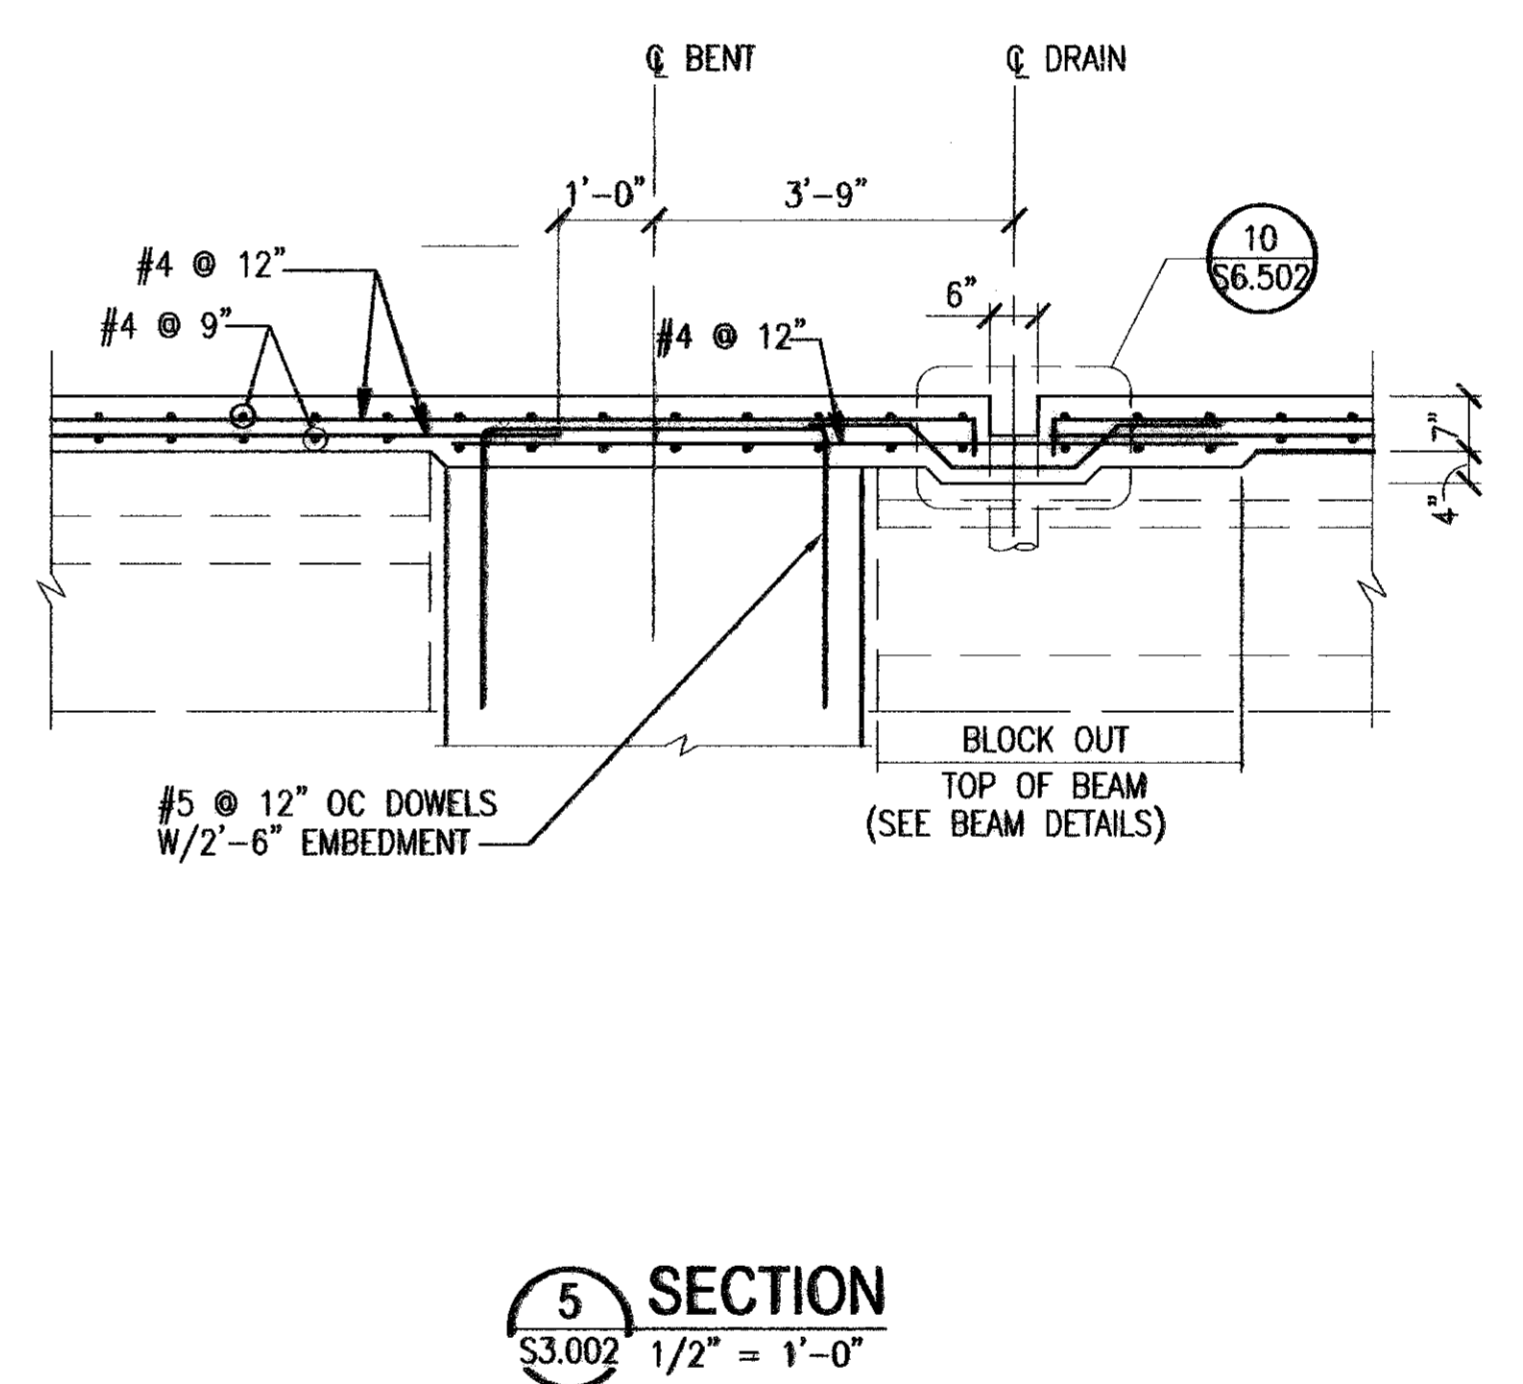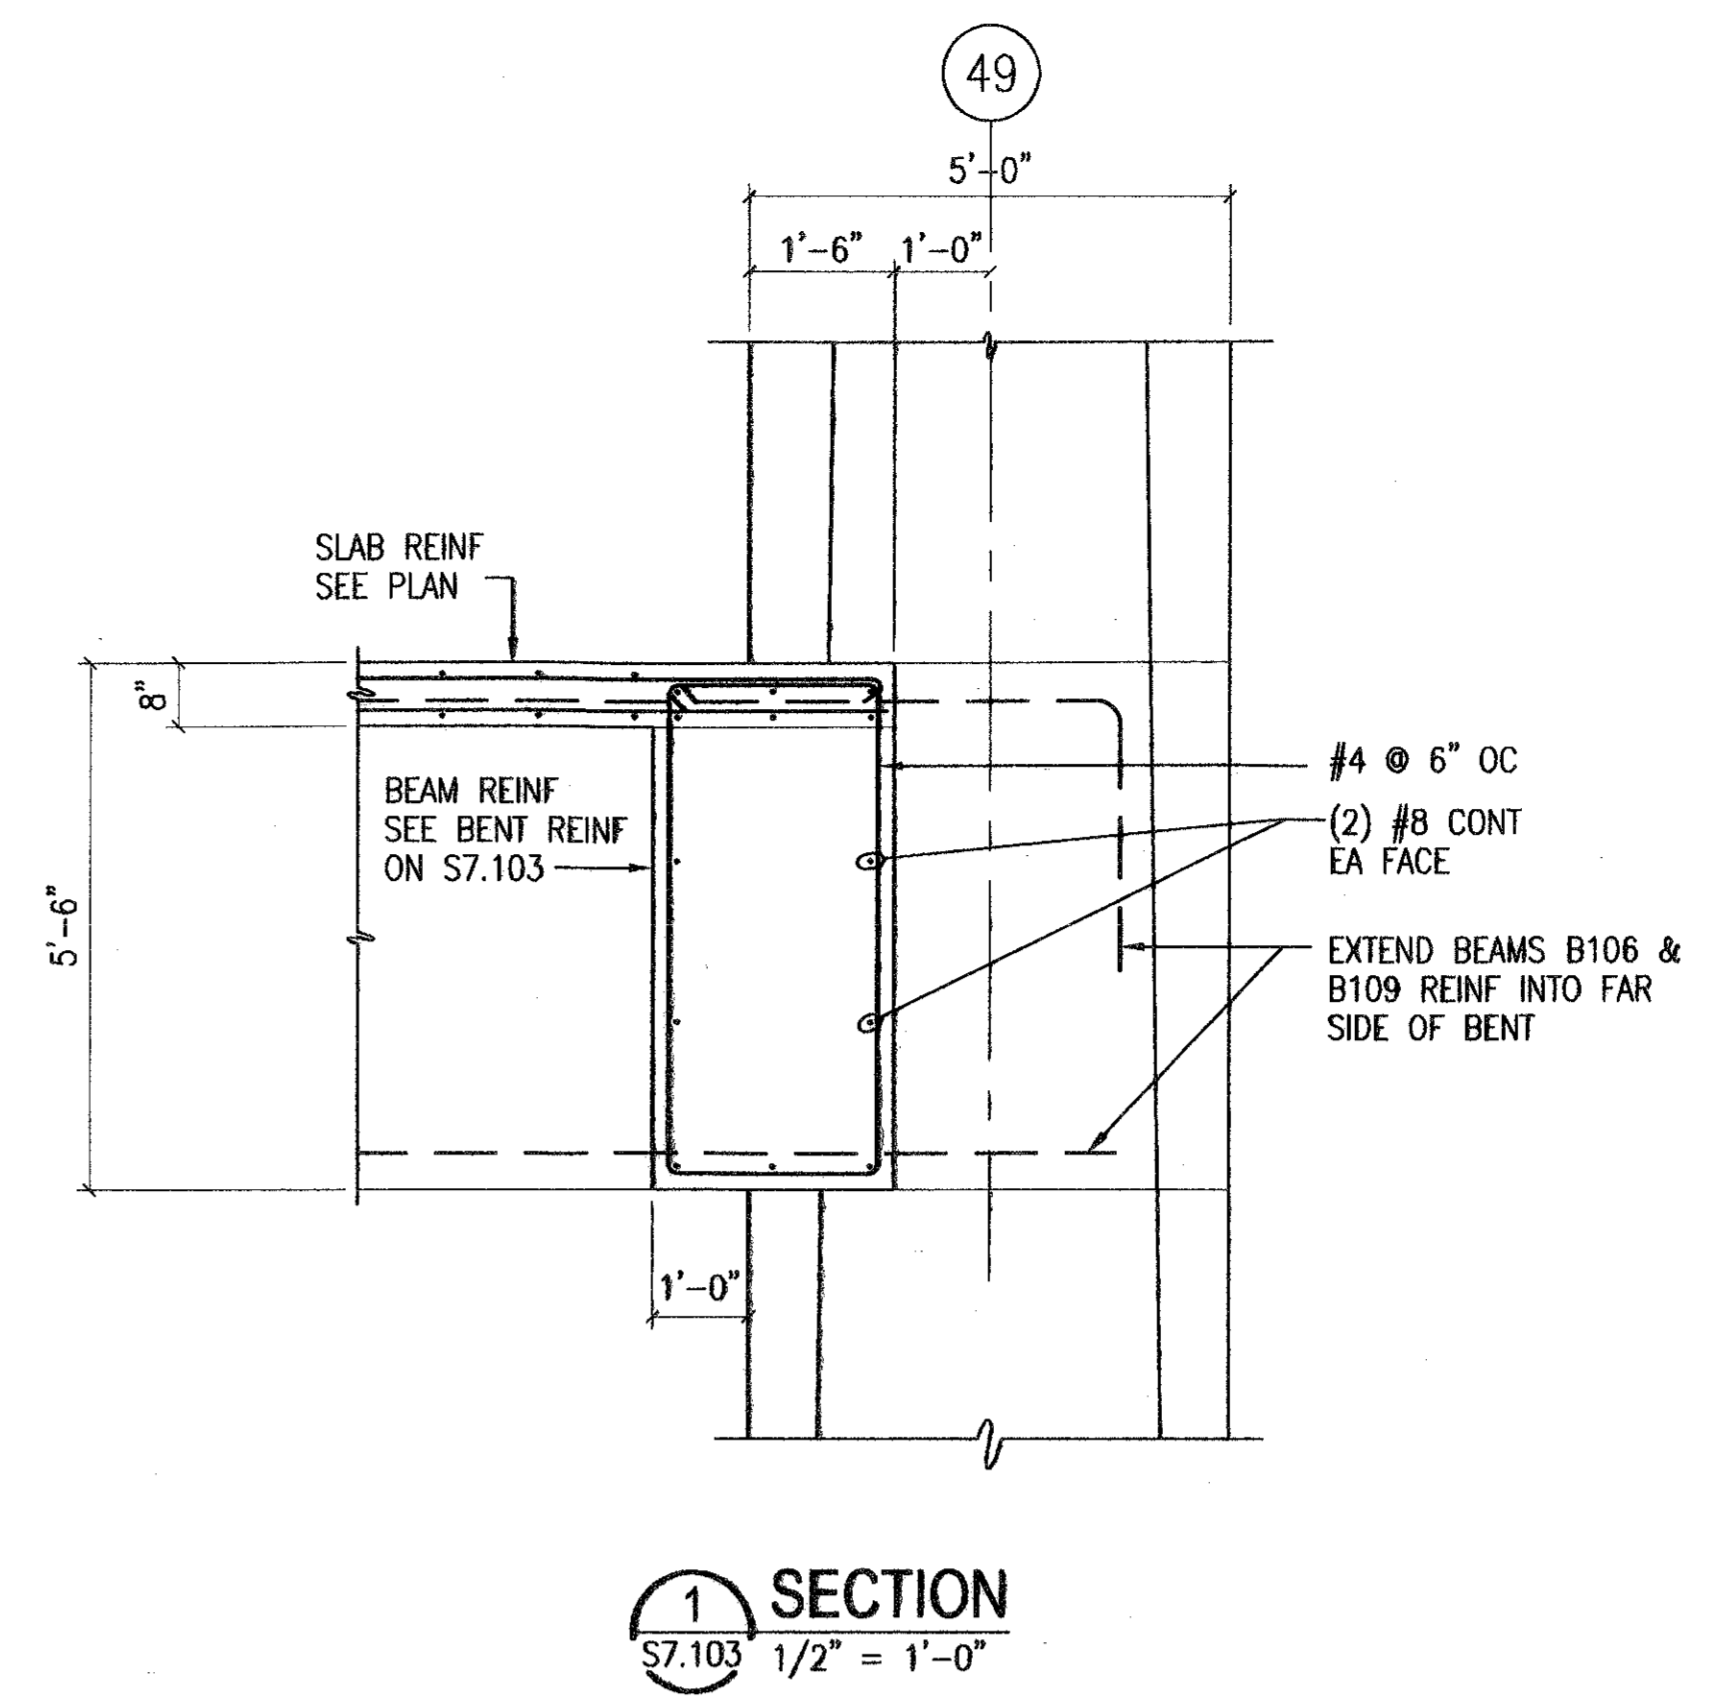

5 SECTION  
S3.002 1/2" = 1'-0"

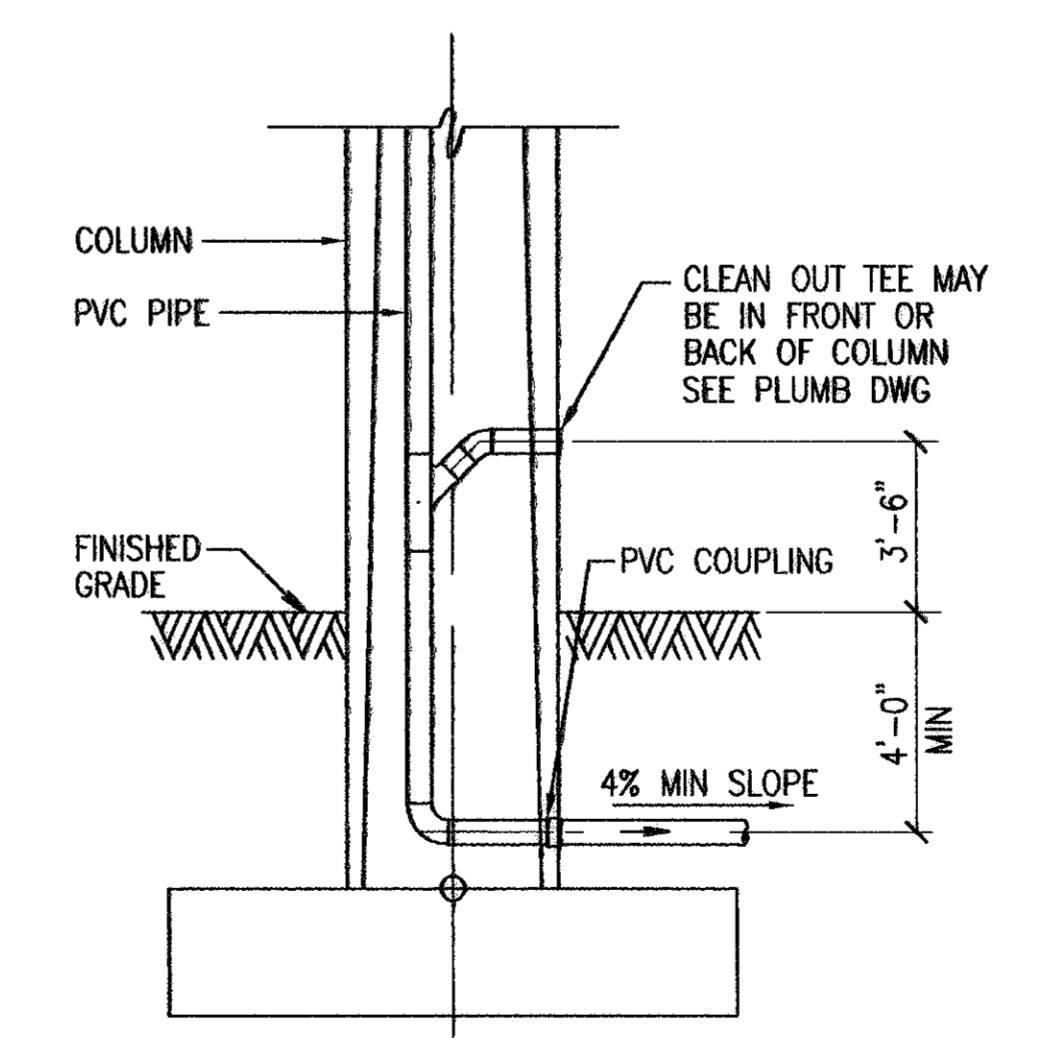

9 TYPICAL CLEAN OUT DETAIL FOR ALL BENTS  
S7.101-S7.104 NTS

NOTES TO SHEET

- REFER TO SHEET S0.100 FOR STRUCTURAL GENERAL NOTES.
- REFER TO SHEET S0.201 FOR CONCRETE BEAM SCHEDULE.

**HUTT-ZOLLARS**  
Houston Airport System  
George Bush Intercontinental Airport  
Houston Texas

**HUTT-ZOLLARS**  
Hutt-Zollars, Inc. Engineering / Architecture  
1500 Dairy Road, Suite 200, Houston, TX 77077  
Phone (281) 488-0066 Fax (281) 488-0220


**CHARLES F. TERRY, INC.**  
Consulting Engineers  
8001 Gessner Avenue  
Dallas, Texas 75226  
Phone (214) 343-8844

NO.	DESCRIPTION	DATE	BY
ISSUED FOR BID		10/19/01	
NOT USED			
REVISION #1		01/27/03	MR


INTERNATIONAL • SERVICES • EXPANSION • PROGRAM  
APM STATION & PLATFORM  
SECTION ALONG BENT #49

PROJECT MGR:	GRW
DESIGNER:	JUC
DRAWN BY:	KLV
CHECKED BY:	MMR
DRAWING STANDARD:	SEP. 07.20.2000
SCALE:	AS NOTED
DATE:	09/14/01

NOTE: REFER TO GRAPHIC SCALE IF ACTUAL SHEET SIZE IS OTHER THAN 30"x42".

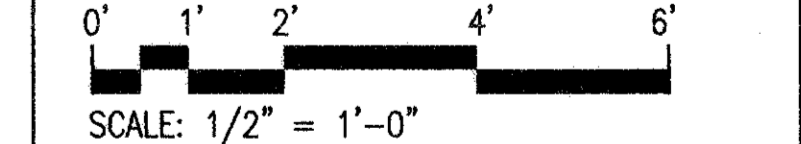

NOTE: REFER TO GRAPHIC SCALE IF ACTUAL SHEET SIZE IS OTHER THAN 30"x42".

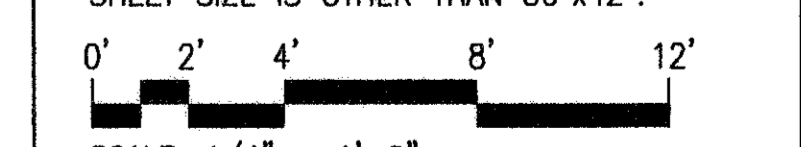


SCALE: 1/4" = 1'-0"

**RECORD DRAWINGS  
DO NOT MODIFY**

DATE: MAY 6, 2005

HUTT-ZOLLARS, INC.

NOTE: INFORMATION USED TO DEVELOP THESE DOCUMENTS WAS TAKEN FROM RECORD OF THE WORK DRAWINGS PREPARED BY THE CONSTRUCTION CONTRACTOR. CLARK/MISSON A JOINT VENTURE. THE INFORMATION PROVIDED BY THE CONTRACTOR WAS NOT VERIFIED BY THE DESIGN FIRM NAMED ABOVE.

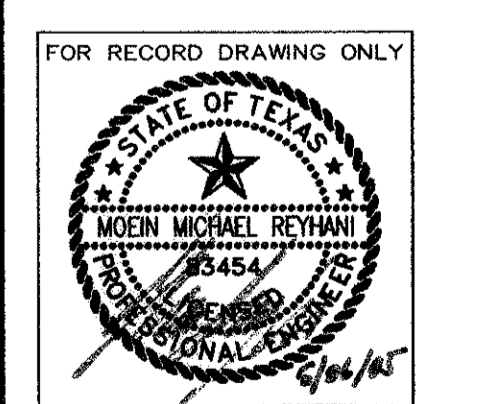


APPROVED BY:	DATE:
PROJECT NO.	02-2025-01
C.I.P. NO.	A-0354
H.A.S. NO.	538C
SHEET NO.	


S6.703

PLOT DATE: 10/19/01 HAS FILE: HAS36565703.DWG




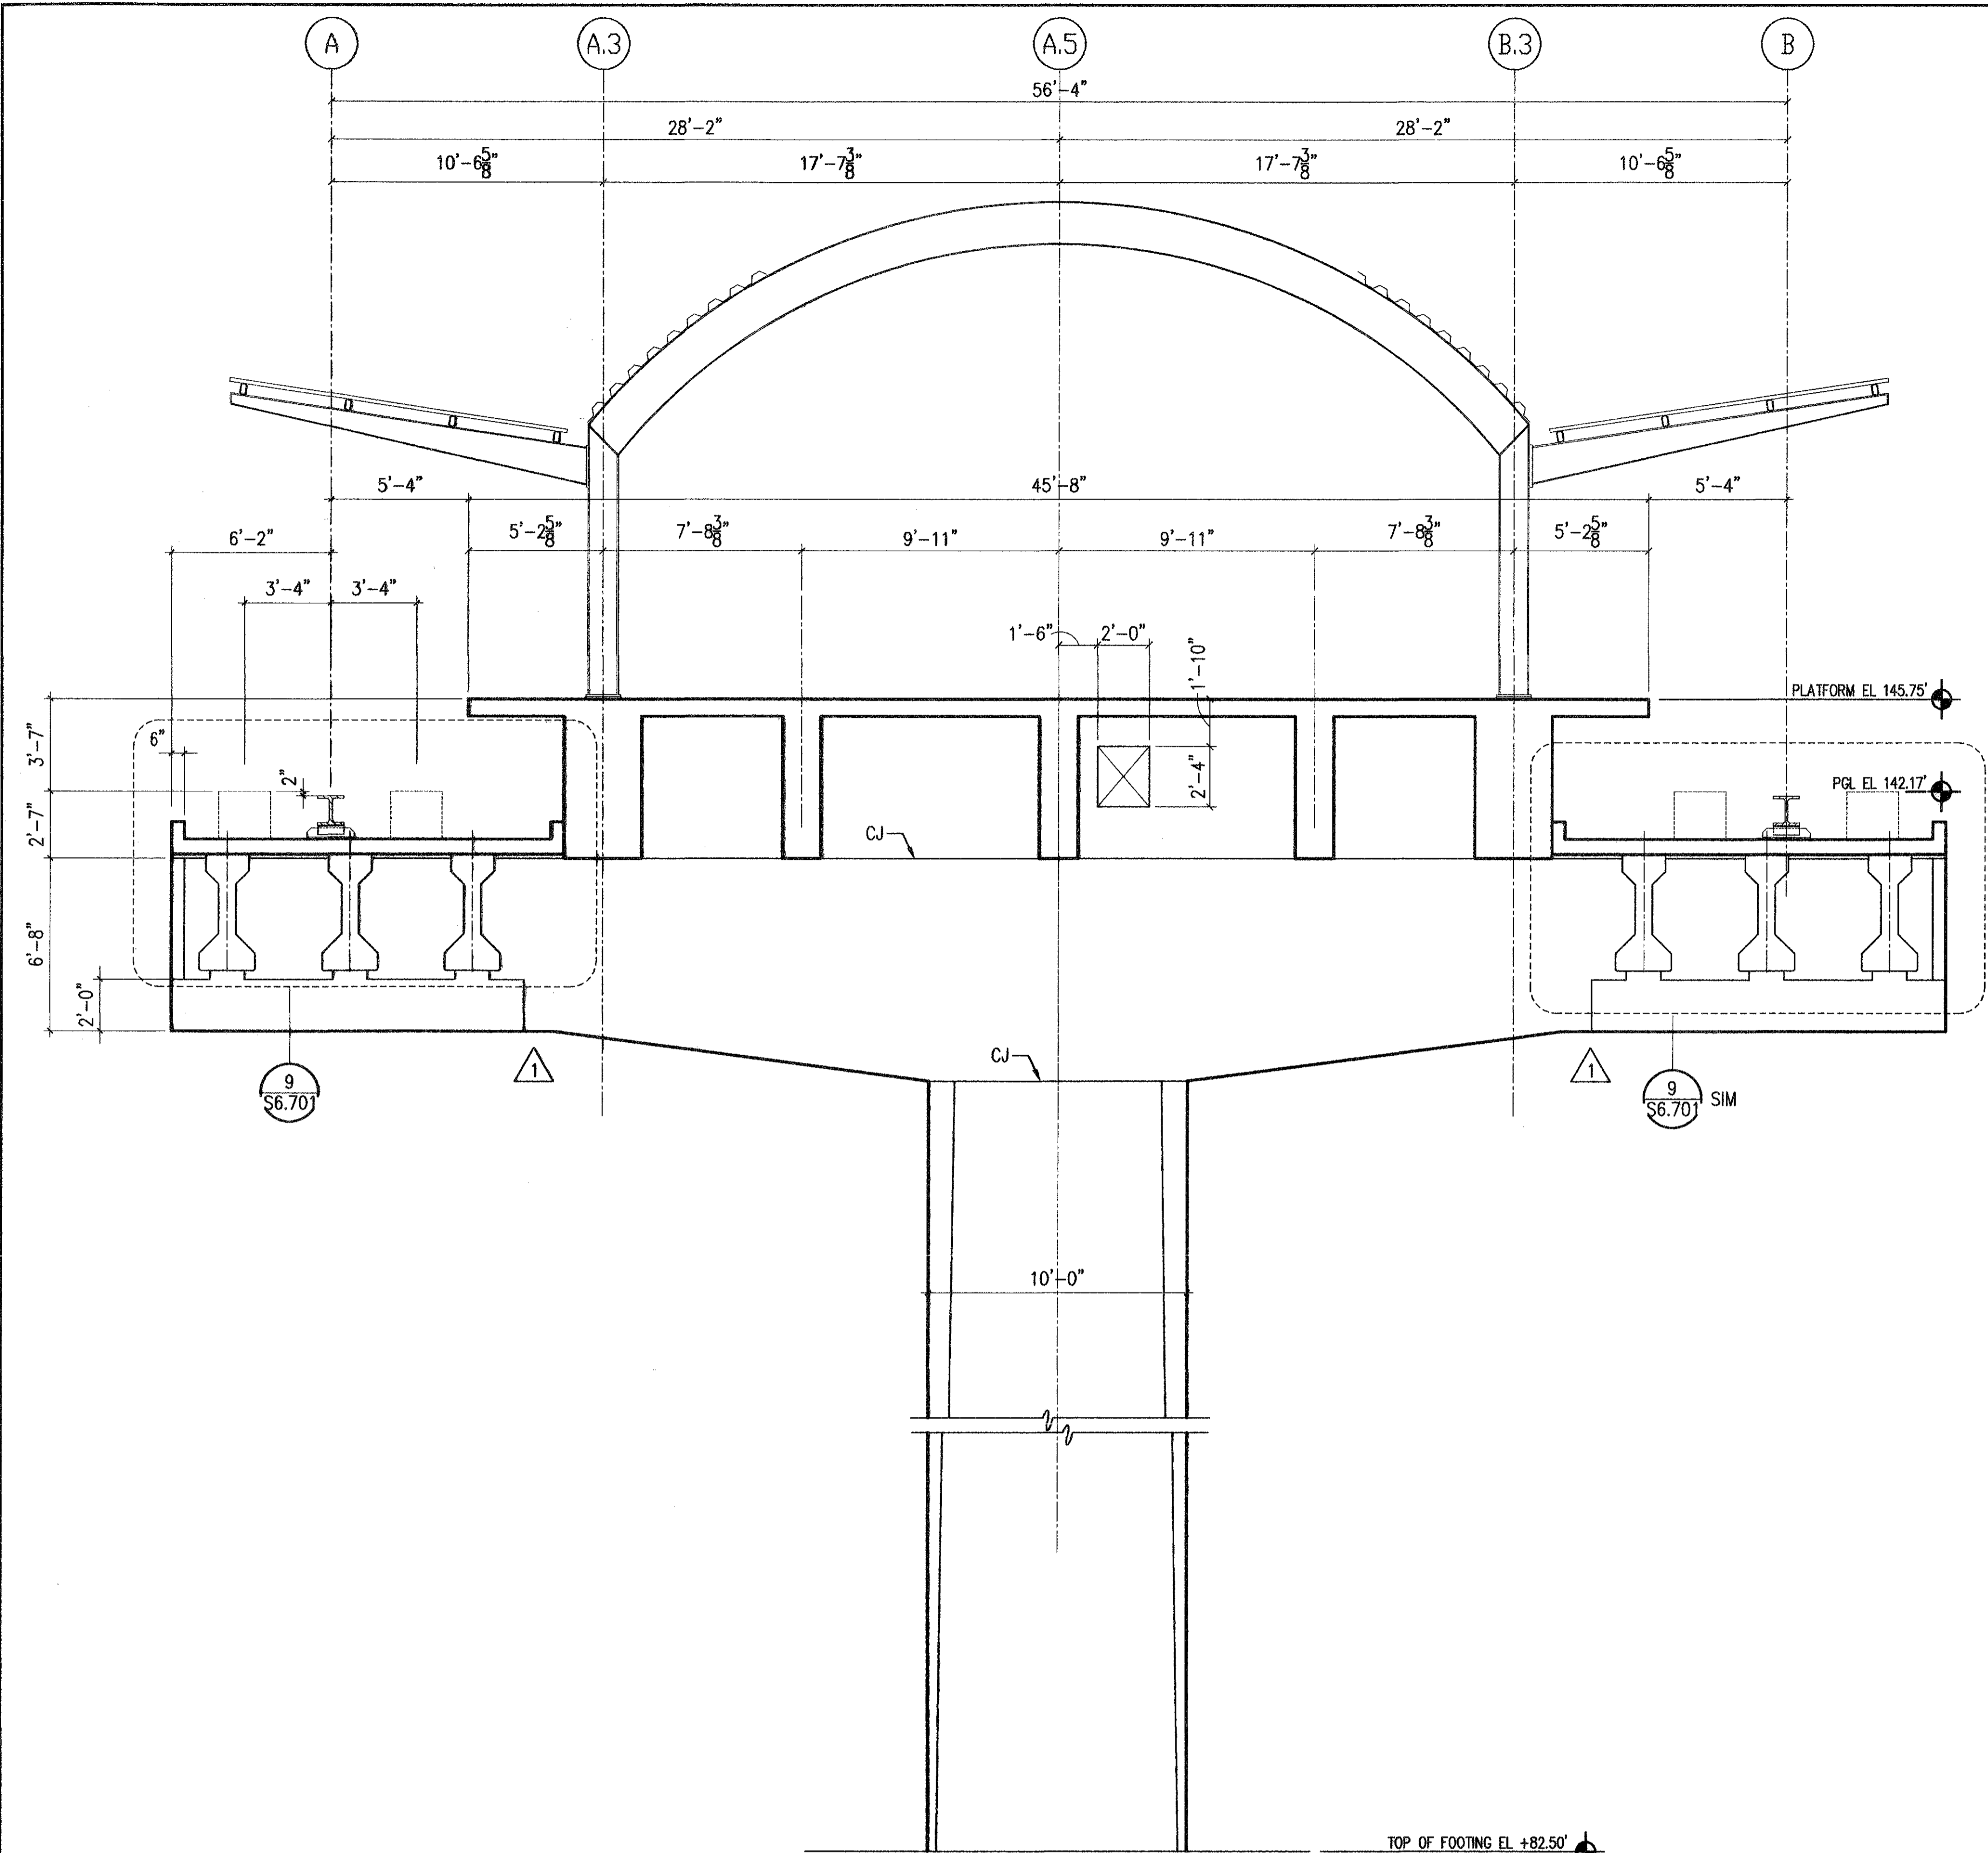


**8 SECTION ALONG BENT #50**  
S3.002 1/4" = 1'-0"

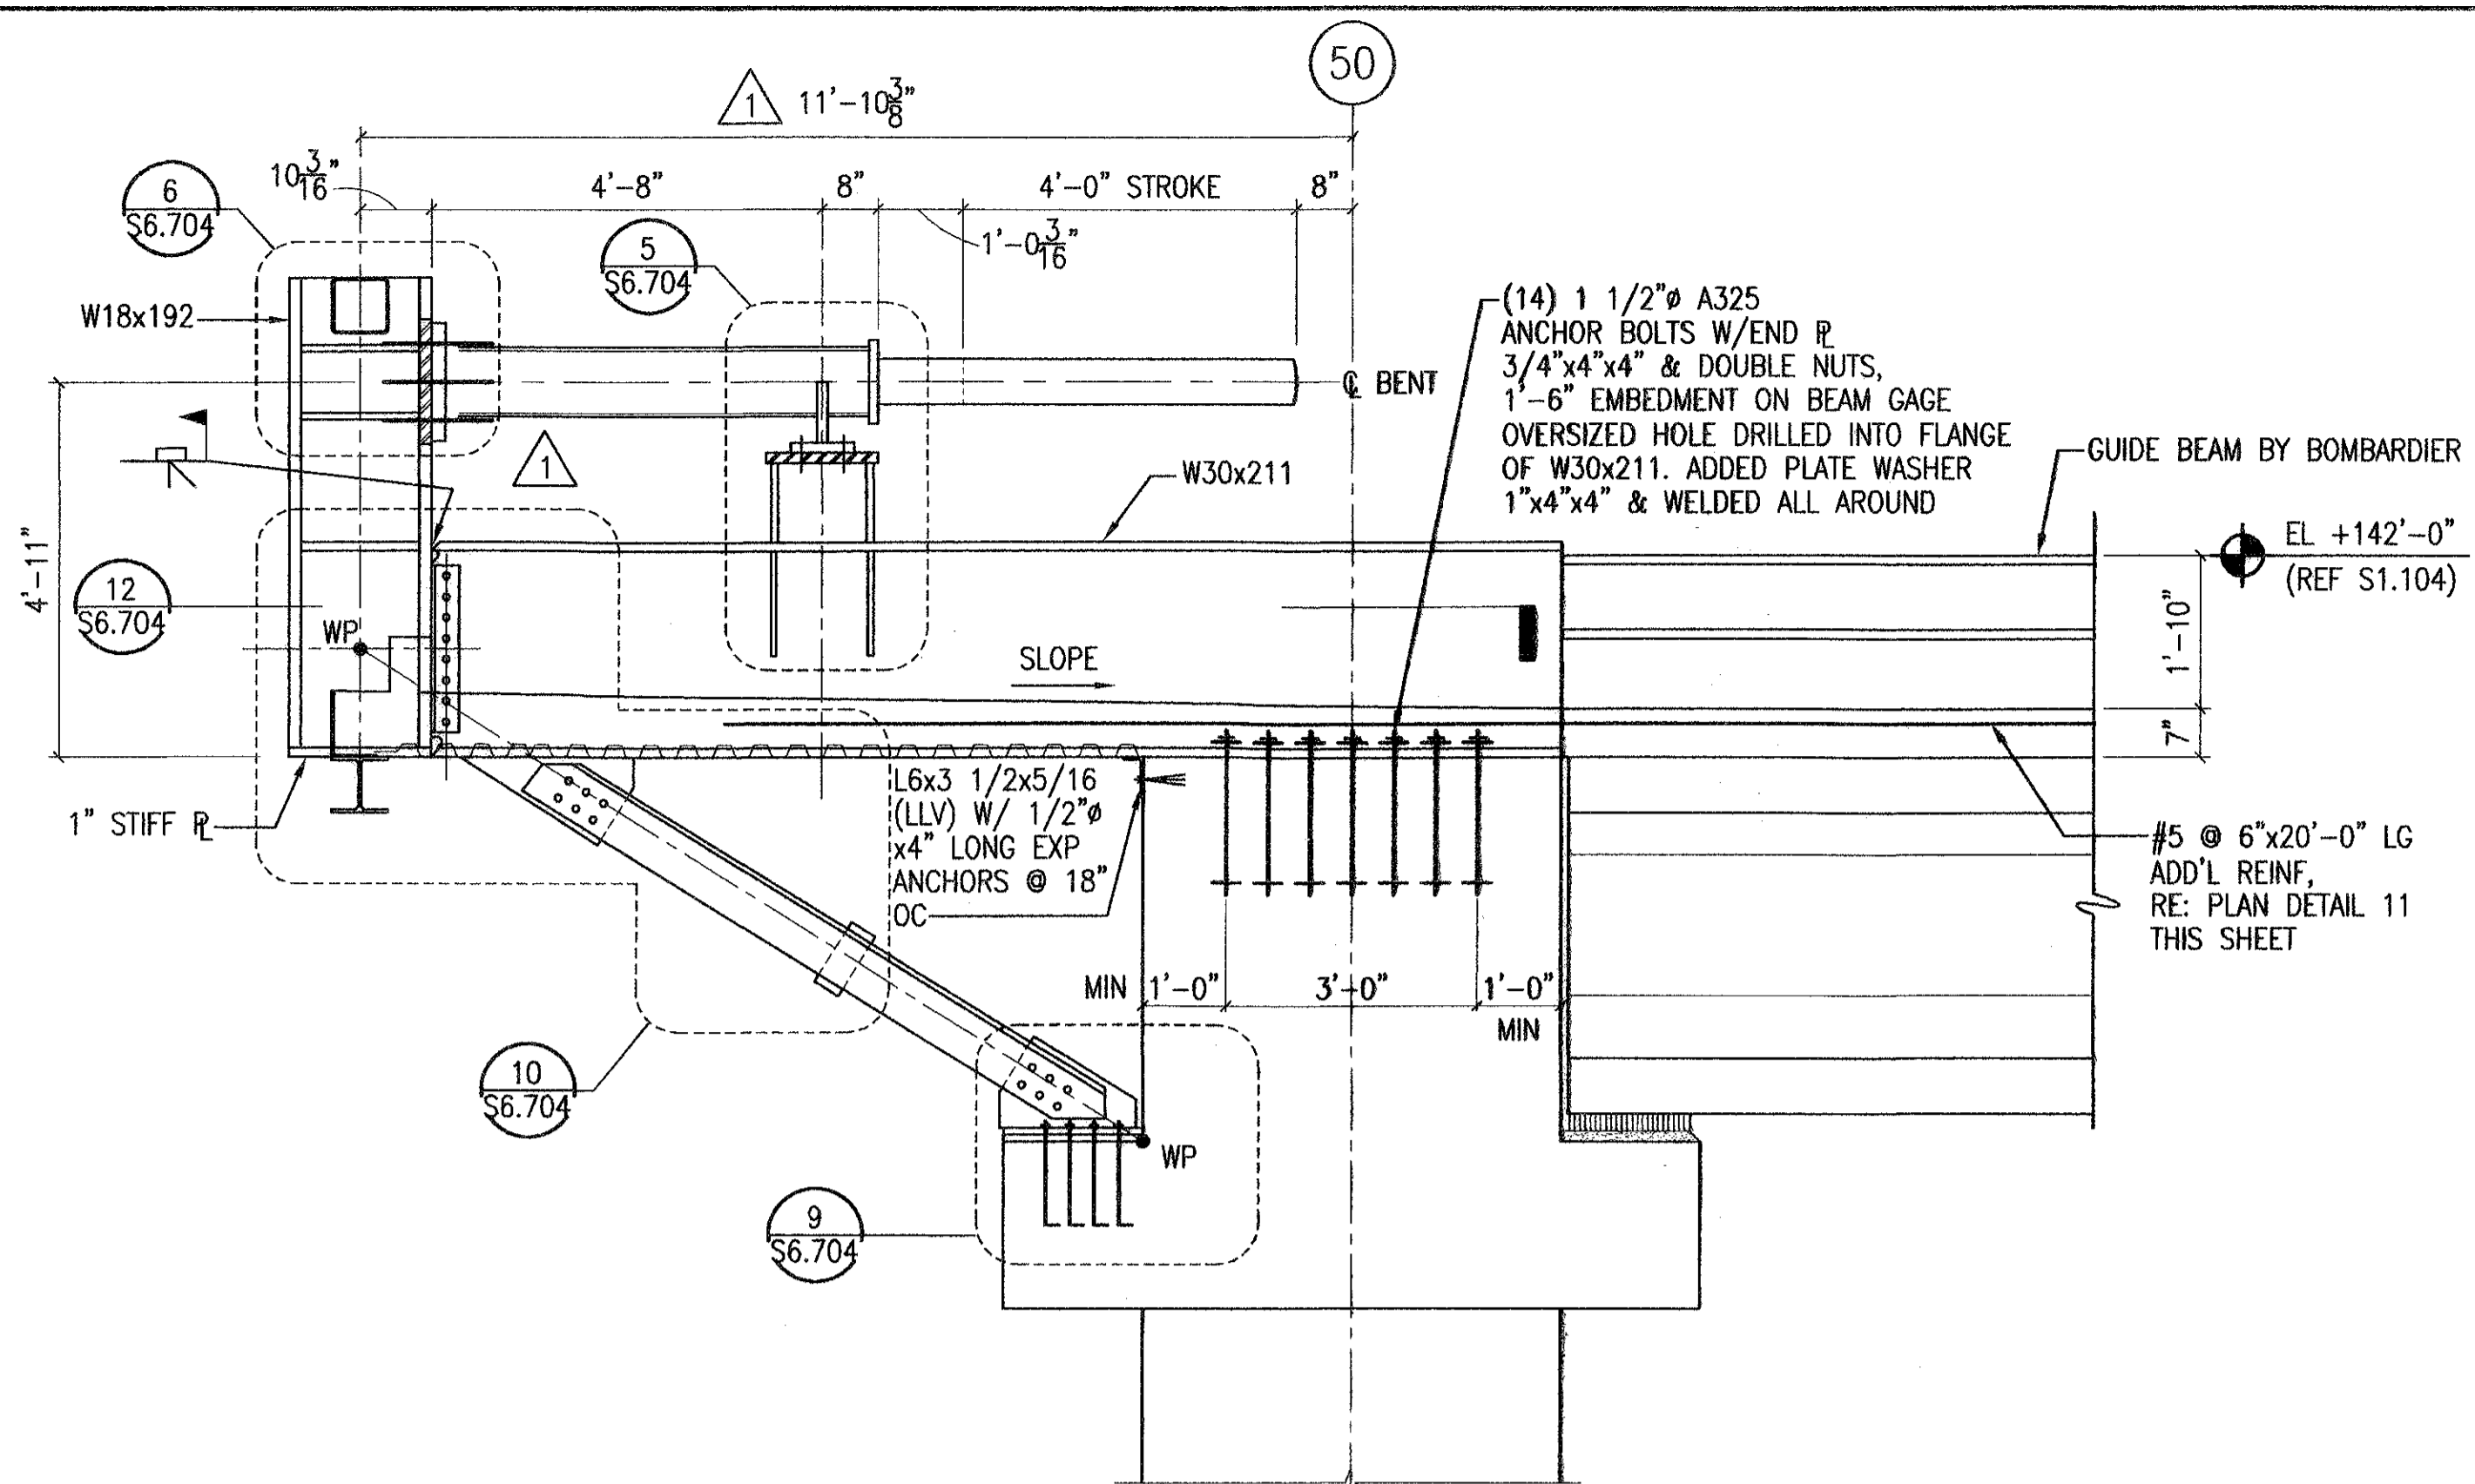


**5 SECTION**  
S3.002, S3.004 1/2" = 1'-0"

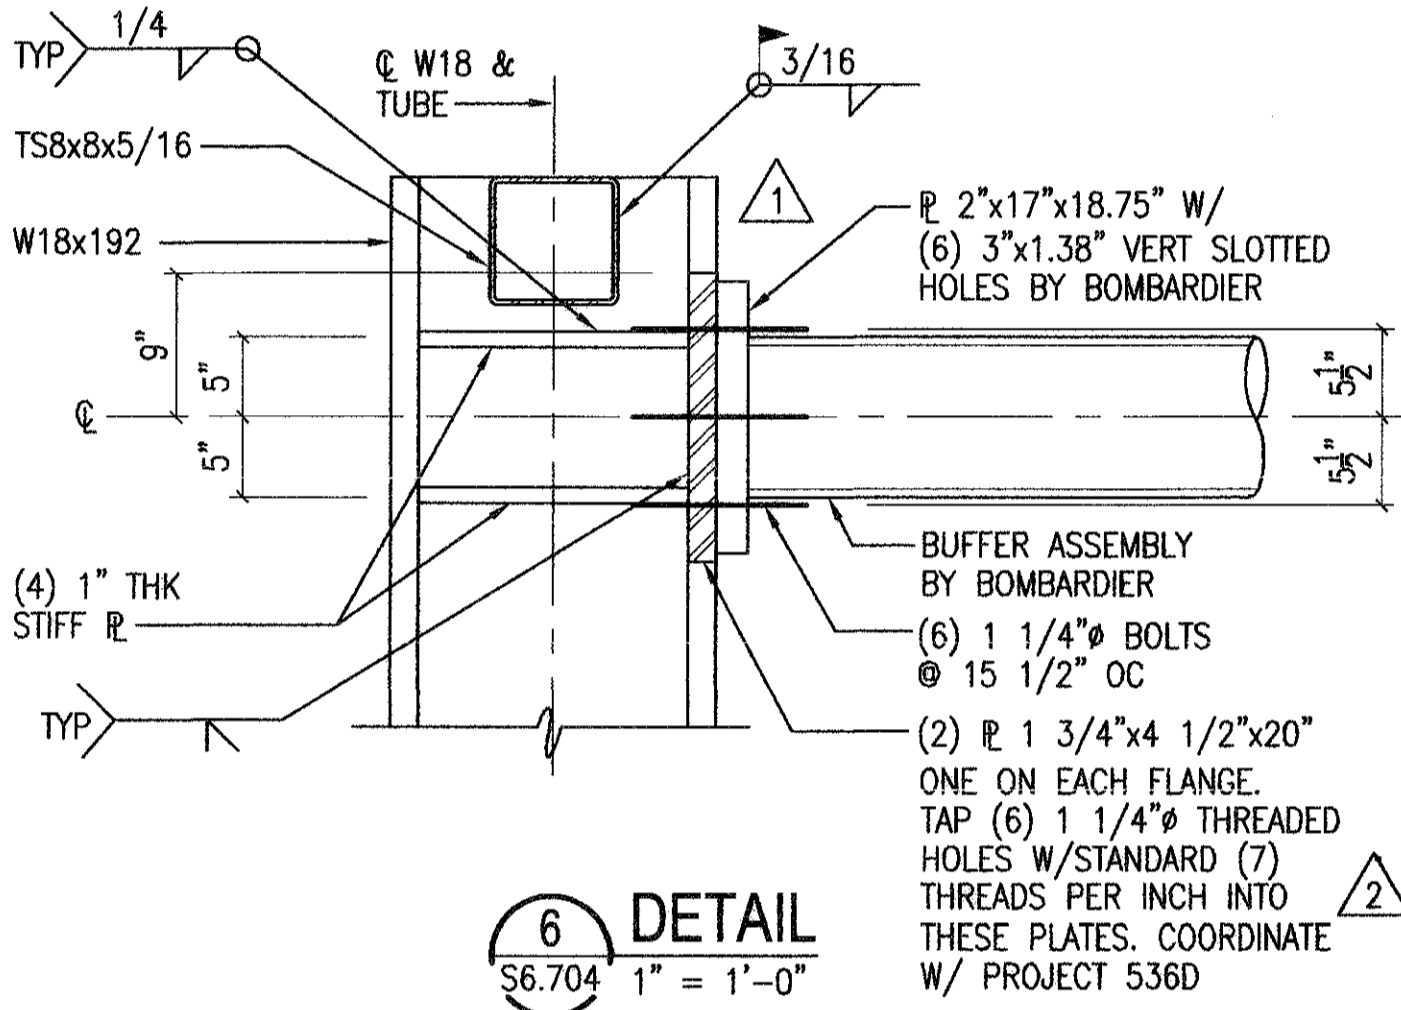


**6 DETAIL**  
S6.704 1" = 1'-0"

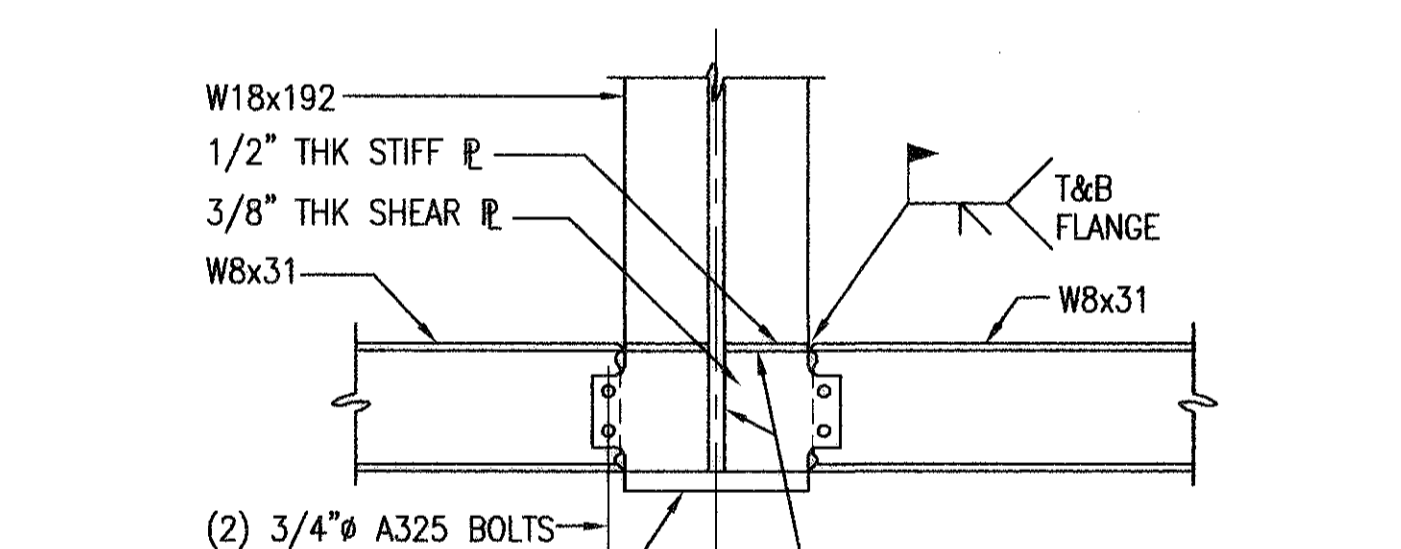


**6A SECTION**  
S6.704 1" = 1'-0"

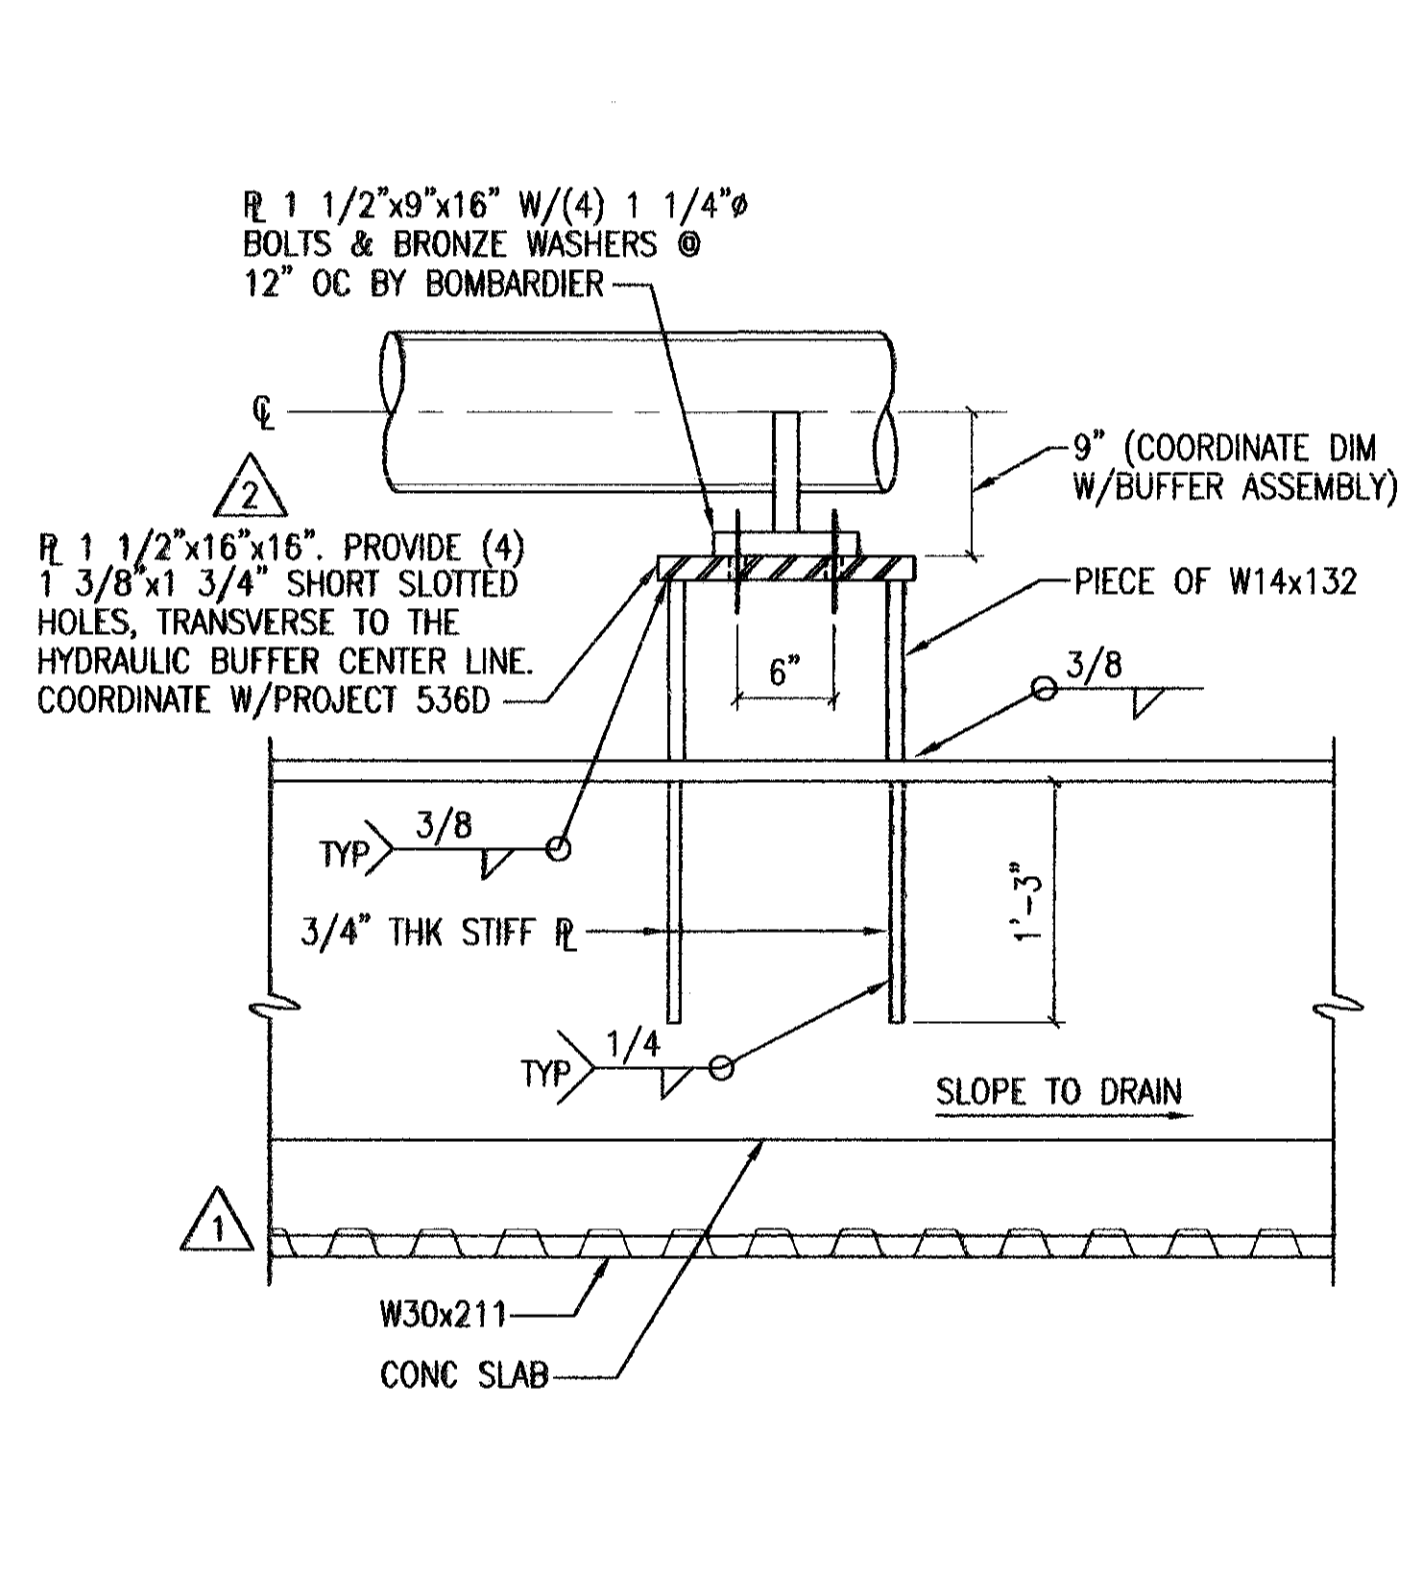


**5 DETAIL**  
S6.704 1" = 1'-0"

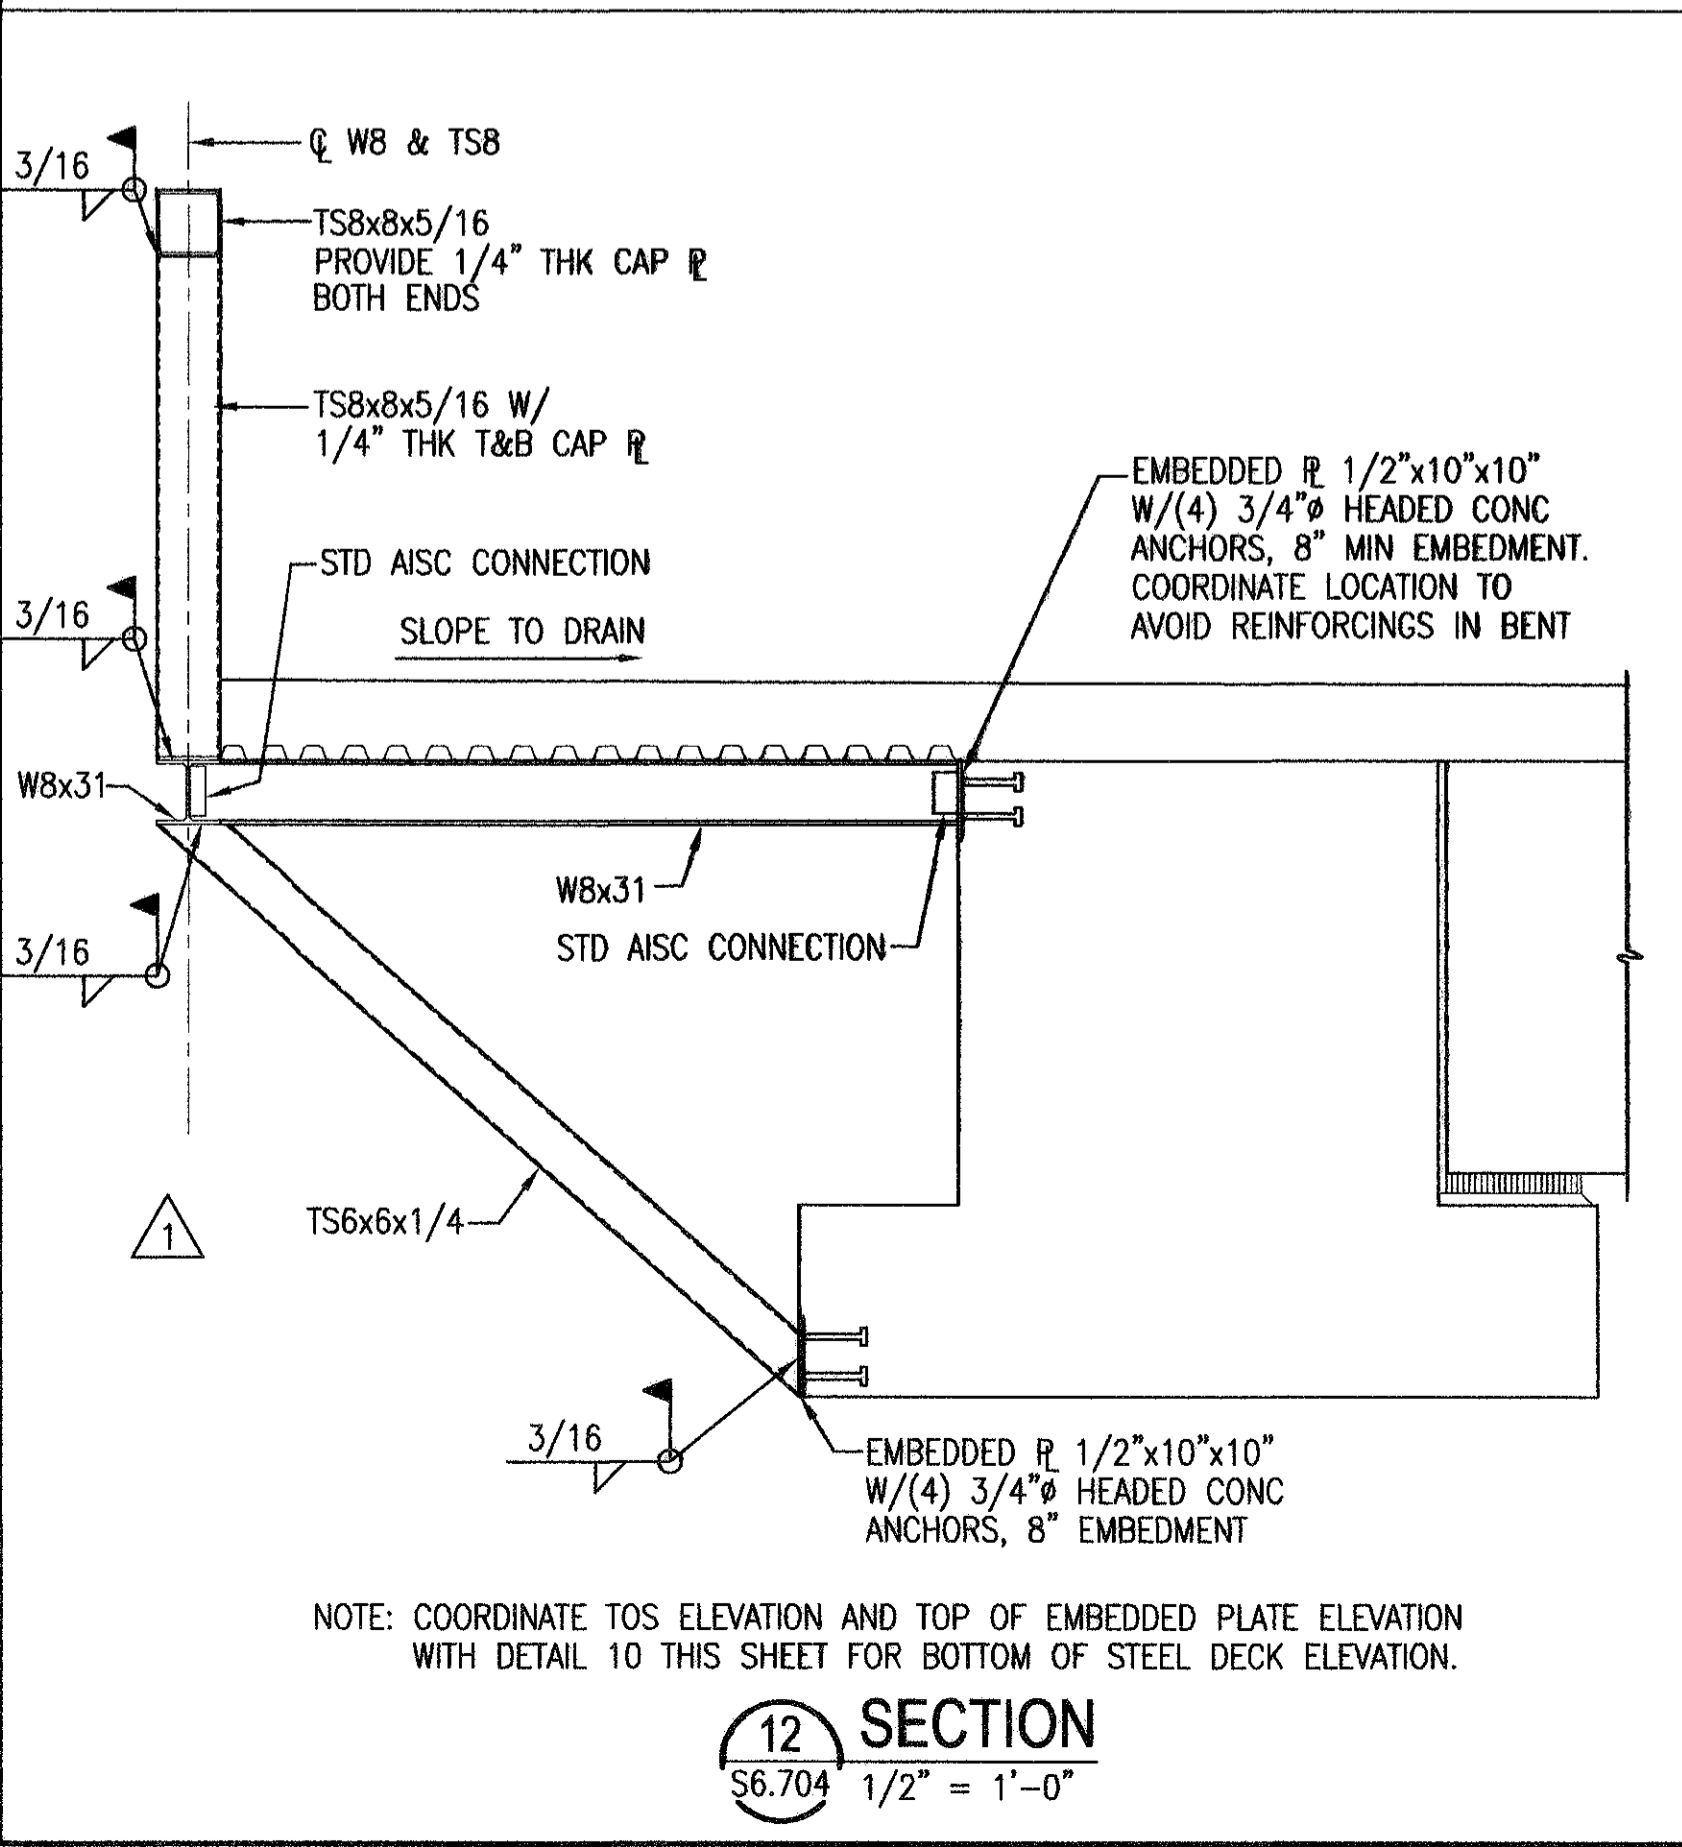


**12 SECTION**  
S6.704 1/2" = 1'-0"

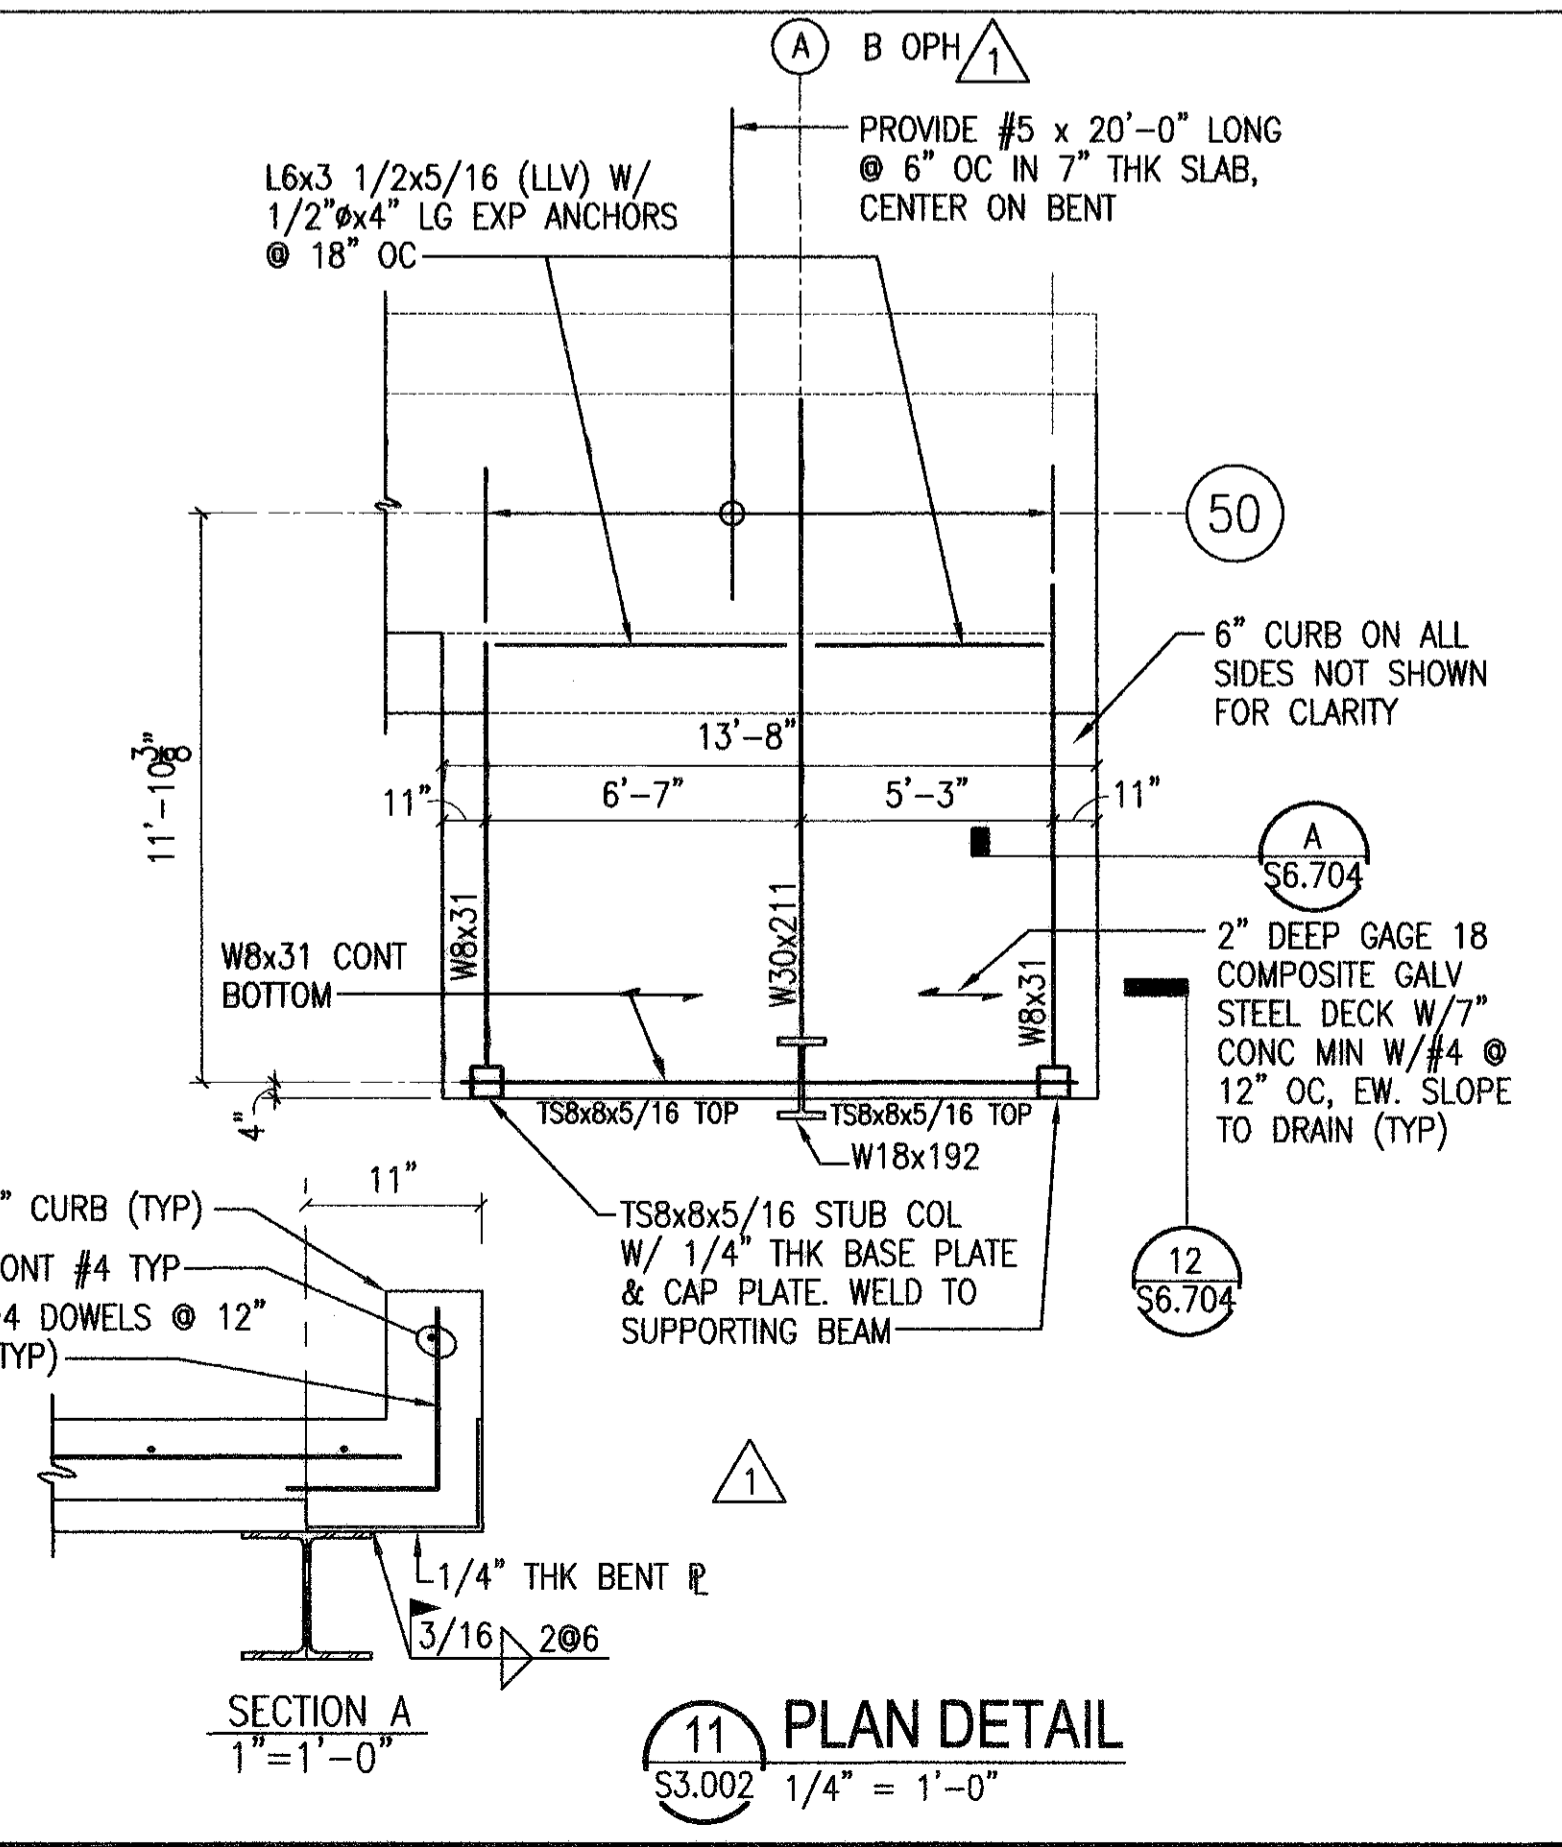

**11 PLAN DETAIL**  
S3.002 1/4" = 1'-0"

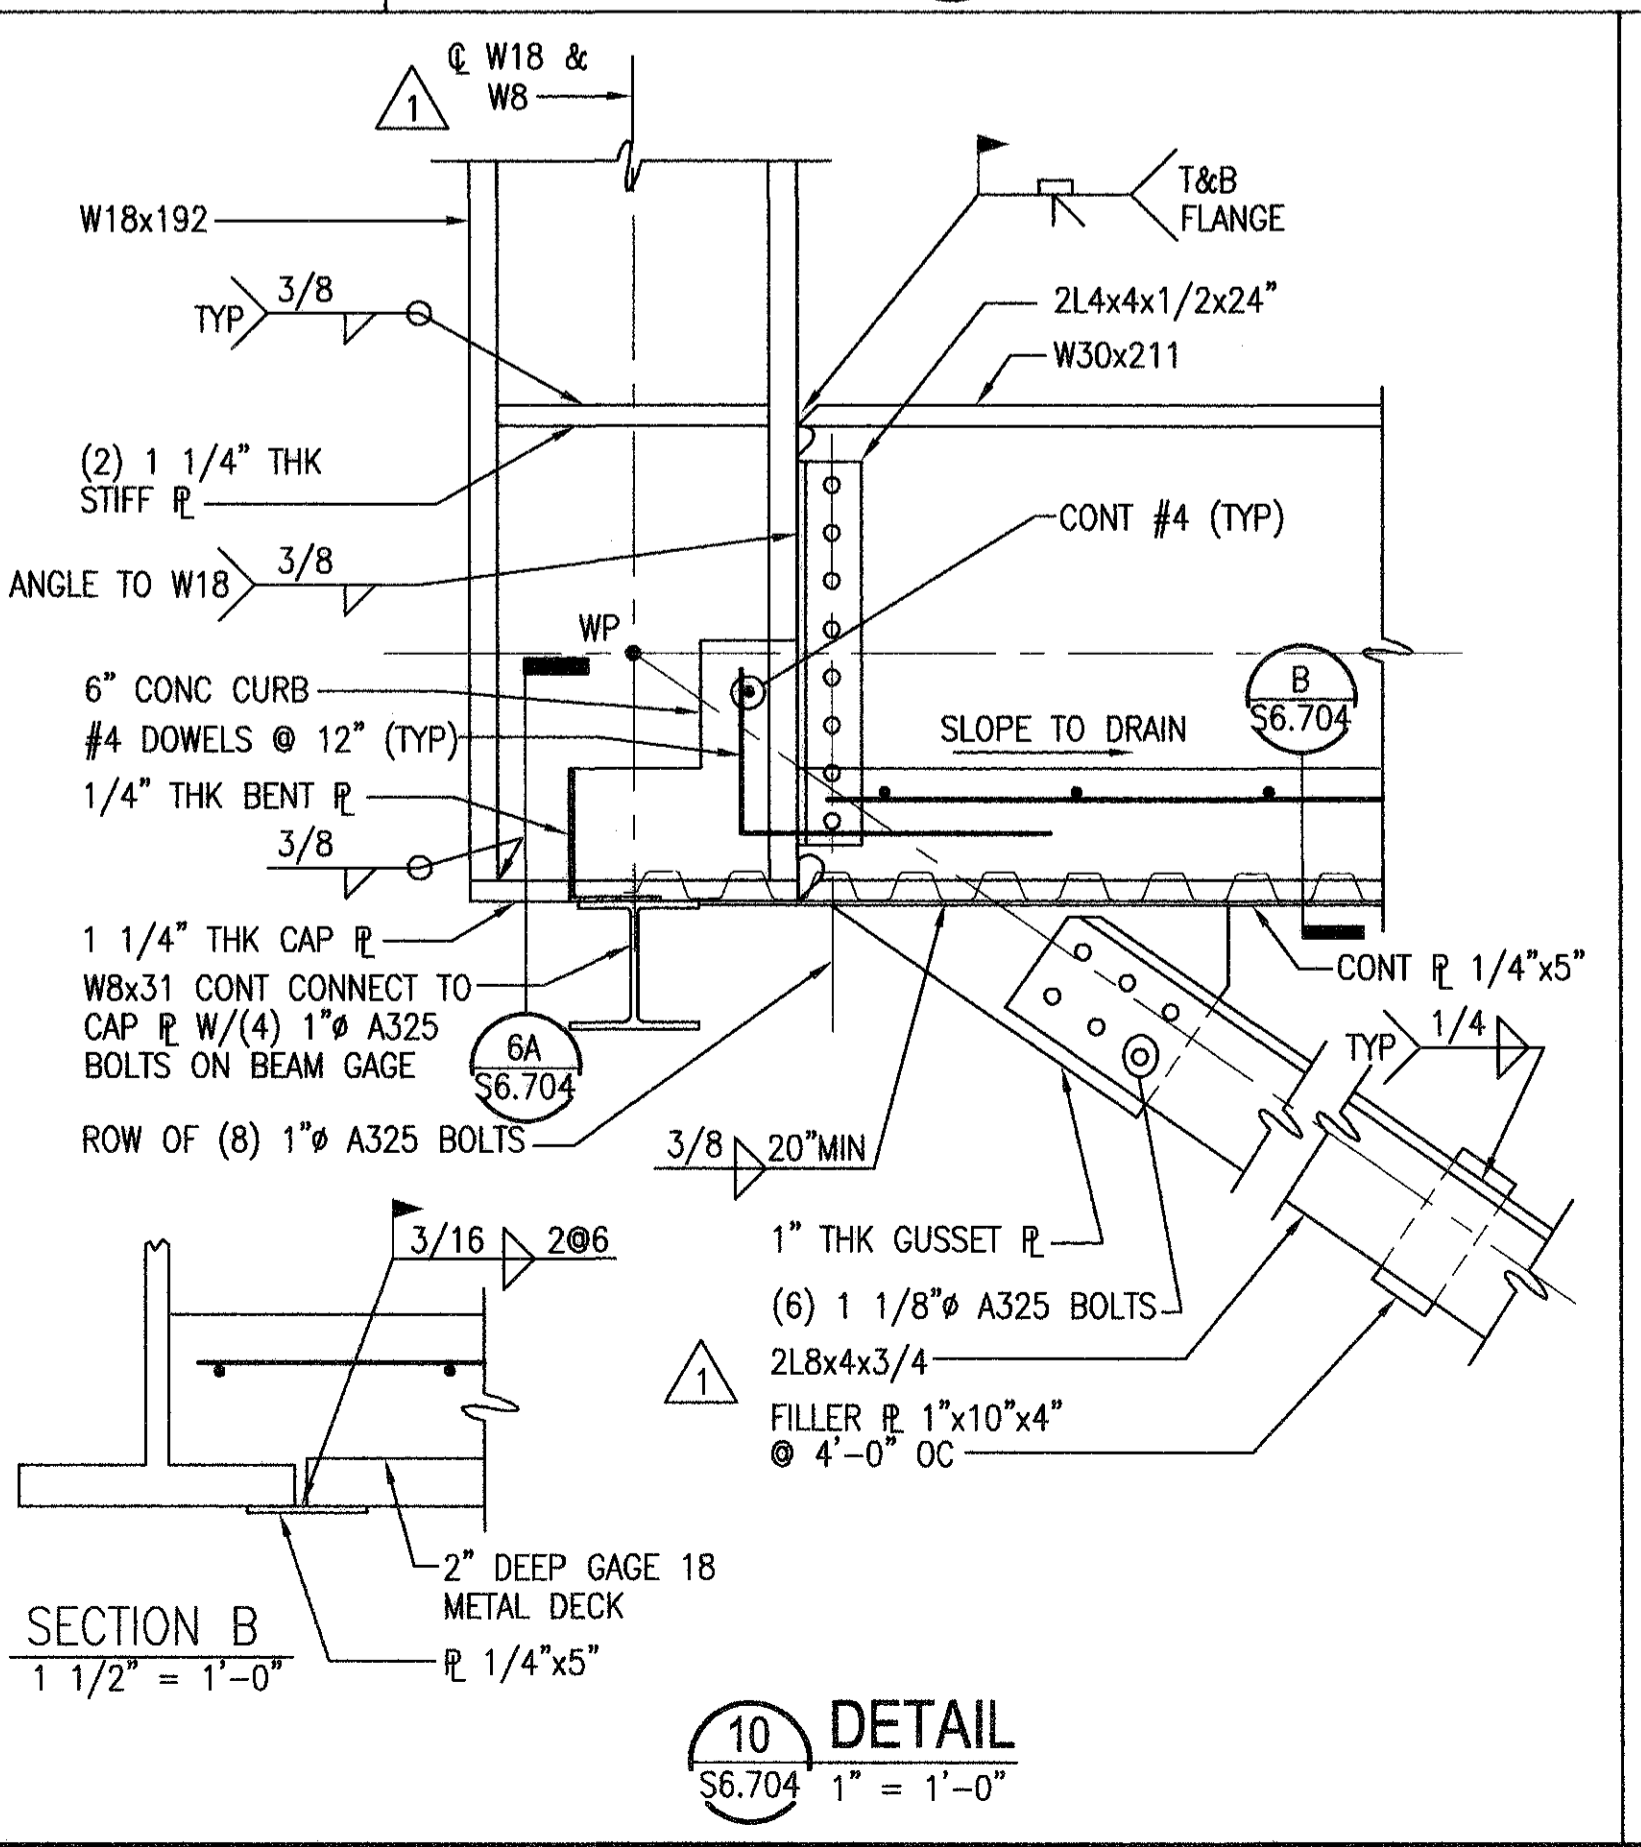

**10 DETAIL**  
S6.704 1" = 1'-0"

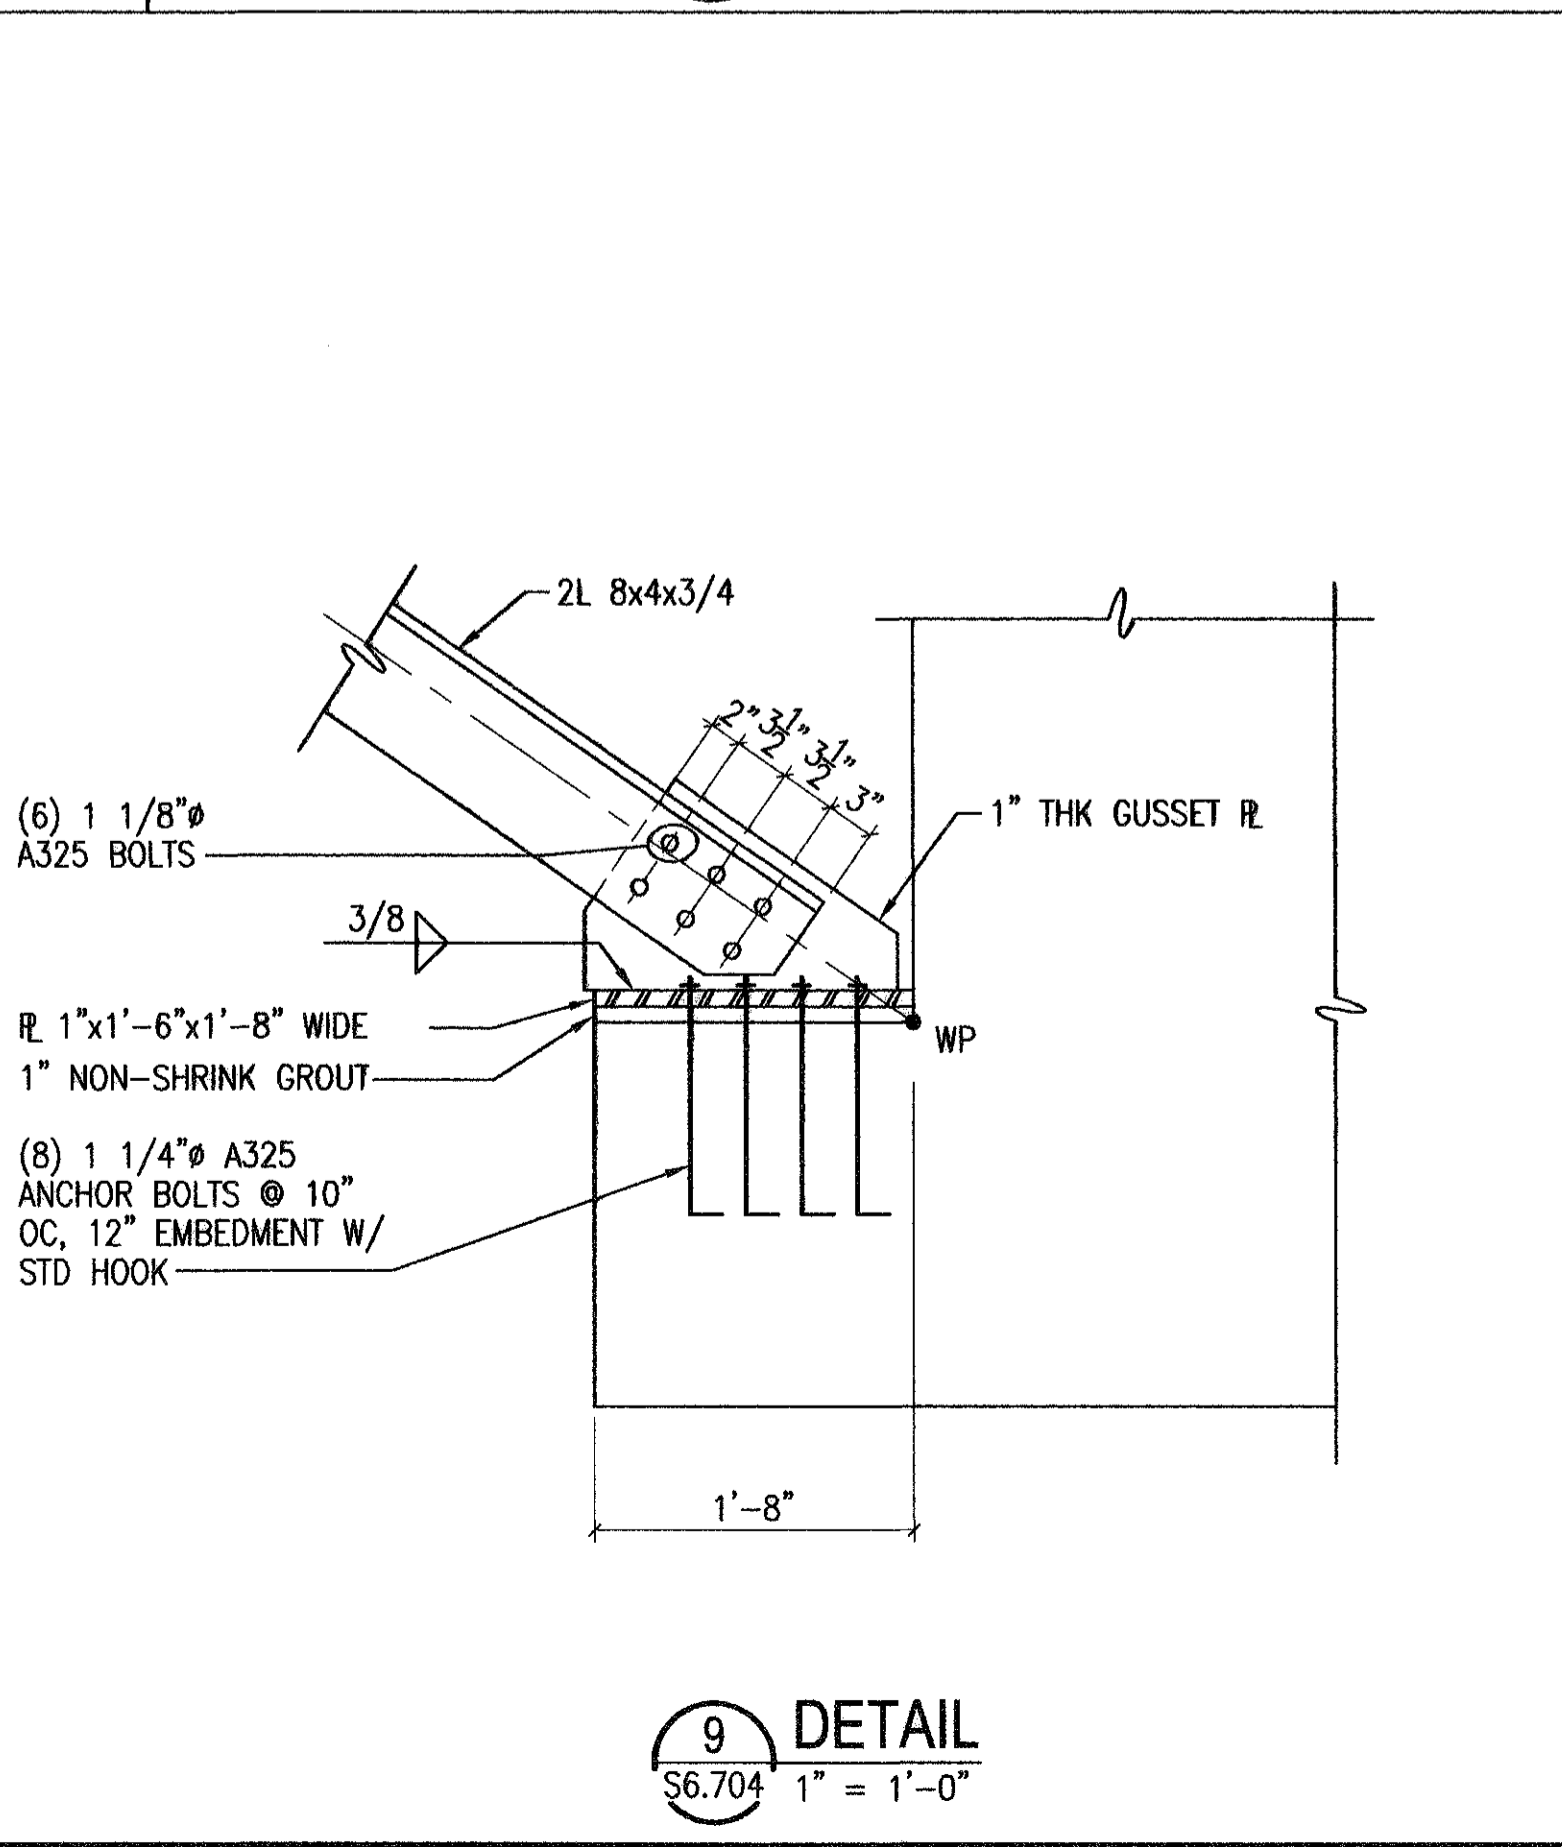

**9 DETAIL**  
S6.704 1" = 1'-0"

**NOTES TO SHEET**

- REFER TO SHEET S0.100 FOR STRUCTURAL GENERAL NOTES.
- REFER TO SHEET S0.201 FOR CONCRETE BEAM SCHEDULE.

**HOUSTON AIRPORT SYSTEM**  
GEORGE BUSH  
INTERCONTINENTAL AIRPORT  
HOUSTON TEXAS

**HUETT-ZOLLARS**  
1200 Dairy Rd., Houston, TX 77077  
Phone (281) 488-0066 Fax (281) 488-0225

**CHARLES F. TERRY, INC.**  
Consulting Engineers  
2801 Garden Avenue  
Dallas, Texas 75226  
Telephone: 714 250-0000

NO.	DESCRIPTION	DATE	BY
ISSUED FOR BID		10/19/01	
ADDENDUM #1		02/01/02	MR
REVISION #1		01/27/03	MR

INTERNATIONAL • SERVICES • EXPANSION • PROGRAM

**APM STATION & PLATFORM**  
SECTION ALONG BENT #50

NOTE: REFER TO GRAPHIC SCALE IF ACTUAL SHEET SIZE IS OTHER THAN 30"x42".

0' 1' 2' 4' 6'

SCALE: 1/2" = 1'-0"

NOTE: REFER TO GRAPHIC SCALE IF ACTUAL SHEET SIZE IS OTHER THAN 30"x42".

0' 2' 4' 8' 12'

SCALE: 1/4" = 1'-0"

NOTE: REFER TO GRAPHIC SCALE IF ACTUAL SHEET SIZE IS OTHER THAN 30"x42".

0' 1' 2'

SCALE: 1" = 1'-0"

**RECORD DRAWINGS DO NOT MODIFY**

DATE: MAY 6, 2005

HUETT-ZOLLARS, INC.

THESE DOCUMENTS WERE DEVELOPED TO DEVELOP RECORD OF THE WORK DRAWINGS PREPARED BY THE CONSTRUCTION CONTRACTOR, CLARK/MISSION A JOINT VENTURE. THE INFORMATION PROVIDED BY THE CONTRACTOR WAS NOT VERIFIED BY THE DESIGN FIRM NAMED ABOVE.

PROJECT MGR: GRW  
DESIGNER: JUC  
DRAWN BY: KLV  
CHECKED BY: MMR  
DRAWING STANDARD: SEP 07.20.2000  
SCALE: AS NOTED  
DATE: 09/14/01

FOR RECORD DRAWING ONLY

STATE OF TEXAS  
MORAN MICHAEL REITHAN  
82654


APPROVED BY: DATE:  
DIRECTOR  
HOUSTON AIRPORT SYSTEM

PROJECT NO. 02-2025-01  
C.I.P. NO. A-0354  
H.A.S. NO. 539C  
SHEET NO.


**S6.704**




PLOT DATE: 10/19/01 HAS FILE: IA536C57.DWG

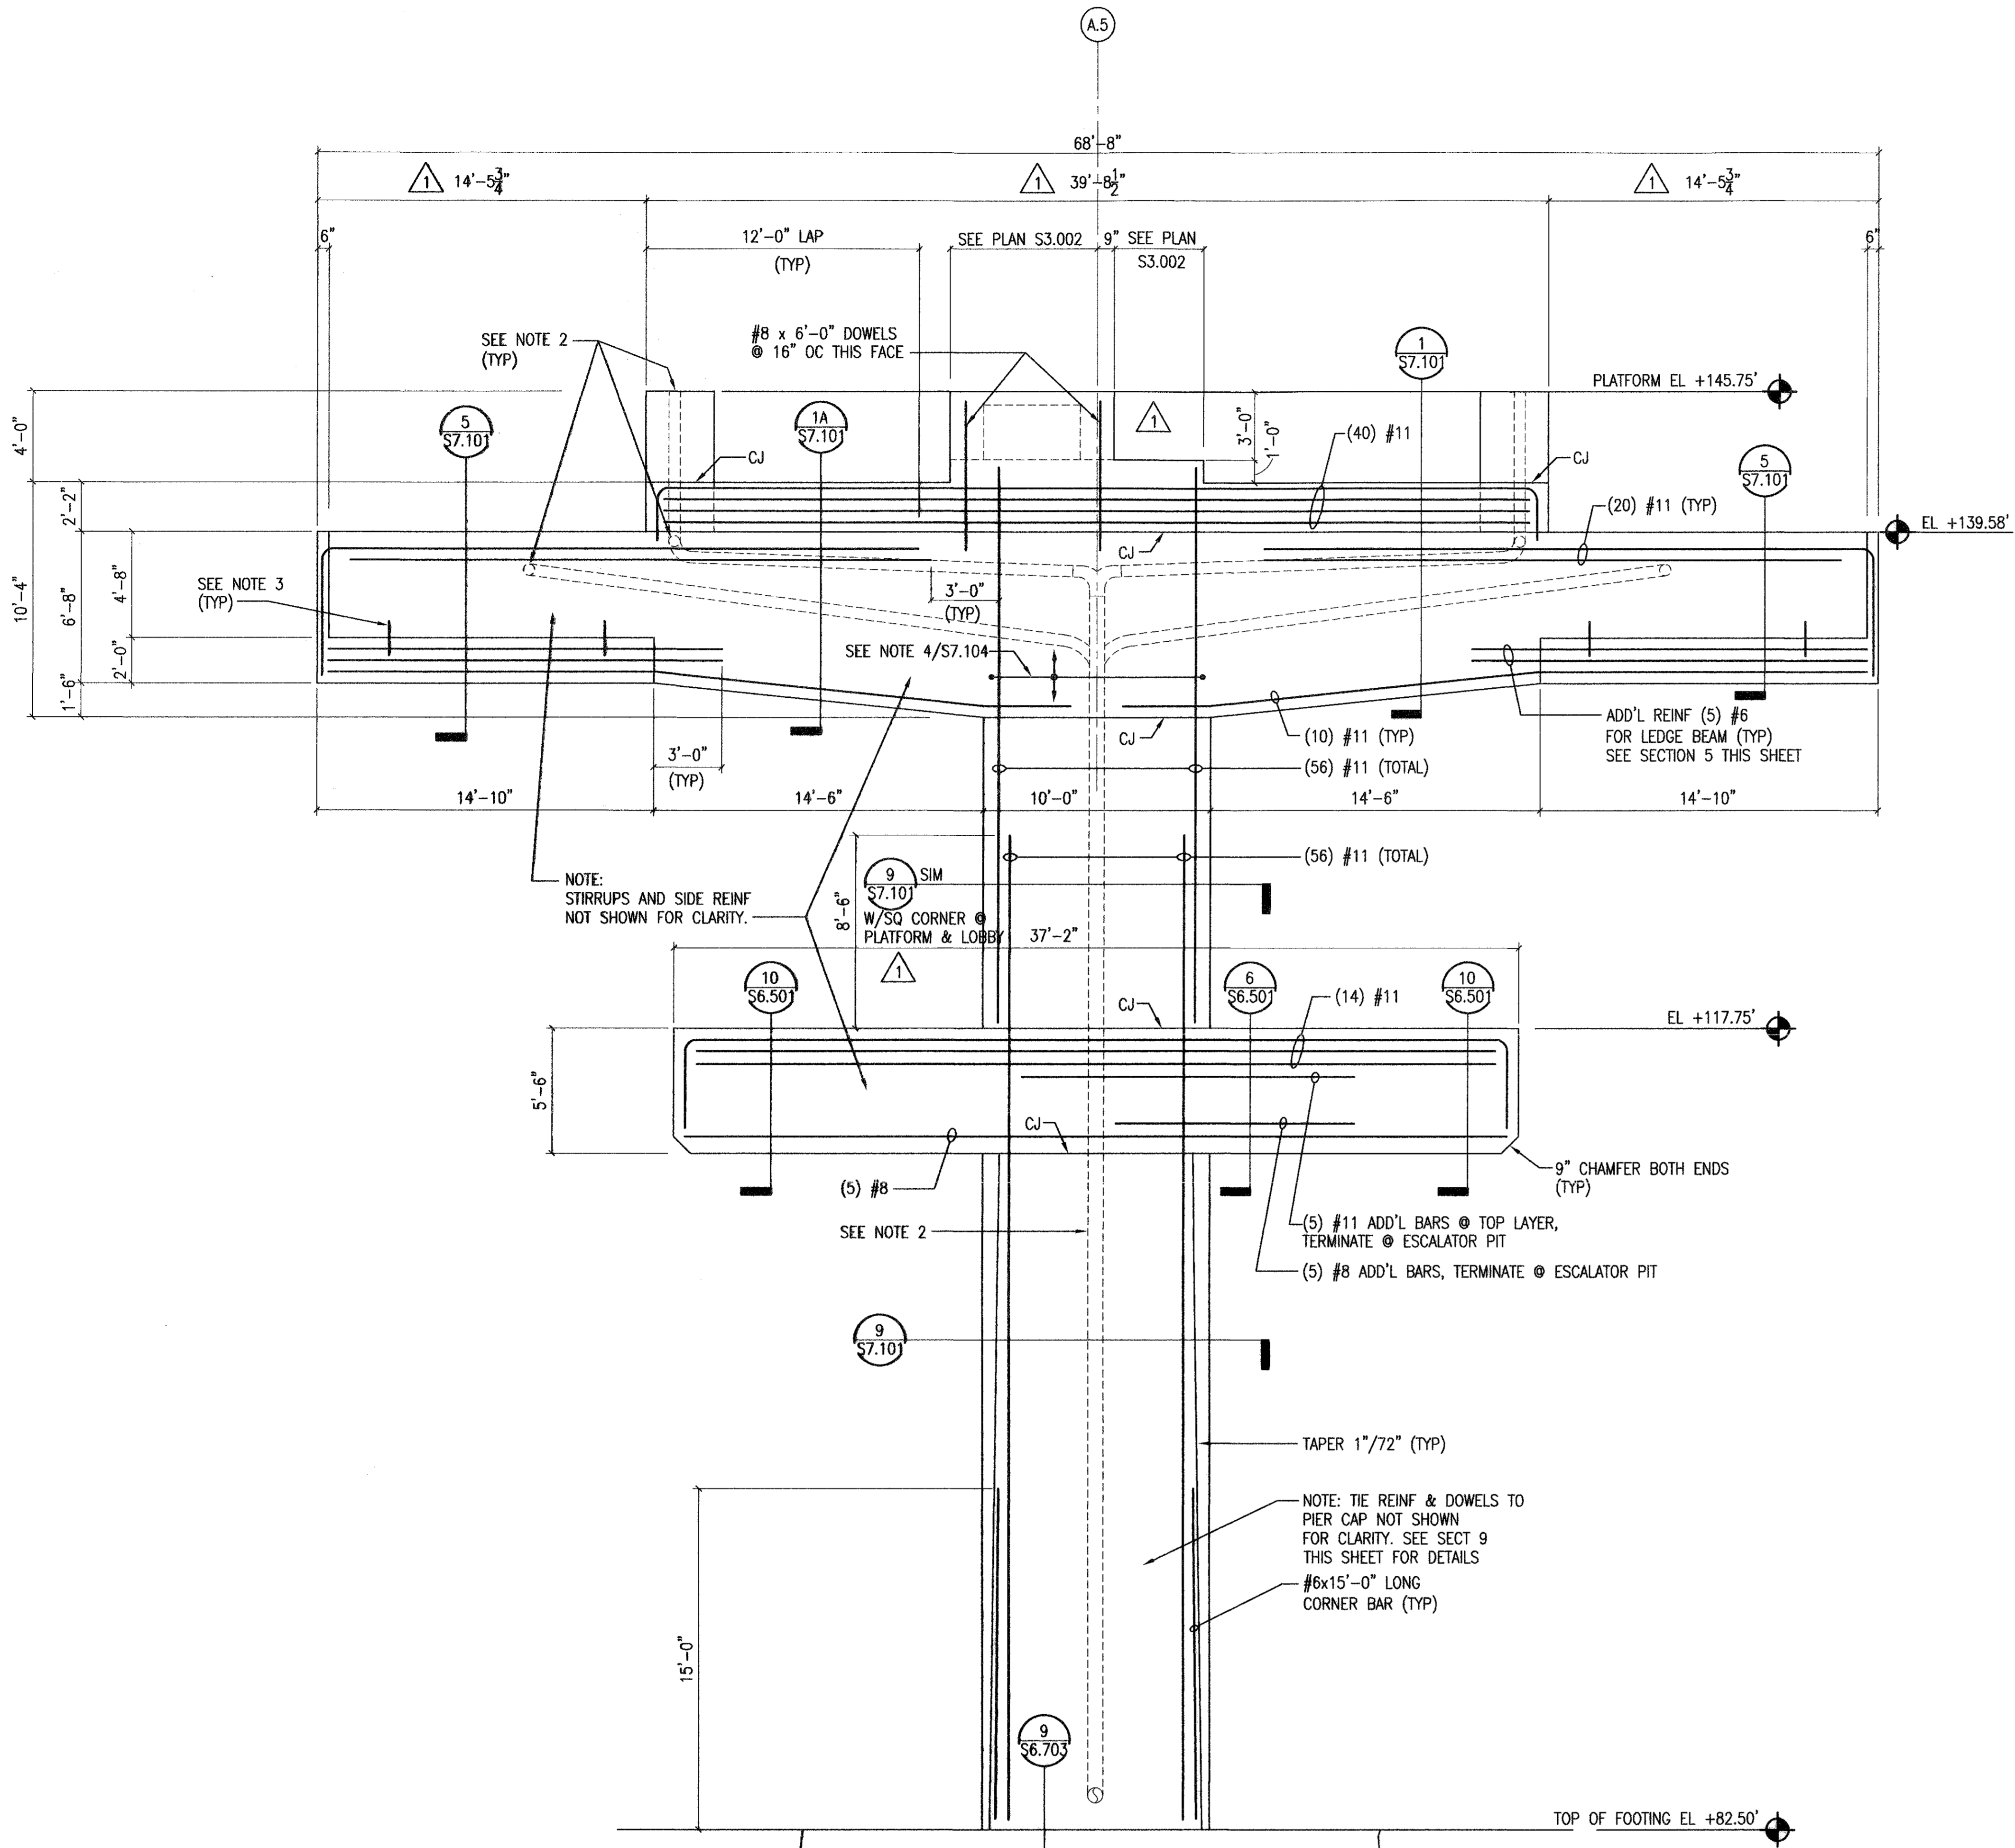


12 BENT FRAME #47 ELEVATION  
S3.002 1/4" = 1'-0"

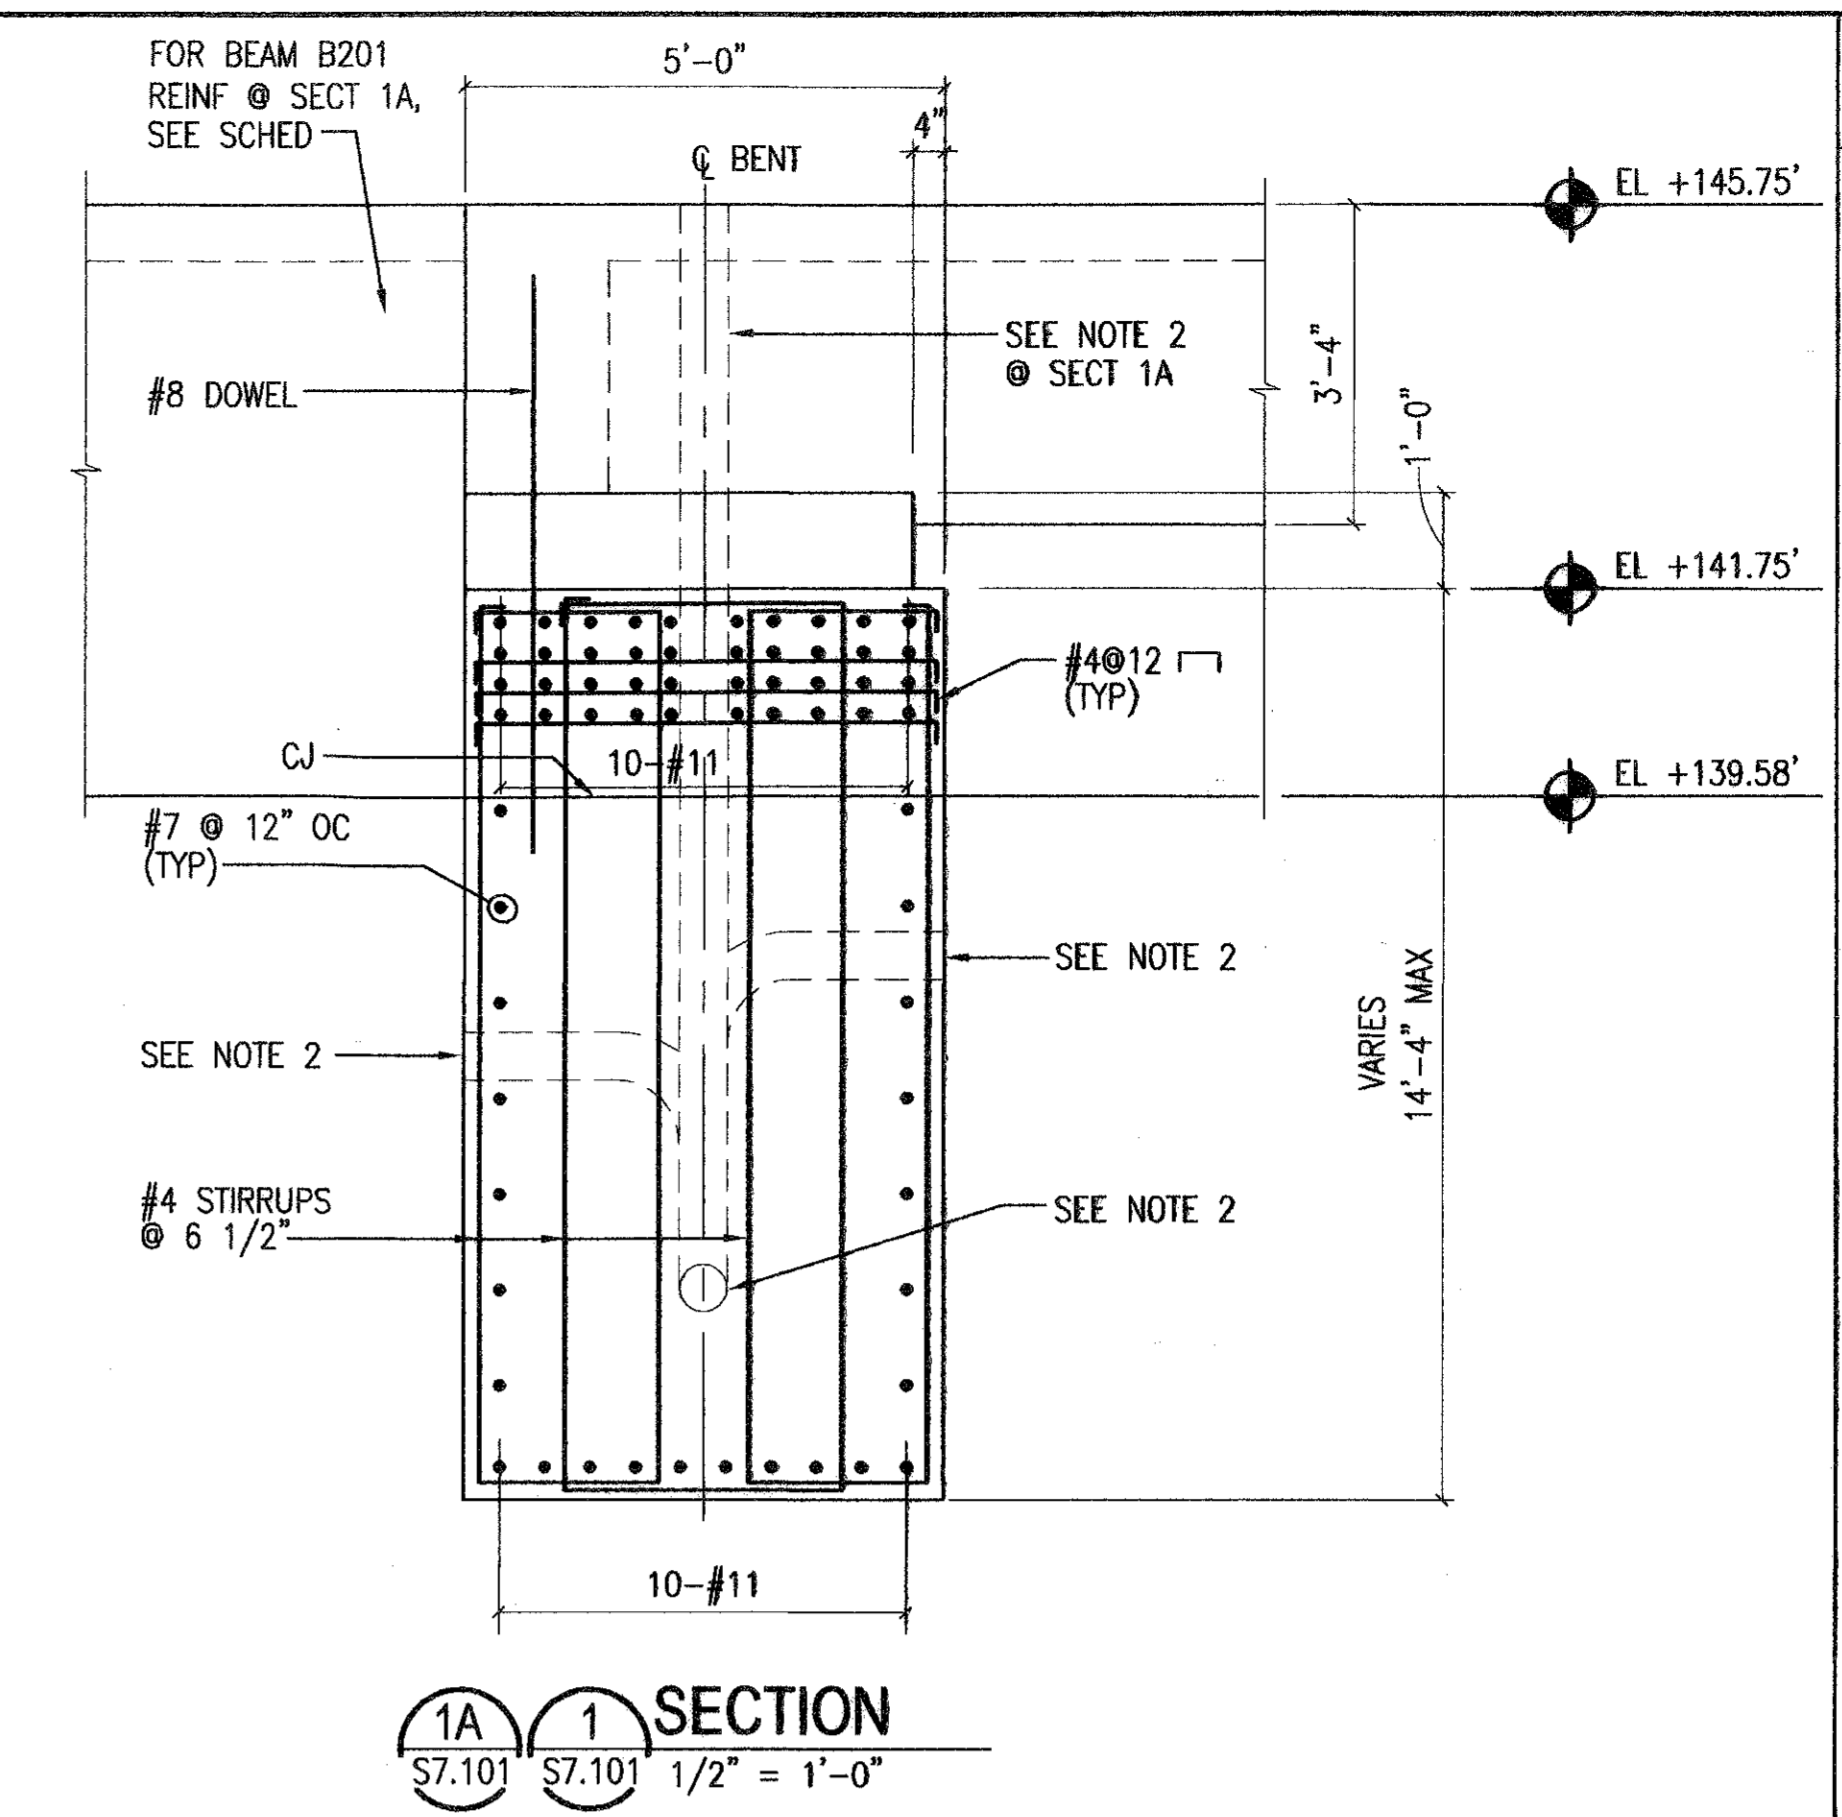

SECTION 1A  
SECTION 1  
57.101 1/2" = 1'-0"

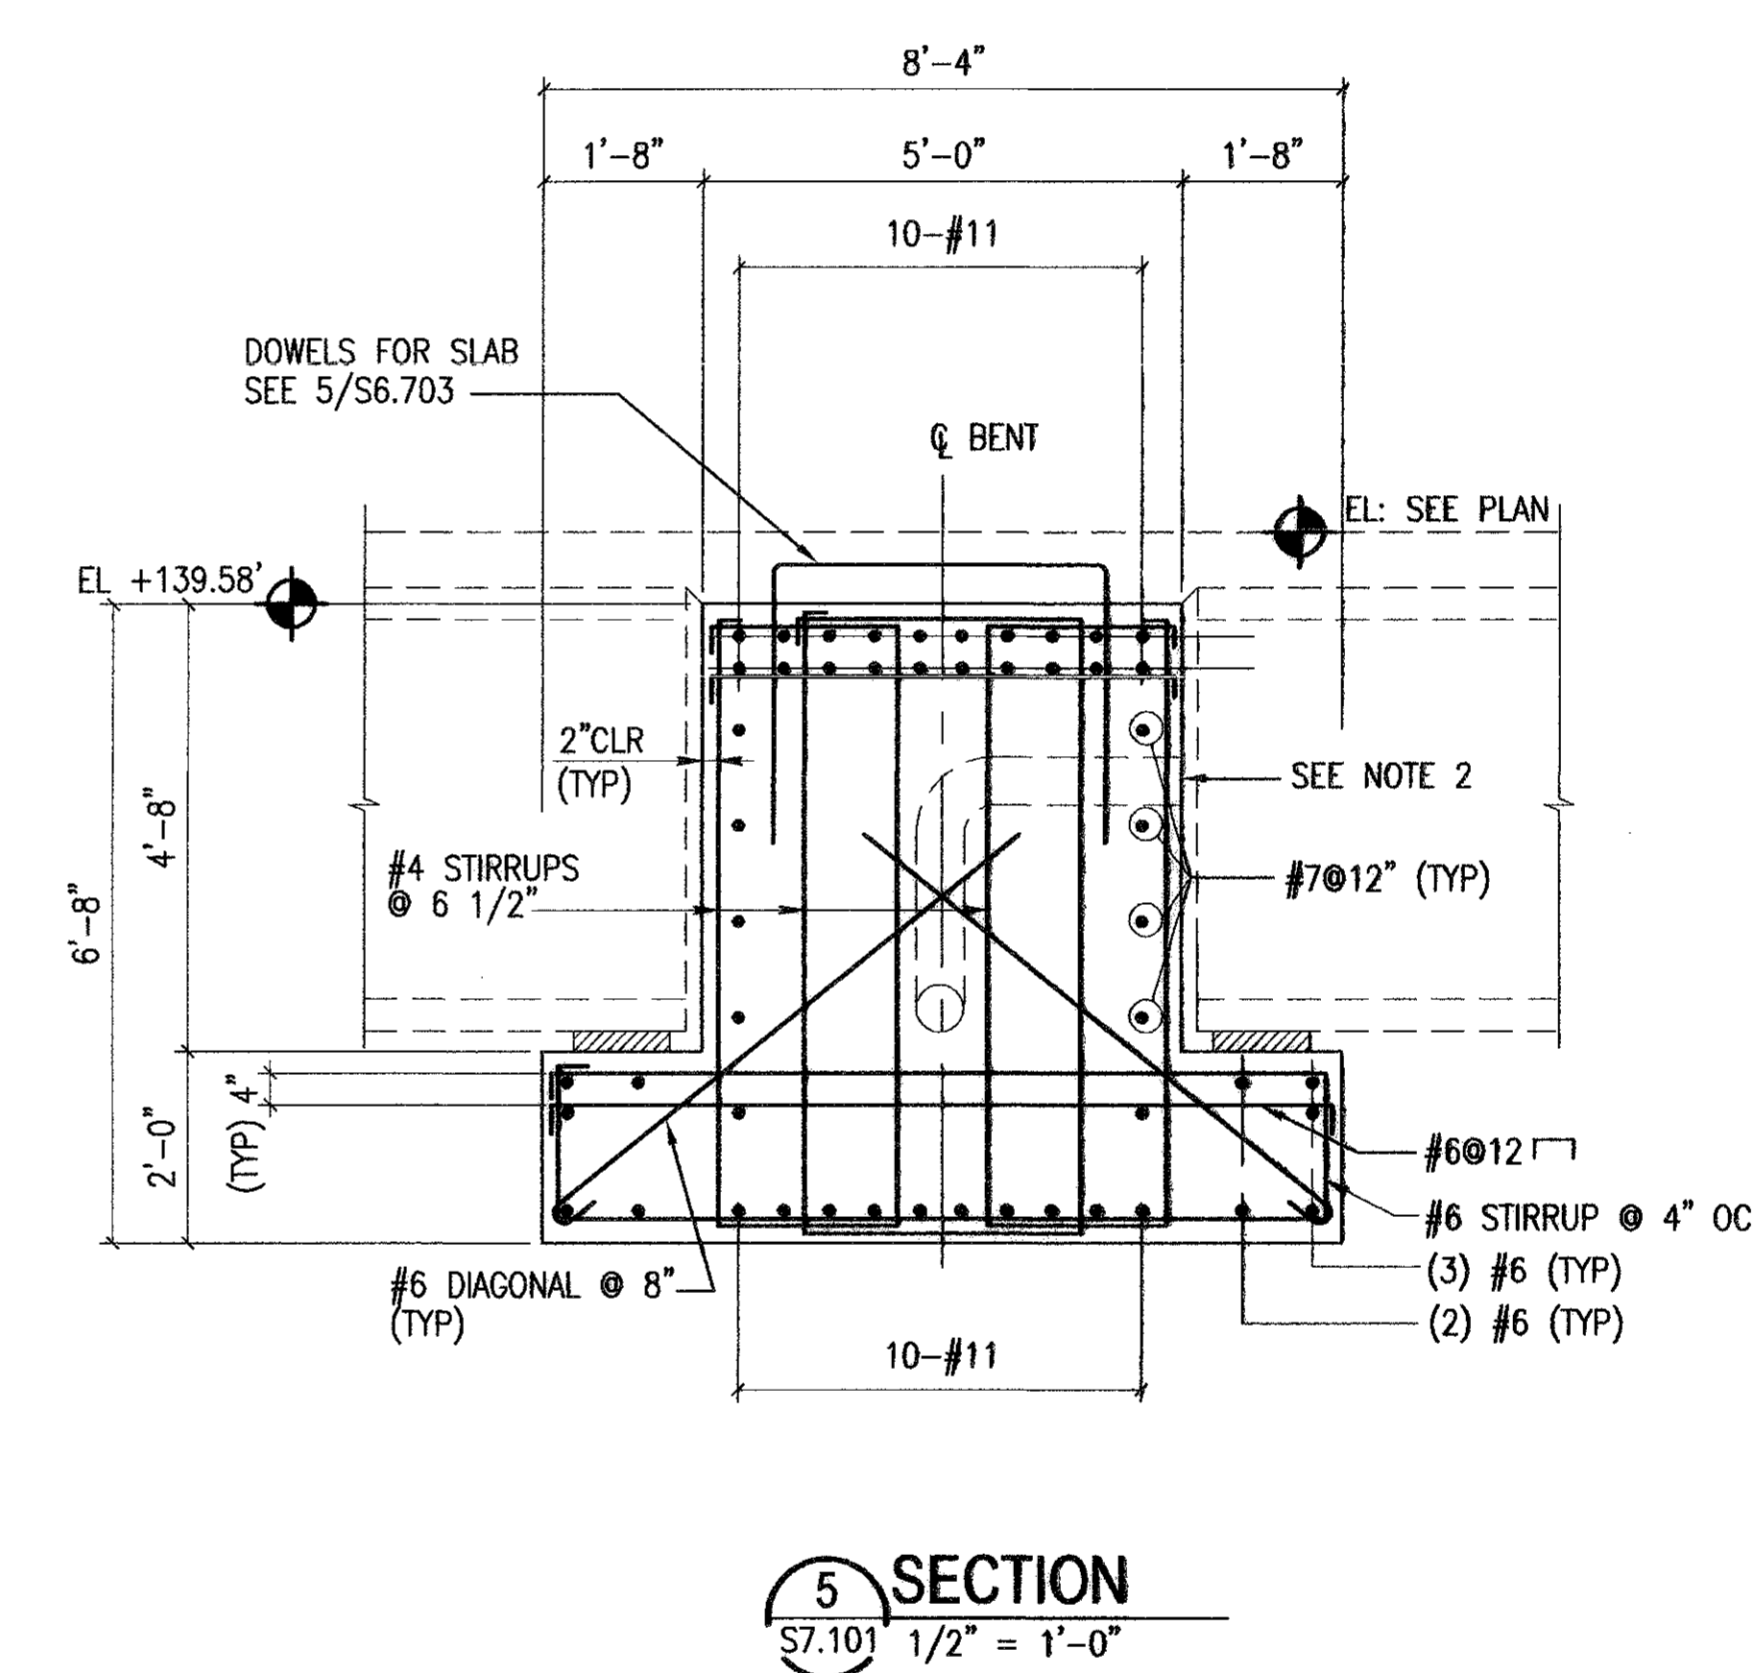

SECTION 5  
57.101 1/2" = 1'-0"

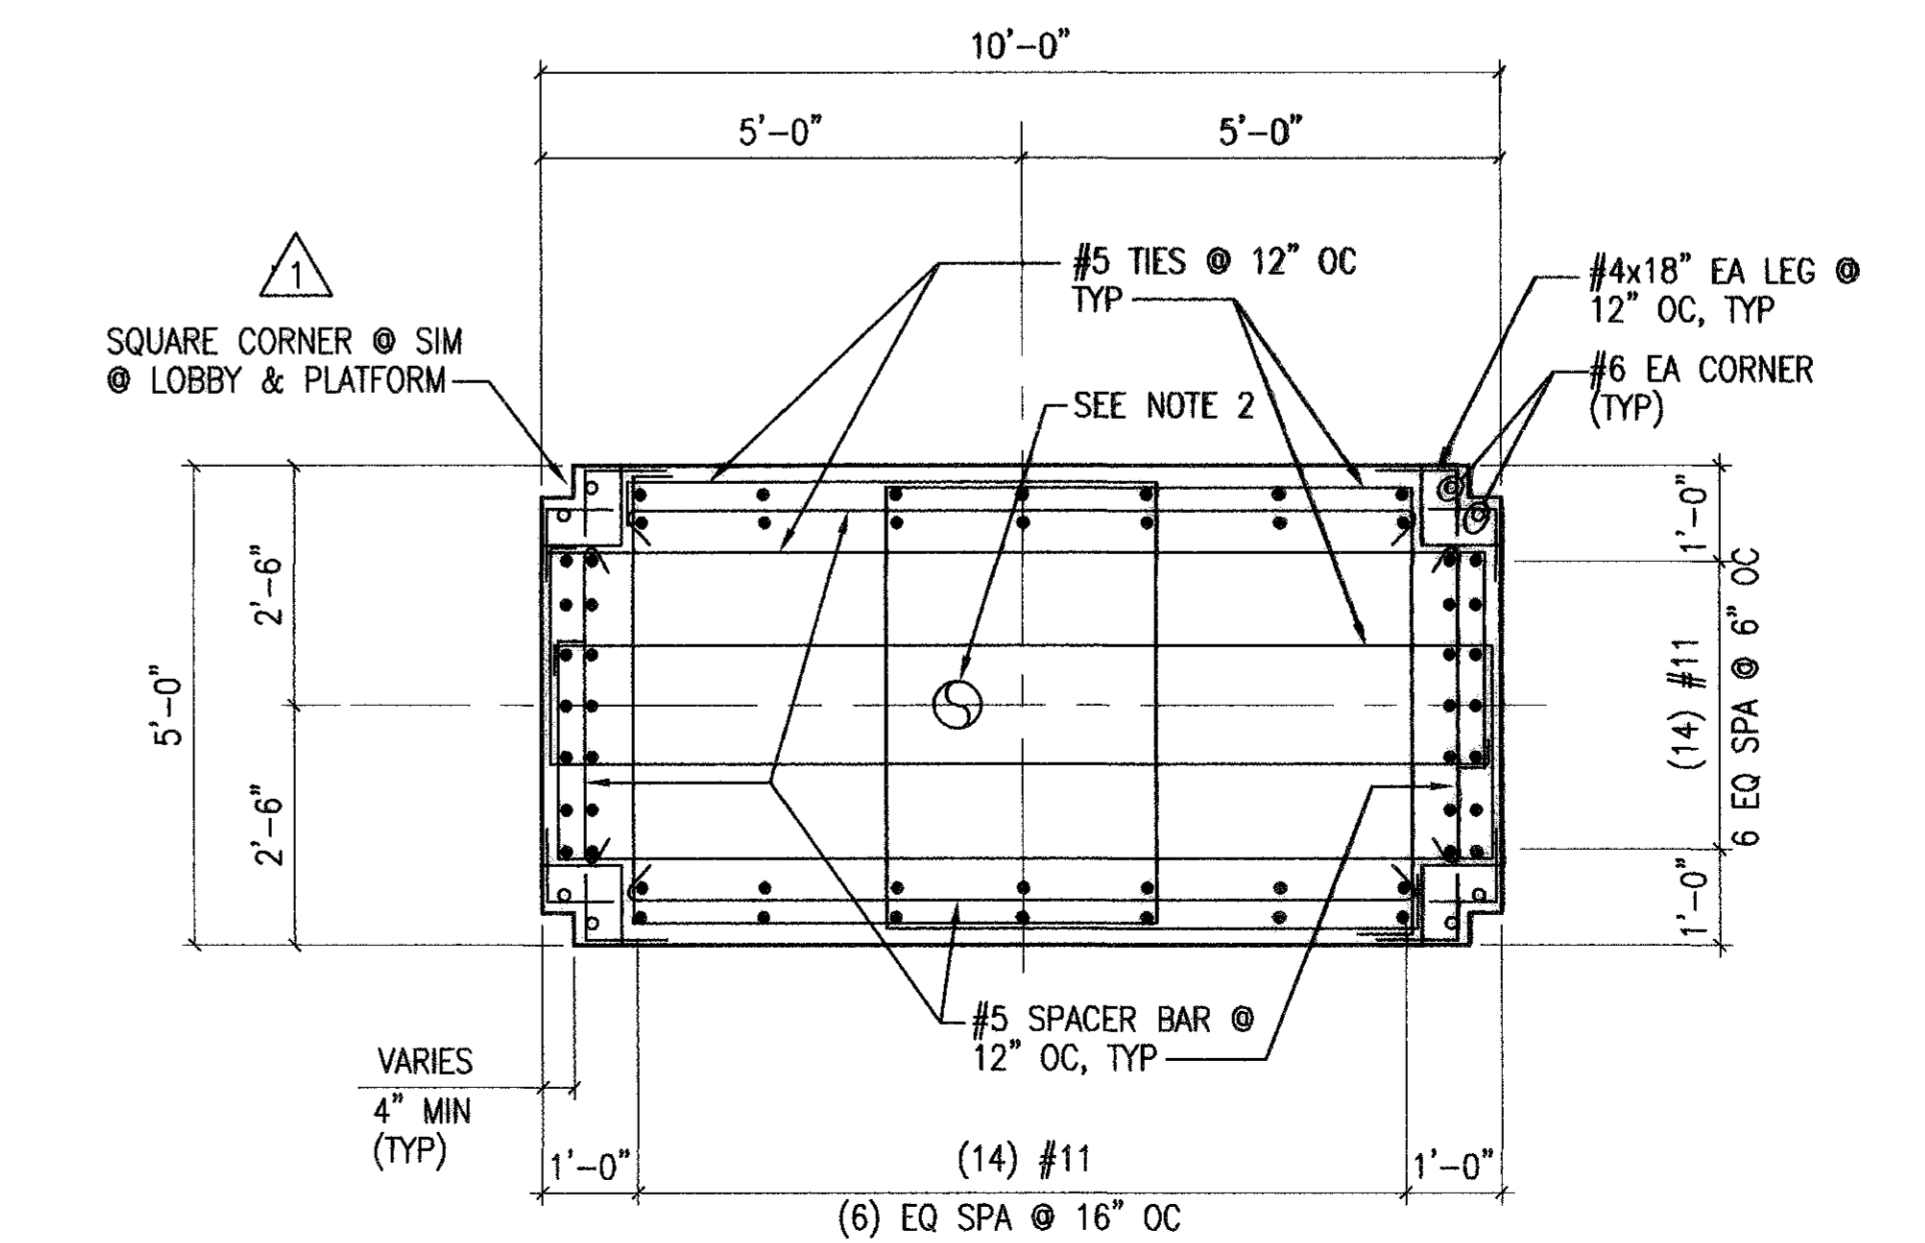

SECTION 9  
57.101 1/2" = 1'-0"

NOTES TO SHEET

- REFER TO SHEET S0.100 FOR STRUCTURAL GENERAL NOTES.
- COORDINATE PVC PIPE SIZE, NUMBER, LOCATION AND INVERT. ELEVATION WITH PLUMBING DWGS.
- PROVIDE 1 1/4"x1'-6" LONG SMOOTH DOWEL WITH 7" PROJECTION.

**HOUSTON AIRPORT SYSTEM**  
GEORGE BUSH  
INTERCONTINENTAL AIRPORT  
HOUSTON TEXAS

**HUTT-ZOLLARS**  
Engineering / Architecture  
1500 West Loop South, Suite 200, Houston, TX 77027  
Phone (281) 498-2068 Fax (281) 498-2250

**CHARLES F. VERNY, INC.**  
Consulting Engineers  
1001 West Loop South, Suite 200, Houston, TX 77027  
Phone (281) 498-2068 Fax (281) 498-2250

NO.	DESCRIPTION	DATE	BY
ISSUED FOR BID		10/19/01	
ADDENDUM #1		02/01/02	MR

INTERNATIONAL SERVICES EXPANSION PROGRAM

**APM STATION & PLATFORM**  
BENT FRAME #47 ELEVATION

PROJECT MGR: GRW  
DESIGNER: JUC  
DRAWN BY: KLV  
CHECKED BY: MMR  
DRAWING STANDARD: IEP 07.20.2000  
SCALE: AS NOTED  
DATE: 09/14/01

NOTE: REFER TO GRAPHIC SCALE IF ACTUAL SHEET SIZE IS OTHER THAN 30"x42".

SCALE: 1/2" = 1'-0"

NOTE: REFER TO GRAPHIC SCALE IF ACTUAL SHEET SIZE IS OTHER THAN 30"x42".

SCALE: 1/4" = 1'-0"

FOR RECORD DRAWING ONLY

STATE OF TEXAS  
MOEN MICHAEL REHMAN  
33454  
REGISTERED PROFESSIONAL ENGINEER

**RECORD DRAWINGS DO NOT MODIFY**

DATE: MAY 6, 2005

HUTT-ZOLLARS, INC.

NOTE: INFORMATION USED TO DEVELOP THESE DOCUMENTS WAS TAKEN FROM RECORD OF THE WORK DRAWINGS PREPARED BY THE CONSTRUCTION CONTRACTOR. CLARK/MISSION A JOINT VENTURE. THE INFORMATION PROVIDED BY THE CONTRACTOR WAS NOT VERIFIED BY THE DESIGN FIRM NAMED ABOVE.

APPROVED BY: DATE:

PROJECT NO. 02-2025-01

C.I.P. NO. A-0354


H.A.S. NO. 536C

SHEET NO. 93 S7.101









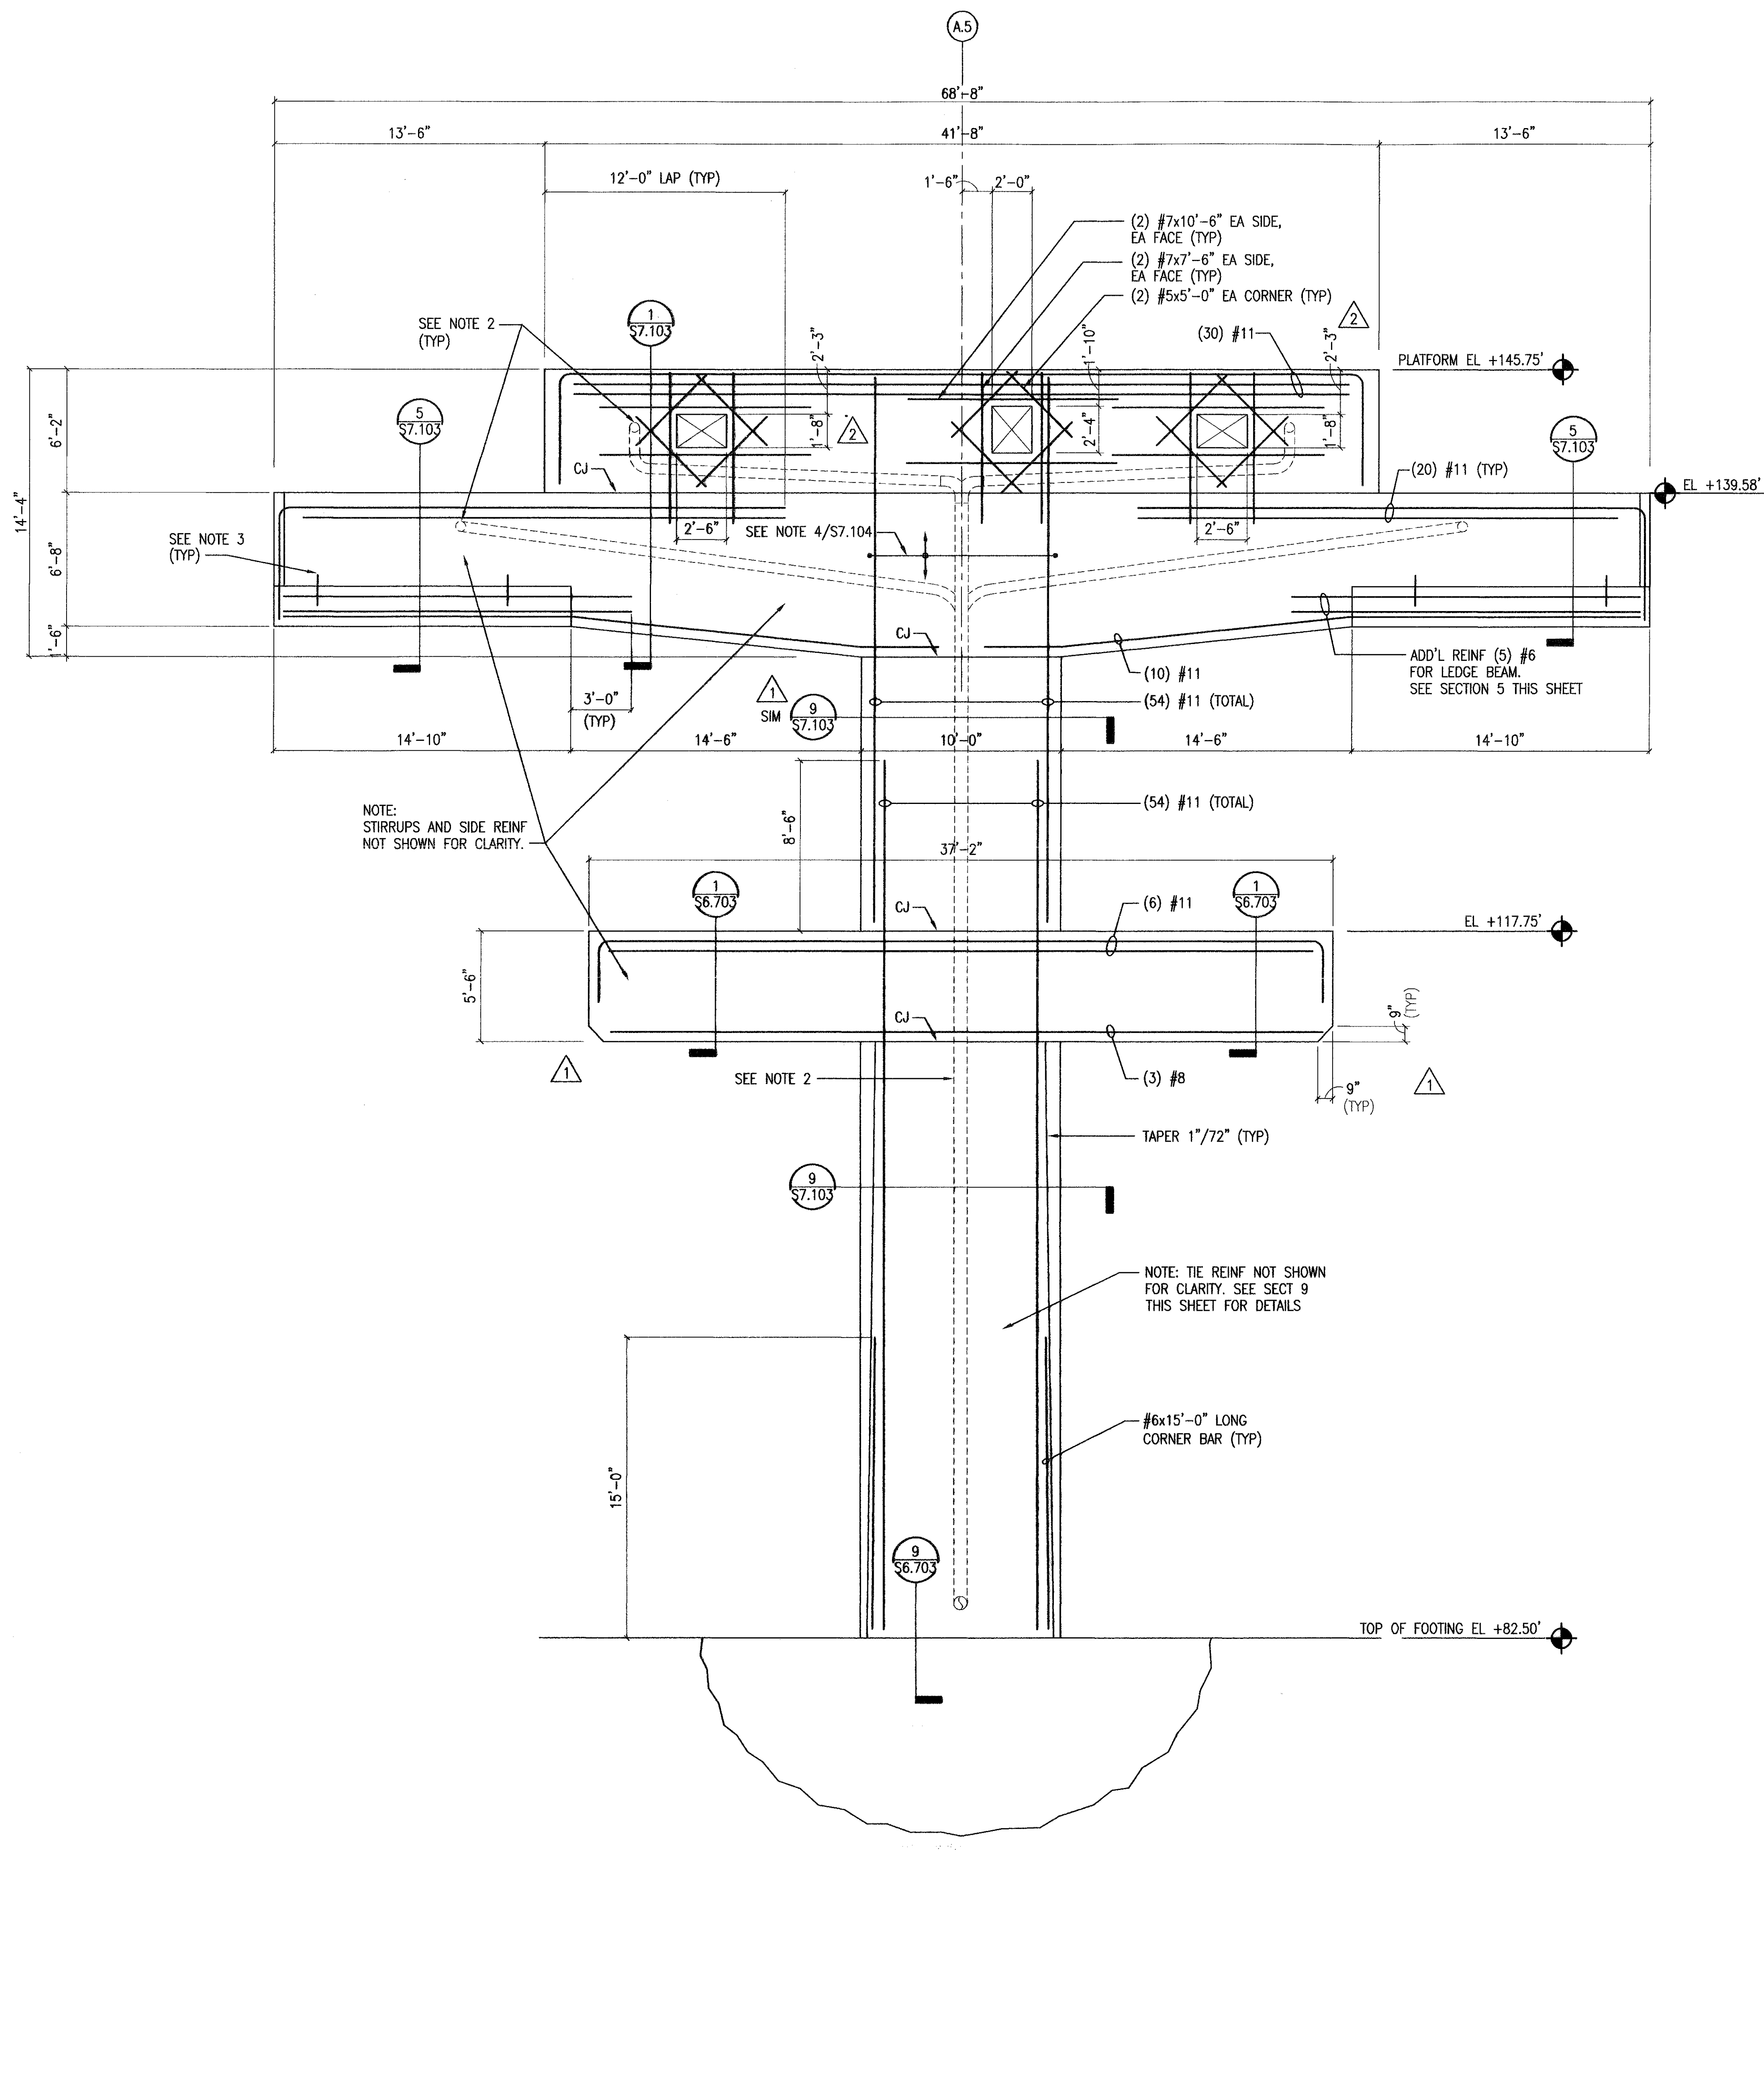


12 BENT FRAME #49 ELEVATION  
 S3.002 1/4" = 1'-0"

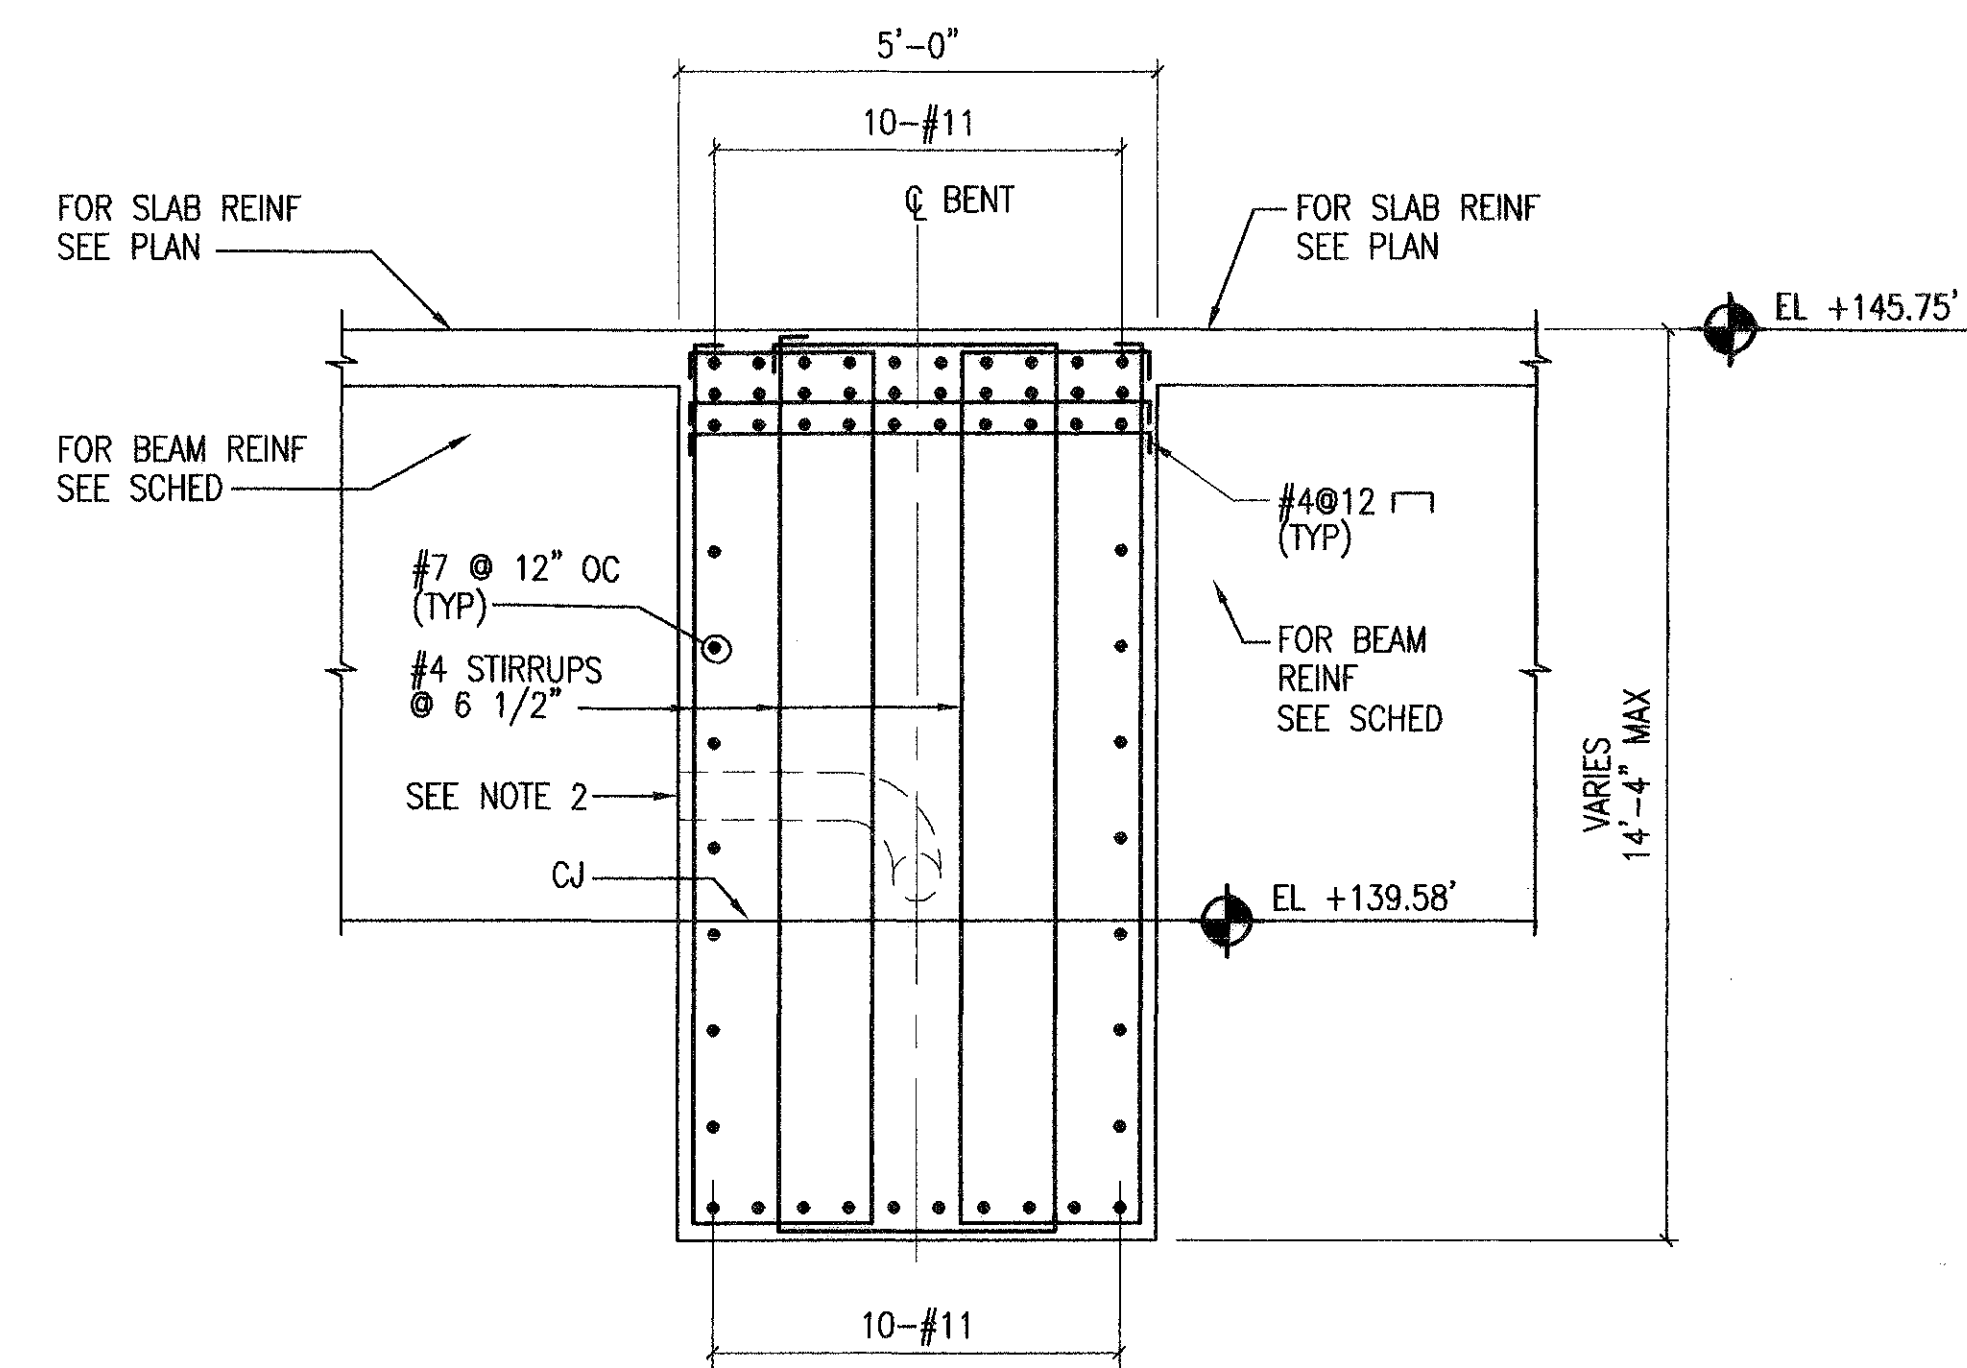

1 SECTION  
 S7.103 1/2" = 1'-0"

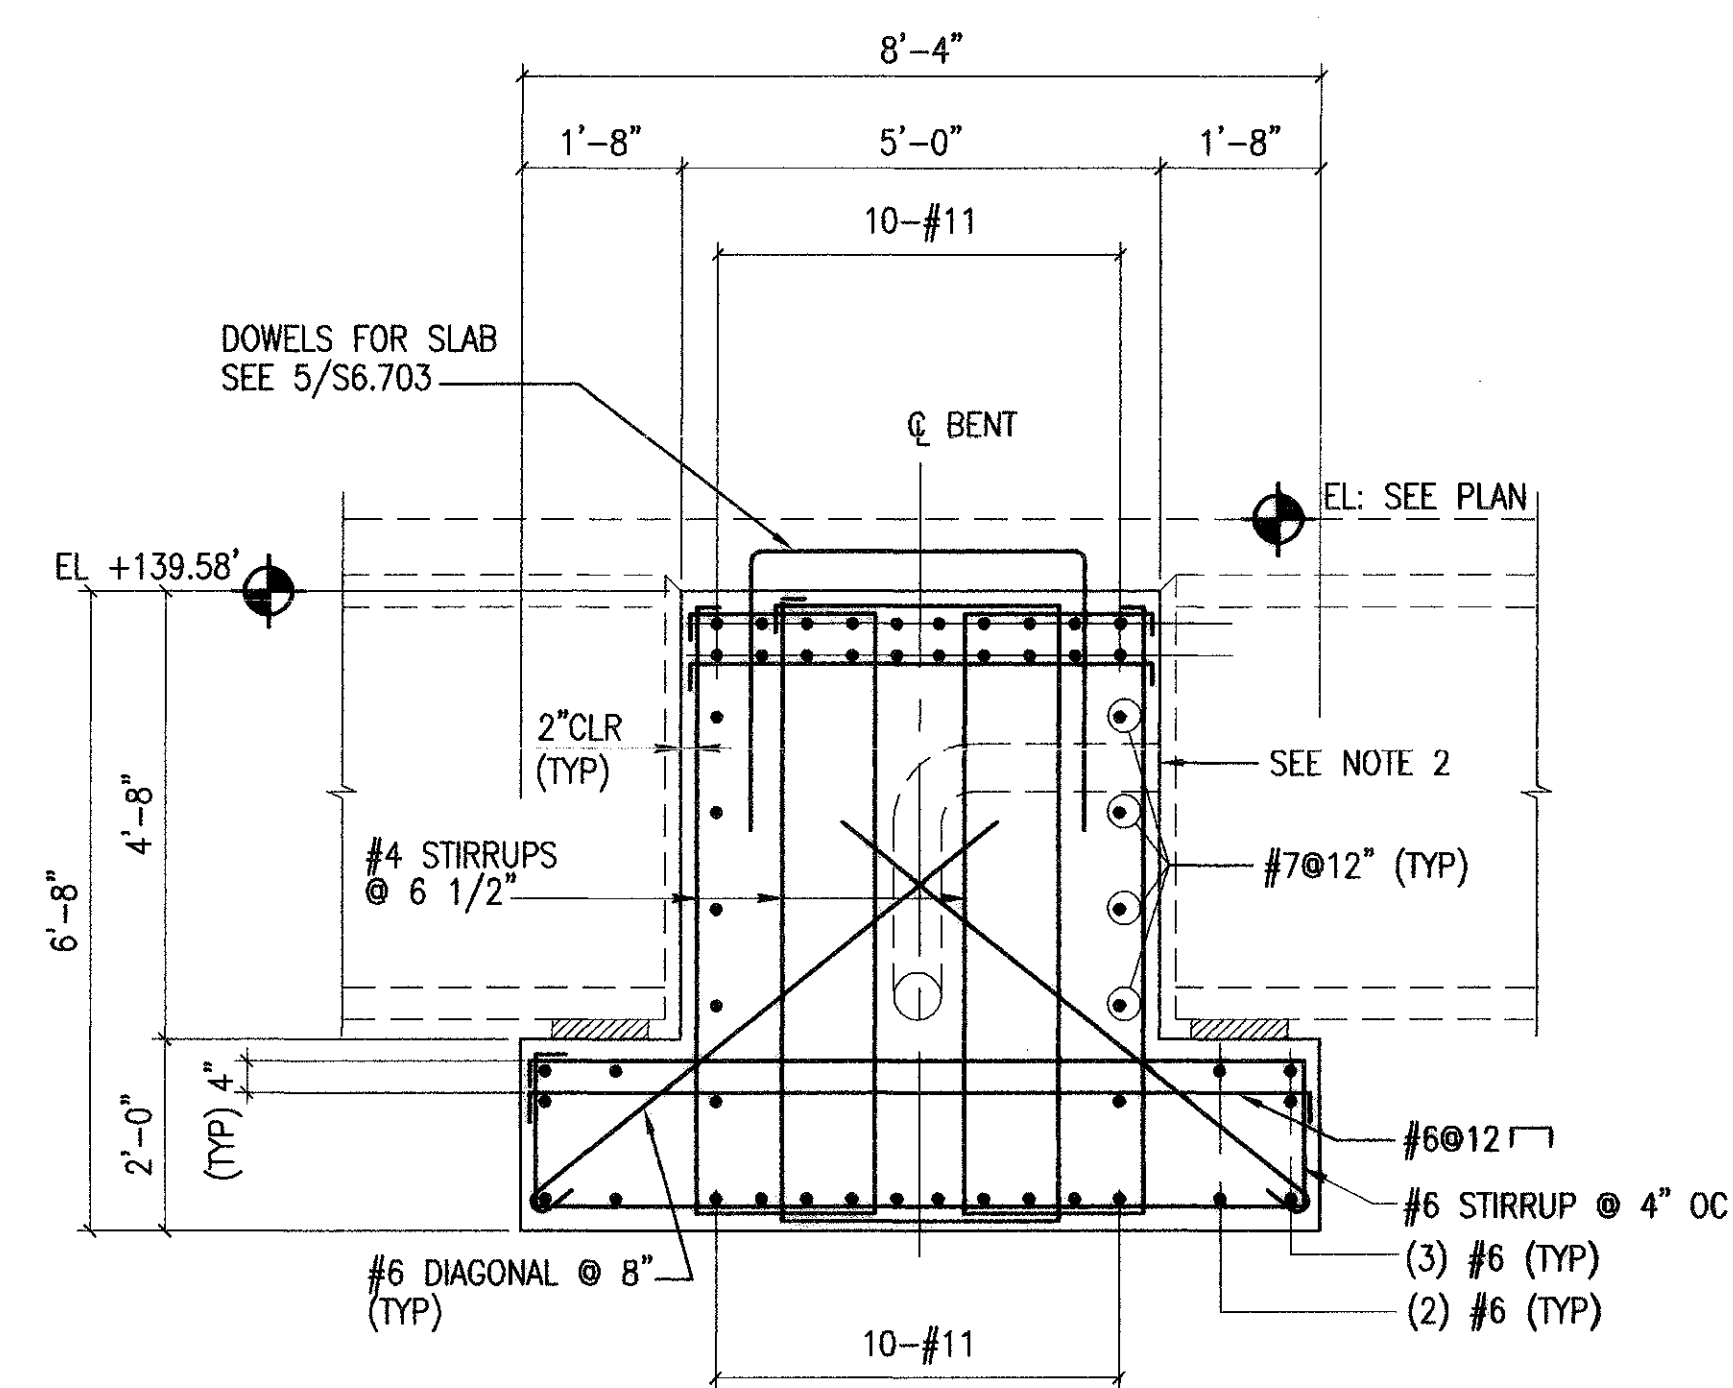

5 SECTION  
 S7.103 1/2" = 1'-0"

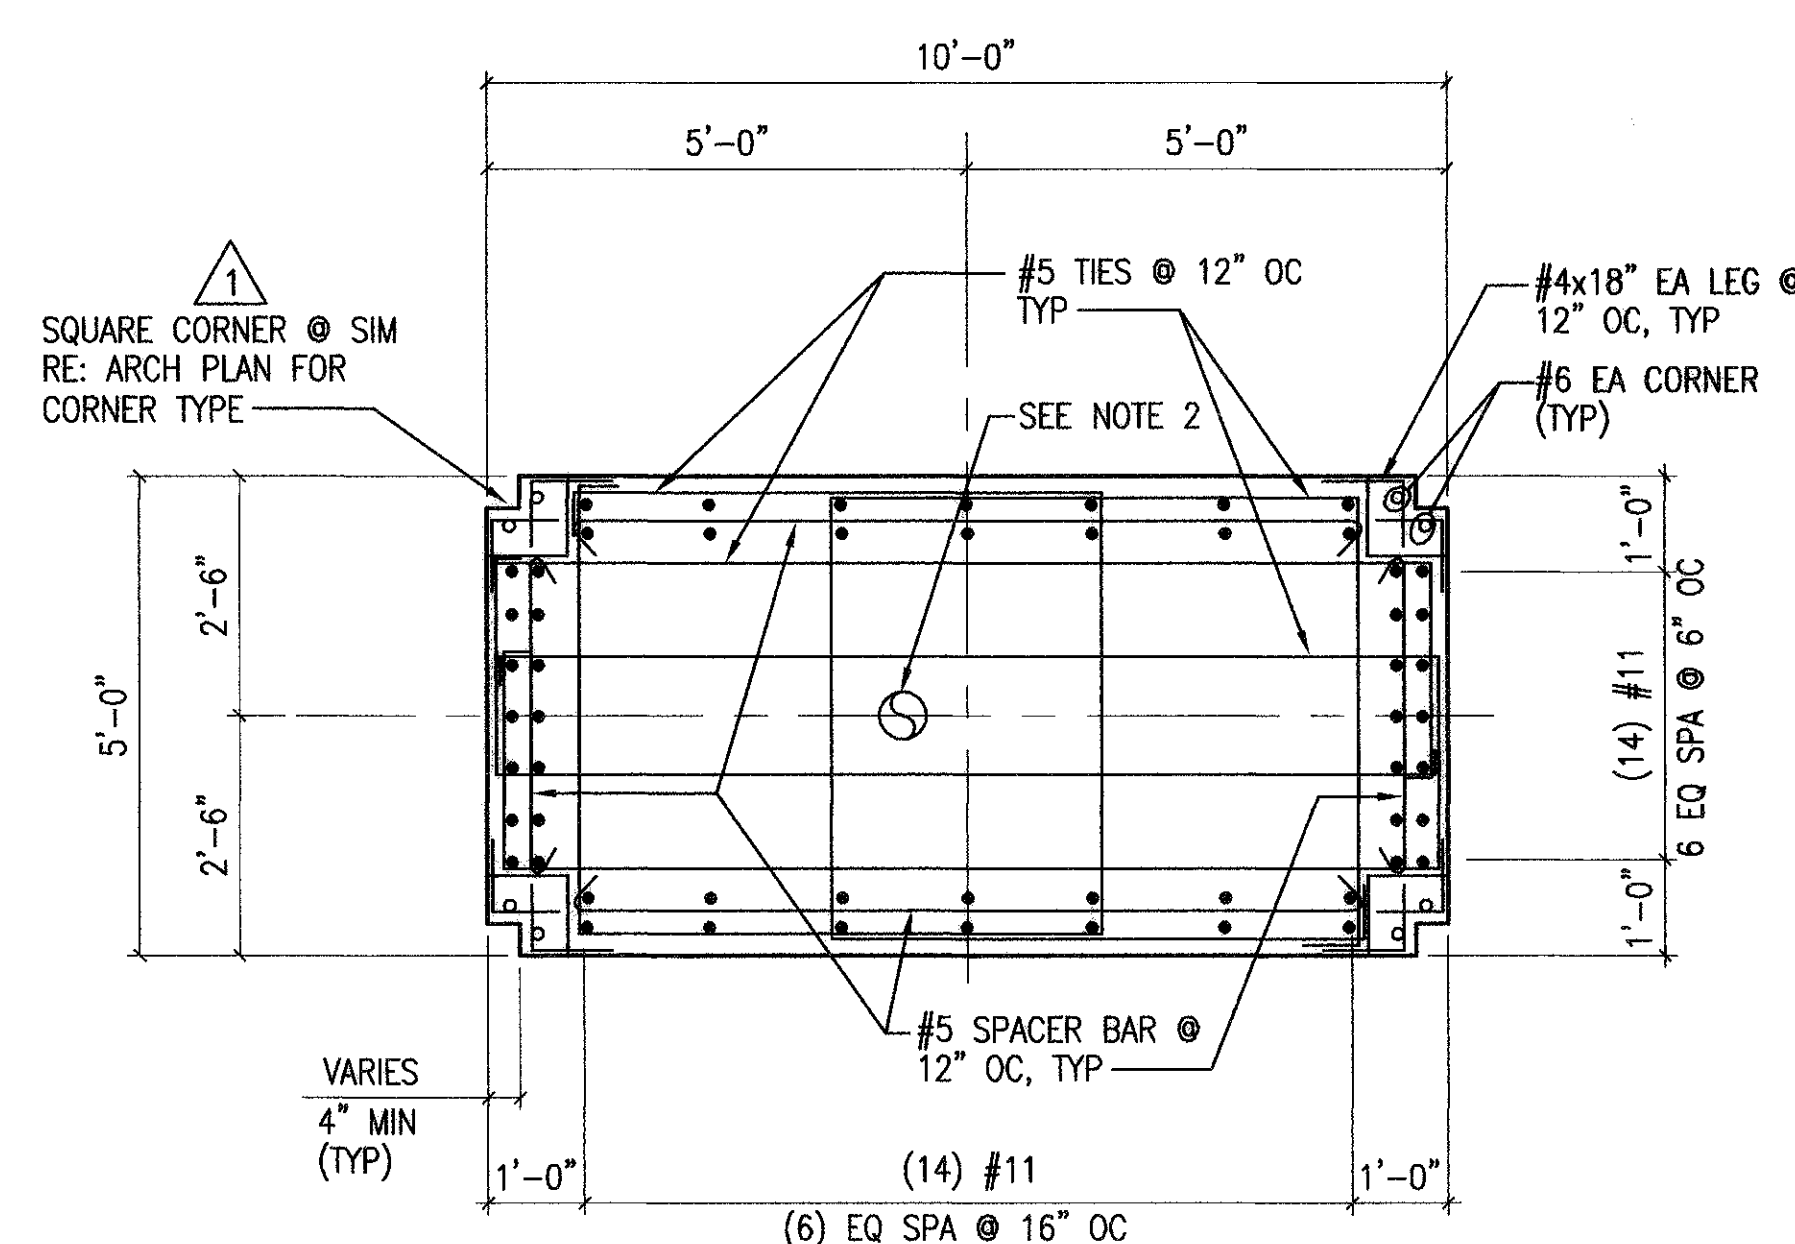

9 SECTION  
 S7.103 1/2" = 1'-0"

NOTES TO SHEET

- REFER TO SHEET S0.100 FOR STRUCTURAL GENERAL NOTES.
- COORDINATE PVC PIPE SIZE, NUMBER, LOCATION AND INVERT. ELEVATION WITH PLUMBING DWGS.
- PROVIDE 1 1/4"x1'-6" LONG SMOOTH DOWEL WITH 7" PROJECTION.

HOUSTON AIRPORT SYSTEM  
 GEORGE BUSH  
 INTERCONTINENTAL AIRPORT  
 HOUSTON TEXAS

HUIT-ZOLLARS  
 Engineering / Architecture  
 1500 West Loop South, Suite 500, Houston, TX 77027  
 Phone (281) 498-0088 Fax (281) 498-0250

CHARLES F. TERRY, INC.  
 Consulting Engineers  
 1400 West Loop South, Suite 500  
 Houston, Texas 77027  
 Phone (281) 498-0088 Fax (281) 498-0250


NO.	DESCRIPTION	DATE	BY
ISSUED FOR BID		10/19/01	
ADDENDUM #1		02/01/02	MR
REVISION #1		01/27/03	MR

INTERNATIONAL SERVICES • EXPANSION • PROGRAM


APM STATION & PLATFORM  
 BENT FRAME #49 ELEVATION

PROJECT MGR:	GRW
DESIGNER:	JUC
DRAWN BY:	KLW
CHECKED BY:	MMR
DRAWING STANDARD:	ISEP 07.20.2000
SCALE:	AS NOTED
DATE:	09/14/01

NOTE: REFER TO GRAPHIC SCALE IF ACTUAL SHEET SIZE IS OTHER THAN 30"x42".

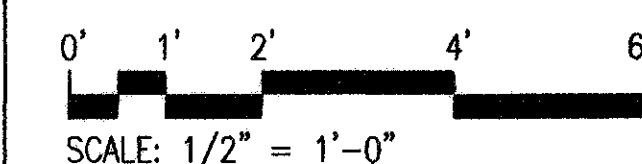


NOTE: REFER TO GRAPHIC SCALE IF ACTUAL SHEET SIZE IS OTHER THAN 30"x42".

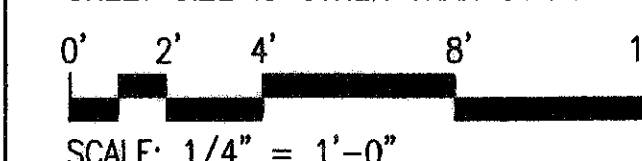

RECORD DRAWINGS  
 DO NOT MODIFY

DATE: MAY 6, 2005  
 HUIT-ZOLLARS, INC.

NOTE: INFORMATION USED TO DEVELOP THESE DOCUMENTS WAS TAKEN FROM RECORD OF THE WORK DRAWINGS PREPARED BY THE CONSTRUCTION CONTRACTOR, CLARK/MISSION A JOINT VENTURE. THE INFORMATION PROVIDED BY THE CONTRACTOR WAS NOT VERIFIED BY THE DESIGN FIRM NAMED ABOVE.

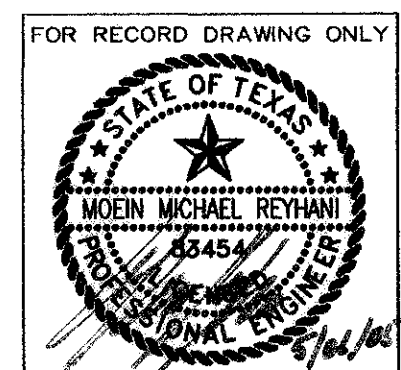

APPROVED BY: DATE:

DIRECTOR  
 HOUSTON AIRPORT SYSTEM

PROJECT NO. 02-2025-01


C.I.P. NO. A-0354

H.A.S. NO. 538C


SHEET NO.

S7.103




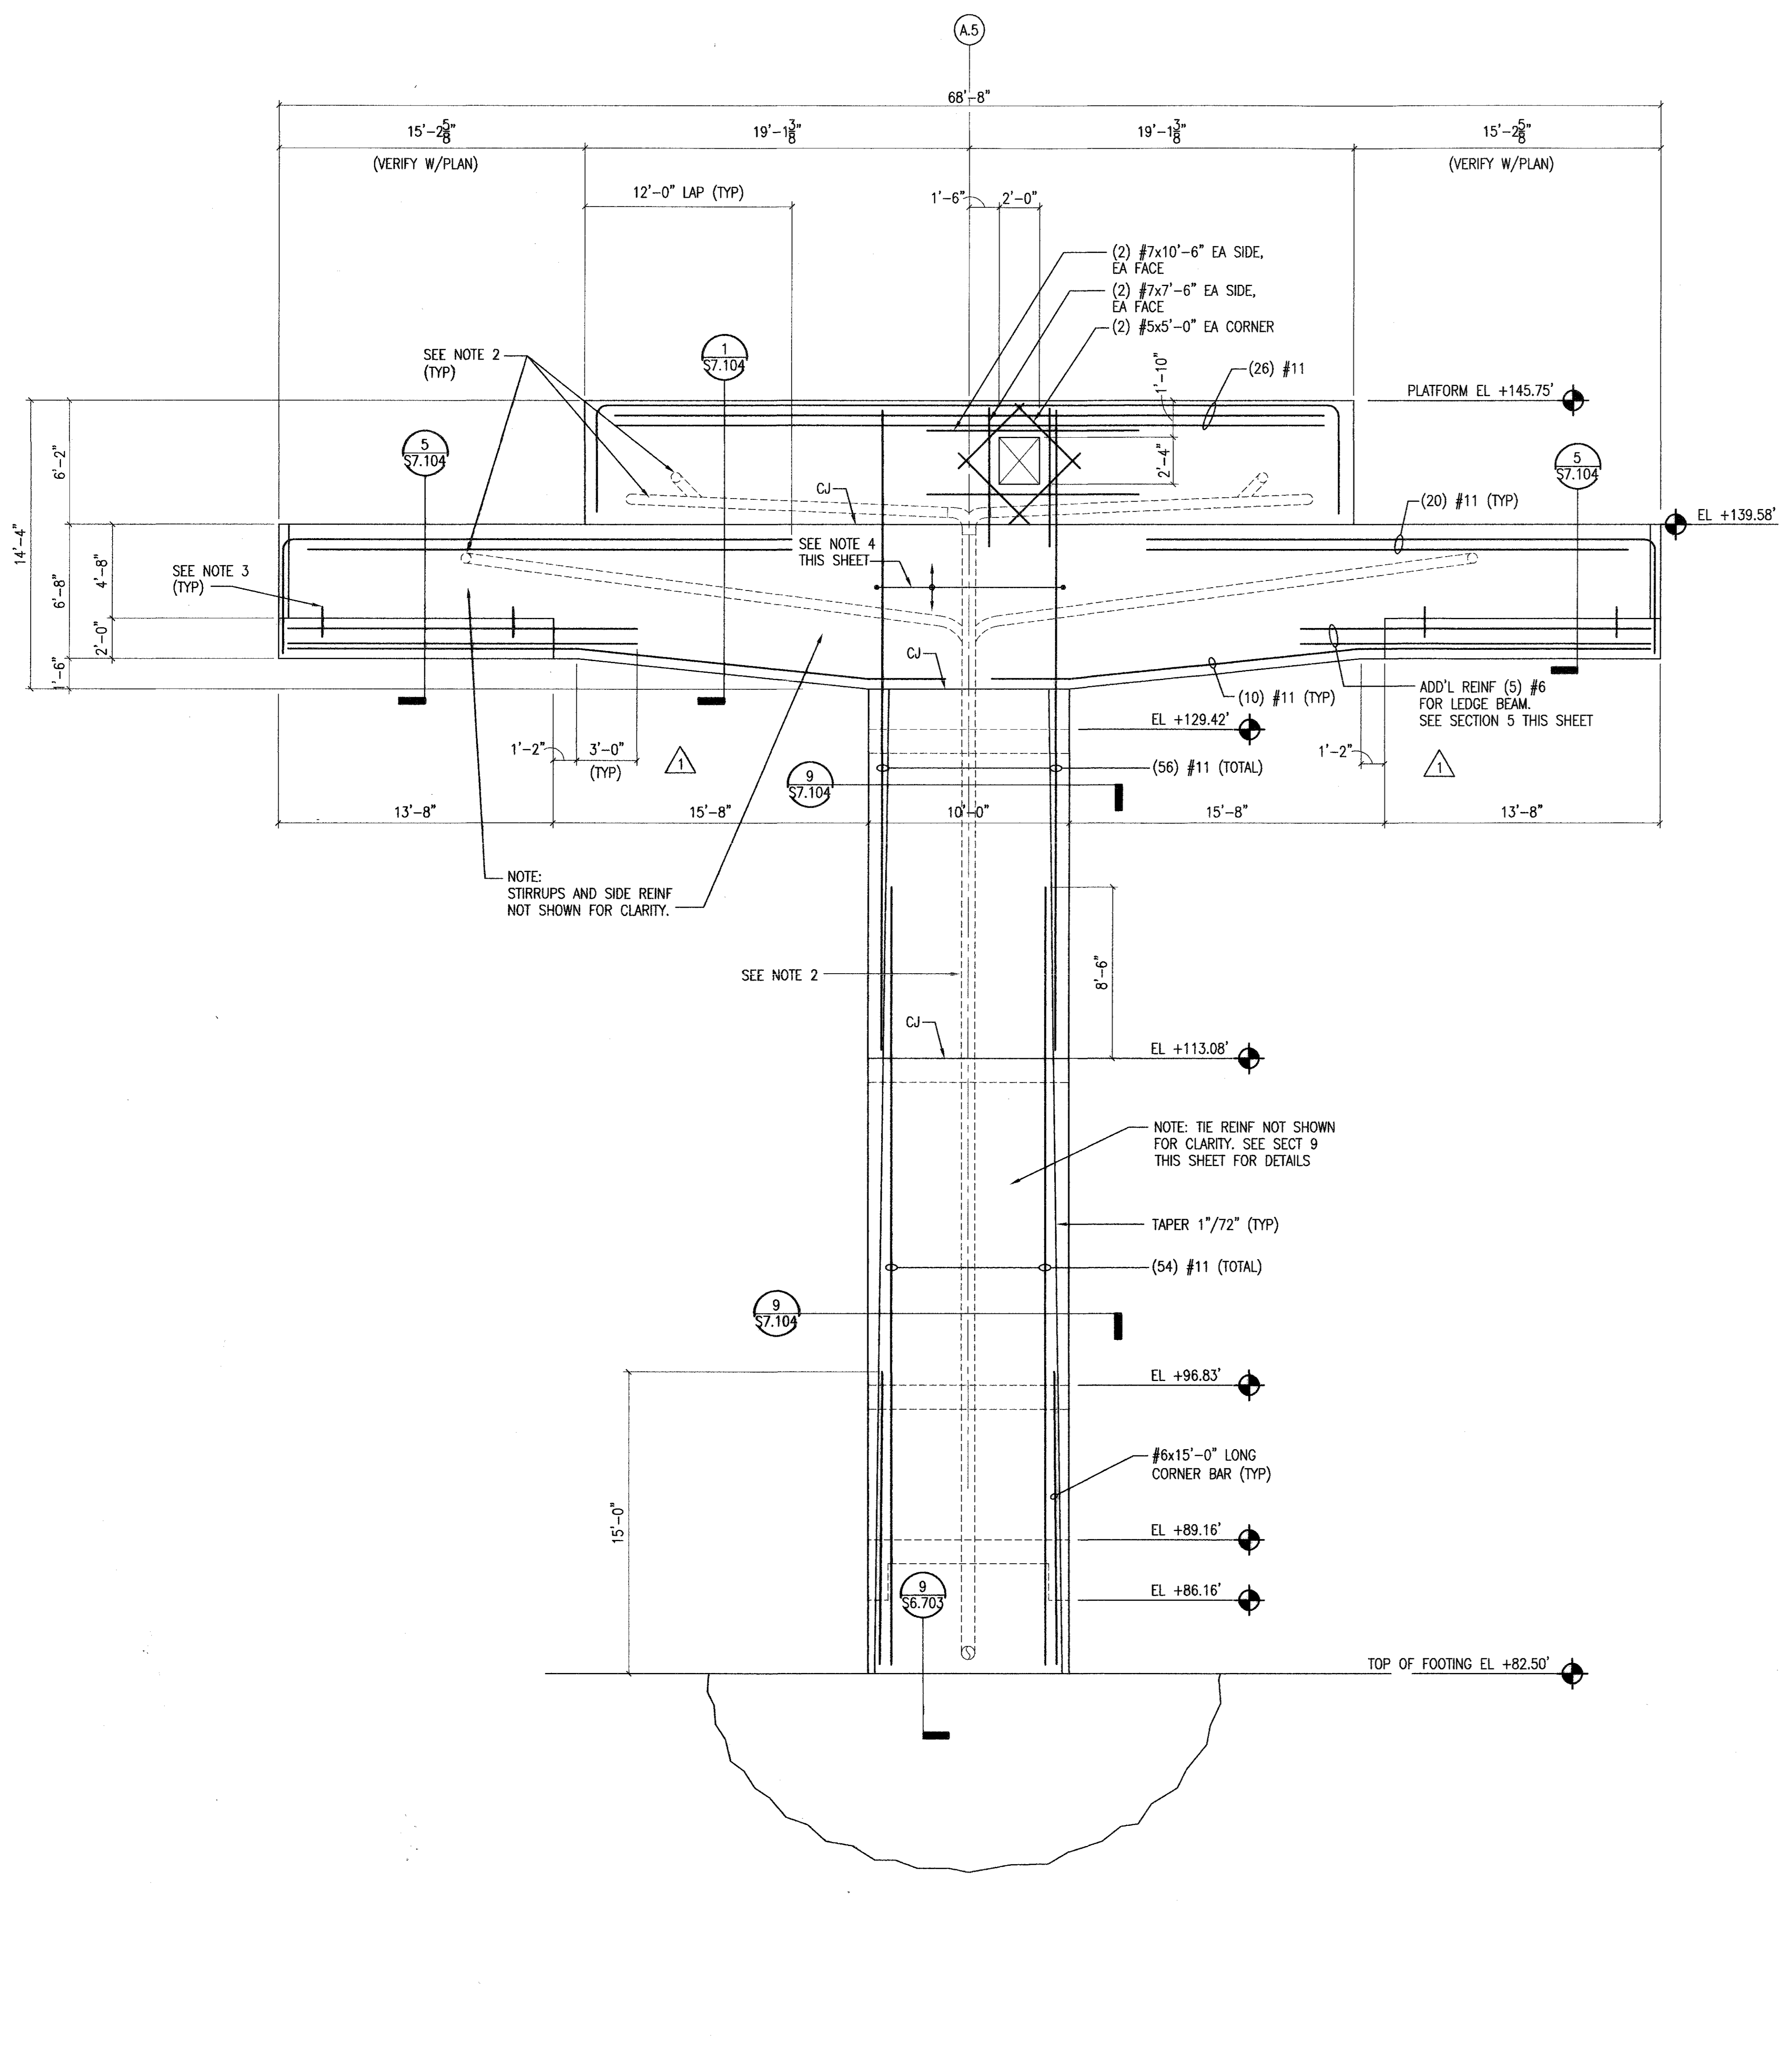


12 BENT FRAME #50 ELEVATION  
S3.002 1/4" = 1'-0"

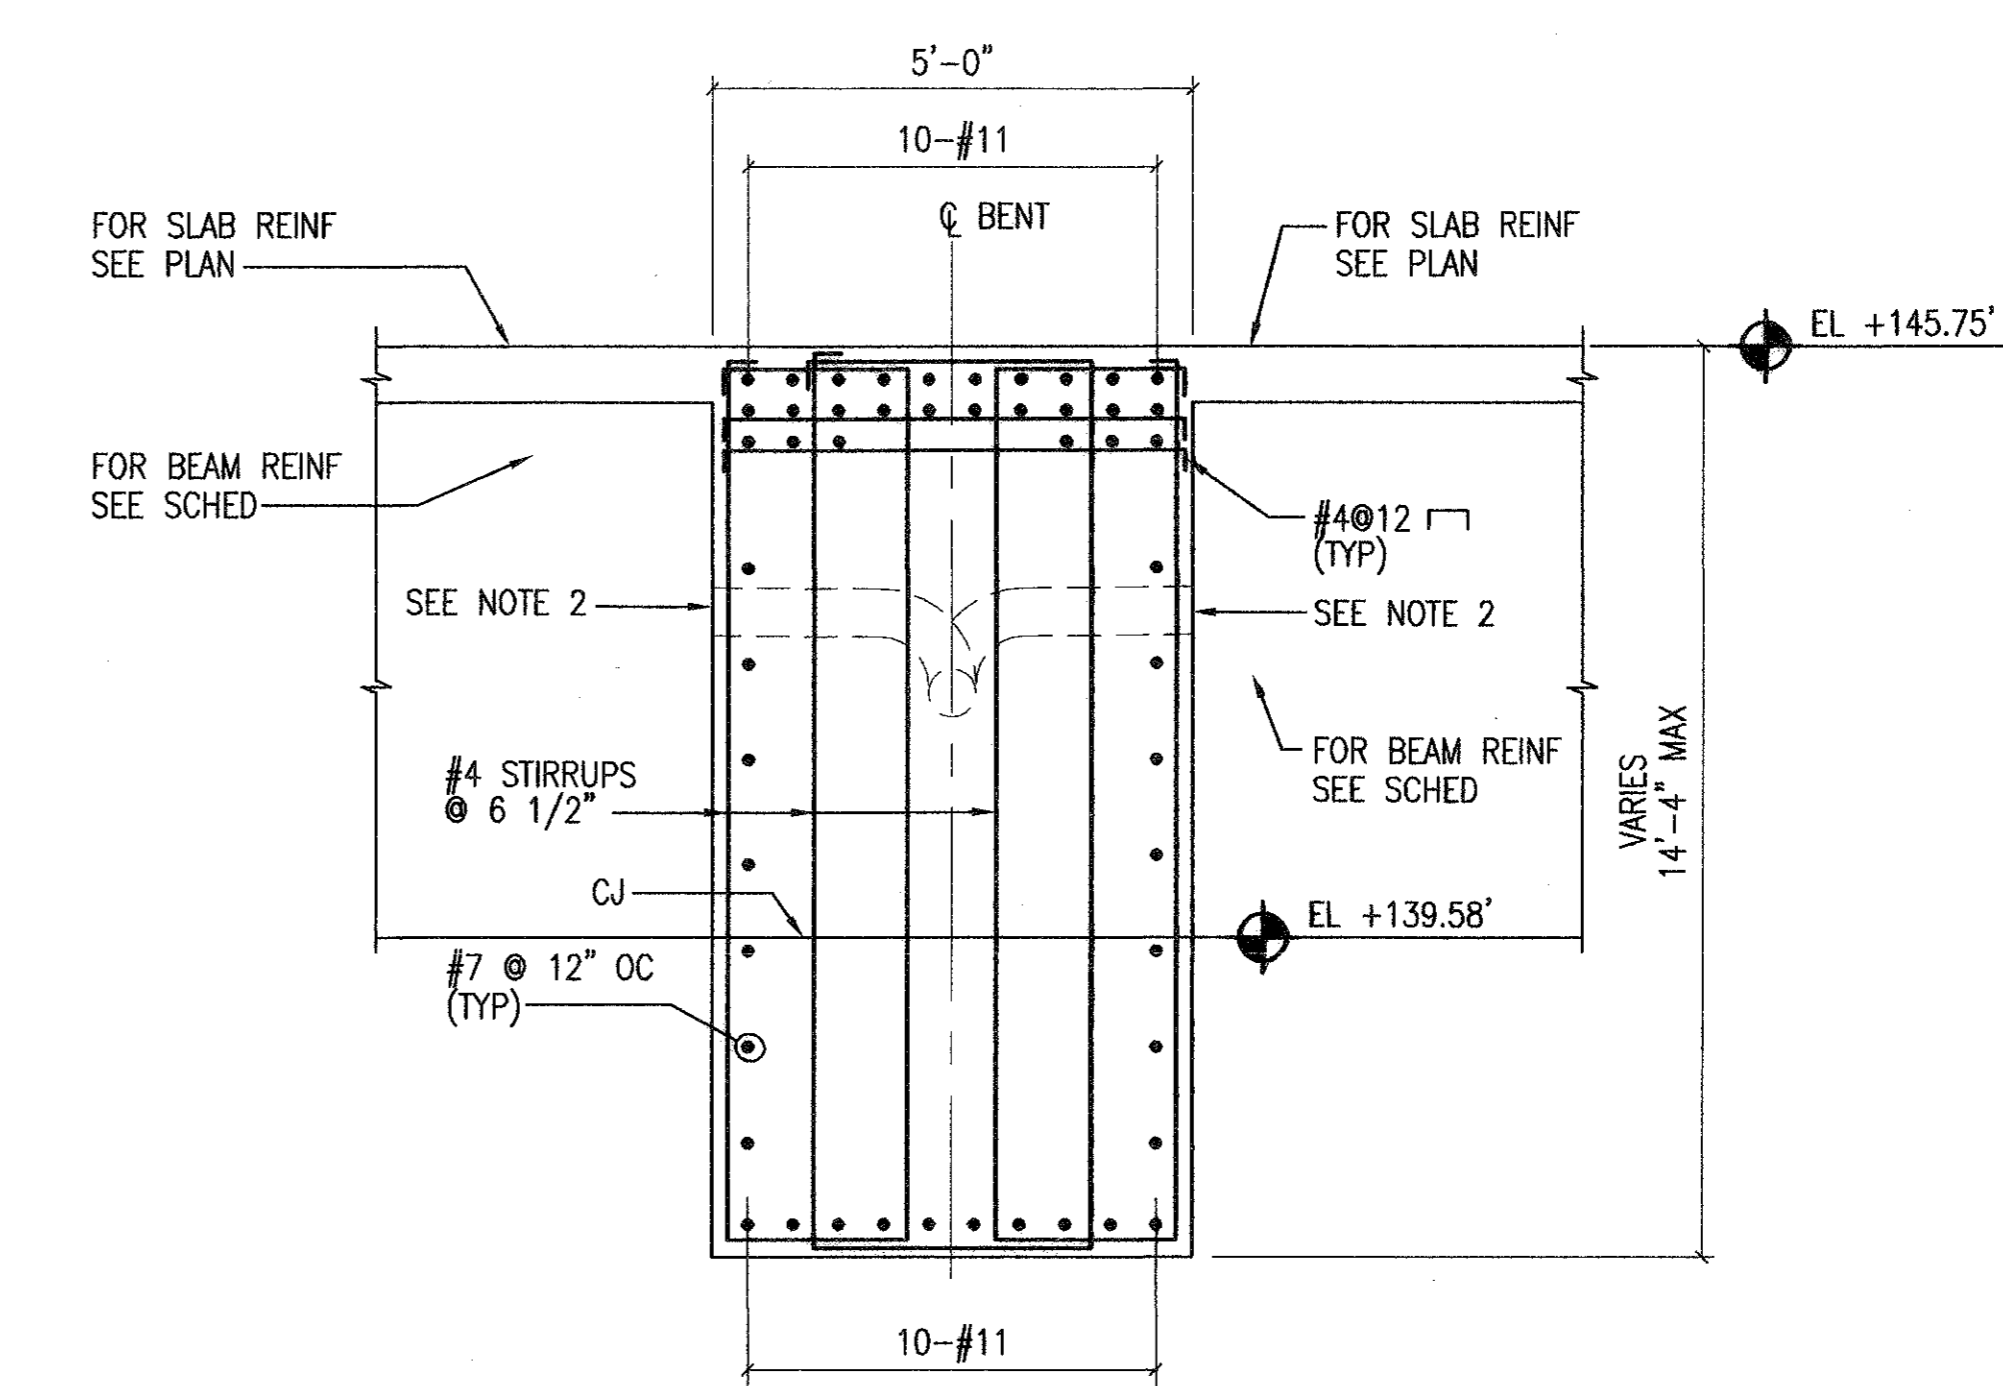

1 SECTION  
S7.104 1/2" = 1'-0"

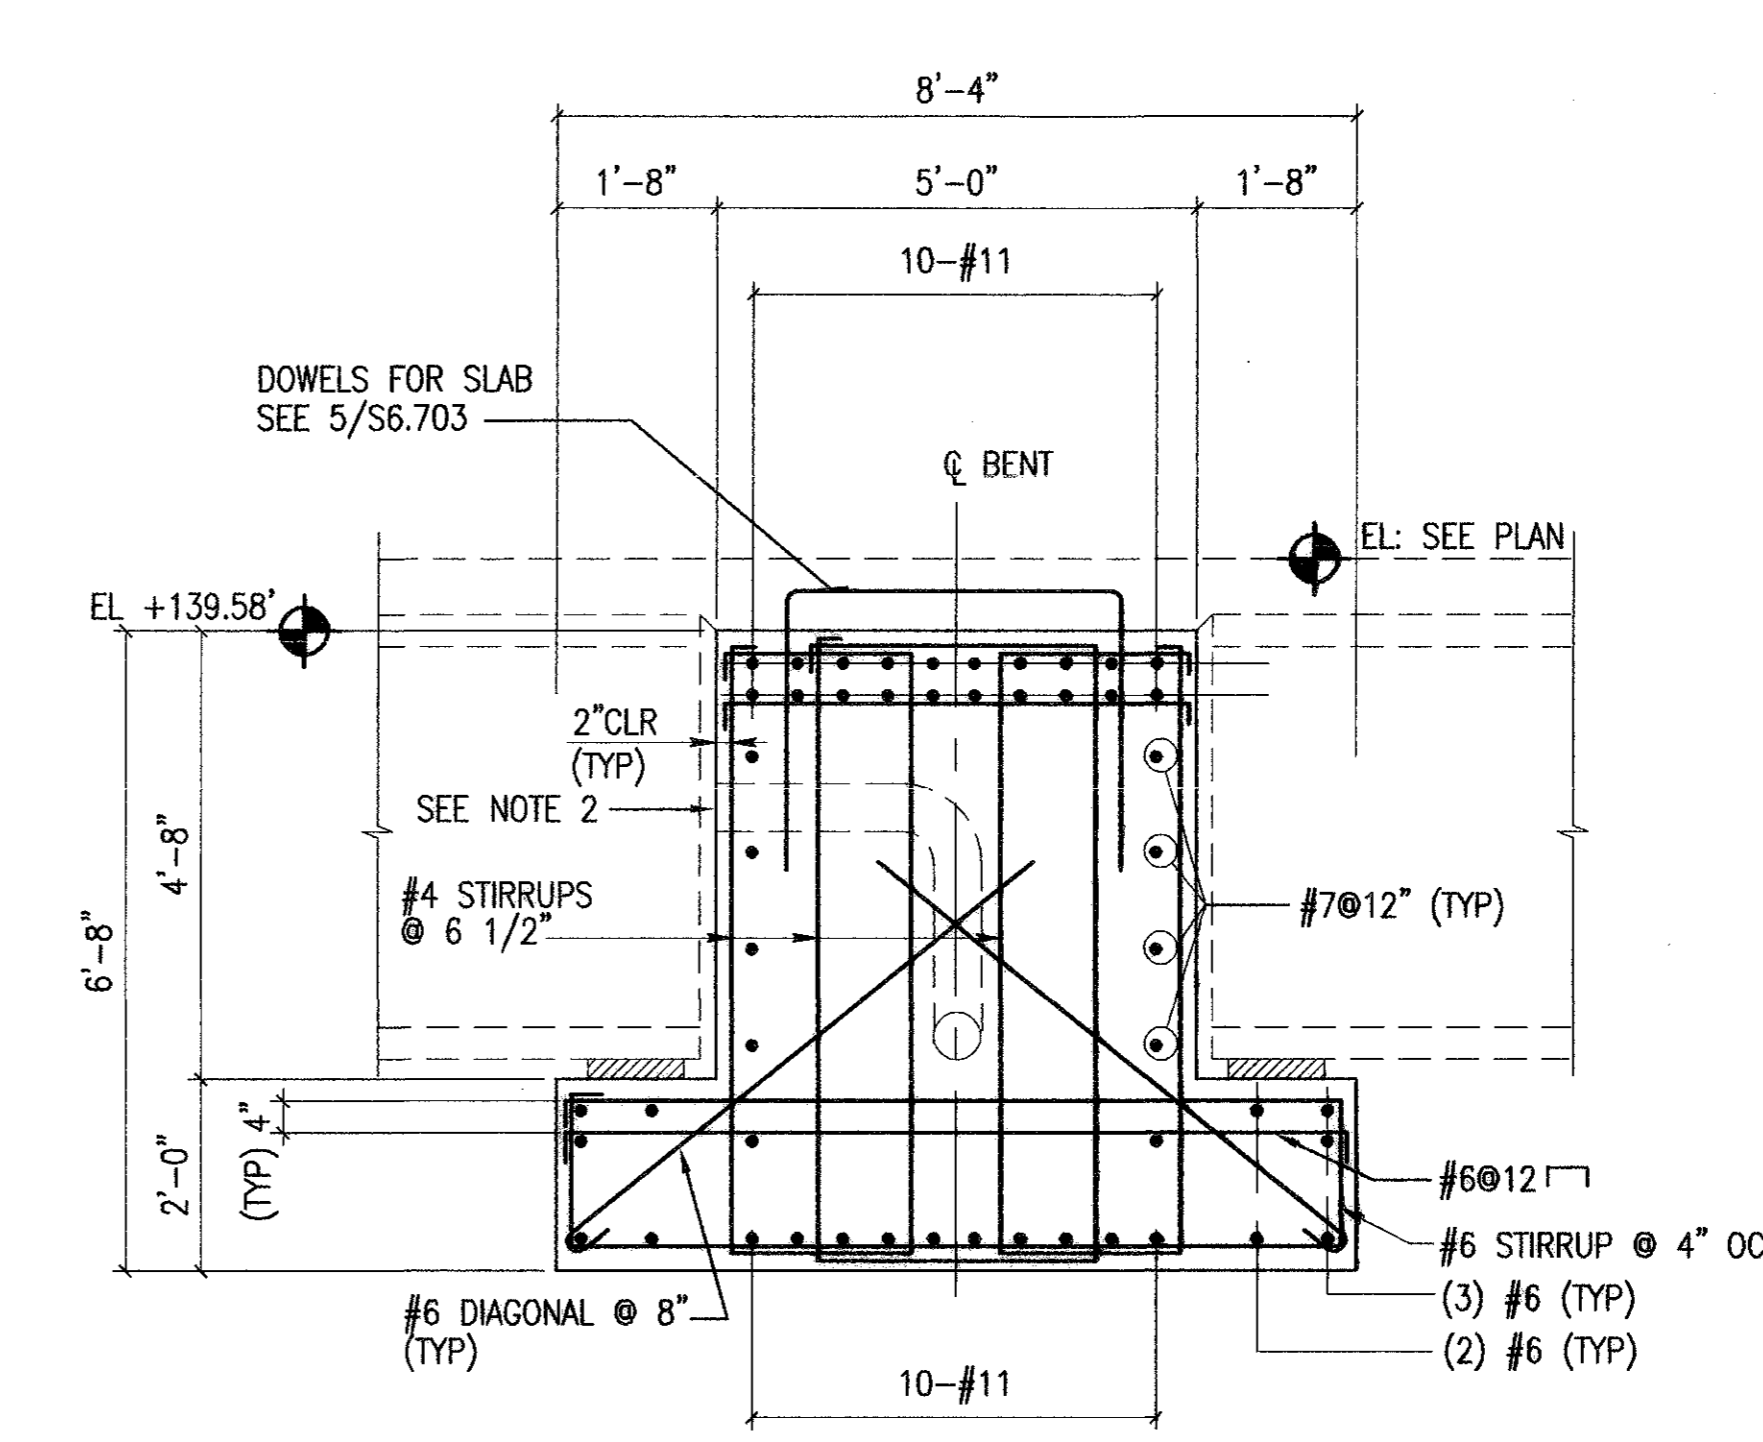

5 SECTION  
S7.104 1/2" = 1'-0"

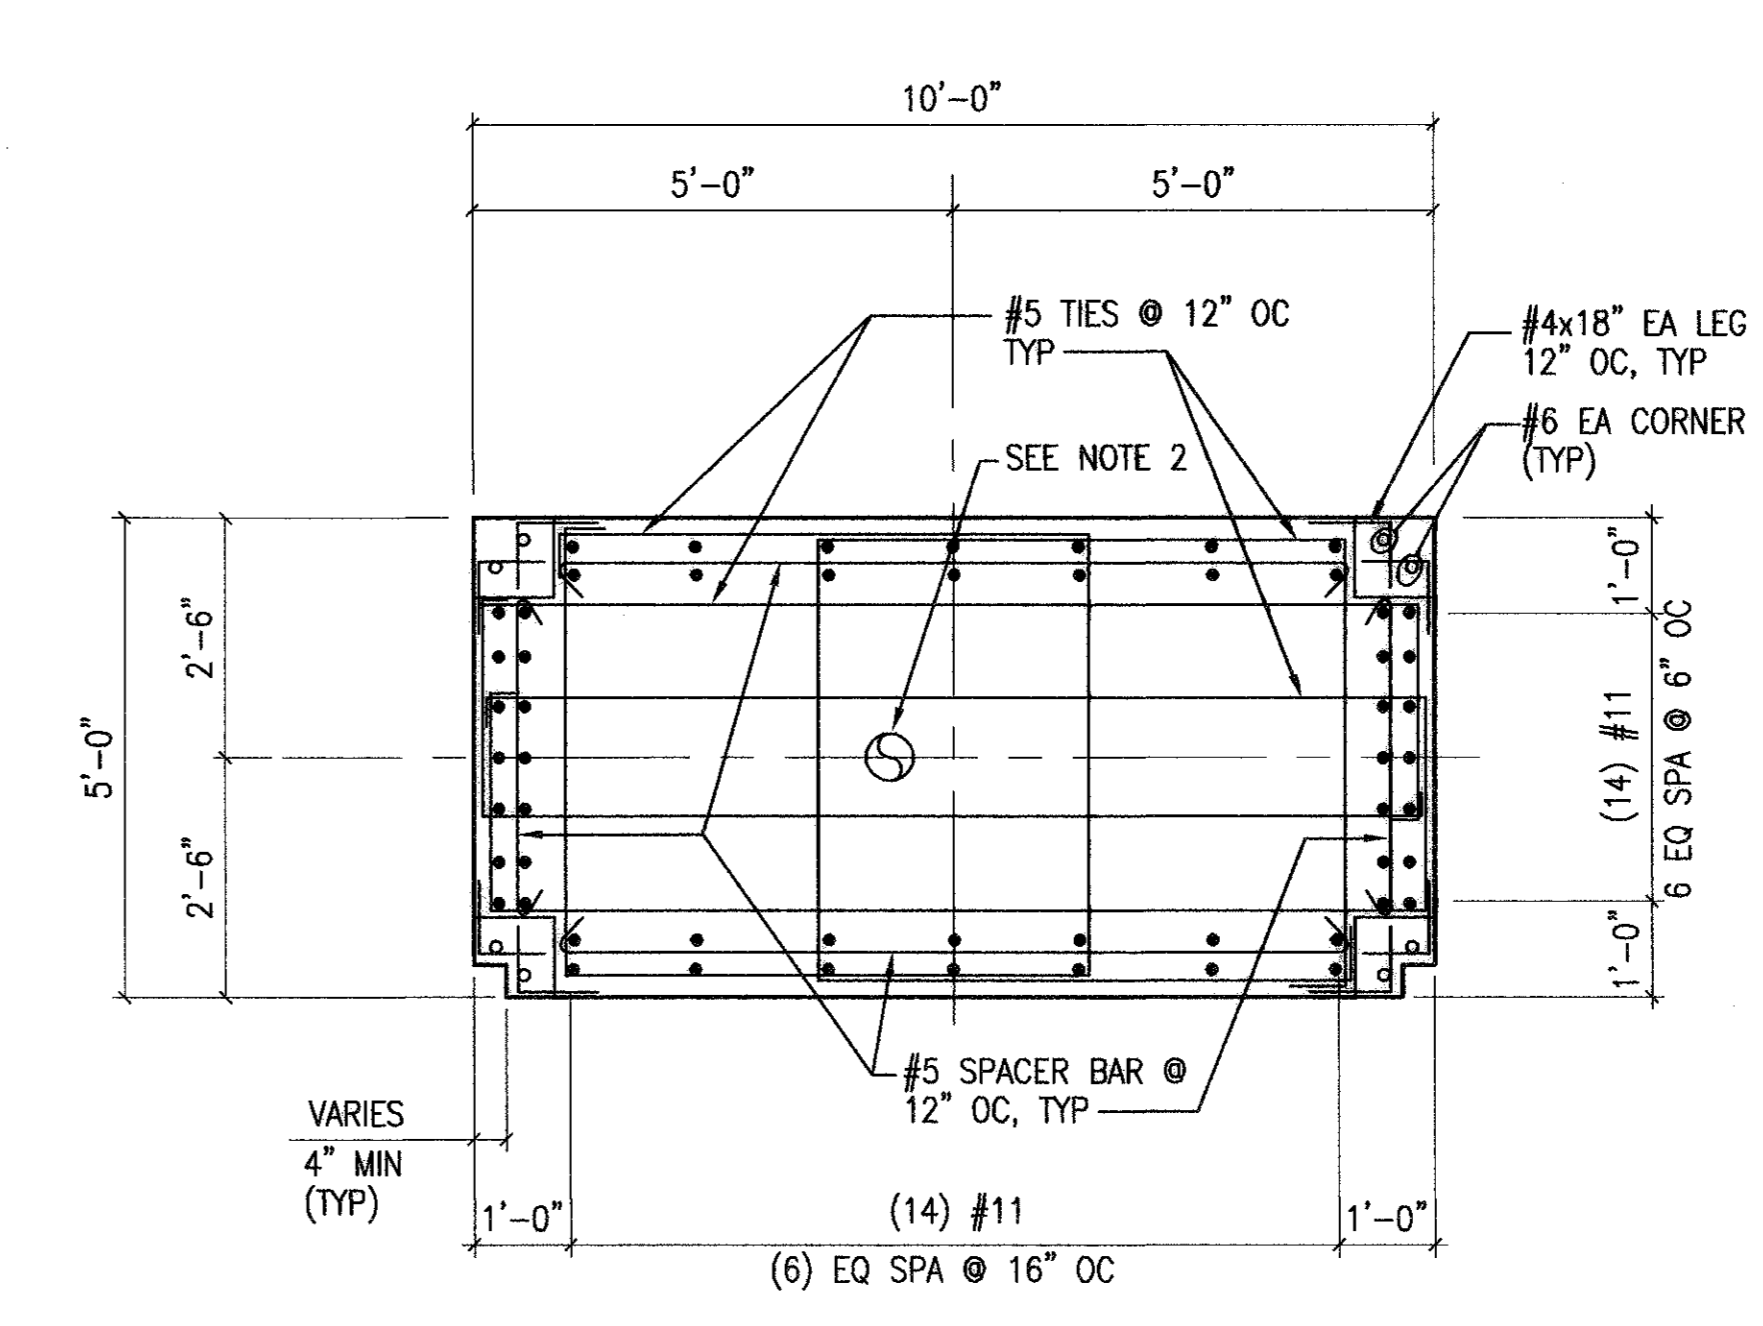

9 SECTION  
S7.104 1/2" = 1'-0"

NOTES TO SHEET

1. REFER TO SHEET S0.100 FOR STRUCTURAL GENERAL NOTES.
2. COORDINATE PVC PIPE SIZE, NUMBER, LOCATION AND INVERT. ELEVATION WITH PLUMBING DWGS.
3. PROVIDE 1 1/4"x1'-6" LONG SMOOTH DOWEL WITH 7" PROJECTION.
4. PROVIDE #5 TIES @ 12" OC SIMILAR TO 9/S7.104 INSIDE BENT GIRDER.

**HOUSTON AIRPORT SYSTEM**  
GEORGE BUSH  
INTERCONTINENTAL AIRPORT  
HOUSTON TEXAS

**HUITT-ZOLLARS**  
Engineering / Architecture  
1200 West Loop, Suite 200, Houston, TX 77027  
Phone (281) 496-0065 Fax (281) 496-0250

**CHARLES F. TERRY, INC.**  
Consulting Engineers  
3801 Gessner Avenue  
Dallas, Texas 75226  
Phone (972) 496-0065

NO.	DESCRIPTION	DATE	BY
1	ISSUED FOR BID	10/19/01	MMR
2	ADDENDUM #1	02/01/02	MMR

INTERNATIONAL • SERVICES • EXPANSION • PROGRAM

**APM STATION & PLATFORM**  
BENT FRAME #50 ELEVATION

PROJECT MGR: GRW  
DESIGNER: JUC  
DRAWN BY: KLV  
CHECKED BY: MMR  
DRAWING STANDARD: ISEP 07.20.2000  
SCALE: AS NOTED  
DATE: 09/14/01

FOR RECORD DRAWING ONLY

STATE OF TEXAS  
MOEN MICHAEL REYANI  
35454  
Professional Engineer  
09/04/01

NOTE: REFER TO GRAPHIC SCALE IF ACTUAL SHEET SIZE IS OTHER THAN 30"x42".

0' 1' 2' 4' 6'

SCALE: 1/2" = 1'-0"

NOTE: REFER TO GRAPHIC SCALE IF ACTUAL SHEET SIZE IS OTHER THAN 30"x42".

0' 2' 4' 8' 12'

SCALE: 1/4" = 1'-0"

**RECORD DRAWINGS**  
DO NOT MODIFY

DATE: MAY 6, 2005

HUITT-ZOLLARS, INC.

NOTE: INFORMATION USED TO DEVELOP THESE DOCUMENTS WAS TAKEN FROM RECORD OF THE WORK DRAWINGS PREPARED BY THE CONSTRUCTION CONTRACTOR. CLARK/MISSION A JOINT VENTURE. THE INFORMATION PROVIDED BY THE CONTRACTOR WAS NOT VERIFIED BY THE DESIGN FIRM NAMED ABOVE.

APPROVED BY: \_\_\_\_\_ DATE: \_\_\_\_\_

DIRECTOR  
HOUSTON AIRPORT SYSTEM

PROJECT NO. 02-2025-01  
C.I.P. NO. A-0354  
H.A.S. NO. 539C  
SHEET NO. 9/0 S7.104

PLOT DATE: 10/19/01 HAS FILE: I4326557104.DWG



NO.	DESCRIPTION	DATE	BY
ISSUED FOR BID		10/19/01	

INTERNATIONAL • SERVICES • EXPANSION • PROGRAM

**APM STATION + PLATFORM**

COMMUNICATIONS LEGEND

PROJECT MGR:	HK
DESIGNER:	TL
DRAWN BY:	MP
CHECKED BY:	KW
DRAWING STANDARD:	ISEP 07.20.2000
SCALE:	N.T.S.
DATE:	9/14/01


APPROVED BY:	DATE:
DIRECTOR	HOUSTON AIRPORT SYSTEM
PROJECT NO.	1AH08
C.I.P. NO.	A-0354
H.A.S. NO.	536C
SHEET NO.	

**T0.100**

COMMUNICATIONS SYMBOLS	GENERAL NOTES	MISCELLANEOUS
<p>NOTES:</p> <p>a) I = INFORMATION                      M = MEDIA                      O = OUTLET</p> <p>b) THE LISTED ELEVATIONS ARE STANDARDS.                      REFER TO PROVIDED DETAILS FOR LOCATIONS AND ELEVATIONS.</p> <p>▼ MO - 1 WALL/VOICE/OFFICE AREA -(VOICE OUTLET)- 18 IN. AFF O/C (1) CATEGORY 5E UTP 4-PAIR CABLE</p> <p>▼ MO - 2 ELEVATOR DEVICE/EMERGENCY INTERCOM - (VOICE OUTLET)-(1) CATEGORY 5E UTP 4-PAIR CABLE TO ELEVATOR WIRING HARNESS CONNECTION D-MARC</p> <p>▼ MO - 3 WALL/VOICE/WORK AREA - (VOICE OUTLET)- 48 IN. AFF O/C (1) CATEGORY UTP 4-PAIR CABLE</p> <p>▼ MO - 4 WALL/VOICE/PUBLIC AREA - (VOICE OUTLET)- 48 IN. AFF O/C (1) CATEGORY 5E EUTP 4-PAIR CABLE</p> <p>▼ MO - 5 DEFIBRILATOR- (VOICE OUTLET)- 30 IN. AFF O/C (1) CATEGORY 5E UTP 4-PAIR CABLE</p> <p>▽ IO - 1 WALL/DATA/OFFICE AREA - (DATA OUTLET)- 18 IN. AFF O/C (1) CATEGORY 5E UTP 4-PAIR CABLE</p> <p>▼ IMO - 1 WALL/VOICE/DATA/OFFICE AREA - (1-VOICE/ 1-DATA OUTLET)-18 IN. AFF O/C (2) CATEGORY 5E UTP 4-PAIR CABLE</p>	<ol style="list-style-type: none"> <li>OUTLETS OR EQUIPMENT SHOWN IN ELEVATOR EQUIPMENT ROOM ARE FOR REFERENCE ONLY. COORDINATE AND VERIFY EXACT INSTALLATION LOCATIONS WITH CONVEYANCE CONTRACTOR.</li> <li>CONTRACTOR SHALL SUBMIT TO THE CITY ENGINEER FOR APPROVAL A CONDUIT IDENTIFICATION PLAN LISTING ASSOCIATING SYSTEMS, LOCATION AND IDENTIFICATION METHOD, AND MATERIALS TO BE USED FOR LABELING. INCLUDE IN THE TELEPHONE AND ELECTRICAL DRAWING ALL CONDUITS, AND J-BOXES                         <ol style="list-style-type: none"> <li>ORINATION ROOM</li> <li>DESTINATION ROOM</li> <li>MEDIA TYPE</li> </ol> </li> <li>NO EXPOSED CONDUIT ALLOWED UNLESS APPROVED IN ADVANCE BY PROJECT MANAGER.</li> <li>CONDUIT AND JUNCTION BOXES INSTALLED BY CONTRACTOR EXPOSED TO VIEW IN FINISHED SPACES SHALL BE PAINTED TO MATCH EXISTING ADJACENT SURFACES.</li> <li>ELECTRICAL POWER CABLES SHALL NOT BE INSTALLED IN OR ATTACHED TO COMMUNICATION CABLE TRAYS.</li> <li>CONTRACTOR SHALL NOT ABANDON WIRING, CONDUIT, J-BOXES, OR DEVICES IN PLACE. UNUSED EQUIPMENT AND SUPPORTS SHALL BE REMOVED AND DISPOSED OF</li> <li>CONDUIT SHALL BE CONCEALED IN CEILING WHERE EVER POSSIBLE. CONTRACTOR SHALL SUBMIT ROUTING PLAN SHOWING CONDUIT PENETRATIONS TO FIRE RATED SURFACES TO CONSTRUCTION MANAGE FOR APPROVAL PRIOR TO INSTALLATION. UNINTERRUPTED FIRE RATING OF FLOORS AND WALLS SHALL BE MAINTAINED.</li> <li>TELECOMMUNICATION OUTLET BOXES SHALL BE                         <ol style="list-style-type: none"> <li>4 IN. SQ. BY 2 1/2 IN. DEEP</li> <li>UNLESS NOTED OTHERWISE</li> <li>ALL COVERS OR PLATES SHALL BE DESIGNED TO FIT ONE-GANG OR TWO-GANG OUTLET BOXES</li> <li>PLASTER RINGS ARE NOT SUITABLE FOR SECURING SERVICE CONNECTORS</li> <li>BUSHING CONNECTORS SHALL BE PROVIDED TO ALL OUTLET BOXES</li> <li>FLUSH WITH THE FINISHED WALL</li> </ol> </li> <li>ALL TELECOMMUNICATION OUTLETS SHALL BE PIPED WITH ONE (1) INCH EMT CONDUIT                         <ol style="list-style-type: none"> <li>TO INCLUDE ALL PROPER CONNECTORS</li> <li>TO INCLUDE ALL PROPER BUSHINGS</li> <li>TO INCLUDE THE SHORTEST ROUT</li> <li>TO INCLUDE THE LEAST AMOUNT OF BENDS</li> </ol> </li> <li>ALL TELECOMMUNICATION CONDUITS SHALL BE PROVIDED WITH A "TRUE TAPE" PULL STRING.</li> <li>WHEN UTILIZING THE "TRUE TAPE" TO INSTALL THE CABLING A STANDARD PULL STRING SHALL BE PROVIDED WHEN PULLING IN ALL CABLING TO REPLACE THE "TRUE TAPE".</li> <li>ALL TELECOMMUNICATION WALL OUTLETS SHALL BE 4 IN. SQ. BY 2 1/2 DEEP AND FLUSH TO WALL FINISH.</li> <li>ALL TELECOMMUNICATION WALL OUTLETS SHALL CONNECT TO WALL/CEILING JUNCTION WITH A 4 IN. SQ. BY 2 1/2 DEEP JUNCTION BOX.</li> <li>ALL JUNCTION BOXES SHALL BE PROVIDED WITH PROPER CONDUIT CUT OUTS AND BUSHINGS FOR EACH CONDUIT.</li> <li>JUNCTION BOX/PULL BOXES SHALL PROVIDE THE FOLLOWING;                         <p>CONSTRUCTION</p> <ul style="list-style-type: none"> <li>. 16 GAUGE OR 14 GAUGE STEEL</li> <li>. SEAMS CONTINUOUSLY WELDED AND GROUND SMOOTH, NO HOLES OR KNOCKOUTS</li> <li>. CONTINUOUS HINGE</li> <li>. EXTERNAL SCREW CLAMPS</li> <li>. EXTERNAL MOUNTING FEET</li> <li>. OIL-RESISTANT GASKET AND ADHESIVE</li> <li>. SPECIFY SIDE TO BE HINGED WHEN ORDERING</li> </ul> <p>FINISH</p> <p>ANSI 61 GRAY POLYESTER POWER COATING INSIDE AND OUT OVER PHOSPHATIZED SURFACES.</p> <p>INDUSTRY STANDARDS</p> <ul style="list-style-type: none"> <li>UL 50 TYPE 12 AND TYPE 13</li> <li>NEMA/EEMAC TYPE 12 AND TYPE 13</li> <li>JIC STANDARD EGP-1-1967</li> <li>CSA TYPE 12</li> <li>IEC 529, IP65</li> </ul> </li> </ol>	<p>MDF MAIN DISTRIBUTION FRAME</p> <p>MM MULTIMODE FIBER</p> <p>N.I.C. NOT IN CONTRACT</p> <p>PR PAIR</p> <p>SM SINGLE MODE FIBER</p> <p>TGB TELECOMMUNICATIONS GROUND BUSBAR</p> <p>TMGB TELECOMMUNICATIONS MAIN GROUND BUSBAR</p> <p>IDF INTERMEDIATE DISTRIBUTION FRAME</p>
COMMUNICATION ROOM NUMBERS		
ARCHITECTURAL	CONSTRUCTION	
1-0006	IDFSP.1LL	




NO.	DESCRIPTION	DATE	BY
ISSUED FOR BID		10/19/01	

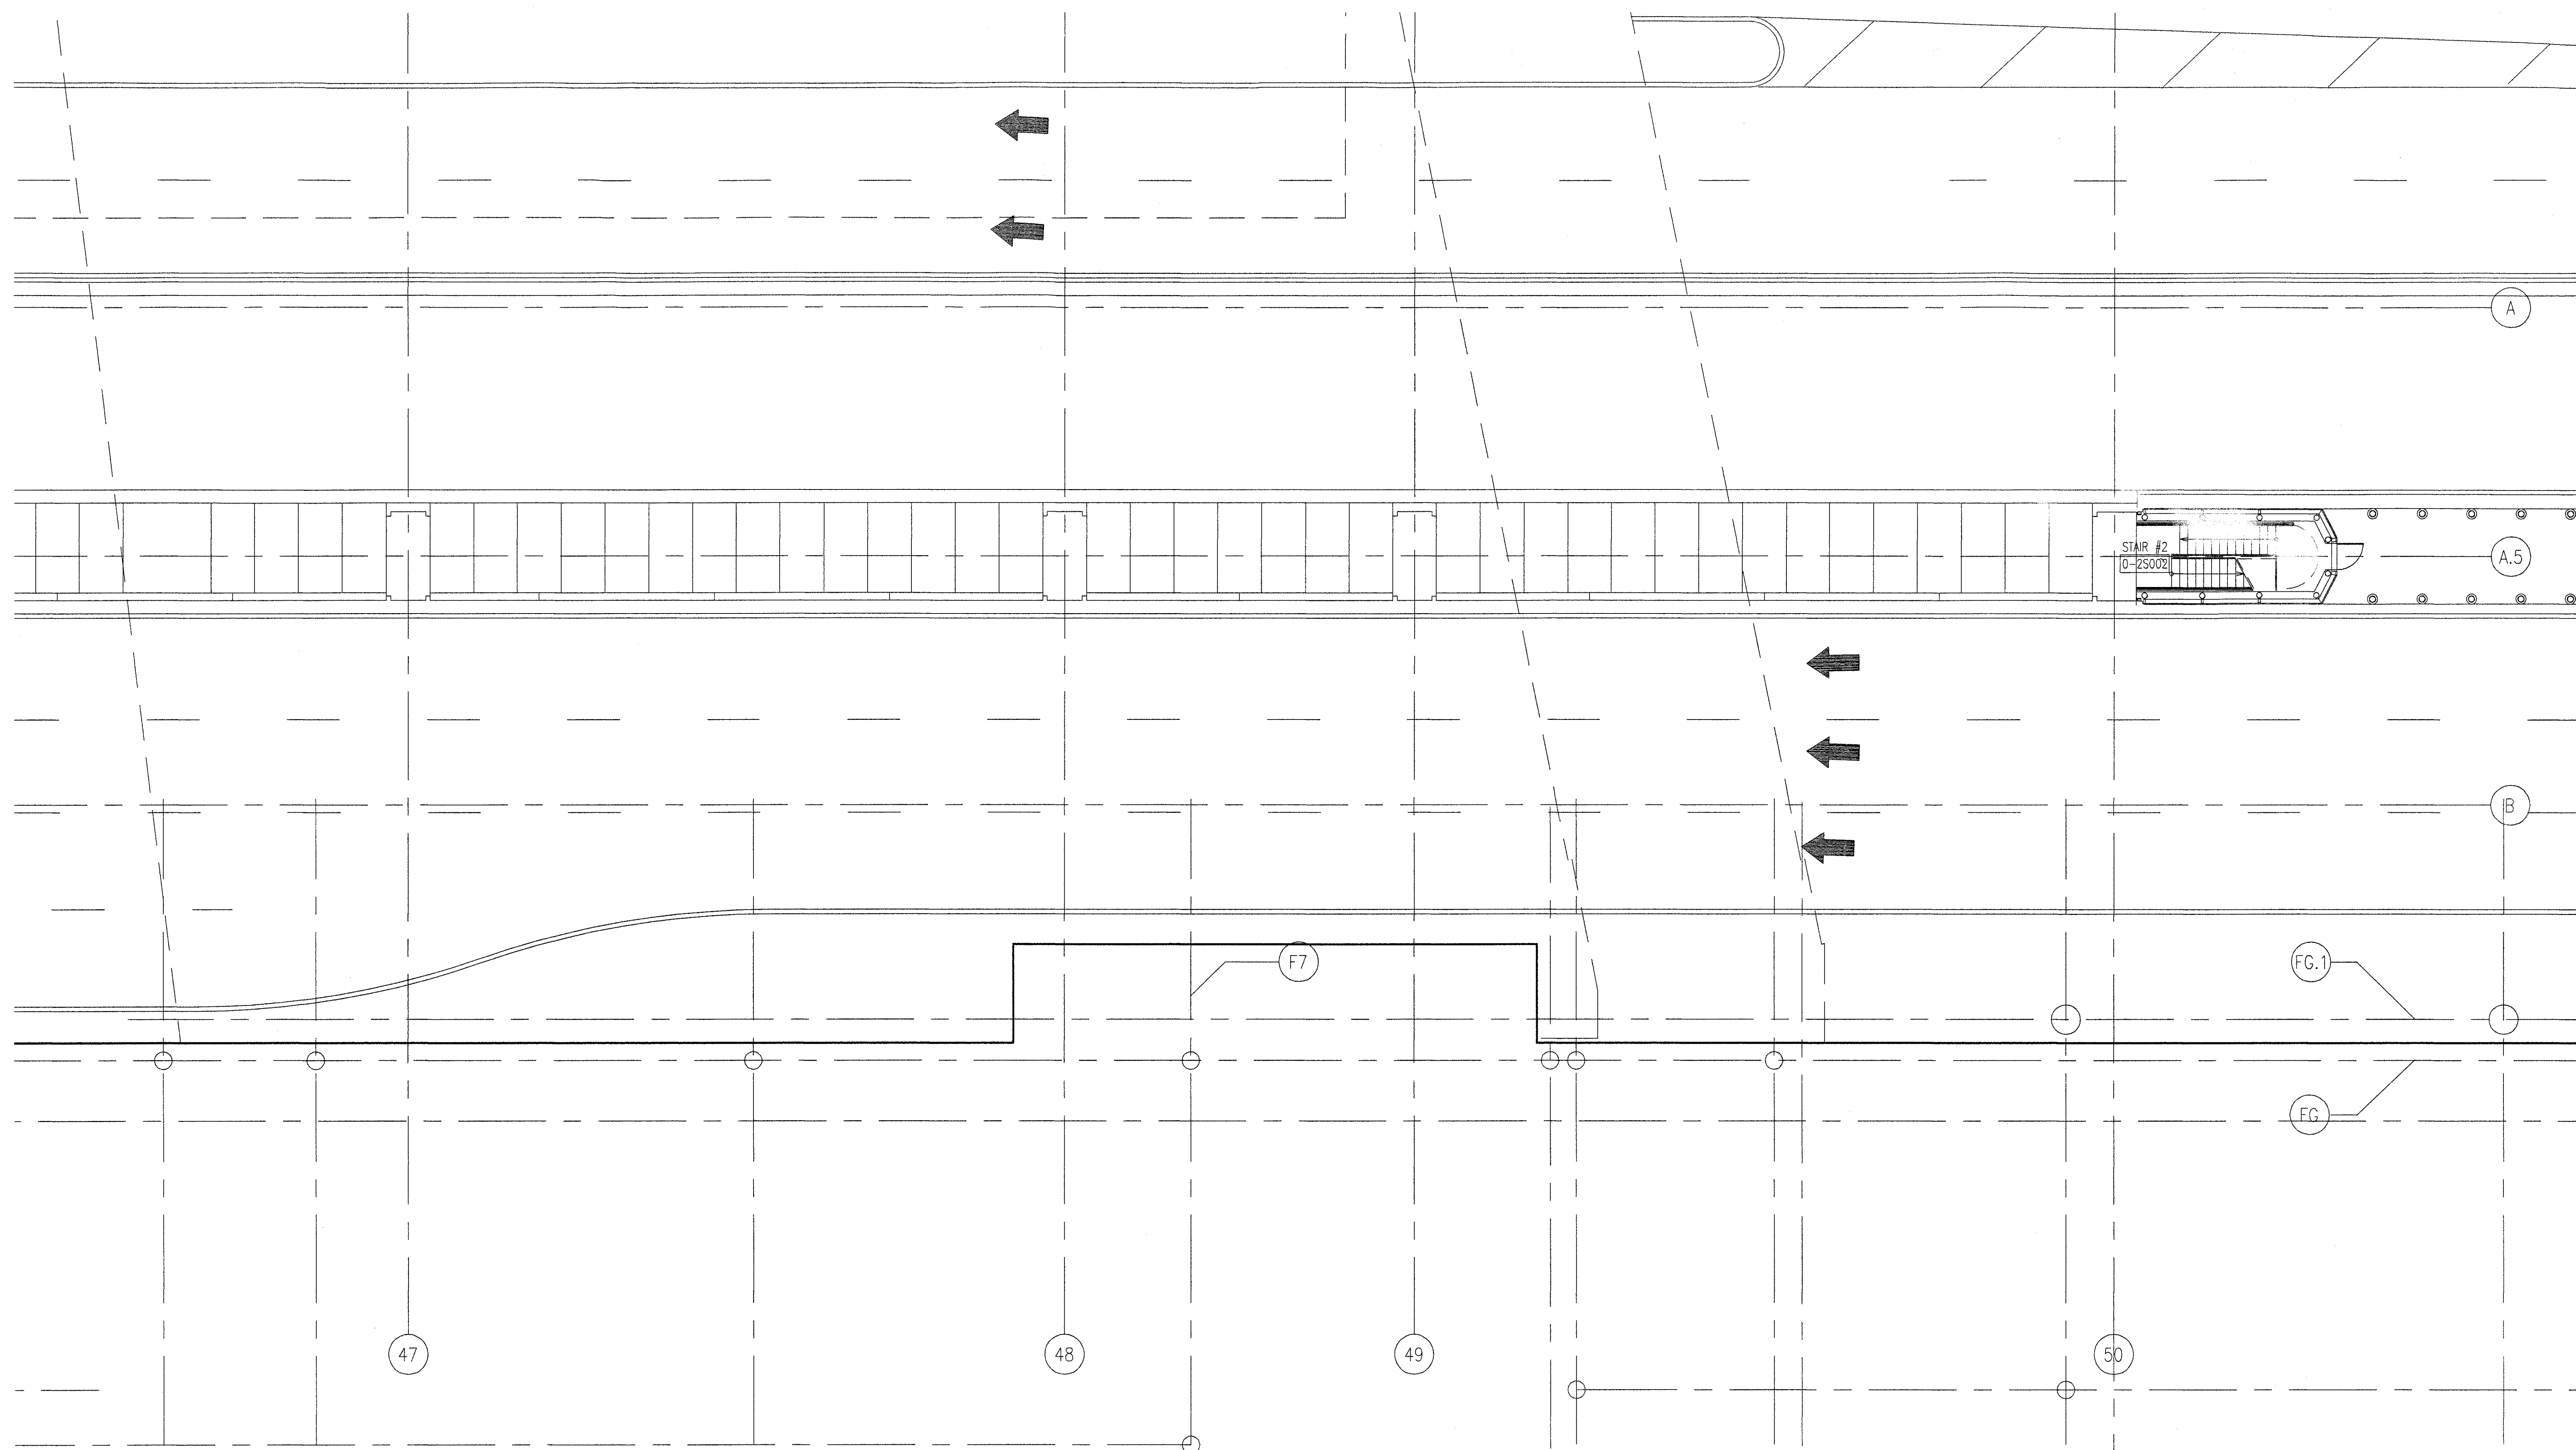

**GENERAL NOTES**

1) CONDUIT AND CABLE ROUTES DEPICTED HEREIN ARE RECOMMENDATIONS ONLY. ACTUAL ROUTES ARE TO BE DETERMINED BY CONTRACTOR AND APPROVED BY OWNER/OWNER REPRESENTATIVE.

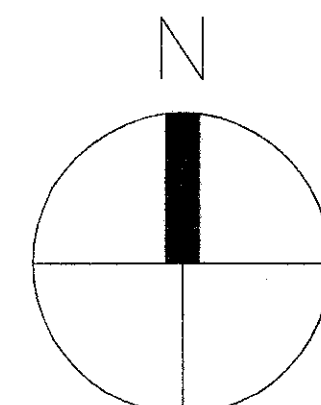

NOTE: REFER TO GRAPHIC SCALE IF ACTUAL SHEET SIZE IS OTHER THAN 30"x42".  
 0' 4' 8' 16' 24'  
 SCALE: 1/8" = 1'-0"

INTERNATIONAL • SERVICES • EXPANSION • PROGRAM  
**APM STATION + PLATFORM**  
 COMMUNICATIONS LAYOUT  
 GROUND FLOOR


PROJECT MGR:	HK
DESIGNER:	TL
DRAWN BY:	MP
CHECKED BY:	KW
DRAWING STANDARD:	
ISRP: 02.20.2000	
SCALE:	1/8"=1'-0"
DATE:	9/14/01

APPROVED BY:	DATE:
DIRECTOR	
HOUSTON AIRPORT SYSTEM	
PROJECT NO.	14H08
C.I.P. NO.	A-0384
M.A.S. NO.	538C
SHEET NO.	

**T2.000**

PLOT DATE: 10/19/01 HAS FILE: HASBC72000.DWG



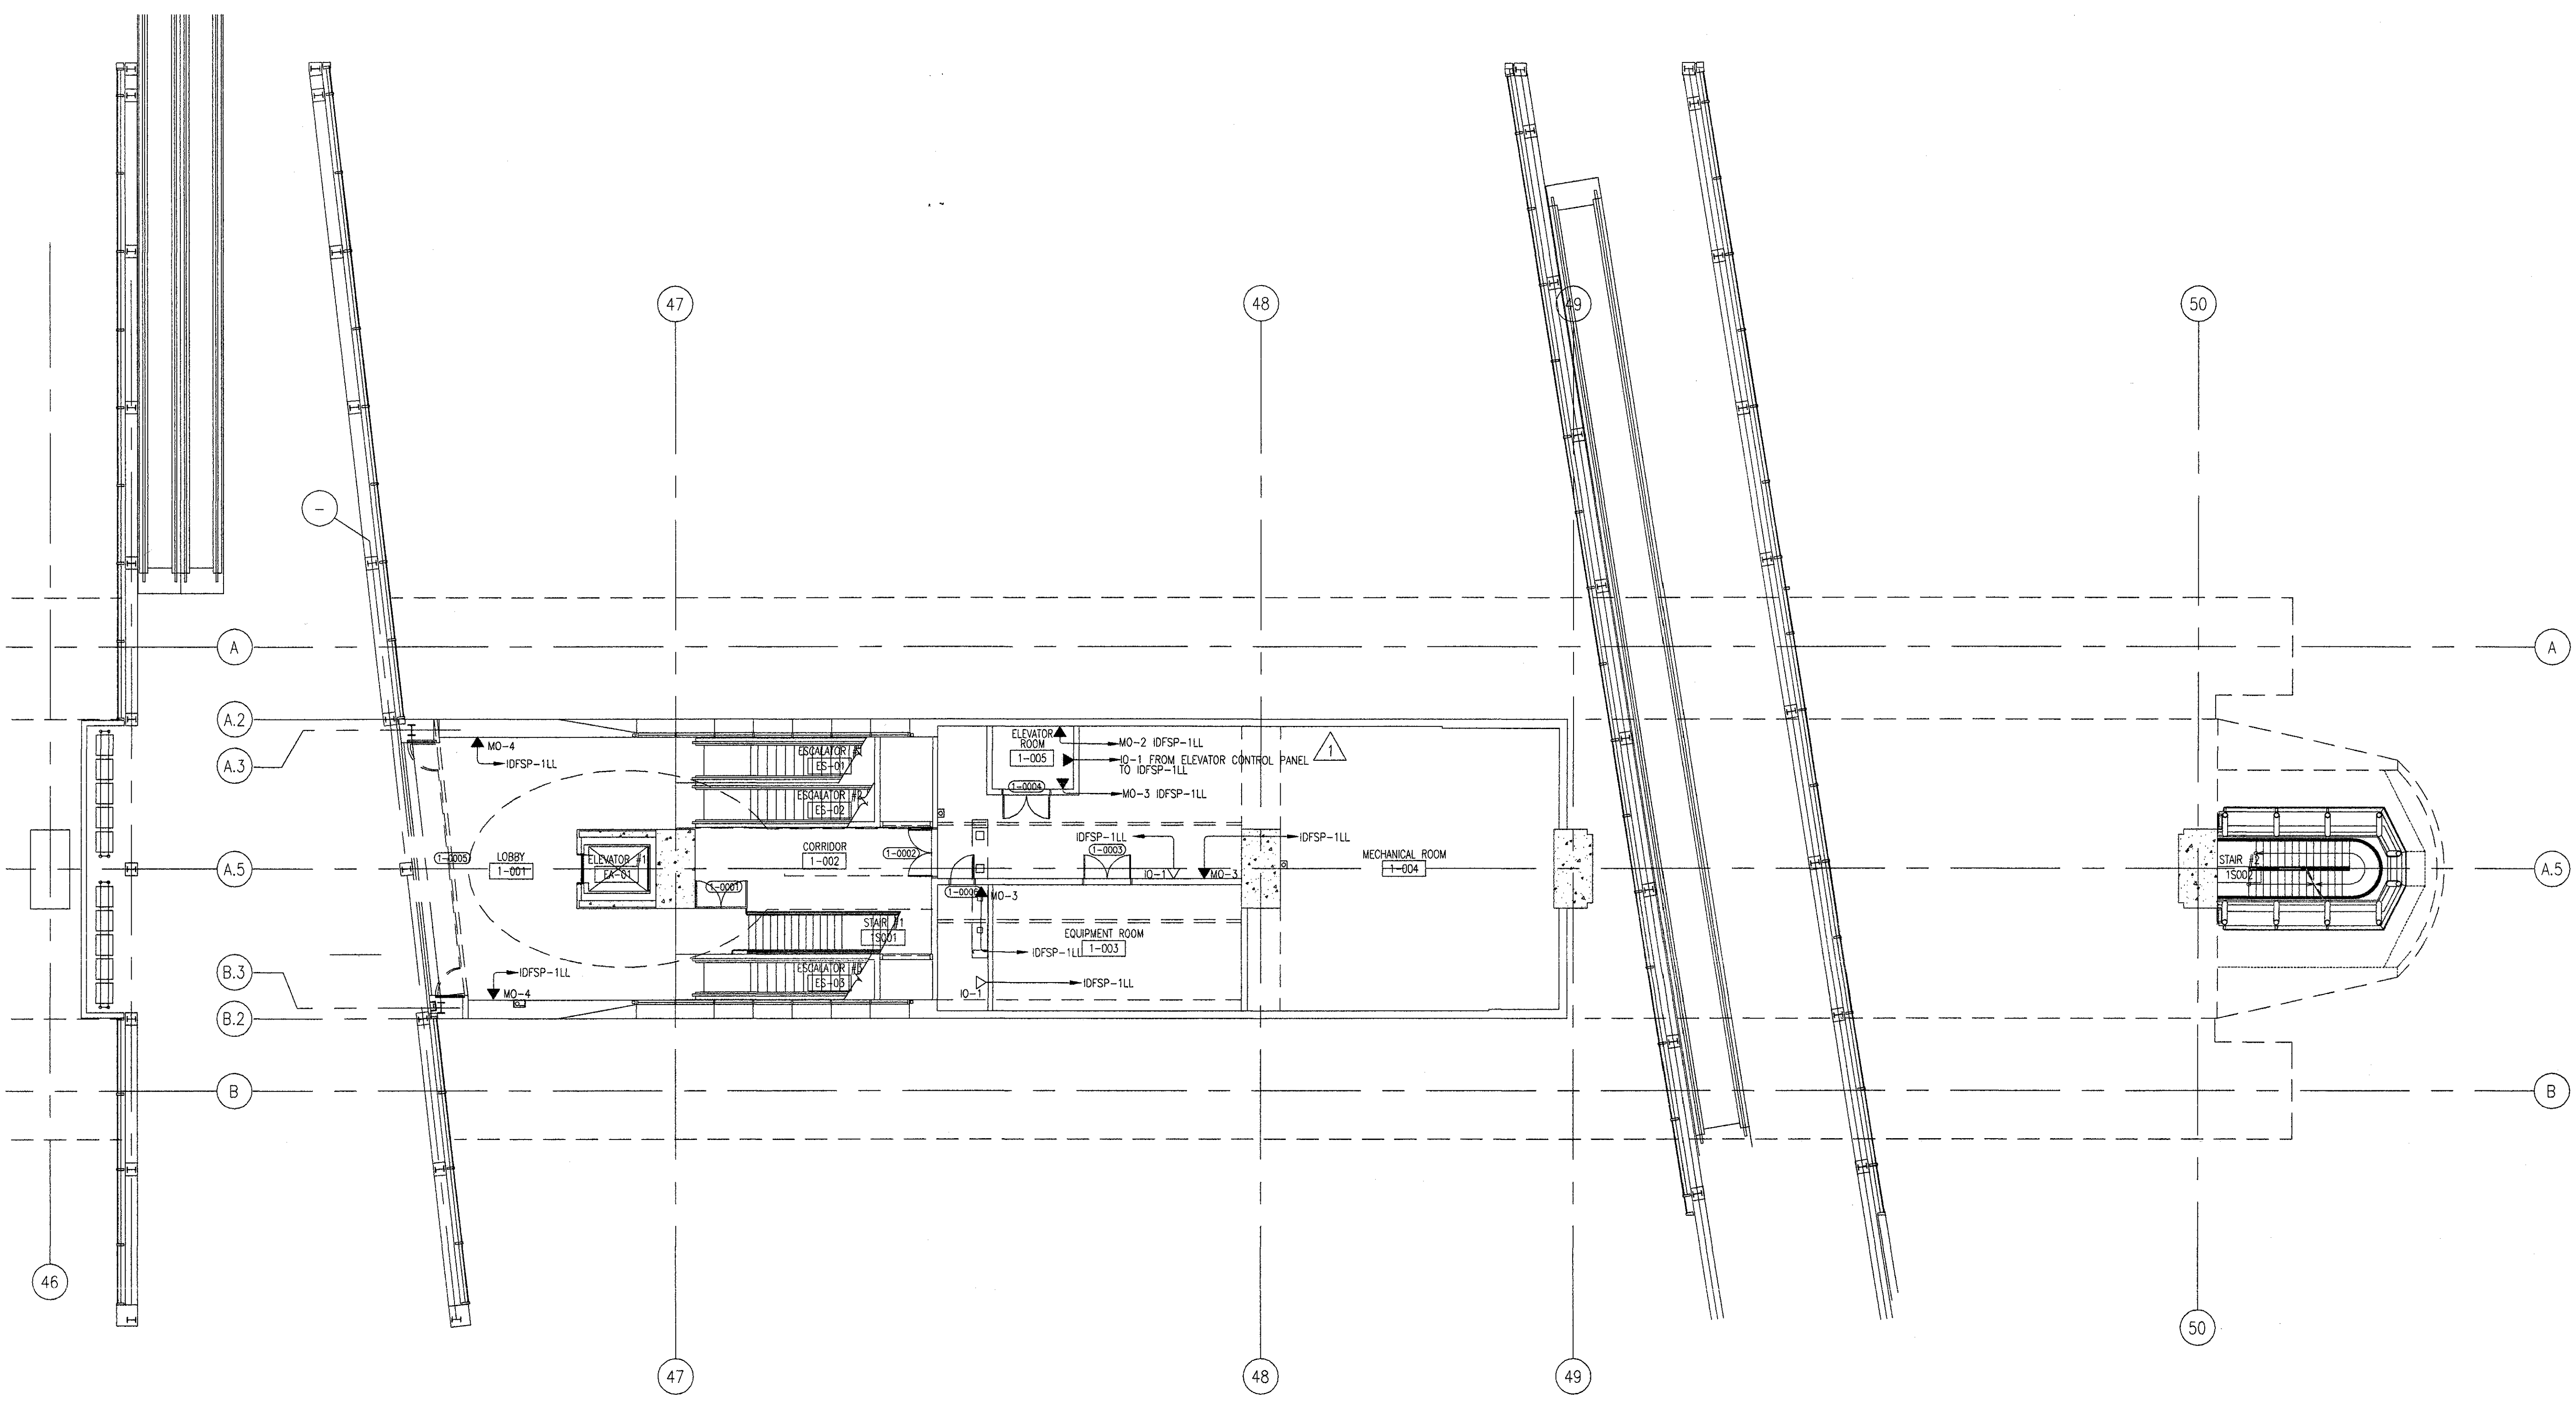

GENERAL NOTES

1) CONDUIT AND CABLE ROUTES DEPICTED HEREIN ARE RECOMMENDATIONS ONLY. ACTUAL ROUTES ARE TO BE DETERMINED BY CONTRACTOR AND APPROVED BY OWNER/OWNER REPRESENTATIVE.

**Houston Airport System**  
 GEORGE BUSH  
 INTERCONTINENTAL AIRPORT  
 HOUSTON TEXAS


**Ross & Baruzzini**  
 400 N. Sam Houston Pkwy. East, Suite 110  
 Houston, Texas 77060  
 Tel: 832.327.8888 • Fax: 832.327.8889

NO.	DESCRIPTION	DATE	BY
ISSUED FOR BID		10/19/01	
REVISION 1		04/13/04	RAB

INTERNATIONAL • SERVICES • EXPANSION • PROGRAM

**APM STATION + PLATFORM**  
 COMMUNICATIONS LAYOUT  
 LOBBY LEVEL

PROJECT MGR:	HK
DESIGNER:	TL
DRAWN BY:	MP
CHECKED BY:	KW
DRAWING STANDARD:	
ISEP STANDARD:	07.20.2000
SCALE:	1/8" = 1'-0"
DATE:	9/14/01

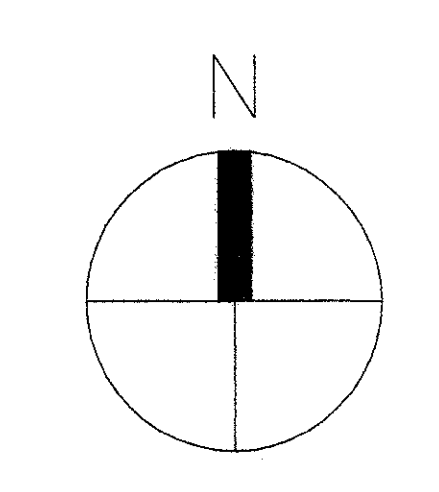

NOTE: REFER TO GRAPHIC SCALE IF ACTUAL SHEET SIZE IS OTHER THAN 30"x42".


SCALE: 1/8" = 1'-0"

APPROVED BY:	DATE:
DIRECTOR	HOUSTON AIRPORT SYSTEM
PROJECT NO.	IAH08
C.L.P. NO.	A-0354
H.A.S. NO.	S38C
SHEET NO.	T2.100

PLOT DATE: 10/19/01 HAS ELEAS38C12100.DWG




NO.	DESCRIPTION	DATE	BY
ISSUED FOR BID		10/18/01	
REVISION 1		04/13/04 R&B	

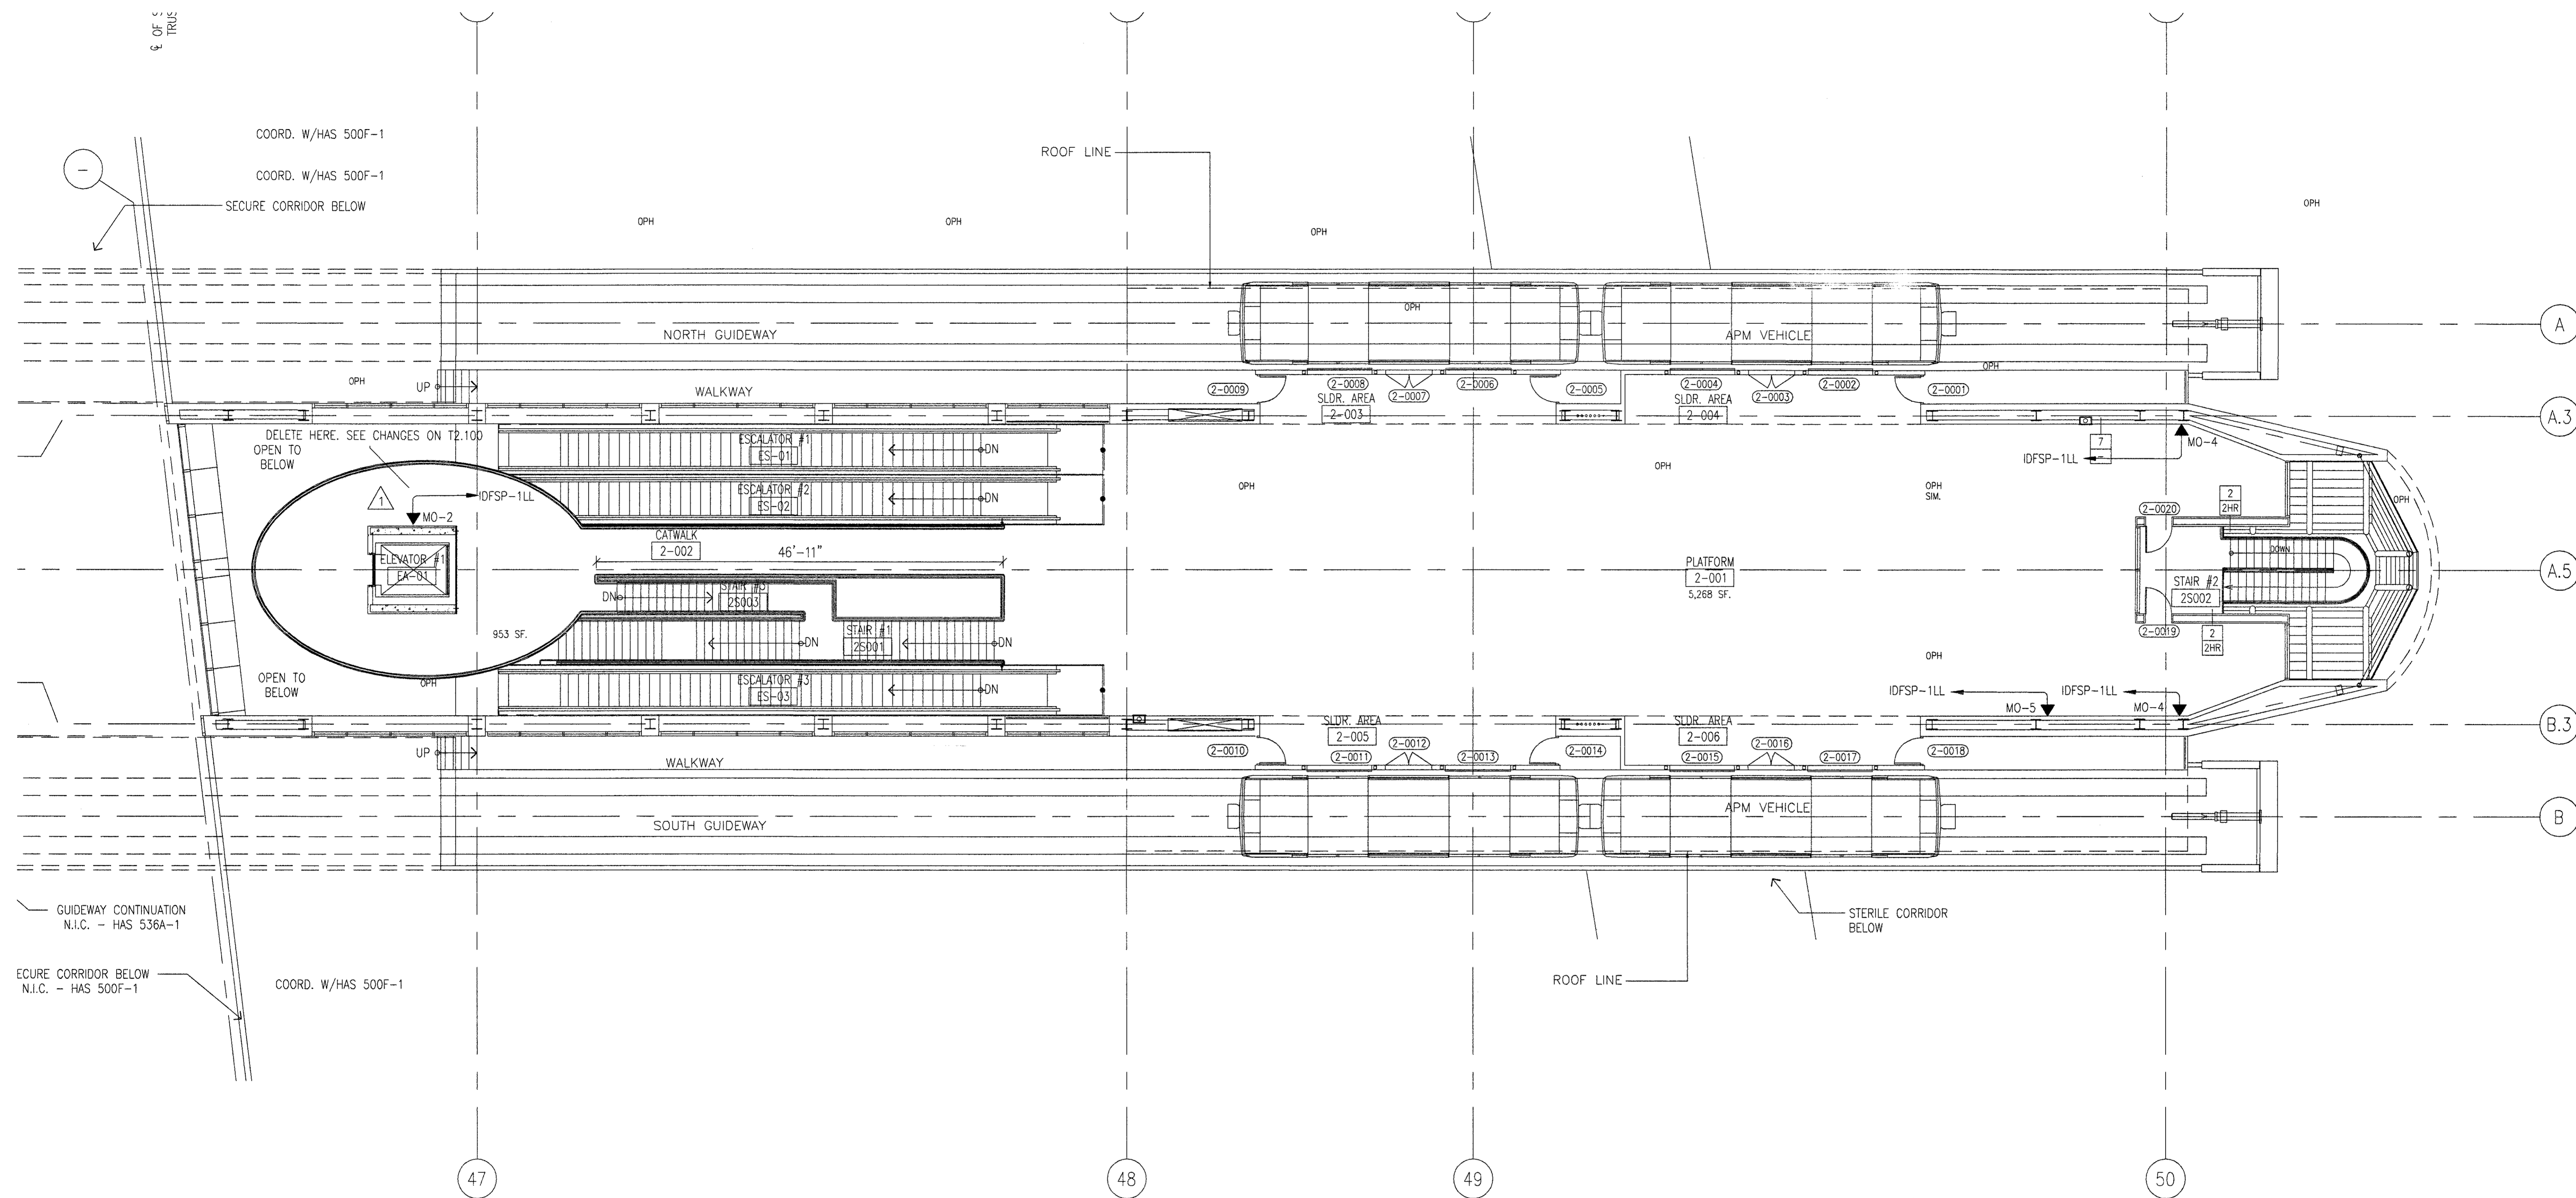

INTERNATIONAL SERVICES • EXPANSION • PROGRAM  
**APM STATION + PLATFORM**  
 COMMUNICATIONS PLATFORM LEVEL

**GENERAL NOTES**

1) CONDUIT AND CABLE ROUTES DEPICTED HEREIN ARE RECOMMENDATIONS ONLY. ACTUAL ROUTES ARE TO BE DETERMINED BY CONTRACTOR AND APPROVED BY OWNER/OWNER REPRESENTATIVE.

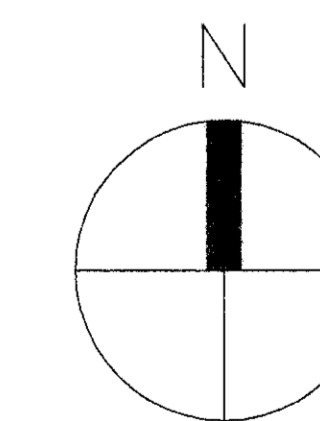

NOTE: REFER TO GRAPHIC SCALE IF ACTUAL SHEET SIZE IS OTHER THAN 30"x42".  
 0' 4' 8' 16' 24'  
 SCALE: 1/8" = 1'-0"

PROJECT MGR: HK  
 DESIGNER: TL  
 DRAWN BY: MP  
 CHECKED BY: KW  
 DRAWING STANDARD:

ISEP 07.20.2000  
 SCALE: 1/8"=1'-0"  
 DATE: 9/14/01

APPROVED BY: DATE:

DIRECTOR  
 HOUSTON AIRPORT SYSTEM  
 PROJECT NO. IAH08  
 C.I.P. NO. 0304  
 P.A.S. NO. 536C  
 SHEET NO.

T2.200



NO.	DESCRIPTION	DATE	BY
1	ISSUED FOR BID	10/19/01	

PROJECT MGR:	HK
DESIGNER:	TL
DRAWN BY:	MP
CHECKED BY:	KW
DRAWING STANDARD:	ISEP 07.20.2000
SCALE:	N.T.S.
DATE:	9/14/01

APPROVED BY: DATE:


PROJECT NO.	1AH06
C.I.P. NO.	A-0354
H.A.S. NO.	536C
SHEET NO.	

GENERAL NOTES


- OVERHEAD CABLE RACEWAY 8"-0" A.F.F. TO BOTTOM OF TRAY (LENGTH AS REQUIRED). REFER TO CABLE RACEWAY MOUNTING DETAILS 1 AND 3 ON SHEET T2.006.
- OVERHEAD CABLE RACEWAY SUSPENSION MOUNT EVERY 3'-0" ON CENTER. SEE DETAIL 2 ON SHEET T2.006.
- INSTALL ROUNDED CORNER BRACE AT ALL TURNS AND RACEWAY INTERSECTION POINTS.
- MOUNT EQUIPMENT CABINET TO FLOOR CENTERED UNDER CABLE RACEWAY AS SHOWN.
- INSTALL RACK MOUNTED OPTICAL FIBER PATCH PANEL. REFER TO DETAIL 4 ON SHEET T2.006 FOR FIBER POSITIONING REQUIREMENTS.
- CONDUIT AND CABLE ROUTES DEPICTED HEREIN ARE RECOMMENDATIONS ONLY. ACTUAL ROUTES ARE TO BE DETERMINED BY CONTRACTOR AND APPROVED BY OWNER/OWNER REPRESENTATIVE.

KEYED NOTES


- PROVIDE PLYWOOD ALL WALLS (TYPICAL)
  - 3/4 IN. FIRE RATED PLYWOOD
  - PAINTED TO MATCH W/FIRE RATED PAINT
  - PLYWOOD SHALL BE INSTALLED VERTICALLY (VERTICAL= 8 FT.) (HORIZONTAL= 4 FT.)
  - PLYWOOD SHALL BE INSTALLED AND BEGIN AT 9 IN. AFF (TOP OF PLYWOOD SHEET SHALL BE 8 FT. 9 IN. AFF)
  - PLYWOOD SHALL BE TRIMMED AND/OR CUT TO PROVIDE ALL WALL OUTLETS A FLUSH WALL FINISH
  - PLYWOOD SHALL BE TRIMMED AND/OR CUT TO PROVIDE OTHER HARDWARE PROPER SUPPORT
  - BE PROPERLY SECURED TO WALL FINISH MATERIAL AND WALL STUDS
  - ALL PLYWOOD SHALL HAVE A SEAM FINISH (MINIMUM EXPOSED/VISIBLE SEAM)
- TYPE 188 BUILDING ENTRANCE PROTECTORS;
  - 188ENA1-100G (110 WIRING BLOCK)
  - SOLID STATE WITH HEAT COILS (4C1S-TYPE)(BLACK (ONE FOR EACH PAIR OF EACH PROTECTOR MODULE)
- AIR CORE RISER CABLE 100 PAIR (TYPE-ARM)

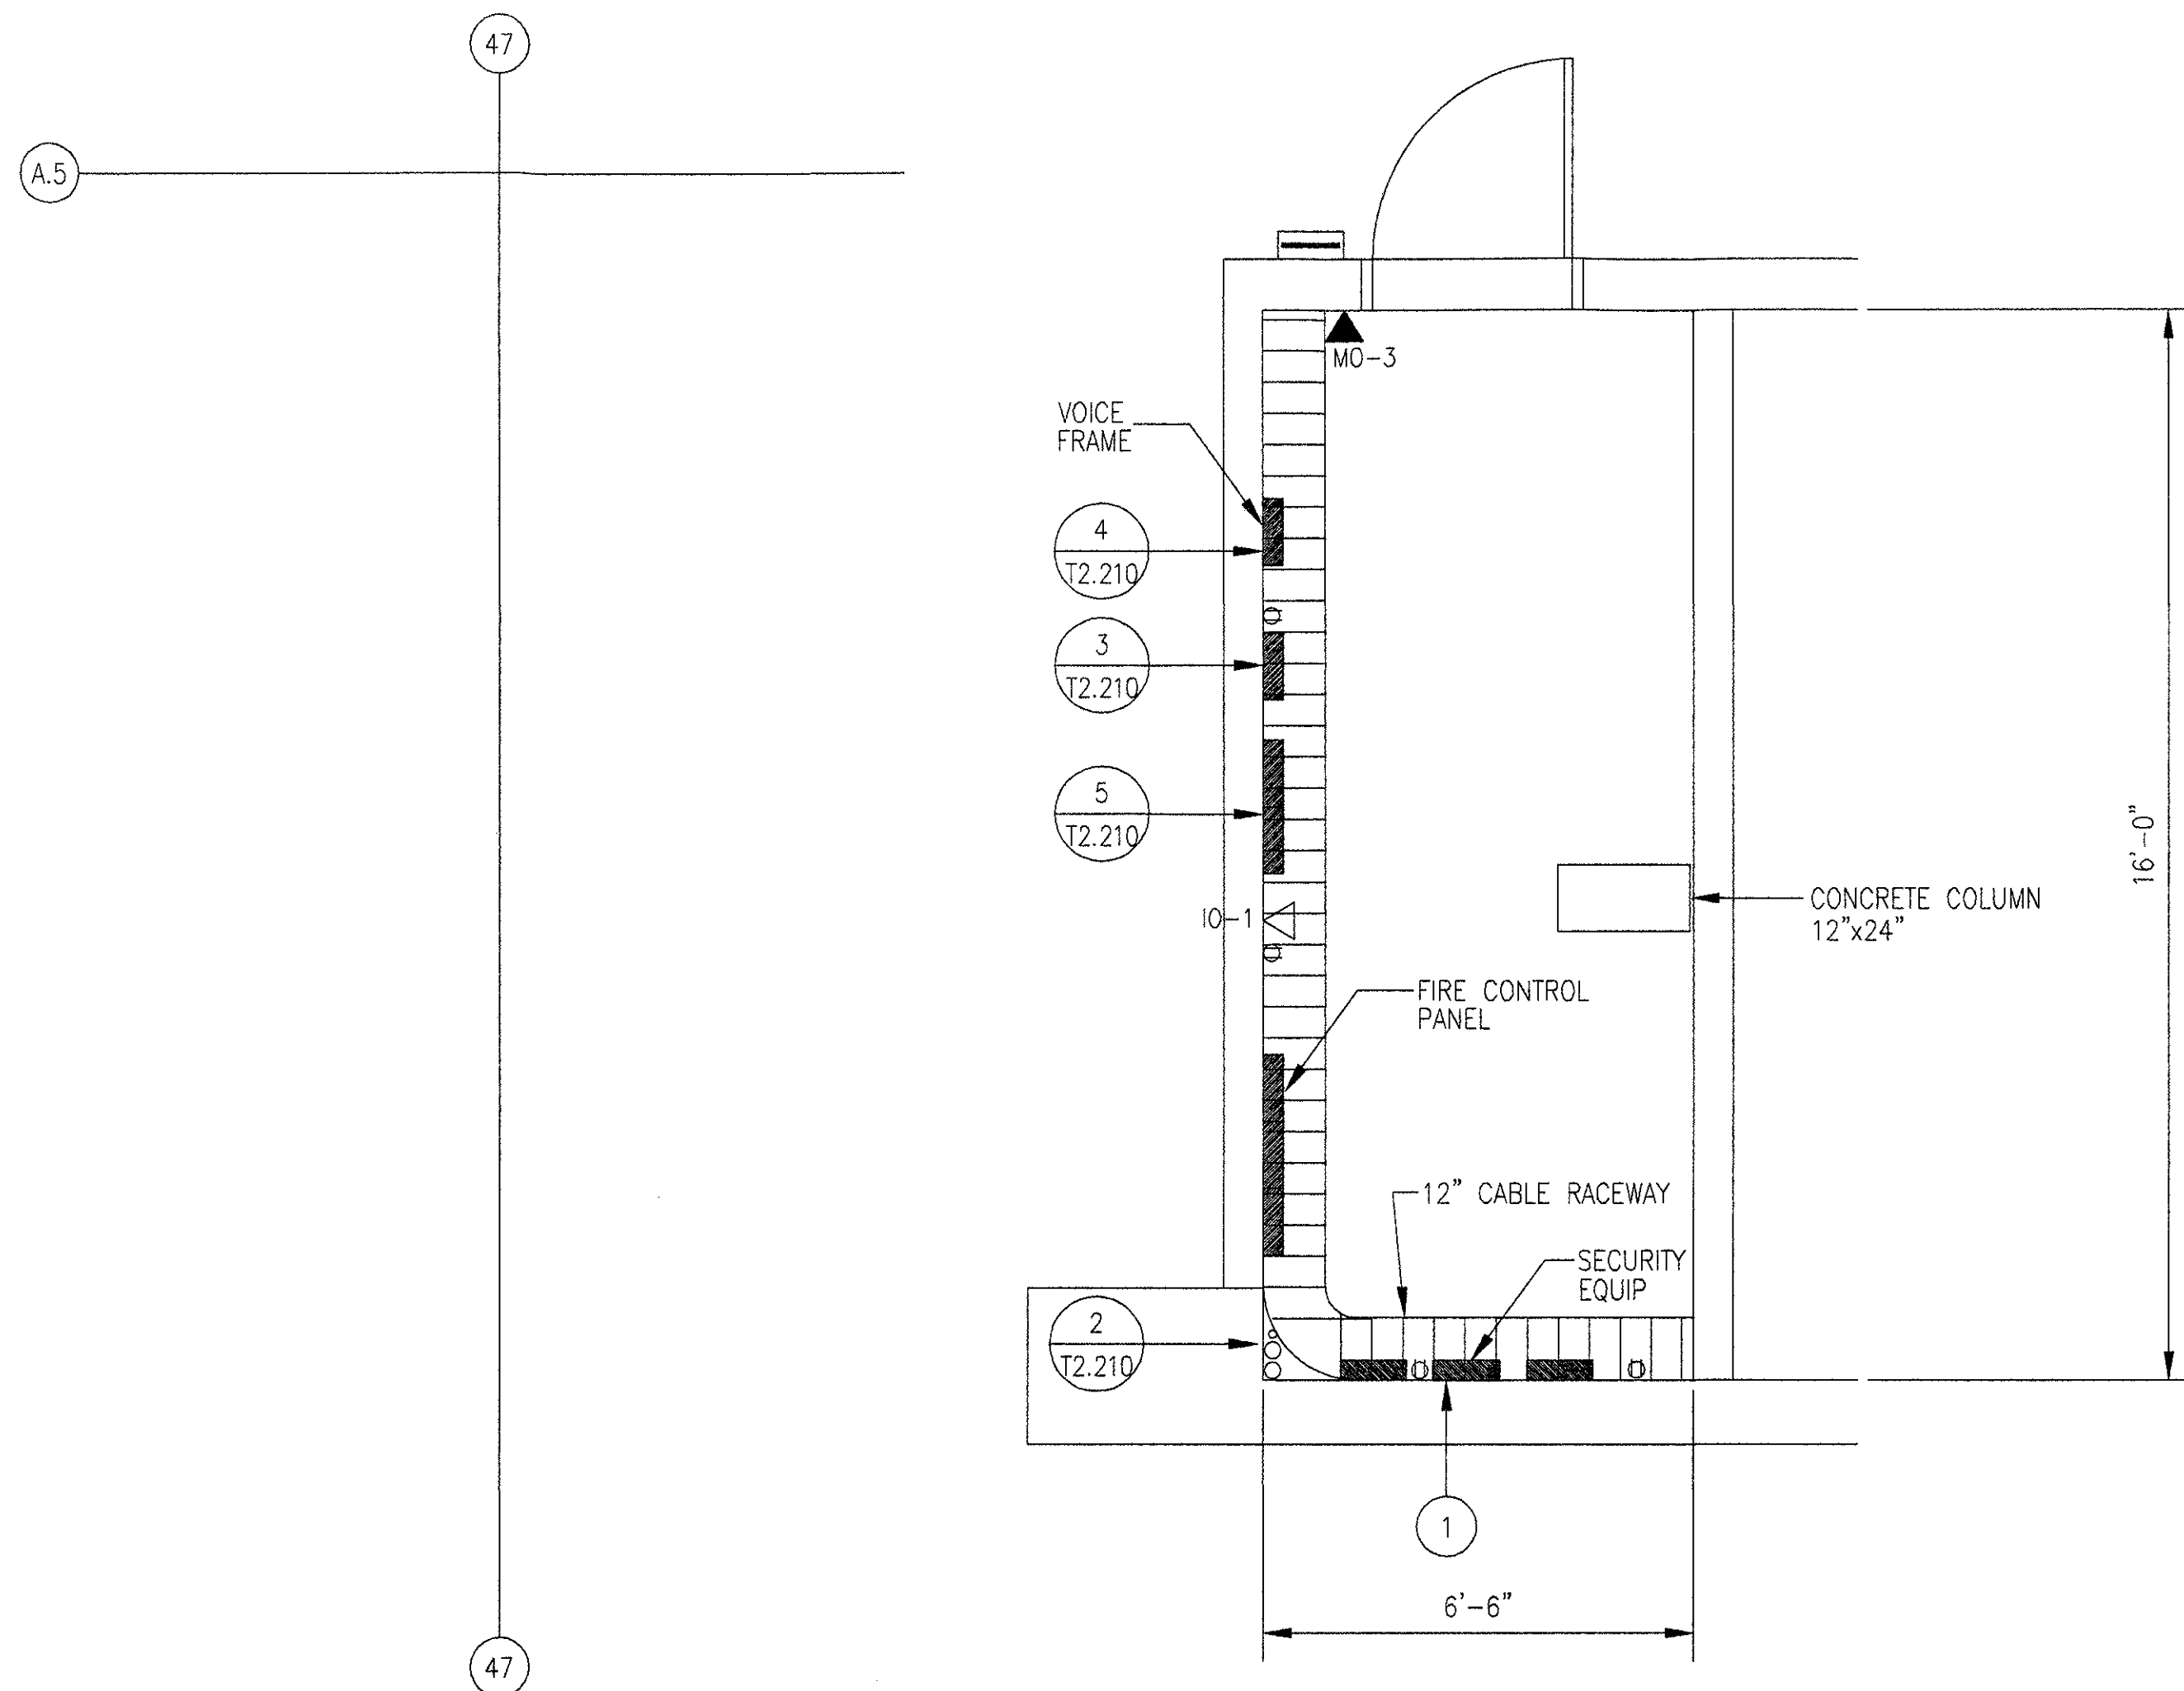


1 IDFSP.1LL (1-0006) CLOSET LAYOUT  
 NOT TO SCALE

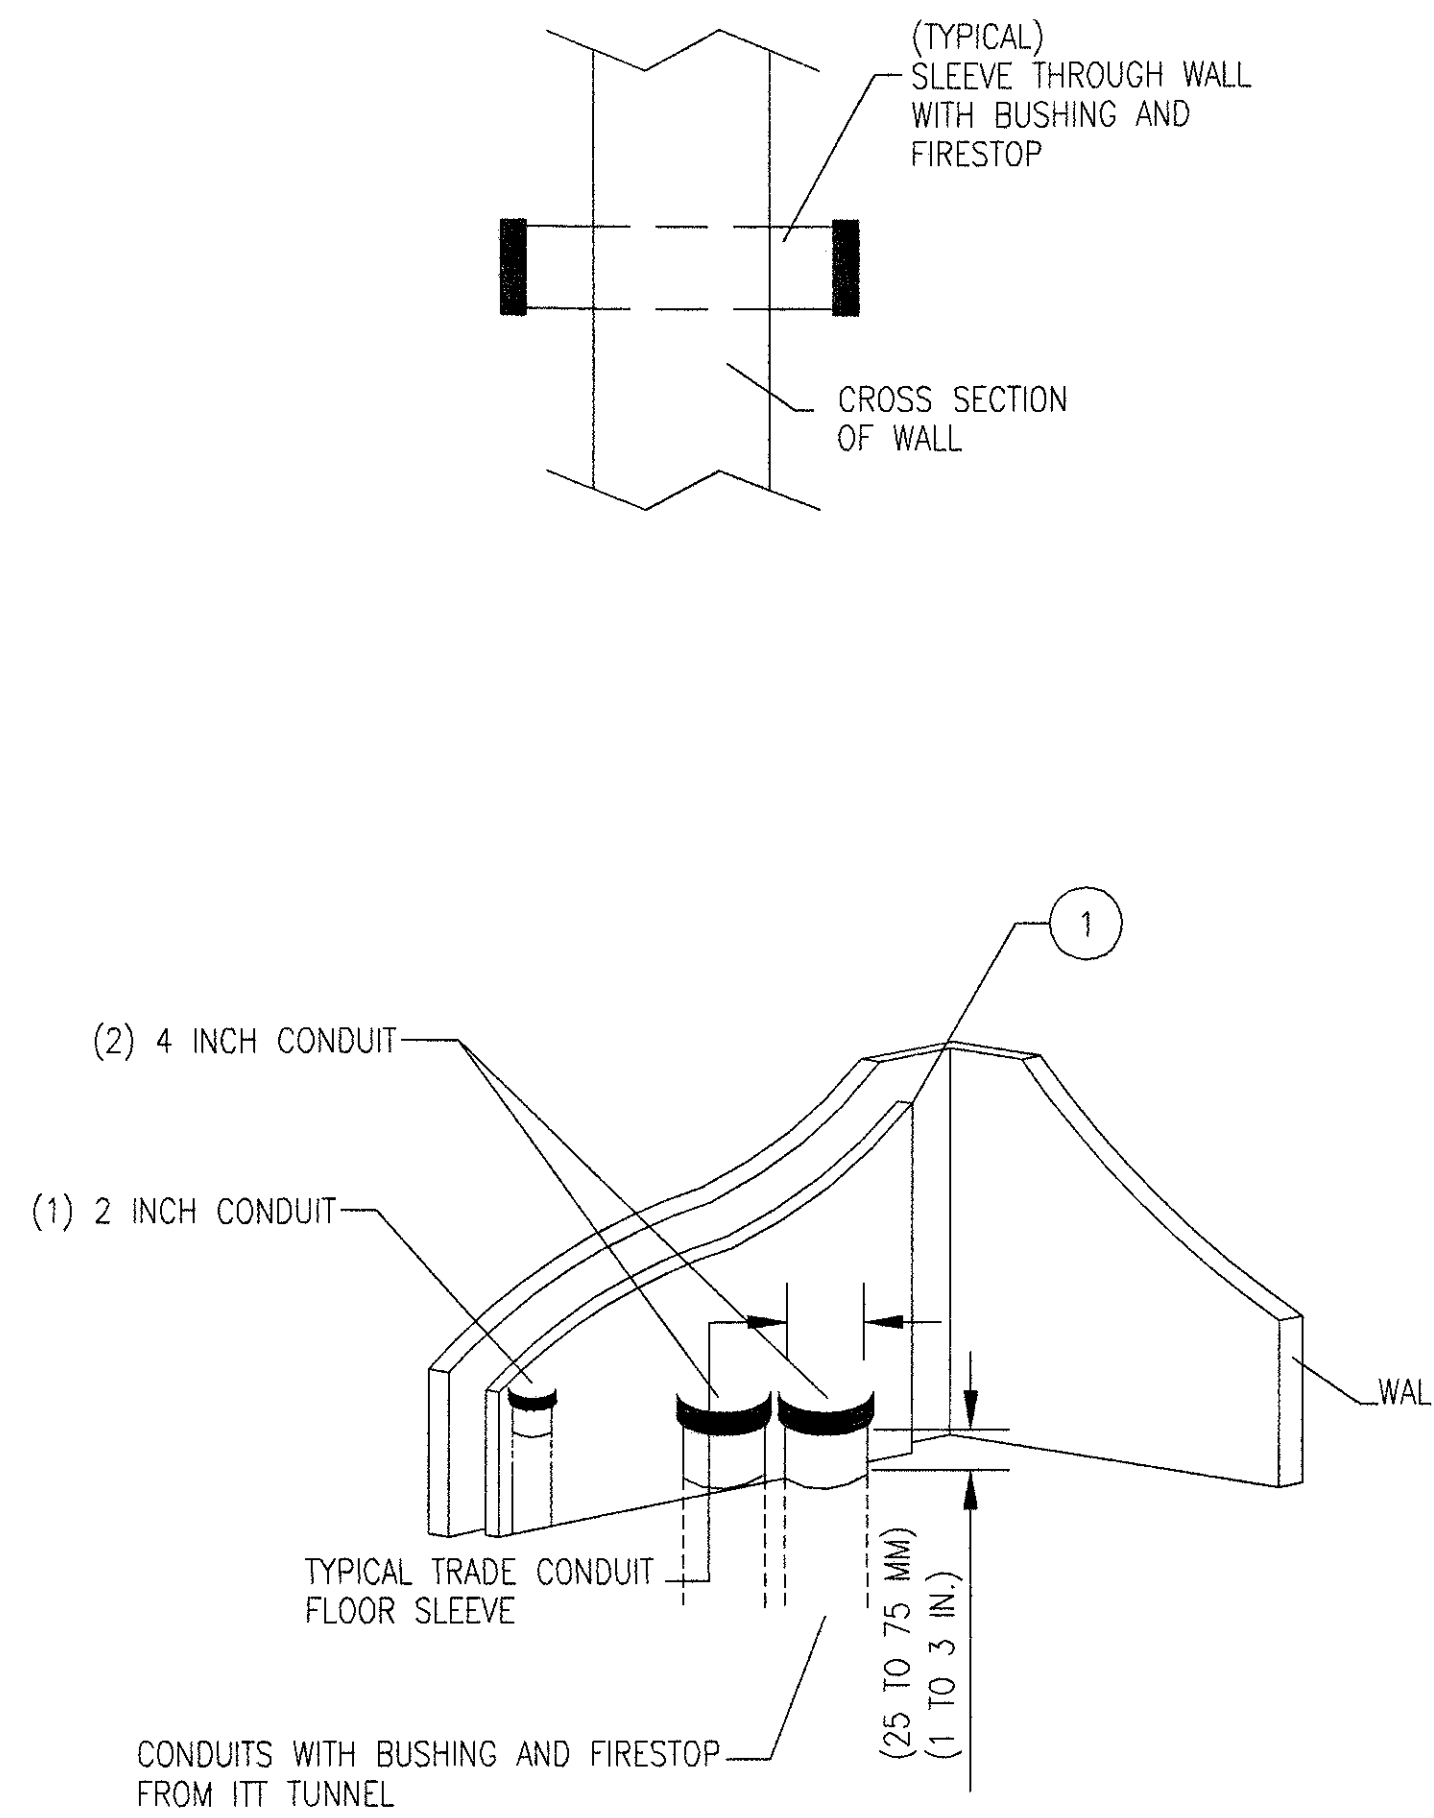

2 SLEEVE/CONDUIT DETAILS  
 NOT TO SCALE

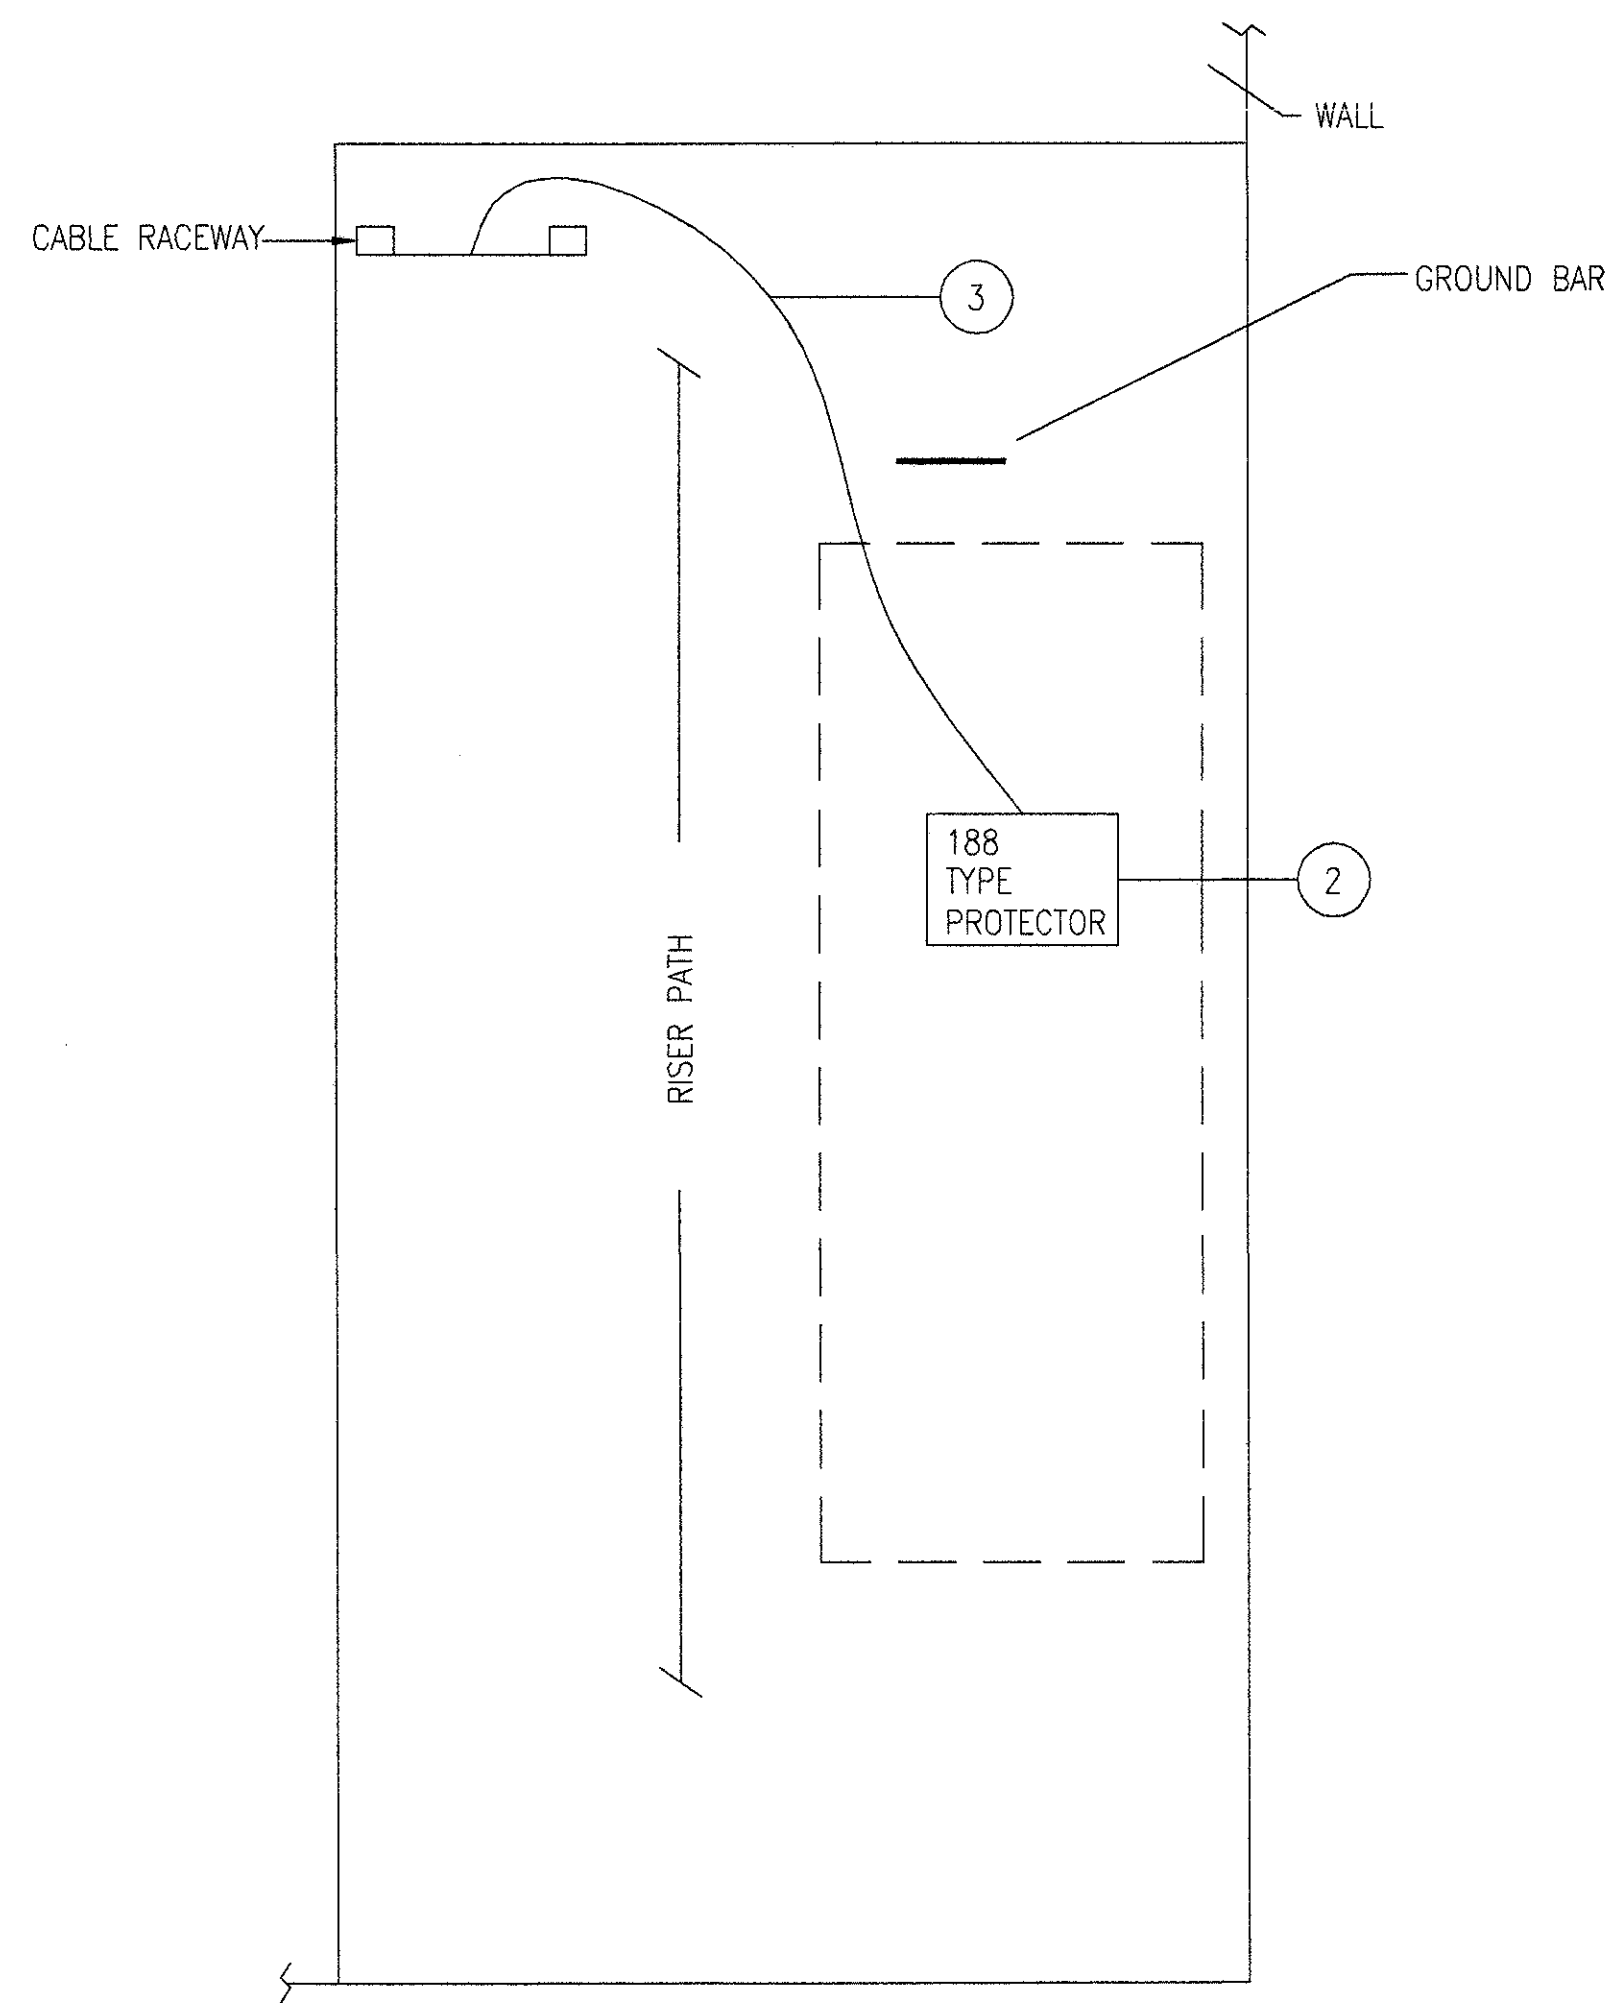


3 RISER BACKBOARD ELEVATION  
 NOT TO SCALE

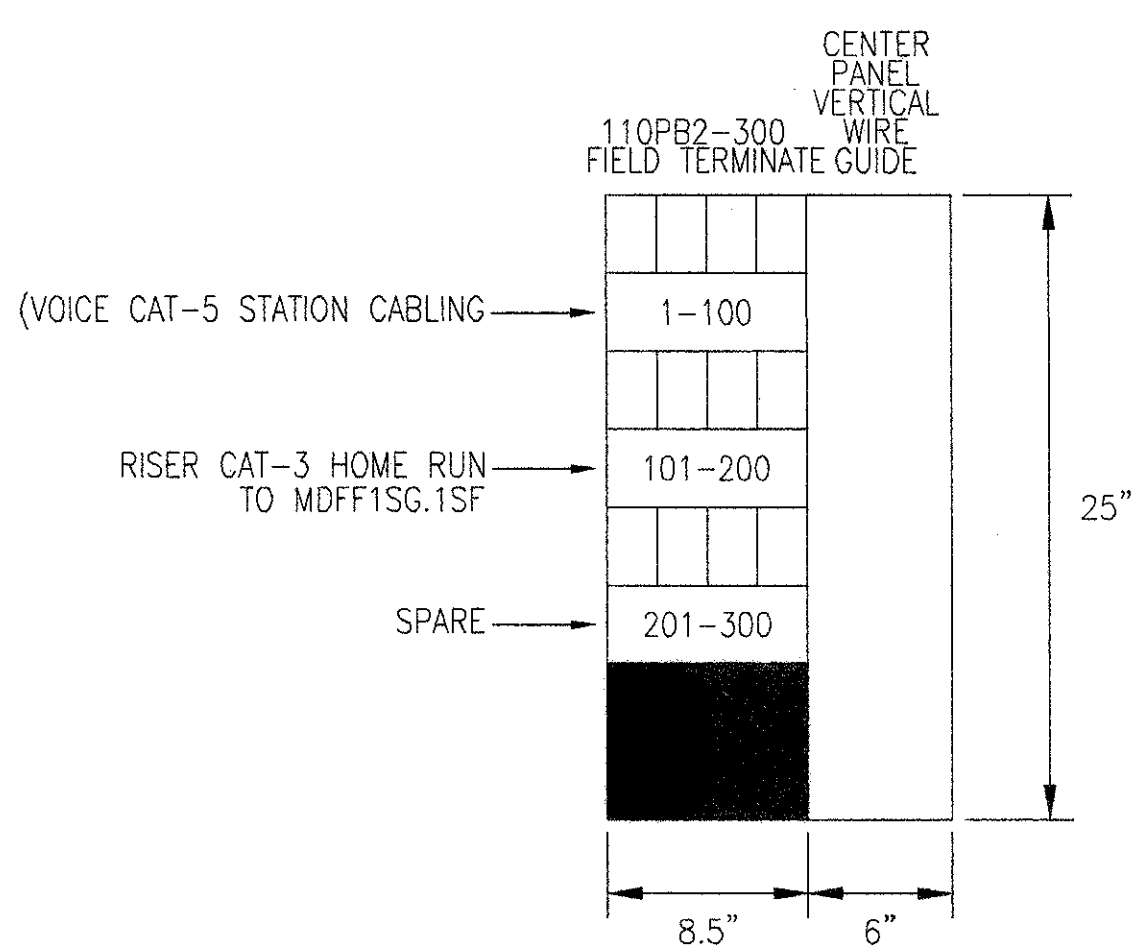

4 IDFSP.1LL (1-0006) COPPER TERMINATION LAYOUT  
 NTS

- MULTI-MODE FIBER LIU (FEEDER)  
 FIBER PORTS  
 1-12 (RISER) CABLING-HOME RUN FROM MDDF1S.1SF  
 13-24 SPARE
- SINGLE-MODE FIBER LIU (FEEDER)  
 FIBER PORTS  
 1-12 (RISER) CABLING HOME RUN FROM MDDF1S.1SF  
 13-24 FUTURE/SPARE
- SINGLE-MODE FIBER LIU (CAMERA'S)  
 FIBER PORTS  
 1-12 (FROM CAMERA'S) CABLING  
 13-24 FUTURE/SPARE
- DATA RJ-45 PATCH PANEL (24 PORT)  
 CAT-5 (DATA) STATION CABLING FROM EACH AREA

- NOTE:  
 SWING-FRAME WALL MOUNT ENCLOSURE-(INSIDE DIMENSIONS)
- 42" HIGH x 24" WIDE x 8" DEEP
  - (BODY-STEEL)(COLOR-GRAY)
  - WITH 120 DEGREE SWING-OUT RACK FRAMES
  - KEYED/LOCKABLE DOOR
  - WITH 19" RACK MOUNTING HARDWARE
  - WITH VERTICAL WIRE MANAGERS
  - WITH HORIZONTAL WIRE MANAGERS
  - DOOR TO OPEN AS SHOWN
  - INSTALL 12" AFF FROM THE BOTTOM OF THE ENCLOSURE
  - PROVIDE SIDE FEED CABLING ACCES HOLES
  - PROVIDE THE PROPER HOLE FITTINGS FOR ALL CABLING

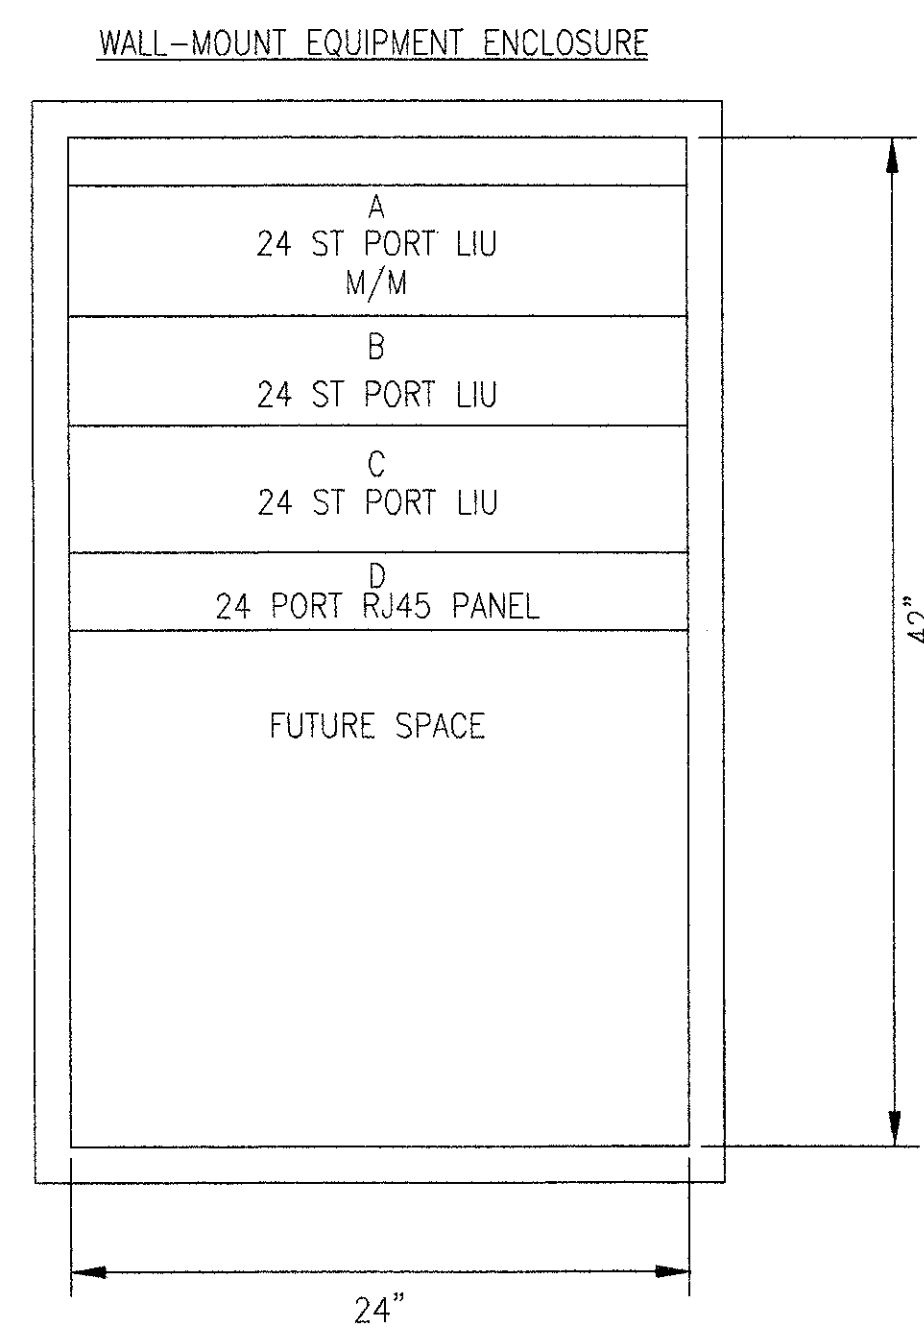

5 IDFSP.1LL (1-0006) FIBER TERMINATION LAYOUT  
 NTS







GENERAL NOTES

- 1) ALL CONDUCTORS AND CONNECTORS SHALL BE U.L. LISTED.
- 2) ALL #3/0 AWG INSULATED COPPER CONDUIT SHALL BE INSTALLED IN 1" CONDUIT.
- 3) ALL CONNECTIONS AND JOINTS SHALL BE EXOTHERMICALLY WELDED.
- 4) PROVIDE IN ALL TELECOMMUNICATIONS CLOSTES, MDF AND IDF ROOMS 51MM WIDE BY 6MM THICK BARE COPPER CONTINUOUS GROUND BUSBAR AROUND THE PERMETER OF EACH ROOM 9'-00" AFF.
- 5) EXOTHERMICALLY WELD ALL BUSBAR JOINTS, OFFSET FROM WALL 1"
- 6) ATTACH BUSBAR TO WALL STUDS AT 16" O/C WITH PROPER ANCHORING HARDWARE TO COMPLY WITH NEC CODE. REFER TO DETAIL SHEET.
- 7) ALL #3/0 AWG INSULATED COPPER CONDUCTOR SHALL BE EXOTHERMICALLY WELDED TO PERMETER GROUNDING BUSBAR.
- 8) #3/0 AWG INSULATED COPPER CONDUCTOR SHALL COMPLY WITH NEC CODE OF EXPOSURE FROM CONDUIT TO WELD.
- 9) #3/0 AWG INSULATED COPPER CONDUCTOR SHALL COMPLY WITH NEC CODE OF EXPOSURE FROM CONDUCTOR INSULATION TO WELD.
- 10) TYPICAL - ALL CONDUITS SHALL BE PROVIDED WITH GROUND BUSHINGS.
- 11) ALL CONDUITS, PIPES, DUCTS, AND OTHER CONDUCTIVE MATERIALS/HARDWARE SHALL BE BONDED TO THE GROUNDING BUSBAR WITH #6 AWG INSULATED COPPER CONDUCTOR WHERE THEY ENTER THE ROOM.
- 12) INSTALL #6 AWG INSULATED COPPER CONDUCTOR AND BOND TO EACH CABLE TRAY JOINT/SECTION/SPAN TO BUSBAR.
- 13) ALL #6 AWG INSULATED COPPER CONDUCTOR CONNECTING HARDWARE SHALL BE COPPER COMPRESSION CONNECTOR LUGS.
- 14) ALL PAINTED EQUIPMENT, HARDWARE, FRAMES, RACK, OR MATERIALS TO BE BONDED SHALL REQUIRE A ONE INCH SQUARE OF PROPER SAND CLEANING.
- 15) ALL CONDUCTIVE EQUIPMENT, HARDWARE, FRAMES, RACKS, CABINETS, AND MATERIALS SHALL BE BONDED WITH #6AWG INSULATED CONDUCTOR TO THE GROUNDING BUSBAR.
- 16) ALL TELECOMMUNICATION ROOM FOOTPRINTS AND LAYOUTS SHOWN ARE FOR ILLUSTRATION PURPOSES ONLY. THE TELECOMMUNICATION ROOM GROUNDING LAYOUTS ARE TO BE GOVERNED BY ROOM AND CABLE TRAY GEOMETRY.
- 17) CONDUIT AND CABLE ROUTES DEPICTED HEREIN ARE RECOMMENDATIONS ONLY. ACTUAL ROUTES ARE TO BE DETERMINED BY CONTRACTOR AND APPROVED BY OWNER/OWNER REPRESENTATIVE.


REVISIONS			
NO.	DESCRIPTION	DATE	BY
ISSUED FOR BID		10/19/01	

INTERNATIONAL • SERVICES • EXPANSION • PROGRAM  
**APM STATION + PLATFORM**  
 COMMUNICATION LAYOUT  
 GROUND RISER

PROJECT MGR:	HK
DESIGNER:	TL
DRAWN BY:	MP
CHECKED BY:	KW
DRAWING STANDARD:	ISEP 07.20.2000
SCALE:	N.T.S.
DATE:	9/14/01

APPROVED BY:	DATE:
DIRECTOR	HOUSTON AIRPORT SYSTEM
PROJECT NO.	1AM06
C.I.P. NO.	A-0354
H.A.S. NO.	538C
SHEET NO.	

30 T2.230

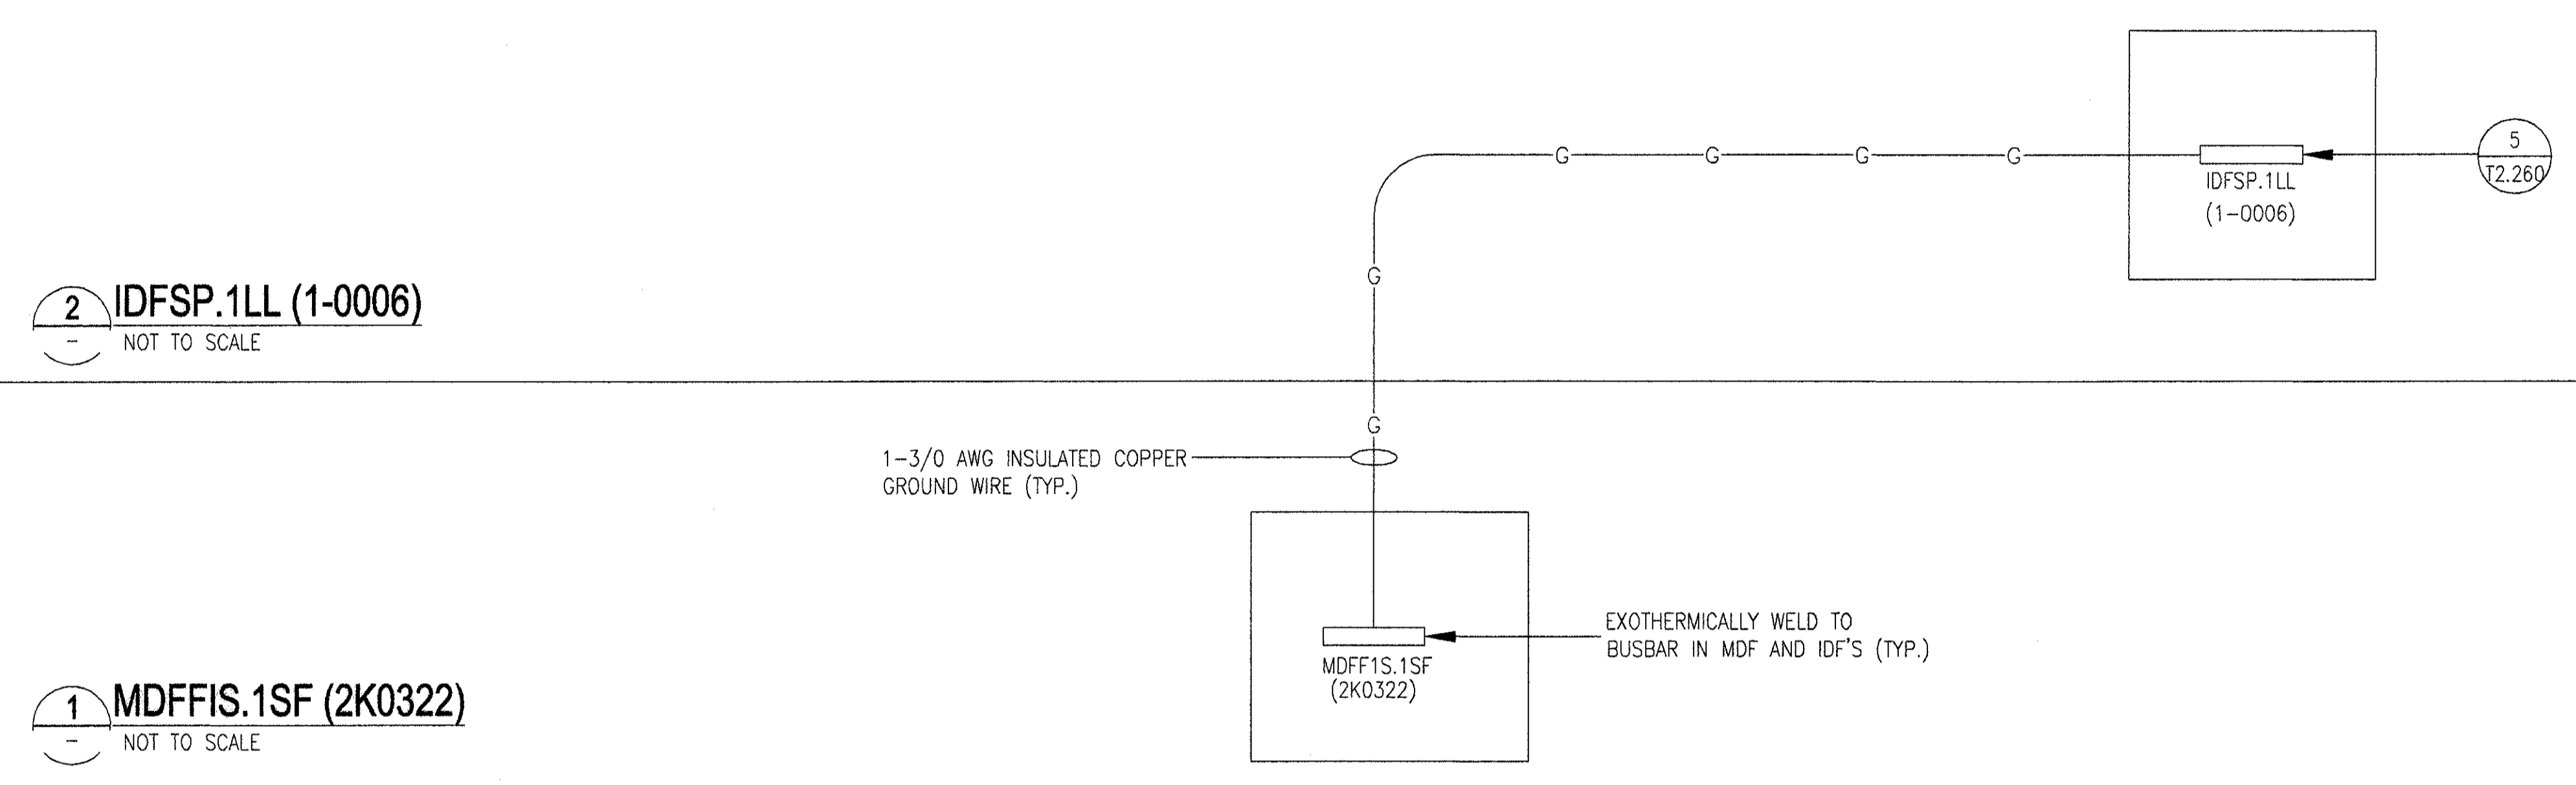

2 IDFSP.1LL (1-0006)  
 NOT TO SCALE

1 MDF1S.1SF (2K0322)  
 NOT TO SCALE



NO.	DESCRIPTION	DATE	BY
ISSUED FOR BID		10/19/01	

INTERNATIONAL • SERVICES • EXPANSION • PROGRAM  
**APM STATION + PLATFORM**  
 COMMUNICATION LAYOUT  
 COPPER AND FIBER RISER DIAGRAM

PROJECT MGR:	HK
DESIGNER:	TL
DRAWN BY:	MP
CHECKED BY:	XW
DRAWING STANDARD:	SEP 07.20.2000
SCALE:	N.T.S.
DATE:	9/14/01

APPROVED BY: \_\_\_\_\_ DATE: \_\_\_\_\_

DIRECTOR	HOUSTON AIRPORT SYSTEM
PROJECT NO.	1AH06
C.I.P. NO.	A-0354
H.A.S. NO.	536C
SHEET NO.	


31 T2.240

**GENERAL NOTES**

- 1) ALL CONDUIT SHALL BE U.L. RATED
- 2) ALL CONDUIT FITTINGS SHALL BE U.L. RATED
- 3) ALL CONDUIT FITTINGS SHALL COMPLY WITH "NEC" CODE
- 4) ALL CONDUIT FITTINGS SHALL BE ABLE TO PROVIDE A SECURE CONNECTION FOR PULLING LARGE COMMUNICATION CABLES
- 5) ALL CONDUITS SHALL BE PROVIDED WITH A "TRUE TAPE" PULL STRING
- 6) ALL CONDUITS SHALL BE PROPERLY LABELED AND LABEL LETTERING AND NUMBERING VISIBLE FROM FINISHED FLOOR
- 7) CONDUIT CROSSOVERS ARE NOT ACCEPTABLE
- 8) JUNCTION BOX/PULL BOXES SHALL PROVIDE THE FOLLOWING CONSTRUCTION:
  - A) 14 GAUGE STEEL AND LARGER
  - B) SEAMS CONTINUOUSLY WELDED AND GROUND SMOOTH
  - C) NO HOLES OR KNOCKOUTS
  - D) CONTINUOUS HINGE (WHERE POSSIBLE)
  - E) EXTERNAL SCREWS CLAMPS
  - F) EXTERNAL MOUNTING FEET
  - G) OIL-RESISTANT GASKET AND ADHESIVE
  - H) SPECIFY WHICH SIDE TO BE HINGED FINISH;
  - J) ANSI 61 GRAY POLYESTER POWER COATING INSIDE AND OUT OVER PHOSPHATIZED SURFACES
  - K) UL 50 TYPE 12 AND TYPE 13 LABELING;
  - L) PROVIDE THE PROPER AND VISABLE LABELING AT EACH JUNCTION AND PULL BOXES CONDUIT INSTALLATION;
- 9) JUNCTION BOX ENTRY SIDE - CONDUITS SHALL BE INSTALLED AND PROVIDE A SMOOTH RADIUS TO THE JUNCTION BOX EXIT SIDE.
- 10) ALL CONDUITS SHALL BE GALVANIZED RIGID STEEL TO THE "MDF" FROM OUTSIDE BUILDING LOCATIONS
- 11) FROM THE "MDF" TO THE REMAINING UPPER FLOORS A CONDUIT TRANSITION FROM GALVANIZED RIGID STEEL TO EMT SHALL COMPLY WITH "NEC" CODES
- 12) ALL MDF AND IDF ROOM CONDUIT ENTRIES SHALL BE PROVIDED WITH THE PROPER GROUNDING BUSHINGS
- 13) ALL CONDUITS SHALL BE GROUNDED TO THE MDF AND IDF GROUND BUSBAR
- 14) REFER TO THE GROUNDING DETAIL SHEETS
- 15) REFER TO THE MDF AND IDF LAYOUT SHEETS FOR ALL CONDUIT WALL ENTRY
- 16) ALL CONDUITS IN EACH ROOM SHALL BE INSTALLED IN A MANNER WHERE ALL FUTURE CABLING SHALL CONTINUE INTO THE CABLE TRAY/RUNWAY
- 17) CONDUITS TO CABLE TRAY/RUNWAY TRANSITION SHALL BE PROVIDED WITH RUNWAY DROP OUT/WATER FALL CABLE EXITS
- 18) A CONDUIT RUN/SPAN SHALL NOT EXCEED MORE THAN 270 DEGREES IN TOTAL BENDS
- 19) CONDUIT AND CABLE ROUTES DEPICTED HEREIN ARE RECOMMENDATIONS ONLY. ACTUAL ROUTES ARE TO BE DETERMINED BY CONTRACTOR AND APPROVED BY OWNER/OWNER REPRESENTATIVE.

**KEYED NOTES**

- ① FROM MDF1S.1SF (2K0322) TO IDFSP.1LL (1-0006)(HOME RUN) 1-50 PAIR CAT-3 RISER CABLE
- ② FROM MDF1S.1SF (2K0322) TO IDFSP.1LL (1-0006)(HOME RUN) 1-24 M/M FIBER CABLE (USE INNERDUCT "A")
- ③ FROM MDF1S.1SF (2K0322) TO IDFSP.1LL (1-0006)(HOME RUN) 1-24 S/M FIBER CABLE (USE INNERDUCT "C")

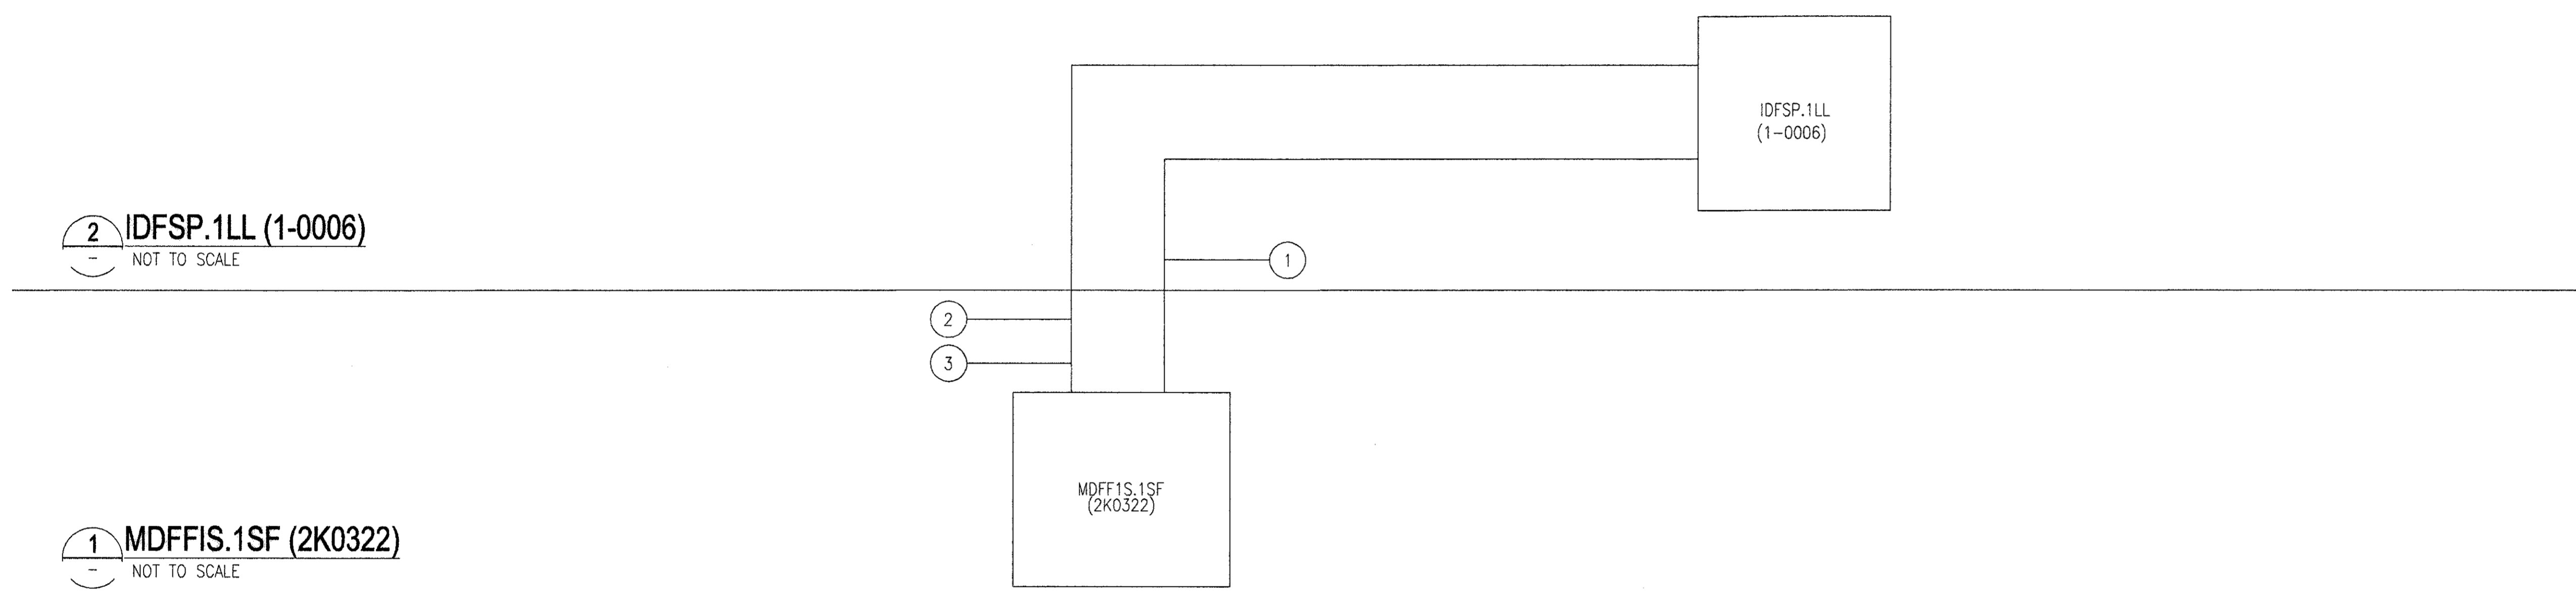

② IDFSP.1LL (1-0006)  
 NOT TO SCALE

① MDF1S.1SF (2K0322)  
 NOT TO SCALE



REVISIONS		
NO.	DESCRIPTION	DATE
1	ISSUED FOR BID	10/19/01

INTERNATIONAL • SERVICES • EXPANSION • PROGRAM  
**APM STATION + PLATFORM**  
 COMMUNICATION LAYOUT  
 CONDUIT RISER DIAGRAM

PROJECT MGR:	HK
DESIGNER:	TL
DRAWN BY:	MP
CHECKED BY:	KW
DRAWING STANDARD:	ISEP 07.20.2000
SCALE:	N.T.S.
DATE:	9/14/01

APPROVED BY: \_\_\_\_\_ DATE: \_\_\_\_\_

DIRECTOR  
 HOUSTON AIRPORT SYSTEM

PROJECT NO. IA106

C.I.P. NO. A-0354

H.A.S. NO. 538C

SHEET NO.

30 T2.250

**GENERAL NOTES**


- 1) ALL CONDUIT SHALL BE U.L. RATED
- 2) ALL CONDUIT FITTINGS SHALL BE U.L. RATED
- 3) ALL CONDUIT FITTINGS SHALL COMPLY WITH "NEC" CODE
- 4) ALL CONDUIT FITTINGS SHALL BE ABLE TO PROVIDE A SECURE CONNECTION FOR PULLING LARGE COMMUNICATION CABLES
- 5) ALL CONDUITS SHALL BE PROVIDED WITH A "TRUE TAPE" PULL STRING
- 6) ALL CONDUITS SHALL BE PROPERLY LABELED AND LABEL LETTERING AND NUMBERING VISIBLE FROM FINISHED FLOOR
- 7) CONDUIT CROSSOVERS ARE NOT ACCEPTABLE
- 8) JUNCTION BOX/PULL BOXES SHALL PROVIDE THE FOLLOWING CONSTRUCTION:
  - A) 14 GAUGE STEEL AND LARGER
  - B) SEAMS CONTINUOUSLY WELDED AND GROUND SMOOTH
  - C) NO HOLES OR KNOCKOUTS
  - D) CONTINUOUS HINGE (WHERE POSSIBLE)
  - E) EXTERNAL SCREWS CLAMPS
  - F) EXTERNAL MOUNTING FEET
  - G) OIL-RESISTANT GASKET AND ADHESIVE
  - H) SPECIFY WHICH SIDE TO BE HINGED FINISH;
  - J) ANSI 61 GRAY POLYESTER POWER COATING INSIDE AND OUT OVER PHOSPHATIZED SURFACES INDUSTRY STANDARDS;
  - K) UL 50 TYPE 12 AND TYPE 13 LABELING;
- L) PROVIDE THE PROPER AND VISABLE LABELING AT EACH JUNCTION AND PULL BOXES CONDUIT INSTALLATION;
- M) JUNCTION BOX ENTRY SIDE - CONDUITS SHALL BE INSTALLED AND PROVIDE A SMOOTH RADIUS TO THE JUNCTION BOX EXIT SIDE.
- 9) ALL CONDUITS SHALL BE GALVANIZED RIGID STEEL TO THE "MDF" FROM OUTSIDE BUILDING LOCATIONS
- 10) FROM THE "MDF" TO THE REMAINING UPPER FLOORS A CONDUIT TRANSITION FROM GALVANIZED RIGID STEEL TO EMT SHALL COMPLY WITH "NEC" CODES
- 11) ALL MDF AND IDF ROOM CONDUIT ENTRIES SHALL BE PROVIDED WITH THE PROPER GROUNDING BUSHINGS
- 12) ALL CONDUITS SHALL BE GROUNDED TO THE MDF AND IDF GROUND BUSBAR
- 13) REFER TO THE GROUNDING DETAIL SHEETS
- 14) REFER TO THE MDF AND IDF LAYOUT SHEETS FOR ALL CONDUIT WALL ENTRY
- 15) ALL CONDUITS IN EACH ROOM SHALL BE INSTALLED IN A MANNER WHERE ALL FUTURE CABLING SHALL CONTINUE INTO THE CABLE TRAY/RUNWAY
- 16) CONDUITS TO CABLE TRAY/RUNWAY TRANSITION SHALL BE PROVIDED WITH RUNWAY DROP OUT/WATER FALL CABLE EXITS
- 17) A CONDUIT RUN/SPAN SHALL NOT EXCEED MORE THAN 270 DEGREES IN TOTAL BENDS
- 18) CONDUIT AND CABLE ROUTES DEPICTED HEREIN ARE RECOMMENDATIONS ONLY. ACTUAL ROUTES ARE TO BE DETERMINED BY CONTRACTOR AND APPROVED BY OWNER/OWNER REPRESENTATIVE.

**KEYED NOTES**

- ① STANDARD 4IN. EMT CONDUIT (WITHOUT INNERDUCT) FROM "IDF" FLOOR TO "CONDUIT JUNCTION BOX " TO "IDF" CEILING
- ② MULTI-CELL 4IN. EMT CONDUIT WITH(4-CELL, 1 1/4" I.D.) (PRE-INSTALLED PVC CORRUGATED INNERDUCTS) FROM "IDF" FLOOR TO "CONDUIT JUNCTION BOX " TO "IDF" CEILING
- ③ MULTI-CELL 4IN. GALVANIZED STEEL CONDUIT WITH PRE-INSTALLED PVC CORRUGATED 4-1 1/4" INNERDUCTS) TO "MDF/FIS.1SF (2K0322)"
- ④ REFER TO THE MDF/IDF ROOM LAYOUTS FOR CONDUIT WALL ENTRY
- ⑤ STANDARD 4IN. GALVANIZED STEEL CONDUIT TO (WITHOUT INNERDUCT) "MDF"

② IDFSP.1LL (1-0006)  
 NOT TO SCALE

① MDFFIS.1SF (2K0322)  
 NOT TO SCALE

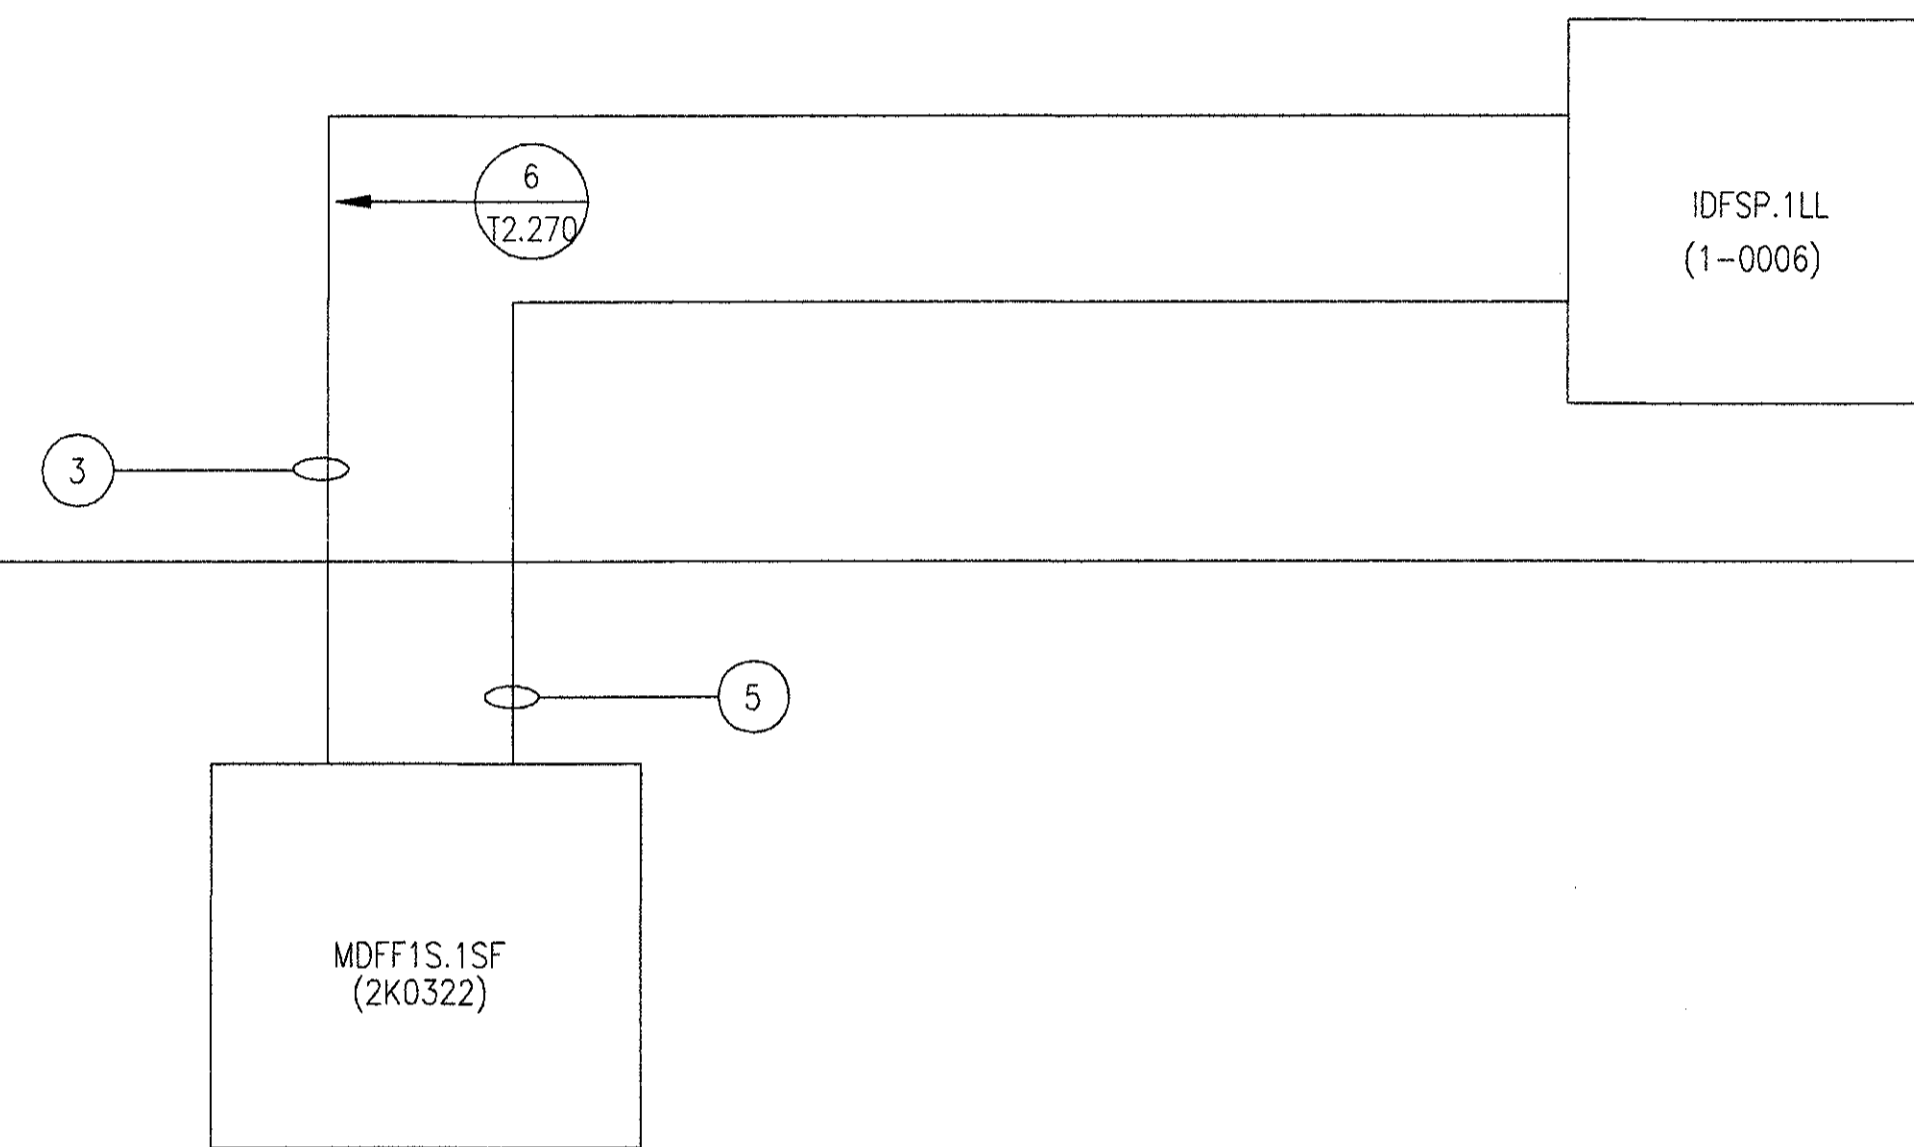


GENERAL NOTES


1. ALL CONDUCTORS AND CONNECTORS SHALL BE U.L. LISTED.
2. ALL CONDUITS, DUCTS, AND OTHER CONDUCTIVE MATERIALS SHALL BE BONDED TO THE GROUNDING BUSBAR WITH #6 AWG CONDUCTOR WHERE THEY ENTER THE ROOM.
3. FOOTPRINT AND LAYOUT SHOWN FOR ILLUSTRATION PURPOSES ONLY. ACTUAL GROUNDING LAYOUT TO BE GOVERNED BY ROOM AND CABLETRAY GEOMETRY.
4. CONDUIT AND CABLE ROUTES DEPICTED HEREIN ARE RECOMMENDATIONS ONLY. ACTUAL ROUTES ARE TO BE DETERMINED BY CONTRACTOR AND APPROVED BY OWNER/OWNER REPRESENTATIVE.

KEYED NOTES


1. INSTALL 51MM WIDE BY 6MM THICK BARE COPPER CONTINUOUS GROUND BUSBAR AROUND PERIMETER OF ROOM 84" A.F.F. EXOTHERMICALLY WELD ALL JOINTS. OFFSET FROM WALL 1". ATTACH TO WALL STUDS AT 16" O.C. WITH TAPPING SCREW. SEE DETAIL 3 THIS SHEET.
2. INSTALL #6 AWG GROUND CONDUCTOR TO CABLE TRAY FOR EQUIPMENT CABINET GROUND BUS. SEE DETAIL 1 THIS SHEET. BOND ALL CABLE TRAY JOINTS NOT ON PERIMETER WALLS WITH #6 AWG.
3. EXOTHERMICALLY WELD TO PERIMETER GROUNDING BUSBAR.
4. INSTALL #6 AWG CONDUCTOR BETWEEN EQUIPMENT CABINET GROUND BUS CONDUCTOR ON CABLE TRAY AND EQUIPMENT FRAME. SAND CLEAN 1 SQUARE INCH AREA. DRILL AND TAP FRAME. BOLT CONDUCTOR TO DEPAINTED AREA CONNECT TO CABLE TRAY GROUND CLAMP. SEE DETAIL 1 THIS SHEET.
5. ALL CONDUITS SHALL BE BONDED TO GROUNDING BUSBAR WITH #6 AWG COPPER CONDUCTOR. SEE DETAIL 2 THIS SHEET.
6. BOND CABLE TRAY TO GROUNDING BUSBAR AT 24" INTERVALS WITH #6 AWG CONDUCTOR. SEE DETAIL 2 THIS SHEET.
7. #3/0 AWG INSULATED COPPER CONDUCTOR IN 1" CONDUIT. EXOTHERMICALLY WELD TO GROUNDING BUSBAR AND TO BUILDING COUNTERPOISE.
8. BOND POWER PANEL GROUND BUS TO GROUNDING BUSBAR WITH #6 AWG.
9. TYPICAL CONDUIT WITH GROUND BUSHING.
10. BOND ALL EQUIPMENT FRAMES TO GROUNDING BUSBAR WITH #6 AWG CONDUCTOR. SAND CLEAN 1 SQUARE INCH AREA. DRILL AND TAP FRAME. BOLT CONDUCTOR TO DEPAINTED AREA.

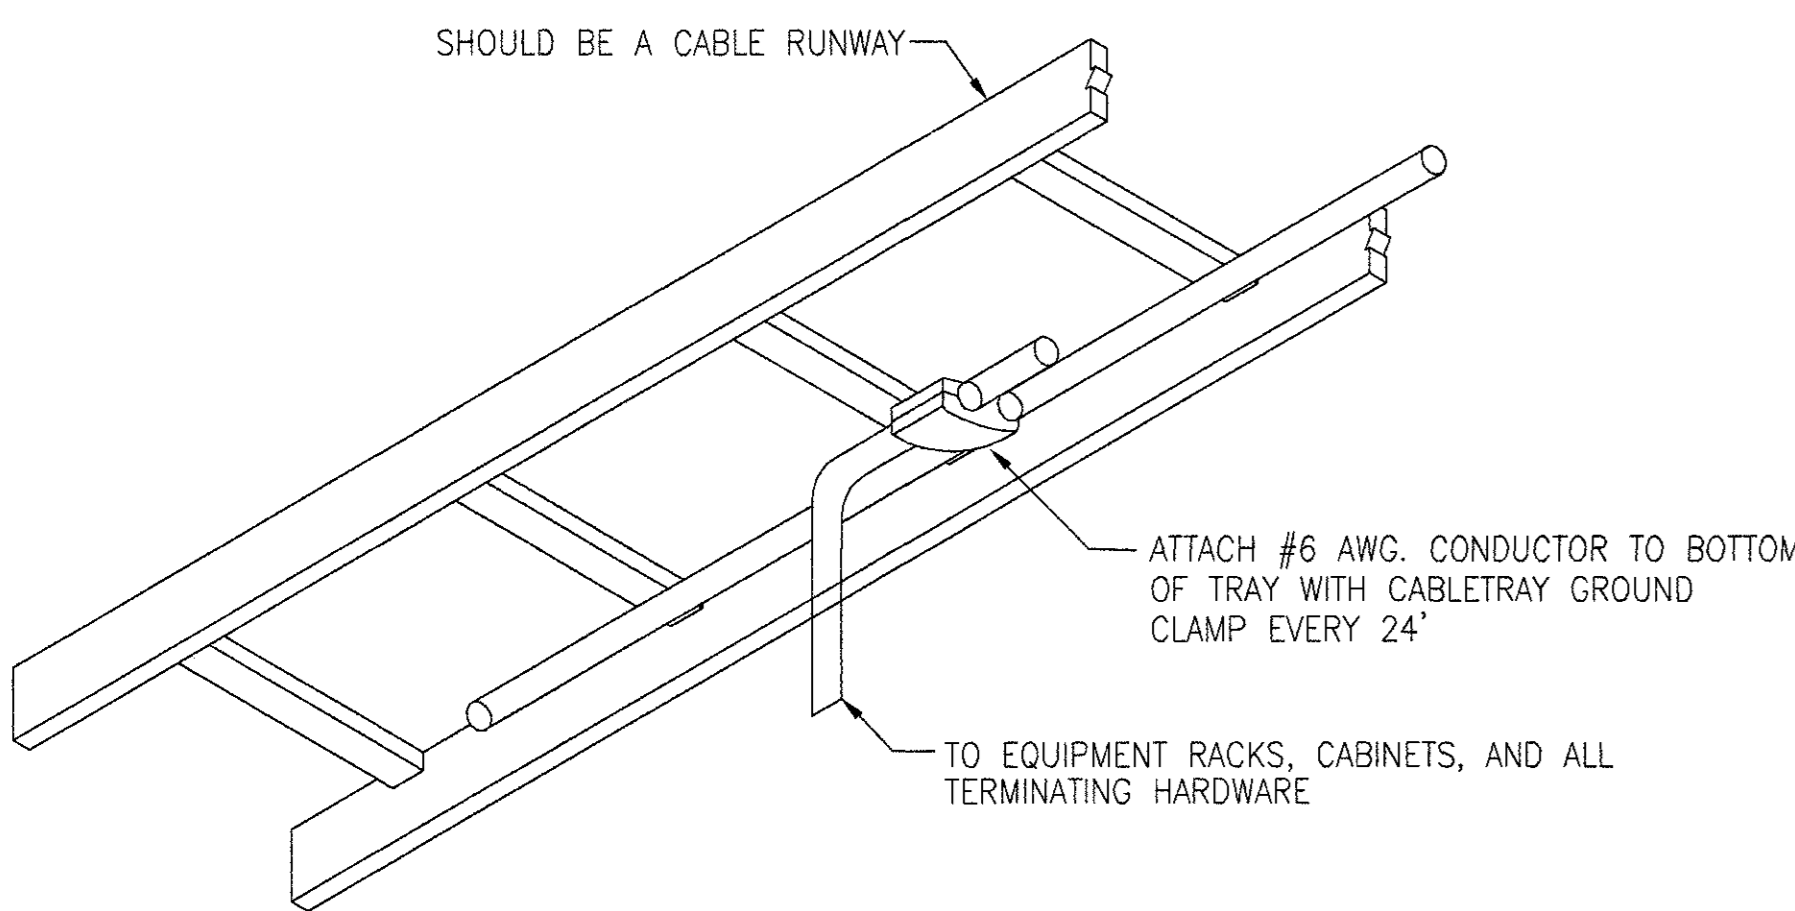


1 EQUIPMENT RACKS, CABINETS, AND ALL TERMINATING HARDWARE GROUND BUS CONDUCTOR  
 NOT TO SCALE

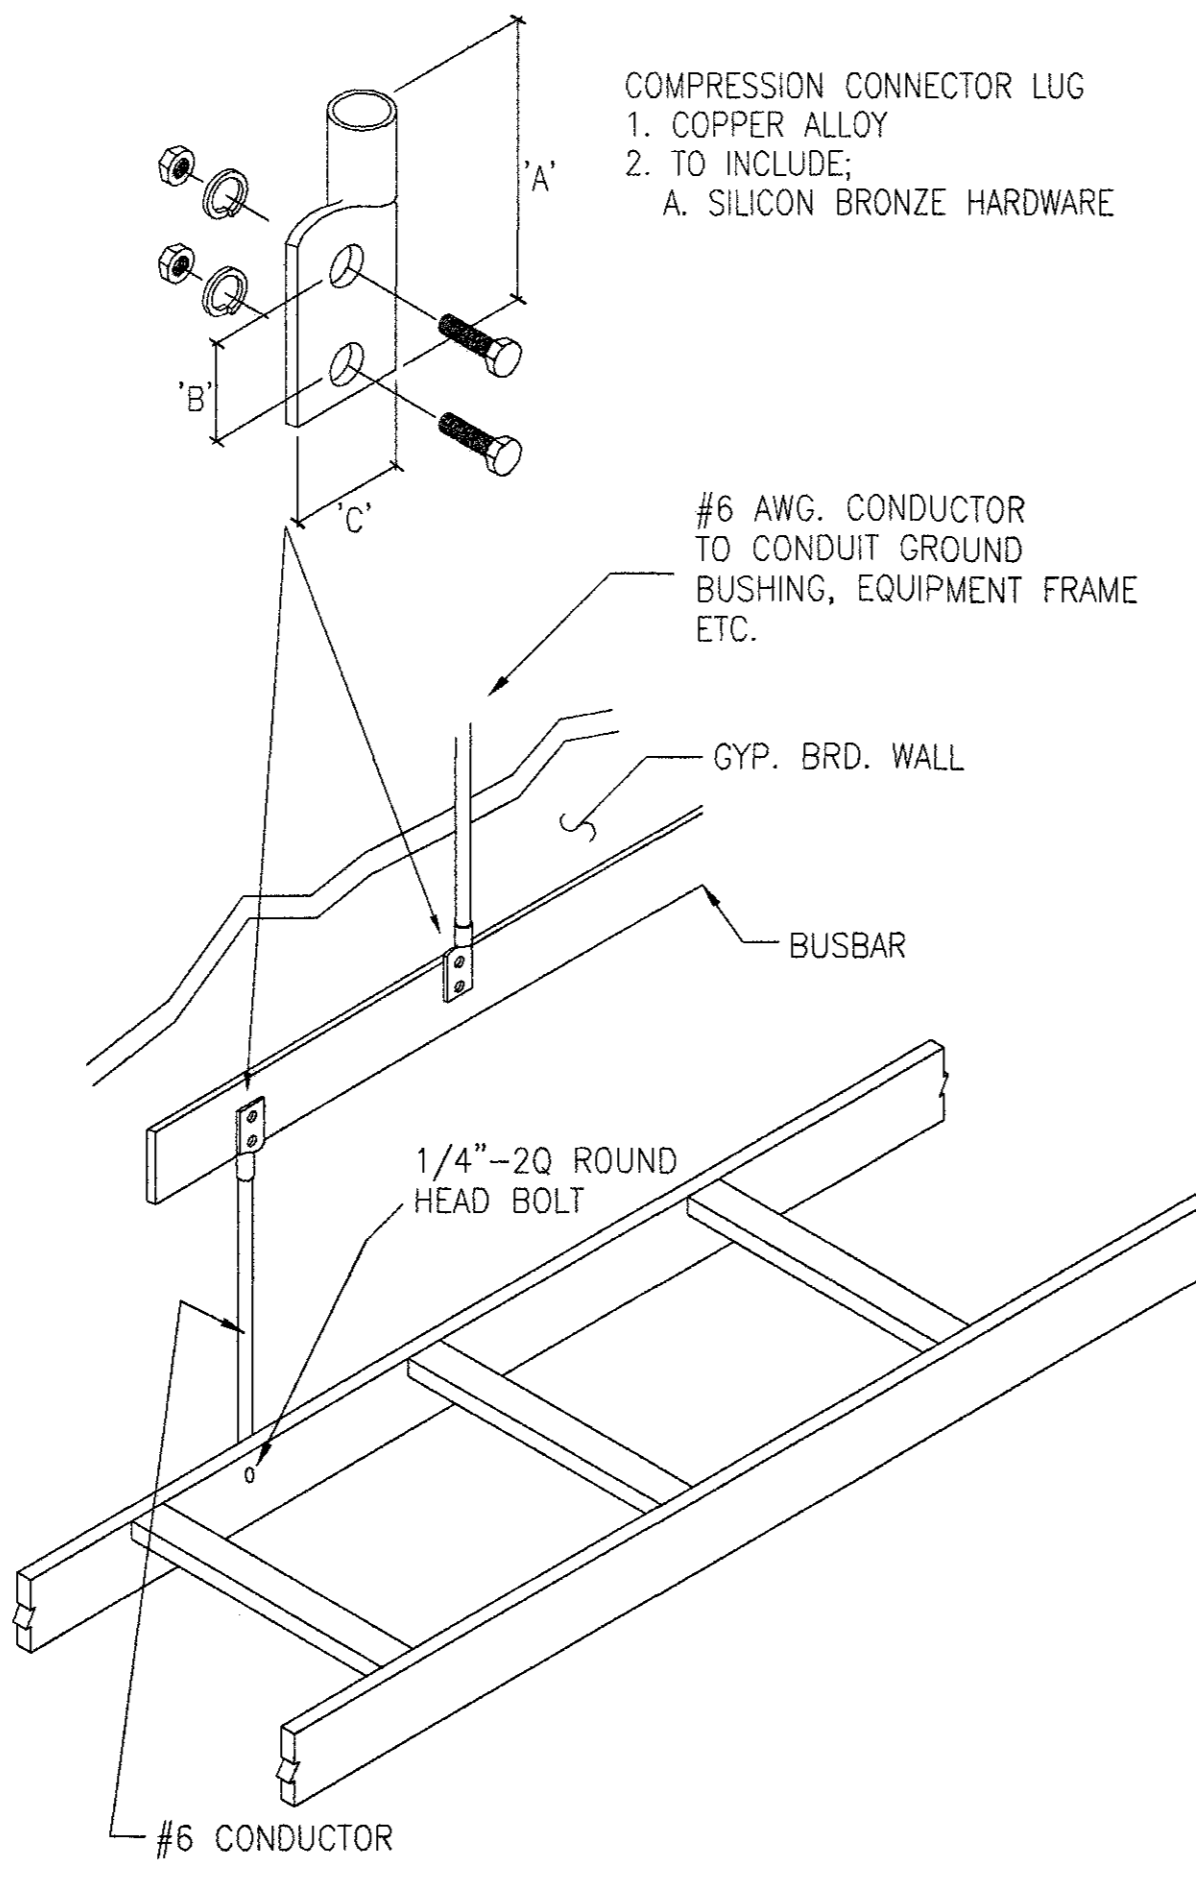

2 CONNECTIONS TO BUSBAR  
 NOT TO SCALE

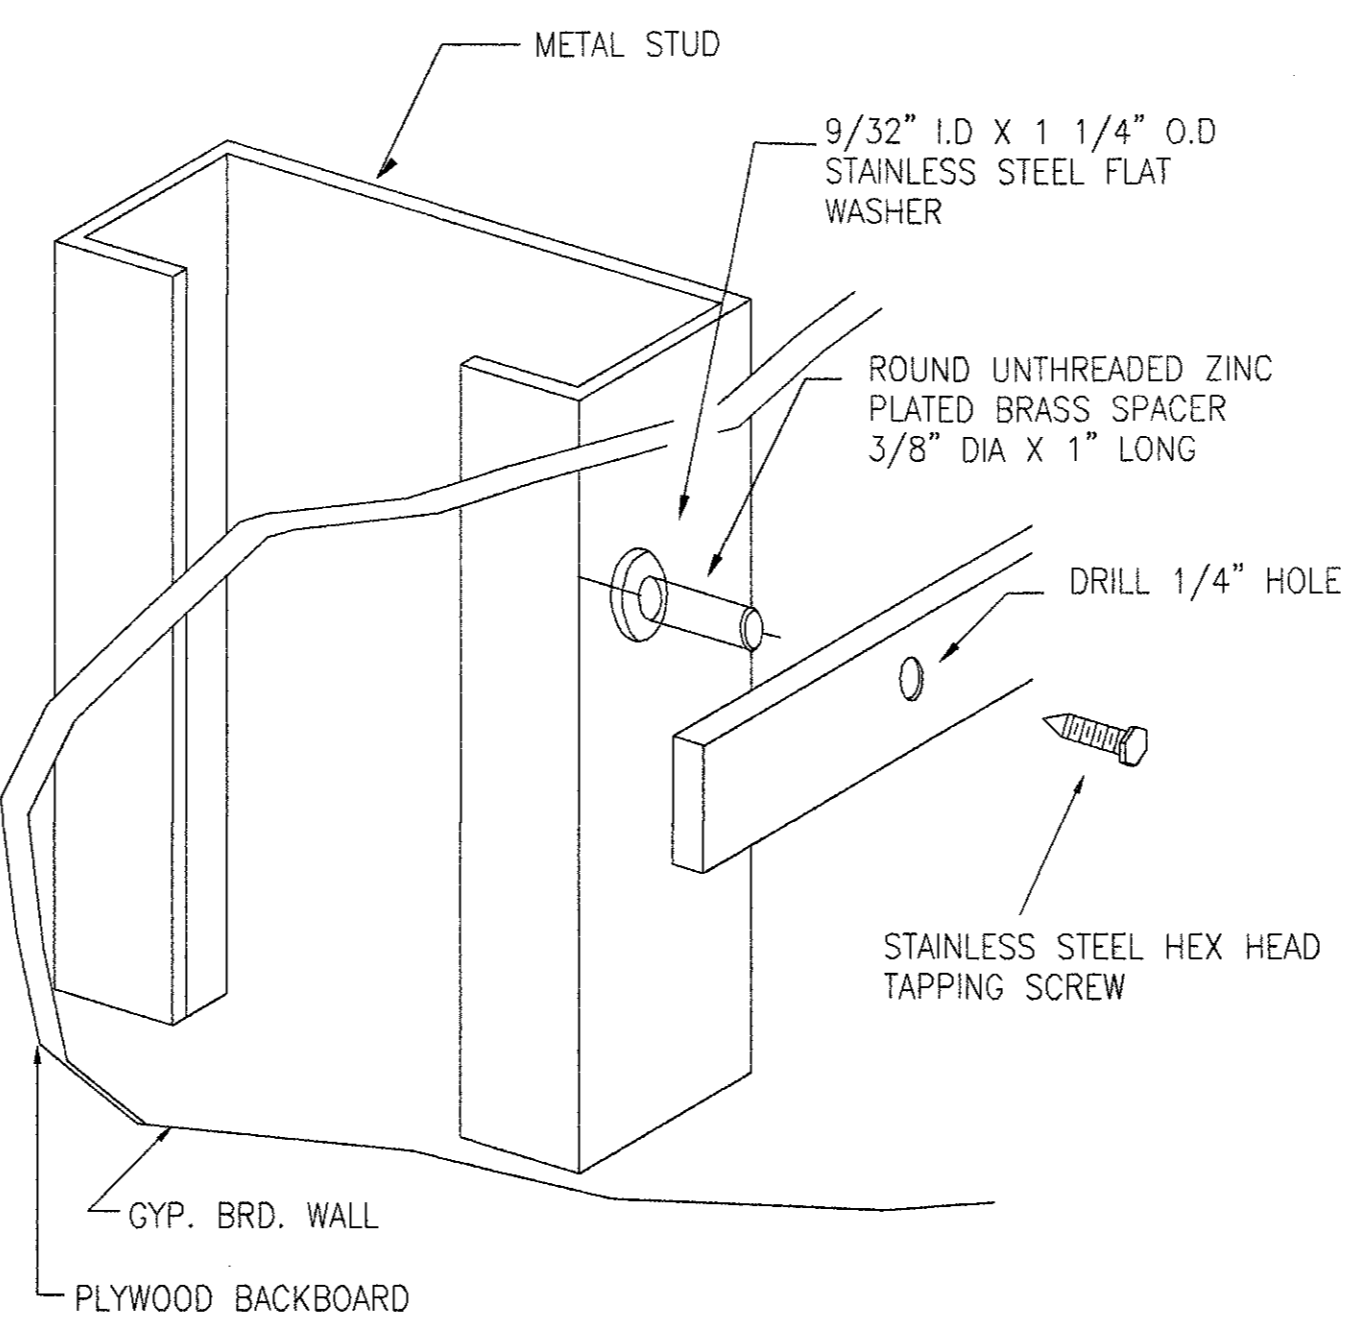


3 CONNECTIONS TO BUSBAR  
 NOT TO SCALE

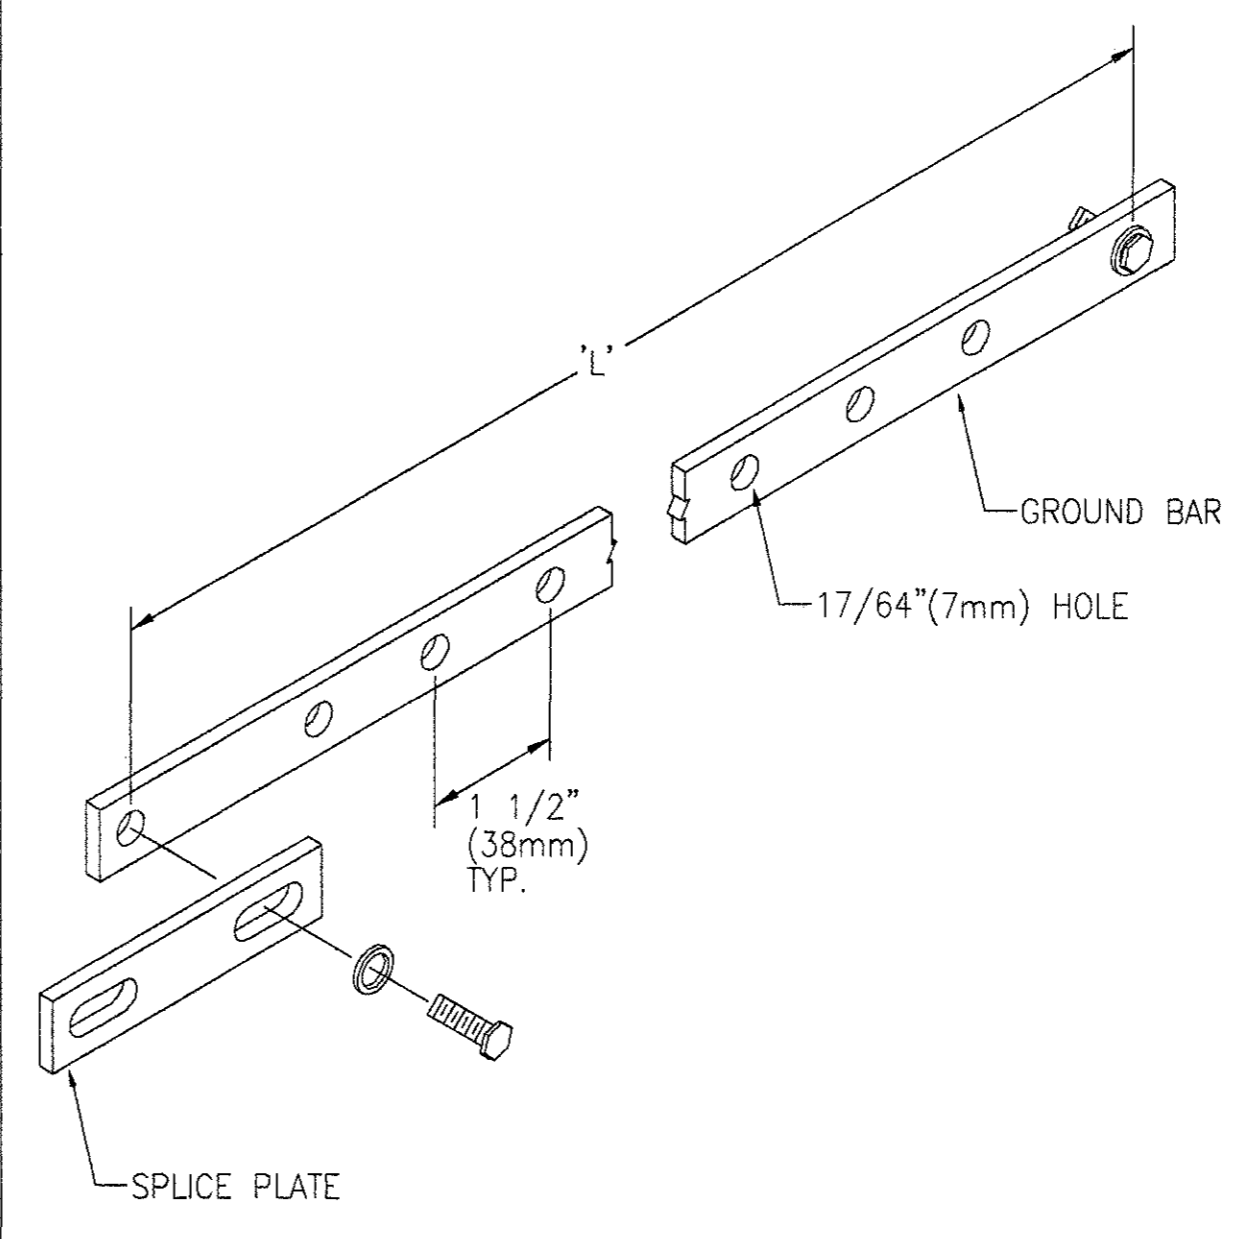

GROUND BAR  
 -USE AS RACK MOUNTED EQUIPMENT GROUNDING BUS.  
 -INCLUDE GROUND BAR, SPICE PLATE (IF REQUIRED)  
 AND #12-24 MOUNTING HARDWARE.  
 -MATERIAL: 3/16"(4.8mm) x 3/4"(19mm) COPPER BAR


RACK WIDTH	'L'		HOLES	WEIGHT		
	in	(mm)		in	(mm)	lbs.
19"	(482)	18 5/16"	(465)	12	1.0	(0.4)

4 GROUND BAR  
 NOT TO SCALE

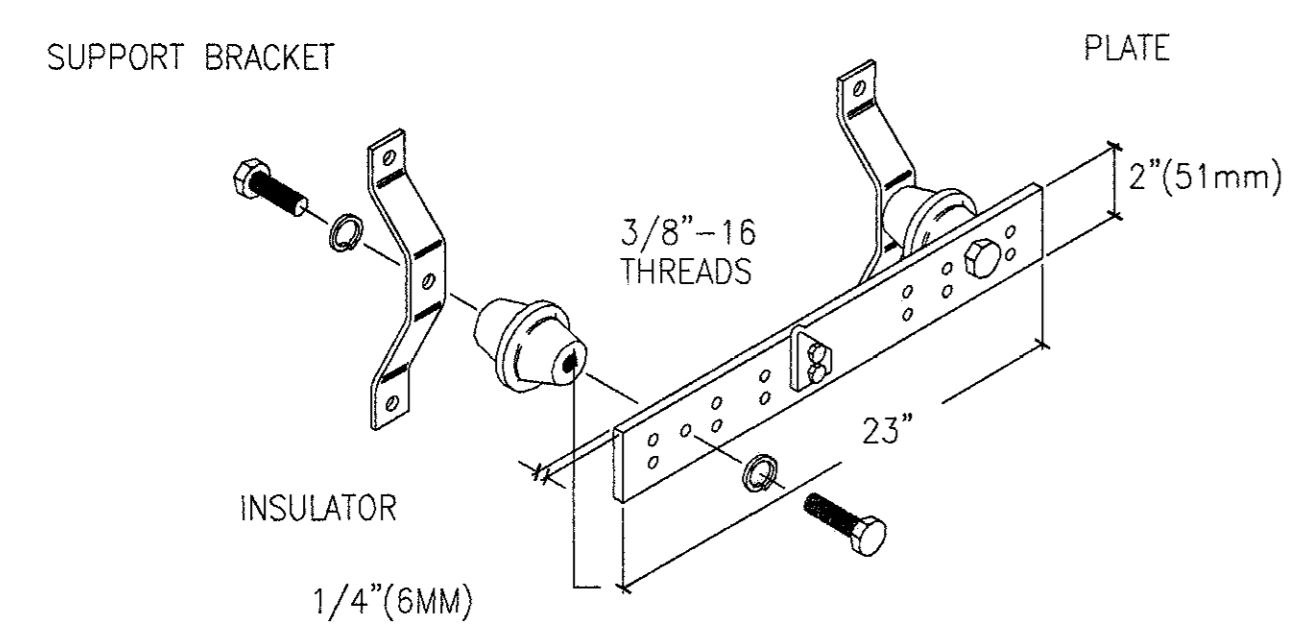


- 23" WALL-MOUNTED BUS BAR
1. TO MEET EIA/TIA 607
  2. STRUCTURAL STEEL
  3. COPPER BAR
  4. POLYESTER RESIN FIBERGLASS-INSULATORS
  5. FINISH: STEEL-YELLOW ZINC DICHROMATE
  6. TO INCLUDE:
    - A. COPPER BAR
    - B. INSULATORS
    - C. SUPPORT BRACKETS AND HARDWARE
    - D. BUS BAR ASSEMBLY
    - E. LUGS FOR 14-8 WIRE
    - F. LUGS FOR 8-4 WIRE
    - G. LUGS FOR 4-1 WIRE


5 23" WALL-MOUNTED BUS BAR  
 NOT TO SCALE

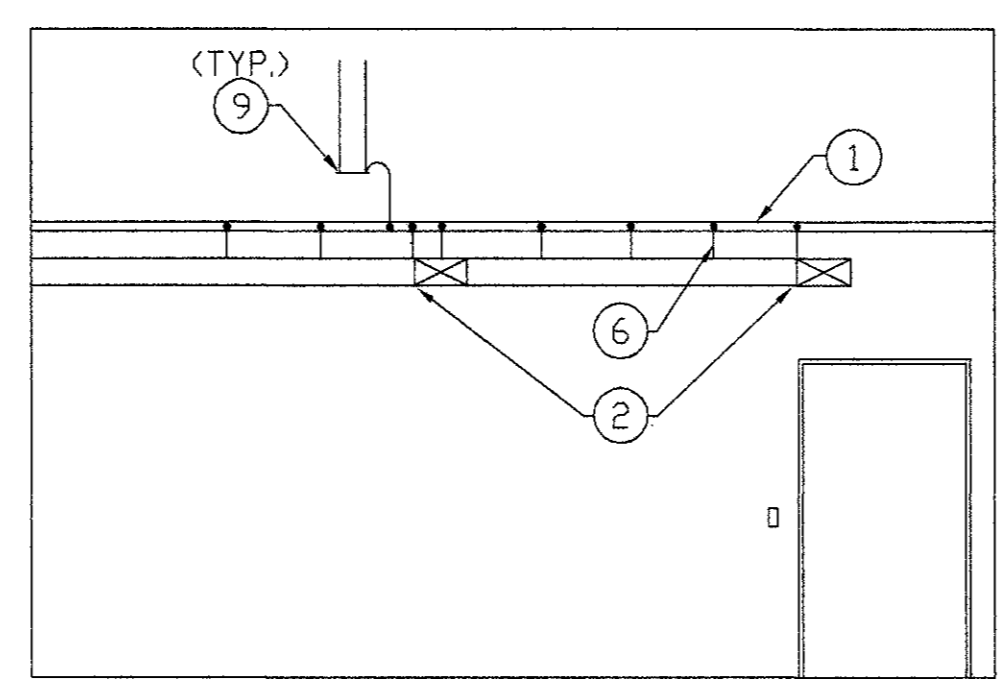


B ELEVATION  
 NOT TO SCALE

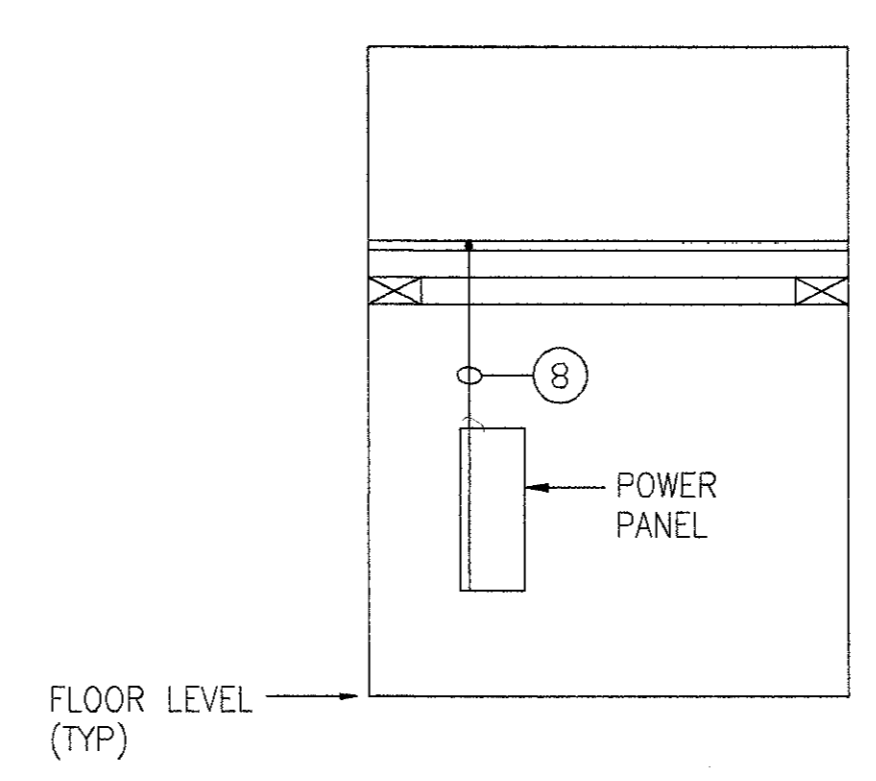

C ELEVATION  
 NOT TO SCALE

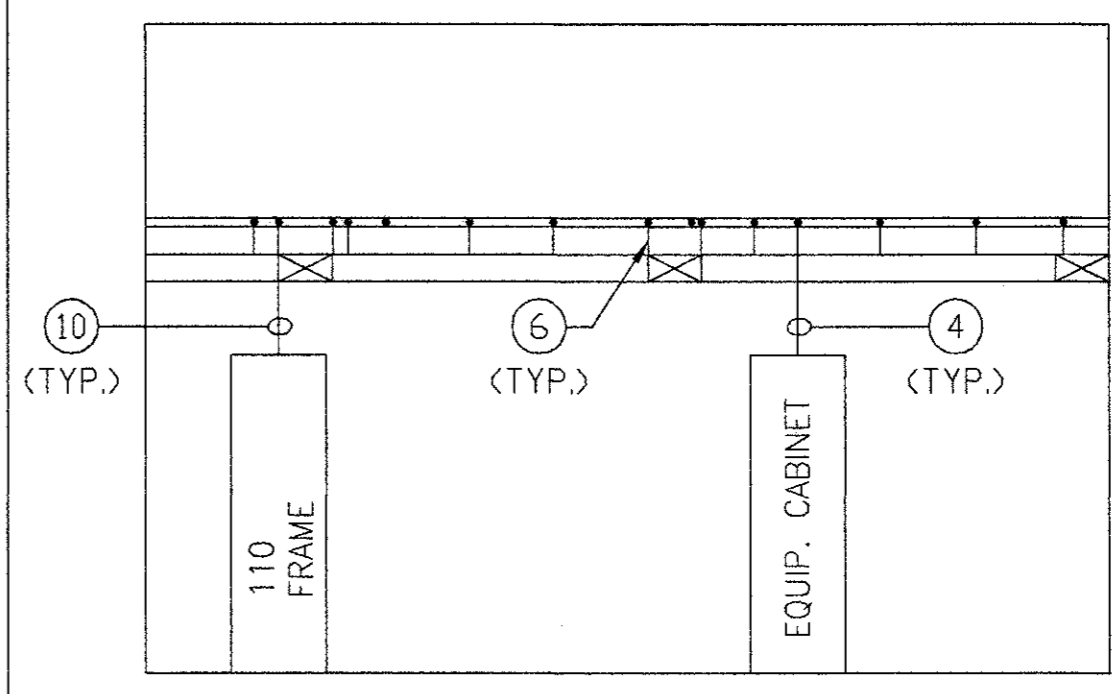

D ELEVATION  
 NOT TO SCALE

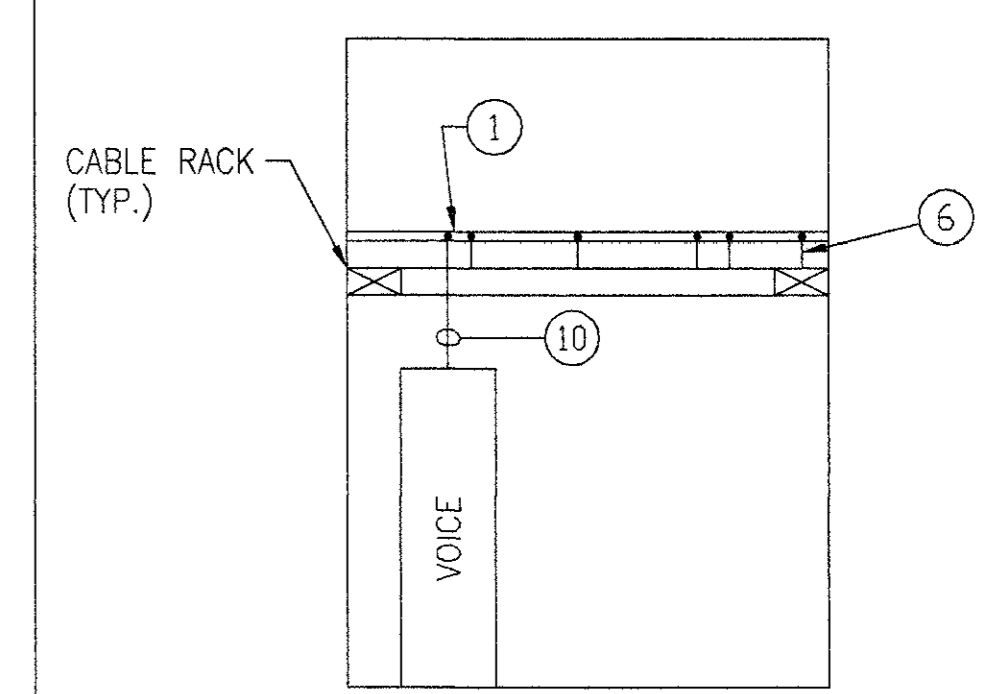

E ELEVATION  
 NOT TO SCALE

INTERNATIONAL • SERVICES • EXPANSION • PROGRAM

APM STATION + PLATFORM  
 COMMUNICATION LAYOUT  
 COMMUNICATION DETAILS

PROJECT MGR: HK  
 DESIGNER: TL  
 DRAWN BY: MP  
 CHECKED BY: KW  
 DRAWING STANDARD: ISEP 07.20.2000  
 SCALE: N.T.S.  
 DATE: 9/14/01

APPROVED BY: DATE:

DIRECTOR  
 HOUSTON AIRPORT SYSTEM

PROJECT NO. IAH06

C.I.P. NO. A-0354


H.A.S. NO. 536C

SHEET NO. T2.260




GENERAL NOTES

1) CONDUIT AND CABLE ROUTES DEPICTED HEREIN ARE RECOMMENDATIONS ONLY. ACTUAL ROUTES ARE TO BE DETERMINED BY CONTRACTOR AND APPROVED BY OWNER/OWNER REPRESENTATIVE.

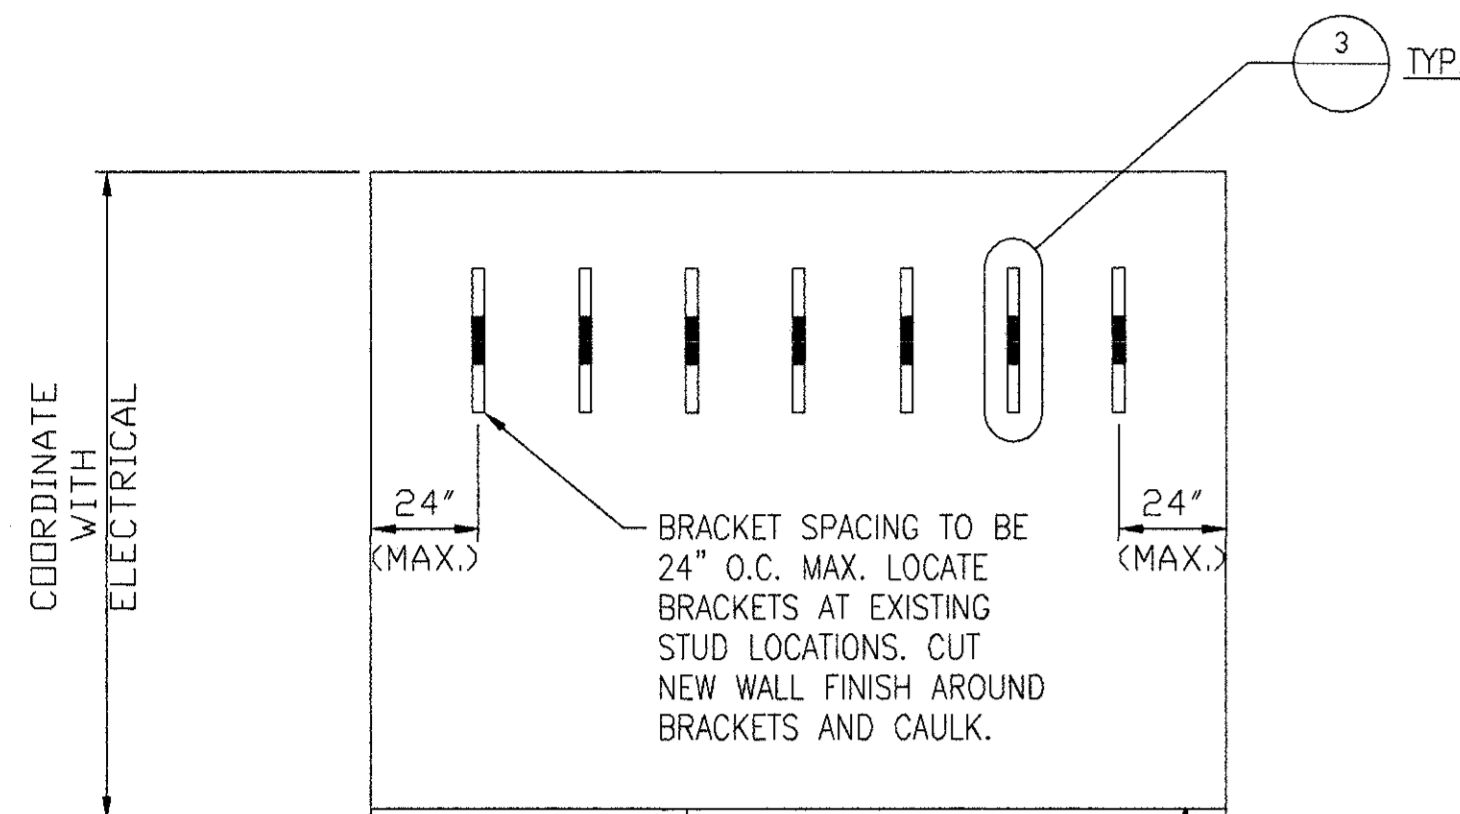

1 TYPICAL CABLE RUNWAY WALL SUPPORT LOCATION  
 NOT TO SCALE

SOLID BAR STRINGER STYLE-2"  
 -1/2" (13mm) x 1" (25mm) STEEL CHANNEL WELDED RUNGS.  
 -YELLOW ZINC DICHROMATE (YZN) IS UL CLASSIFIED.  
 -13/32" (10mm) HOLES PROVIDED IN SOLID BAR STRINGERS FOR SEISMIC APPLICATIONS.  
 -MATERIAL: ASTM A36 STRUCTURAL STEEL BAR.  
 -FINISH: TELCO GRAY.

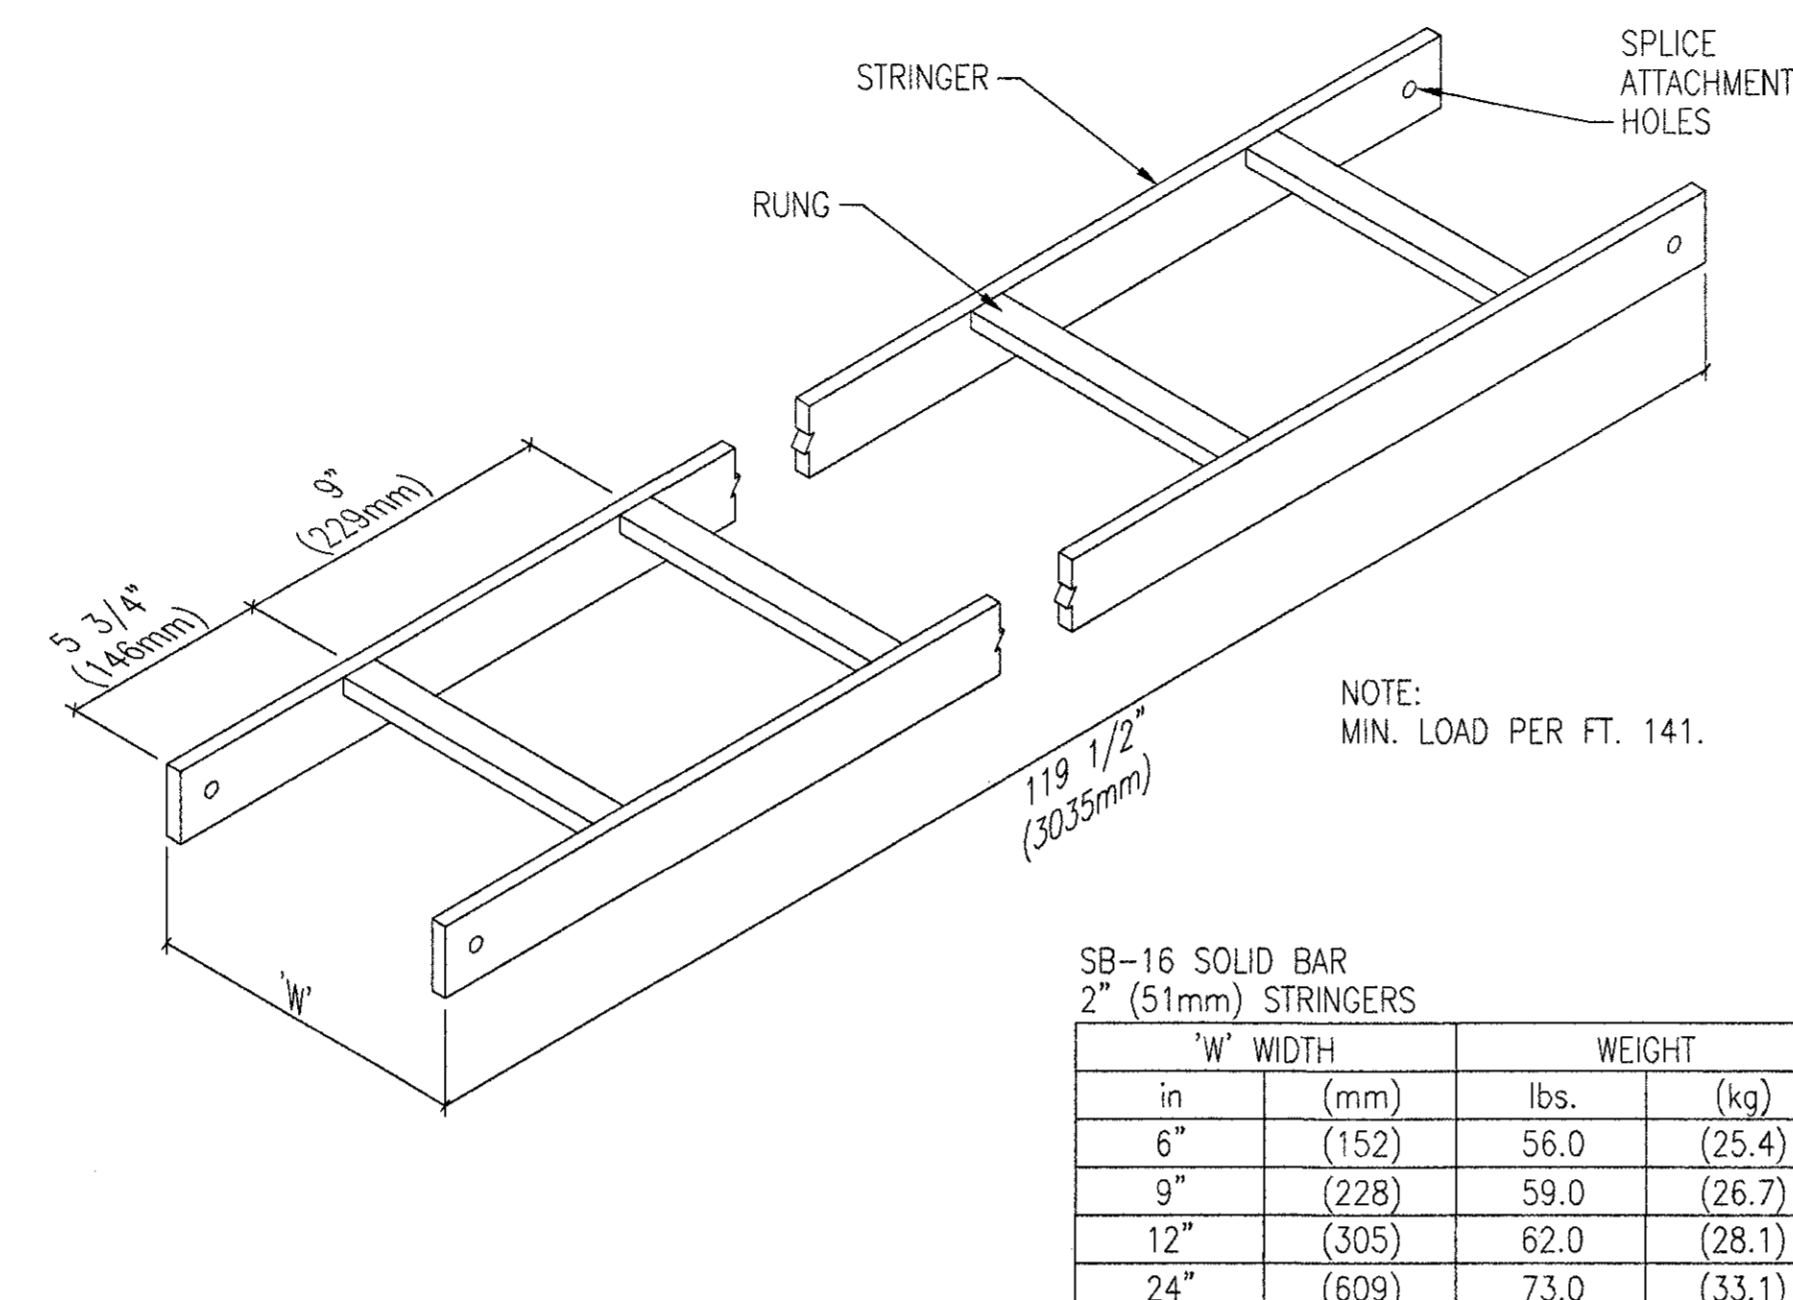


NOTE: MIN. LOAD PER FT. 141.

SB-16 SOLID BAR  
 2" (51mm) STRINGERS

"W" WIDTH		WEIGHT	
in	(mm)	lbs.	(kg)
6"	(152)	56.0	(25.4)
9"	(228)	59.0	(26.7)
12"	(305)	62.0	(28.1)
24"	(609)	73.0	(33.1)


2 TYPICAL CABLE RUNWAY  
 NOT TO SCALE

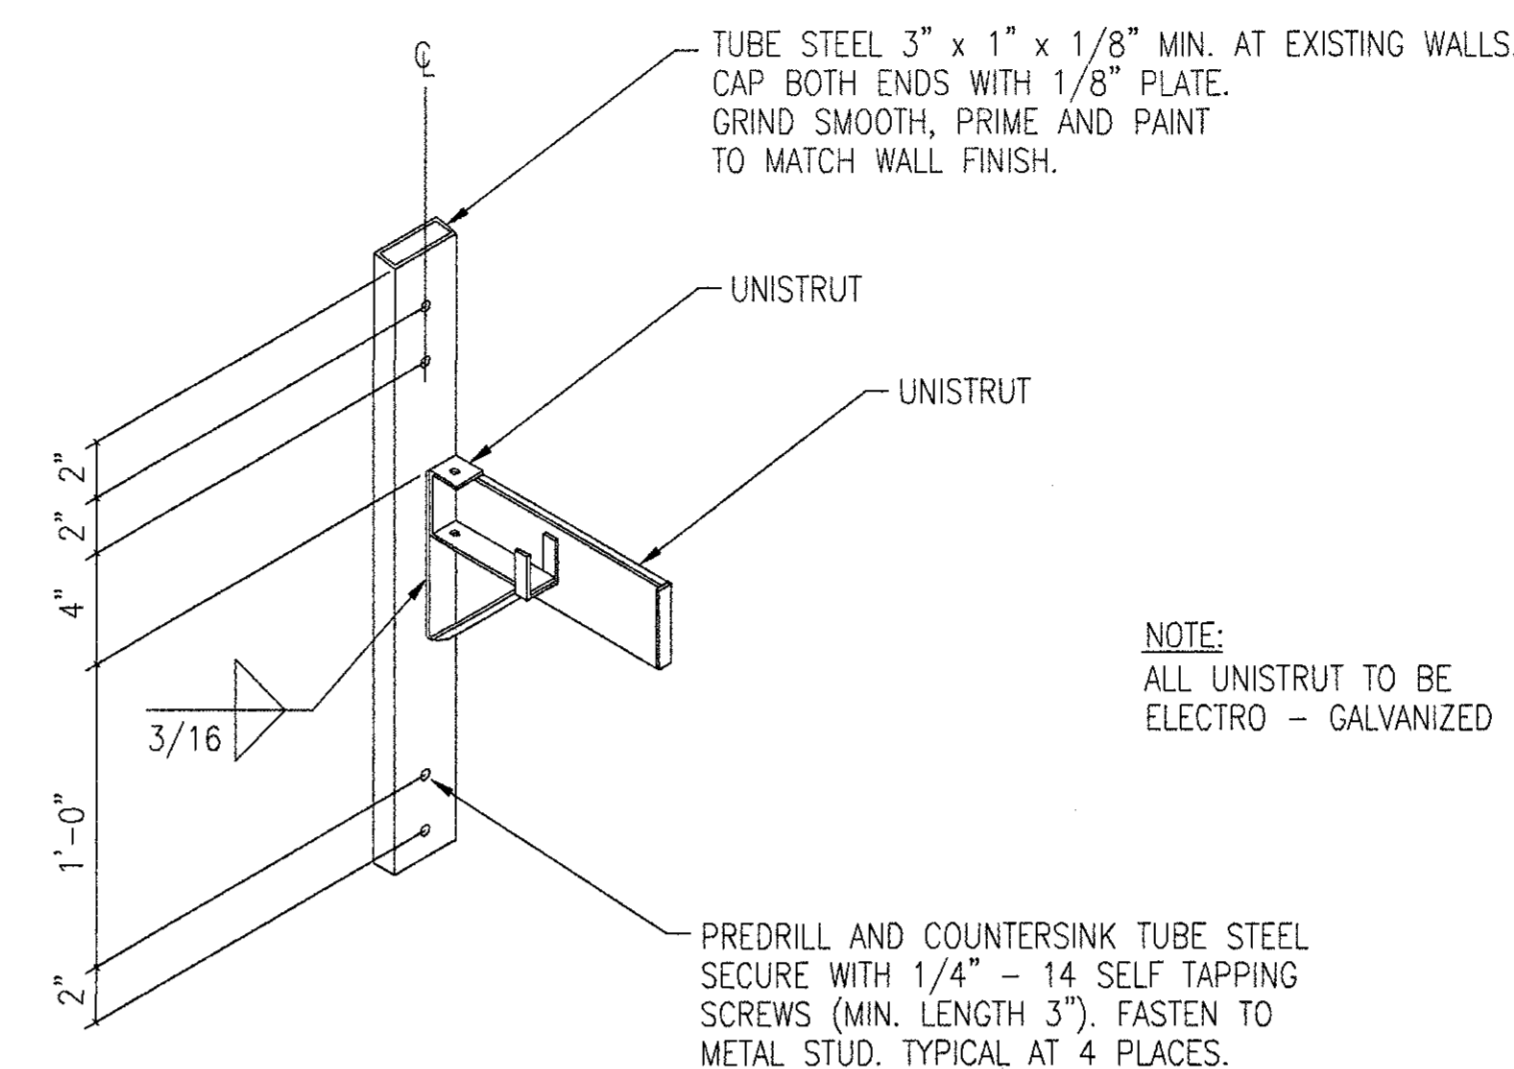


3 TYPICAL-WALL SUPPORT BRACKET  
 NOT TO SCALE

-USE TO SUSPEND CABLE RUNWAY FROM ALL THREADED ROD.  
 -INCLUDE HANGER SUPPORTS AND HARDWARE.  
 -MATERIAL: ASTM A570 STRUCTURAL STEEL.  
 -FINISH: YELLOW ZINC DICHROMATE (YZN).

RUNWAY HEIGHT		ATR SIZE		WEIGHT	
in	(mm)	1/2"-13		lbs.	(kg)
2"	(51)	0.80		(0.36)	

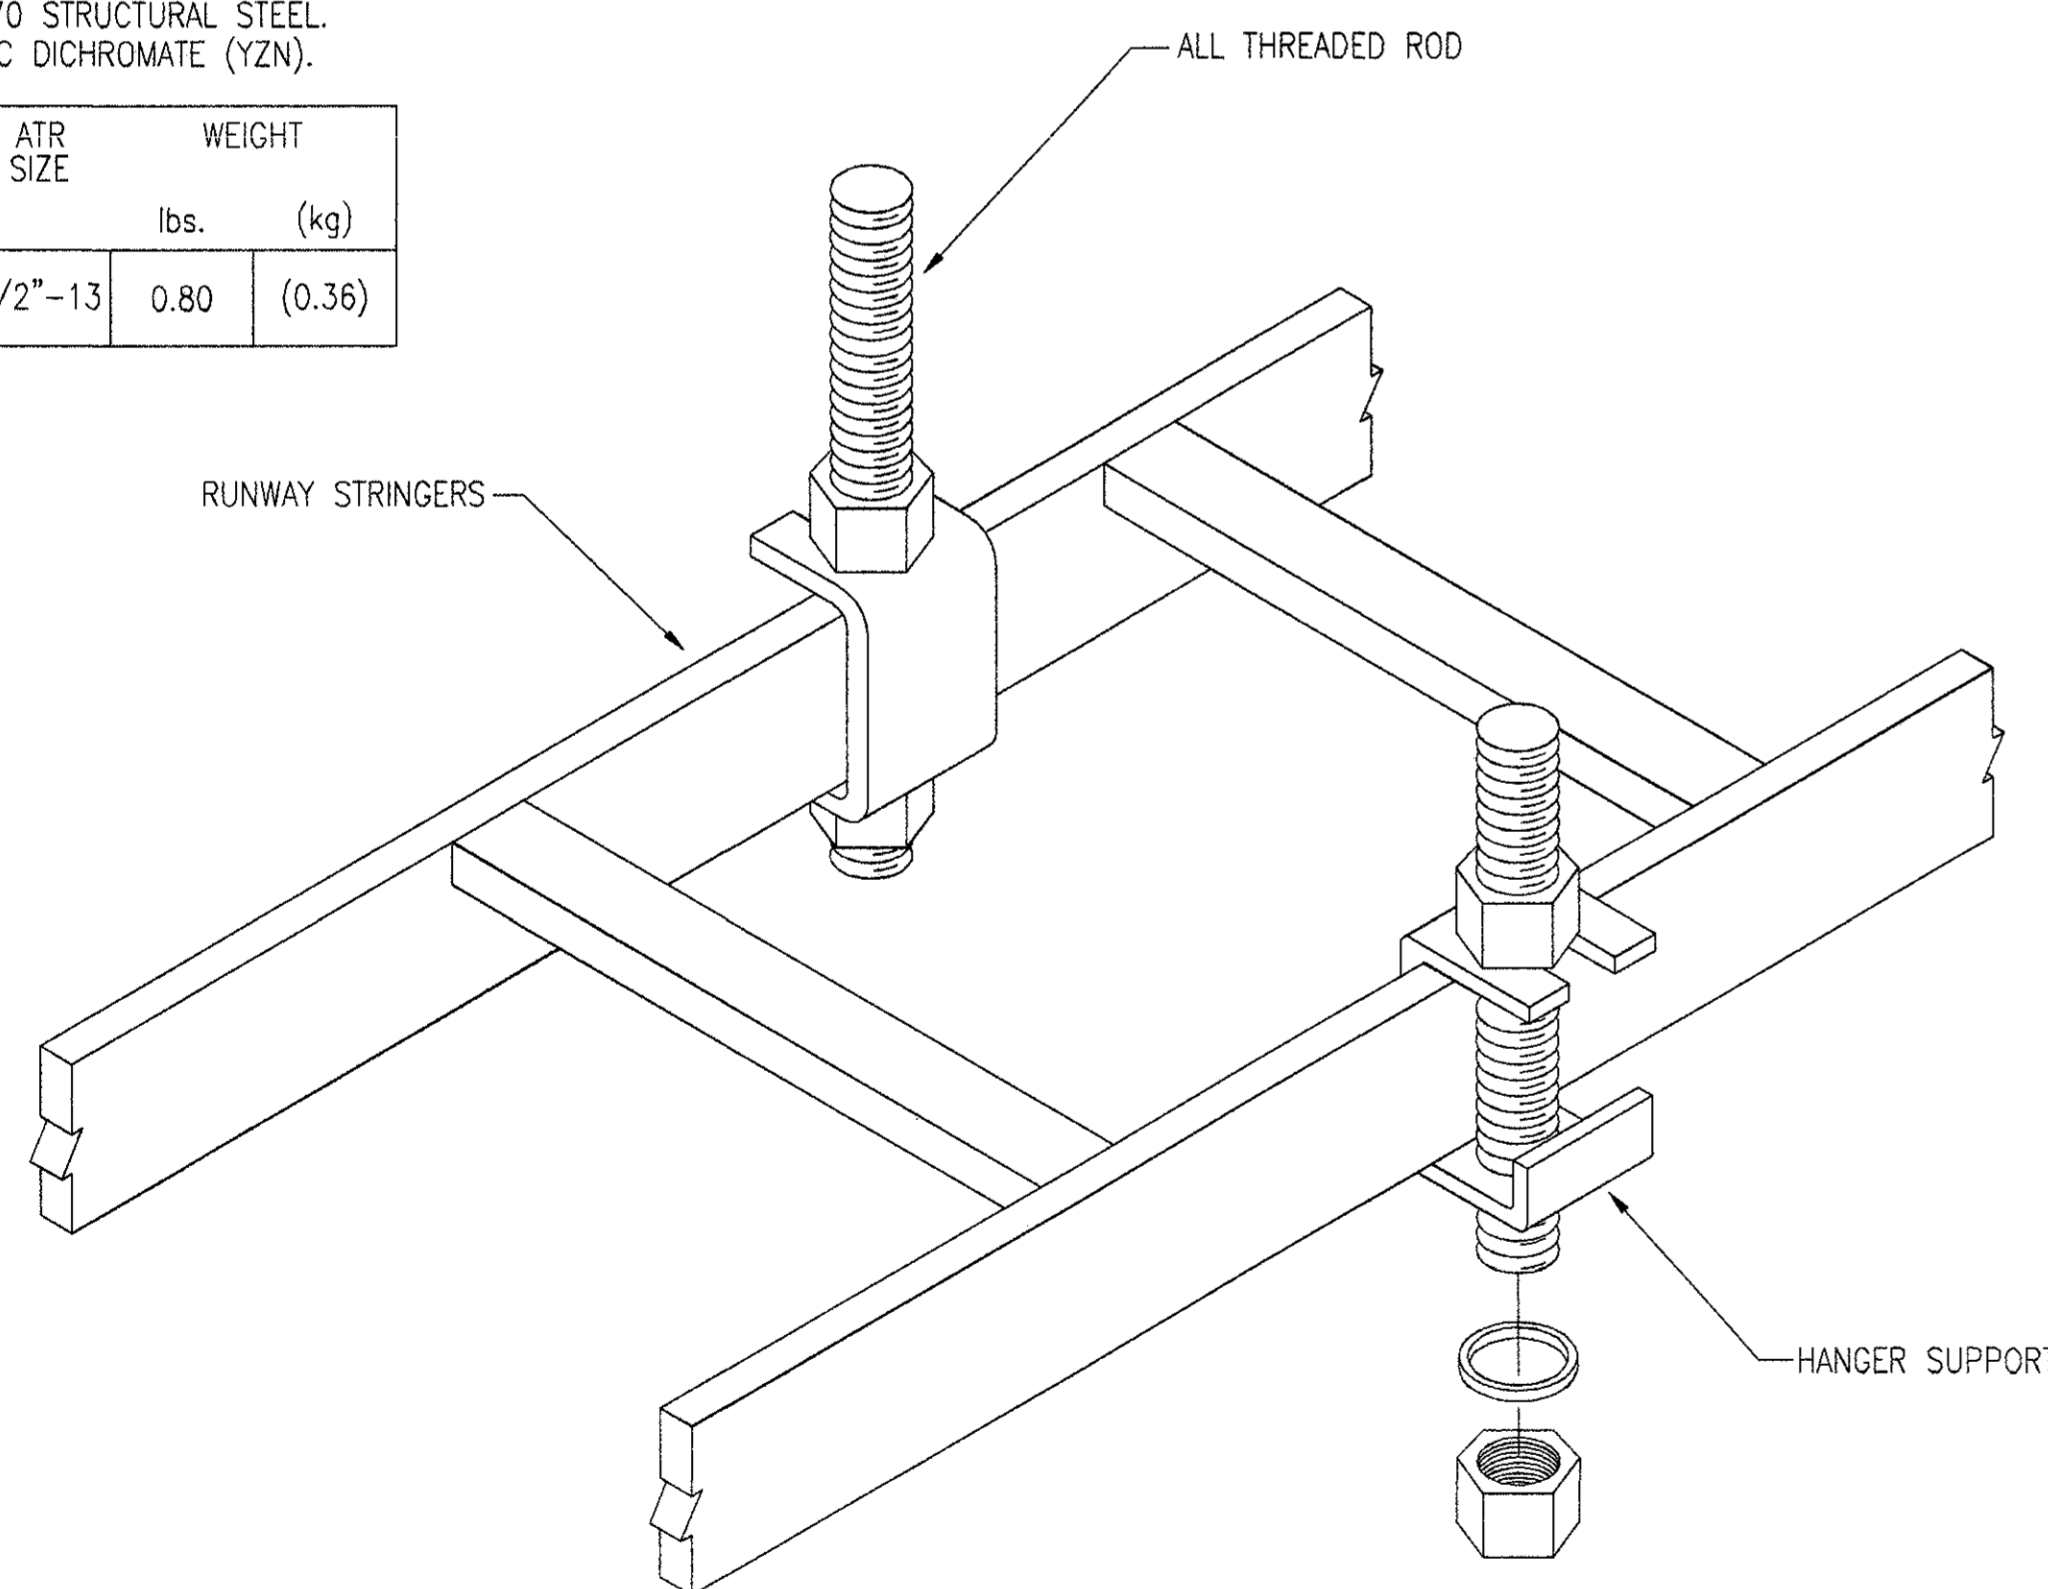

4 SLOTTED RUNWAY SUPPORT KIT  
 NONE

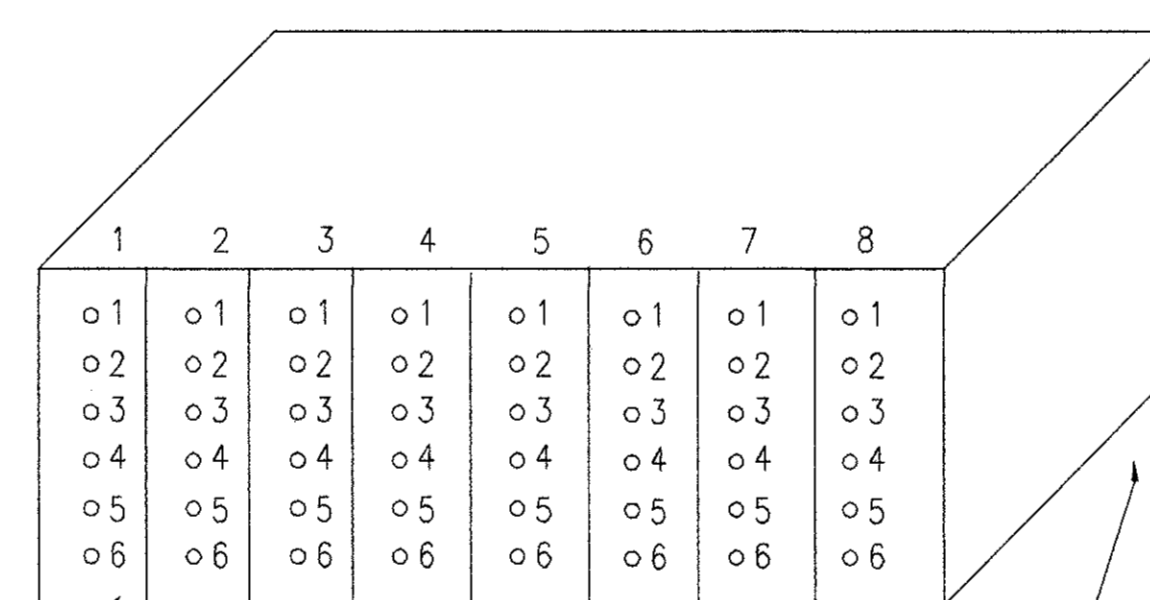


12 - FIBER TRUNK CABLE  
 48 - FIBER LIU  
 A SINGLE PANEL MAY HOLD MORE THAN ONE TRUNK CABLE.  
 EACH TRUNK CABLE SHALL BE CONTAINED COMPLETELY WITHIN SEVERAL PANELS

5 TYPICAL PATCH PANEL FIBER POSITIONING  
 NOT TO SCALE

OPTION-1  
 IF AVAILABLE INNER DUCT COLORS  
 A=ORANGE-MULTIMODE  
 B=GRAY-SPARSE  
 C=YELLOW-SINGLE MODE  
 D=WHITE-SPARSE



OPTION-2  
 ORANGE INNER DUCT  
 A=MULTIMODE  
 B=SPARSE  
 C=SINGLE MODE  
 D=SPARSE

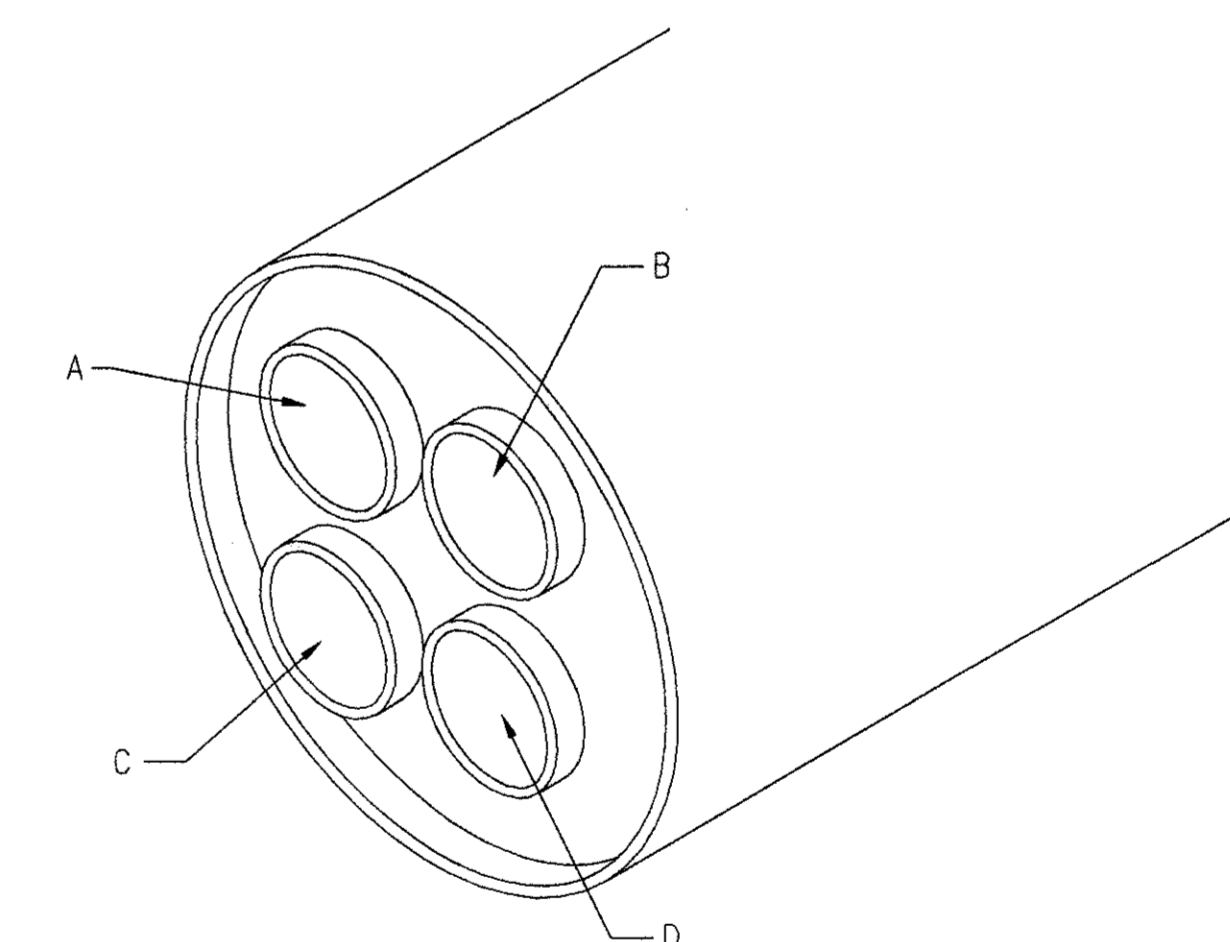

TO BE USED WITH OPTION #1 OR #2  
 (FROM MDF TO WITHIN COMPLEX IDF'S)  
 MULTI-CELL 4 INCH EMT CONDUIT  
 WITH (4-CELL, 1 1/4 INCH INSIDE DIAMETER)  
 (PRE-INSTALLED PVC CORRUGATED INNER DUCTS)

(FROM OUTSIDE THE COMPLEX TO MDF)  
 MULTI-CELL 4 INCH GALVANIZED STEEL CONDUIT  
 WITH (4-CELL, 1 1/4 INCH INSIDE DIAMETER)  
 (PRE-INSTALLED PVC CORRUGATED INNER DUCTS)

6 FIBER CONDUIT AND INNER DUCT ASSIGNMENTS  
 NONE

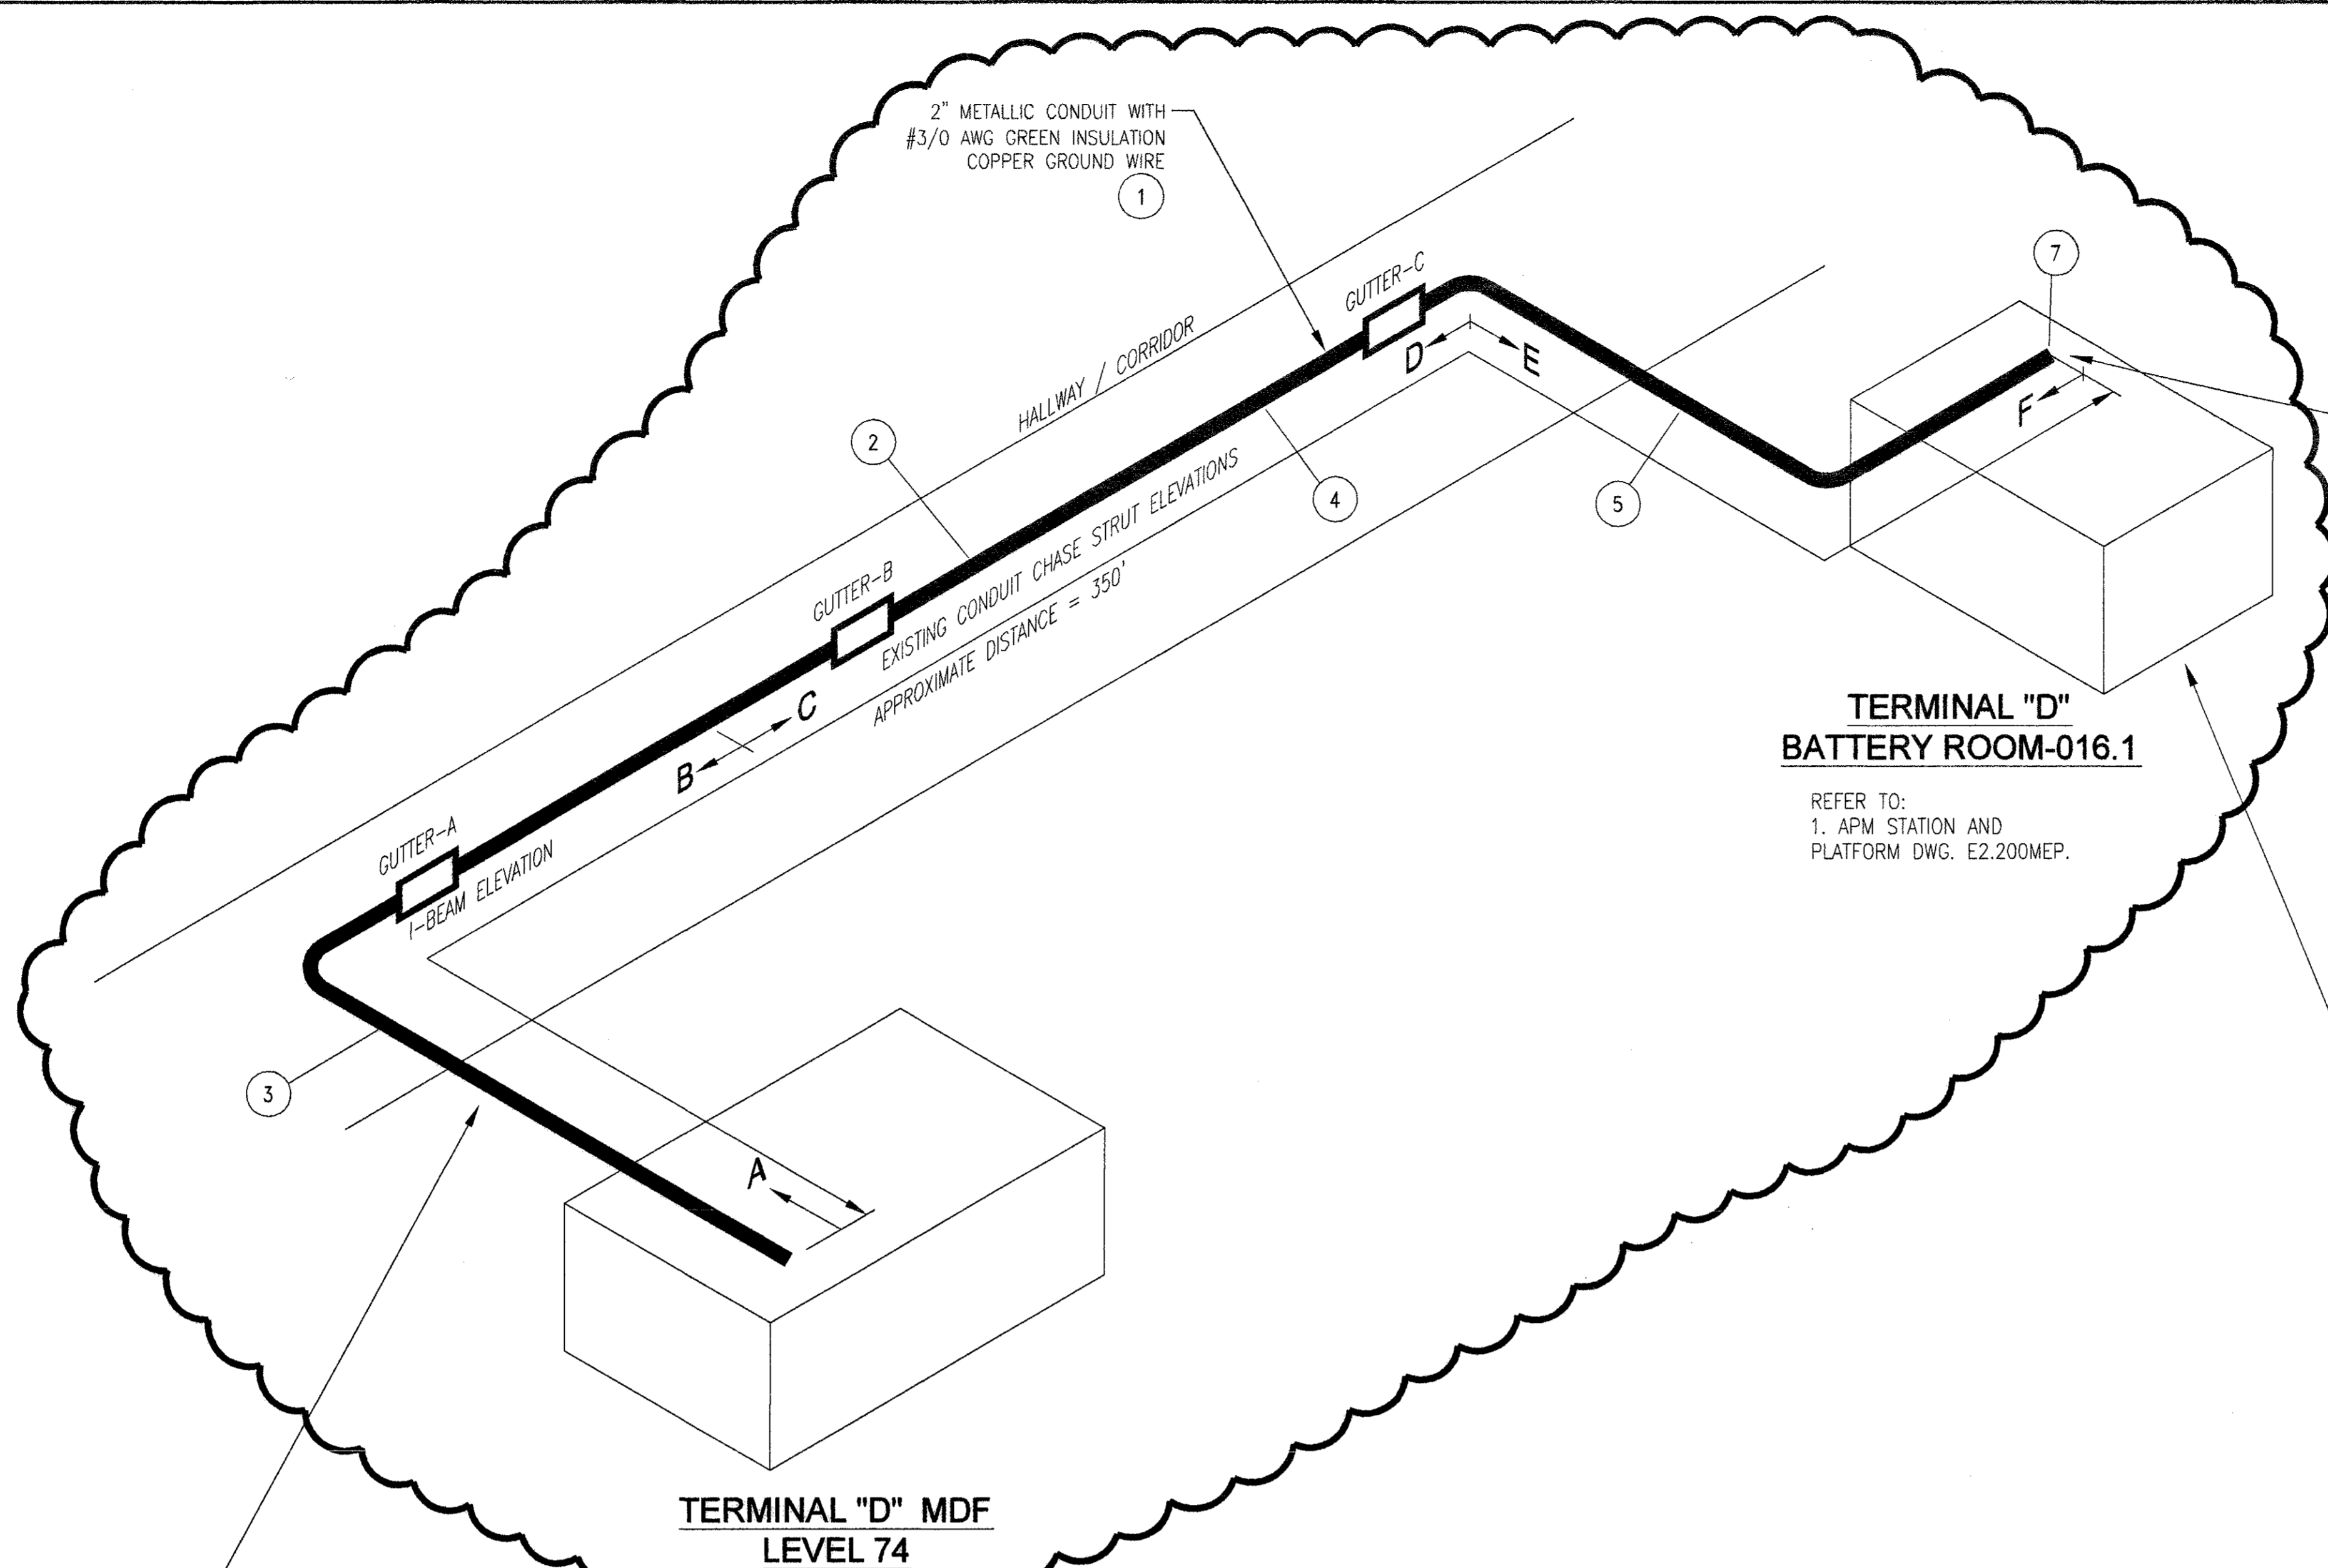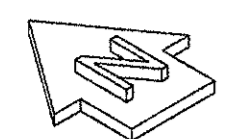

**TERMINAL "D"  
BATTERY ROOM-016.1**


REFER TO:  
1. APM STATION AND  
PLATFORM DWG. E2.200MEP.

**KEYED NOTES**


- 1) CONDUIT RACEWAY
  - A. PROVIDE 1- EA. 2 INCH METALLIC CONDUIT
  - B. PROVIDE THE NOTED GUTTER JUNCTION BOXES FROM POINT "A" TO POINT "F"
  - C. PROVIDE A CONTINUOUS HOMERUN IN THE 2 INCH CONDUIT A #3/0 AWG GREEN INSULATED COPPER GROUND WIRE
- 2) CONDUIT RACEWAY PATH
  - A. INSTALL THE 2 INCH CONDUIT IN THE HALLWAY/CORRIDOR CEILING
  - B. FROM SPAN/SECTION "A" (DMDF/ORIGINATING END) TO SPAN/SECTION "F" (EAST/MH TO BLDG END)
- 3) CONDUIT RACEWAY PATH "A" TO "B" ELEVATIONS
  - A. FROM SPAN/SECTION "A" TO SPAN/SECTION "B" ELEVATION - SHALL BE THE BOTTOM OF THE EXISTING CEILING
  - B. CONDUIT ROUTE IN THE HALLWAY SHALL BE AT THE LEVEL AND BE ABOVE ALL EXISTING CABLE TRAYS
- 4) CONDUIT RACEWAY PATH "C" TO "D" ELEVATIONS
  - A. FROM SPAN/SECTION "C" TO SPAN/SECTION "D" ELEVATIONS - SHALL BE THE TOP SIDE OF EXISTING CONDUIT CHASES TRAPEZE STRUTS
  - B. THIS PATH WILL REQUIRE CONDUIT BENDS TO UTILIZE THE AVAILABLE CHASE TRAPEZE STRUT SPACE
- 5) CONDUIT RACEWAY PATH "E" TO "F" ELEVATIONS
  - A. FROM SPAN/SECTION "E" TO SPAN/SECTION "F" ELEVATIONS - SHALL MATCH SECTION "E" END OUTSIDE WALL 2 INCH CONDUIT STUB ELEVATION
  - B. CONDUIT SHALL BE INSTALLED ABOVE THE JUNCTION BOX # 1AND NOT BLOCK ACCESS
  - C. PROVIDE THE REQUIRED CONDUIT CHASE STRUTS OR THE PROPER CONDUIT HANGERS
- 6) EXISTING DMDF GROUND BUS BAR - (ORIGINATING END)
  - A. FROM APM - MDF GROUND BUS BAR (TERMINATING END)
  - B. TO BE WELD #3/0 AWG GROUND WIRE TO BOTH ORIGINATING AND TERMINATING END GROUND BUS BARS
  - C. ALL GROUND WIRING INSTALLATION AND CONNECTIONS SHALL COMPLY WITH T2.705, T2.724 NOTES, PROJECT SPECIFICATIONS, EIA/TIA 607 GROUNDING & BONDING, AND NEC CODES
  - D. THE 2 INCH CONDUIT SHALL BE GROUNDED PER NOTE 6C ABOVE
- 7) BUILDING EAST END OUTSIDE WALL
  - A. 2 INCH CONDUIT ENTRY STUB FROM MH
  - B. EXISTING
  - C. CONNECT 2 INCH CONDUIT WITH THE PROPER CONDUIT FITTINGS TO THE WALL STUB

**GENERAL NOTES**

- 1) CONDUIT BENDS
  - A. PROVIDE THE LEAST AMOUNT OF BENDS AS POSSIBLE FROM POINT "A" TO POINT "F"
- 2) LABELING
  - A. LABEL CONDUIT TO COMPLY WITH SPECIFICATIONS
  - B. LABEL JUNCTION BOXES TO COMPLY WITH SPECIFICATIONS
  - C. LABEL GROUND WIRE TO COMPLY WITH SPECIFICATIONS

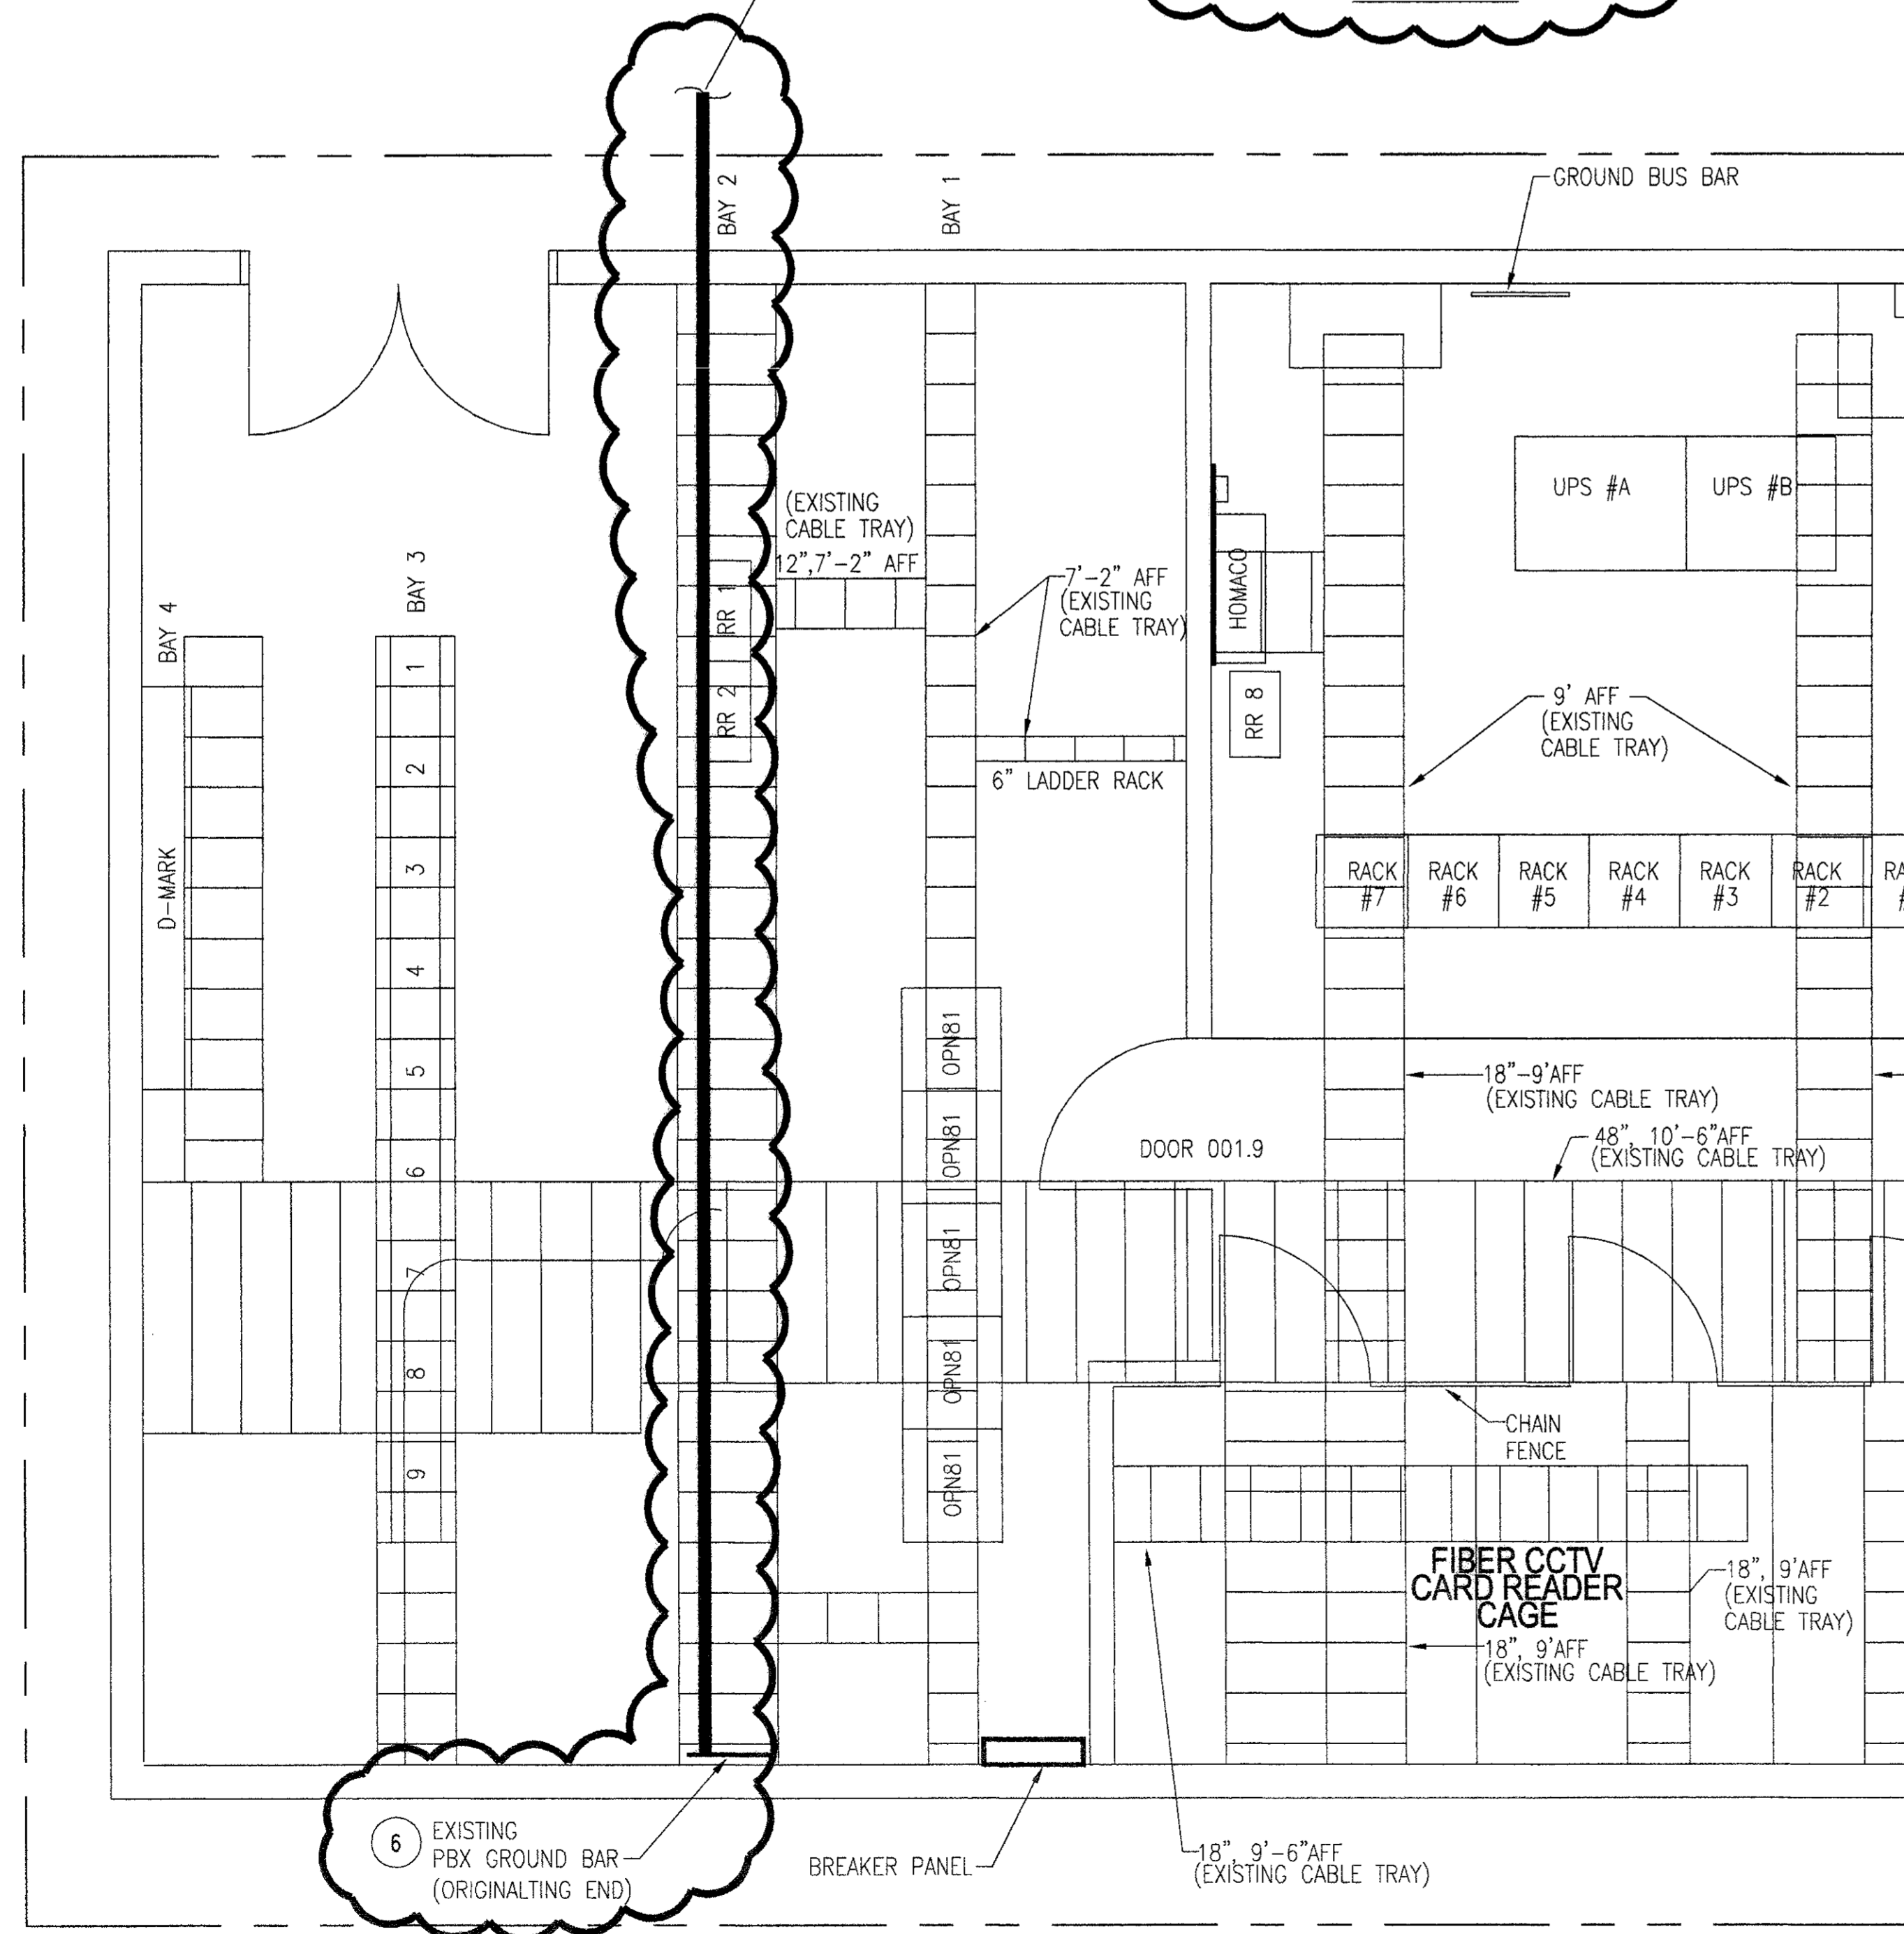

**TERMINAL "D" MDF  
LEVEL 74**

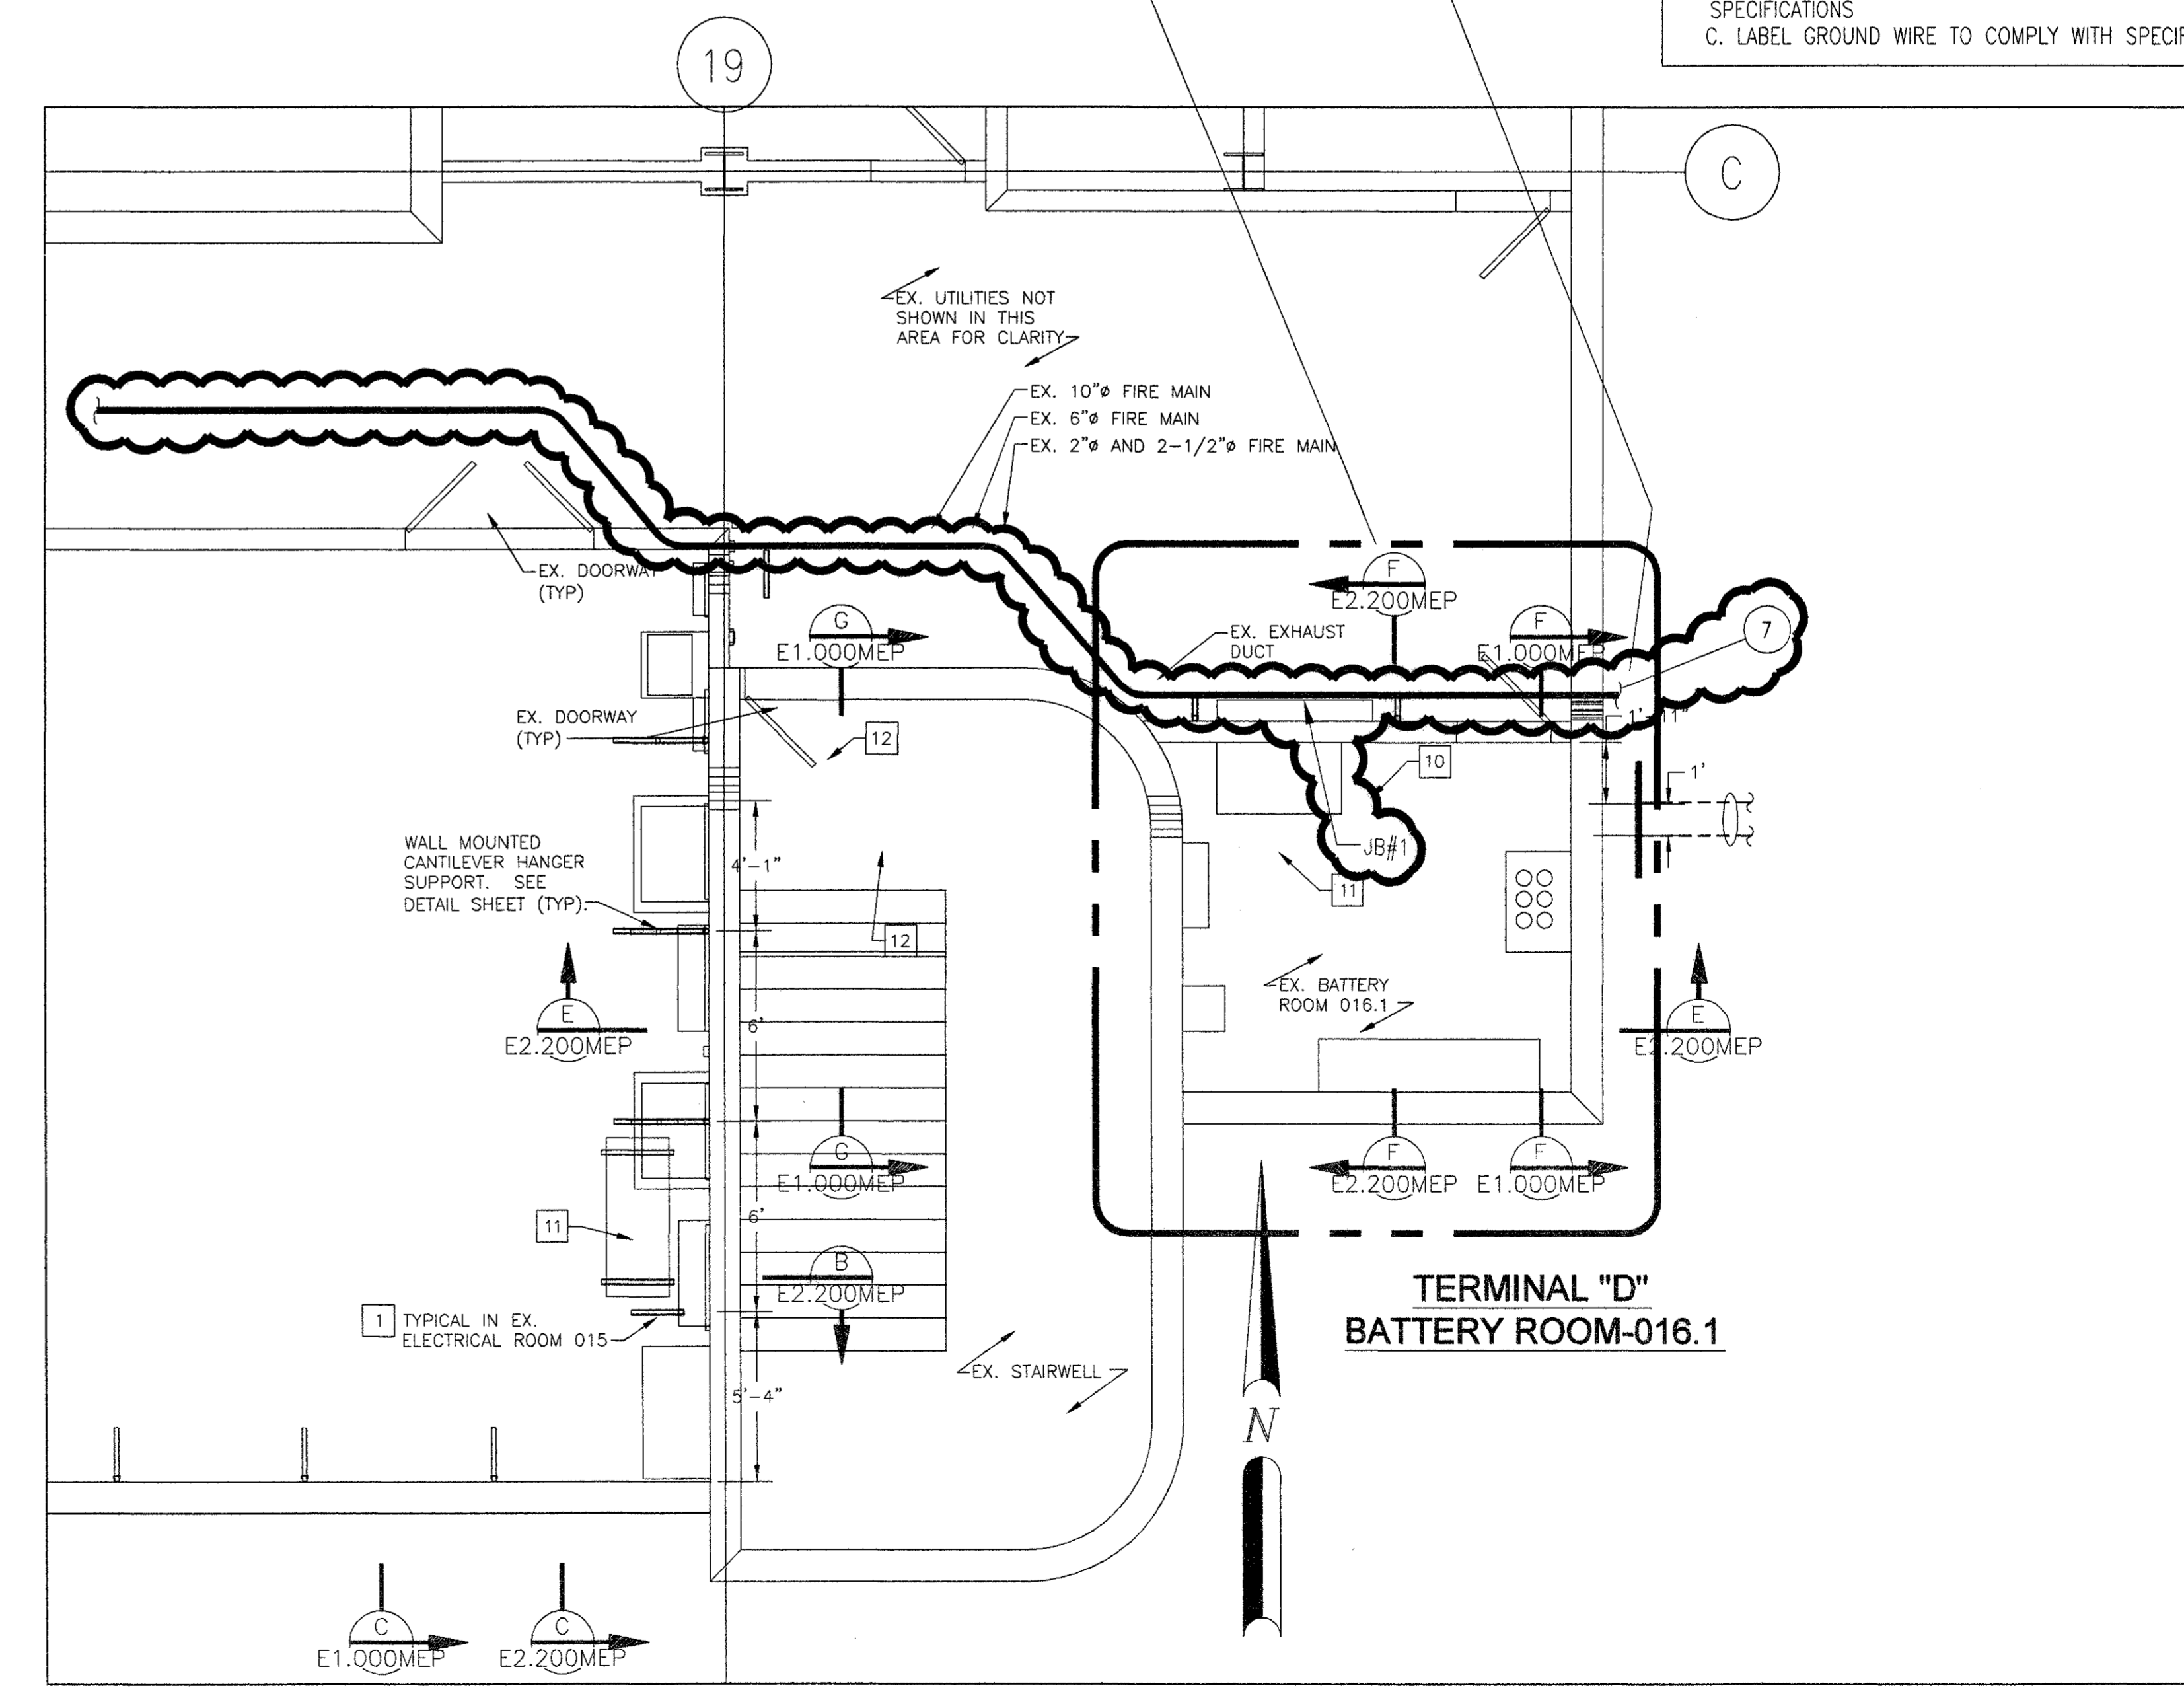

**TERMINAL "D"  
BATTERY ROOM-016.1**

REVISIONS			
NO.	DESCRIPTION	DATE	BY
1	ISSUED FOR BID	10/19/07	
2	REVIEWED	02/03/04	R&B
3	NEW SHEET		

PROJECT MGR:	EP
DESIGNER:	RD
DRAWN BY:	TS
CHECKED BY:	
DRAWING STANDARD:	

SCALE: NOT TO SCALE  
DATE: 2-03-2004

APPROVED BY: \_\_\_\_\_ DATE: \_\_\_\_\_


PROJECT NO.	538C
C.I.P. NO.	A-0354
H.A.S. NO.	538C
SHEET NO.	135

PLOT DATE: 2-18-04 FILE: A538C227.DWG



REVISIONS			
NO.	DESCRIPTION	DATE	BY
ISSUED FOR BID	10/14/01		
REVISED	01/11/02		
RECORD SET	05/13/05	EM	

**MAYOR**  
 LEE P. BROWN  
**CITY COUNCIL MEMBERS**  
 BRUCE TATRO  
 CAROL MIMS GALLOWAY  
 MARK GOLDBERG  
 ADA EDWARDS  
 ADDIE WISEMAN  
 MARK ELLIS  
 BERT KELLER

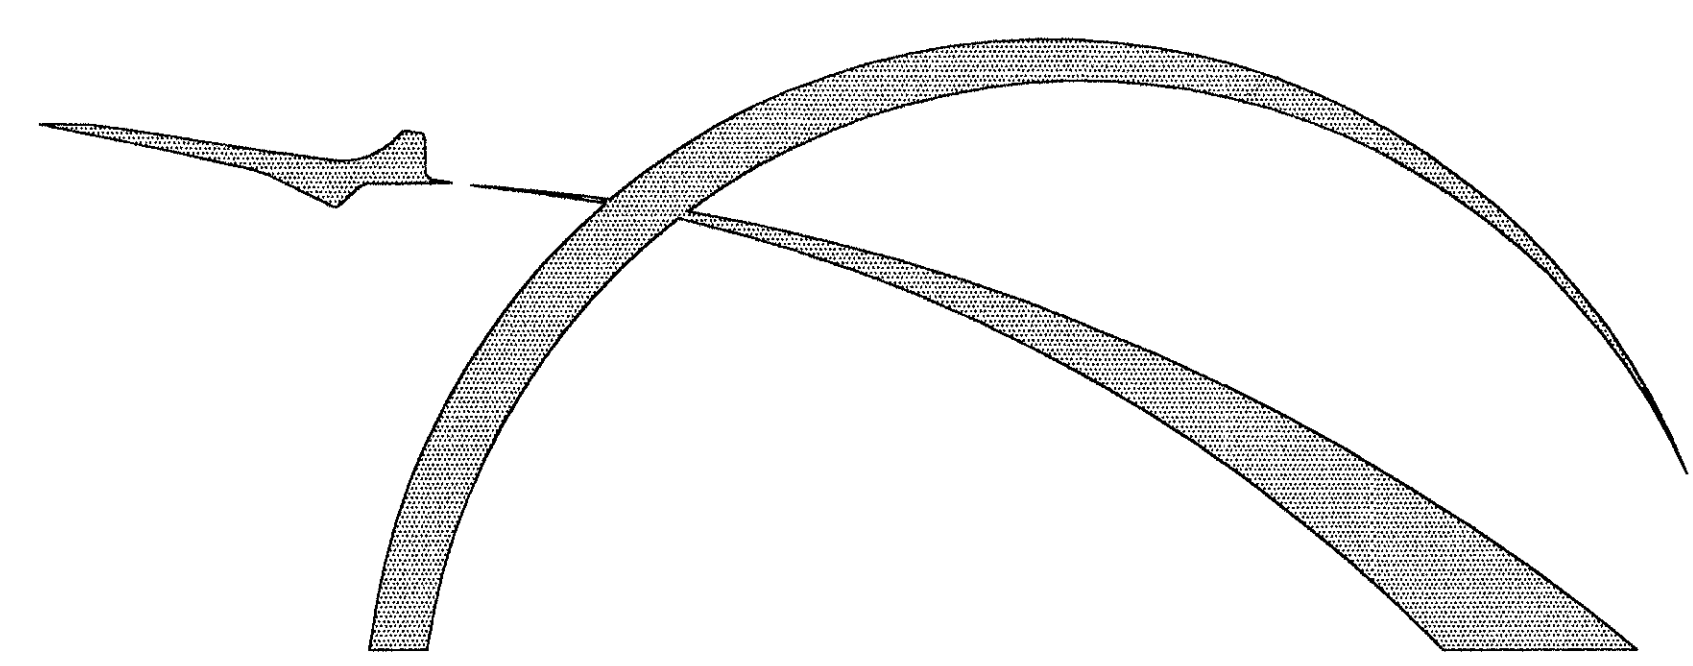

# HOUSTON AIRPORT SYSTEM

**CONTROLLER**  
 SYLVIA GARCIA  
**CITY COUNCIL MEMBERS**  
 GABRIEL VASQUEZ  
 CAROL ALVARADO  
 ANNISE PARKER  
 GORDON QUAN  
 SHELLY SEKULA-RODRIGUEZ  
 MICHAEL BERRY  
 CARROLL G. ROBINSON

PLANS FOR CONSTRUCTION  
 OF

## INTERNATIONAL SERVICES EXPANSION PROGRAM APM STATION AND PLATFORM AT GEORGE BUSH INTERCONTINENTAL AIRPORT, HOUSTON, TEXAS CONSTRUCTION PACKAGE ISSUED FOR BID

PROJECT NO. 536C  
 CIP NO. A-0354

PREPARED BY

**TRANSPORTATION CONSULTANT**  
 LEA+ELLIOTT, INC.  
**ARCHITECT**  
 REY DE LA REZA ARCHITECTS, INC.  
**STRUCTURAL ENGINEER**  
 CHARLES F. TERRY, INC.  
 HUITT-ZOLLARS, INC.  
**MEP ENGINEER**  
 SHAH SMITH & ASSOCIATES, INC.  
**CIVIL ENGINEER**  
 BROWN & GAY ENGINEERS, INC.

**SPECIALITY CONSULTANTS**  
 LIFE SAFETY ANALYSIS  
 ROLF JENSEN & ASSOCIATES, INC.  
 GRAPHICS & SIGNAGE  
 MORRIS ARCHITECTS  
 TELECOMMUNICATION  
 CDI  
 SECURITY/ ACCESS CONTROL SYSTEMS  
 GLOVER/ RESNICK & ASSOCIATES, INC.  
 ELEVATORS, ESCALATORS  
 PERSOHN/ HAHN


PB TEAM  
 09-14-2001

INTERNATIONAL • SERVICES • EXPANSION • PROGRAM  
 APM STATION + PLATFORM  
 COVER SHEET

PROJECT MGR: HEM  
 DESIGNER: SG  
 DRAWN BY: SEN  
 CHECKED BY: AA  
 DRAWING STANDARD: ISEP 07.20.2000

SCALE: NTS  
 DATE: 09/14/01

**RECORD DRAWINGS**  
 DO NOT MODIFY  
 Rey de la Reza Architects, Inc.  
 13 May 2005  
 Note: Information used to develop these documents was taken from Record of the Work Drawings prepared by the construction contractor, Clark Construction Group - Texas. The information provided by the contractor was not verified by the design firm named above.

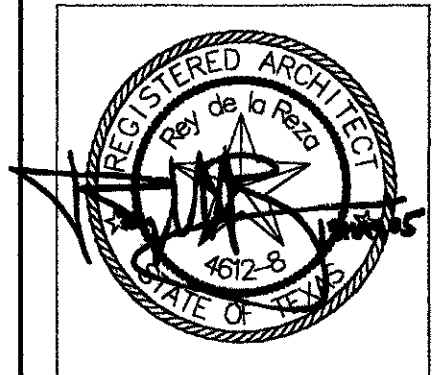


APPROVED BY: DATE:  
 DIRECTOR  
 HOUSTON AIRPORT SYSTEM  
 PROJECT NO. 1140  
 C.I.P. NO. A-0354  
 H.A.S. NO. 536C  
 SHEET NO.

536C

Z0.001

VOLUME I

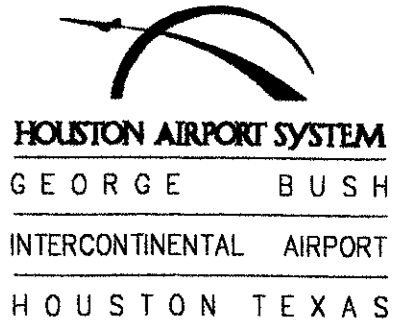

HOUSTON AIRPORT SYSTEM  
 GEORGE BUSH  
 INTERCONTINENTAL AIRPORT  
 HOUSTON TEXAS

Lee Elliott  
 1009 W RANDOLPH MILL RD  
 HOUSTON, TEXAS 77061  
 TEL: 817.261.1446  
 TEL: 817.881.3266

REVISIONS  
 NO. DESCRIPTION DATE BY  
 ISSUED FOR BID 10/18/01  
 RECORD SET 05/13/05 EM

INTERNATIONAL SERVICES EXPANSION PROGRAM  
 APM STATION & PLATFORM  
 DRAWING INDEX

SHEET NUMBER

DRAWING TITLE

GENERAL

Z0.001	COVER SHEET
Z1.000	DRAWING INDEX
Z1.001	GENERAL NOTES, ABBREVIATIONS, SYMBOLS AND CODE REVIEW
Z1.002	UL DESIGN ASSEMBLY CLASSIFICATIONS
Z1.003	UL DESIGN FIRESTOP ASSEMBLIES
Z1.004	ADA STANDARDS
Z2.000	LIFE SAFETY EGRESS PLANS

SHEET NUMBER

DRAWING TITLE

ARCHITECTURAL

A1.000	GENERAL SITE PLAN
A1.100	APM STATION SITE PLAN
A2.000	GROUND LEVEL PLAN
A2.100	LOBBY LEVEL PLAN
A2.200	PLATFORM LEVEL PLAN
A2.300	ROOF PLAN
A2.700	PARTITION TYPES
A2.800	DOOR SCHEDULE AND ROOM SCHEDULE
A2.801	DOOR TYPES AND DETAILS
A2.850	WINDOW SCHEDULE - CURTAIN WALLS
A2.880	SKYLIGHT - DETAILS
A3.000	LONGITUDINAL SECTION
A3.001	LONGITUDINAL SECTION
A3.002	LONGITUDINAL SECTION
A3.100	CROSS SECTIONS
A3.101	CROSS SECTIONS
A3.102	CROSS SECTION
A3.103	CROSS SECTIONS
A3.104	CROSS SECTIONS
A3.200	CROSS SECTIONS
A3.210	WALL SECTIONS
A3.220	WALL SECTIONS
A3.230	WALL SECTIONS
A3.240	SECTION & ELEVATIONS @ BUFFER
A3.300	WALL DETAILS
A3.400	ELEVATIONS
A3.500	NORTH ELEVATION
A3.501	SOUTH ELEVATION
A3.600	WEST & EAST ELEVATIONS
A5.000	INTERIOR ELEVATIONS
A6.000	REFLECTED CEILING PLAN @ GROUND LEVEL
A6.100	REFLECTED CEILING PLAN @ LOBBY LEVEL
A6.200	REFLECTED CEILING PLAN @ PLATFORM LEVEL
A7.100	STAIR 1 AND STAIR 3 - PLANS AND SECTION
A7.101	STAIR 2 - PLANS AND SECTION
A7.110	STAIR 1 - DETAILS
A7.120	STAIR 2 - DETAILS
A7.125	STAIR 2 - CURTAIN WALL CW-5 DETAILS
A7.200	ELEVATOR - PLANS AND SECTION
A7.300	ESCALATORS 1, 2 AND 3 - PLANS AND SECTION
A8.000	PLAN DETAILS - LOBBY LEVEL
A8.010	PLAN DETAILS - PLATFORM LEVEL
A8.020	PLAN & SECTION DETAILS
A8.020a	RFI RESPONSES
A8.030	CURTAIN WALL DETAILS
A8.040	DETAILS
A9.000	INTERIOR DETAILS
A9.001	INTERIOR DETAILS
A9.010	ELEVATOR DETAILS

SHEET NUMBER

DRAWING TITLE

STRUCTURAL

S0.100	STRUCTURAL GENERAL NOTES AND DETAILS
S0.201	PRESTRESSED CONCRETE BEAM SCHEDULES AND DETAILS
S0.301	CONCRETE BEAM/SLAB SCHEDULES AND REINFORCING DETAILS
S1.001	HORIZONTAL CONTROL ALIGNMENT
S1.101	APM GUIDEWAY PLAN + PROFILE
S2.001	FOUNDATION PLAN
S3.001	LOBBY LEVEL FRAMING PLANS
S3.002	PLATFORM LEVEL FRAMING PLAN
S3.003	APM STATION ROOF FRAMING PLAN
S3.004	APM GUIDEWAY BEAM FRAMING PLAN
S4.001	STAIR FRAMING PLANS AND SECTIONS
S4.002	STAIR SECTIONS AND DETAILS
S5.501	PRESTRESSED CONCRETE BEAM STANDARD DETAILS
S5.502	PERMANENT METAL DECK FORMS
S5.503	PRESTRESSED CONCRETE BEAM-MINIMUM ERECTION AND BRACING REQUIREMENTS
S5.504	CONCRETE DIAPHRAM AND MISCELLANEOUS DETAILS
S6.001	DRILLED SHAFT AND FOOTING DETAILS
S6.501	SECTIONS AND DETAILS
S6.502	SECTIONS AND DETAILS
S6.601	STEEL SECTIONS AND DETAILS
S6.602	STEEL SECTIONS AND DETAILS
S6.701	SECTION ALONG BENT #47
S6.702	SECTION ALONG BENT #48
S6.703	SECTION ALONG BENT #49
S6.704	SECTION ALONG BENT #50
S7.101	BENT FRAME #47 ELEVATION
S7.102	BENT FRAME #48 ELEVATION
S7.103	BENT FRAME #49 ELEVATION
S7.104	BENT FRAME #50 ELEVATION

MECHANICAL

M0.100	HVAC LEGEND AND SCHEDULES
M2.000	LOBBY HVAC PLAN
M2.001	PLATFORM HVAC PLAN
M4.000	HVAC SECTIONS
M4.001	HVAC SECTIONS
M5.000	HVAC DETAILS
M6.000	FLOW DIAGRAMS AND DETAILS

ELECTRICAL

E0.000	LEGEND & LOAD ANALYSIS
E1.000	LIGHTING FIXTURE SCHEDULE
E2.000	LOBBY - POWER AND FIRE ALARM PLAN
E2.001	PLATFORM - POWER AND FIRE ALARM PLAN
E3.000	GROUND LEVEL - LIGHTING PLAN
E3.001	LOBBY - LIGHTING PLAN
E3.002	PLATFORM - LIGHTING PLAN
E4.000	GROUNDING & LIGHTNING PROTECTION PLAN
E4.001	ELECTRICAL EAST STAIRWELL
E6.000	ONE LINE DIAGRAM
E6.001	ELECTRICAL DETAILS
E6.002	ELECTRICAL DETAILS

SHEET NUMBER

DRAWING TITLE

PLUMBING

P0.001	PLUMBING LEGEND, SCHEDULE AND RISERS
P2.001	GROUND FLOOR PLUMBING
P2.002	LOBBY LEVEL PLUMBING
P2.003	PLATFORM LEVEL PLUMBING
P2.004	ROOF PLAN

SECURITY

Q0.000	COVER SHEET, CONVENTIONS AND NOTES
Q1.000	GENERAL SITE PLAN
Q1.100	DEMARICATION PLAN
Q2.000	GROUND FLOOR
Q2.100	LOBBY LEVEL
Q2.200	PLATFORM LEVEL
Q5.000	SECURITY DETAILS AND POINT SCHEDULES
Q5.100	BLOCK AND RISER DIAGRAMS
Q5.101	SECURITY EQUIPMENT CONFIGURATION

TELECOMMUNICATION

T0.100	COMMUNICATIONS LEGEND
T2.000	COMMUNICATIONS LAYOUT GROUND FLOOR
T2.100	COMMUNICATIONS LAYOUT LOBBY LEVEL
T2.200	COMMUNICATIONS LAYOUT PLATFORM LEVEL
T2.210	COMMUNICATIONS LAYOUT IDFSP .1LL
T2.220	COMMUNICATIONS LAYOUT COURTESY PHONE LAYOUT
T2.230	COMMUNICATIONS LAYOUT GROUND RISER
T2.240	COMMUNICATIONS LAYOUT COPPER FIBER RISER DIAGRAM
T2.250	COMMUNICATIONS LAYOUT CONDUIT RISER DIAGRAM
T2.260	COMMUNICATIONS LAYOUT COMMUNICATIONS DETAILS
T2.270	COMMUNICATIONS LAYOUT COMMUNICATIONS DETAILS


GRAPHICS & SIGNAGE

G1.001	SIGN LOCATIONS LOBBY LEVEL
G1.002	SIGN LOCATIONS PLATFORM LEVEL

RECORD DRAWINGS  
 DO NOT MODIFY  
 Rey de la Reza Architects, Inc.  
 13 May 2005  
 Note: Information used to develop these documents was taken from Record of the Work Drawings prepared by the construction contractor, Clark Construction Group - Texas. The information provided by the contractor was not verified by the design firm named above.

PROJECT MGR: HEM  
 DESIGNER: SQ  
 DRAWN BY: SEM  
 CHECKED BY: AB  
 DRAWING STANDARD: ISEP 07.20.2000

SCALE: NTS  
 DATE: 09/14/01

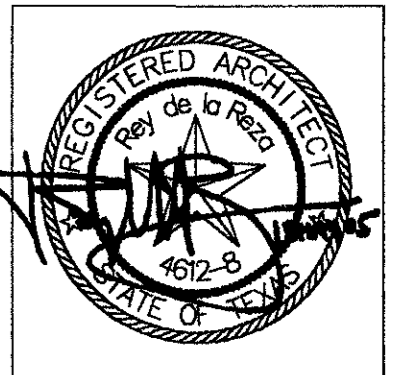

APPROVED BY: DATE:

DIRECTOR HOUSTON AIRPORT SYSTEM

PROJECT NO. 1140

C.I.P. NO. A-0354

H.A.S. NO. 536C

SHEET NO.


Z1.000








Design No. U465  
Nonbearing Wall Rating—1 HR.

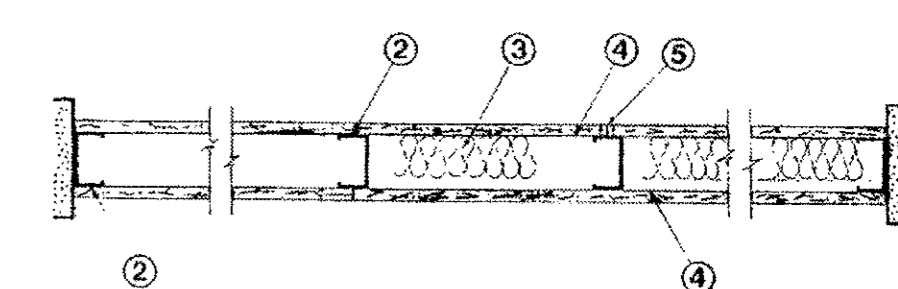


1. Floor and Ceiling Runners—(not shown)—Channel shaped runners, 3-1/8 in. wide (min), 1-1/4 in. high, formed from min No. 25 MSG (min No. 20 MSG when Item 4 is used) galv steel, attached to floor and ceiling with fasteners spaced 24 in. OC max.
  2. Steel Studs—Channel shaped, 3-1/8 in. wide (min), 1-1/4 in. high, 3/8 in. folded back returns, formed from min No. 25 MSG (min No. 20 MSG when Item 4C is used) galv steel spaced 24 in. OC max.
  3. Batts and Blankets—(Optional)—Mineral wool or glass fiber batts partially or completely filling stud cavity. See Batts and Blankets (B232) category for names of Classified companies.
  4. Wallboard, Gypsum—5/8 in. thick, 4 ft wide, attached to steel studs and floor and ceiling track with 1 in. long, Type 5 steel screws spaced 8 in. OC, along edges of board and 12 in. OC in the field of the board. Joints oriented vertically and staggered on opposite sides of the assembly. When attached to Item 6 (furring channels), wallboard is screw attached to furring channels with 1 in. long, Type 5 steel screws spaced 12 in. OC.
  5. American Gypsum Co.—Type AG-C.  
Canadian Gypsum Company—Types AR, C, IP-X2, SCX, SHX, WRK or WRX.  
Continental Gypsum Company—Types CG-C, CG-5, CG-6, CG-9, CGT-C.  
G-P Gypsum Corp.—Types 5, 9, C, GPF56.  
James Hardie Gypsum Inc.—Type GFC.  
Lafarge Gypsum, A Div. of Lafarge Corp.—Types LGFC, LGFC-C.  
National Gypsum Co., Charlotte, NC—Types FSW-6, FSW-6-G.  
National Gypsum Co., Riyadh, Saudi Arabia—Type FR or WR.  
Pabco Gypsum Co.—Type PG-C.  
Republix Gypsum Co.—Type RG-C.  
Standard Gypsum Corp.—Type SG-C.  
Temple-Inland Forest Products Corp.—Type TG-C.  
United States Gypsum Co.—Type AR, C, IP-X2, SCX, SHX, WRK or WRX.  
Yeso Panamericano SA de CV—Type AR, C, IP-X2, SCX, SHX, WRK or WRX.
  6. Westroc Inc.—Type Westroc Fireboard.
- 4A. Wallboard, Gypsum—(As an alternate to Item 4)—Nom 3/4 in. thick, 4 ft wide, installed as described in Item 4 with screw length increased to 1-1/4 in.
- 4B. Wallboard, Gypsum—(As an alternate to Item 4 and 4A)—5/8 in. thick installed as described in Item 4. Joint covering as specified under Item 4.
- 4C. Wallboard, Gypsum—(As an alternate to Item 4, 4A and 4B)—5/8 in. thick gypsum panels, installed as described in Item 4 with Type 5-12 screws. The length and spacing of the screws as specified under Item 4.
- Canadian Gypsum Company—Type FRX.  
United States Gypsum Co.—Type FRX.
5. Joint Tape and Compound—Vinyl, dry or premixed joint compound, applied in two coats to joints and screw heads; paper tape, 2 in. wide, embedded in first layer of compound over all joints. As an alternate, nominal 3/32 in. thick gypsum veneer plaster may be applied to the entire surface of classified veneer baseboard. Joints reinforced.
6. Furring Channel—(Optional-Not Shown)—Resilient G5 MSG galv steel furring channels spaced vertically max 24 in. OC. Flange portion attached to each 1-1/2 in. long Type 5-12 painted steel studs.
- \*Bearing the UL Classification Marking

Design No. U438  
Nonbearing Wall Rating—2 HR.

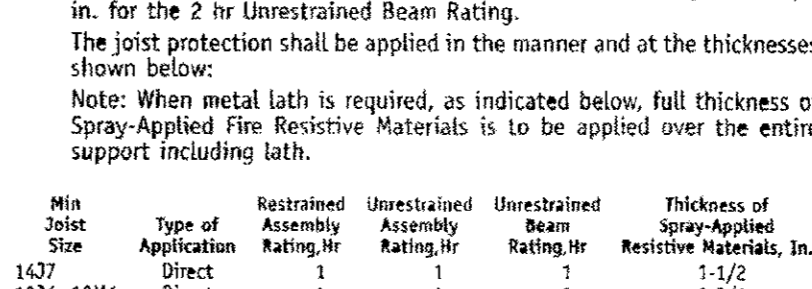


1. Floor and Ceiling Runners—(Not shown)—"U"-shaped runner, 1-1/2 in. wide with unequal legs of 1 in. and 2 in., fabricated from 24 MSG (min 20 MSG when Item 4B is used) galv steel. Runners positioned with short leg toward finished side of runners. Attached to structural supports with steel fasteners located not greater than 2 in. from ends and not greater than 24 in. OC.
  2. Steel Studs—"C"-shaped studs, 2-1/2 in. wide by 1-1/2 in. deep, fabricated from 25 MSG (min 20 MSG when Item 4B is used) galv steel. Cut to lengths 3/8 in. 1/2 in. less than floor to ceiling height and spaced 24 in. or 600 mm OC.
  3. Steel Studs—(Not shown)—"C"-shaped studs installed in place of "U"-shaped studs (Item 2) to secure the closure liner panels at the ends of walls. Fabricated from 25 MSG (min 20 MSG when Item 4B is used) galv steel, 2-1/2 in. wide, with one leg 1 in. long and two legs 3/4 in. long. Shorter legs 1 in. apart to engage gypsum liner panels. Cut to lengths 3/8 in. less than floor to ceiling height. Still listed as opening formed with "U"-shaped runners (Item 1) secured to "E"-shaped studs with angle clips and steel screws.
  4. Wallboard, Gypsum—1 in. thick gypsum wallboard liner panels, supplied in nom 24 in. or 600 mm (for metric spacing) widths. Panels cut 1 in. less in length than floor to ceiling height. Vertical edges inserted in "U"-shaped section of "C"-H studs. Free edge of end panels attached to long leg of "U"-runner with 1-5/8 in. long Type 5 steel screws spaced not greater than 12 in. OC.
  5. Canadian Gypsum Co.—Type S1X.  
United States Gypsum Co.—Type S1X.  
Yeso Panamericano SA de CV—Type S1X.
  6. Wallboard, Gypsum—1/2 in. thick, 4 ft. or 1200 mm (for metric spacing) wide wallboard applied vertically in two layers. Inner or base layer attached to studs with 1 in. long Type 5 steel screws spaced 24 in. OC along the edges and in the field of the boards. Outer or face layer attached to studs and "U"-runners with 1-5/8 in. long Type 5 steel screws spaced 12 in. along the edges and in the field of the boards, staggered from screws in inner layer. Joints between inner and outer layers staggered.
  - Outer layer joints covered with paper tape and joint compound. Exposed screw heads covered with joint compound.
  - As an alternate method, inner wallboard applied vertically, outer wallboard layer applied horizontally. Inner layer attached to studs with 1 in. Type 5 steel screws spaced 24 in. OC along vertical edges and in the field. Outer layer attached to the studs and "U"-runners over the inner layer with 1-5/8 in. long Type 5 steel screws spaced 12 in. OC in the field, along the vertical edges and to the floor and ceiling runners. Outer layer secured to inner layer wallboard with 1-1/2 in. long Type 6 steel screws located midway between studs and 1 in. from the horizontal joint.
  - American Gypsum Co.—Type AG-C or WRC.  
Canadian Gypsum Company—Type AR, C or WRC.  
Celotex Corp.—Type FRP.  
Continental Gypsum Company—Types CG-C, CG-5, CGT-C.  
G-P Gypsum Corp.—Type 5.  
James Hardie Gypsum Inc.—Type Max-C.  
Lafarge Gypsum, A Div. of Lafarge Corp.—Type LGFC-C.  
Pabco Gypsum Co.—Types PG-C.  
Republix Gypsum Co.—Type RG-C.  
Standard Gypsum Corp.—Type SG-C.  
Temple-Inland Forest Products Corp.—Type TG-C.  
United States Gypsum Co.—Type AR, C or WRC.  
Yeso Panamericano SA de CV—Type AR, C or WRC.
  - 4A. Wallboard, Gypsum—(As an alternate to Item 4)—Nom 3/4 in. thick, 4 ft wide gypsum panels, installed as described in Item 4 with Type 5-12 screws. The length and spacing of the screws as specified under Item 4.
  - 4B. Wallboard, Gypsum—(As an alternate to Item 4 and 4A)—5/8 in. thick, 4 ft wide gypsum panels, installed as described in Item 4 with Type 5-12 screws. The length and spacing of the screws as specified under Item 4.
  - Canadian Gypsum Company—Type FRX.  
United States Gypsum Company—Type FRX.
  5. Batts and Blankets—(Optional)—(Not shown)—Mineral wool or glass fiber batts partially or completely filling stud cavity. Any mineral wool or glass fiber batt material bearing the UL Classification Marking as to Fire Resistance.
- \*Bearing the UL Classification Marking

Design No. U411  
Nonbearing Wall Rating—2 HR.

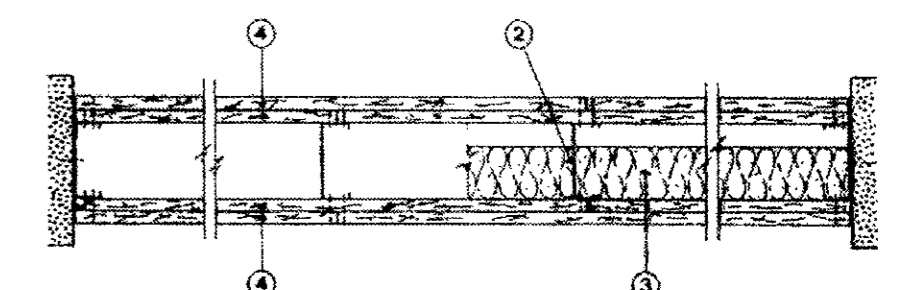


1. Floor and Ceiling Runner—(Not shown)—Min. 25 MSG (min 20 MSG when Item 4B is used) galv steel, 2-1/2 in. wide (min), attached to floor and ceiling with fasteners 24 in. OC max.
  2. Steel Studs—Min 2-1/2 in. wide, 1-1/4 in. high, 3/8 in. return, formed from min 25 MSG (min 20 MSG when Item 4B is used) galv steel spaced 24 in. OC max.
  3. Batts and Blankets—(Optional)—Mineral wool or glass fiber batts partially or completely filling stud cavity. See Batts and Blankets (B232) category for names of Classified companies.
  4. Wallboard, Gypsum—5/8 in. thick, 4 ft wide, attached to steel studs and floor and ceiling runner track with 1-5/8 in. long Type 5 steel screws spaced 12 in. OC.
  - Optional: (Lines Attached Section). Inner layer attached to studs with 1 in. long Type 5 steel screws spaced 16 in. OC in the field and along the vertical edges. Outer layer attached to the studs over the inner layer with 1-5/8 in. long Type 5 steel screws spaced 16 in. OC in the field and along the vertical edges and 12 in. OC to the floor and ceiling runners. Joints of screw-attached outer layer offset from inner layer joints. Joints of outer layer may be taped or un taped.
  - Nom 3/32 in. thick gypsum veneer plaster may be applied to the entire surface of classified veneer baseboard. Joints reinforced.
  - American Gypsum Co.—Type AG-C or AGX-11.  
Boral Gypsum Inc.—Type BG-C, B0603, B062 or B061.  
Canadian Gypsum Company—Type AR, C, FCV, IP-X1, IP-X2, SCX, SHX, WRK or WRX.  
Celotex Corp.—Type FRP.  
Continental Gypsum Company—Types CG-C, CG-3, CG-3-C, CG-5, CG-5-C, CG-9, CGT-C.  
G-P Gypsum Corp.—Types 5, 9, C, DGG, GPF56.  
James Hardie Gypsum Inc.—Types Fire X, Max-C.  
Lafarge Gypsum, A Div. of Lafarge Corp.—Types LGFC, LGFC-C, LGFC-C.  
National Gypsum Co., Charlotte, NC—Type FSW, FSW-3 or FSW-6.  
National Gypsum Co., Riyadh, Saudi Arabia—Types FR, WR.  
Pabco Gypsum—Type PG-C, PG-3, PG-5, PG-9 or PG-C.  
Republix Gypsum Co.—Type RG-C.  
Standard Gypsum Corp.—Type SG-C, SG-C or SG-C-G.  
Temple-Inland Forest Products Corp.—Types T, TG-C, VFB-Type 1.  
United States Gypsum Co.—Type AR, C, FCV, IP-X1, IP-X2, SCX, SHX, WRK or WRX.  
Yeso Panamericano SA de CV—Type AR, C, FCV, IP-X1, IP-X2, SCX, SHX, WRK or WRX.
  - 4A. Wallboard, Gypsum—(As an alternate to Item 4)—Nom 3/4 in. thick, installed as described in Item 4 with 1-1/4 in. long Type 5 screws for inner layer and 2-1/4 in. long Type 5 screws for outer layer.
  - 4B. Wallboard, Gypsum—(As an alternate to Item 4 and 4A)—Nom 5/8 in. thick gypsum panels, installed as described in Item 4 with Type 5-12 steel screws. The length and spacing of the screws as specified under Item 4.
  - Canadian Gypsum Company—Type FRX.  
United States Gypsum Company—Type FRX.
- \*Bearing the UL Classification Marking

Design No. U438  
Nonbearing Wall Rating—2 HR.

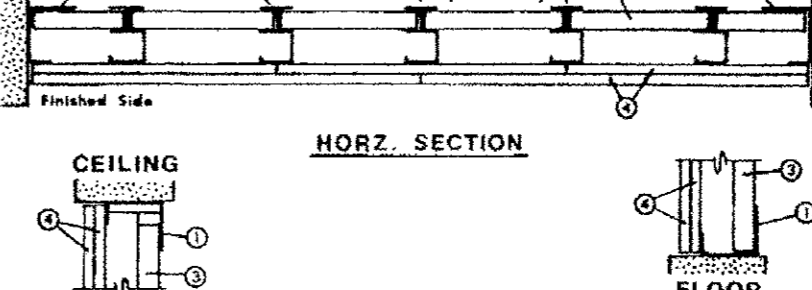


1. Floor and Ceiling Runners—(Not shown)—"U"-shaped runner, 1-1/2 in. wide with unequal legs of 1 in. and 2 in., fabricated from 24 MSG (min 20 MSG when Item 4B is used) galv steel. Runners positioned with short leg toward finished side of runners. Attached to structural supports with steel fasteners located not greater than 2 in. from ends and not greater than 24 in. OC.
  2. Steel Studs—"C"-shaped studs, 2-1/2 in. wide by 1-1/2 in. deep, fabricated from 25 MSG (min 20 MSG when Item 4B is used) galv steel. Cut to lengths 3/8 in. 1/2 in. less than floor to ceiling height and spaced 24 in. or 600 mm OC.
  3. Steel Studs—(Not shown)—"C"-shaped studs installed in place of "U"-shaped studs (Item 2) to secure the closure liner panels at the ends of walls. Fabricated from 25 MSG (min 20 MSG when Item 4B is used) galv steel, 2-1/2 in. wide, with one leg 1 in. long and two legs 3/4 in. long. Shorter legs 1 in. apart to engage gypsum liner panels. Cut to lengths 3/8 in. less than floor to ceiling height. Still listed as opening formed with "U"-shaped runners (Item 1) secured to "E"-shaped studs with angle clips and steel screws.
  4. Wallboard, Gypsum—1 in. thick gypsum wallboard liner panels, supplied in nom 24 in. or 600 mm (for metric spacing) widths. Panels cut 1 in. less in length than floor to ceiling height. Vertical edges inserted in "U"-shaped section of "C"-H studs. Free edge of end panels attached to long leg of "U"-runner with 1-5/8 in. long Type 5 steel screws spaced not greater than 12 in. OC.
  5. Canadian Gypsum Co.—Type S1X.  
United States Gypsum Co.—Type S1X.  
Yeso Panamericano SA de CV—Type S1X.
  6. Wallboard, Gypsum—1/2 in. thick, 4 ft. or 1200 mm (for metric spacing) wide wallboard applied vertically in two layers. Inner or base layer attached to studs with 1 in. long Type 5 steel screws spaced 24 in. OC along the edges and in the field of the boards. Outer or face layer attached to studs and "U"-runners with 1-5/8 in. long Type 5 steel screws spaced 12 in. along the edges and in the field of the boards, staggered from screws in inner layer. Joints between inner and outer layers staggered.
  - Outer layer joints covered with paper tape and joint compound. Exposed screw heads covered with joint compound.
  - As an alternate method, inner wallboard applied vertically, outer wallboard layer applied horizontally. Inner layer attached to studs with 1 in. Type 5 steel screws spaced 24 in. OC along vertical edges and in the field. Outer layer attached to the studs and "U"-runners over the inner layer with 1-5/8 in. long Type 5 steel screws spaced 12 in. OC in the field, along the vertical edges and to the floor and ceiling runners. Outer layer secured to inner layer wallboard with 1-1/2 in. long Type 6 steel screws located midway between studs and 1 in. from the horizontal joint.
  - American Gypsum Co.—Type AG-C or WRC.  
Canadian Gypsum Company—Type AR, C or WRC.  
Celotex Corp.—Type FRP.  
Continental Gypsum Company—Types CG-C, CG-5, CGT-C.  
G-P Gypsum Corp.—Type 5.  
James Hardie Gypsum Inc.—Type Max-C.  
Lafarge Gypsum, A Div. of Lafarge Corp.—Type LGFC-C.  
Pabco Gypsum Co.—Types PG-C.  
Republix Gypsum Co.—Type RG-C.  
Standard Gypsum Corp.—Type SG-C.  
Temple-Inland Forest Products Corp.—Type TG-C.  
United States Gypsum Co.—Type AR, C or WRC.  
Yeso Panamericano SA de CV—Type AR, C or WRC.
  - 4A. Wallboard, Gypsum—(As an alternate to Item 4)—Nom 3/4 in. thick, 4 ft wide gypsum panels, installed as described in Item 4 with Type 5-12 screws. The length and spacing of the screws as specified under Item 4.
  - 4B. Wallboard, Gypsum—(As an alternate to Item 4 and 4A)—5/8 in. thick, 4 ft wide gypsum panels, installed as described in Item 4 with Type 5-12 screws. The length and spacing of the screws as specified under Item 4.
  - Canadian Gypsum Company—Type FRX.  
United States Gypsum Company—Type FRX.
  5. Batts and Blankets—(Optional)—(Not shown)—Mineral wool or glass fiber batts partially or completely filling stud cavity. Any mineral wool or glass fiber batt material bearing the UL Classification Marking as to Fire Resistance.
- \*Bearing the UL Classification Marking

Design No. X723  
Ratings—1, 2, 3 and 4 Hr.

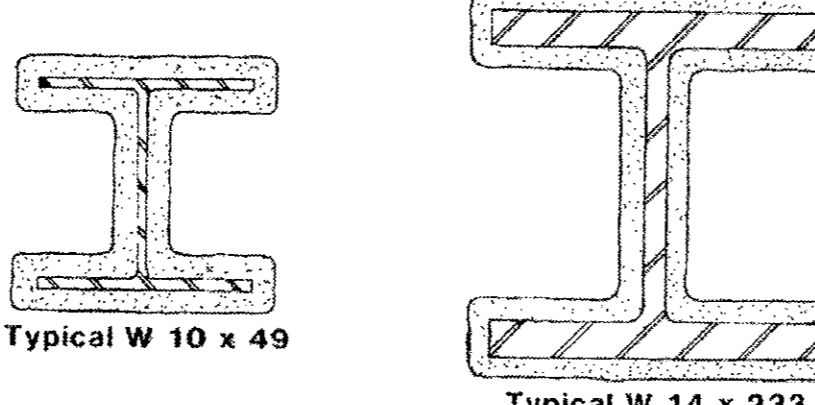


1. Steel Column—Min size of column, a W8x8 with outside dimensions of 8 by 8 1/2 in. with a flange thickness of 7/16 in., a web thickness of 5/16 in. and a cross-sectional area of 8.23 sq in.
  2. Spray-Applied Fire Resistive Materials—See table below for appropriate thickness. Applied by mixing with water and spraying in one or more coats to steel surfaces which must be clean and free of dirt, loose scale and oil. Min avg and min ind density of 15/14 pcf respectively. For method of density determination, see Design Information Section, preceding these designs.
- | Rating-Hr. | Min. Thickness-In. |
|------------|--------------------|
| 1          | 2-1/16             |
| 2          | 2-1/2              |
| 3          | 3-3/8              |
| 4          | 3/4                |
- The thicknesses contained in the table above are applicable when the Spray-Applied Fire Resistive Materials thickness applied to the column flange tips is reduced to 1/2 that shown in the table below:
- | Rating-Hr. | Min. Thickness-In. |
|------------|--------------------|
| 1          | 2-1/16             |
| 2          | 2-1/4              |
| 3          | 3-1/2              |
| 4          | 13/16              |
- Construction Products Div., W. R. Grace & Co. of Canada Ltd.—Types MK-4, MK-5.  
Grace Construction Products—Types MK-4, MK-5, MK-6/HY, MK-6S, RG, Sonotex 1.  
Grace Korea Inc.—Types MK-6/CBF, MK-6/ED, MK-6/HY, MK-6S, Sonotex 1.  
Pyrok Inc.—Type LD.
- Southwest Vermiculite Co., Inc.—Types 4, 5, SEF, SGP, SMD, BEF, RGP, SMD, SEF, SGP, SMD.  
Vermiculite Products, Inc.—Types MK-4, MK-5, VP4, VPS.  
\*Bearing the UL Classification Marking

Design No. X799  
Ratings—1, 1-1/2, 2, 3 and 4 Hr

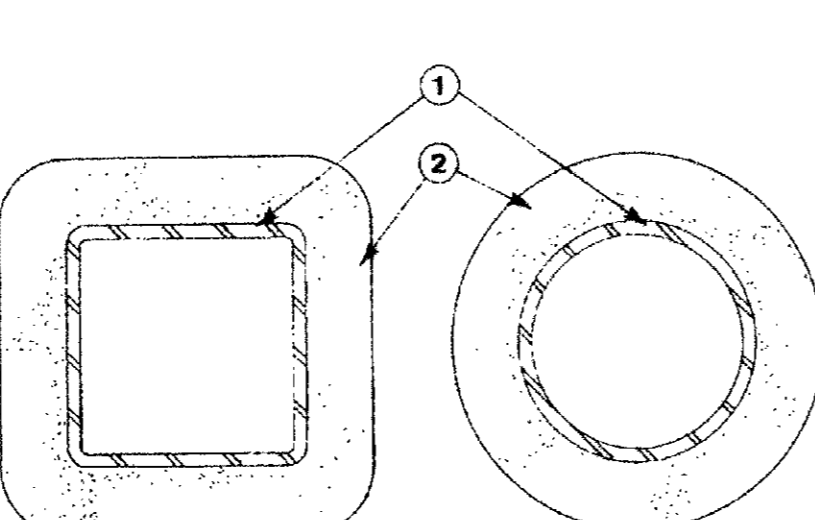

1. Beam—W6x16 min size. As alternate to steel beams, joist girders—(Not shown)—20 in. min depth and 13 lb per lin ft min weight.
  2. Steel Joist—Types 10K4, 10K4, 10K4, 14J7 or 14K4 min size. NOTE: Design load shall stress 10K4 joist to a max tensile stress of 22 ksi.
  3. Roof Covering—Consisting of hot mopped or cold application materials compatible with insulation(s) described herein which provide Class A, B or C coverings. See Roofing Materials and Systems Directory-Roof Covering Materials (RTV).
  4. Spray-Applied Fire Resistive Materials—Applied by mixing with water and spraying in more than one coat to the thickness shown below, to steel surfaces which are clean and free of dirt, loose scale and oil. Min avg and min ind density of 19/16 pcf for Type CP-2 and 23/21 pcf for Type P-20. For method of density see Design Information Section, Sprayed Material.
- | Column Size | Min. Thickness (In.) |
|-------------|----------------------|
| 4 in.       | 1-1/2                |
| 6 in.       | 2                    |
| 8 in.       | 2-1/2                |
| 10 in.      | 3                    |
| 12 in.      | 3-1/2                |
| 14 in.      | 4                    |
| 16 in.      | 4-1/2                |
| 18 in.      | 5                    |
| 20 in.      | 5-1/2                |
| 22 in.      | 6                    |
| 24 in.      | 6-1/2                |
| 26 in.      | 7                    |
| 28 in.      | 7-1/2                |
| 30 in.      | 8                    |
| 32 in.      | 8-1/2                |
| 34 in.      | 9                    |
| 36 in.      | 9-1/2                |
| 38 in.      | 10                   |
| 40 in.      | 10-1/2               |
| 42 in.      | 11                   |
| 44 in.      | 11-1/2               |
| 46 in.      | 12                   |
| 48 in.      | 12-1/2               |
| 50 in.      | 13                   |
| 52 in.      | 13-1/2               |
| 54 in.      | 14                   |
| 56 in.      | 14-1/2               |
| 58 in.      | 15                   |
| 60 in.      | 15-1/2               |
| 62 in.      | 16                   |
| 64 in.      | 16-1/2               |
| 66 in.      | 17                   |
| 68 in.      | 17-1/2               |
| 70 in.      | 18                   |
| 72 in.      | 18-1/2               |
| 74 in.      | 19                   |
| 76 in.      | 19-1/2               |
| 78 in.      | 20                   |
| 80 in.      | 20-1/2               |
| 82 in.      | 21                   |
| 84 in.      | 21-1/2               |
| 86 in.      | 22                   |
| 88 in.      | 22-1/2               |
| 90 in.      | 23                   |
| 92 in.      | 23-1/2               |
| 94 in.      | 24                   |
| 96 in.      | 24-1/2               |
| 98 in.      | 25                   |
| 100 in.     | 25-1/2               |
- Isoltek International—Types CP-2, P-20.  
Hoy Yuan Industrial Ltd.—Types CP-2, P-20.  
Newkem Products Corp.—Types CP-2, P-20.  
P T Hume Concrete Indonesia—Type CP-2.  
Pronar Contract Services PTE. Ltd.—Types CP-2, P-20.  
Shin Sung Trading Co. Ltd.—Types CP-2, P-20.  
\*Bearing the UL Classification Marking

Design No. P711  
Restrained Assembly Ratings—1, 1-1/2 or 2 Hr.  
(See Items 3, 7 and 8A)  
Unrestrained Assembly Ratings—1, 1-1/2 or 2 Hr.  
(See Items 3, 7 and 8A)  
Unrestrained Beam Rating—1, 1-1/2 or 2 Hr.  
(See Items 7 and 8A)

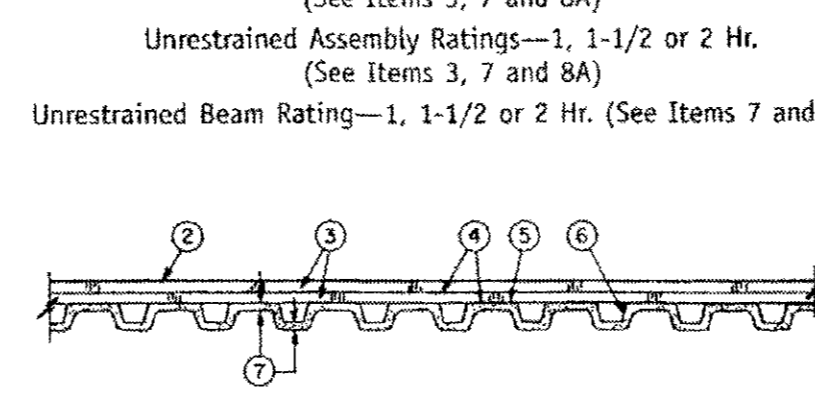

1. Beam—W6x16 min size. As alternate to steel beams, joist girders—(Not shown)—20 in. min depth and 13 lb per lin ft min weight.
  2. Steel Joist—Types 10K4, 10K4, 10K4, 14J7 or 14K4 min size. NOTE: Design load shall stress 10K4 joist to a max tensile stress of 22 ksi.
  3. Roof Covering—Consisting of hot mopped or cold application materials compatible with insulation(s) described herein which provide Class A, B or C coverings. See Roofing Materials and Systems Directory-Roof Covering Materials (RTV).
  4. Spray-Applied Fire Resistive Materials—Applied by mixing with water and spraying in more than one coat to the thickness shown below, to steel surfaces which are clean and free of dirt, loose scale and oil. Min avg and min ind density of 19/16 pcf for Type CP-2 and 23/21 pcf for Type P-20. For method of density see Design Information Section, Sprayed Material.
- | Column Size | Min. Thickness (In.) |
|-------------|----------------------|
| 4 in.       | 1-1/2                |
| 6 in.       | 2                    |
| 8 in.       | 2-1/2                |
| 10 in.      | 3                    |
| 12 in.      | 3-1/2                |
| 14 in.      | 4                    |
| 16 in.      | 4-1/2                |
| 18 in.      | 5                    |
| 20 in.      | 5-1/2                |
| 22 in.      | 6                    |
| 24 in.      | 6-1/2                |
| 26 in.      | 7                    |
| 28 in.      | 7-1/2                |
| 30 in.      | 8                    |
| 32 in.      | 8-1/2                |
| 34 in.      | 9                    |
| 36 in.      | 9-1/2                |
| 38 in.      | 10                   |
| 40 in.      | 10-1/2               |
| 42 in.      | 11                   |
| 44 in.      | 11-1/2               |
| 46 in.      | 12                   |
| 48 in.      | 12-1/2               |
| 50 in.      | 13                   |
| 52 in.      | 13-1/2               |
| 54 in.      | 14                   |
| 56 in.      | 14-1/2               |
| 58 in.      | 15                   |
| 60 in.      | 15-1/2               |
| 62 in.      | 16                   |
| 64 in.      | 16-1/2               |
| 66 in.      | 17                   |
| 68 in.      | 17-1/2               |
| 70 in.      | 18                   |
| 72 in.      | 18-1/2               |
| 74 in.      | 19                   |
| 76 in.      | 19-1/2               |
| 78 in.      | 20                   |
| 80 in.      | 20-1/2               |
| 82 in.      | 21                   |
| 84 in.      | 21-1/2               |
| 86 in.      | 22                   |
| 88 in.      | 22-1/2               |
| 90 in.      | 23                   |
| 92 in.      | 23-1/2               |
| 94 in.      | 24                   |
| 96 in.      | 24-1/2               |
| 98 in.      | 25                   |
| 100 in.     | 25-1/2               |
- Isoltek International—Types CP-2, P-20.  
Hoy Yuan Industrial Ltd.—Types CP-2, P-20.  
Newkem Products Corp.—Types CP-2, P-20.  
P T Hume Concrete Indonesia—Type CP-2.  
Pronar Contract Services PTE. Ltd.—Types CP-2, P-20.  
Shin Sung Trading Co. Ltd.—Types CP-2, P-20.  
\*Bearing the UL Classification Marking

For method of density determination, refer to Design Information Section.

For the W6x16 wide flange beam, the thickness of Spray-Applied Fire Resistive Materials shall be 7/8 in. for the 1-1/2 hr Unrestrained Beam Rating, 1-3/8 in. for the 1-1/2 hr Unrestrained Beam Rating, and 1-1/2 in. for the 2 hr Unrestrained Beam Rating.

The joist protection shall be applied in the manner and at the thicknesses shown below.

Note: When metal lath is required, as indicated below, full thickness of Spray-Applied Fire Resistive Materials is to be applied over the entire support including lath.

Min. Size	Type of Application	Restrained Assembly Rating-Hr.	Unrestrained Assembly Rating-Hr.	Unrestrained Assembly Rating-Hr.	Thickness of Spray-Applied Fire Resistive Material, In.
14K7	Direct	1	1	1	1-1/2
10K4, 10K4	Direct	1	1	1	1-1/4
10K4, 10K4	Direct	1	1-1/2	1-1/2	2-1/4
10K4, 10K4	Direct	2	2	2	2-3/8
12K4, 14K4	Direct	1	1	1	2
12K4, 14K4	Direct	1-1/2	1-1/2	1-1/2	2-1/4
12K4, 14K4	Direct	2	2	2	2-3/8
12K4, 14K4	Lath	1-1/2	1-1/2	1-1/2	1-3/4
12K4, 14K4	Lath	2	2	2	1-7/8

When W6x16 beams and min size 12K4, 14K7 or 14K4 joists are used, thickness of the spray-applied resistive material applied to the roof deck units shall be:

Restrained Or Unrestrained Assembly Rating Hr.	W/Gypsum Sheathing	W/Gypsum Sheathing
1	1-1/16	1-1/4
2	1-1/8	1-1/2
2	1-7/16	1-3/4

When min size 10K4 or 10K4 joists are used, thickness of spray-applied resistive material applied to the roof deck units, with or without gypsum sheathing, shall be:

Restrained Or Unrestrained Assembly Rating Hr.	Thin Or Spray-Applied Resistive Hits On Steel Deck	W/Gypsum Sheathing
1	1-3/8	1-1/4
1-1/2	1-7/8	1-1/2
2	1-7/8	1-3/4


When min size 10K4 or 10K4 joists are used, thickness of spray-applied resistive material applied to the roof deck units, with or without gypsum sheathing, shall be:

Restrained Or Unrestrained Assembly Rating Hr.	Thin Or Spray-Applied Resistive Hits On Steel Deck
1	1-3/8
1-1/2	1-7/8
2	1-7/8


Construction Products Div., W. R. Grace & Co. of Canada Ltd.—Types MK-4, MK-5.  
Grace Construction Products—Types MK-4, MK-5, MK-6/HY, MK-6S, RG, Sonotex 1.  
Grace Korea Inc.—Types MK-6/CBF, MK-6/ED, MK-6/HY, MK-6S, Sonotex 1.  
Pyrok Inc.—Type LD.  
Southwest Vermiculite Co., Inc.—Types 4, 5, SEF, SGP, SMD, BEF, RGP, SMD, SEF, SGP, SMD.  
Vermiculite Products, Inc.—Types MK-4, MK-5, VP4, VPS.  
\*Bearing the UL Classification Marking




PLOT DATE: 02/04/02 HAS FILE: ASBZ0203

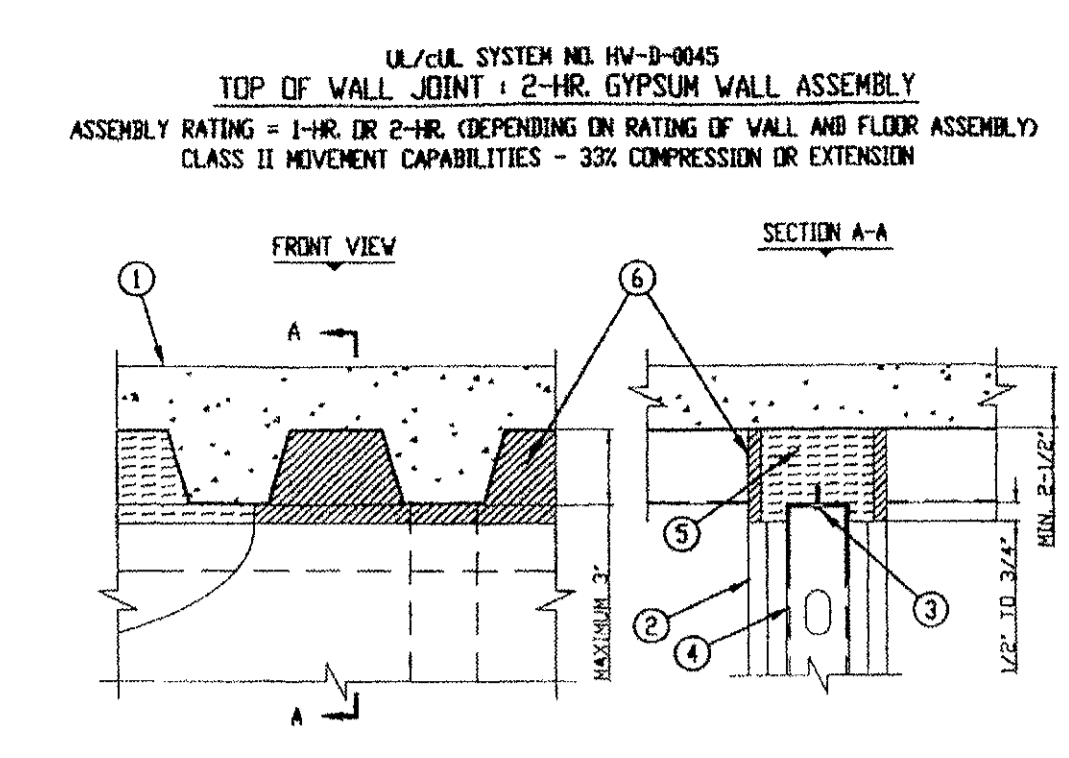


1. LIGHTWEIGHT OR NORMAL WEIGHT CONCRETE FLOOR OR 2-1/2" THICK OVER METAL DECKING (1-HR. OR 2-HR. FIRE-RATING).
2. GYPSUM WALL ASSEMBLY (UL/CUL CLASSIFIED U300 SERIES WALL) (1-HR. OR 2-HR. FIRE-RATING) CAPABLE OF UNRESTRICTED MOVEMENT AS REQUIRED BY DESIGNER.
3. METAL DEFLECTION TRACK FASTENED TO UNDERSIDE OF THE DECK. DEFLECTION TRACK SHALL HAVE 2" FLANGES AND CONSIST OF A SINGLE TRACK OR NESTED DOUBLE TRACK SYSTEM.
4. STEEL STUDS TO BE MIN. 2-1/2" WIDE. STUD SPACING SHOULD NOT EXCEED 24" CENTER TO CENTER.
5. MINIMUM 2-3/4" OR 4" THICKNESS MINERAL WOOL OR 4 PCF DENSITY, FER 1-HR. OR 2-HR. FIRE-RATED WALLS RESPECTIVELY, TO BE FIRMLY PACKED INTO FLUTES AND RECESSED 1/2" ON EACH SIDE OF WALL TO ACCOMMODATE SEALANT.
6. MINIMUM 1/2" DEPTH HILTI FS-ONE INTUMESCENT FIRESTOP SEALANT ON BOTH SIDES OF WALL ASSEMBLY.

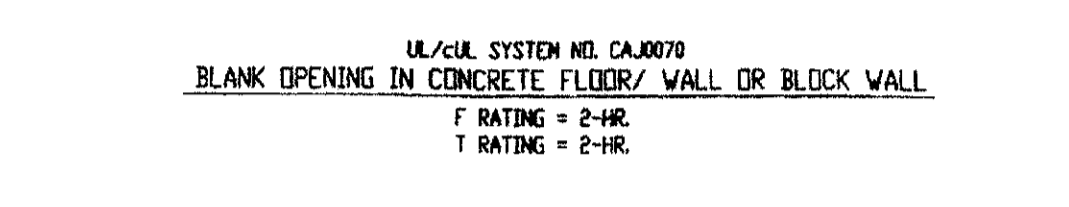


1. CONCRETE FLOOR OR WALL ASSEMBLY (2-HR. FIRE-RATING).
2. ANY UL/CUL CLASSIFIED CONCRETE BLOCK WALL.
3. MINIMUM 1/2" DEPTH HILTI FS-ONE INTUMESCENT FIRESTOP SEALANT IS REQUIRED ON BOTH SIDES OF A WALL ASSEMBLY.

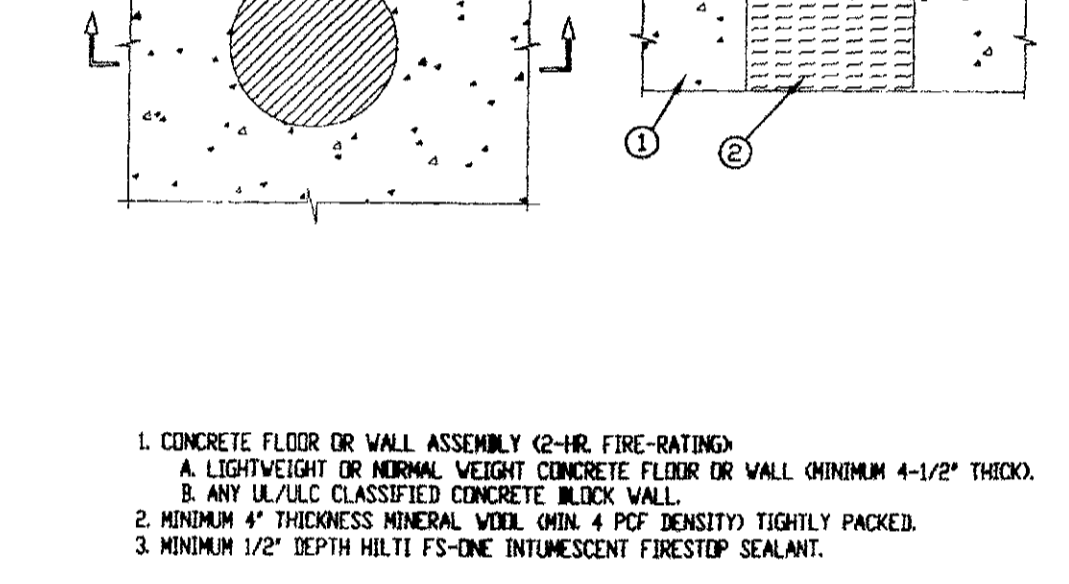


1. CONCRETE FLOOR OR WALL ASSEMBLY (2-HR. FIRE-RATING).
2. ANY UL/CUL CLASSIFIED CONCRETE BLOCK WALL.
3. MINIMUM 1/2" DEPTH HILTI FS-ONE INTUMESCENT FIRESTOP SEALANT IS REQUIRED ON BOTH SIDES OF A WALL ASSEMBLY.

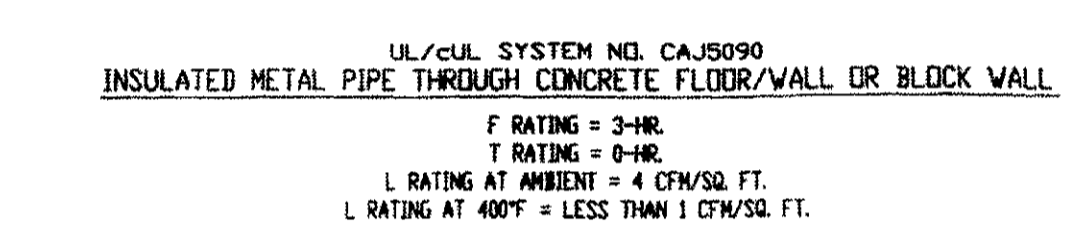


1. CONCRETE FLOOR OR WALL ASSEMBLY (2-HR. FIRE-RATING).
2. ANY UL/CUL CLASSIFIED CONCRETE BLOCK WALL.
3. MINIMUM 1/2" DEPTH HILTI FS-ONE INTUMESCENT FIRESTOP SEALANT IS REQUIRED ON BOTH SIDES OF A WALL ASSEMBLY.

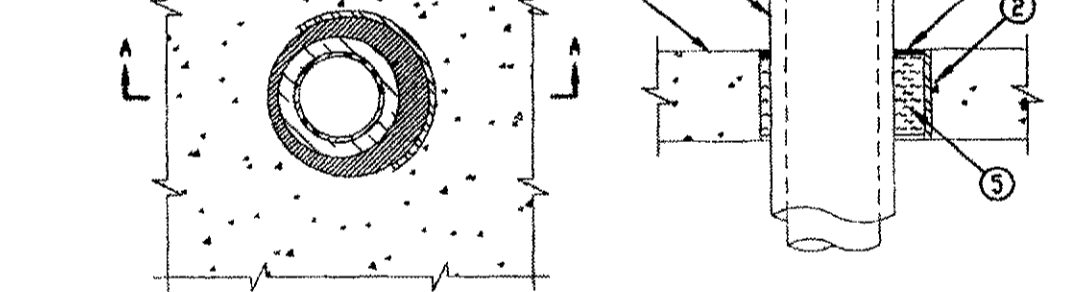


1. CONCRETE FLOOR OR WALL ASSEMBLY (2-HR. FIRE-RATING).
2. ANY UL/CUL CLASSIFIED CONCRETE BLOCK WALL.
3. MINIMUM 1/2" DEPTH HILTI FS-ONE INTUMESCENT FIRESTOP SEALANT IS REQUIRED ON BOTH SIDES OF A WALL ASSEMBLY.

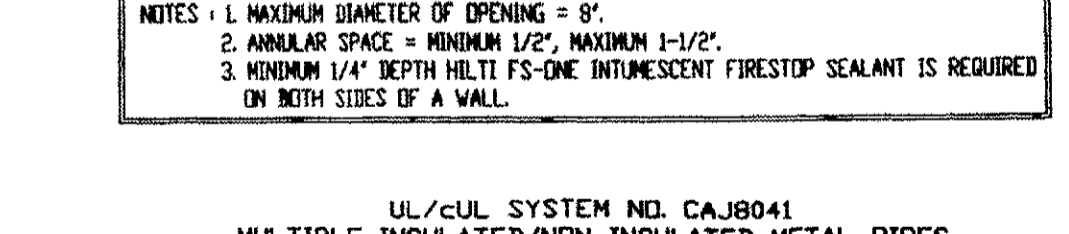


1. CONCRETE FLOOR OR WALL ASSEMBLY (2-HR. FIRE-RATING).
2. ANY UL/CUL CLASSIFIED CONCRETE BLOCK WALL.
3. MINIMUM 1/2" DEPTH HILTI FS-ONE INTUMESCENT FIRESTOP SEALANT IS REQUIRED ON BOTH SIDES OF A WALL ASSEMBLY.

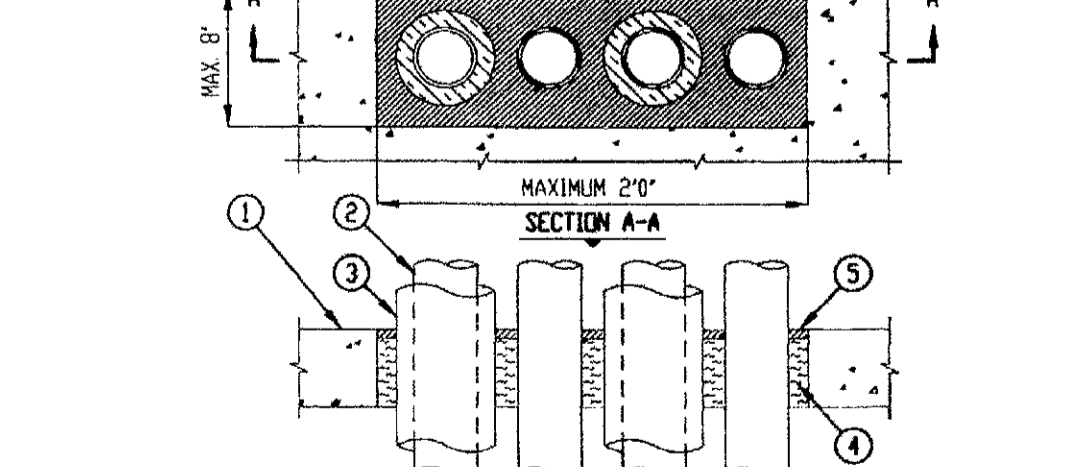

1. CONCRETE FLOOR OR WALL ASSEMBLY (2-HR. FIRE-RATING).
2. ANY UL/CUL CLASSIFIED CONCRETE BLOCK WALL.
3. MINIMUM 1/2" DEPTH HILTI FS-ONE INTUMESCENT FIRESTOP SEALANT IS REQUIRED ON BOTH SIDES OF A WALL ASSEMBLY.

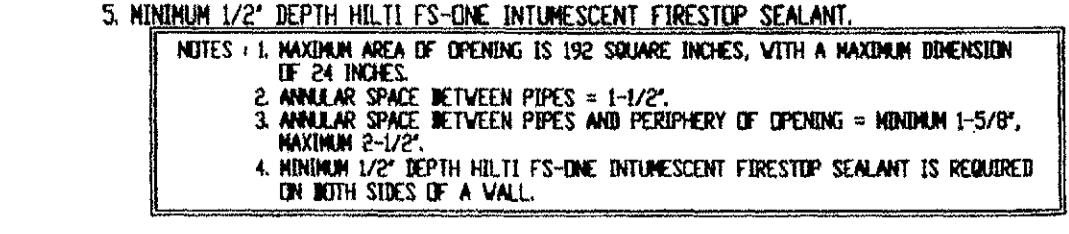


1. CONCRETE FLOOR OR WALL ASSEMBLY (2-HR. FIRE-RATING).
2. ANY UL/CUL CLASSIFIED CONCRETE BLOCK WALL.
3. MINIMUM 1/2" DEPTH HILTI FS-ONE INTUMESCENT FIRESTOP SEALANT IS REQUIRED ON BOTH SIDES OF A WALL ASSEMBLY.

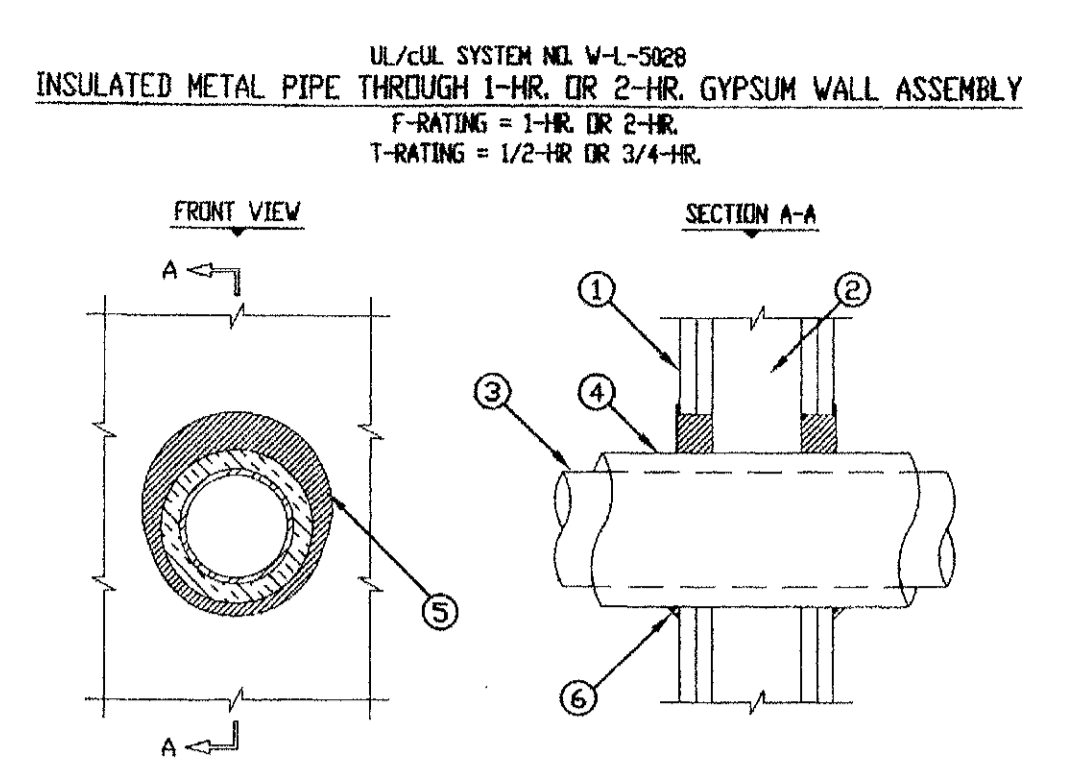

1. GYPSUM WALL ASSEMBLY (UL/CUL CLASSIFIED U300 OR U400 SERIES) (1-HR. OR 2-HR. FIRE-RATING) (2-HR. FIRE-RATING).
2. ONIT SHOWING WOOD STUDS TO CONSIST OF MINIMUM 2" x 4" LUMBER STEEL STUDS TO BE MINIMUM 2-1/2" WIDE.
3. PENETRATING ITEM TO BE ONE OF THE FOLLOWING:
  - A. MAXIMUM 1/2" NOMINAL DIAMETER STEEL PIPE (SCHEDULE 40 OR HEAVIER).
  - B. MAXIMUM 1/2" NOMINAL DIAMETER COPPER PIPE.
  - C. MAXIMUM 1/2" NOMINAL DIAMETER STEEL CONDUIT.
  - D. MAXIMUM 3/4" THICK AB/PVC FLEXIBLE FOAM PIPE INSULATION.
4. HILTI FS-ONE HIGH PERFORMANCE INTUMESCENT FIRESTOP SEALANT:
  - A. MINIMUM 5/8" DEPTH FOR A 1-HR. FIRE-RATING.
  - B. MINIMUM 1-1/4" DEPTH FOR A 2-HR. FIRE-RATING.
5. MINIMUM 1/2" DEPTH HILTI FS-ONE FIRESTOP SEALANT AT POINT OF CONTACT.

 NOTES: 1. MAXIMUM DIAMETER OF OPENING = 7-1/2".  
2. ANNULAR SPACE = MINIMUM 1/2", MAXIMUM 1-1/2".



1. Wall Assembly—The 1 or 2 h fire-rated gypsum wallboard/stud wall assembly shall be constructed of the materials and in the manner specified in the individual U300 or U400 Series Wall and Partition Designs in the UL Fire Resistance Directory and shall include the following construction features:
  - A. Studs—Wall framing may consist of either wood studs or steel channel studs. Wood studs to consist of nom 2 by 4 in. lumber spaced 16 in. OC. In 2 h fire-rated assemblies, steel studs to be min 2-1/2 in. wide and spaced max 24 in. OC. In 1 h fire-rated assemblies, steel studs to be min 3-5/8 in. wide and spaced 24 in. OC. Additional studs shall be installed horizontally in such a manner to form a nom 2x3-1/4 in. wide by 6 in. high opening.
  - B. Wallboard, Gypsum—5/8 in. thick, 4 ft wide with square or tapered edges; the gypsum wallboard type, thickness, number of layers, fastener type and sheet orientation shall be as specified in the individual U300 or U400 Series Design in the UL Fire Resistance Directory. If the through penetrants are installed in a wood stud/gypsum wallboard assembly, the max area of opening is 87 sq. in. with max dimension of 16-1/2 in.

2. Through Penetrants—Four pipes, conduits or tubing to be installed within the opening. The space between pipes, conduits or tubing shall be a nom 3-7/8 in. The space between pipes, conduits or tubing and periphery of opening shall be min 5/8 in. to max 1-15/16 in. Pipe, conduit or tubing to be rigidly supported on both sides of wall assembly. The following types and sizes of pipes, conduits or tubing may be used:
  - A. Steel Pipe—Nom 3 in. diam (or smaller) Schedule 5 (or heavier) steel pipe.
  - B. Iron Pipe—Nom 2 in. diam (or smaller) cast or ductile iron pipe.
  - C. Conduit—Nom 3 in. diam (or smaller) steel electrical metallic tubing or steel conduit.
  - D. Copper Tubing—Nom 2 in. diam (or smaller) Type L (or heavier) copper tubing.
  - E. Copper Pipe—Nom 2 in. diam (or smaller) Regular (or heavier) copper pipe.
  - F. Polyvinyl Chloride (PVC) Pipe—Nom 2 in. diam (or smaller) Schedule 40 PVC pipe for use in closed (process or supply) piping system.

3. Pipe Coverings—The following types of pipe coverings shall be used:
  - A. Pipe and Equipment Covering—Materials—Nom 1 in. thick hollow cylindrical heavy duty (min 3.5 pcf) glass fiber units jacketed on the outside with an all service jacket. Longitudinal joints sealed with metal fasteners or factory-applied self-sealing lap tape. Transverse joints secured with metal fasteners or with butt tape supplied with the product. The pipe covering may be installed on one of the metallic pipes or tubing having a nom diam of 2 in. or less. The insulated pipe or tubing shall be spaced a nom 1-7/8 in. from the other through-penetrants. The space between the insulated pipe or tubing and periphery of the opening shall be a nom 1 in.
  - B. See Pipe and Equipment Covering—Materials (BRGU) category in the Building Materials Directory for names of manufacturers. Any pipe covering material meeting the above specifications and bearing the UL Classification Marking with a Flame Spread Index of 25 or less and a Smoke Developed Index of 50 or less may be used.
  - C. Pipe Covering Materials—Nom 1 in. thick unfaced mineral fiber pipe insulation having a nom density of 3.5 pcf (or heavier) and sized to the outside diam of pipe or tube. Pipe insulation secured with min 8 AWG steel wire spaced max 12 in. OC. The insulated pipe or tubing shall be spaced a nom 1-7/8 in. from the other through-penetrants. The space between insulated pipe and periphery of opening shall be a nom 1 in.

4. Cables—Max six cables to be installed within the firestop system. Cables to be spaced 1-1/2 in. from the through-penetrants. The space between the cables and periphery of opening shall range from a min 1 in. to a max 2-7/8 in. Cables to be tightly bundled together and rigidly supported on both surfaces of wall. Any combination of the following types and sizes of copper conductor cables may be used:
  - A. Max 25 pair No. 24 AWG (or smaller) telephone cables with polyvinyl chloride (PVC) insulation and jacket.
  - B. Max 3/4 (with ground)—No. 10 AWG (or smaller) nonmetallic sheathed ("Romex") cable with PVC insulation and jacket.
  - C. Max 4 pair No. 18 AWG (or smaller) thermostat cables with PVC insulation and jacket.

5. Firestop System—The firestop system shall consist of the following:
  - A. Packing Material—In 2 h fire-rated assemblies, min 2-1/2 in. thickness of min 8 pcf mineral wool batt insulation firmly packed into opening as a permanent form. In 1 h fire-rated assemblies, min 2-1/4 in. thickness of mineral wool batt insulation firmly packed into opening as a permanent form. Packing material to be recessed from both surfaces of wall as required to accommodate the required thickness of fill material.
  - B. Fill, Void or Cavity Material—Caulk—Min 1-1/4 in. thickness of fill material applied within the annulus, on both surfaces of wall. Caulk to be forced into interstices of cable group to max extent possible. Additional caulk to be installed such that a min 1 in. is leaving beyond periphery of the opening.


Approved by: \_\_\_\_\_ DATE: \_\_\_\_\_  
 Director  
 HOUSTON AIRPORT SYSTEM  
 PROJECT NO. 1140  
 C.I.P. No. A-0354  
 H.A.S. No. 538C  
 SHEET NO. 5 Z1.003

**RECORD DRAWINGS**  
 DO NOT MODIFY  
 Rev'd by Rosa Architects, Inc.  
 13 May 2005  
 Note: Information used to develop these documents was taken from Record of the Work Drawings prepared by the construction contractor. Check Construction Group - Texas. The information provided by the contractor was not verified by the design firm named above.



NO.	DESCRIPTION	DATE	BY
ISSUED FOR BID		10/19/01	
RECORD SET		05/13/05	EM

PROJECT MGR:	HEM
DESIGNER:	SG
DRAWN BY:	SEM
CHECKED BY:	AB
DRAWING STANDARD:	ISEP 07.20.2000
SCALE:	N.T.S.
DATE:	09/14/01

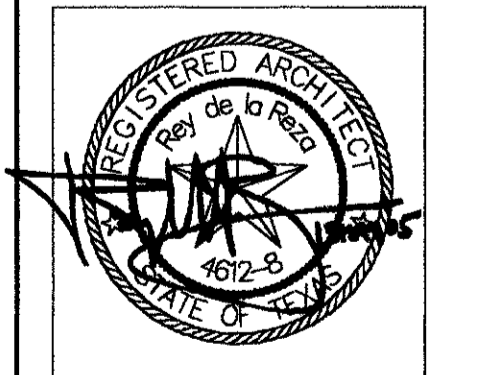




APPROVED BY:	DATE:
DIRECTOR	
HOUSTON AIRPORT SYSTEM	
PROJECT NO.	1140
C.J.P. NO.	A-0354
H.A.S. NO.	536C
SHEET NO.	

**RECORD DRAWINGS**  
 DO NOT MODIFY  
 Rey de la Reza Architects, Inc.  
 13 May 2005

Note: Information used to develop these documents was taken from Record of the Work. Drawings prepared by the construction contractor. Civil Construction Group - Texas. The information provided by the contractor was not verified by the design firm named above.


**ACCESSIBILITY NOTES**

- Controls and hardware:**
  - A. Handles, pulls, latches, locks and other operating devices on doors, windows, cabinets, plumbing fixtures and storage lockers, shall have lever or other shape which will permit operation by wrist or arm pressure and does not require tight grasping, pinching or twisting to operate.
  - B. The highest operable part of environmental and other controls, dispensers, receptacles and other operable equipment shall be within at least one of the reach ranges specified above and not less than 36 in. above the floor. Electrical and communications system receptacles on walls shall be mounted a minimum of 15 in. in height above the floor. Door hardware shall be mounted not more than 42 in. above finished floor, except accessible stiles where it shall be mounted between 54 and 36 in. above finished floor.
  - C. Clear floor space that allows a forward or a side approach shall be provided at all controls or hardware.
- Accessible route of travel:**
  - A. The minimum clear width of an accessible route of travel shall be 36 in. except at doors. Where an accessible route includes a 180-degree turn around an obstruction which is less than 48 in. in width, the clear width of the accessible route of travel around the obstruction shall be 42 in. min.
  - B. An accessible route of travel shall have a running slope not greater than 1 vertical in 12 horizontal. Cross slopes of an accessible route of travel shall not exceed 1 vertical in 50 horizontal.
  - C. Protruding objects shall not reduce the clear width of an accessible route of travel or maneuvering space. Any wall- or post-mounted object with its leading edge between 27 in. and 80 in. above the floor may project no more than 4 in. into the required width within a corridor any wall- or post-mounted projection greater than 4 in. shall extend to the floor. Protruding objects shall not reduce the clear width of an accessible route of travel or maneuvering space.
  - D. Accessible routes from public transportation stops, accessible parking, accessible passenger loading zones at public streets or sidewalks to the accessible building entrance they serve are required and shall not exceed 5% or 1:20 slope in the direction of travel nor 2% or 1:50 in cross slope.
- Obstacles in clear:**
  - A. Accessible routes of travel and accessible spaces within buildings shall have continuous common floor or ramp surfaces. Abrupt changes in height greater than 1/4 in. shall be beveled to 1 vertical in 2 horizontal changes in level greater than 1/2 in. shall be accomplished by means of a ramp or delineated in section 5 below.
  - B. All surfaces shall be firm and stable. Showers, locker rooms, toilet rooms, and other areas subject to wet conditions shall have slip-resistant floors. Grates within an accessible route of travel shall have no openings more than 1/2 in. in least clear distance between solid parts. The maximum vertical surface change shall be 1/8 in.
  - C. Ramps:
    - A. The maximum slope of a ramp shall be 1 vertical in 2 horizontal. The maximum rise for any run shall be 30 in.
    - B. The minimum clear width of a ramp shall not be less than 48 in. (with the exception of single-run ramps not in excess of 15 ft. in length which may have widths of not less than 36 in.)
    - C. Exposed ramps and their approaches shall be constructed to prevent the accumulation of water on walking surfaces.
  - D. Curb ramps can not be located in access aisle. The access aisle must be level, less than 2% slope. This means the curb ramp must be within the sidewalk rather than within the access aisle.
- Entrances:**
  - A. All entrances are required to be level. Level is 2% or 1/4" per foot or less slope.
- Doors:**
  - A. Doors shall be capable of opening so that the clear width of the opening is not less than 32 in.. All doors shall have minimum maneuvering clearances as follows:
    - (a) Where a door must be pulled to be opened, an unobstructed floor space shall extend at least 18 in. beyond the stile.
    - (b) Where a door must be pushed to be opened and is equipped with a closer and a latch, an unobstructed floor space shall extend at least 12 in. beyond the strike jamb.
    - (c) Where two doors are in series, the minimum distance between two hinged or pivoted doors shall be 52 in. in addition to any area needed for door swing.
  - B. Where provided, a door closer shall be adjusted to close from an open position of 70 degrees in not less than three seconds. To a point 3 in. (75mm) from the latch, when measured to the leading edge of the door.
  - C. Exit doors shall be of the side-hinged swinging or pivoted type. Exit doors shall swing in the direction of exit travel when serving any hazardous area or when serving an occupant load of 50 or more. The door latch shall release when subjected to a 15-pound force, and the door shall be set in motion when subjected to a 30-pound force. The door shall swing to full-open position when subjected to a 15-pound force. The maximum opening force for doors located within an accessible route shall not exceed 8.5 pounds for exterior hinged doors, 5 pounds for sliding or folding doors or 5-pounds for interior hinged doors. Forces shall be applied to the latch side.
  - D. When panic hardware is installed, the activating member shall be mounted at a height of not less than 30 in. or more than 44 in. above the floor. The unlatching force shall not exceed 15 pounds when applied in the direction of exit travel.
  - E. Every required exit doorway shall be of a size as to permit the installation of a door not less than 3 feet in width and not less than 6 ft. 8 in. in height. When installed, exit doors shall be capable of opening so that the clear width of the exit is not less than 32 in..
  - F. The maximum force for pushing or pulling a door shall be as follows:
    - (a) Fire doors shall have the minimum opening force allowable by the appropriate administrative authority.
    - (b) Interior hinged doors: 5 LBF (22.2N)
    - (c) Sliding or folding doors: 5 LBF (22.2N)
 These forces do not apply to the force required to retract latch bolts or disengage other devices that may hold the door in a closed position.
  - G. Thresholds at doorways and thresholds shall not exceed 3/4" (19mm) in height for exterior sliding doors or 1/2" (13mm) for other types of doors.
  - H. Raised thresholds and floor level changes at accessible doorways shall be beveled with a slope no greater than 1:2.
- Restrooms, toilet rooms, bathing facilities and shower rooms:**
  - A. An unobstructed floor space shall be provided within restrooms, toilet rooms, bathing facilities and shower rooms of sufficient size to inscribe a circle with a diameter not less than 60 in. Doors in any position may encroach into this space by not more than 12 in.. The clear floor spaces at fixture, the accessible route of travel and the unobstructed floor space may overlap.
  - B. Grab bars shall have a nominal diameter of not less than 1 1/4 in. or more than 1 1/2 in. (32mm to 38mm) and shall provide a clearance of 1 1/2 in. (38mm) between the grab bars and the wall.
  - C. The grab bar which is located on the back wall behind the toilet is to be placed 6 in. from side wall.
  - D. The grab bar which is located on the side wall is to be placed 12 in. from the back wall.
- Controls and operating mechanisms:**
  - A. The highest operable part of controls, dispensers, receptacles, and other operable equipment shall be placed within at least one of the reach ranges specified in the state accessibility standards.
  - B. Electrical and communications system receptacles on walls shall be mounted not less than 15 in. (380mm) above the floor. Exception: These requirements do not apply where the use of special equipment dictates otherwise or where electrical and communications systems are not normally intended for use by building occupants.
- Water fountains:**
  - A. Wall- and post-mounted cantilevered units shall have a minimum clear floor space in front of the units 30 in. in width by 52 in. in depth in order to allow a person in a wheelchair to approach the unit facing forward. Free-standing or built-in units not having a clear space under them shall have a clear floor space of at least 30 in. in depth by 52 in. in width in order to allow a person in a wheelchair to make a parallel approach to the unit.
  - B. Wall- and post-mounted cantilevered units shall have knee spaces of not less than 19 in. in depth.
  - C. Spouts shall be located not more than 36 in. above the floor or ground surface. Spouts shall be located in the front of the unit and shall direct a flow not less than 4 in. in height, in a trajectory parallel to the front of the unit.
  - D. Controls shall be located not more than 6 in. from the front of the unit. The force required to activate the control shall not exceed 5 pounds.
- Alarms:**
  - A. If provided, alarms must be both audio and visual. At a minimum, visual signal appliances shall be provided in buildings and facilities in:
    - (a) Restrooms and any other general usage areas (e.g., meeting rooms).
    - (b) Hallways, lobbies, and any other area for common use.
  - B. Audible alarms shall comply with NFPA 72-1990. Audible alarms shall exceed the prevailing ambient sound level in the room or space by at least 15 decibels or shall exceed any maximum sound level with a duration of 60 in. louder. Sound levels for alarm signals shall not exceed 120 decibels.
  - C. Manual fire alarm devices shall be mounted not more than 48 in. above the floor provided that parallel approach is provided.
  - D. If single station audible alarms are provided then single station visual alarms shall be provided.
- Signage:**
  - A. Raised and brail characters and pictorial symbol signs shall be provided.
  - B. Facilities and elements required to be identified as accessible by this code shall use international symbol of accessibility.
  - C. If permanent identification is provided for rooms and spaces, then the signs shall be installed on the wall adjacent to the latch side of the door. Signs shall be centered at 60 in. (1525mm) above the finished floor.

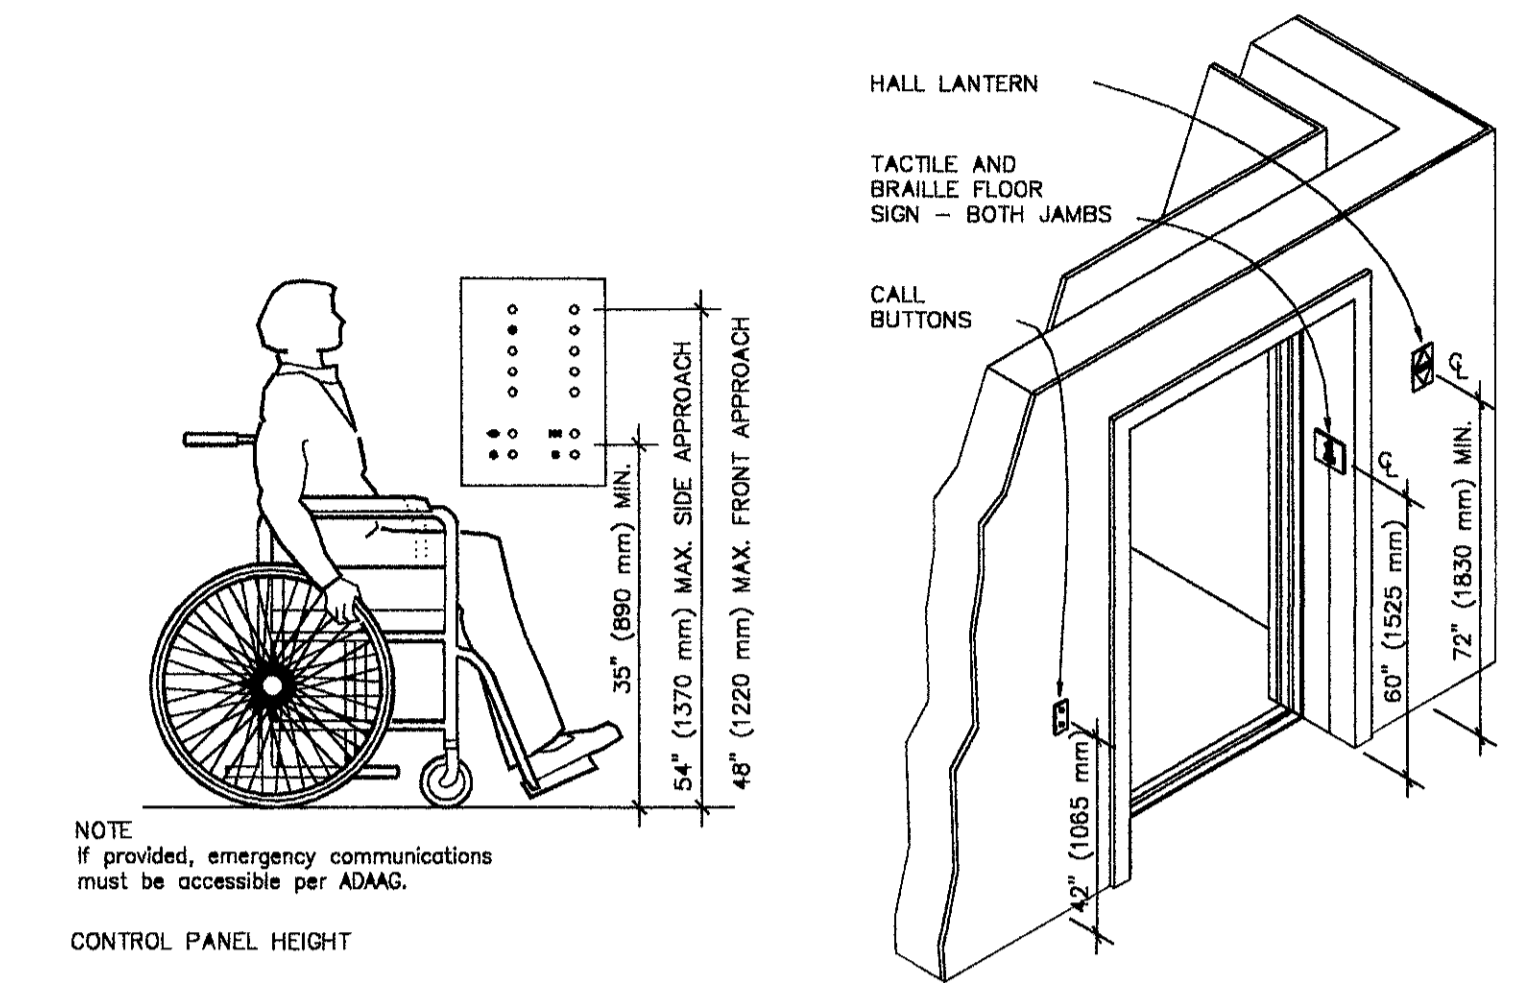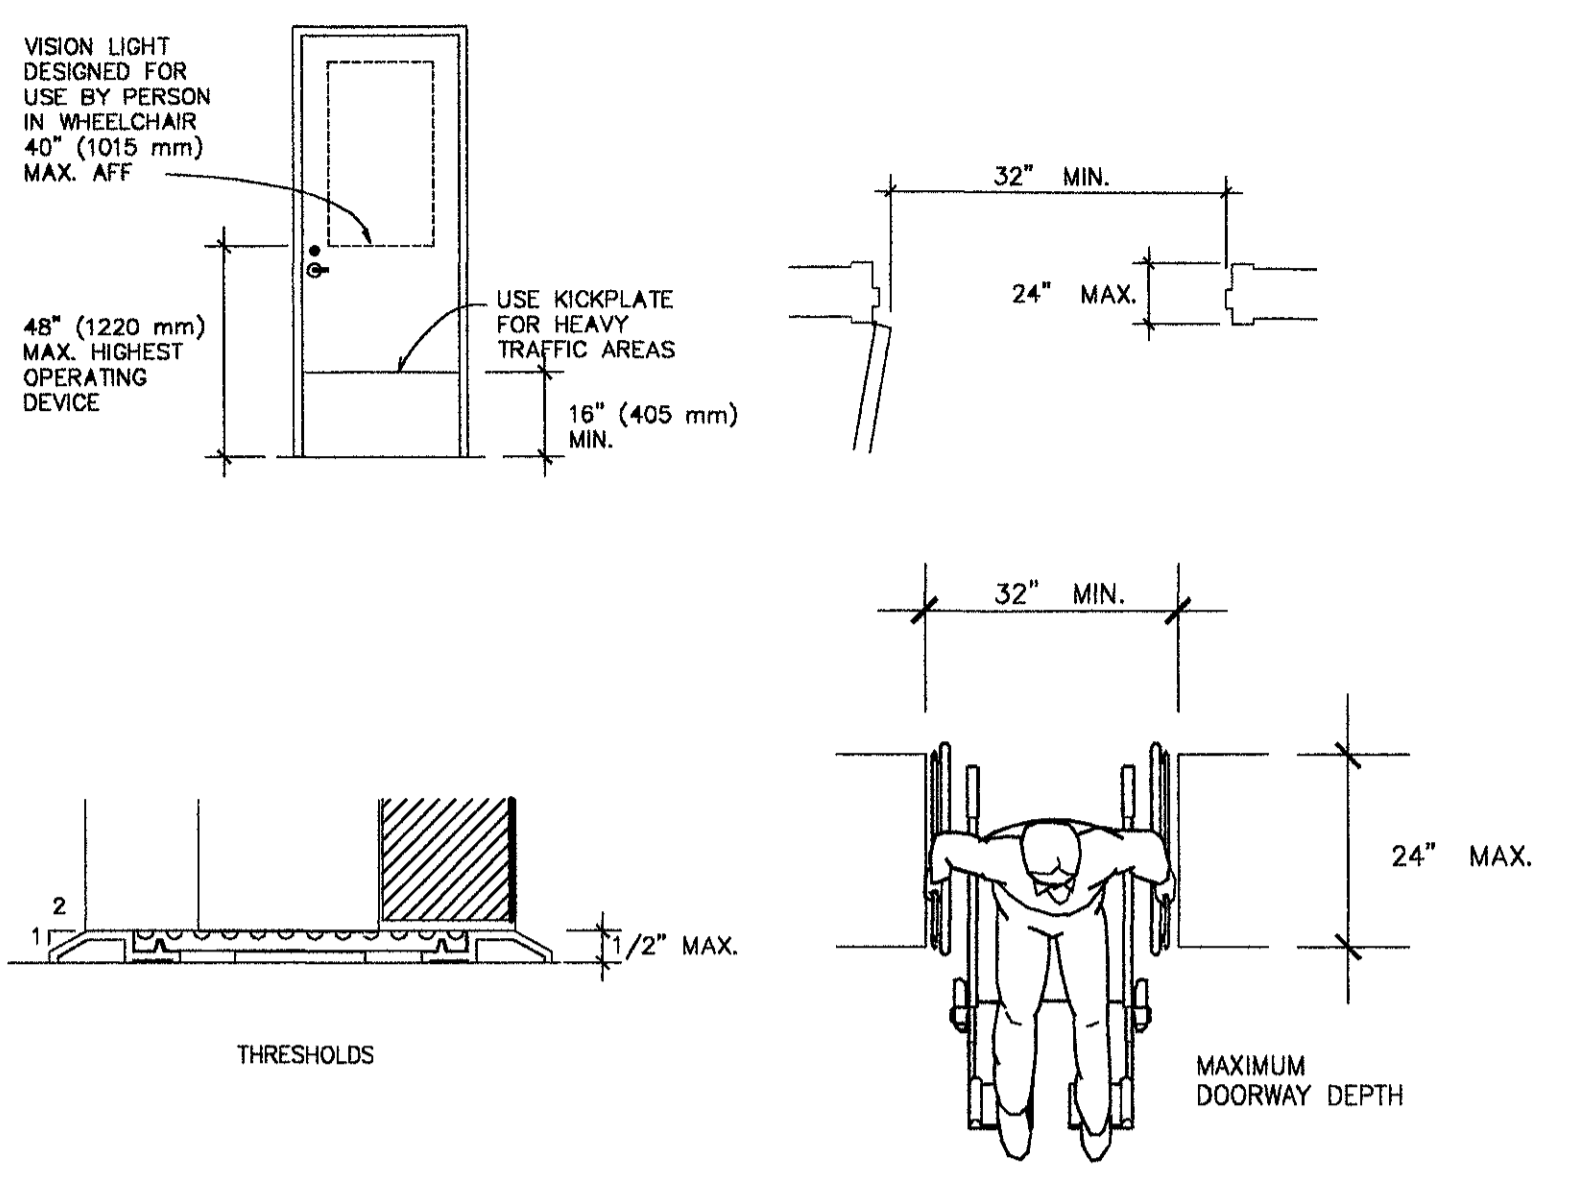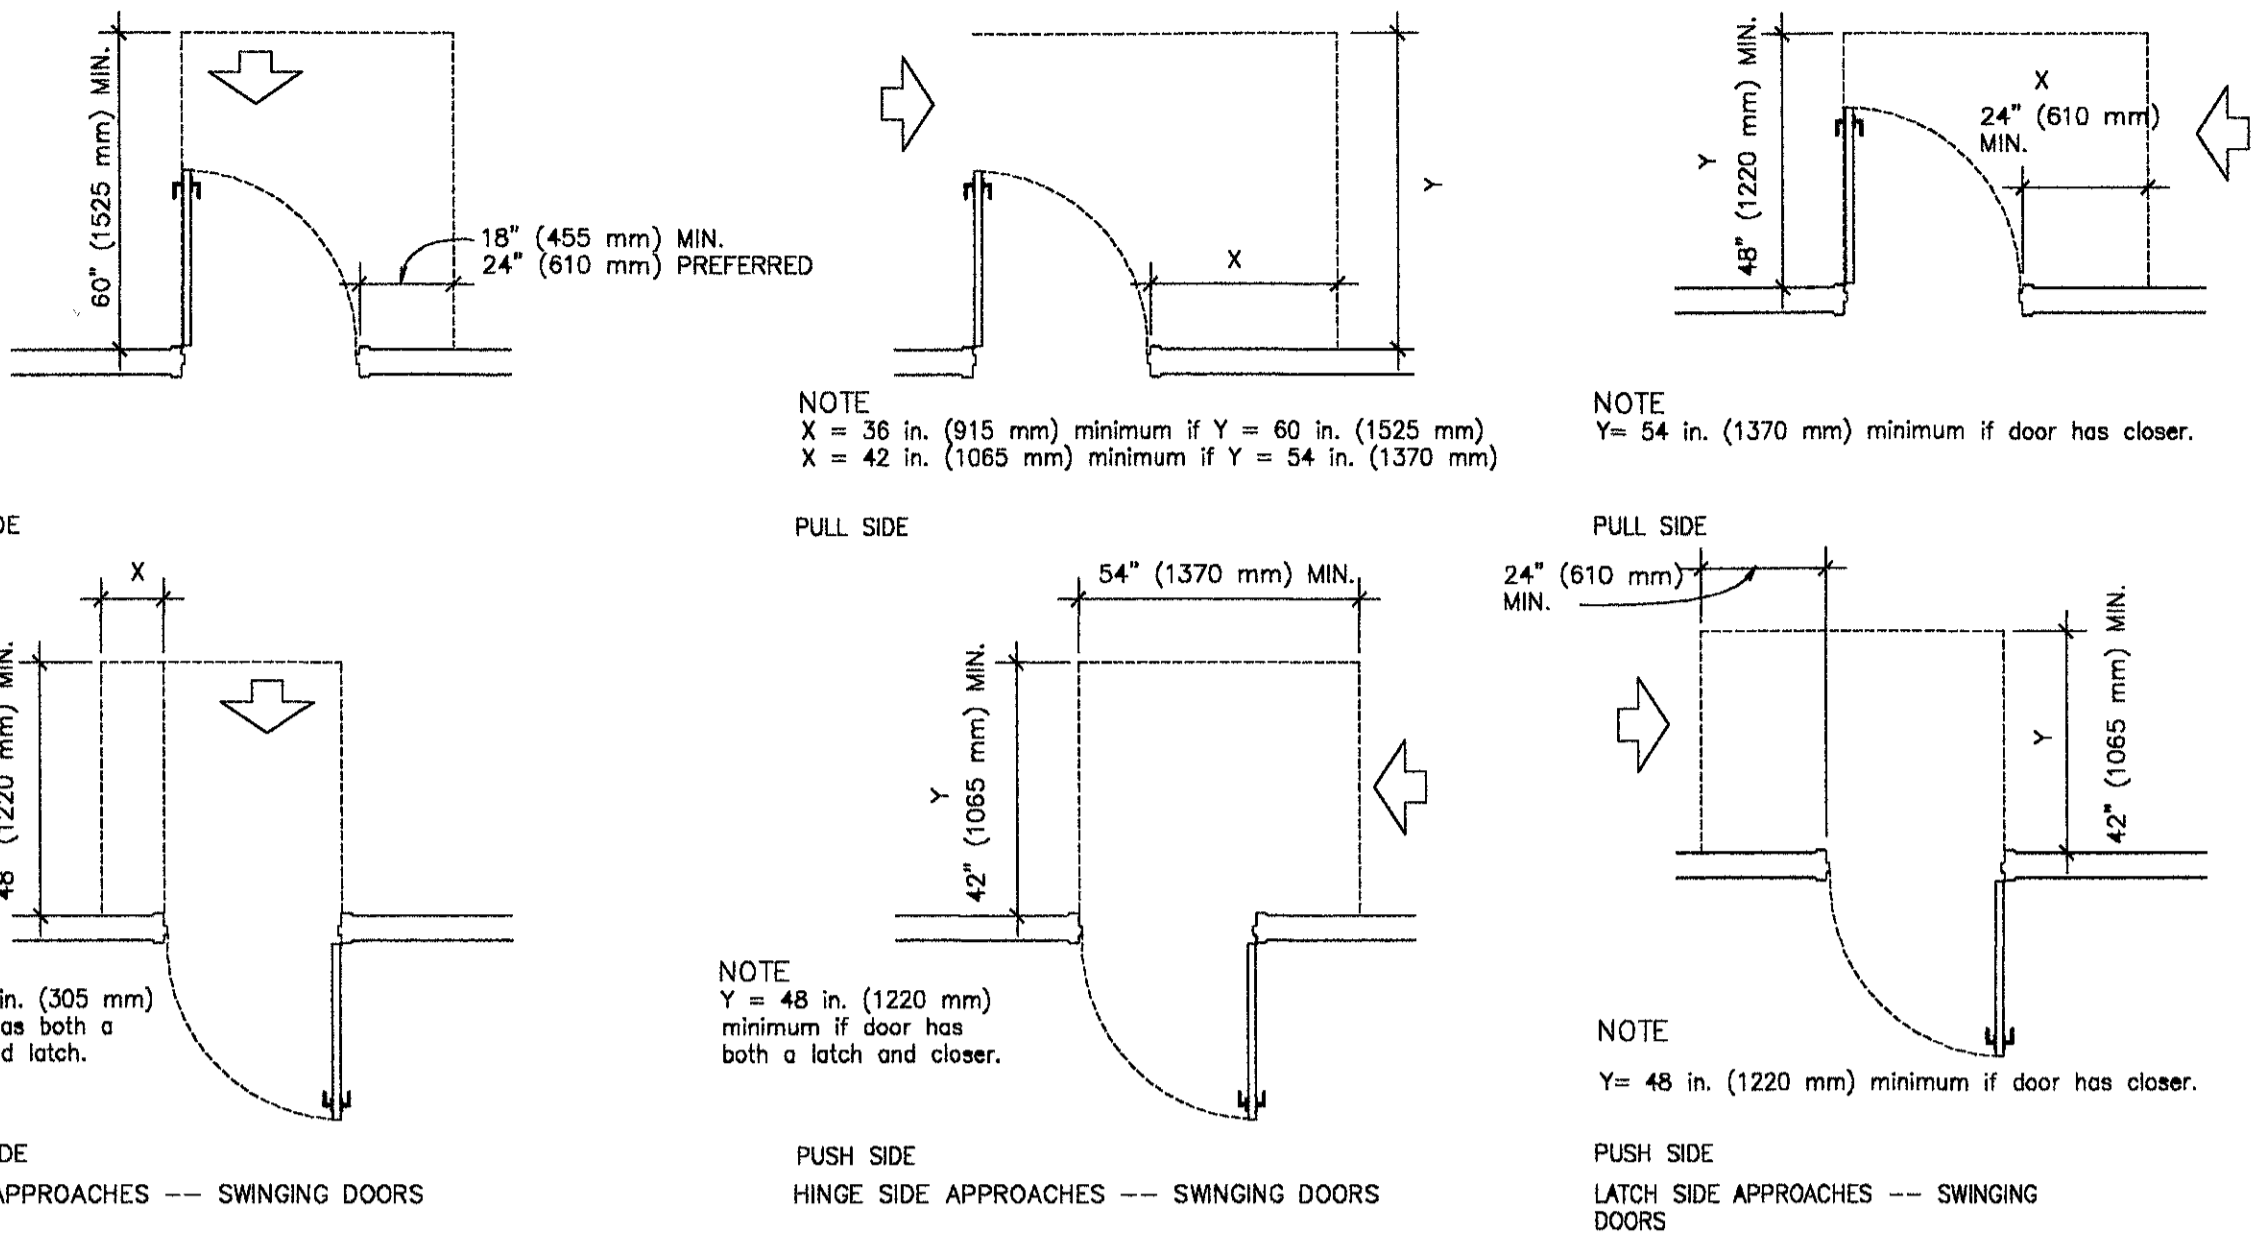


**02 MANEUVERING CLEARANCES AT DOORS**  
 Z1.003 N.T.S.


**01 ACCESSIBLE ELEVATOR**  
 Z1.003 N.T.S.

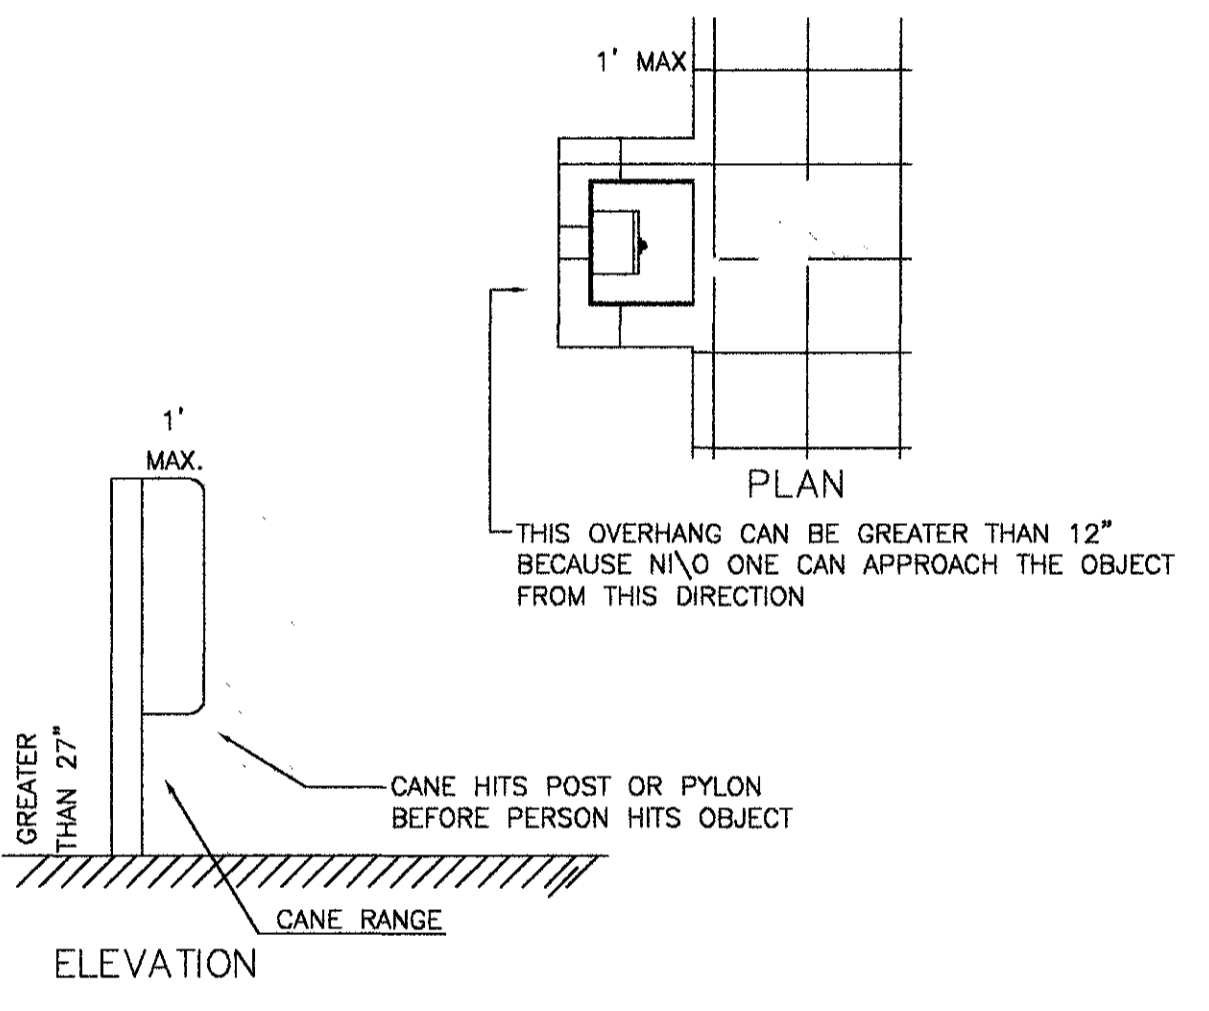


**06 POSTS/PYLONS**  
 Z1.003 N.T.S.

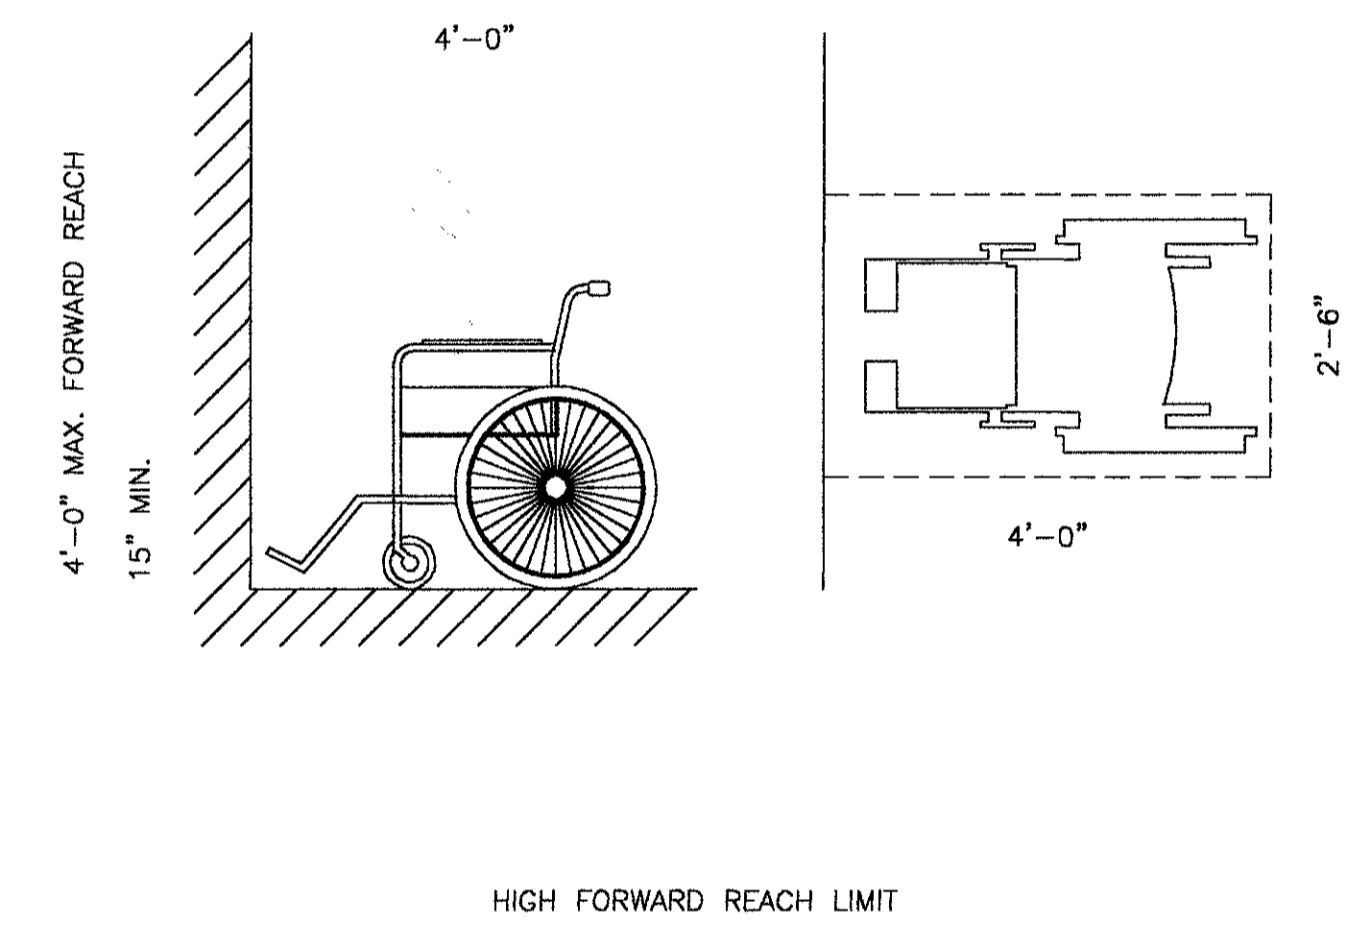


**05 FORWARD REACH**  
 Z1.003 N.T.S.

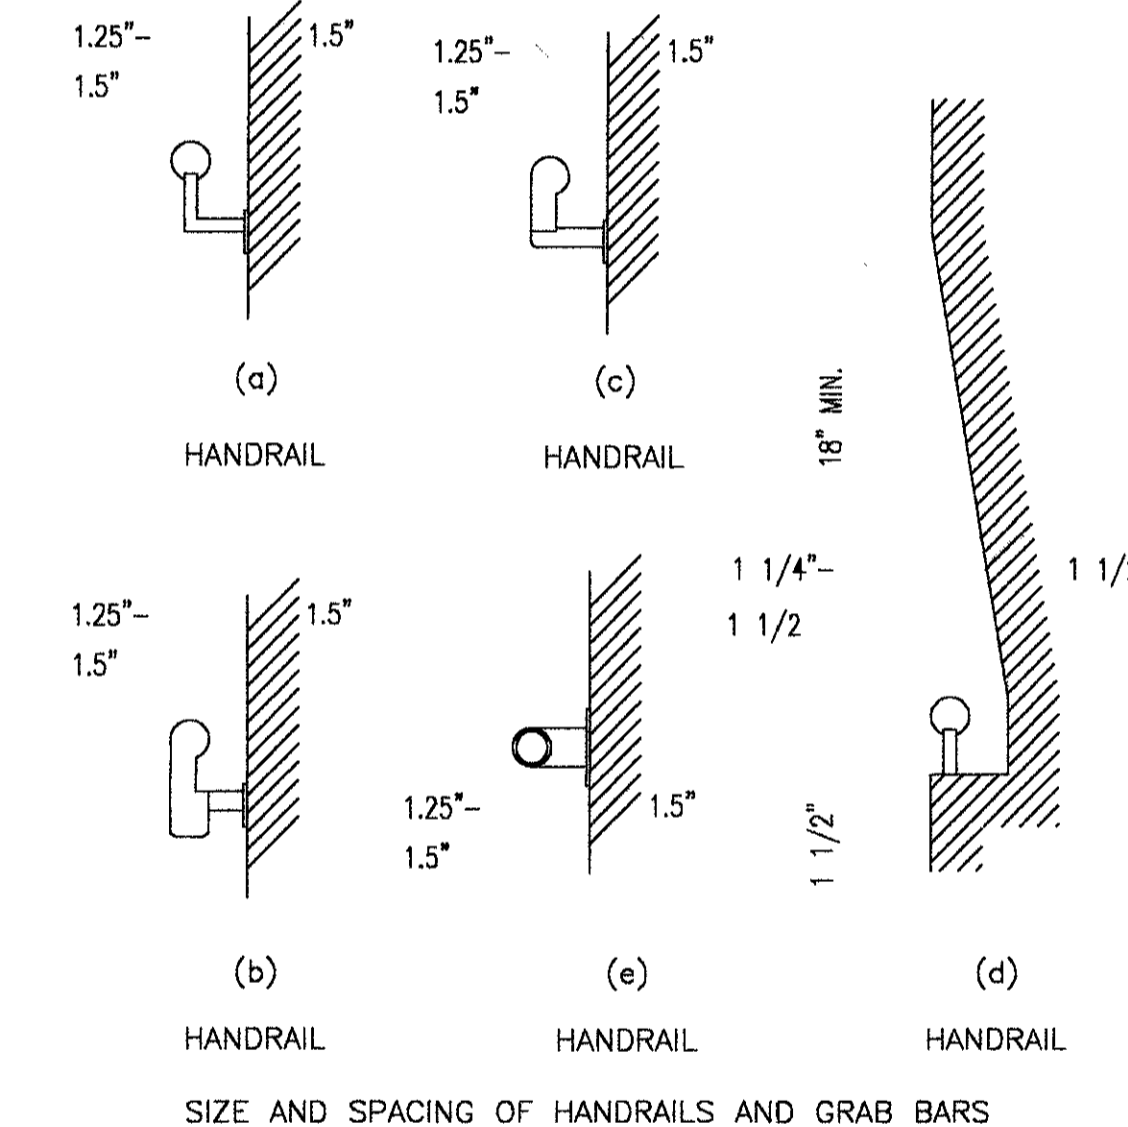


**04 HANDRAIL DETAILS**  
 Z1.003 N.T.S.

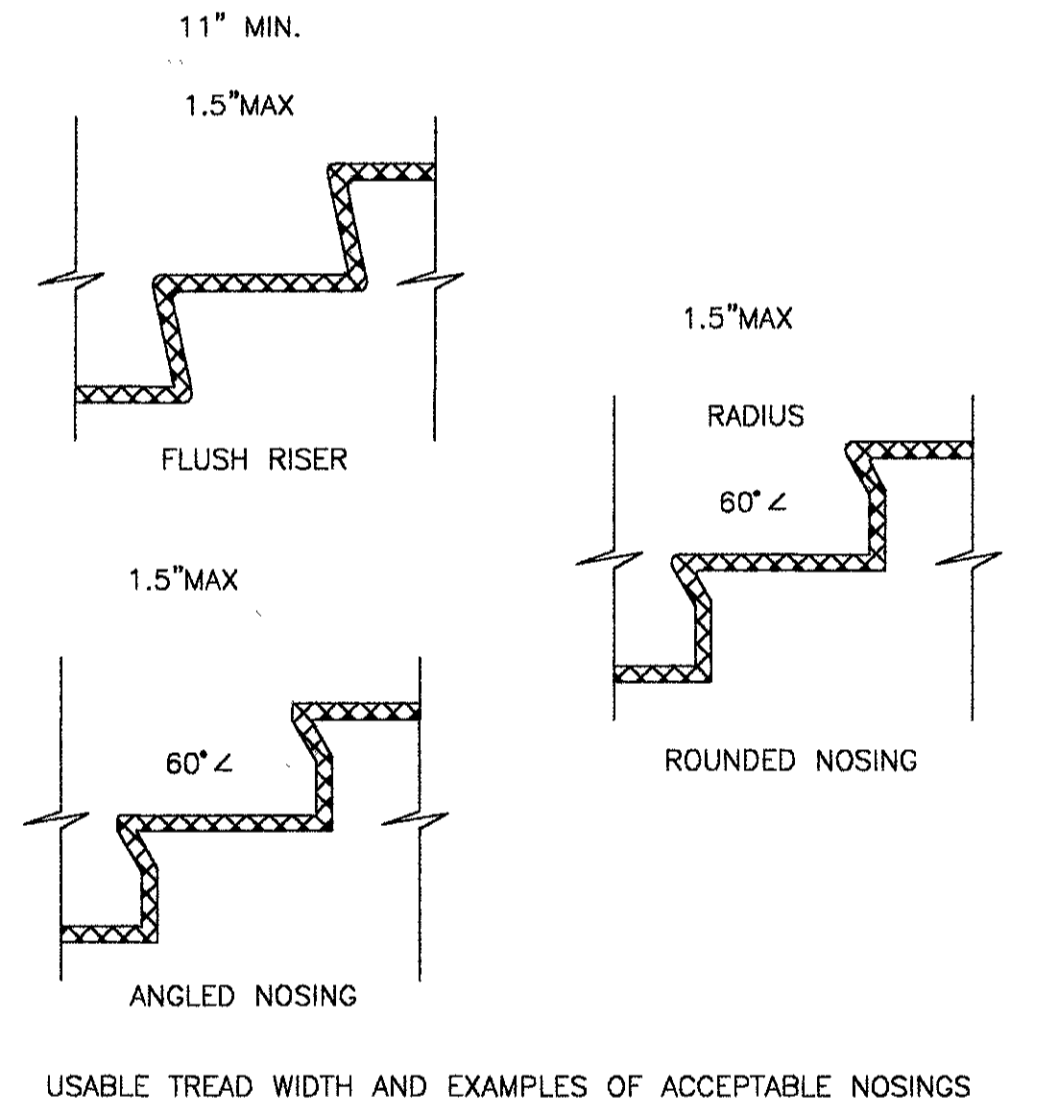

**03 TREAD & NOSINGS**  
 Z1.003 N.T.S.

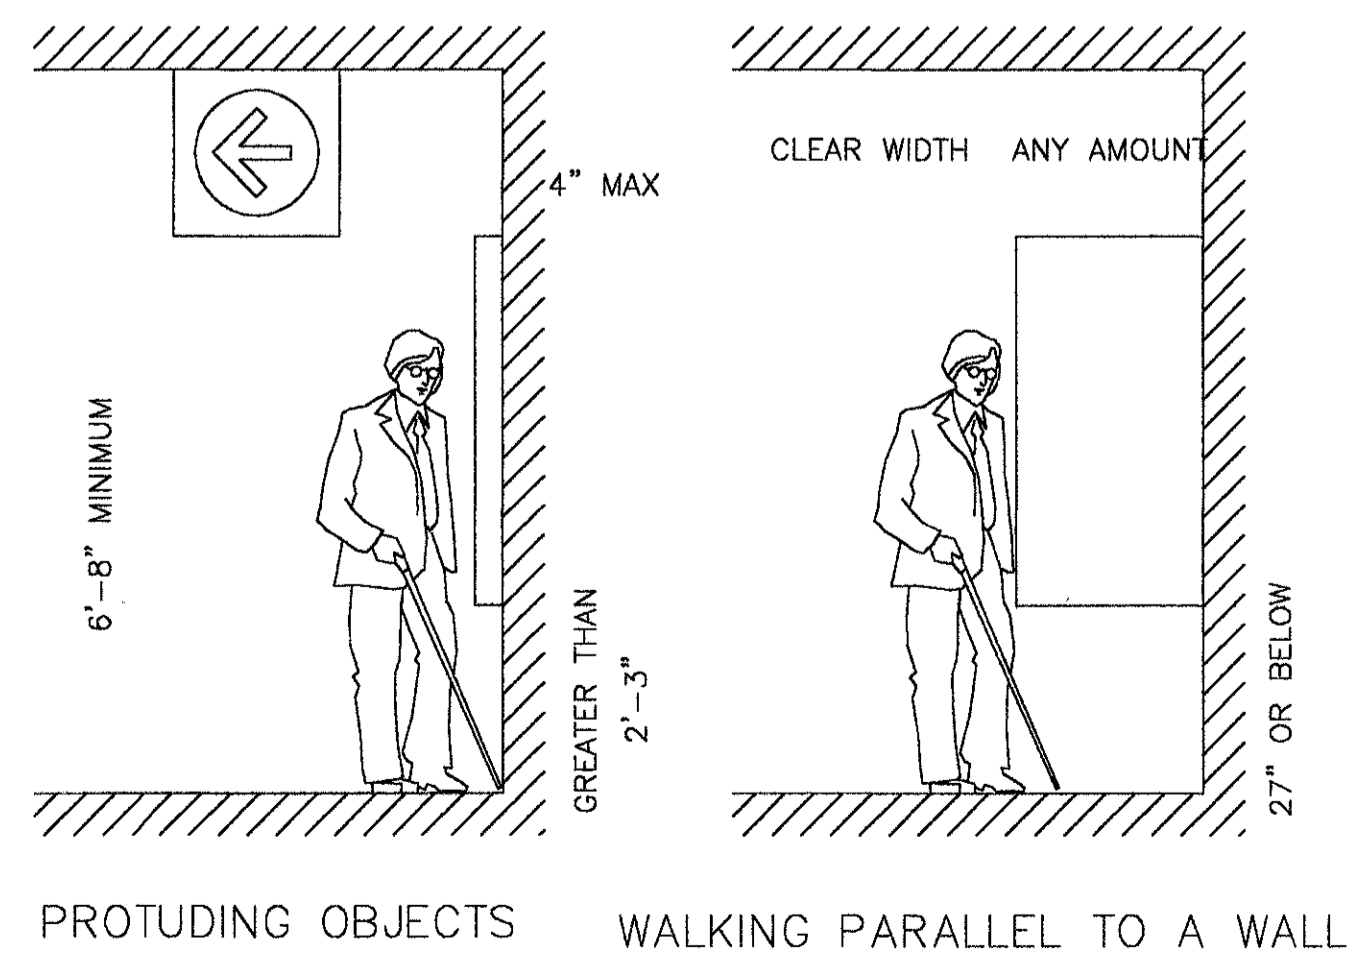

**11 PROTRUDING OBJECTS**  
 Z1.003 N.T.S.

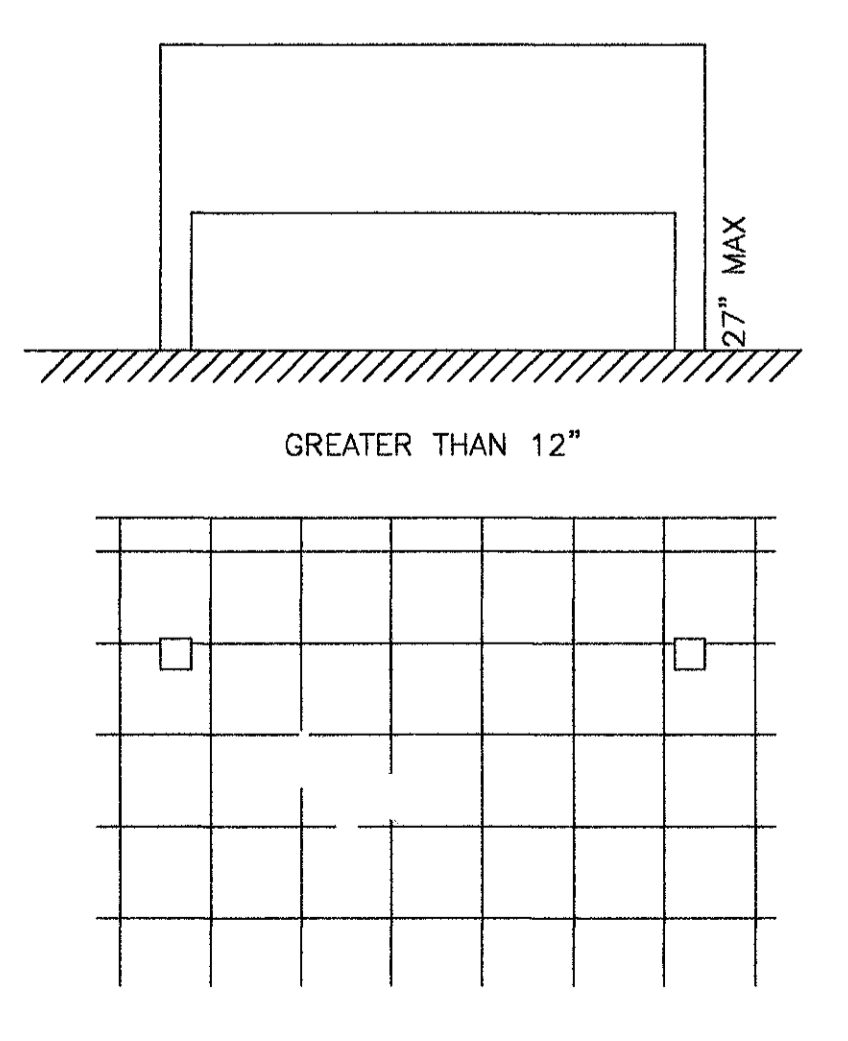

**10 PROTRUDING OBJECTS**  
 Z1.003 N.T.S.

